


- KEY**
- EXTENT OF EXISTING OXFORDSHIRE COUNTY COUNCIL HIGHWAY OWNERSHIP.
 - EXTENT OF HIGHWAY WORKS.
 - AREA OFFERED TO OXFORDSHIRE COUNTY COUNCIL FOR ADOPTION.

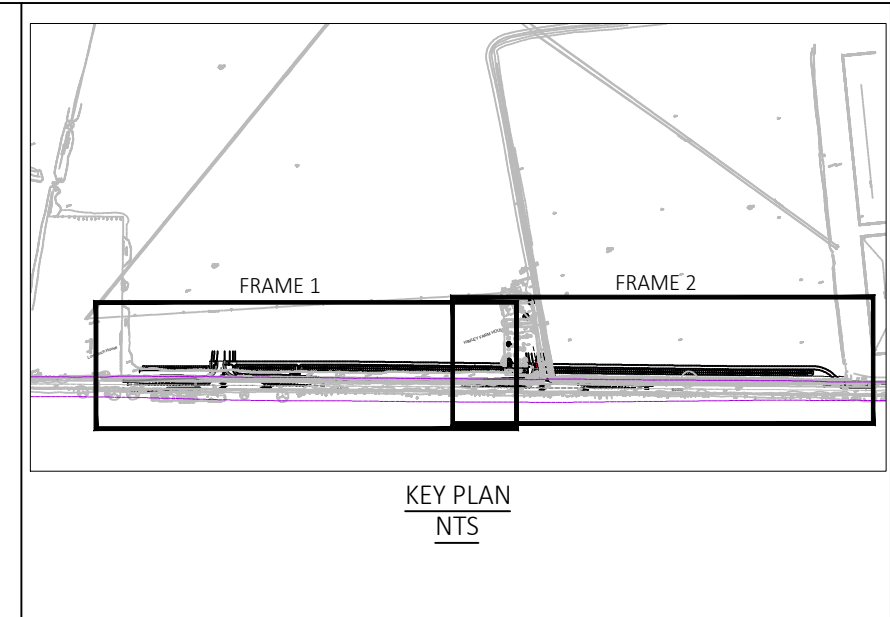

REVISIONS:

REV	DATE	DESCRIPTION	BY	CHKD	APP
P01	15/09/23	FIRST ISSUE.	TW	RJP	RJP

Hydrock

OVER COURT BARN
OVER LANE
ALMONDSBURY
BRISTOL
BS32 4DF
t: +44 (0) 1454 619533
e: bristol@hydrock.com

CLIENT
CALA HOMES COTSWOLDS LTD

PROJECT
HIMLEY VILLAGE,
MIDDLETON STONEY ROAD,
BICESTER

TITLE S278 OFFSITE HIGHWAY WORKS STREET ACCESSES LEGAL PLAN	
HYDROCK PROJECT NO. C-27141-C	SCALE @ A1 1 : 500
STATUS DESCRIPTION INFORMATION	STATUS S2
DRAWING NO. (PROJECT CODE-ORIGINATOR-ZONE-LEVEL-TYPE-ROLE-NUMBER) 27141-HYD-XX-XX-DR-D-0160	REVISION P01