
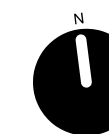
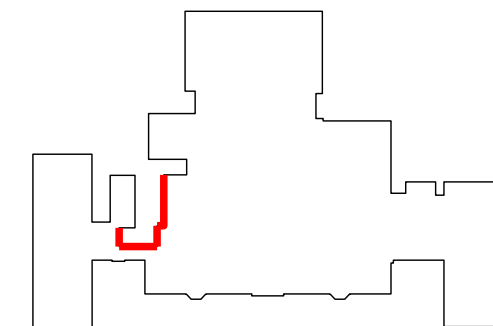


KEY

- 1 Paint
- 2 Minor Epoxy Repair
- 3 Full Timber Replace
- DU Damaged/Failed Unit
- WC Window Chip Repair
- OG Obscure Glass
- Brick Clean
- Soffit / Fascia Repair
- Remove Items
- Brick Repair

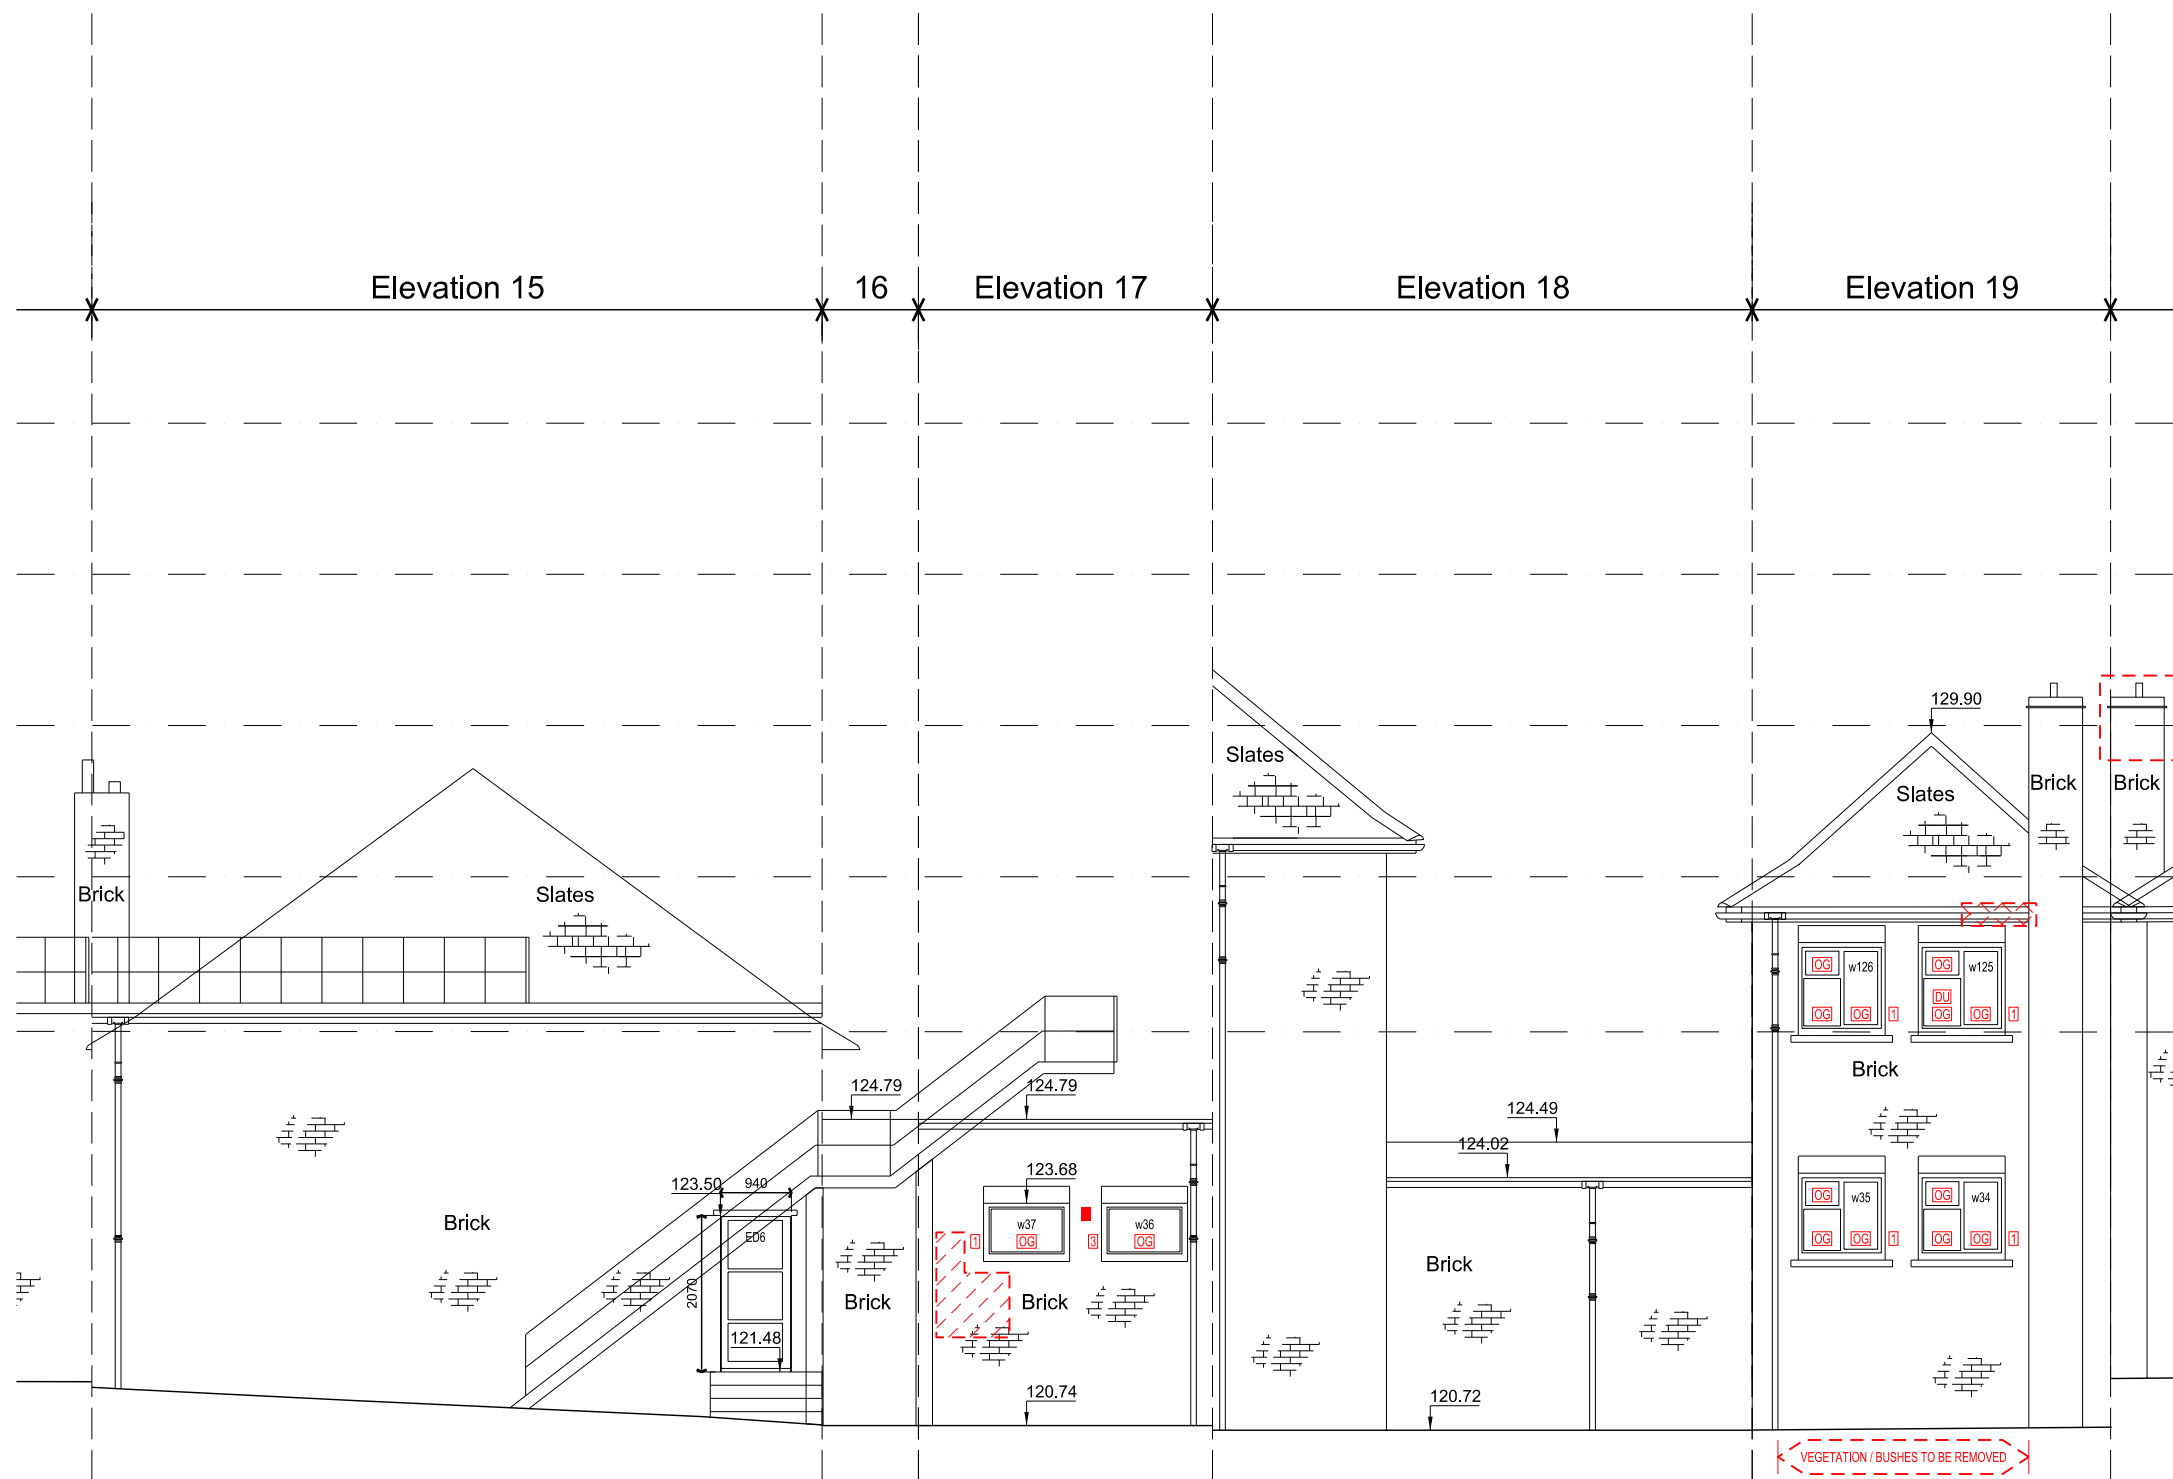

Revisions

Revision	Date	Revision notes	Design change	Inspected by
A	17.03.14	Revised elevation 19	TFW	IJ
B	09.04.14	Marked up areas to be repaired / made good	TFW	IJ

CP ISSUE

Job title  
**HeyFord Park Free School  
 Officers' Mess**

Drawing title  
**Existing Elevation  
 Elevation 15, 16, 17, 18, 19**

Check all dimensions and verify on site. Report any errors or omissions

First issued	13.03.14
Drawn by	IJ/DJ/TW
Drawing sheet size	A3
Scale	1:100
Inspected by	DJ
Job code	HFSK
Drawing number prefix	L-OM
Drawing number	1056
Revision	B



33a Victoria Street  
 Birmingham  
 B1 3ND  
 T +44(0) 121 234 6440  
 F +44(0) 121 234 6450  
 bham@adp-architects.co.uk  
 www.adp-architects.co.uk