



SSE Utility Solutions
Robert Brown House
Pipers Way
Thatcham
RG19 4AZ


DATE	DETAILS OF REVISION	Rev by:	Rev:
05/12/11	Water main moved to opposite side of the road as per as laid drawing. See revision cloud.	ME	B
22/09/11	Amendment to G,W and E designs - routes moved to other side of road from Plot 80	ME	A

Not all utilities are shown on this plan. Information with regard to such utilities should be obtained from the owners. The information shown on this plan is given without obligation, or warranty. The accuracy thereof cannot be guaranteed. All service pipes are not necessarily shown but their presence should be anticipated. No liability of any kind whatsoever is accepted by SSE PLC, its agents or servants, for any error or omission. Safe digging practices, as detailed in Health and Safety booklet HS(G)47 'Avoiding danger from underground services', must be used to verify and establish the actual position of mains, services and other plant on site before any Mechanical plant is used. It is your responsibility to ensure that this information is provided to all persons (either direct or contract labour) working for you.

THE INFRASTRUCTURE DESIGN INFORMATION CONTAINED WITHIN THIS DRAWING REMAINS THE PROPERTY OF SSE AND AS SUCH SHOULD NOT BE PASSED TO 3rd PARTIES WITHOUT PRIOR WRITTEN CONSENT.



- ELECTRICAL SERVICES**
- APPROXIMATE POSITION OF EXISTING HV CABLE
 - APPROXIMATE POSITION OF EXISTING LV CABLE
 - PROPOSED HV CABLE
 - PROPOSED LV CABLE
 - PROPOSED LV SERVICE CABLE
 - 150mm BLACK PLASTIC PRODUCT
 - 50mm ALUMINIUM DUCT FOR ELECTRICITY SUPPLY (BLACK)
 - BREACH JOINT
 - STRAIGHT JOINT
 - POT END
 - SINGLE PHASE SERVICE CONNECTED TO RED PHASE
 - SINGLE PHASE SERVICE CONNECTED TO YELLOW PHASE
 - SINGLE PHASE SERVICE CONNECTED TO BLUE PHASE
 - THREE PHASE SERVICE
 - STREET LIGHTING COLUMN
 - 50mm DUCT FOR STREET LIGHTING
- WATER SERVICES**
- APPROXIMATE POSITION OF EXISTING WATER MAIN
 - PROPOSED WATER MAIN
 - SERVICE CONNECTION 25mm UNLESS STATED OTHERWISE
 - PE DUCT FOR WATER SUPPLY (BLUE)
 - WATER METER/BIK METER LOCATION
 - SERVICE CONNECTIONS MANIFOLD - No. of PORTS
 - FIRE HYDRANT
 - WASH-OUT
 - TEMPORARY WASH-OUT
 - VALVE
- GAS SERVICES**
- APPROXIMATE POSITION OF EXISTING GAS MAIN (MEDIUM PRESSURE)
 - APPROXIMATE POSITION OF EXISTING GAS MAIN (LOW PRESSURE)
 - PROPOSED GAS MAIN (MEDIUM PRESSURE)
 - PROPOSED GAS MAIN (LOW PRESSURE)
 - GAS SERVICE PIPE TO BE Laid INSIDE FLEXIBLE 50mm ID
 - PE DUCT FOR GAS SUPPLY (YELLOW)
 - METER
 - SEMI CONCEALED RECESSED MULTIBOX
 - VALVE
 - SERVICE VALVE
 - REDUCER
 - END CAP
 - PRESS
- TELECOM SERVICES**
- APPROXIMATE POSITION OF EXISTING TELECOM CABLING/DUCTING
 - 40mm PVC DUCT (GREY)
 - 50mm PVC DUCT (GREY)
 - 60 & 50mm PVC DUCTS (GREY)
 - 2 x 50mm PVC DUCTS (GREY)
 - EXISTING JOINTBOX
 - NEW THIRTYTWO JOINTBOX
 - JOINTBOX JBT108 BUILT TO BT SPECIFICATION
 - JOINTBOX JBT110 BUILT TO BT SPECIFICATION
 - JOINTBOX JBT112 BUILT TO BT SPECIFICATION
 - DP (DRAW PTD) IDENTIFIER
 - SWEEP DUCT TEE
 - DUCT REDUCER 50 REDUCER
 - PLOT NUMBER/DP IDENTIFIER

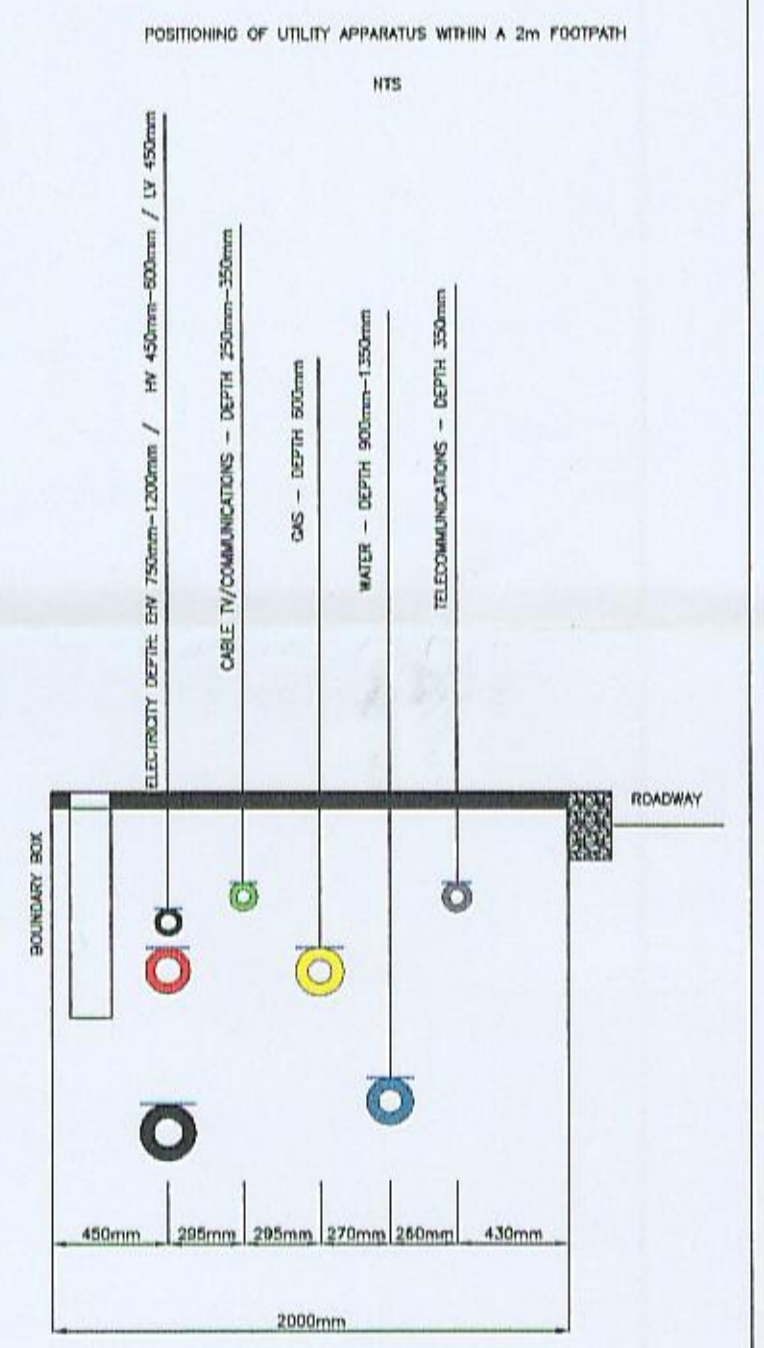

INDICATIVE PURPOSES ONLY
DO NOT SCALE

15/00355/DISC

PROJECT
**Whitlands Farm
Southwest Bicester**

TITLE **KM2 - WATER LAYOUT**

DATE: 05/12/2011	SCALE: 1:500
DESIGNED BY:	DRAWN BY: ME
APPROVED BY: (Print Name):	REV: B
DRAWING NO: 220920 - KM2 - MU03	SHEET SIZE: A1