

Plot 100-102, 127 - 128 & 134 - 135 only,
PV panels in accordance with manufacturers design. Refer to external works drawing for exact location

Roof pitch: 40°

Eaves to be constructed in accordance with eaves detail.

Entrance door style 1.

Entrance canopy style 1.

Facing brick to all elevations as indicated : to be constructed in accordance with manufacturer's recommendations and structural engineer's design.

Leaded light windows to all elevations

Brick heads and gills to all elevations

Refer to site general door and window schedule for details

Provide Code 4 leadwork flashing with cavity tray over to all abutments.

All entrance doors to have flush threshold and internal transition siltip to suit mobility standards in accordance with Approved Document M, refer to standard detail SUP/DPC/LT.

Refer to development engineers site layout for locations of ramp / steps. Provide stepped DPC 150mm above top of threshold.

Movement joints in accordance with Structural Engineers requirements.

NOTE:

If upper floor operable window is within 800mm of floor, internal guarding will be required in accordance with standard detail INT/WG/1.

Additionally safety glazing will also be required if within 800mm of finished floor level.

Revisions:

| Ref. | Date | Details |
|------|----------|--|
| D | 03/01/17 | BT Customer splice point shown as clients markup, electric meter notes amended for Plots 38 & 102. |
| C | 31/10/16 | Entrance door style corrected |
| B | 30/09/16 | Gas meter box design amended |
| A | 18/08/16 | General amendments and manufacturer's comments incorporated as per letter dated 12/08/16 |



BELLWAY HOMES NORTHERN-HOME-COUNTIES MILTON-KENNES

Site Location: KINGSMERE KM5 & KM22

BICESTER

Drawing: AF2 - VERSION 1

LIFETIME HOMES

FRONT ELEVATION

SHEET 5 of 16

| | | | |
|-------------|---------|-------------|----------|
| Scale | 1:50 | Date | 08.02.16 |
| Drawing No. | 113/374 | Rev. | D |
| Drawn By. | CDA | Checked By. | CDA |
| Cad Ref: | | | |

THIS DRAWING IS A COPYRIGHT
All dimensions to be checked on site or in the workshop before work commences. Only figured dimensions to be worked to. Any discrepancies to be reported to the Architect.

Carlton Design Architecture Ltd
Architectural Consultants
7 The Old Dairy Buildings, Walsburn, Northamptonshire, NN22 8PQ.
tel: 01656 656533 Facsimile: 01656 656123
E MAIL: carlton.design@virgin.net


- Safety Glazing
- Obscure Glazing
- E - Escape Window

BT Customer splice point - BT entry point to external brickwork and internal spur point. Cable to run through the floor void to BT point (where fibre equipment is stored).

FRONT ELEVATION

WC extract - Plots 39, 40, 41, 66, 67, 69, 70, 100, 101, 124, 125, 126 & 127 only.

Electric box - Plots 20, 21, 22, 23, 38, 39, 40, 41, 100, 101, 102, 124 & 125 only.

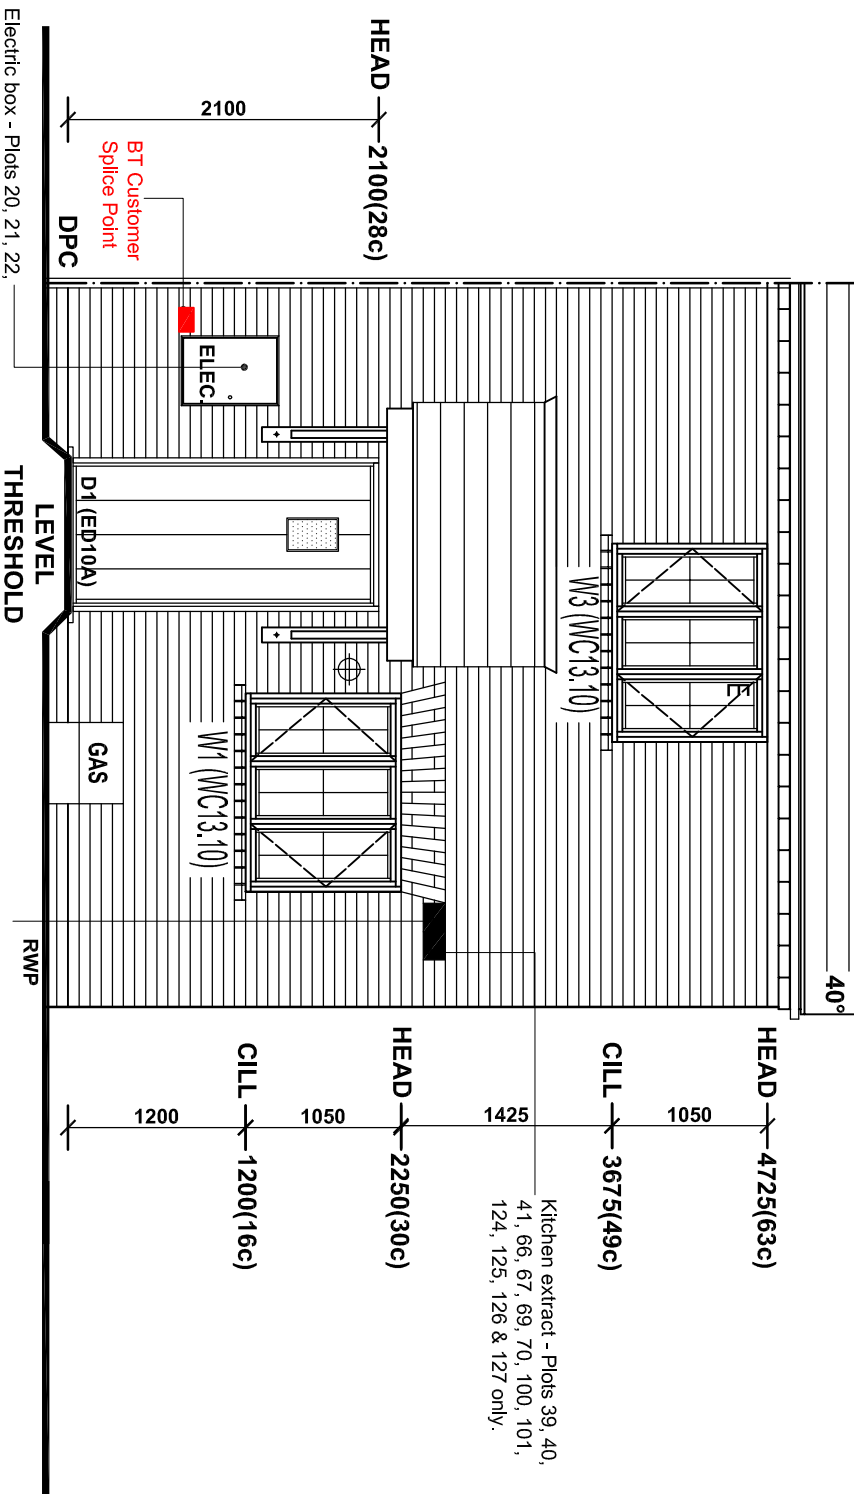

Kitchen extract - Plots 39, 40, 41, 66, 67, 69, 70, 100, 101, 124, 125, 126 & 127 only.

- Safety Glazing
- Obscure Glazing
- E - Escape Window

BT Customer splice point - BT entry point to external brickwork and internal spur point. Cable to run through the floor void to BT point (where fibre equipment is stored).

FRONT ELEVATION

WC extract - Plots 39, 40, 41, 66, 67, 69, 70, 100, 101, 124, 125, 126 & 127 only.

Electric box - Plots 20, 21, 22, 23, 38, 39, 40, 41, 100, 101, 102, 124 & 125 only.