




1. NEW SLATE ROOF
2. OFF WHITE BRICKWORK
3. PPC ALUMINIUM FRAME WINDOWS
4. BRONZE EFFECT SPANDREL PANEL
5. PPC ALUMINIUM FRAMED WINDOW/DOOR WITH BRONZE EFFECT SPANDREL ABOVE
6. OFF WHITE RENDER
7. GLAZED AUTOMATIC DOORS WITH BRONZE CLADDING ABOVE
8. PPC ALUMINIUM FRAMED DOORS
9. ~~NEW PAINTED TIMBER FRAMED WINDOW~~
10. DARK GREY BRICKWORK
11. PPC ALUMINIUM VERTICAL LOUVRES
12. BRONZE EFFECT SHINGLE METAL CLADDING
13. PPC ALUMINIUM FASCIA
14. GLAZED CURTAIN WALLING
15. ~~PPC ALUMINIUM BIFOLD DOORS~~
16. ~~LARGE PIVOT BRONZE EFFECT FEATURE DOOR~~
17. BRONZE EFFECT COLUMNS
18. METAL ROOF TRUSS
19. PPC ALUMINIUM COPING
20. ~~FIXED GLASS BALUSTRADE~~
21. PPC ALUMINIUM BRONZE EFFECT CANOPY

Canopy Link - Proposed Section AA
1 : 100



NOTE:
TO BE READ IN CONJUNCTION WITH DESIGN AMENDMENT SCHEDULE FOR DESIGN DEVELOPMENT CHANGES TO APPROVED PLANNING SCHEME. TO BE READ IN CONJUNCTION WITH CORDE APPROVED PLANNING DOCUMENTS - 1700PTMA

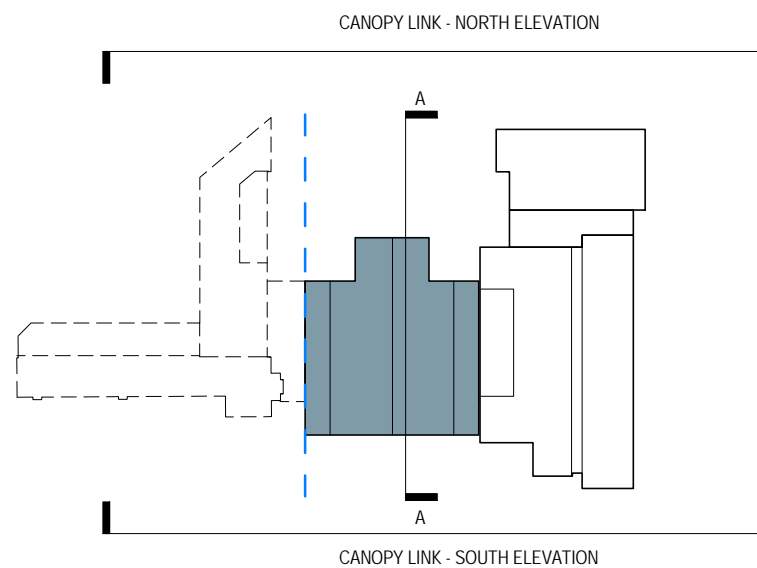

Canopy Link - Proposed North Elevation
1 : 100

| | | | | | 5 | 10 |
|----------|----------|---|-------|---------|---|----|
| REVISION | DATE | DESCRIPTION | DRAWN | CHECKED | | |
| S2-C 1 | 12.02.18 | Issued to Client/Planning Consultant | RG | ADP | | |
| S2-C 2 | 23.02.18 | Planning Issue to Client/ Planning Consultant | RG | ADP | | |
| S2-C 3 | 21.03.18 | Planning Issue to Client/ Planning Consultant | RG | ADP | | |

CHECK ALL DIMENSIONS AND VERIFY ON SITE. REPORT ANY ERRORS OR OMISSIONS

CONSTRUCTION

CORDE

Canary House
Park End Street Oxford OX1 1JD
T +44 (0) 1865 248045
E info@corde.co.uk
www.corde.co.uk


JOB TITLE:
HEYFORD PARK
DORCHESTER LIVING

DRAWING TITLE:
CANOPY LINK - PROPOSED ELEVATIONS

SCALE:
As indicated

DRAWING SHEET SIZE:
A1

| | | |
|---------------------|--|---------------------|
| JOB CODE: CD3216 | DRAWING NUMBER: CRD-02-ZZ-DR- A-05045 | REVISION: S2-C 3 |
|---------------------|--|---------------------|

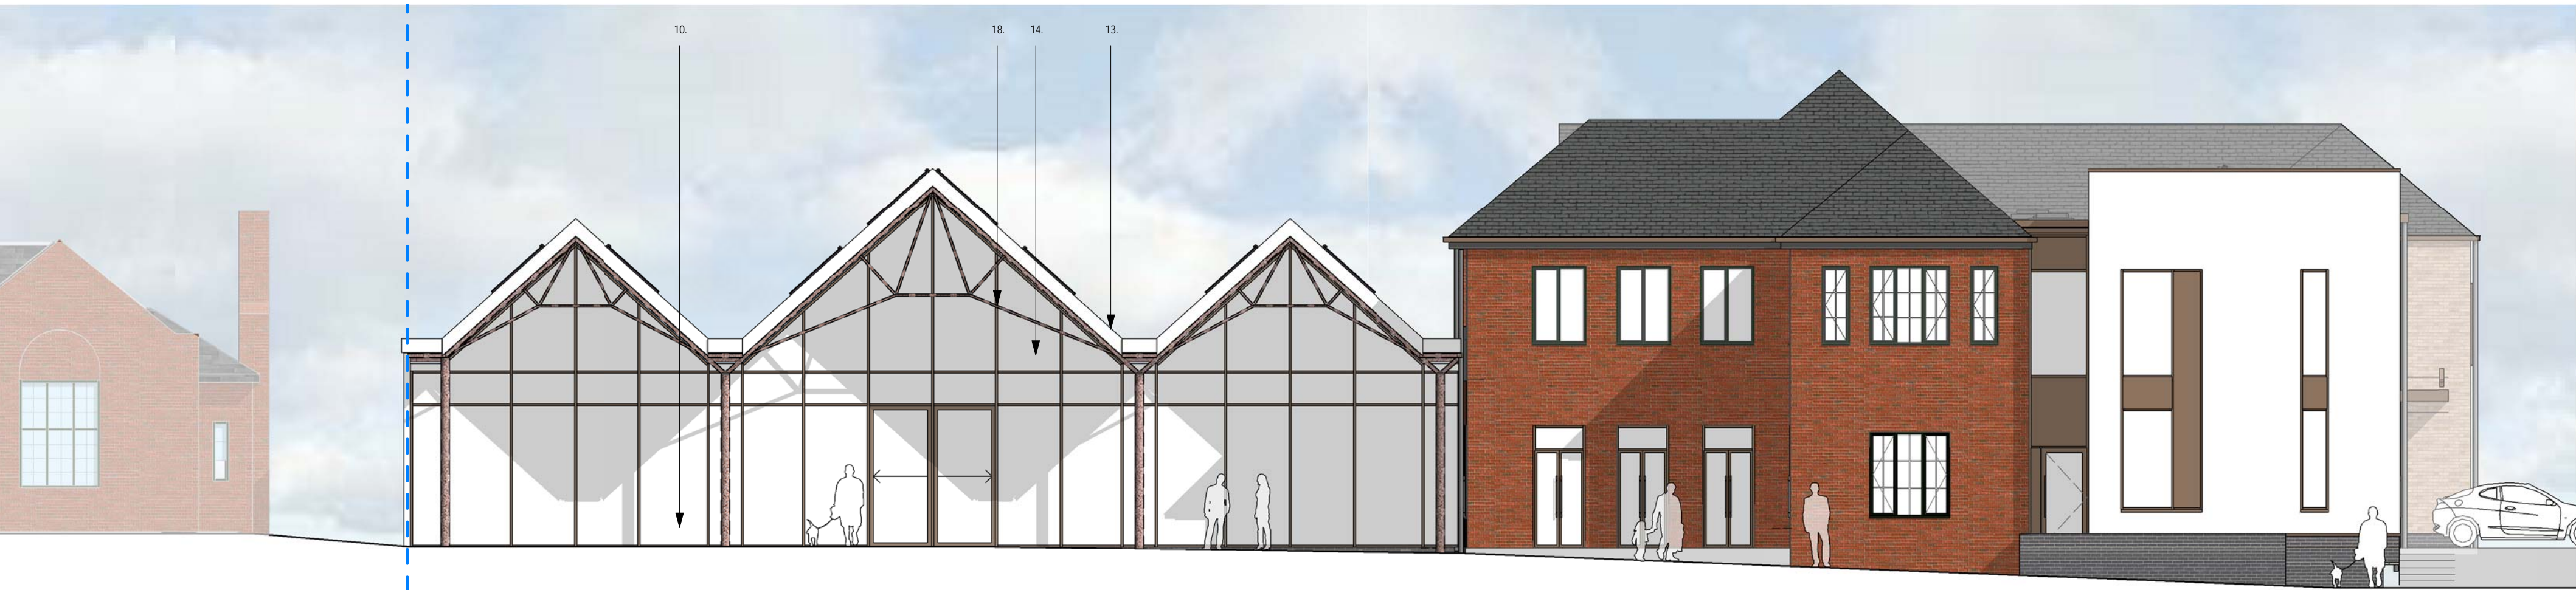

Canopy Link - Proposed South Elevation
1 : 100