



Building 455 - Proposed North Elevation
1 : 100



Building 455 - Section AA
1 : 100





Building 455 - Proposed South Elevation
1 : 100



Building 455 - Section BB
1 : 100

1. NEW SLATE ROOF
2. OFF WHITE BRICKWORK
3. PPC ALUMINIUM FRAME WINDOWS
4. BRONZE EFFECT SPANDREL PANEL
5. PPC ALUMINIUM FRAMED WINDOW/DOOR WITH BRONZE EFFECT SPANDREL ABOVE
6. OFF WHITE RENDER
7. GLAZED AUTOMATIC DOORS WITH BRONZE CLADDING ABOVE
8. PPC ALUMINIUM FRAMED DOORS
9. ~~NEW PAINTED TIMBER FRAMED WINDOW~~
10. DARK GREY BRICKWORK
11. PPC ALUMINIUM VERTICAL LOUVRES
12. BRONZE EFFECT SHINGLE METAL CLADDING
13. PPC ALUMINIUM FASCIA
14. GLAZED CURTAIN WALLING
15. ~~PPC ALUMINIUM BL FOLD DOORS~~
16. ~~LARGE PIVOT BRONZE EFFECT FEATURE DOOR~~
17. BRONZE EFFECT COLUMNS
18. METAL ROOF TRUSS
19. PPC ALUMINIUM COPING
20. ~~FIXED GLASS BALUSTRADE~~
21. PPC ALUMINIUM BRONZE EFFECT CANOPY

NOTE:
TO BE READ IN CONJUNCTION WITH DESIGN AMENDMENT SCHEDULE FOR DESIGN DEVELOPMENT CHANGES TO APPROVED PLANNING SCHEME. TO BE READ IN CONJUNCTION WITH CORDE APPROVED PLANNING DOCUMENTS - 1700091NMA

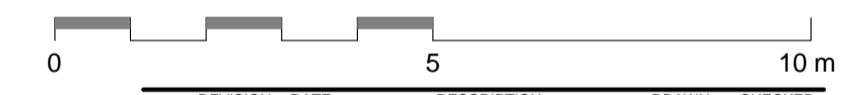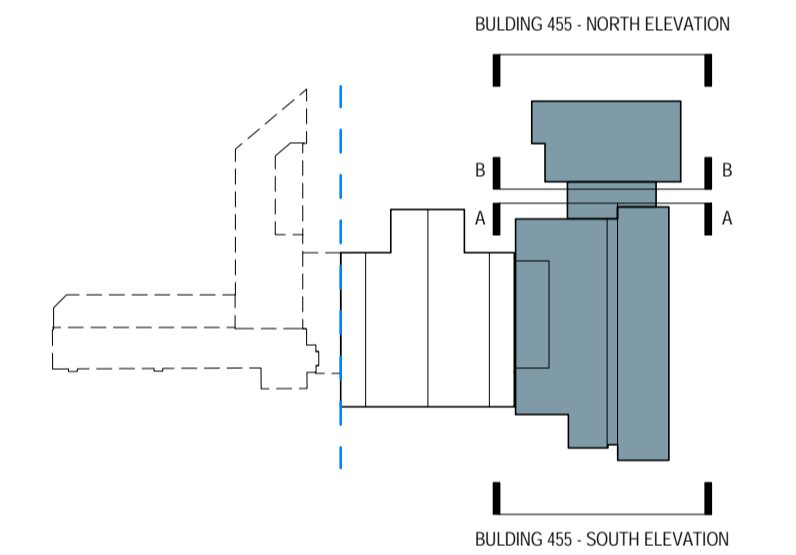

REVISION	DATE	DESCRIPTION	DRAWN	CHECKED
S2-C 1	12.02.18	Issued to Client/Planning Consultant	RG	ADP
S2-C 2	23.02.18	Planning Issue to Client/Planning Consultant	RG	ADP
S2-C 3	21.03.18	Planning Issue to Client/Planning Consultant	RG	ADP
S2-C 4	24.04.18	Planners Comments Incorporated. Planning Issue to Client	RG	ADP

CHECK ALL DIMENSIONS AND VERIFY ON SITE. REPORT ANY ERRORS OR OMISSIONS

CONSTRUCTION

CORDE

Charity House
Park End Street Oxford OX1 1JD
T +44 (0) 1865 248045
E info@corde.co.uk
www.corde.co.uk

JOB TITLE:
**HEYFORD PARK
DORCHESTER LIVING**

DRAWING TITLE:
BUILDING 455 - PROPOSED ELEVATIONS

SCALE:
As indicated

DRAWING SHEET SIZE:
A1

JOB CODE: CD3216	DRAWING NUMBER: CRD-01-ZZ-DR- A-05036	REVISION: S2-C 4
----------------------------	---	----------------------------

This line should measure 100mm along x and y axis when printed