


0 10m 20m SCALE 1:500

A41

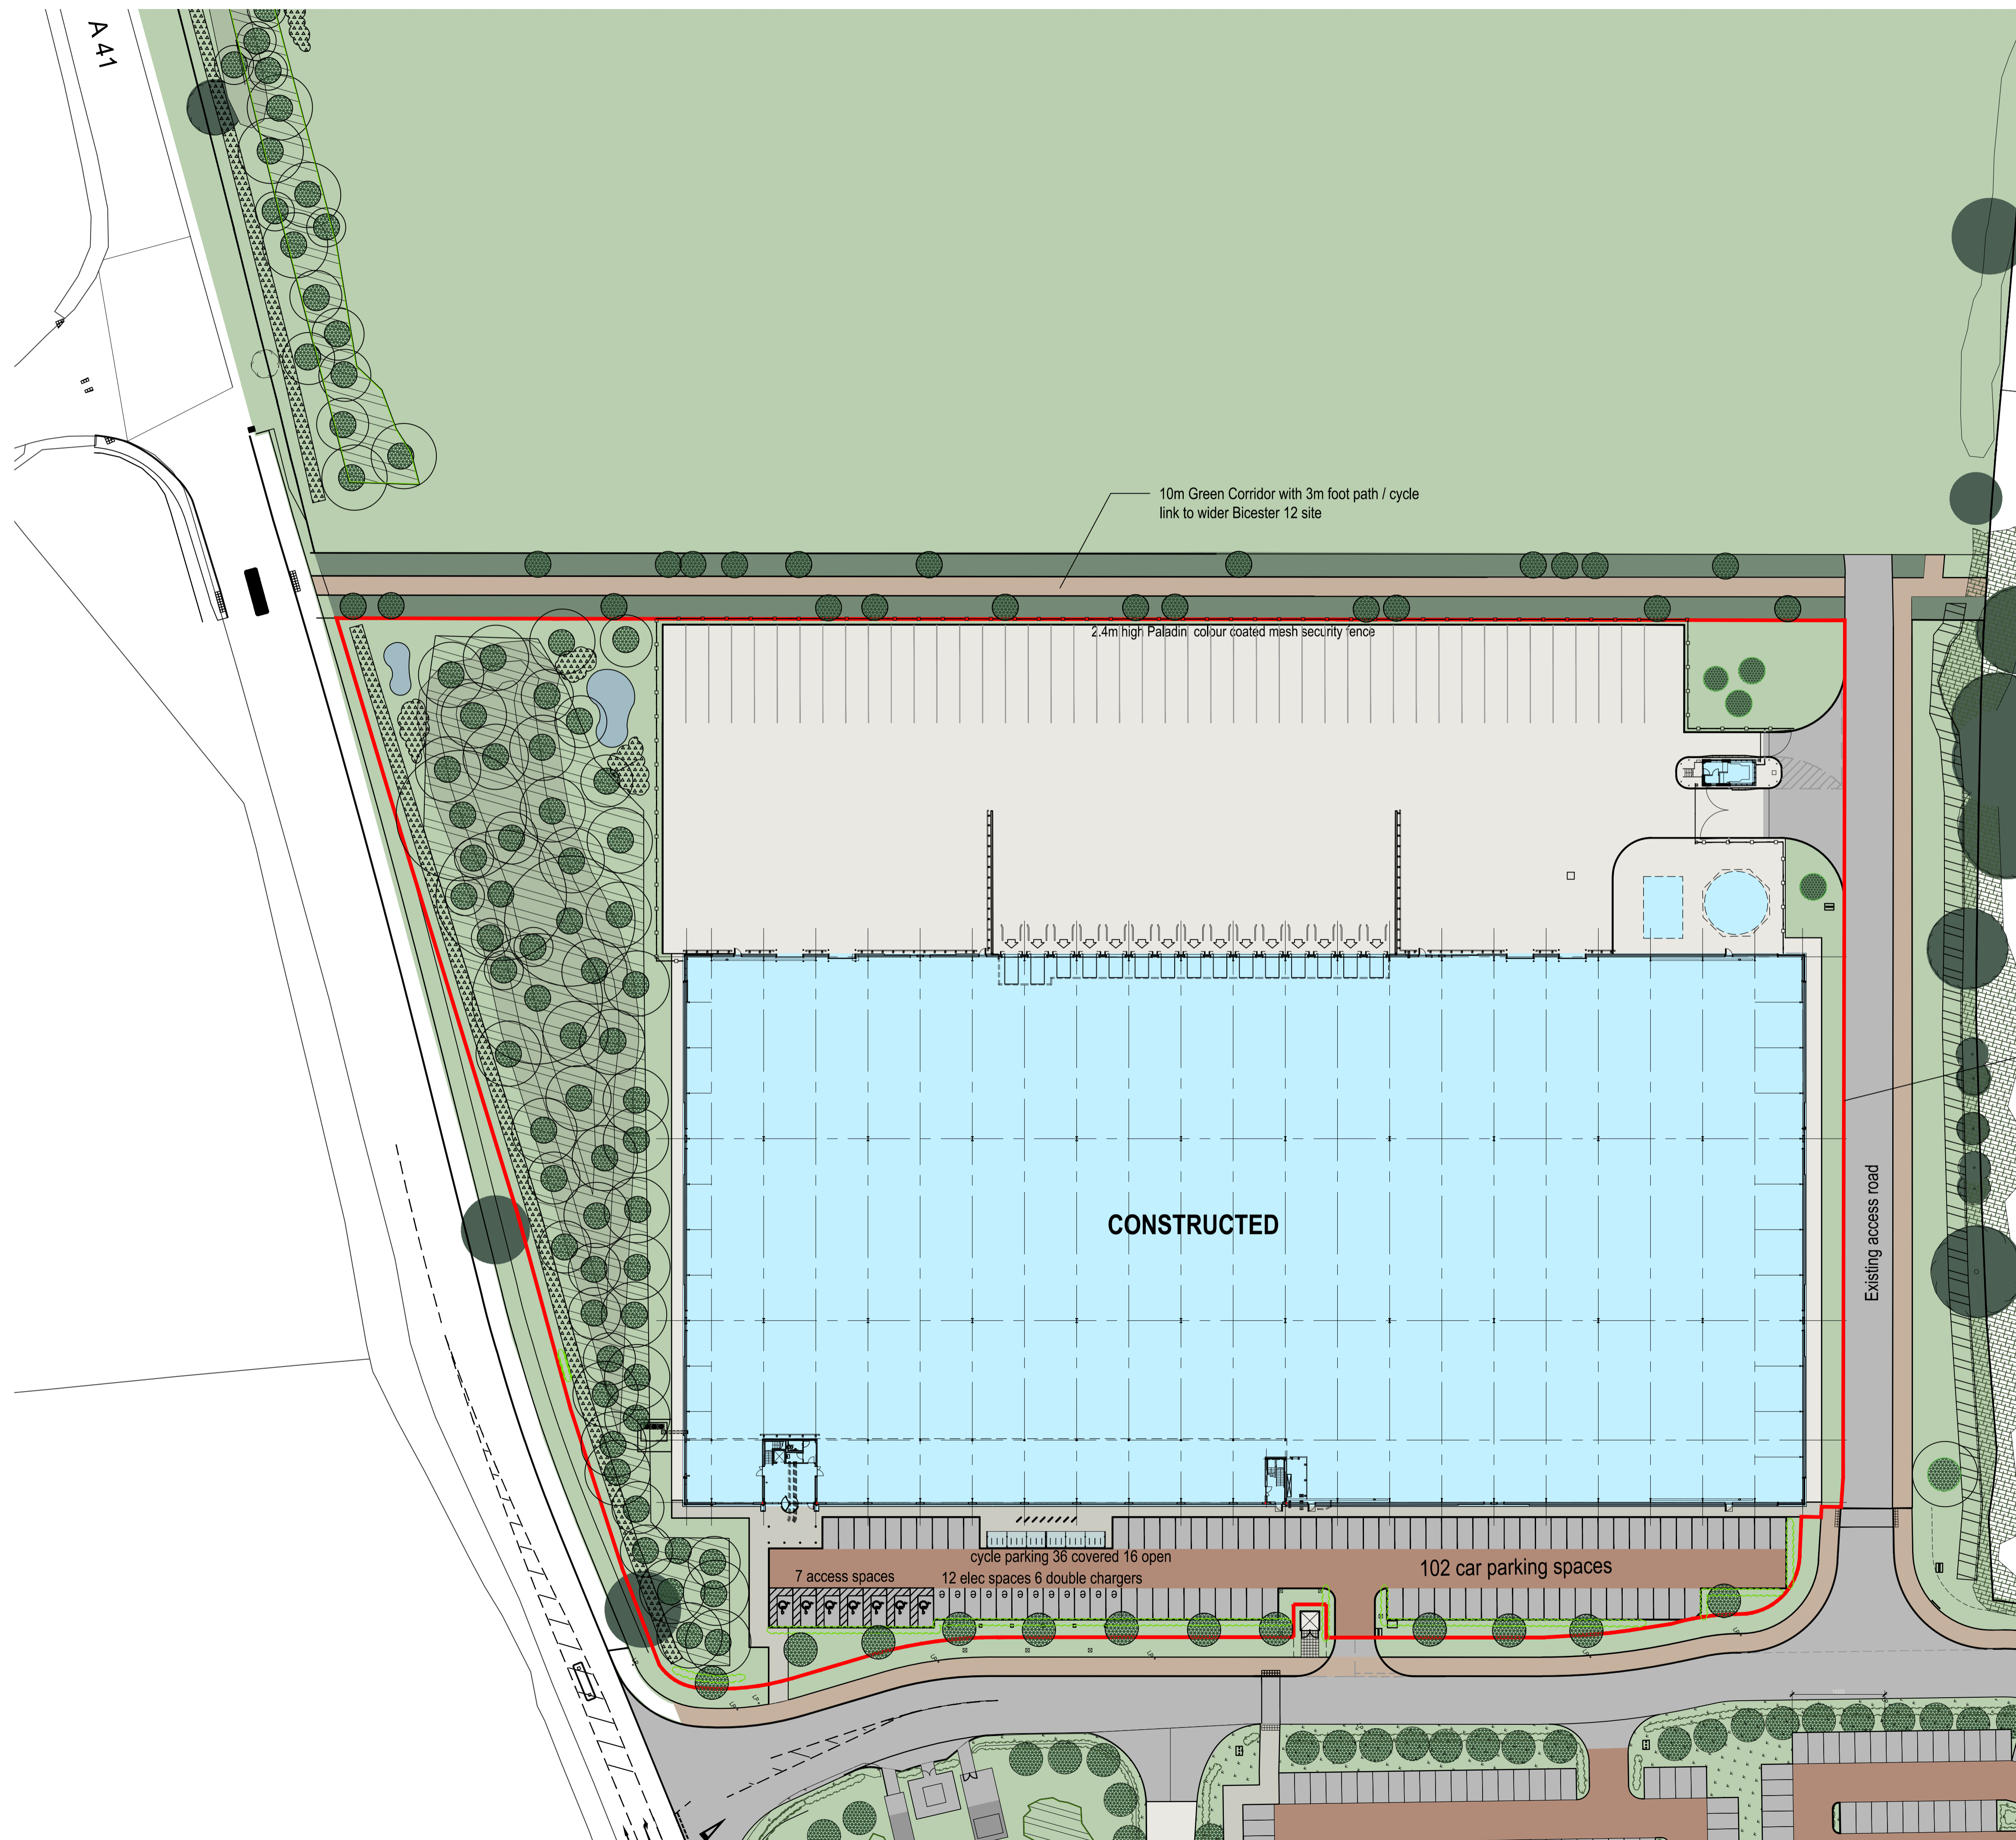

Plot B Site Demise Boundary Line

Existing access road

CONSTRUCTED

10m Green Corridor with 3m foot path / cycle link to wider Bicester 12 site

2.4m high Paladin colour coated mesh security fence

7 access spaces 12 elec spaces 6 double chargers cycle parking 36 covered 16 open 102 car parking spaces

Existing Site & Unit As Constructed & Approved under planning consent ref: 1/00091/F dated 12.07.2018



P3: Notes added 27.09.19 sh
P2: minor amendments 25.09.19 sh
P1: first issue 23.09.19 sh
Rev: _____ Date/Checked

php architects

The Old Rectory Rectory Lane Milton Malzor
NORTHAMPTON NN7 3AQ
t: +44 (0)1604 858916 f: +44 (0)1604 859123
www.peter-haddon.com



UNIT B SITE EXPANSION & EXTERNAL WORKS
SYMMETRY PARK
A41, BICESTER

Issue Purpose: _____
Drawn by: SPH Checked by: RM
Scale @ A1: 1:500 Date: NOVEMBER 2020

PLOT B - SITE PLAN AS EXISTING

CAD ref: 4036-BC-102 A Dwg no.: 4036-B10-102 P3

Copyright reserved. Dimensions to be checked on site. Discrepancies to be reported before proceeding