
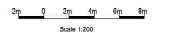


FEASIBILITY	FOR INFORMATION	FOR COMMENT	PRELIMINARY	PLANNING	BUILDING REGULATIONS	TENDER	CONSTRUCTION ISSUE	AS BUILT

- 1 drawing and content copyright © of BeswickPartnership and should not be reproduced in whole or in part or used in any manner whatsoever without prior written permission
- 2 all dimensions to be checked on site prior to construction work commencing and any discrepancies reported to CA
- 3 above scale of drawing

rev: date: description:  
 A: 02/09/17/15 landscape area added  
 B: 20/07/16 Minor adjustments to layout

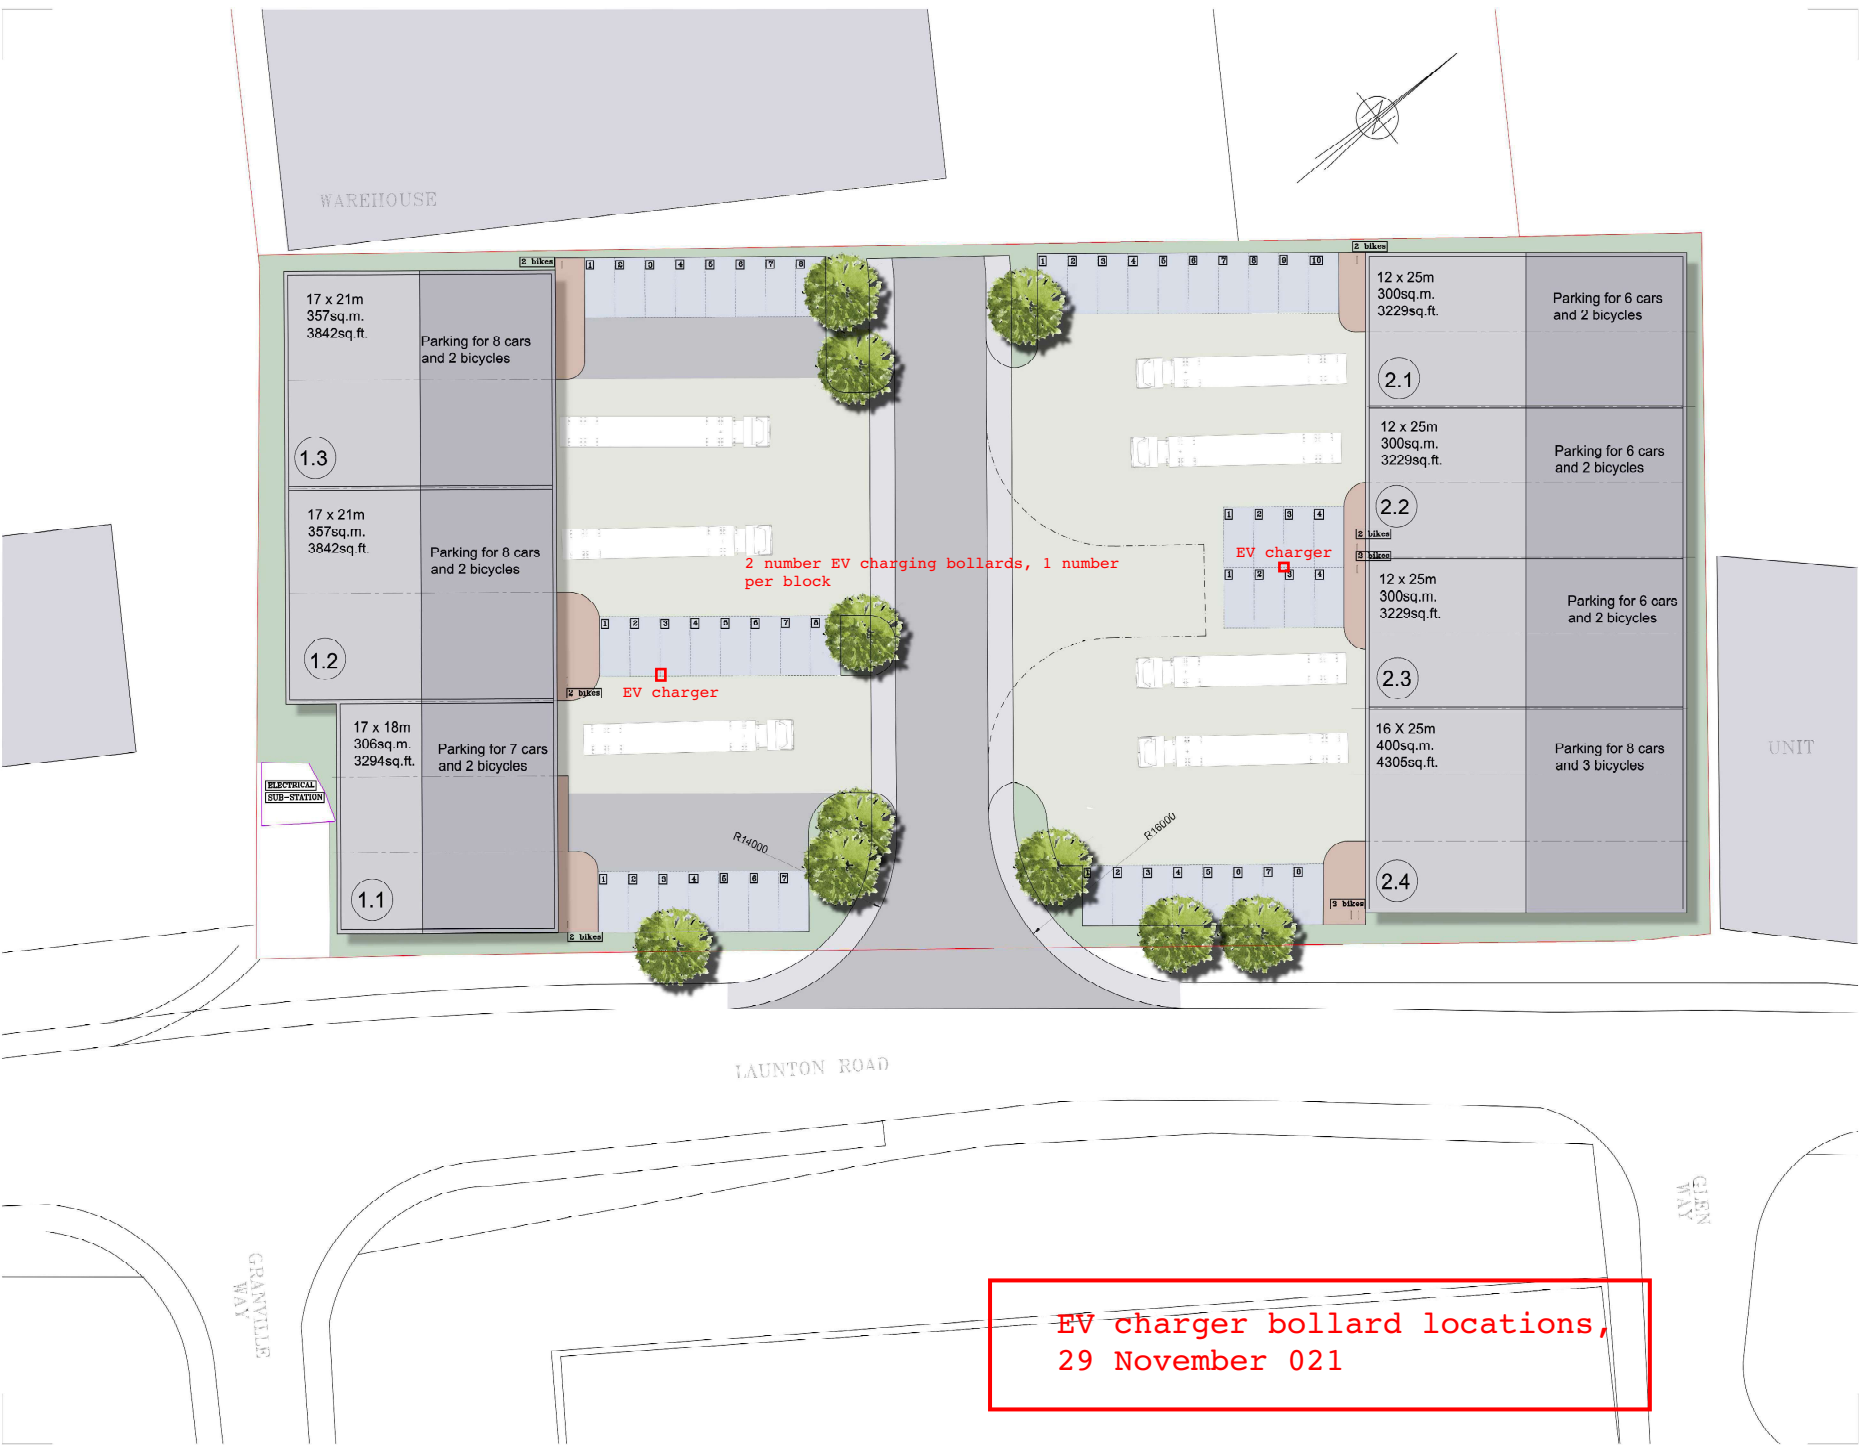

**BESWICK PARTNERSHIP LIMITED**  
**CHARTERED ARCHITECTS**  
 SUN STREET TEWESBURY  
 CLOUDESTON ROAD, CLOS BVA  
 T: 01664 295888  
 e: mail@bpaarchitecture.co.uk  
 www.bpaarchitecture.co.uk

client: **morleys**

project: **REDEVELOPMENT OF LAND AT ARKWRIGHT ROAD BICESTER, OX20 4UU**

drawing title: **SITE LAYOUT PLAN AS PROPOSED**

scale: 1:200 @ A1 date: 20/07/16  
 drawn by: DD checked by: RAB

drawing number: 210,34 - 51 revision: B

