







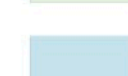





# Mark & Melanie Adams
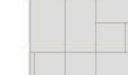
## Nicholsons Proposal - Masterplan

Key:

-  - Gravel
-  - Mixed Planting
-  - Paving
-  - Hedging
-  - Brick
-  - Proposed Tree
-  - Lawn
-  - Topiary
-  - Water
-  - Existing Tree
-  - Shrubs
-  - Proposed Evergreen

Proposed location for air source heat pumps  
 Evergreen trees conceal power pole.

Proposed location of hot tub to be placed in corner of terrace.


Existing stone feature relocated.

Proposed pool.


6 seat dining set.

Fire pit area with seating.

Existing fenceline.

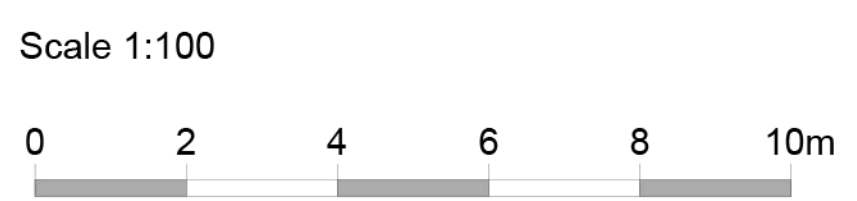

Soils to be placed to 450mm overall depth in shrub areas and 600mm in tree pits. Soils should be placed in 150mm layers, firming as you go, over compaction free, well draining subsoil.

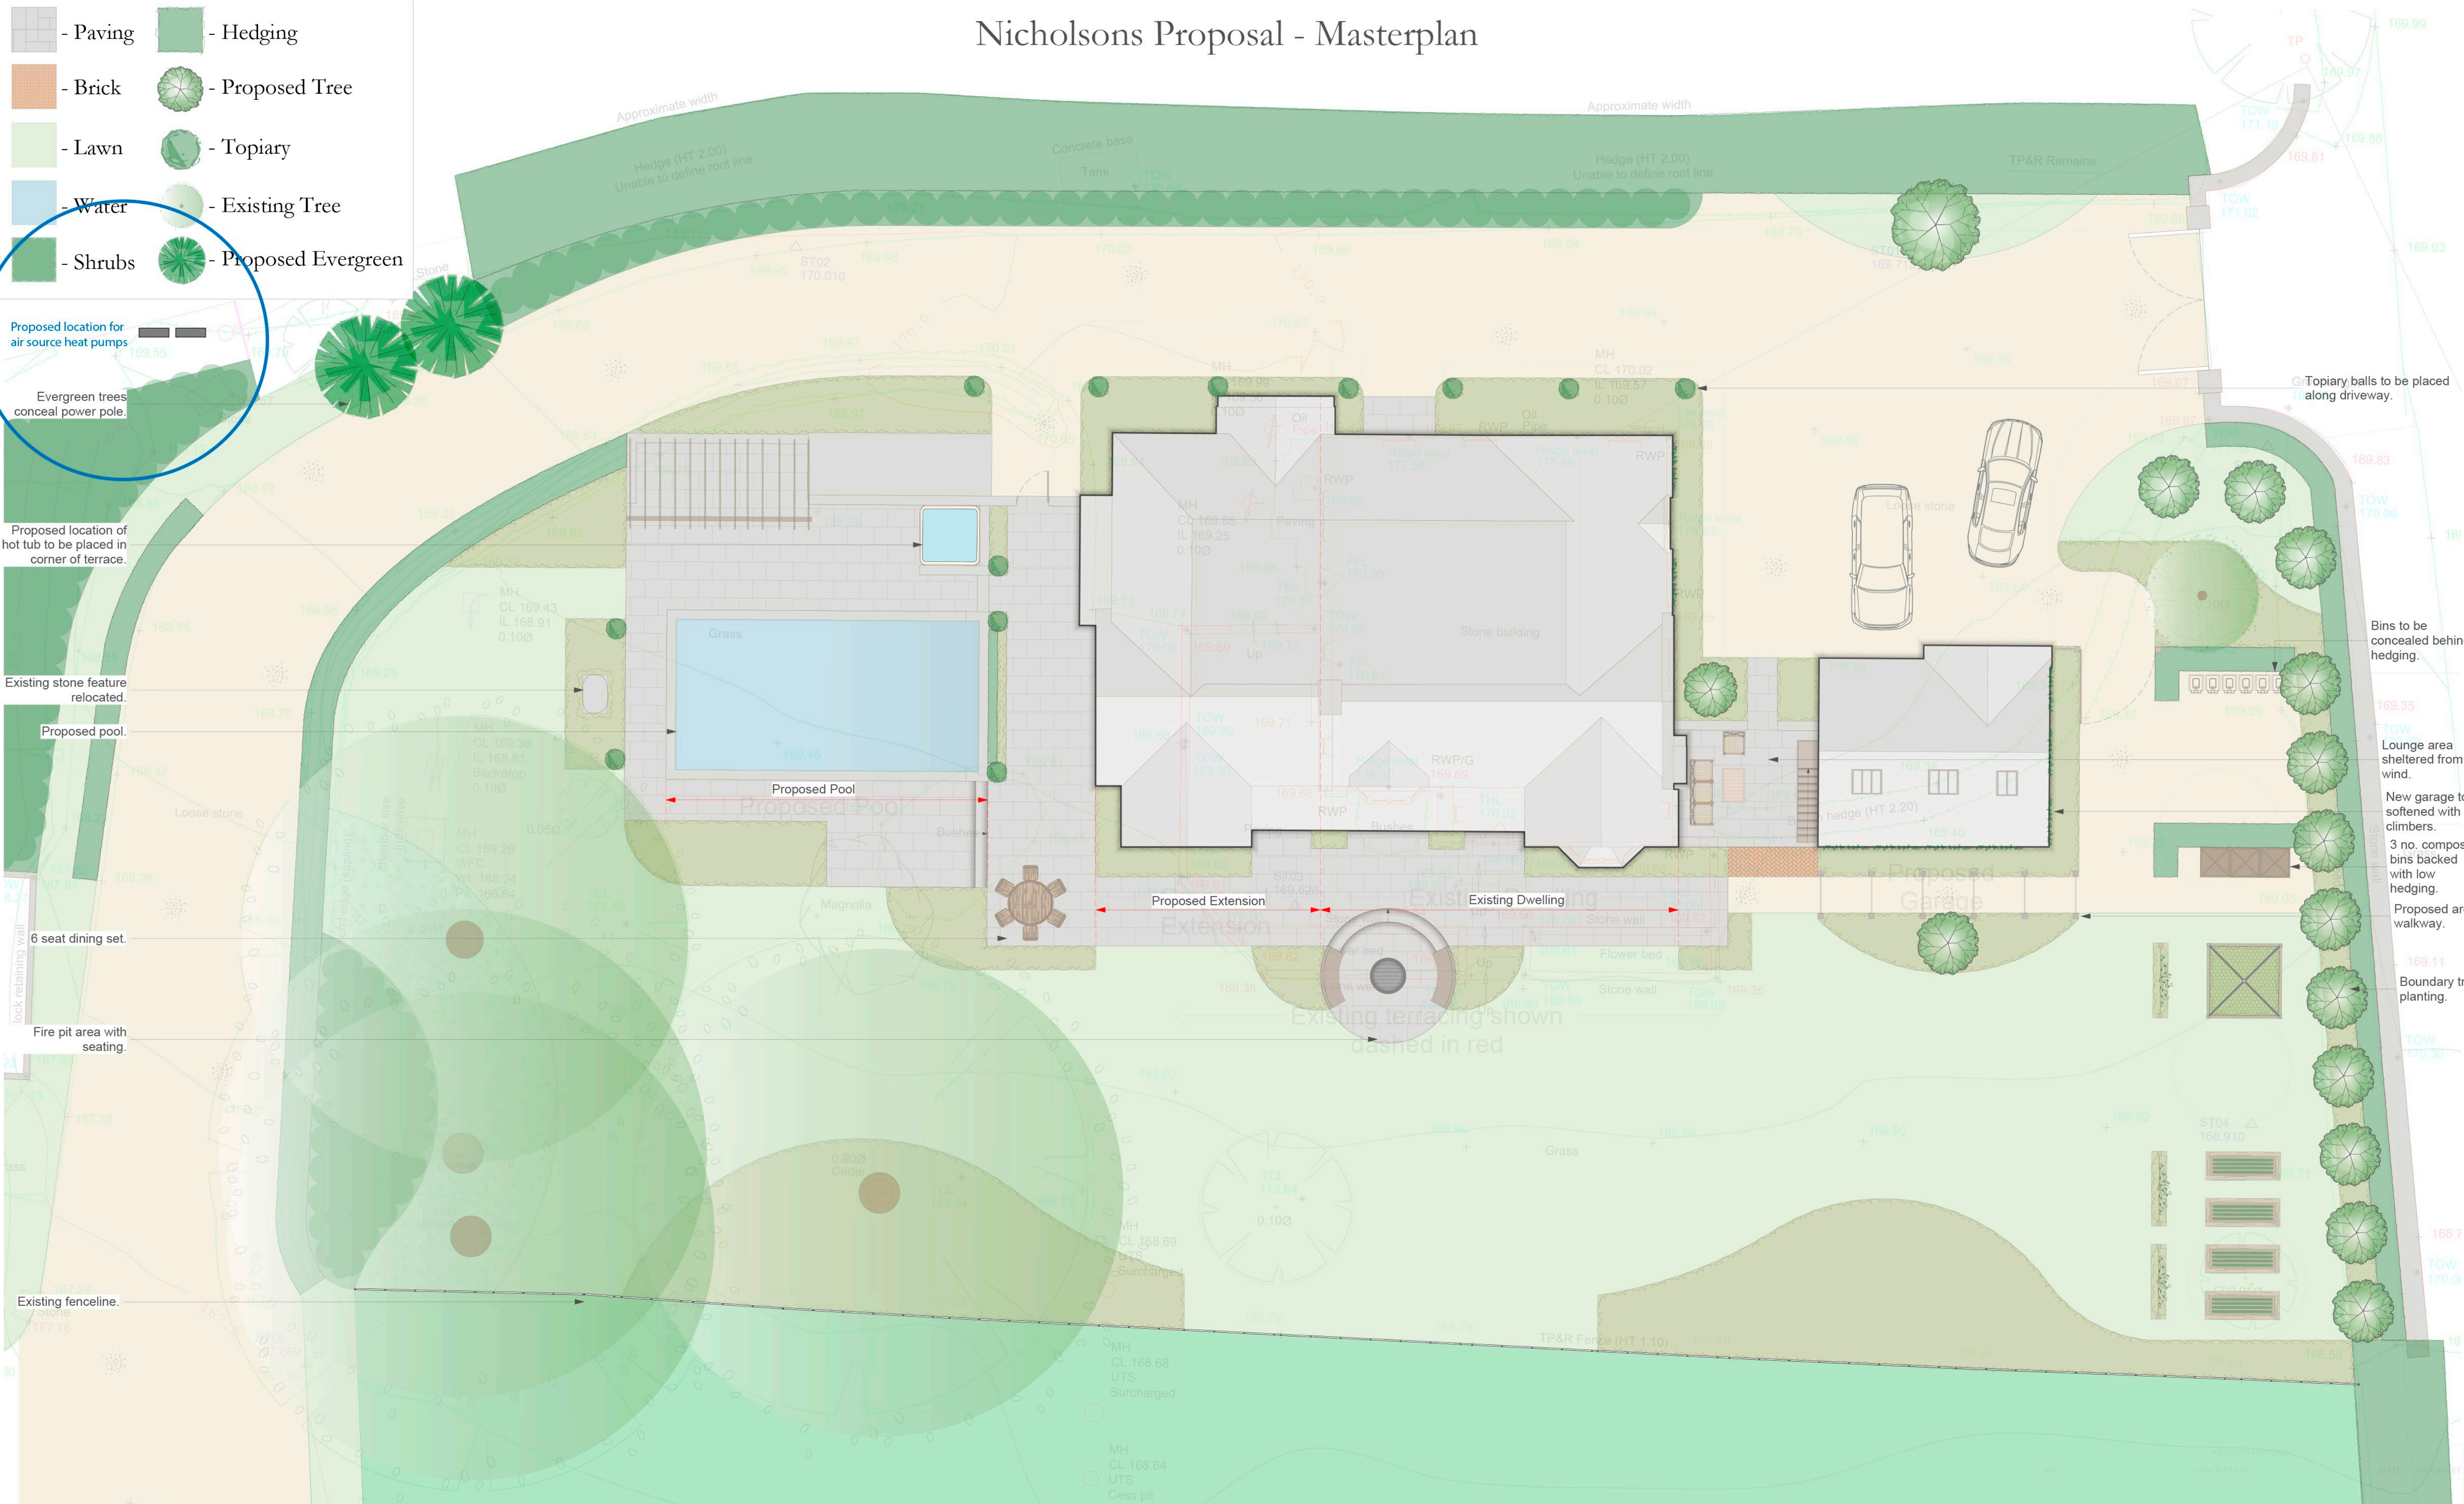

Topiary balls to be placed along driveway.

Bins to be concealed behind hedging.

Lounge area sheltered from wind.


New garage to be softened with climbers.

3 no. compost bins backed with low hedging.

Proposed arch walkway.

Boundary tree planting.

Tyack Architects mark up - Proposed Air Source Heat Pumps 26-01-2022

	<b>NICHOLSONS</b> The Park, North Aston, Bicester, Oxfordshire. OX25 6HL. 01869 340342 www.nicholsonsgb.com		
	Mark & Melanie Adams	1:100	A1
	Shortlands Park Stud	26/11/2021	WB DKM
	Nicholsons Proposal - Masterplan	Adams.NL.21.03	