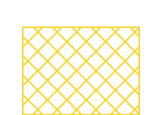
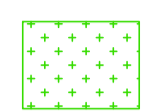



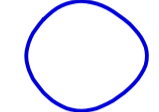
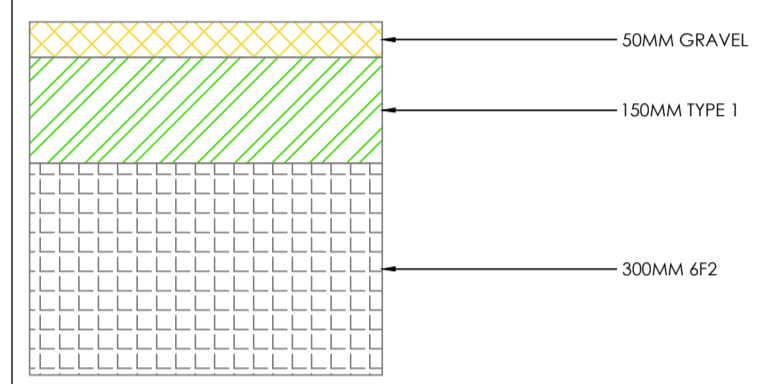


Notes:

KEY:

- GRAVEL 
- GRASS 
- PAVING 
- MULCH 
- TIMBER KNEE RAIL 
- TREE 

GRAVEL CAR PARK DETAIL (NTS)



50MM GRAVEL  
150MM TYPE 1  
300MM 6F2

Base layer taken from an as built survey of Heyford Park

REV:	DESCRIPTION:	BY:	DATE:
STATUS:		INFORMATION ISSUE	
CLIENT: DORCHESTER LIVING LTD CAMP ROAD HEYFORD PARK OX25 5HD			
ARCHITECT:			
SITE: HEYFORD PARK			
TITLE: HOTEL CAR PARK			
SCALE AT A1: 1:200 @ A1	DATE: 22/06/22	DRAWN: RS	CHECKED: RS
PROJECT NO: 001	DRAWING NO: 001	REVISION: -	