

All dimensions to be checked on site.

Do not scale dimensions from this drawing, use figured dimensions.

Refer to Engineer's drawings and specification for all structural and services information.

Any discrepancies between the Architect's and Engineer's drawings to be reported to the Architect immediately.

The survey information shown on this drawing is based on a survey prepared by a third party and NCA Architects accept no responsibility for the accuracy or completeness of the survey.

These drawings have been amended to attain Record drawing status based on information received from the Main Contractor.

Note: Detailed design information for Various components / constructions are indicated on separate specialist sub-contractor drawings, & may supersede the information shown on this drawing.

Warehouse corrugated metal roof finish.

Existing brown metal cladding band at roof eaves.

Grey coloured PPC Frame

Timber brise soleil to mitigate solar gain of new reception.

Grey Cladding panels.


Timber effect cladding.

Workshop buildings within service yard.


Timber effect clad wall to warehouse and assembly line .

New Aluminium Framed Windows.

Spandrel panel between ground and first floor windows.

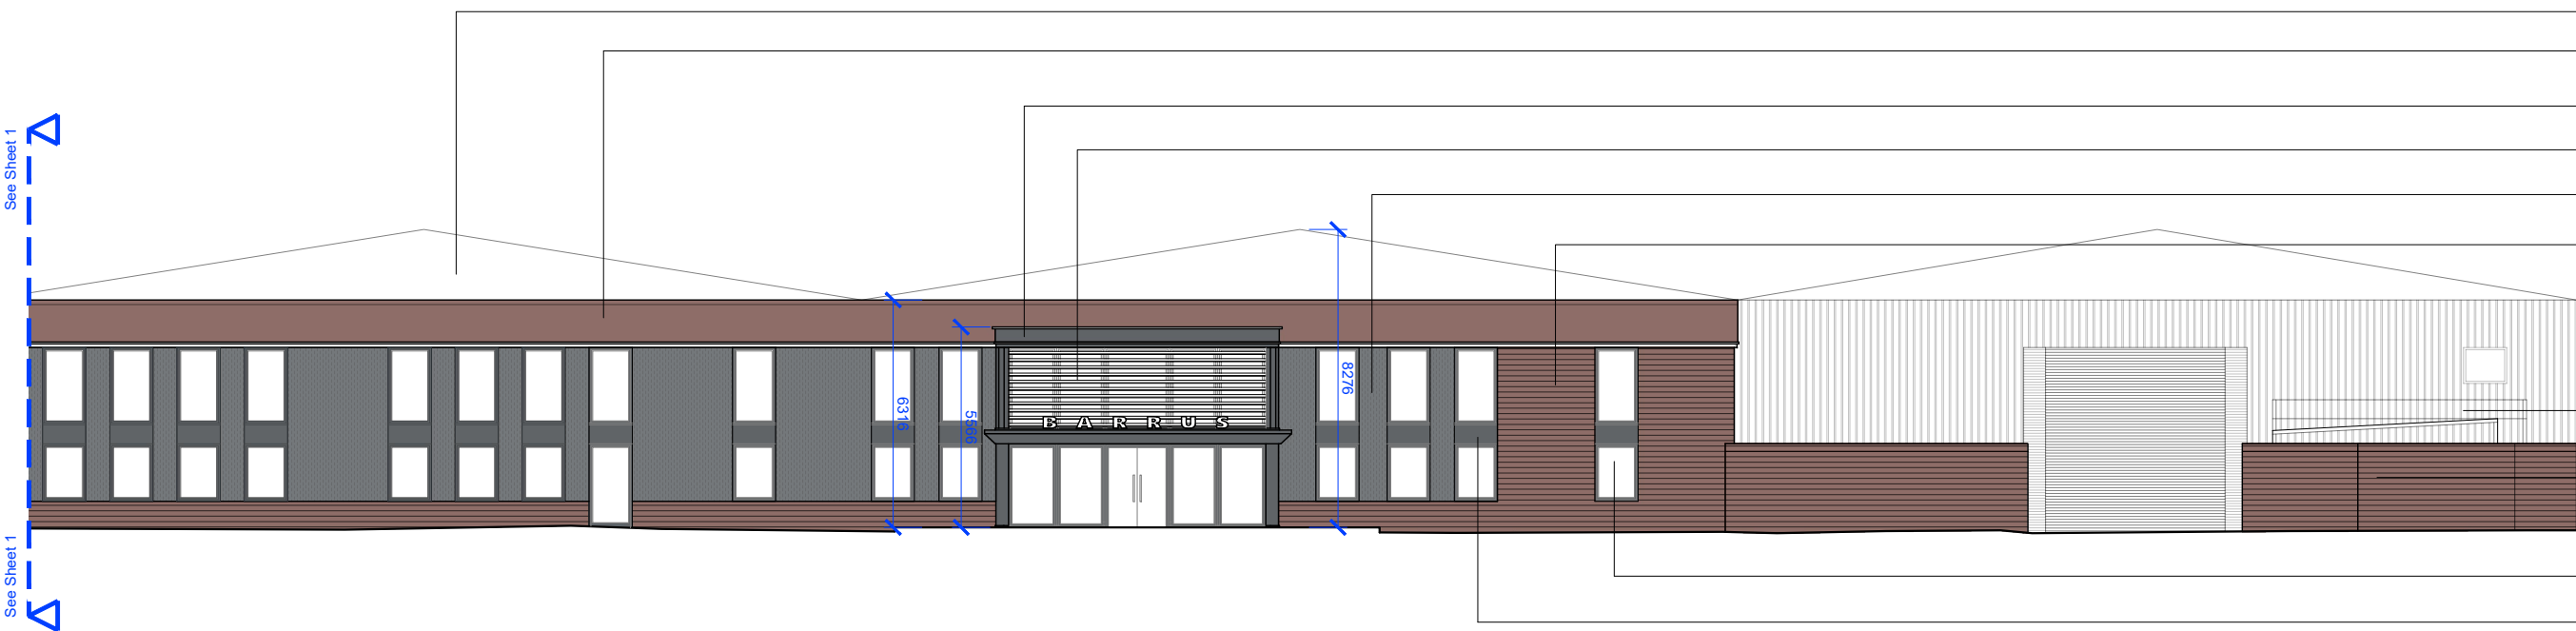

Front Elevation 1:200

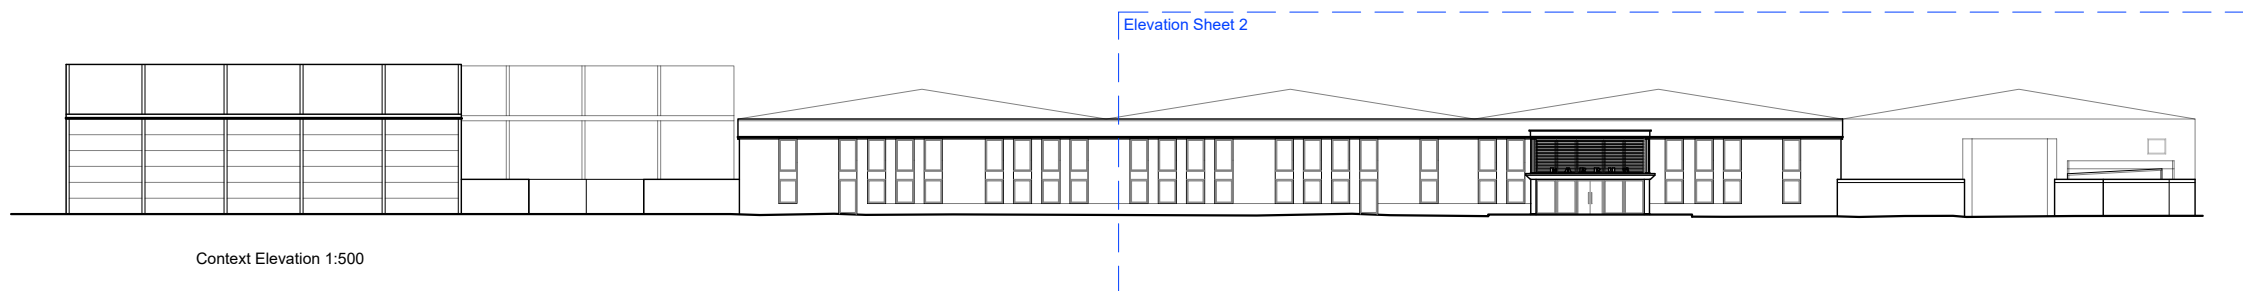

Context Elevation 1:500



C 12.05.23 Service Yard Revised

Rev Date Description

nca-architecture

tel: 01869 226610

email: enquiries@nca-architecture.co.uk
www.nca-architecture.co.uk

7 Court Farm Barns
Medcroft Road
Tackley, OXON
OX5 3AL

Barrus, Bicester

Date: **12.09.2022**

Scale: **1:200/500@A3**

Proposed Elevations

Status: **Preliminary**

Front Elevation

Drawn: **JC**

Sheet 2

220025 - A - PR - 104

Revision: **C**