


REVISIONS:

NOTES:

Red line denotes existing development, including consented extension ref. 22/01576/F

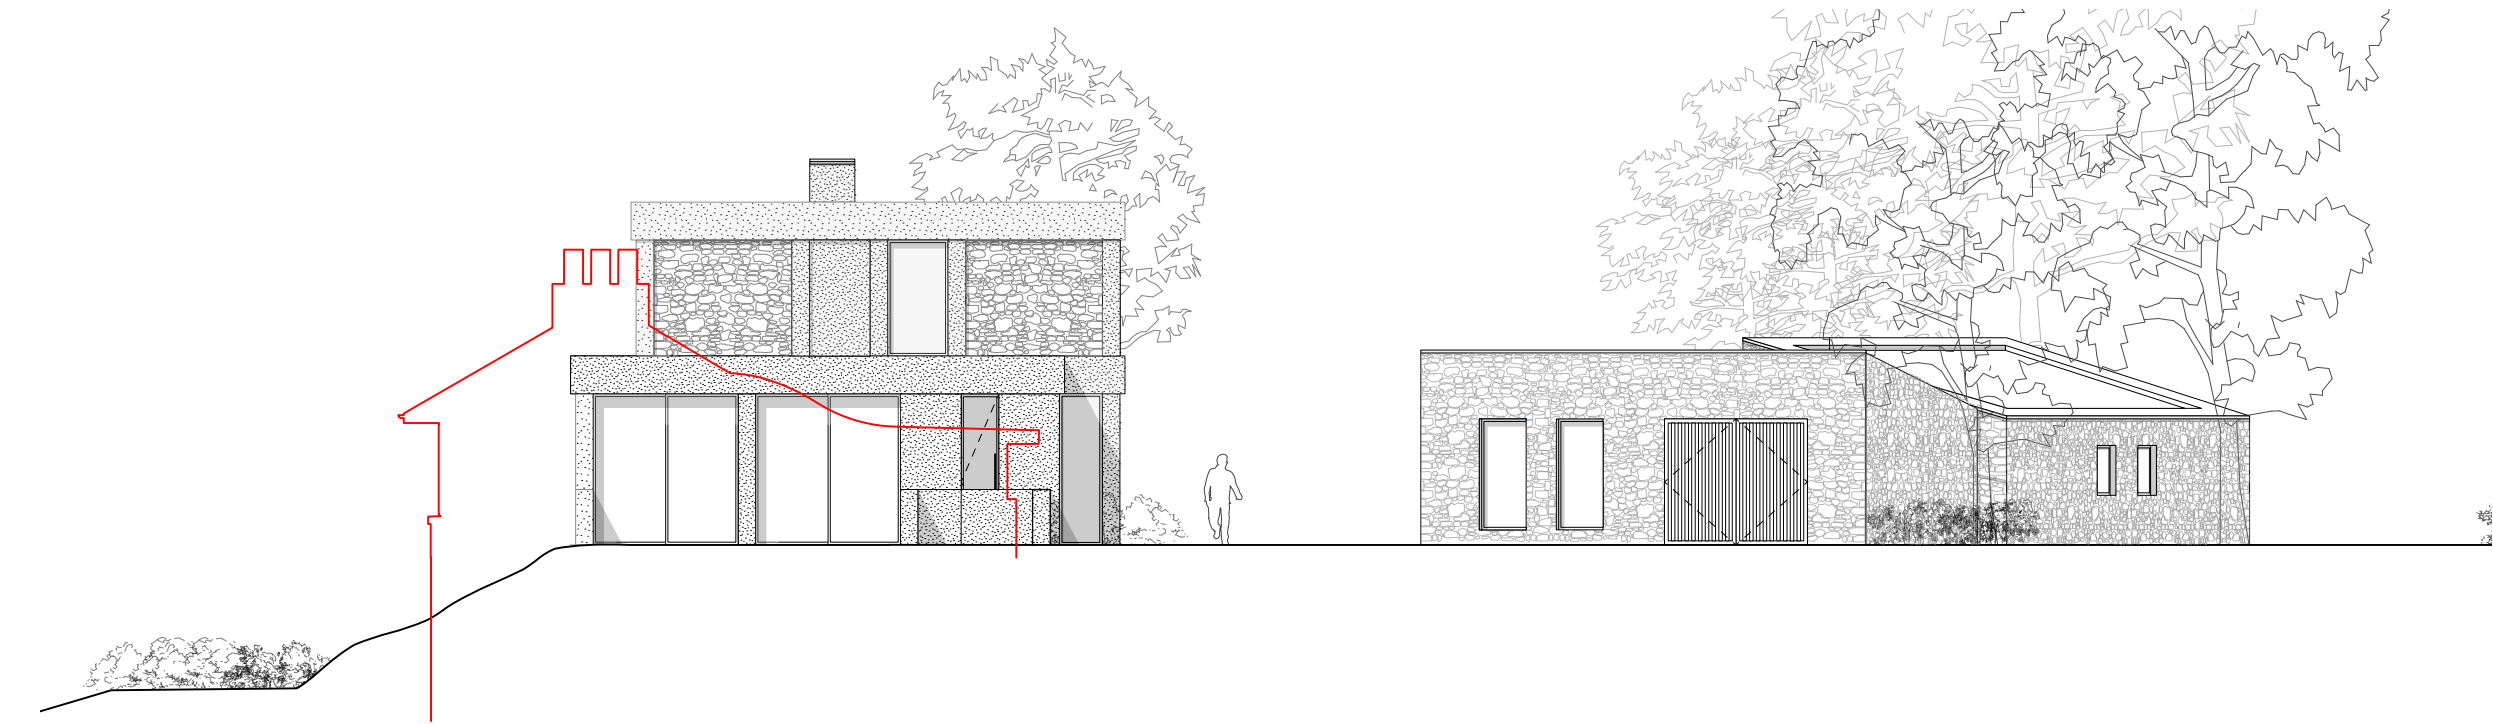

PROJECT:  
Longview House

DRAWING TITLE:  
Proposed Main House North & South  
Companion Elevations (with consented ext)

STATUS:  
Planning

NOTE:  
Do not scale from the drawing. Any discrepancies to be reported to the architect.  
All dimensions will be taken on site prior to ordering and construction.  
Copyright remains with the architect.  
This drawing is to be read in conjunction with the specification and all other relevant drawings.

JAMES  
GORST  
ARCHITECTS

The House of Detention  
London  
EC1R 0AS  
t 020 7336 7140  
f 020 7336 7150  
e info@jamesgorstarchitects.com

0m 3m 6m

SCALE:	DRAWING NUMBER:	REVISION:
1:150 at A3	PR GA 2006	P 1