



Legend

- Site Boundary
- Foam Filled Pipeline
- Fuel Dispenser Point
- Fuel Dispenser No Evidence Found
- Pipeline Cleaned But Not Filled
- Pipeline No Evidence Found
- POL Location
- POL Location With Type-1 Tank(s)
- Pre-Existing Valve Pits
- Trial Pit - With Pipe Cut & Filled - Pathway Break
- Trial Pit - No Evidence of Pipework
- USTs (Filled In-Situ)
- USTs (Known But Not Filled - No Access)
- Interceptor
- ASTs (Cleaned Only)
- Perimeter Locations

Notes:

1. For detail on individual tanks please see Completion Report:-

Appendix C
 a. Summary Sheet - POL Tanks
 b. Summary Sheet - Additional AST & UST Tanks

2: This Drawing shows Approximate Locations Only

B	USTs, ASTs & POL 1 Pipes Updated	MRG	28-02-12
A	Pipes Updated to As-Built Configuration	MRG	14-02-12
	FIRST ISSUE		30-01-12

Rev.	Description	Revised By	Date
------	-------------	------------	------

Vertase F.L.I.

- Bristol Head Office: Tel: 01275 397600 Fax: 01275 397601
- Sheffield Office: Tel: 01246 813289 Fax: 01246 812953
- Hertford Office: Tel: 01992 535757 Fax: 01992 535858
- Manchester Office: Tel: 01614 372708 Fax: 01614 376300

email: info@vertasefl.com
www.vertasefl.com


Site Address: Heyford Park Upper Heyford	Rev: B
--	-----------

Title: As-Built Fuel Distribution Pipeline & Tanks

Client: Upper Heyford LP

Drawn: MRG	Checked: MP	Approved: ML
------------	-------------	--------------

Dwg: 2862_17	Contract: 1246 DOR	Scale: 1:4000
--------------	--------------------	---------------

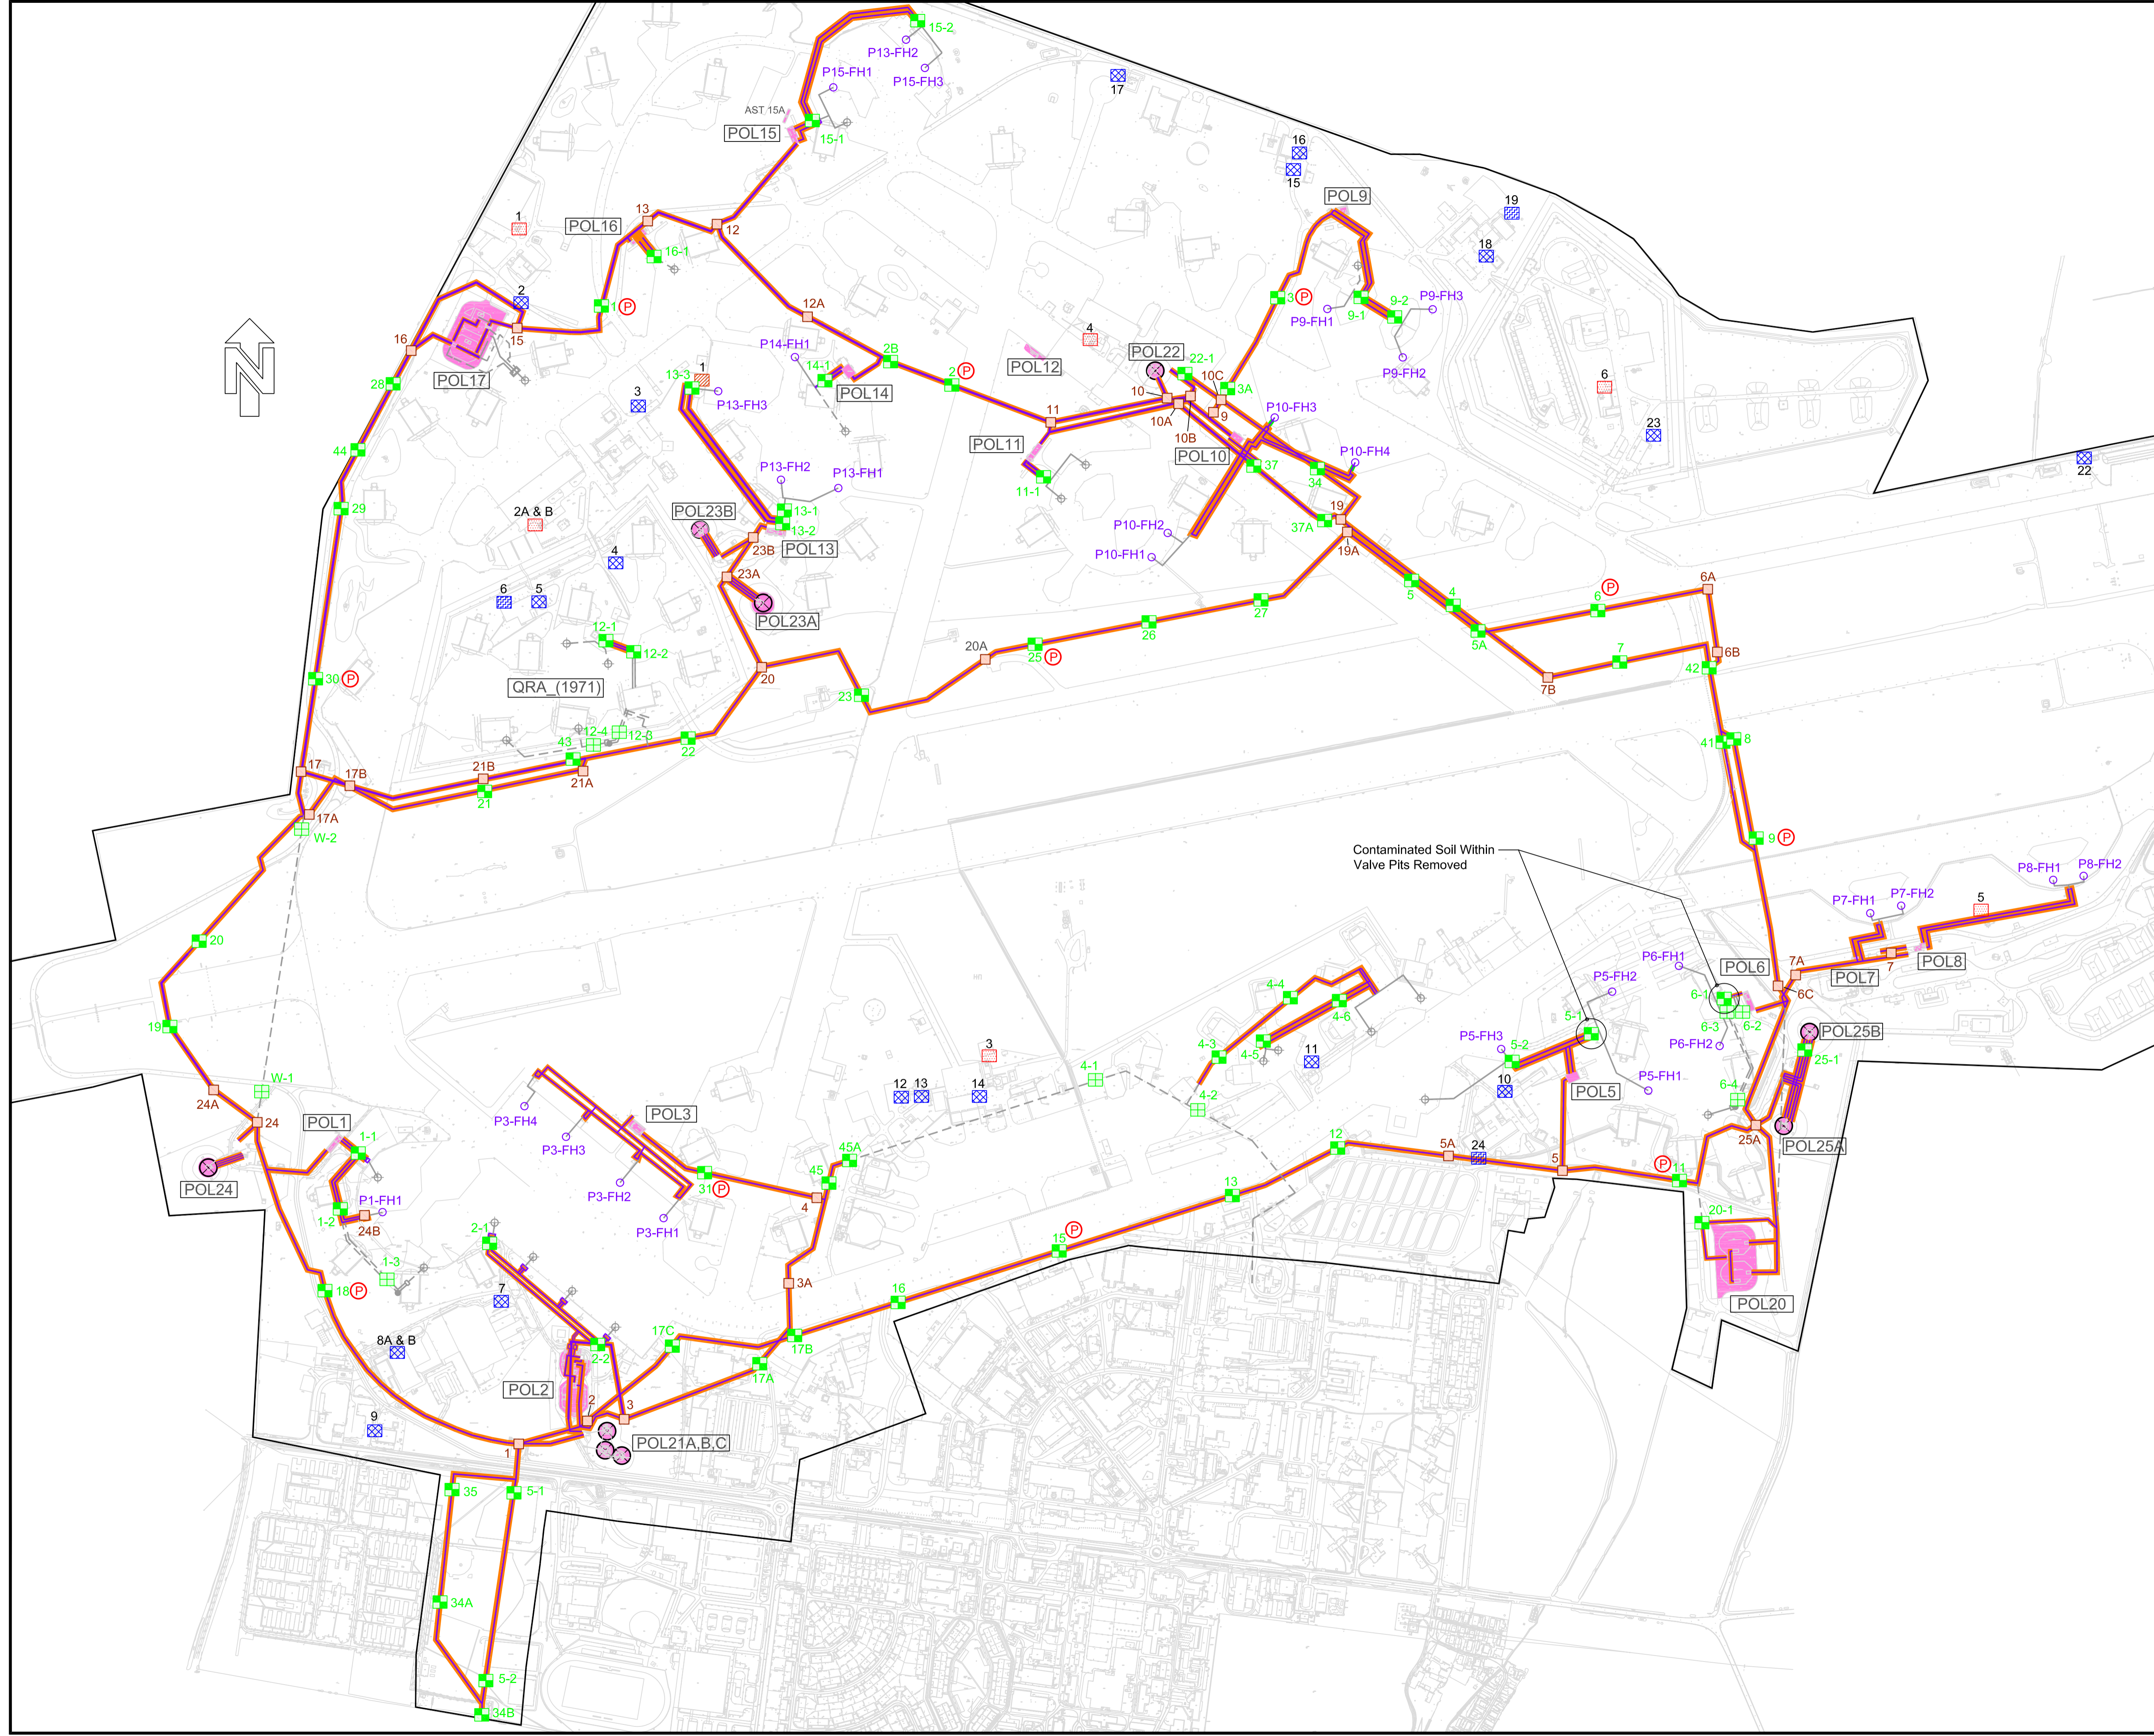

Contaminated Soil Within
Valve Pits Removed