
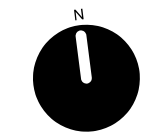



KEY

- 1 Paint
- 2 Minor Epoxy Repair
- 3 Full Timber Replace
- DU Damaged/Failed Unit
- WC Window Chip Repair
- OG Obscure Glass
- Brick Clean
- Soffit / Fascia Repair
- Remove Items
- Brick Repair

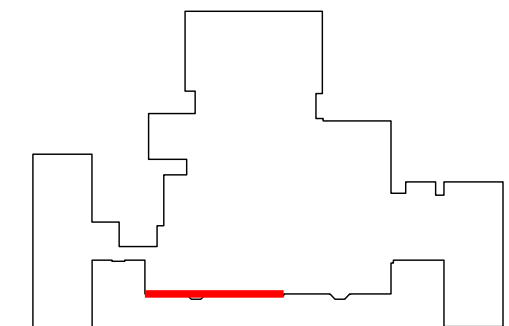

Revisions				
Revision	Date	Revision notes	Design change	Inspected by
A	09.04.14	Marked up areas to be repaired / made good	TFW	IJ

Elevation 28

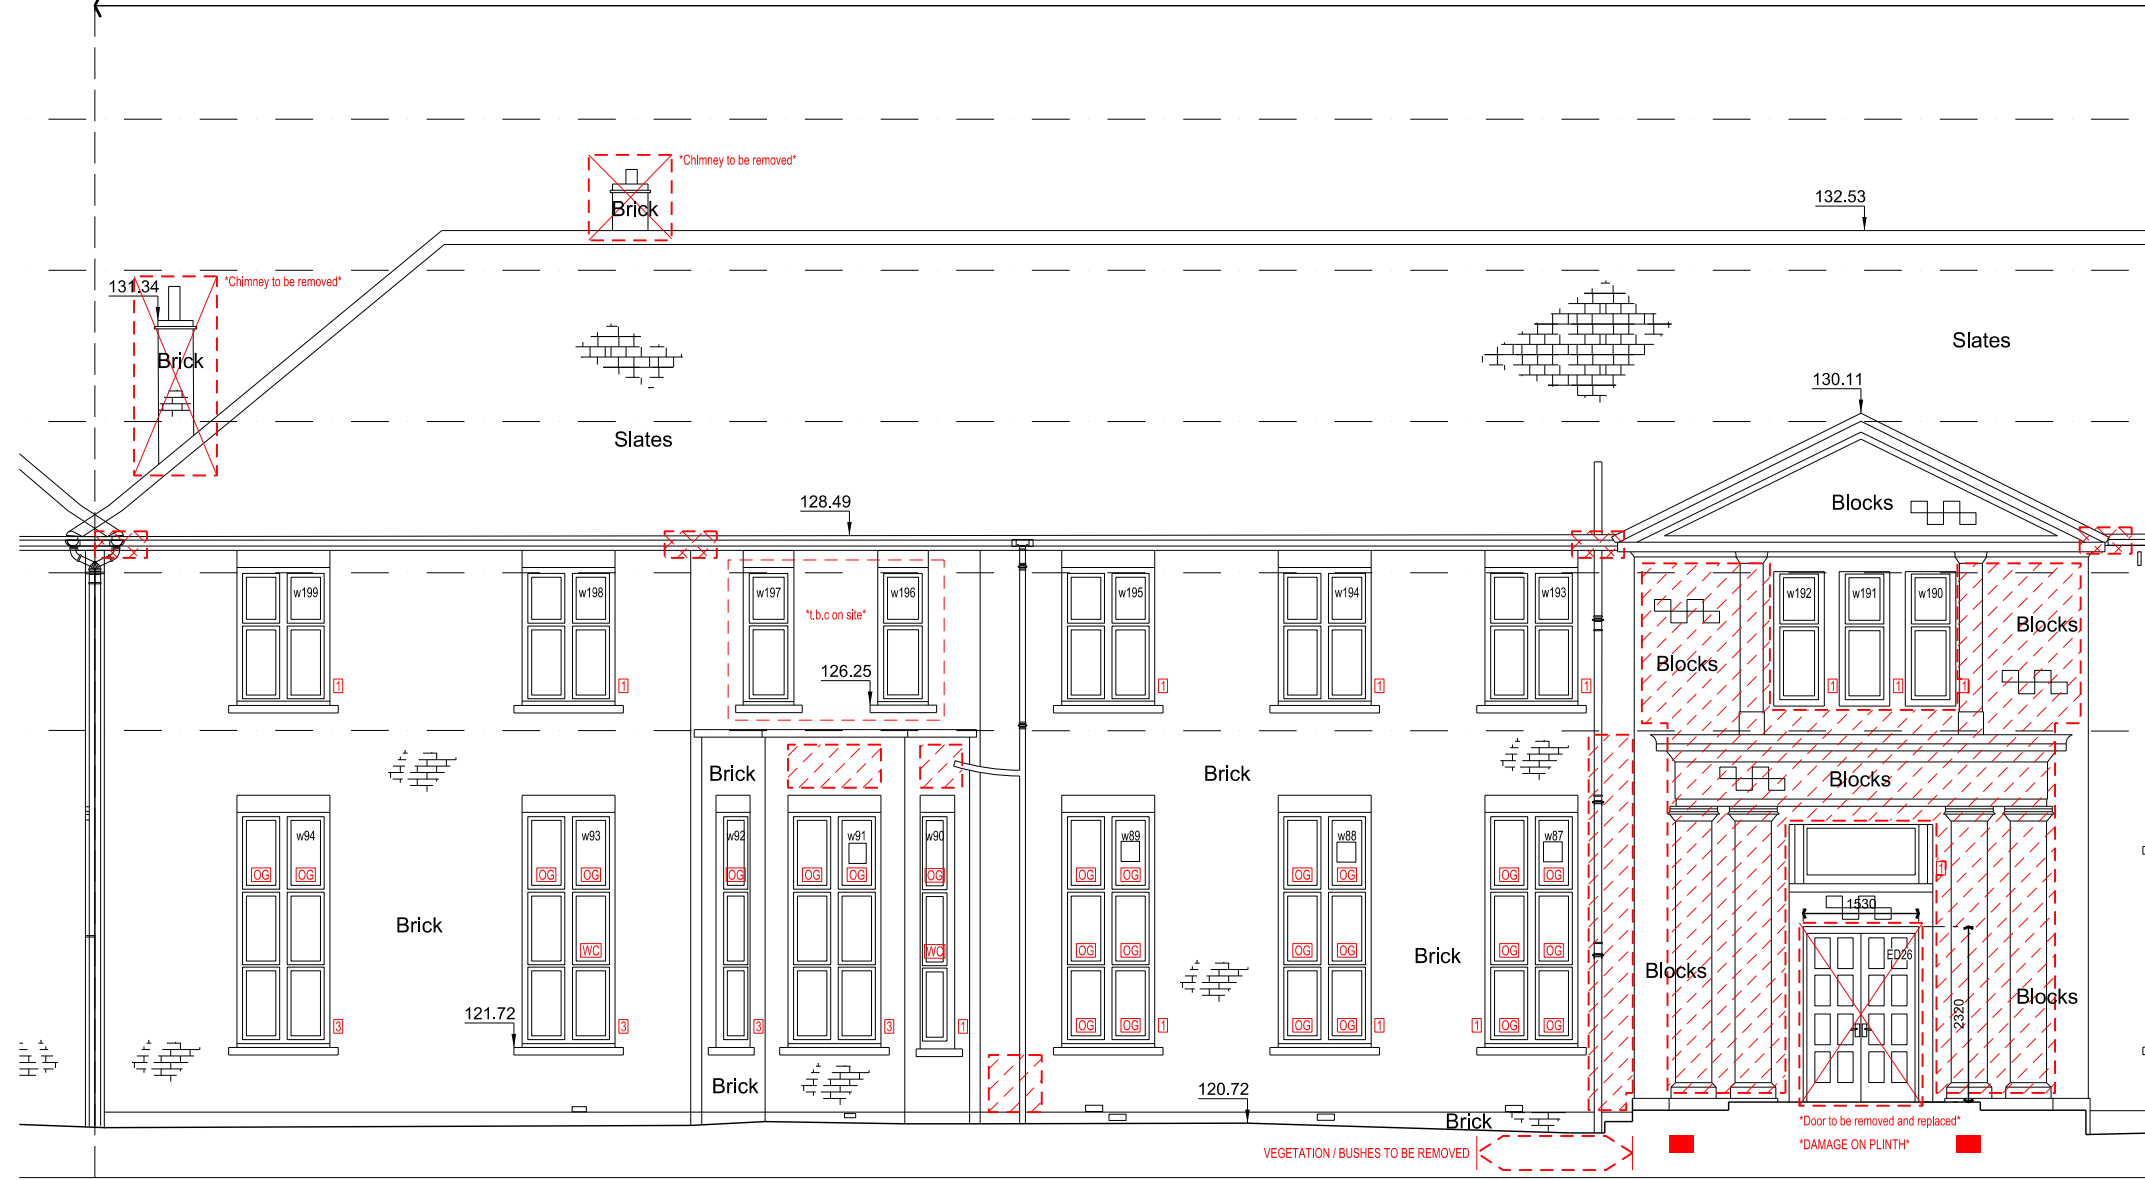


CP ISSUE

Job title
**HeyFord Park Free School
 Officers' Mess**

Drawing title
**Existing Elevation
 Elevation 28 - 1 of 2**

Check all dimensions and verify on site. Report any errors or omissions

First issued	13.03.14
Drawn by	IJ/DJ/TW
Drawing sheet size	A3
Scale	1:100
Inspected by	DJ
Job code	HFSK
Drawing number prefix	L-OM
Drawing number	1061
Revision	A

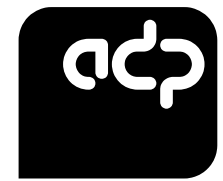

33a Vittoria Street
 Birmingham
 B1 3ND
 T +44(0) 121 234 6440
 F +44(0) 121 234 6450
 bham@adp-architects.co.uk
 www.adp-architects.co.uk

This line should measure 100mm along x and y axes when printed