



AS INSTALLED PART FRONT ELEVATION
Scale 1:50

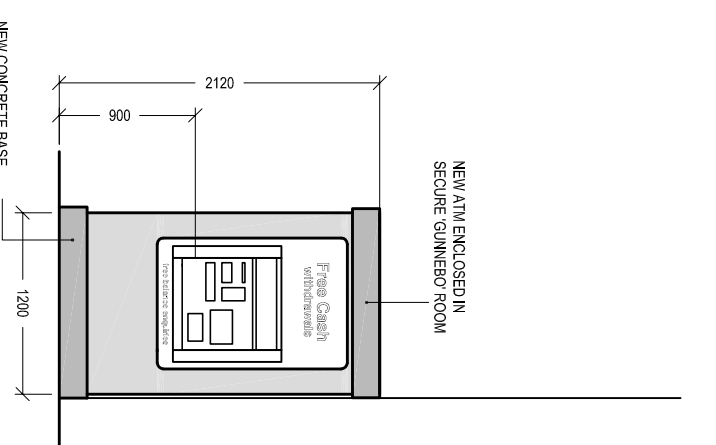

A INSTALLED PART SIDE ELEVATION
Scale 1:50

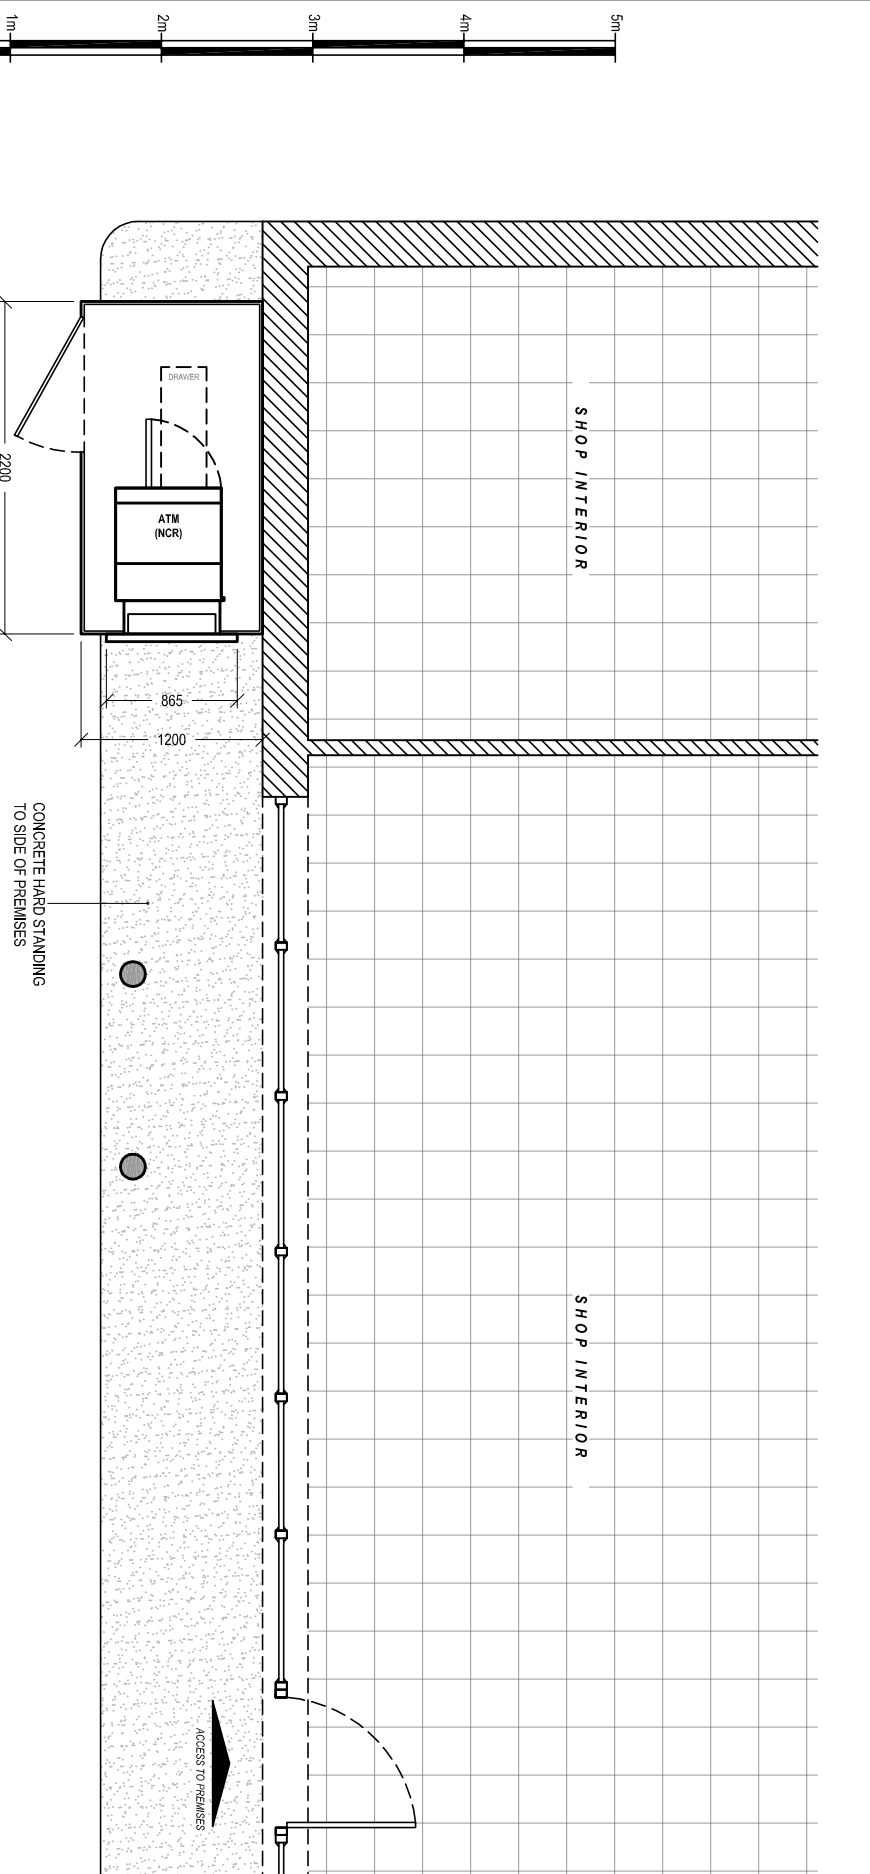

AS INSTALLED PART PLAN
Scale 1:50



Date:	Comments:	By:

GENERAL NOTES:
1) All dimensions in millimeters unless otherwise stated.

Site:
EURO GARAGE BANBURY
Oxford Road,
Bodicole,
Banbury,
OX15 4AB

Drawing Title:
As Installed Elevation and Plan

Ref:	Date:	Rev:
NM-08-2016-20-2	07-08-2016	
Scale:	Paper:	Date Rev:
1:50	A3	