



FFL 79.96m

BUILDING 129
New - West Elevation - As-built

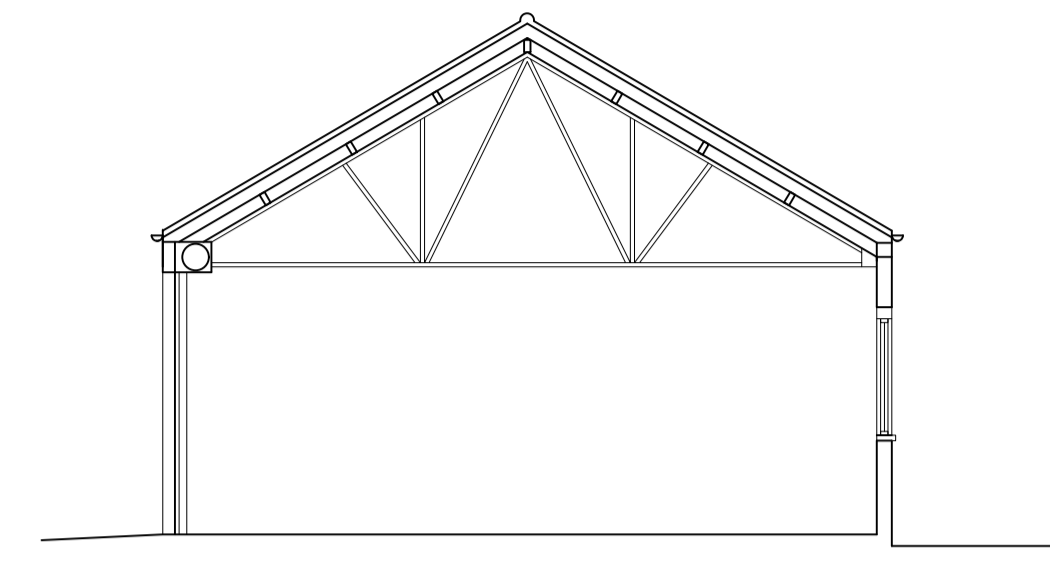


BROAD SECTION

As-built

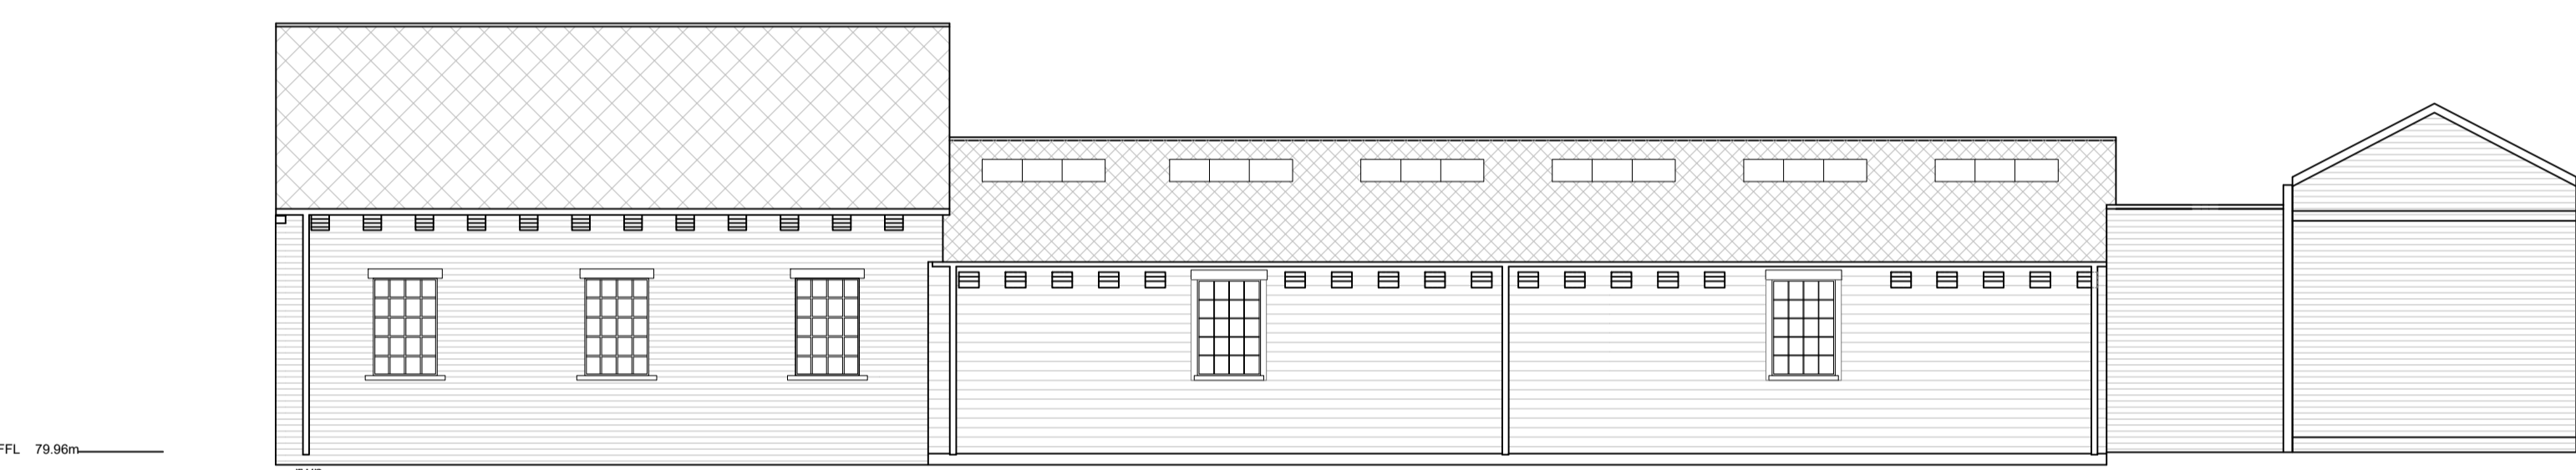


FFL 79.96m

BUILDING 129
East Elevation - As-built

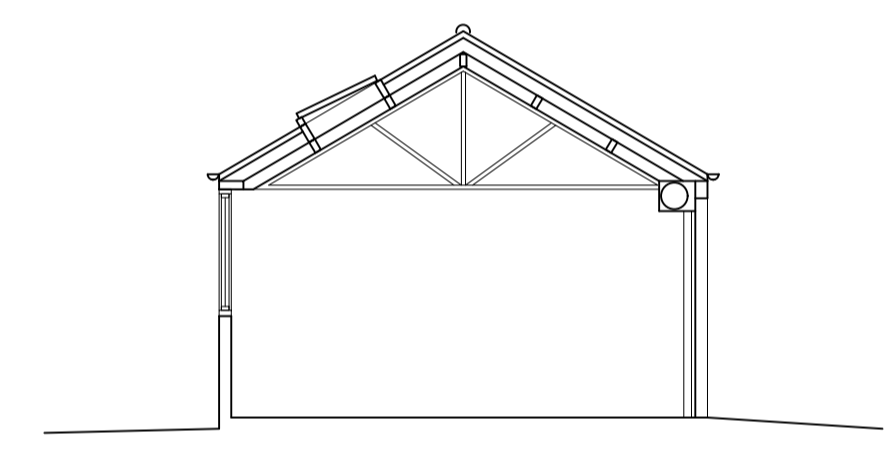


SHORT SECTION

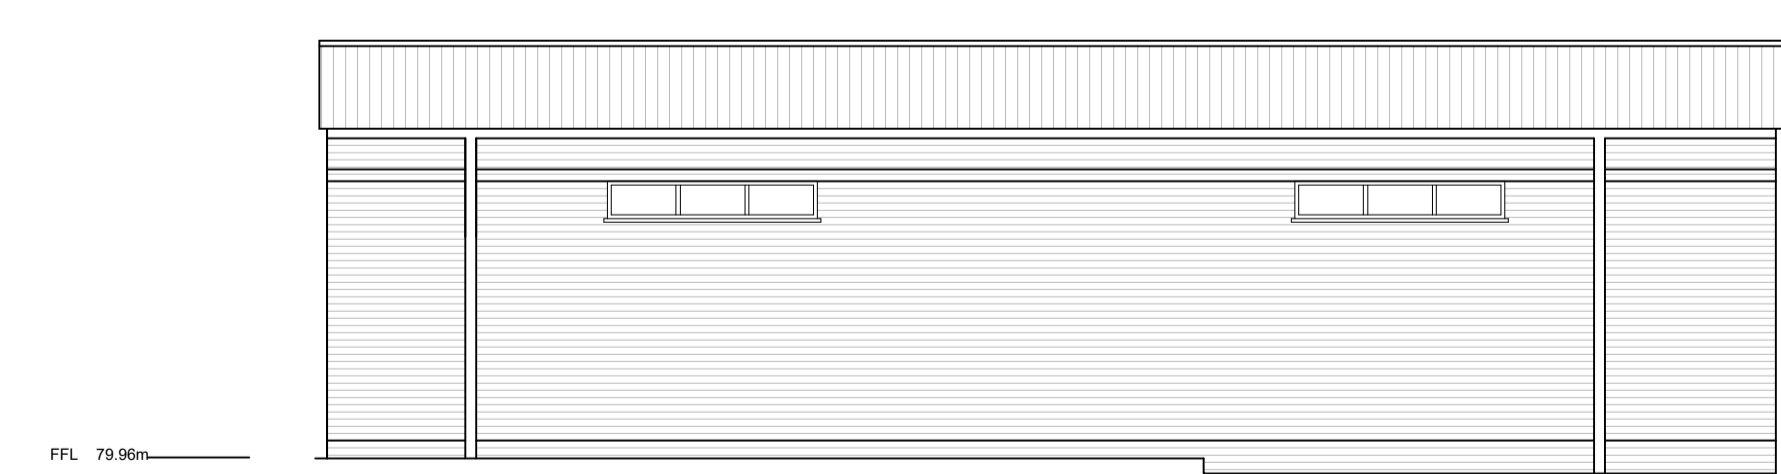


FFL 79.96m

BUILDING 129
North Elevation - As-built

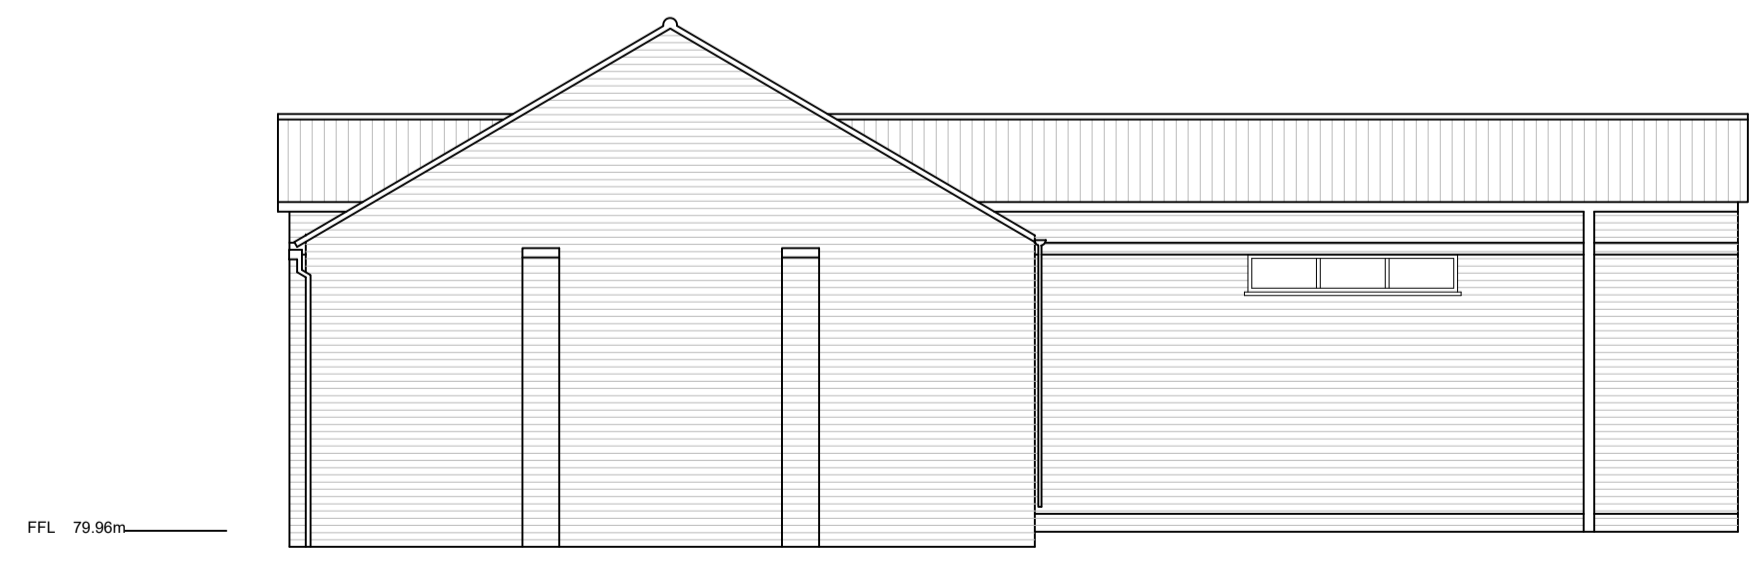

FFL 79.96m

BUILDING 129
South Elevation - As-built

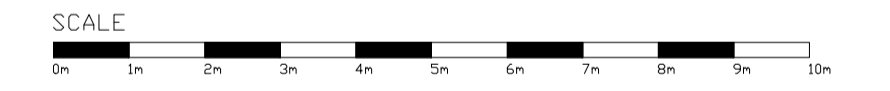

This drawing's copyright. All rights described in Chapter IV of the Copyright, Designs and Patents Act 1988 have generally been assigned. All drawings are the property of the client. No reproduction or translation is permitted without the written consent of GAFT.

Client
Bicester Heritage

Project
Bicester Airfield
Building 129 Motor Transport Sheds

Title
As-built Elevations

Drawing No	Rev	Drawn	Date	Scale
12068 / 129GA141	C	SC	2/11/2016	1:100 @A1

GAUNT FRANCIS
Architects
London & Cardiff
31 Southampton Row | London WC1B 5HU | T: 020 7629 3993 | W: GauntFrancis.co.uk