

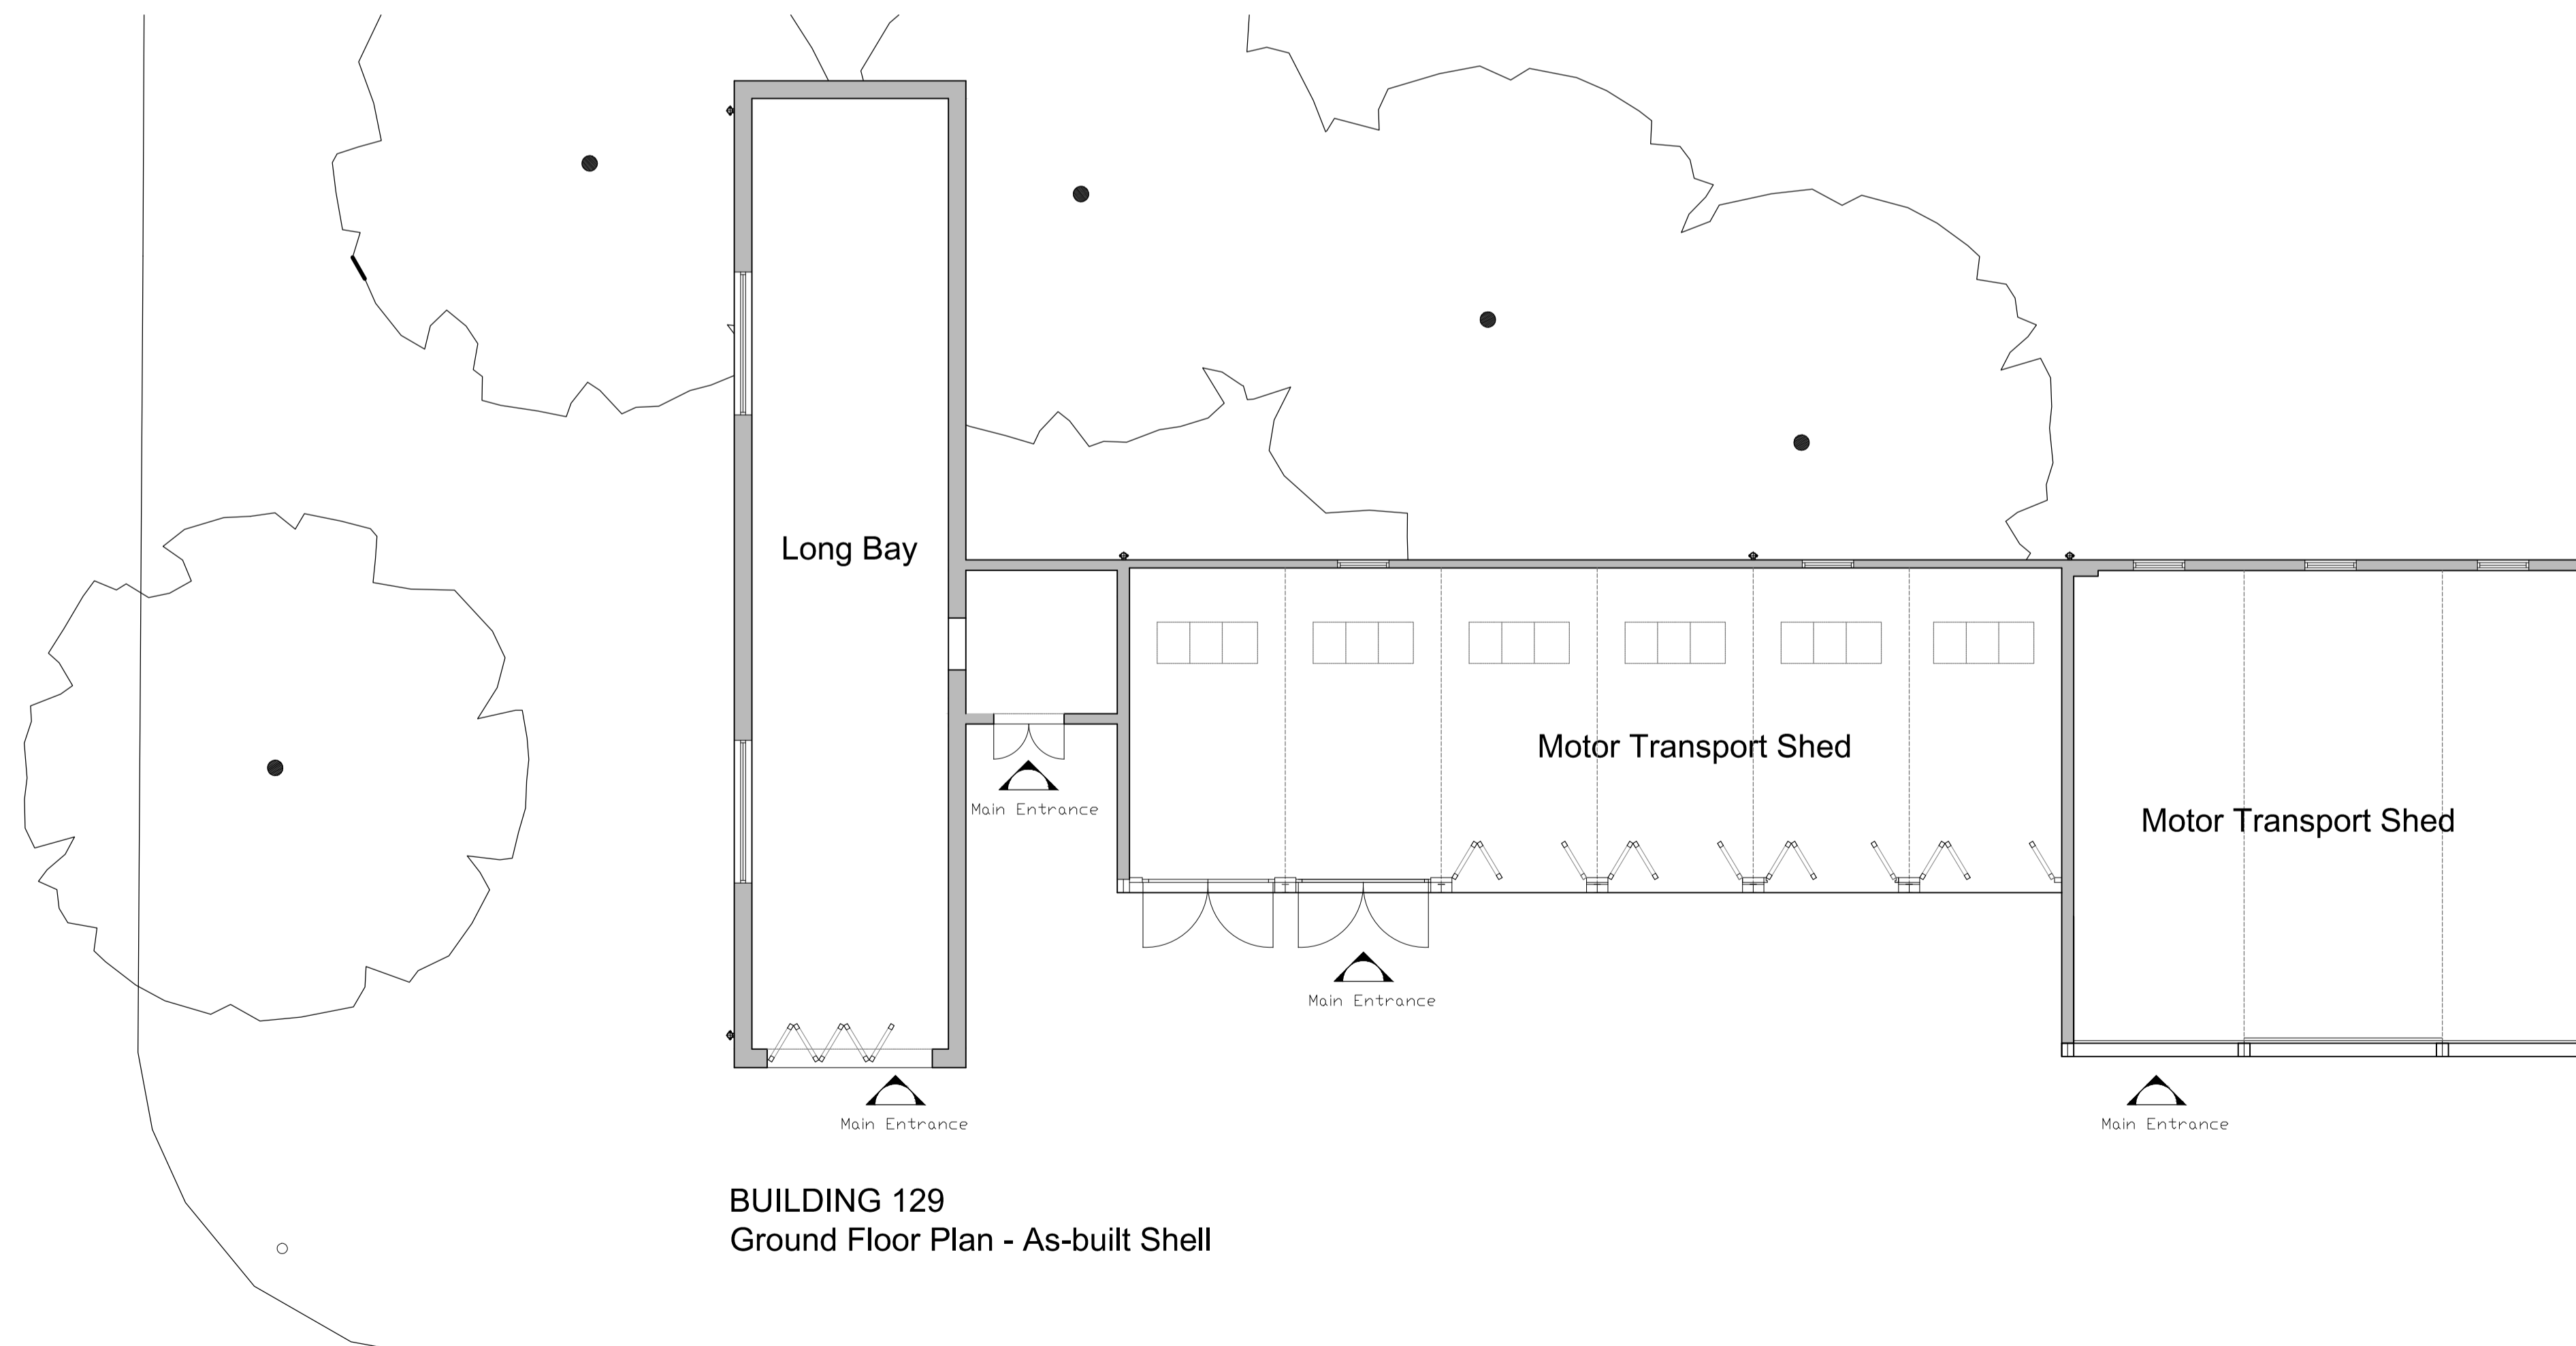


**BUILDING 129**  
Roof Plan - As-built Shell

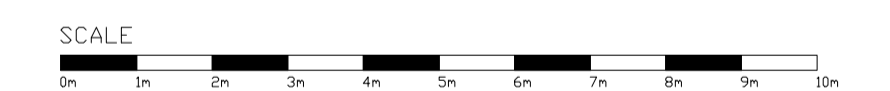

**BUILDING 129**  
Ground Floor Plan - As-built Shell

As-built

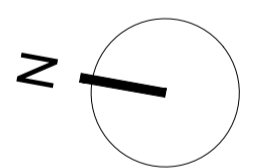

This drawing's copyright. All rights described in Chapter IV of the Copyright, Designs and Patents Act 1988 have generally been granted. All drawings are copyright of the client. No responsibility is accepted for any errors or omissions or for any loss or damage, whether direct or indirect, arising from the use of this drawing.

Client  
**Bicester Heritage**

Project  
**Bicester Airfield  
Building 129 Light Industrial Unit**

Title  
**As-built Plans**

Drawing No	Rev	Drawn	Date	Scale
12068 / 129GA102	C	SC	2/11/2016	1:100 @A1

**GAUNT FRANCIS**  
Architects  
London & Cardiff  
31 Southampton Row | London WC1B 5HU | T: 020 7629 3993 | W: GauntFrancis.co.uk