


BUILDING 131
Roof Plan - As-built



BUILDING 131
Ground Floor Plan - As-built

Key As-built

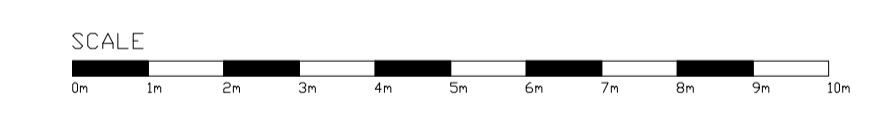

This drawing's copyright. All rights described in Chapter IV of the Copyright, Designs and Patents Act 1988 have generally been assigned. All drawings are the property of the client. No responsibility is accepted for any errors or omissions. Any discrepancy between this drawing and other information is the responsibility of the client.

Client
Bicester Heritage

Project
Bicester Airfield
Building 131 Motor Transport Shed

Title
As-built Plans

Drawing No	Rev	Drawn	Date	Scale
12068 /131GA100	C	SC	2/11/2016	1:100 @A1