



BUILDING 129 Roof Plan

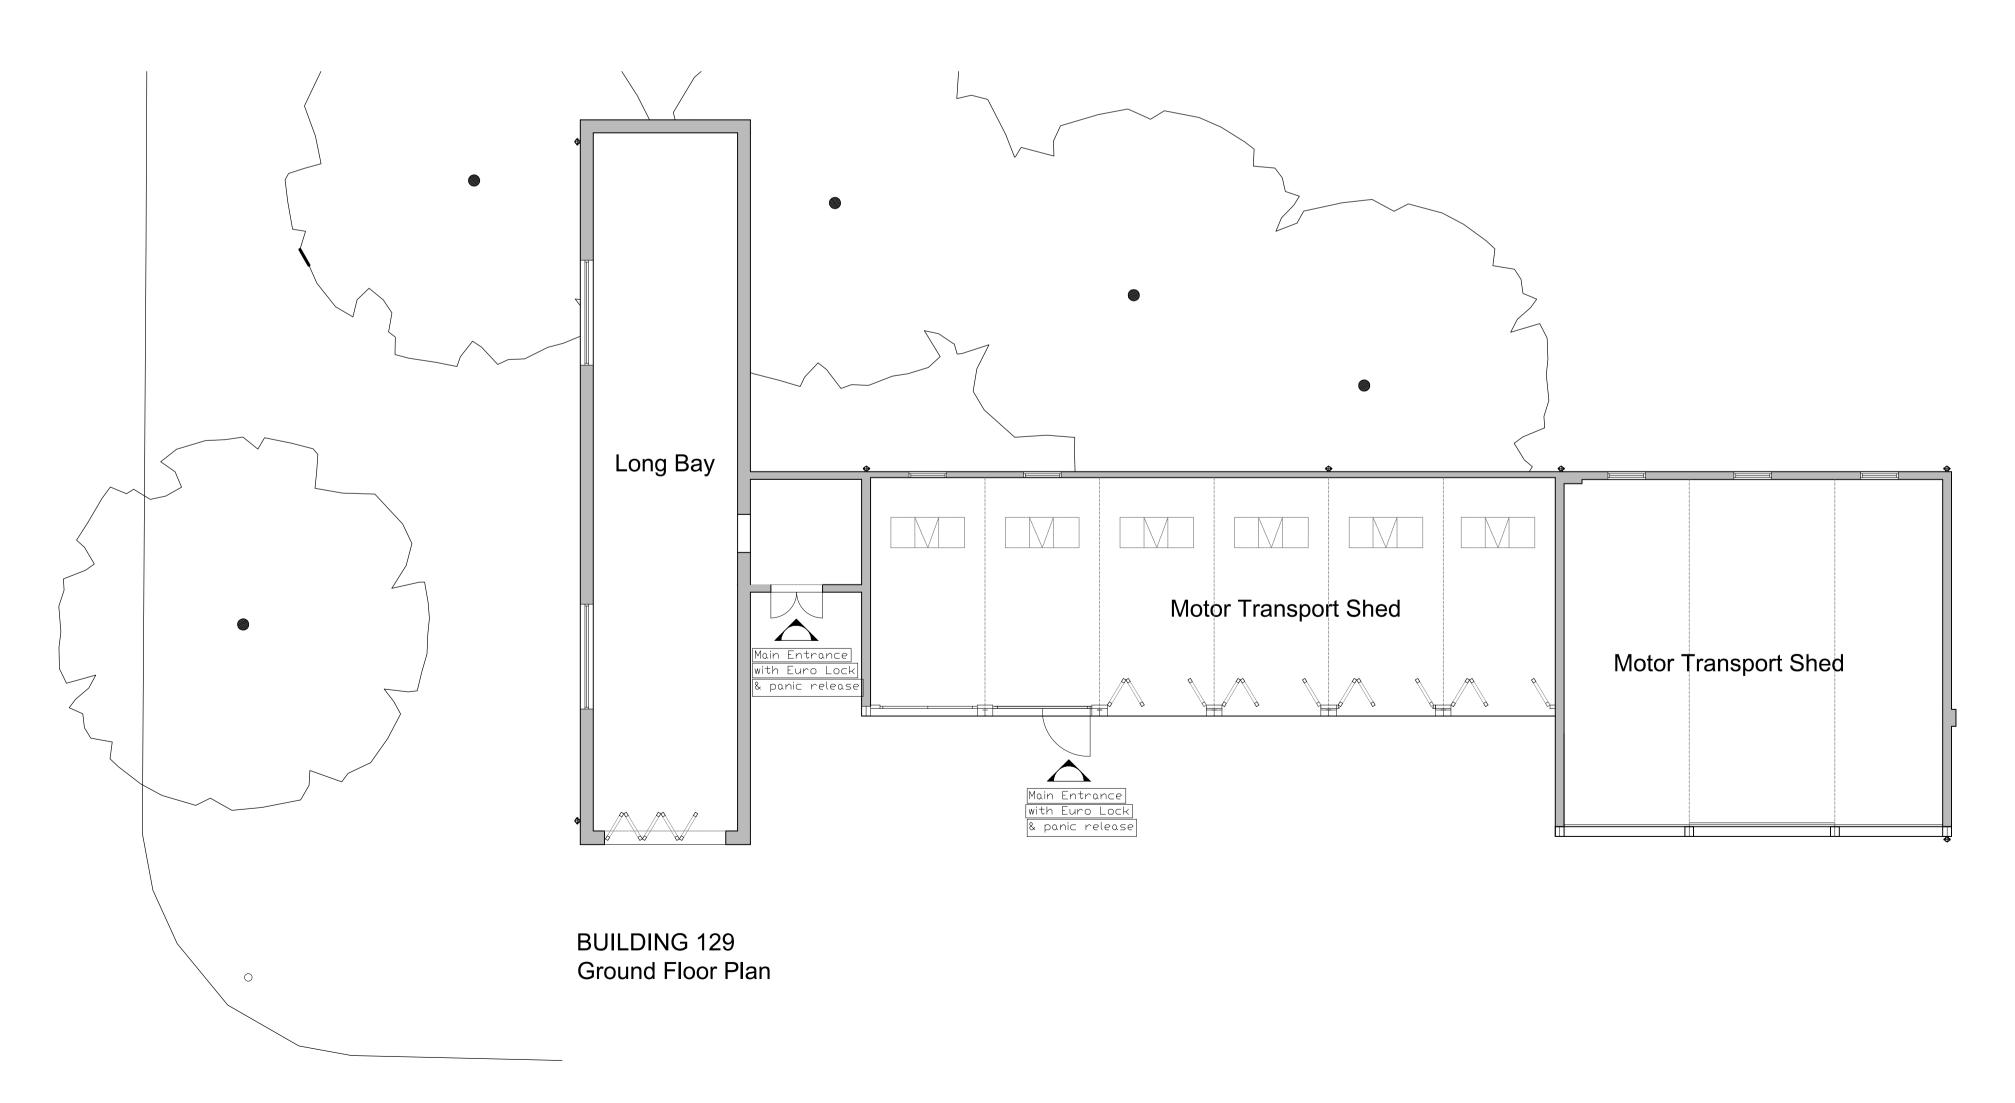

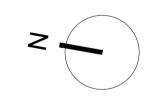

 SCALE

 On
 1m
 2m
 3m
 4m
 5m
 6m
 7m
 8m
 9m
 10m

this ardwing is cophight. Amplifs described in Chapter for on the cophight a flat a definished information to be checked on site. Do not scale. Any discrepancy between this drawing and other information to be reported to GFA, drawing shows Design Intent Only.

Bicester Heritage

Bicester Airfield Building 129

Drawing No Rev Drawn Date Scale

12068 /129GA102 AB SC 2/11/2016 1:100 @A1

GAUNT FRANCIS

Architects

S1 Southampton Row | London WC1B 5HJ | T: 020 7629 3993 | W: GauntFrancis.co.uk

As-built Plans