

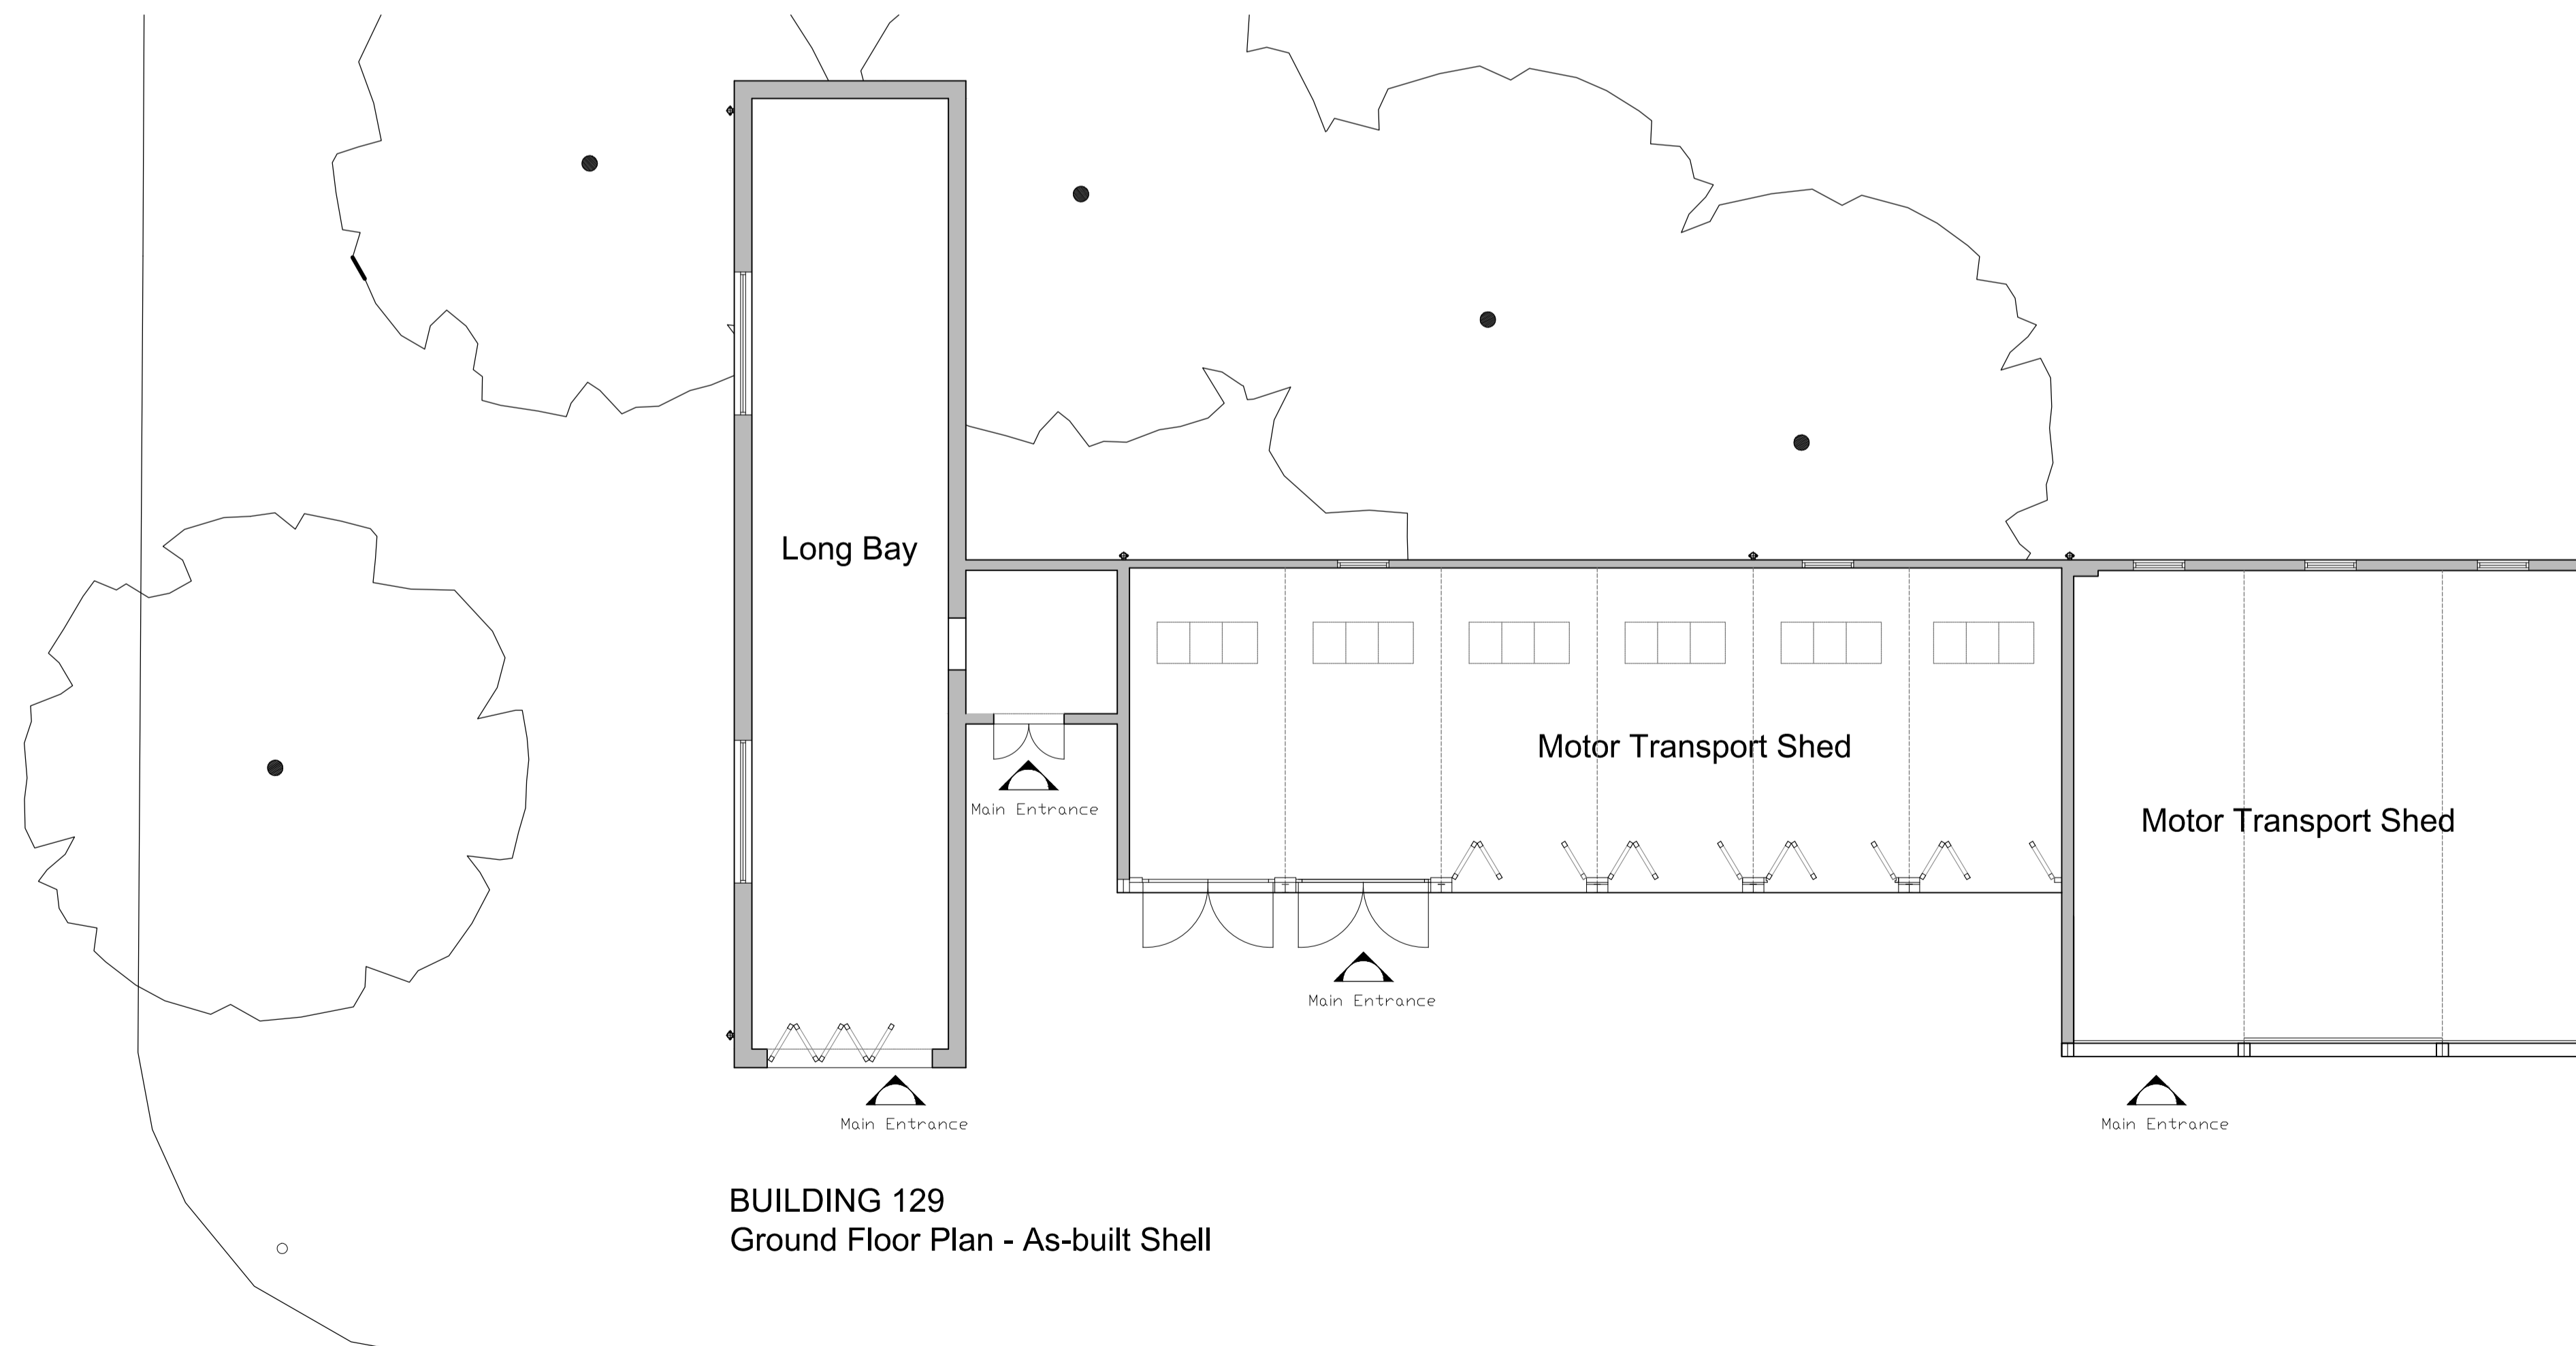


BUILDING 129
Roof Plan - As-built Shell

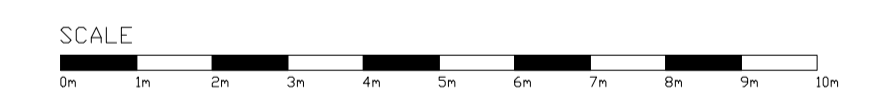

BUILDING 129
Ground Floor Plan - As-built Shell

As-built

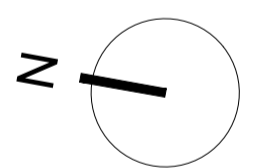

This drawing's copyright. All rights described in Chapter IV of the Copyright, Designs and Patents Act 1988 have generally been assigned. All drawings are copyright of the client. No responsibility is accepted for any errors or omissions in this drawing and other information or for any loss, damage, or injury resulting from its use.

Client
Bicester Heritage

Project
**Bicester Airfield
Building 129 Light Industrial Unit**

Title
As-built Plans

Drawing No	Rev	Drawn	Date	Scale
12068 / 129GA102	C	SC	2/11/2016	1:100 @A1

GAUNT FRANCIS
Architects
London & Cardiff
31 Southampton Row | London WC1B 5HU | T: 020 7629 3993 | W: GauntFrancis.co.uk