



BUILDING 129
New - West Elevation - As-built

As-built

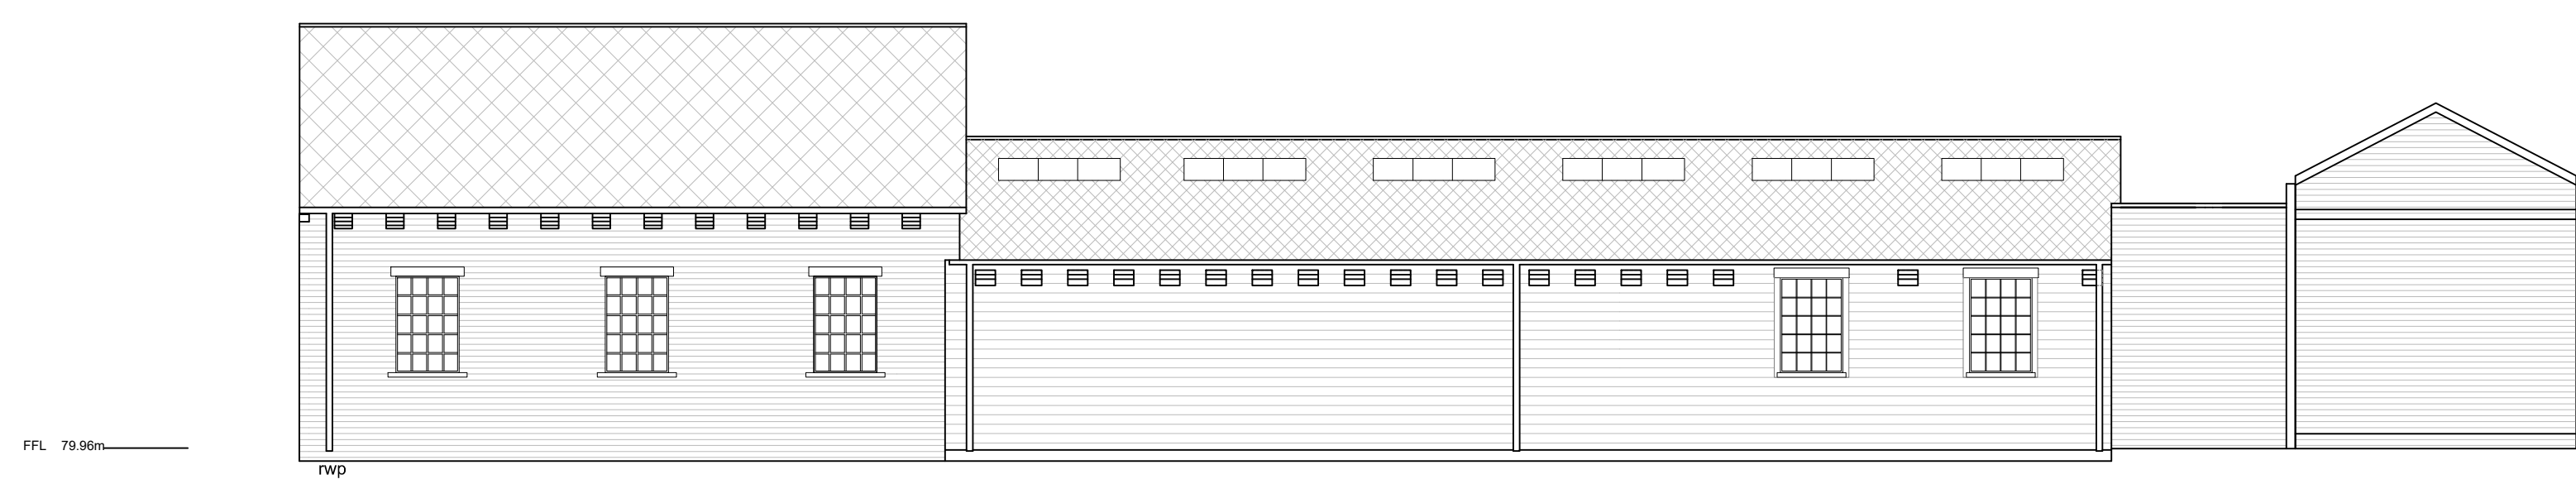


BUILDING 129
East Elevation - As-built

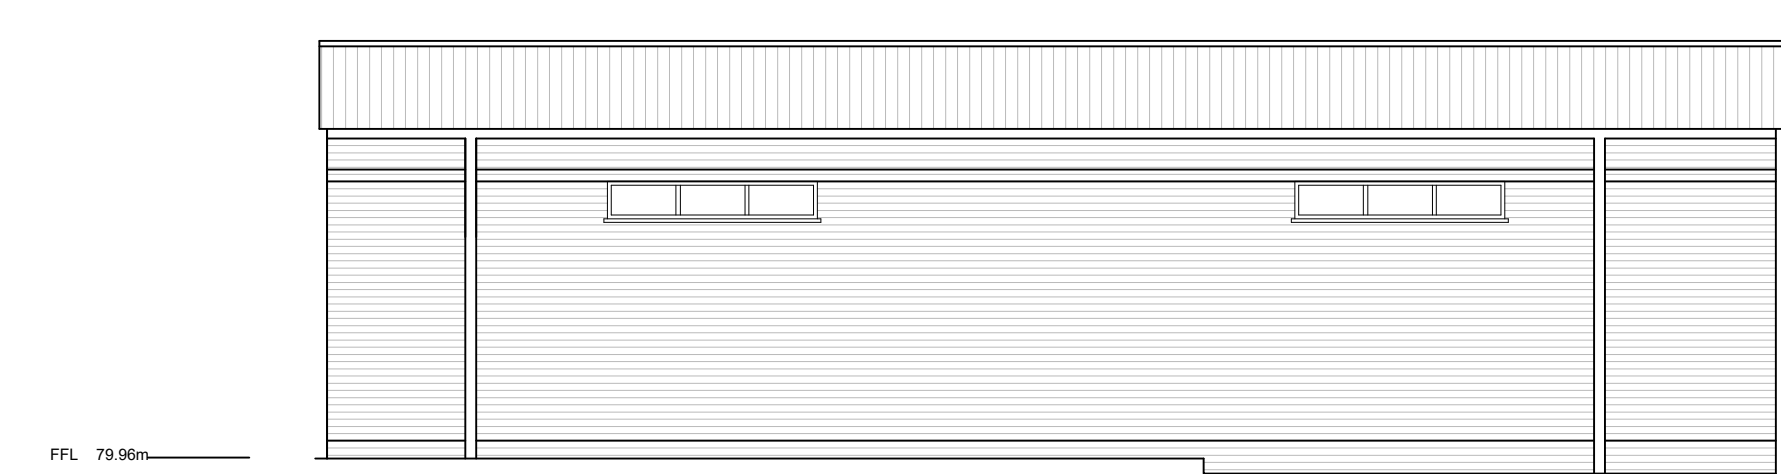

BUILDING 129
North Elevation - As-built



BUILDING 129
South Elevation - As-built

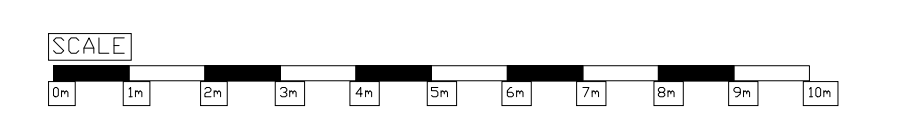

This drawing's copyright. All rights described in Chapter IV of the Copyright, Designs and Patents Act 1988 have generally been assigned. All drawings are the property of the client. No responsibility is accepted for any errors or omissions. The client is responsible for the accuracy of the data provided.

Client
Bicester Heritage

Project
**Bicester Airfield
Building 129 Motor Transport Sheds**

Drawing No	Rev	Drawn	Date	Scale
12068 / 129GA141	AB	SC	2/11/2016	1:100 @A1

GAUNT FRANCIS
Architects
London & Cardiff
31 Southampton Row | London WC1B 5HU | T: 020 7629 3993 | W: GauntFrancis.co.uk