



Building 455 - Proposed North Elevation  
1 : 100



Building 455 - Section AA  
1 : 100





Building 455 - Proposed South Elevation  
1 : 100



Building 455 - Section BB  
1 : 100

1. NEW SLATE ROOF
2. OFF WHITE BRICKWORK
3. PPC ALUMINIUM FRAME WINDOWS
4. BRONZE EFFECT SPANDREL PANEL
5. PPC ALUMINIUM FRAMED WINDOW/DOOR WITH BRONZE EFFECT SPANDREL ABOVE
6. OFF WHITE RENDER
7. GLAZED AUTOMATIC DOORS WITH BRONZE CLADDING ABOVE
8. PPC ALUMINIUM FRAMED DOORS
9. ~~NEW PAINTED TIMBER FRAMED WINDOW~~
10. DARK GREY BRICKWORK
11. PPC ALUMINIUM VERTICAL LOUVRES
12. BRONZE EFFECT SHINGLE METAL CLADDING
13. PPC ALUMINIUM FASCIA
14. GLAZED CURTAIN WALLING
15. ~~PPC ALUMINIUM FOLD DOORS~~
16. ~~LARGE PIVOT BRONZE EFFECT FEATURE DOOR~~
17. BRONZE EFFECT COLUMNS
18. METAL ROOF TRUSS
19. PPC ALUMINIUM COPING
20. ~~FIXED GLASS BALUSTRADE~~
21. PPC ALUMINIUM BRONZE EFFECT CANOPY

**NOTE:**  
TO BE READ IN CONJUNCTION WITH DESIGN AMENDMENT SCHEDULE FOR DESIGN DEVELOPMENT CHANGES TO APPROVED PLANNING SCHEME. TO BE READ IN CONJUNCTION WITH CORDE APPROVED PLANNING DOCUMENTS - 1700091NMA

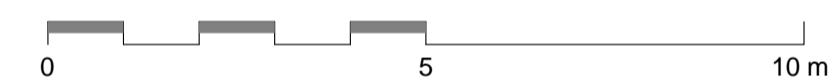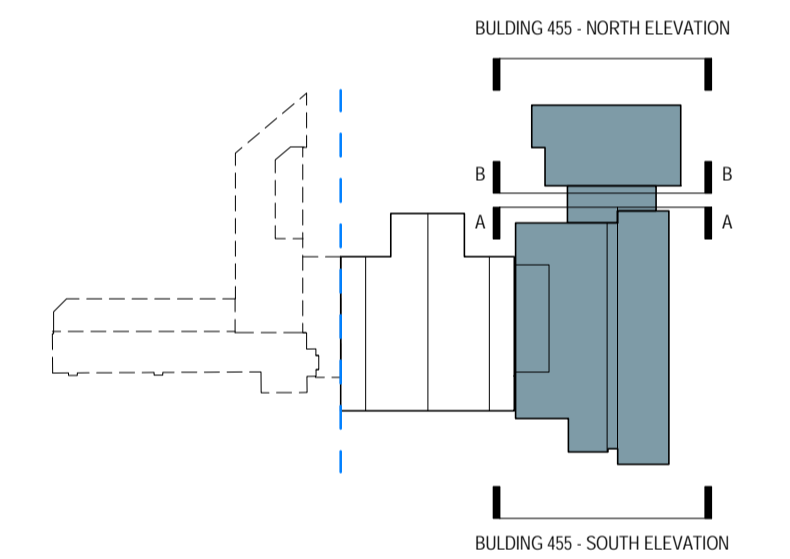

REVISION	DATE	DESCRIPTION	DRAWN	CHECKED
S2-C 1	12.02.18	Issued to Client/Planning Consultant	RG	ADP
S2-C 2	23.02.18	Planning Issue to Client/Planning Consultant	RG	ADP
S2-C 3	21.03.18	Planning Issue to Client/Planning Consultant	RG	ADP

CHECK ALL DIMENSIONS AND VERIFY ON SITE. REPORT ANY ERRORS OR OMISSIONS

**CONSTRUCTION**

**CORDE**

Charity House  
Park End Street Oxford OX1 1JD  
T +44 (0) 1865 248045  
E info@corde.co.uk  
www.corde.co.uk

JOB TITLE:  
**HEYFORD PARK  
DORCHESTER LIVING**

DRAWING TITLE:  
**BUILDING 455 - PROPOSED ELEVATIONS**

SCALE:  
**As indicated**

DRAWING SHEET SIZE:  
**A1**

JOB CODE: **CD3216**    DRAWING NUMBER: **CRD-01-ZZ-DR- A-05036**    REVISION: **S2-C 3**