



1. NEW SLATE ROOF
2. OFF WHITE BRICKWORK
3. PPC ALUMINIUM FRAME WINDOWS
4. BRONZE EFFECT SPANDREL PANEL
5. PPC ALUMINIUM FRAMED WINDOW/DOOR WITH BRONZE EFFECT SPANDREL ABOVE
6. OFF WHITE RENDER
7. GLAZED AUTOMATIC DOORS WITH BRONZE CLADDING ABOVE
8. PPC ALUMINIUM FRAMED DOORS
9. ~~NEW PAINTED TIMBER FRAMED WINDOW~~
10. DARK GREY BRICKWORK
11. PPC ALUMINIUM VERTICAL LOUVRES
12. BRONZE EFFECT SHINGLE METAL CLADDING
13. PPC ALUMINIUM FASCIA
14. GLAZED CURTAIN WALLING
15. ~~PPC ALUMINIUM BI-FOLD DOORS~~
16. ~~LARGE PIVOT BRONZE EFFECT FEATURE DOOR~~
17. BRONZE EFFECT COLUMNS
18. METAL ROOF TRUSS
19. PPC ALUMINIUM COPING
20. ~~FIXED GLASS BALUSTRADE~~
21. PPC ALUMINIUM BRONZE EFFECT CANOPY

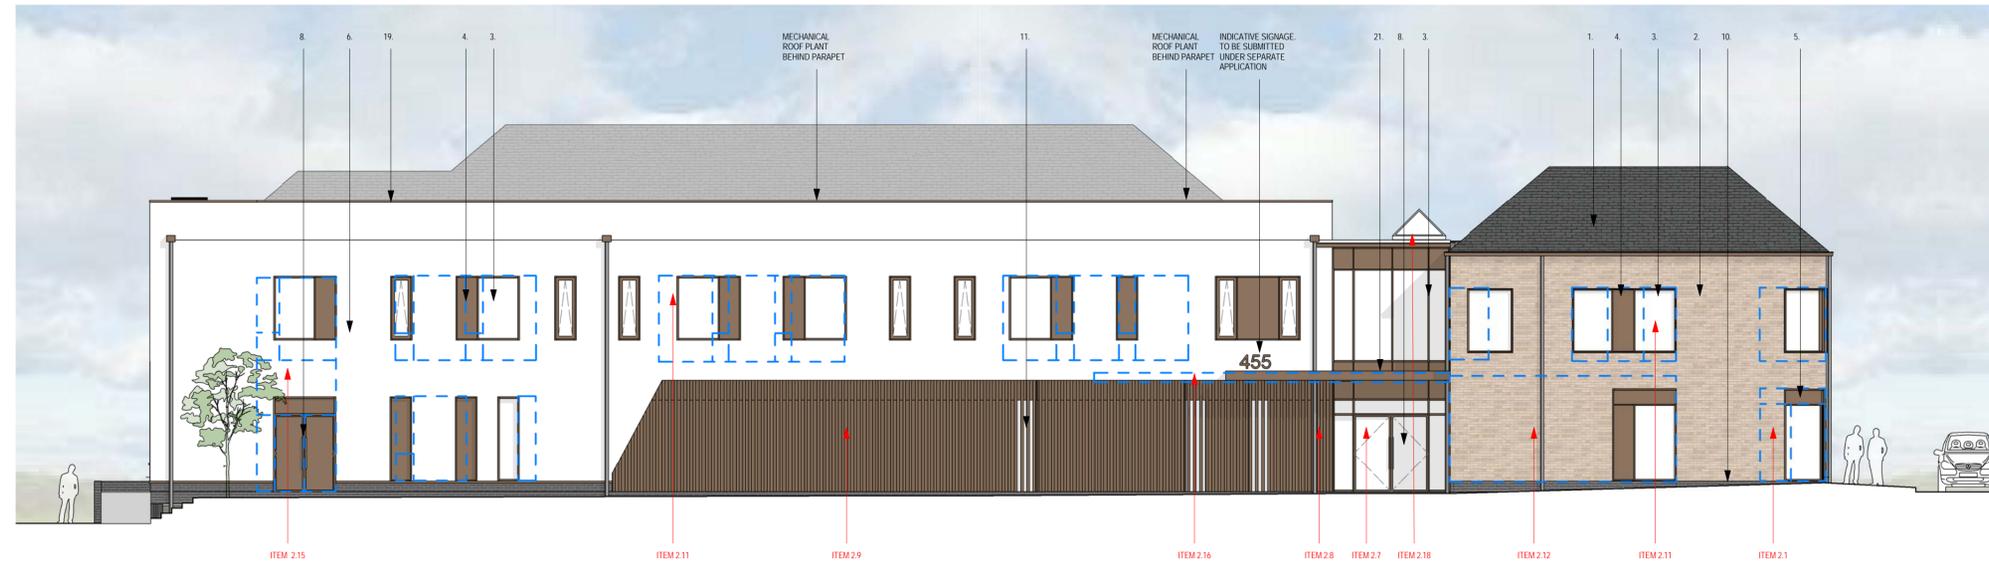

Building 455 - Proposed East Elevation
1 : 100

--- ELEVATIONAL TREATMENT ON PREVIOUS CORDE PLANNING INFORMATION

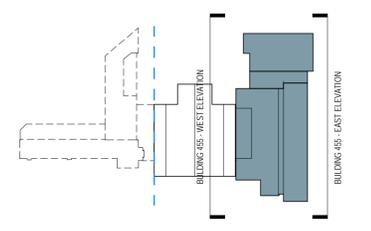

0 5 10 m

REVISION	DATE	DESCRIPTION	DRAWN	CHECKED
S2-C 1	12.02.18	Issued to Client/Planning Consultant	RG	ADP
S2-C 2	23.02.18	Planning Issue to Client/Planning Consultant	RG	ADP
S2-C 3	21.03.18	Planning Issue to Client/Planning Consultant	RG	ADP

CHECK ALL DIMENSIONS AND VERIFY ON SITE. REPORT ANY ERRORS OR OMISSIONS

CONSTRUCTION

CORDE

Charity House
 Park End Street Oxford OX1 1JD
 T +44 (0) 1865 248045
 E info@corde.co.uk
 www.corde.co.uk

JOB TITLE:
**HEYFORD PARK
 DORCHESTER LIVING**

DRAWING TITLE:
**BUILDING 455 - PROPOSED ELEVATIONS - DESIGN
 AMENDMENTS**

SCALE: As indicated	DRAWING SHEET SIZE: A1
JOB CODE: CD3216	DRAWING NUMBER: CRD-01-ZZ-DR- A-05030
REVISION: S2-C 3	



Building 455 - Proposed West Elevation
1 : 100

This line should measure 100mm along x and y axis when printed