





1:500 @ A1

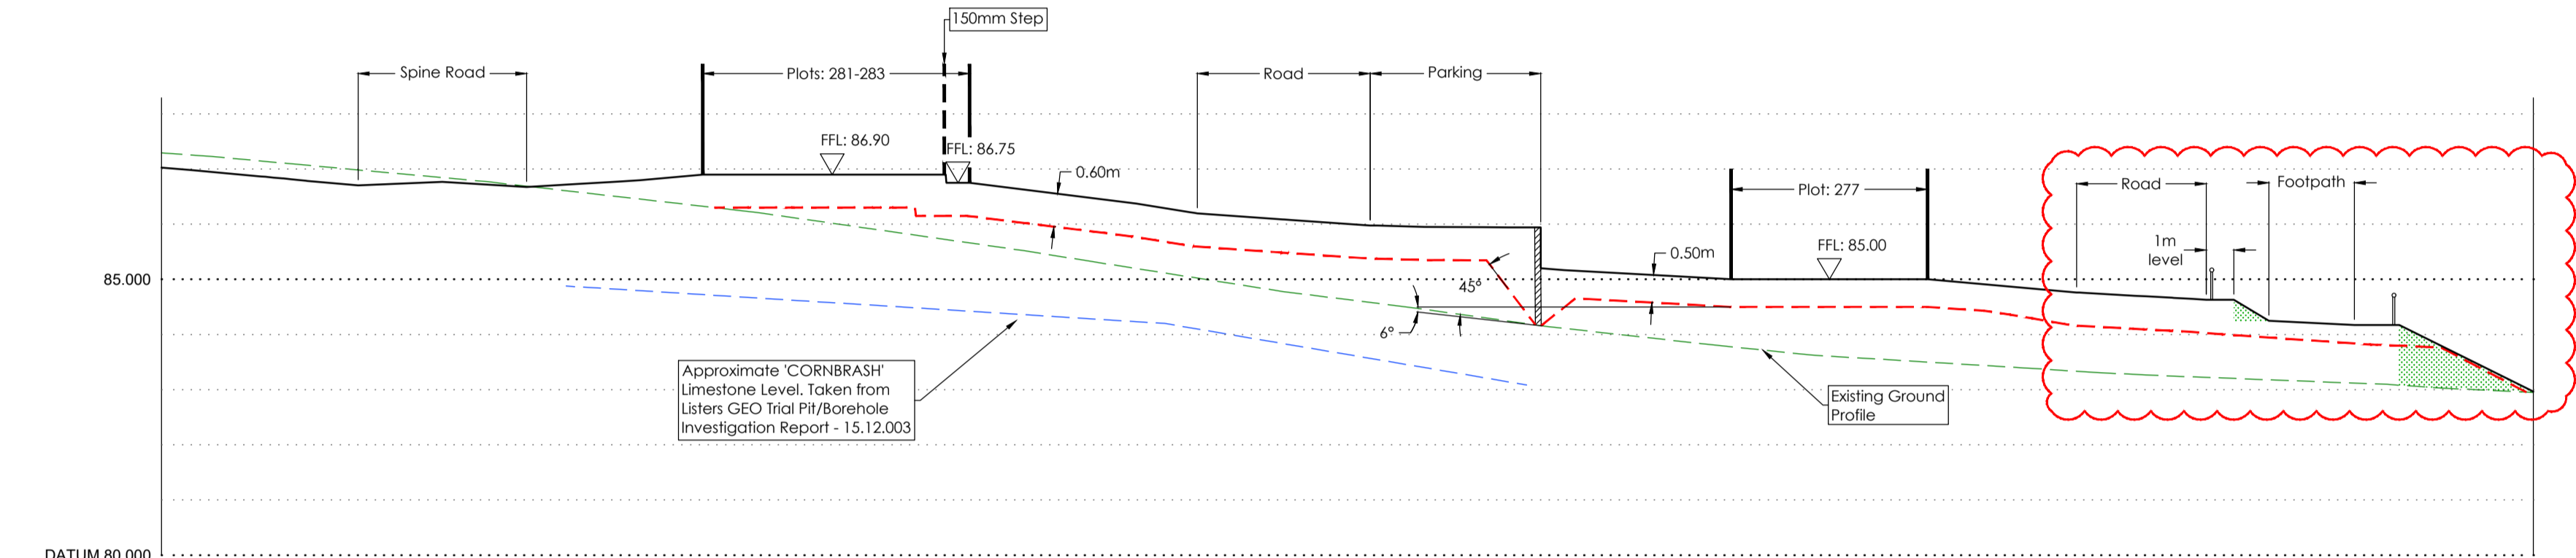

CHAINAGE	0.000	5.000	10.000	14.868	20.000	25.000	30.000	35.000	40.000	45.000	49.481	50.000	55.000	60.000	65.000	70.000	75.000	80.000	85.000	85.982	
BRASH LEVEL				84.838	84.711	84.555	84.399	84.242	83.890	83.465	83.085										
PROPOSED LEVEL	87.023	86.759	86.762	86.726	86.600	86.500	86.706	86.393	86.108	85.961	85.300		85.033	85.000	84.967	84.761	84.633	84.150	83.752	82.944	
BASE LEVEL	87.293	87.081	86.852	86.588	86.303	86.000	85.609	85.222	84.829	84.507	84.161		83.879	83.620	83.470	83.315	83.206	83.108	82.972	82.940	

Section D-D

Scale: 1:200 Horizontal
1:100 Vertical

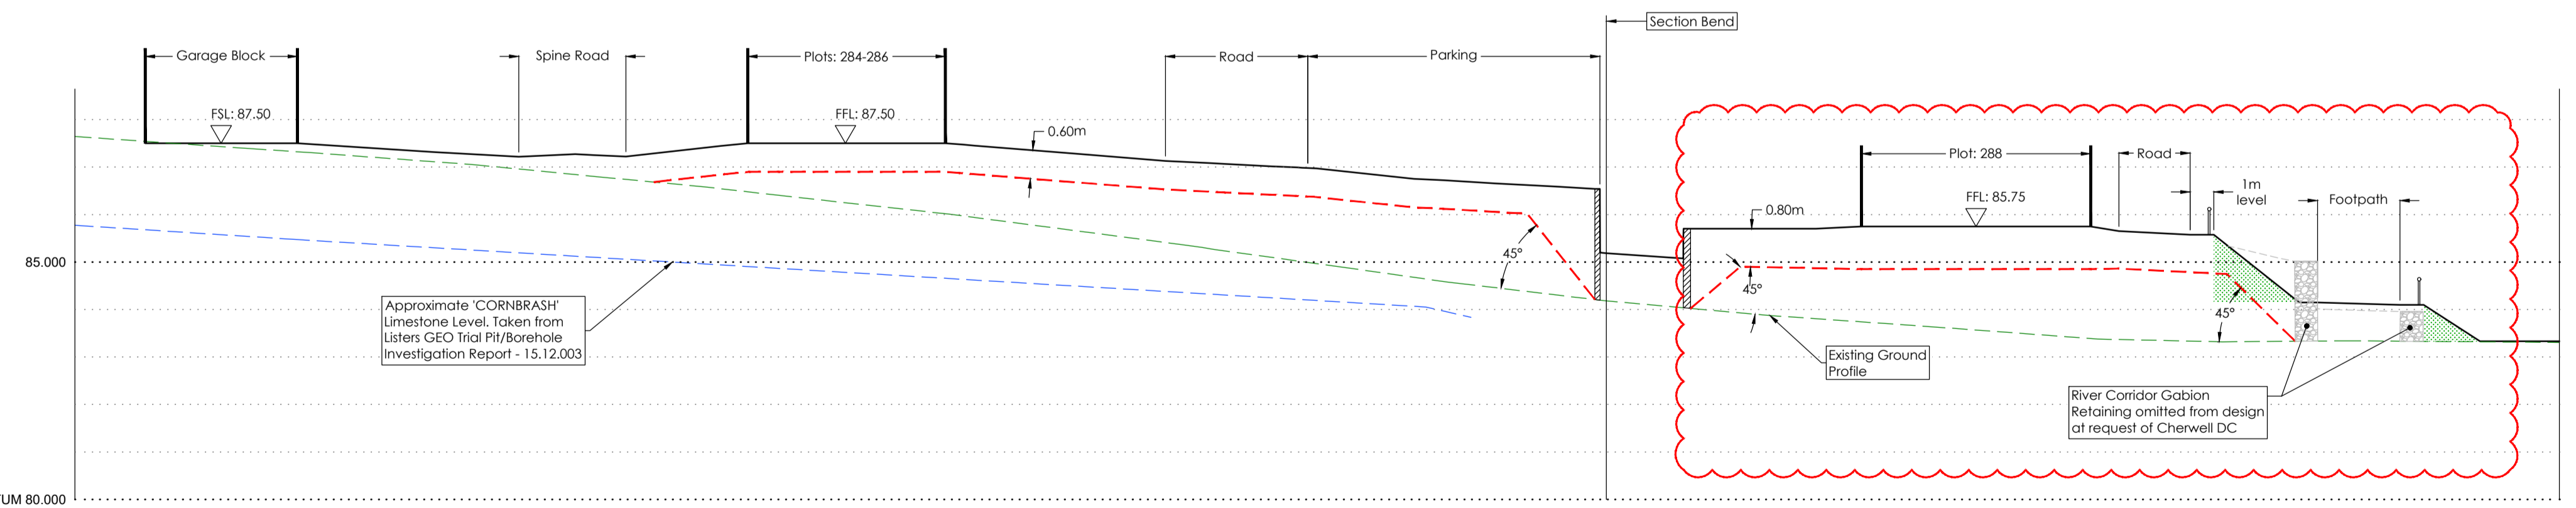

CHAINAGE	0.000	2.992	5.000	10.000	15.000	20.000	25.000	30.000	35.000	40.000	45.000	50.000	55.000	58.800	60.000	65.000	70.000	75.000	80.000	85.000	90.000	95.000	100.000	104.635	
BRASH LEVEL	85.775		85.613	85.453	85.304	85.154	85.005	84.856	84.706	84.557	84.408	84.258	84.109	83.935											
PROPOSED LEVEL		87.500	87.500	87.480	87.318	87.247	87.322	87.500	87.500	87.367	87.186	87.027	86.826	86.652	85.169	85.700	85.744	85.750	85.753	85.240	84.145	83.750	83.329		
BASE LEVEL	87.644	87.470	87.301	87.116	86.884	86.655	86.384	86.109	85.800	85.472	85.125	84.777	84.449	84.128	83.935	83.748	83.570	83.325	83.324	83.338	83.325	83.307			

Section E-E

Scale: 1:200 Horizontal
1:100 Vertical

SURVEY INFORMATION
MK Surveys - 01908 565561
DRG NUMBER: 17523 - Sheets 1-12
DATE RECEIVED: 17/12/2014

ARCHITECT SITE PLAN INFORMATION
PRP Architects - 020 7653 3464
DRG NUMBER: A16157C-3000-B/3100-D
DATE RECEIVED: Sept 2016

NOTES

- All dimensions and levels are in metres unless otherwise noted
- This drawing is to be read in conjunction with the relevant Architect/Engineer's drawings, specifications and CDM documentation
- This drawing has been produced electronically and may have been photo reduced or enlarged when copied. Work to figured dimensions only (DO NOT SCALE). All dimensions to be checked on site. Any errors or omissions to be reported to the engineer immediately.
- This drawing contains coloured lines / information that may not be clear if reproduced in black and white.



Sheet Arrangement (1:2500)

Key:

	Retaining Element
	River Corridor Retaining - Green Slope
	Typical Fill Level

P02	NJ	TST	Amendments following comments from Planning Authority	03/11/16
P01	SNN	TST	Initial issue	22/02/16
Rev	Drawn by	Chkd by	Comments	Date

DRAWING TITLE
Site Cross Sections
Sheet 2 of 4

PROJECT
Phase 2
Bicester Eco Village
Bicester
Oxon

DESIGNED BY TST	DRAFTED BY SNN	APPROVED BY DJ
DATE 22/02/2016	STATUS INFORMATION	

SCALE
As Noted

CLIENT

JOB NUMBER 15-1859	DRAWING NUMBER 44-2	REVISION P02
-----------------------	------------------------	-----------------

X:\VCS_jobs\1800 Jobs\15-1859 Bicester Phase 2\01 - Drawings\01 CH\15-1859_Sectors.dwg