


Appendix D: Sewer Asset Location Plans




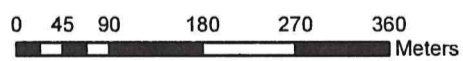

The position of the apparatus shown on this plan is given without obligation and warranty, and the accuracy cannot be guaranteed. Service pipes are not shown but their presence should be anticipated. No liability of any kind whatsoever is accepted by Thames Water for any error or omission. The actual position of mains and services must be verified before any works are undertaken. Crown copyright Reserved

Scale: 1:7165
Width: 2001m
Printed By: dshivaji
Print Date: 03/07/2018
Map Centre: 435396,236957
Grid Reference: SP3536NW

Comments:

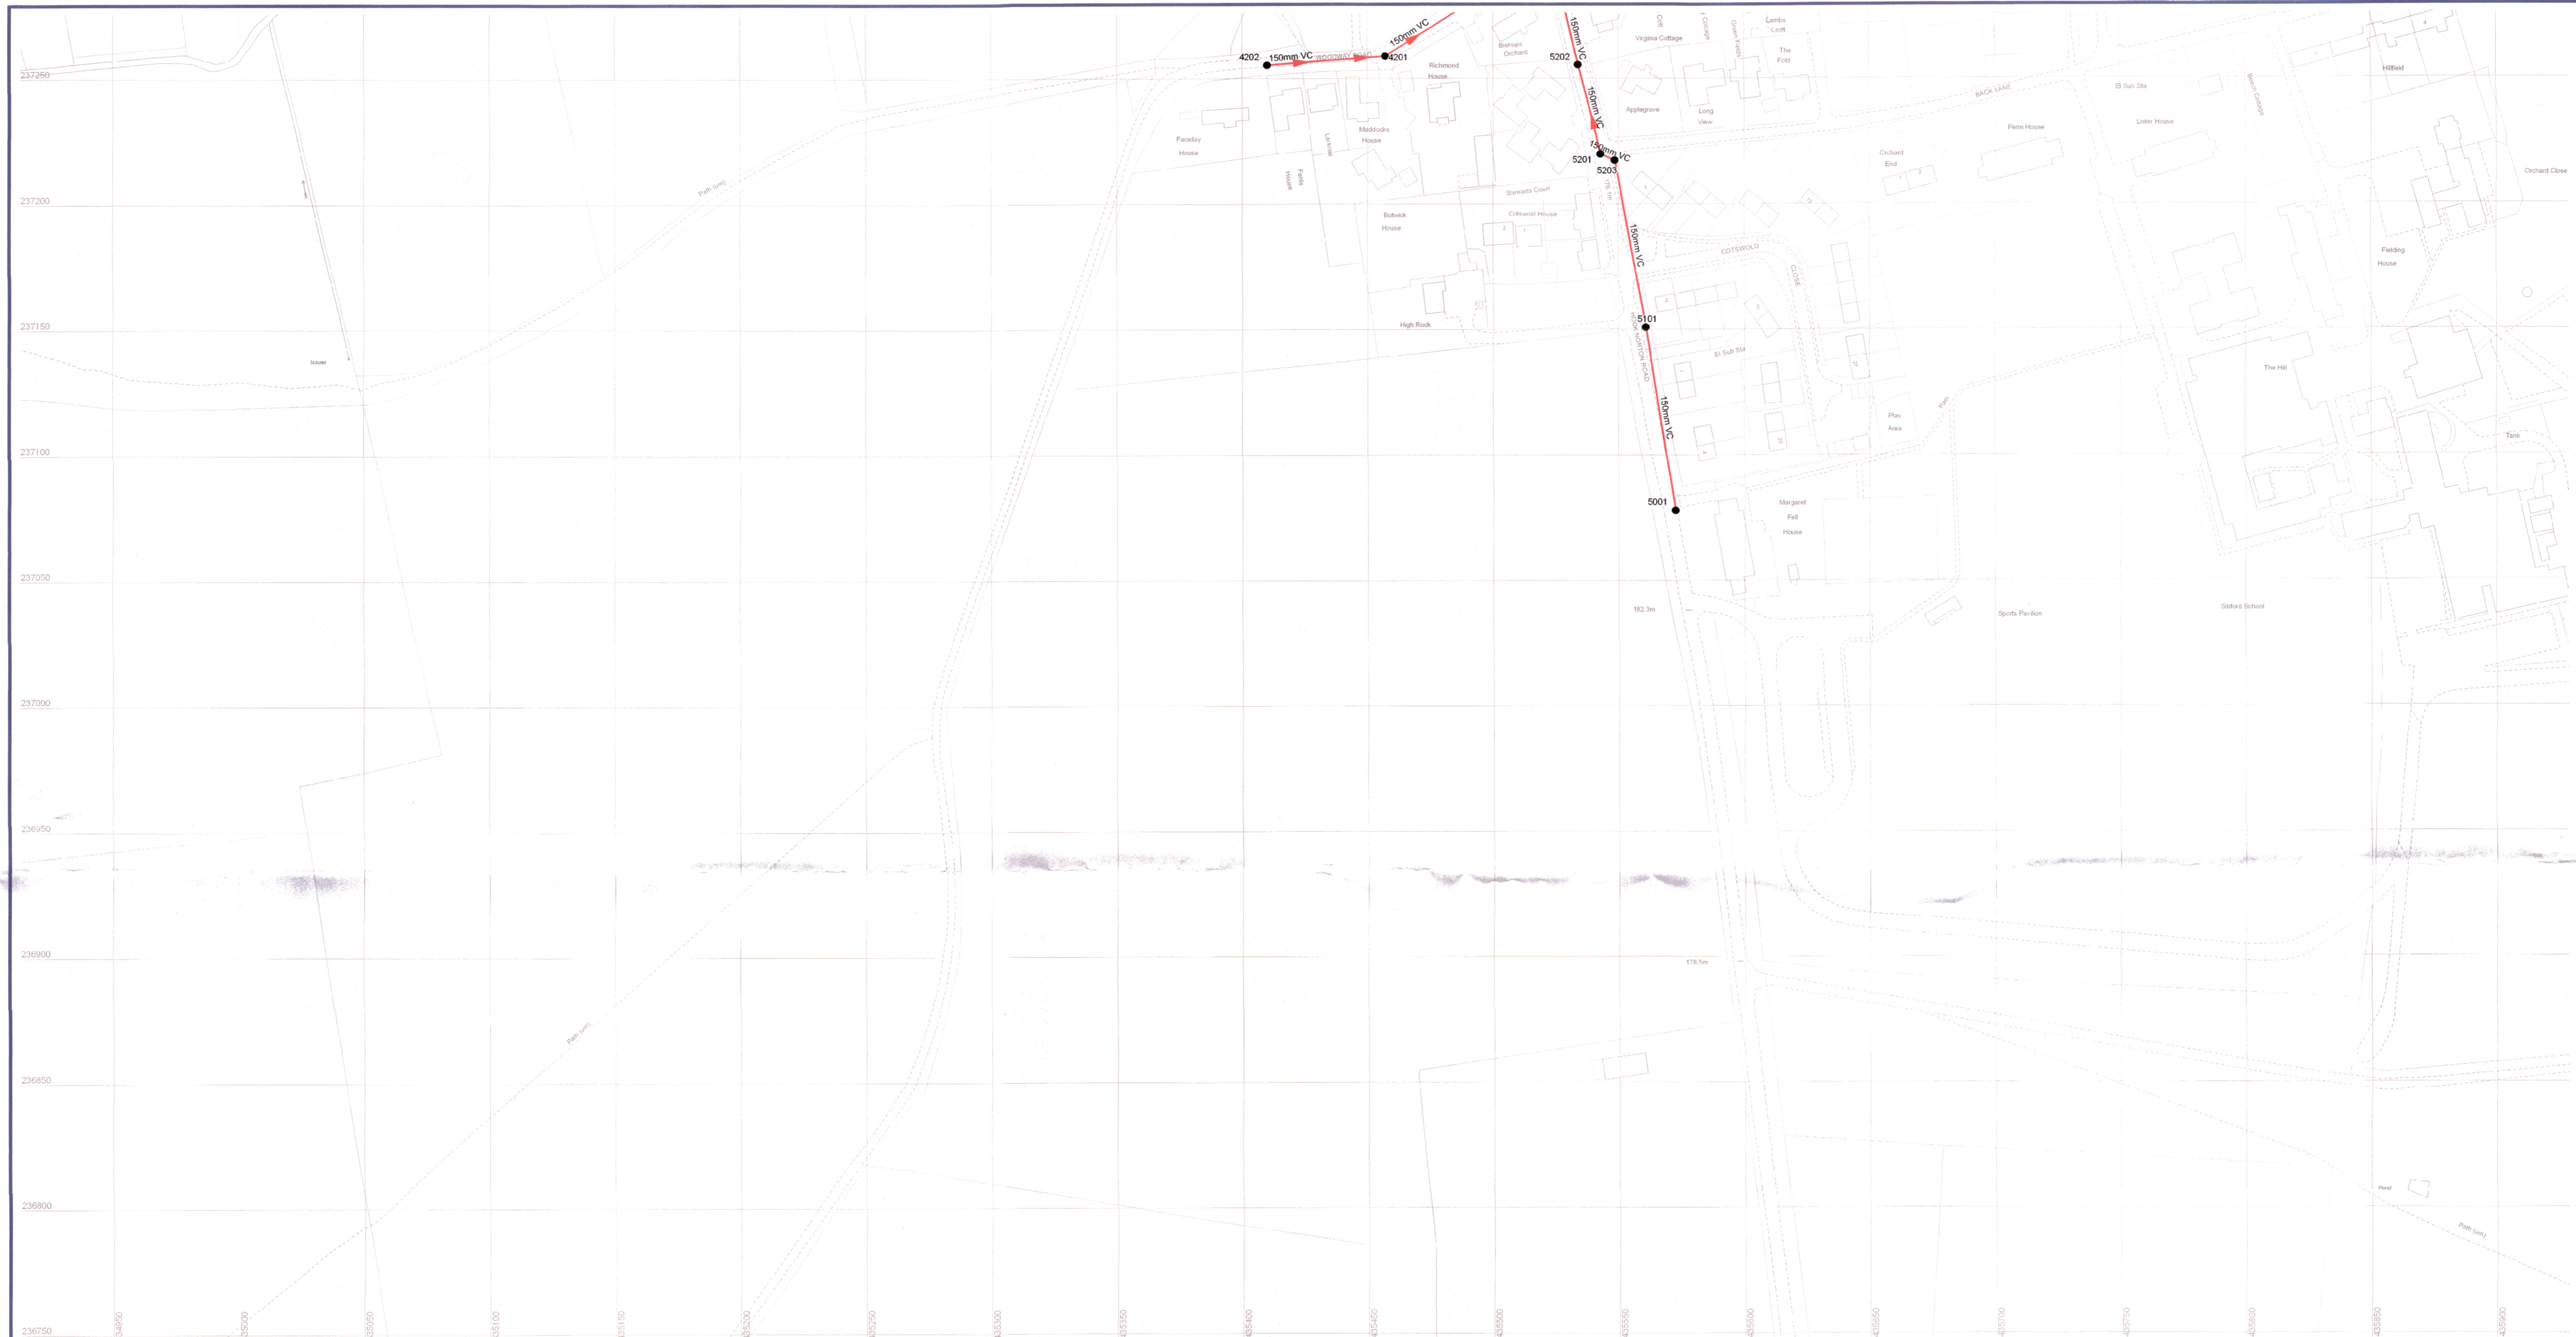

CATEGORIES

- W - WEIR
- C - CASCADE
- DB - DAMBOARD
- SE - SIDE ENTRY
- FV - FLAP VALVE
- BD - BACK DROP
- S - SIPHON
- HD - HIGHWAY DRAIN
- S104 - SECTION 104

All Private Sewers are shown in magenta
 All section 104 sewers are shown in green
 All Sewers that have been transferred to Severn Trent Water after the 1st October 2011, but have not been surveyed and confirmed by Severn Trent Water are shown in orange



Severn Trent Water Limited
Asset Data Management
PO Box 5344
Coventry
CV3 9FT
Telephone: 0845 601 6616

SEWER RECORD

O/S Map 1:1250
Scale:
Date of issue: 17.07.18

This map is centred upon:
 O/S Grid reference:
x : 435421
y : 237012

Disclaimer Statement:
 1. Do not scale off this Map.
 2. This map and any information supplied with it is furnished as a general guide, is only valid at the date of issue and no warranty as to its correctness is given or implied. In particular this Map and any information shown on it must not be relied upon in the event of any development or works (including but not limited to excavations) in the vicinity of Severn Trent Water's assets or for the purposes of determining the suitability of a point of connection to the sewerage or distribution systems.
 3. On 1 October 2011 most private sewers and private lateral drains in Severn Trent Water's sewerage areas, which were connected to a public sewer as at 1 July 2011, transferred to the ownership of Severn Trent Water and became public sewers and public lateral drains. A further transfer takes place on 1 October 2012 (date to be confirmed). Private pumping stations, which form part of these sewers or lateral drains, will transfer to the ownership of Severn Trent Water on or before 1 October 2016.
 Severn Trent Water does not possess complete records of these assets.
 These assets may not be displayed on this Map.
 4. Reproduction by permission of Ordnance Survey on behalf of HMSO. © Crown Copyright and database right 2004. All rights reserved. Ordnance Survey licence number 100018202. Document users other than Severn Trent Water business users are advised that this document is provided for reference purpose only and is subject to copyright, therefore, no further copies should be made from it.