


### KEY

<b>GENERAL</b>	<b>PIPE MATERIALS</b>
Av AVERAGE	AC ASBESTOS CEMENT
Cow CABLE ON WALL	Alk ALKATHENE
Dis DISBURSED	Brk BRICK
Dk DROP KERB	CI CAST IRON
Em ELECTROMAGNETIC LOCATOR	Co CONCRETE
Eot END OF TRACE	Di DUCTILE IRON
Fo FIBRE OPTIC	HoP HIGH DENSITY PE
Fp FOOTPATH	MoP MEDIUM DENSITY PE
Fw FOLI WATER	Pe POLYETHYLENE
Gp GATE POST	Pf PITCH FIBRE
Gpr GROUND PENETRATING RADAR	Pp POLYPROPYLENE
Hb HARD BED	PvcU POLYVINYL CHLORIDE
Hp HIGH PRESSURE	U Ultra (RIB) PVC
Hv HIGH VOLTAGE	SI SPUN IRON
Kv KILD VOLT	St STEEL
Ip INTERMEDIATE PRESSURE	Vc VITRIFIED CLAY
Lv LOW PRESSURE	
Mp MEDIUM PRESSURE	<b>FENCES</b>
Nd NO DEPTH INFORMATION	Bw BARBED WIRE FENCE
Nfi NO FURTHER INFORMATION	Cb CLOSED BOARD FENCE
Ndv NO DUCTS VISIBLE	Cpl CONCRETE PANEL FENCE
Npv NO PIPES VISIBLE	Cri CORRUGATED IRON FENCE
Osbm ORDNANCE SURVEY BENCHMARK	Cnp CHESTNUT PALING
Pow PIPE ON WALL	Cl CHAIN LINK FENCE
Pbox POST BOX	Ir IRON RAILINGS
Red REDUNDANT SERVICE	Ll LARCH LAF FENCE
Rw RETAINING WALL	Pr POST AND RAIL FENCE
Sb SOFT BED	Pw POST AND WIRE FENCE
Snp STREET NAME PLATE	Wm WIRE MESH FENCE
Sw SURFACE WATER	
Tac TACTILE PAVING	<b>LEVELS</b>
Tow TOP OF WALL	Bd BACKDROP LEVEL
Tv TRADE EFFLUENT WATER	Bl BASE LEVEL
Utl UNABLE TO LOCATE	Cv COVER LEVEL
Ura UNABLE TO RAISE	Cw CROWN LEVEL
Uts UNABLE TO SURVEY	Dpc DAMP PROOF COURSE
	Fl FLOOR LEVEL
	Il INVERT LEVEL
	Pt P TRAP LEVEL
	Rl ROOF LEVEL
	Sl SILT LEVEL
	Sof SOFT LEVEL
	Thl THRESHOLD LEVEL
	Wl WATER LEVEL
<b>APPARATUS</b>	<b>APPARATUS</b>
Av AIR CONDITIONING UNIT	Av AIR VALVE
Bd BELLSHA BEACON	Bb BOLLARD
Bol BOLLARD LIGHT	Bs BUS STOP
Catv CATV	Cb CONTROL BOX
Cp CROSSING CONTROL BUTTON	Cr CABLE RISER
Chm CHAIN HOLE	Cch CHAIN CHANNEL
EB ELECTRIC CONTROL BOX	ER EARTH ROD
EP ELECTRIC POLE	FD FILTER DRAIN
ER EARTH ROD	FFP FUEL TANK FILL POINT
FD FILTER DRAIN	FH FIRE HYDRANT
FFP FUEL TANK FILL POINT	GR GAS RISER
FH FIRE HYDRANT	GR GAS RISER
GR GAS RISER	GV GAS VALVE
GV GAS VALVE	GY GULLY
IC INSPECTION COVER	INT INTERCEPTOR
INT INTERCEPTOR	IN INLET
IN INLET	KO KERB OUTLET
KO KERB OUTLET	LD LOOP DETECTOR
LD LOOP DETECTOR	LH LAMP HOLE
LH LAMP HOLE	LP LAMP POST
LP LAMP POST	Mh MANHOLE
Mh MANHOLE	Mk MARKER POST / PLATE
Mk MARKER POST / PLATE	Mt METER
Mt METER	Mw MONITORING WELL
Mw MONITORING WELL	Ou OUTLET
Ou OUTLET	PO POST
PO POST	PTG PIPE TO GROUND
PTG PIPE TO GROUND	PTS PIPE TO SURFACE
PTS PIPE TO SURFACE	Pu PUMP
Pu PUMP	RE ROODING EYE
RE ROODING EYE	RS ROAD SIGN
RS ROAD SIGN	Rm RISING MAIN
Rm RISING MAIN	Rwp RAIN WATER PIPE
Rwp RAIN WATER PIPE	SC STOP COOK
SC STOP COOK	SO SKANAWAY
SO SKANAWAY	SP SOIL PIPE
SP SOIL PIPE	ST STAY CABLE
ST STAY CABLE	SV STOP / SLUCE VALVE
SV STOP / SLUCE VALVE	SVP SOIL VENT PIPE
SVP SOIL VENT PIPE	Tcb TELEPHONE CALL BOX
Tcb TELEPHONE CALL BOX	TEL TELECOM INSPECTION COVER
TEL TELECOM INSPECTION COVER	Tl TRAFFIC LIGHT
Tl TRAFFIC LIGHT	Tlc TRAFFIC LIGHT COVER
Tlc TRAFFIC LIGHT COVER	Tm TICKET MACHINE
Tm TICKET MACHINE	TO TELECOM POLE
TO TELECOM POLE	Vp VENT PIPE
Vp VENT PIPE	WM WATER METER
WM WATER METER	WO WASH OUT
WO WASH OUT	WR WATER RISER
WR WATER RISER	WT WATER TAP
WT WATER TAP	Ww WET WELL
Ww WET WELL	
<b>DEPTHS</b>	
d ELECTRONICALLY DERIVED	
pd PASSIVELY DERIVED	
bd BASE DEPTH	
cd DEPTH TO CROWN	
id DEPTH TO INVERT	
sd DEPTH TO SOFFIT	
<b>CAUTIONARY NOTES</b>	

- EML techniques have been used in the detection of underground utilities as outlined in Table 2 of PAS 128:2014. The results are not infallible and trial excavations must be carried out in order to confirm identification, position and in particular depth of the utility.
  - GPR techniques have been used in the detection of non-metallic utilities as outlined in Table 2 of PAS 128:2014. The interpretation of these results is not infallible and success will depend on a number of factors including soil type, ground water levels and surface conditions. Hence trial excavations must be carried out in order to confirm identification, position and in particular depth of the utility.
  - Depths derived via EML are taken to the centre of the conductor (cable, metallic pipe) and those derived via GPR are usually to the crown of the utility unless otherwise indicated.
  - Where cables cannot be detected individually an average depth has been obtained and trial excavations are recommended to confirm number and depths of cables banded together.
  - 'Hot-ended' cables are often difficult to detect and although we have made all reasonable efforts to locate or transpose this information from records, we cannot guarantee that all 'hot-ended' cables have been located.
  - Fibre optic cables are often difficult to detect, and commonly access chambers can be locked and thereby made inaccessible by the utility provider. All reasonable efforts have been made to locate these ducts using GPR. Cables not located have been transposed from records.
  - Within close proximity of electrical substations and similar structures results using EML may become distorted. All reasonable efforts have been made to verify our results using GPR wherever conditions permitted.
  - Underneath overhead power lines results using EML may become distorted. All reasonable efforts have been made to verify our results using GPR wherever conditions permitted.
  - Drainage information has been obtained without man entry into the chamber.
  - Wherever possible we have attempted to locate the route of the sewer. Issues such as blockages, surcharging, flooding, sedimentation, sewer collapse, root ingress, excessive depth, obstructions or heavy traffic flow may have affected our ability to obtain meaningful results. In these cases recommendations have been made for further survey or maintenance work.
  - Pipe / duct sizes have been recorded from surface inspection or taken from record information. Pipe sizes have been recorded in millimetres and depths in metres, except in instances where sizes are indicated in imperial units on the record information.
  - Water and Gas utilities to individual properties are often of a size that cannot be detected using EML or GPR. Investigation, whenever possible the route has been added from surface evidence (pipe risers, valves, etc.) but this should be viewed as a guide only.
  - All utilities detected should be considered live unless confirmed otherwise by client or service provider.
  - We cannot confirm when utilities are redundant unless there is visual or record evidence to indicate this. In addition we cannot guarantee being able to detect all redundant utilities.
  - Wherever available the results of our investigations have been cross referenced with record information. If a utility shown on the records cannot be detected on site, the information has been added to the drawing and indicated as QBA (R). However it should be noted that the completeness and accuracy of the records cannot be guaranteed.
  - The utility information has been obtained from non-intrusive survey techniques; it always remains possible that there are additional utilities within the survey boundary that we have not been able to detect. We recommend that care is taken on site and that all utility records are used in conjunction with this survey.
  - The responsibility for avoiding damage to assets and utilities on site shall be that of the persons proposing to excavate within the surveyed area, who shall be liable to the asset owner and any third party who may be affected in any way for any loss or damage.
- ALWAYS EXERCISE CAUTION WHEN EXCAVATING.**

Quality Level	Description	Accuracy
QB4	A utility is expected to exist but cannot be detected - (AR), (R), (V)	Undefined
QB3	Horizontal location only using one geophysical technique	±1-500mm Horizontal
QB3P	No depth information - NDI	Undefined Vertical
QB2	Horizontal and vertical location only using one geophysical technique	±1-250mm or ±1-40% of depth whichever is greater
QB1	Horizontal and vertical location only using two geophysical techniques	±1-150mm or ±1-15% of depth whichever is greater
QA	Service verified in an open excavation, inside an inspection chamber / draw pit, or at the point the service enters / exits the ground.	±1-50mm Horizontal ±1-25mm Vertical

Utility Type	Provider Details	Date Acquired
Drainage	Thames Water	26/07/2021
Water	Thames Water	26/07/2021
Gas	Scottia Gas Networks	22/07/2021
Electricity	Scottish and Southern Electricity Networks	22/07/2021
Telecom	Openreach	22/07/2021
CATV	None Provided	N/A
Communications	Clyffire	22/07/2021

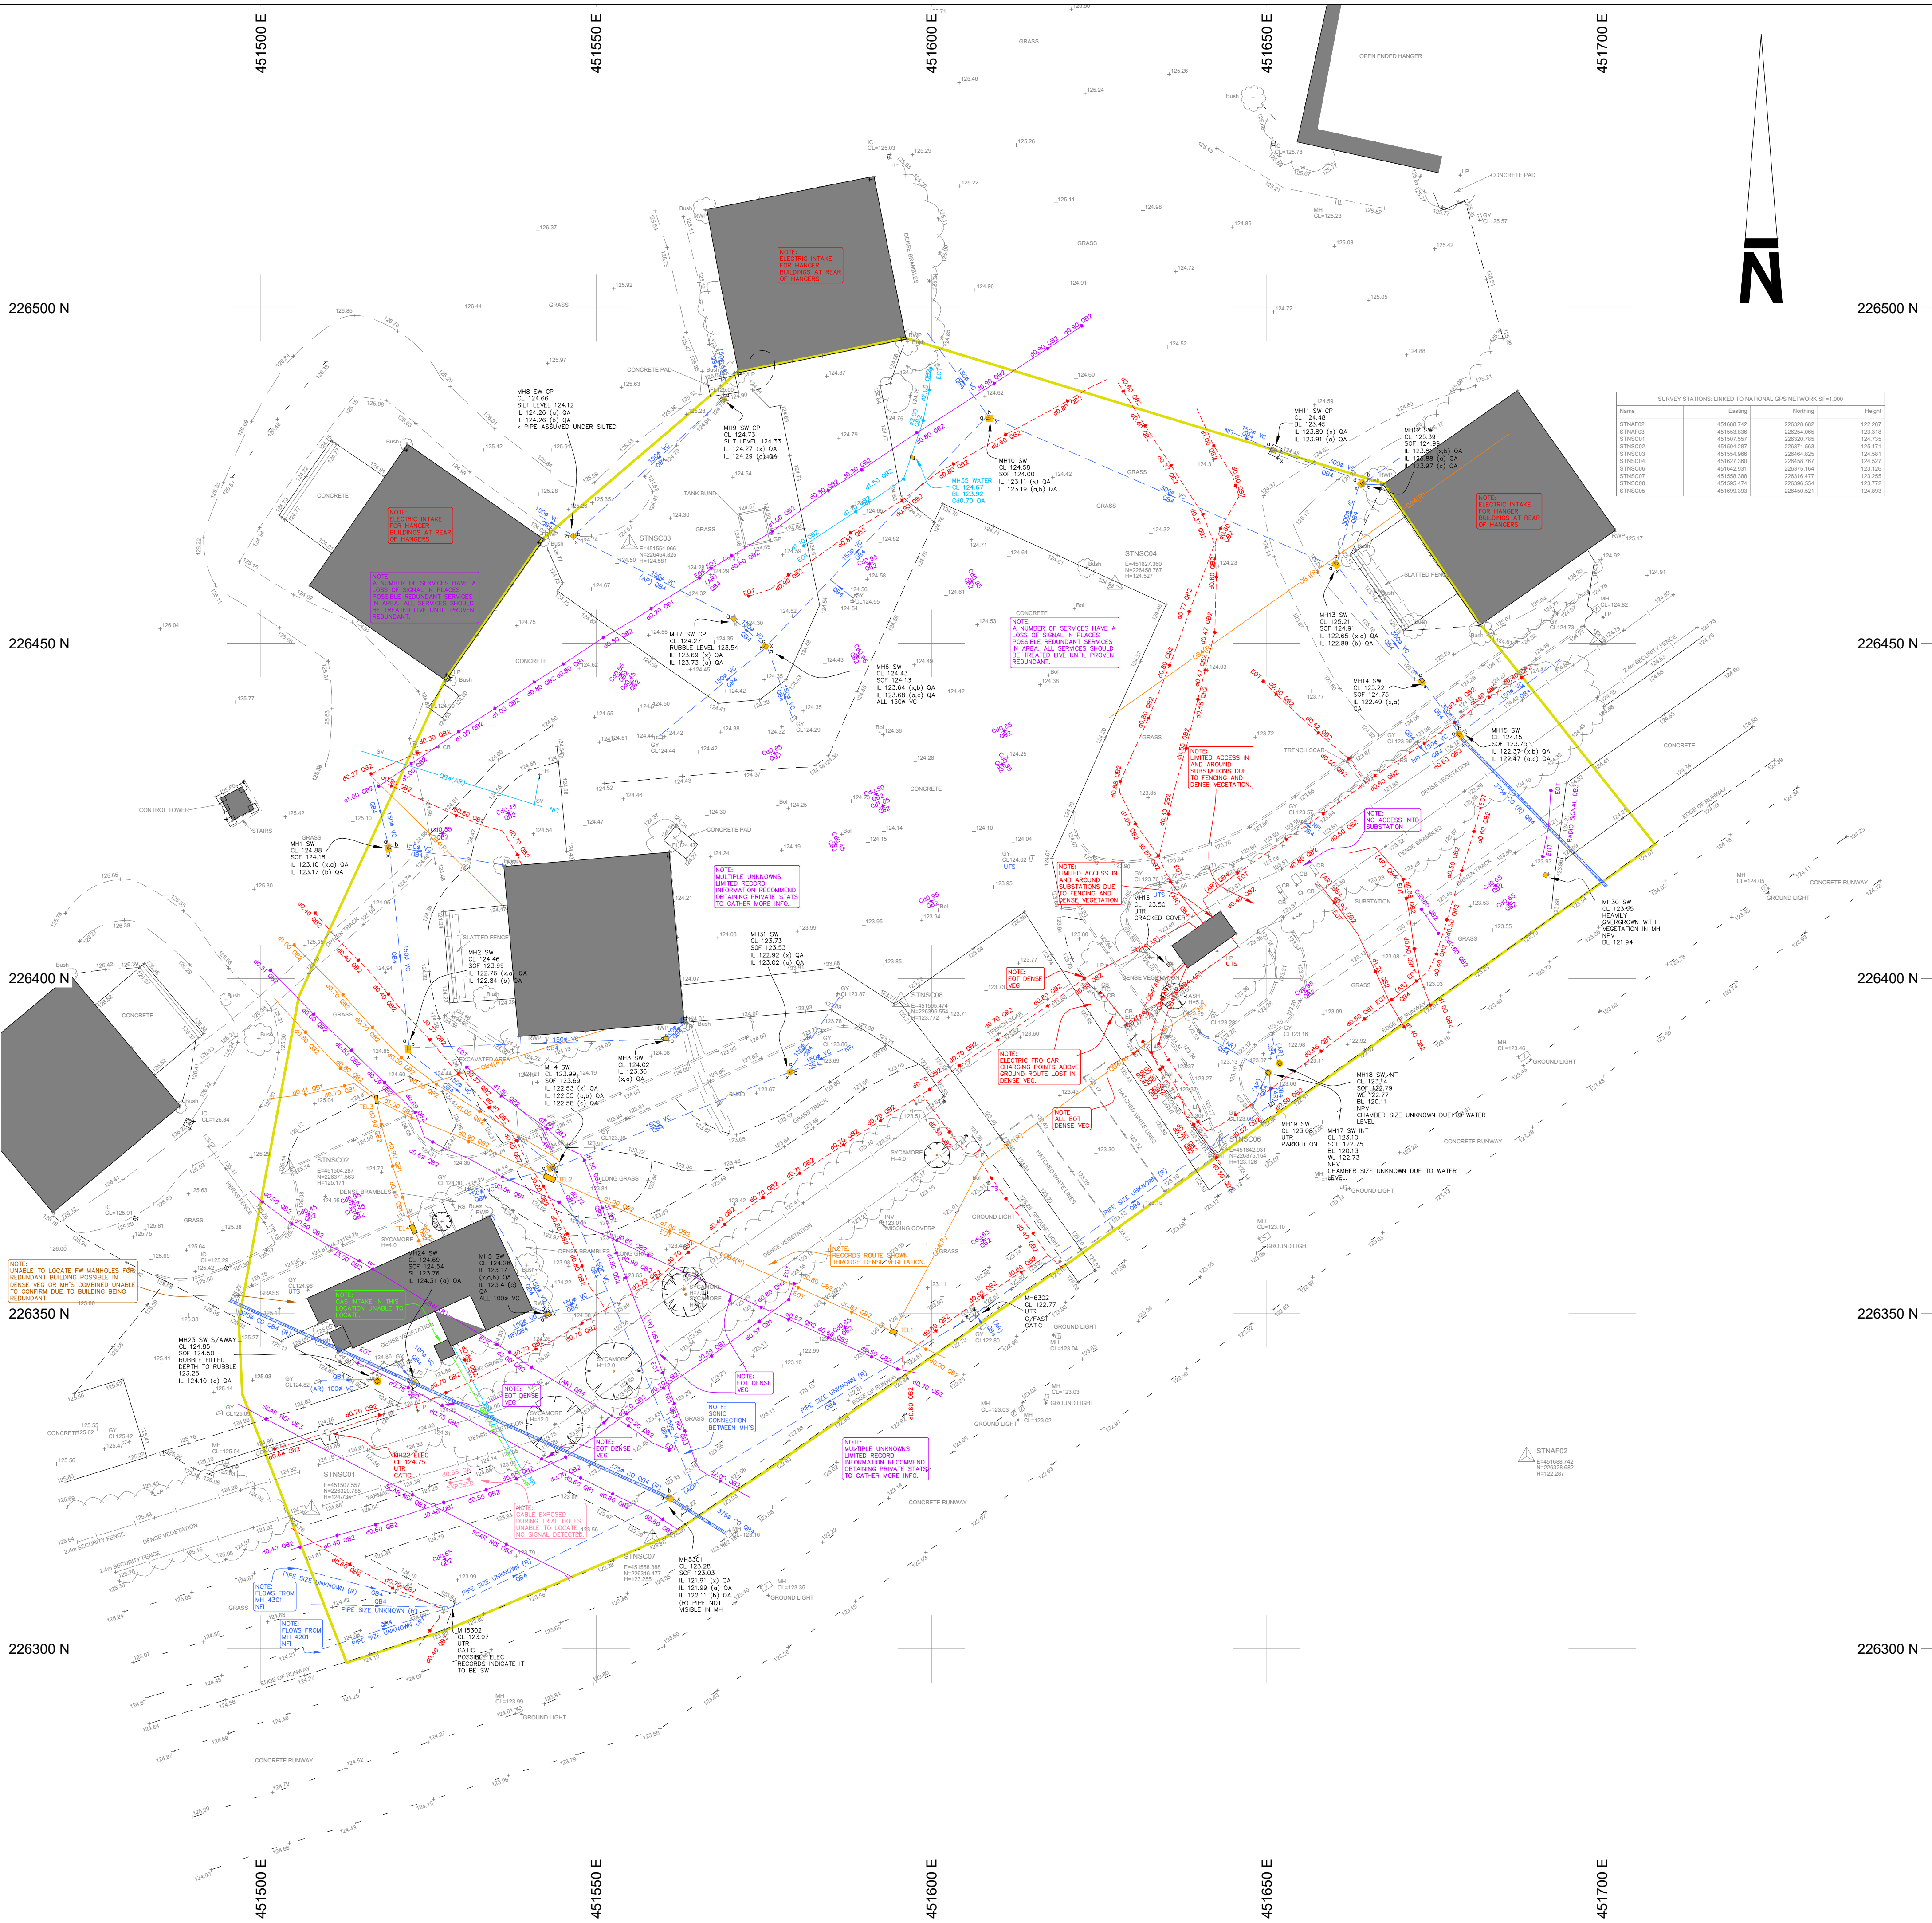

- Notes :
- UTILITY AND SERVICE INFORMATION ADDED TO TOPOGRAPHICAL SURVEY PRODUCED BY WOODS HARDWICK. JOB NO. 16871-7-870. DATE JULY 2021.
  - THIS SURVEY SHOULD ALWAYS BE READ IN CONJUNCTION WITH THE DESKTOP UTILITY STATS.

Equipment Information				
Equipment	Manufacturer	Model	Serial Number	Date of Calibration
EML Tx Transmitter	SPX Radiodetection	RD8000	10TX-108-11192	RD19 12/05/2021
EML Rx Receiver	SPX Radiodetection	RD8100	1081PDL-3375	RD19 12/05/2021
GPR	IDS Georadar	Leica DS2000	SN 010-16-000409	GRP14 Day of Survey

### DETECTION SURVEY REPORT

**GENERAL**  
This survey was carried out in accordance with PAS 128:2014 (Publicly Available Specification from BS). After a pre-survey consultation with the client it was agreed to carry out the detection survey using methodology M1 as per Table 2 of the PAS 128:2014. The survey boundary has been shown on the drawing; please see linearty section of the key for reference.

**DESKTOP UTILITY REPORT**  
Prior to the survey commencing record information was gathered and compiled by client. These stats should be read in conjunction with the information contained in this utility detection survey. Record information was at the time of the survey, less than 90 days old in accordance with the requirements of the PAS 128:2014. For a full list of the providers searched, records received and the date the information was obtained, please refer to the attachments page of the desktop utility report.

**DETECTION SURVEY DRAINAGE**  
Drainage was lifted with pipe sizes and invert levels recorded. Wherever possible the chamber sizes have been recorded and positioned on the drawing. All connections from gullies, external rainwater pipes and external soil stacks have been proven wherever possible. Manholes, manholes and sewer runs by rod sonde location and/or GPR. Where a saddle connection is present the position is assumed only until proven to QB2 or above. In instances where other detection methods were unsuccessful connections between manholes have been assumed to be straight and labelled as QB4. All drainage should be cross checked in critical areas by CCTV survey or verification survey type A. Unable to lift some MHs due to c/cast, damaged or gatic.

**WATER**  
Water utility has been located where possible using EML methods. Thames water records show no private services. Recommend obtaining private stat plans to gather more information on water pipes. Some unknown responses are possibly water services. Recommend trial excavations in critical areas to confirm position and depth of pipes.

**GAS**  
No gas network located. Unable to locate gas for redundant building due to no EML signal and dense vegetation to conduct GPR scans. Gas records show no private gas pipes within survey area. Recommend obtaining private stat plans to gather more information. Some unknown responses are possibly gas services. Recommend trial excavations in critical areas around gas intake for building to confirm route of service.

**ELECTRICITY**  
Electric cables have been located using EML methods with electronically derived depth recorded. Electric records show no private cables recommend obtaining private records to gather more information. HV and LV cables have been identified only from depth and route. Unable to confirm for certain which is HV and LV. Recommend trial excavations in critical areas to confirm position and depth of cables.

**TELECOM**  
Telecom ducts have been traced with depths recorded. Due to laws protecting British Telecom apparatus all ducts have been located using remote detection techniques only and compared with record information. Chamber sizes have been recorded using GPR techniques wherever possible. For further information regarding BT apparatus please contact Openreach directly.

**CATV**  
No CATV or communications ducts located within survey area recommend obtaining records to confirm this.

**UNKNOWN**  
Some unknown targets identified on the drawing using GPR are classified as 'non-linear targets'. These are not consistent with what we expect to see when identifying a buried utility, and appear on the drawing as single targets with depths (i.e. not linking two or more depth readings). This does not mean they are not utilities, we are just unable to positively identify them as a utility. We would strongly recommend that further verification surveys (PAS 128:2014 survey type A) are carried out to identify these targets in critical areas. Many unknowns located using EML methods recommend obtaining private stats to better identify services possible fuel lines in survey area.

**SEE CAUTIONARY NOTES WITHIN THE UTILITY KEY**

REV	DESCRIPTION	DRN	CHD	DATE

<input checked="" type="checkbox"/> PRELIMINARY	<input type="checkbox"/> INFORMATION	<input type="checkbox"/> TENDER
<input type="checkbox"/> CONSTRUCTION	<input type="checkbox"/> AS BUILT	

SCALE: 1:500 @ A1 DATE: AUGUST 2021

DRAWN: WHS CHK: NC

DRAWING NO.: 16871-7-872 REV: -

TITLE: AIRFIELD, CAMP ROAD UPPER HEYFORD

DETAILS: PAS 128:2014 UTILITY SURVEY

**Woods Hardwick**  
Architecture | Engineering | Planning | Surveying

**BEDFORD : HEAD OFFICE**  
15-17 Goldington Road  
Bedford MK40 3NH  
T: +44 (0) 1234 268862

**BIRMINGHAM**  
Fort Dunlop, Fort Parkway  
Birmingham B24 9FE  
T: +44 (0) 121 6297784

ONLINE: [ma2@woodsardwick.com](mailto:ma2@woodsardwick.com) | [woodsardwick.com](http://woodsardwick.com)

PLEASE CONSIDER THE ENVIRONMENT BEFORE PRINTING THIS DRAWING