


SUDs FEATURE - AREA 3

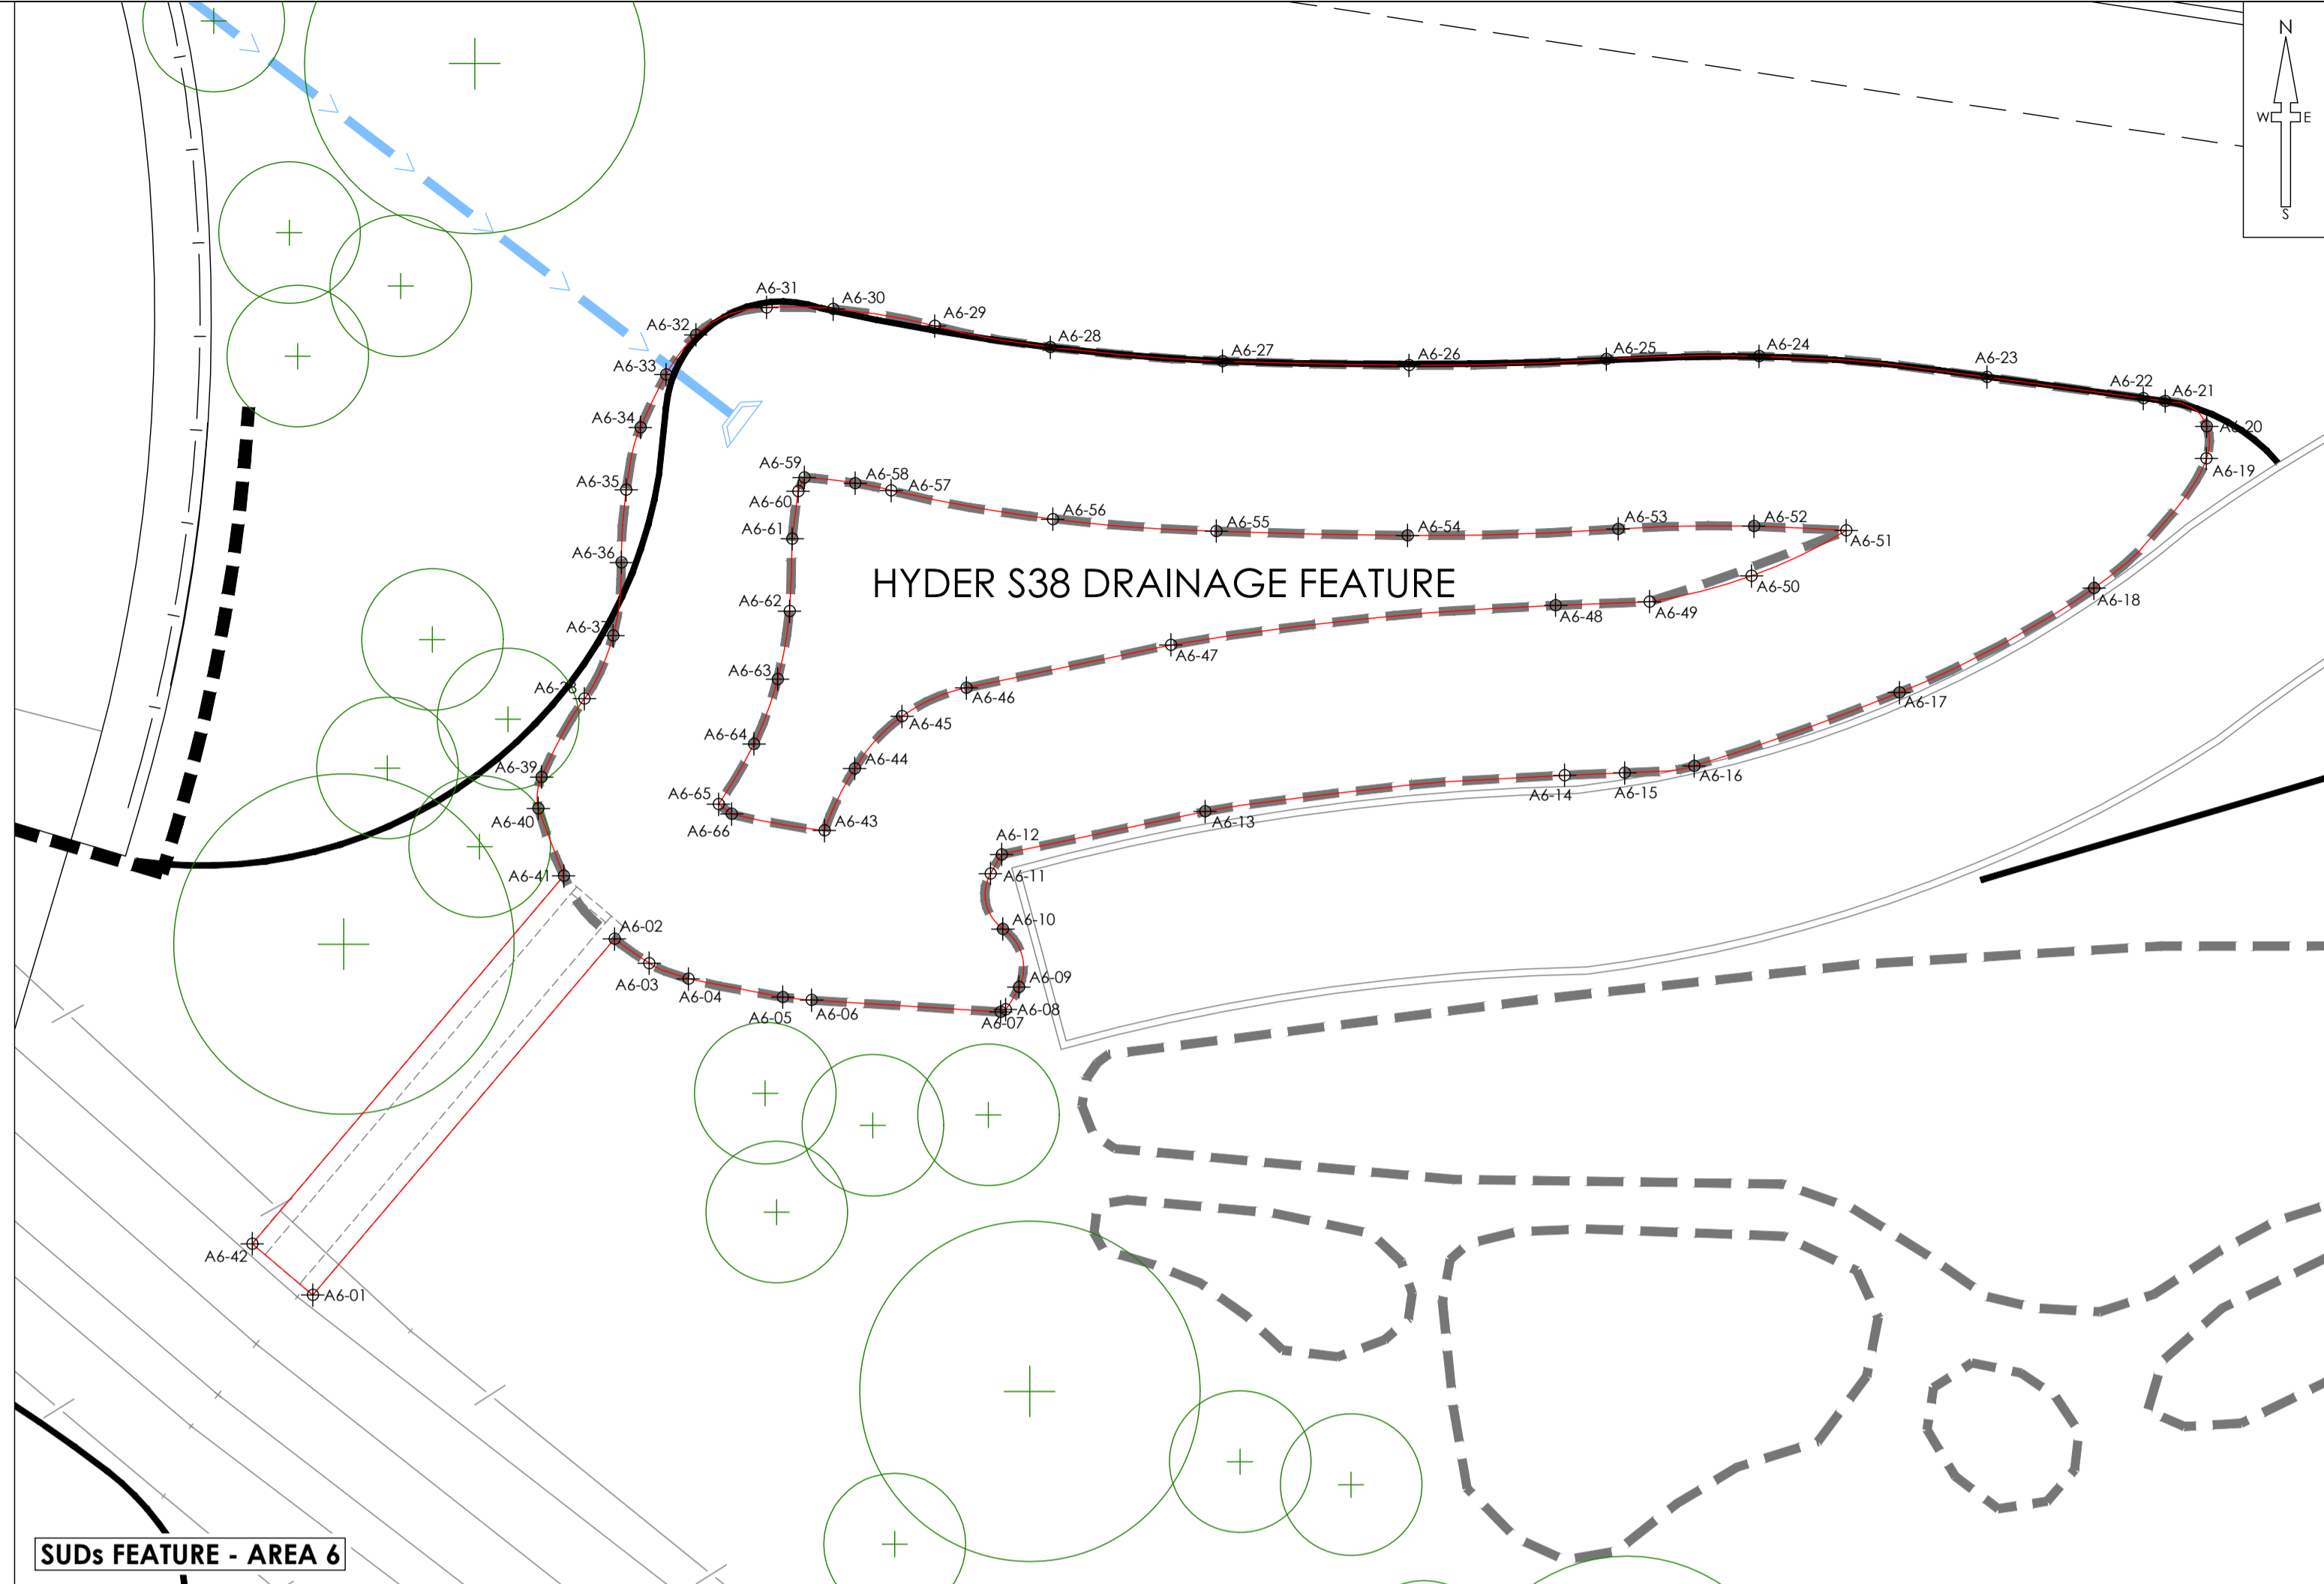

SUDs FEATURE - AREA 6

- NOTES**
- All dimensions and levels are in metres unless otherwise noted
 - This drawing is to be read in conjunction with the relevant Architect's/Engineer's drawings, specifications and CDM documentation
 - This drawings has been produced electronically and may have been photo reduced or enlarged when copied. Work to figured dimensions only (DO NOT SCALE). All dimensions to be checked on site. Any errors or omissions to be reported to the engineer immediately.
 - This drawing contains coloured lines / information that may not be clear if reproduced in black and white.

NOTE:
For Proposed Construction details of SUDs Feature Ponds, Refer drawings: ICS-1859-85-1 (Area 6) and ICS-1859-85-2 (Area 3)

SUDs Feature TOB - Area 3		
	EASTINGS	NORTHINGS
A3-1	457836.473	224855.907
A3-2	457827.288	224858.466
A3-3	457827.669	224859.795
A3-4	457826.486	224862.032
A3-5	457824.555	224860.837
A3-6	457823.118	224857.334
A3-7	457822.243	224854.289
A3-8	457821.473	224851.215
A3-9	457820.784	224848.402
A3-10	457820.224	224845.561
A3-11	457821.687	224843.180
A3-12	457823.471	224844.872
A3-13	457823.881	224846.567
A3-14	457824.387	224848.361
A3-15	457825.644	224852.741
A3-16	457826.902	224857.121
A3-17	457836.097	224854.558

SUDs Feature BOB - Area 3		
	EASTINGS	NORTHINGS
A3-18	457826.712	224860.083
A3-19	457826.194	224861.076
A3-20	457825.210	224860.541
A3-21	457824.072	224857.033
A3-22	457823.205	224854.017
A3-23	457822.444	224850.972
A3-24	457821.764	224848.205
A3-25	457821.213	224845.410
A3-26	457821.748	224844.183
A3-27	457822.499	224845.106
A3-28	457822.907	224846.793
A3-29	457823.431	224848.653
A3-30	457825.071	224854.368

SUDs Feature TOB - Area 6		
	EASTINGS	NORTHINGS
A6-1	457817.438	224932.659
A6-2	457822.758	224938.938
A6-3	457823.373	224938.508
A6-4	457824.061	224938.233
A6-5	457825.729	224937.911
A6-6	457826.236	224937.857
A6-7	457829.569	224937.650
A6-8	457829.657	224937.691
A6-9	457829.892	224938.089
A6-10	457829.609	224939.111
A6-11	457829.389	224940.091
A6-12	457829.585	224940.426
A6-13	457833.174	224941.183
A6-14	457839.514	224941.823
A6-15	457840.573	224941.863
A6-16	457841.796	224941.988
A6-17	457845.415	224943.279
A6-18	457848.847	224945.120
A6-19	457850.830	224947.407
A6-20	457850.834	224947.974
A6-21	457850.102	224948.420
A6-22	457849.717	224948.468
A6-23	457846.960	224948.846
A6-24	457842.944	224949.210
A6-25	457840.249	224949.158
A6-26	457836.766	224949.050
A6-27	457833.482	224949.124
A6-28	457830.442	224949.370
A6-29	457828.404	224949.743
A6-30	457826.616	224950.042
A6-31	457825.442	224950.070
A6-32	457824.196	224949.588
A6-33	457823.668	224948.885
A6-34	457823.216	224947.956
A6-35	457822.966	224946.853
A6-36	457822.879	224945.576
A6-37	457822.735	224944.282
A6-38	457822.231	224943.173
A6-39	457821.472	224941.791
A6-40	457821.416	224941.237
A6-41	457821.865	224940.049
A6-42	457816.370	224933.564

SUDs Feature BOB - Area 6		
	EASTINGS	NORTHINGS
A6-43	457826.463	224940.848
A6-44	457826.996	224941.942
A6-45	457827.831	224942.860
A6-46	457828.945	224943.363
A6-47	457832.571	224944.122
A6-48	457839.355	224944.819
A6-49	457841.010	224944.884
A6-50	457842.808	224945.336
A6-51	457844.481	224946.138
A6-52	457842.851	224946.212
A6-53	457840.458	224946.165
A6-54	457836.742	224946.050
A6-55	457833.372	224946.126
A6-56	457830.487	224946.338
A6-57	457827.638	224946.842
A6-58	457827.006	224946.973
A6-59	457826.106	224947.073
A6-60	457825.997	224946.828
A6-61	457825.892	224945.991
A6-62	457825.844	224944.714
A6-63	457825.635	224943.517
A6-64	457825.221	224942.374
A6-65	457824.594	224941.312
A6-66	457824.825	224941.140

POI	SNN	TST	Initial Issue	05/05/17
Rev	Drawn by	Chk'd by	Comments	Date

DRAWING TITLE
SUDs Feature Setting Out

PROJECT
Phase 2
Bicester Eco Village
Bicester
Oxon

DESIGNED BY TST	DRAFTED BY SNN	APPROVED BY DJ
--------------------	-------------------	-------------------

DATE
05/05/17

STATUS
INFORMATION

SCALE
1:100 @ A1

Scale bar @ 1:100
0m 2.5m 5.0m

CLIENT

JOB NUMBER 15-1859	DRAWING NUMBER 86	REVISION P01
-----------------------	----------------------	-----------------