


NOTE: Location of boardwalk set out under the direction of Cherwell DC planning officer Jenny Barker on 1st June 2018

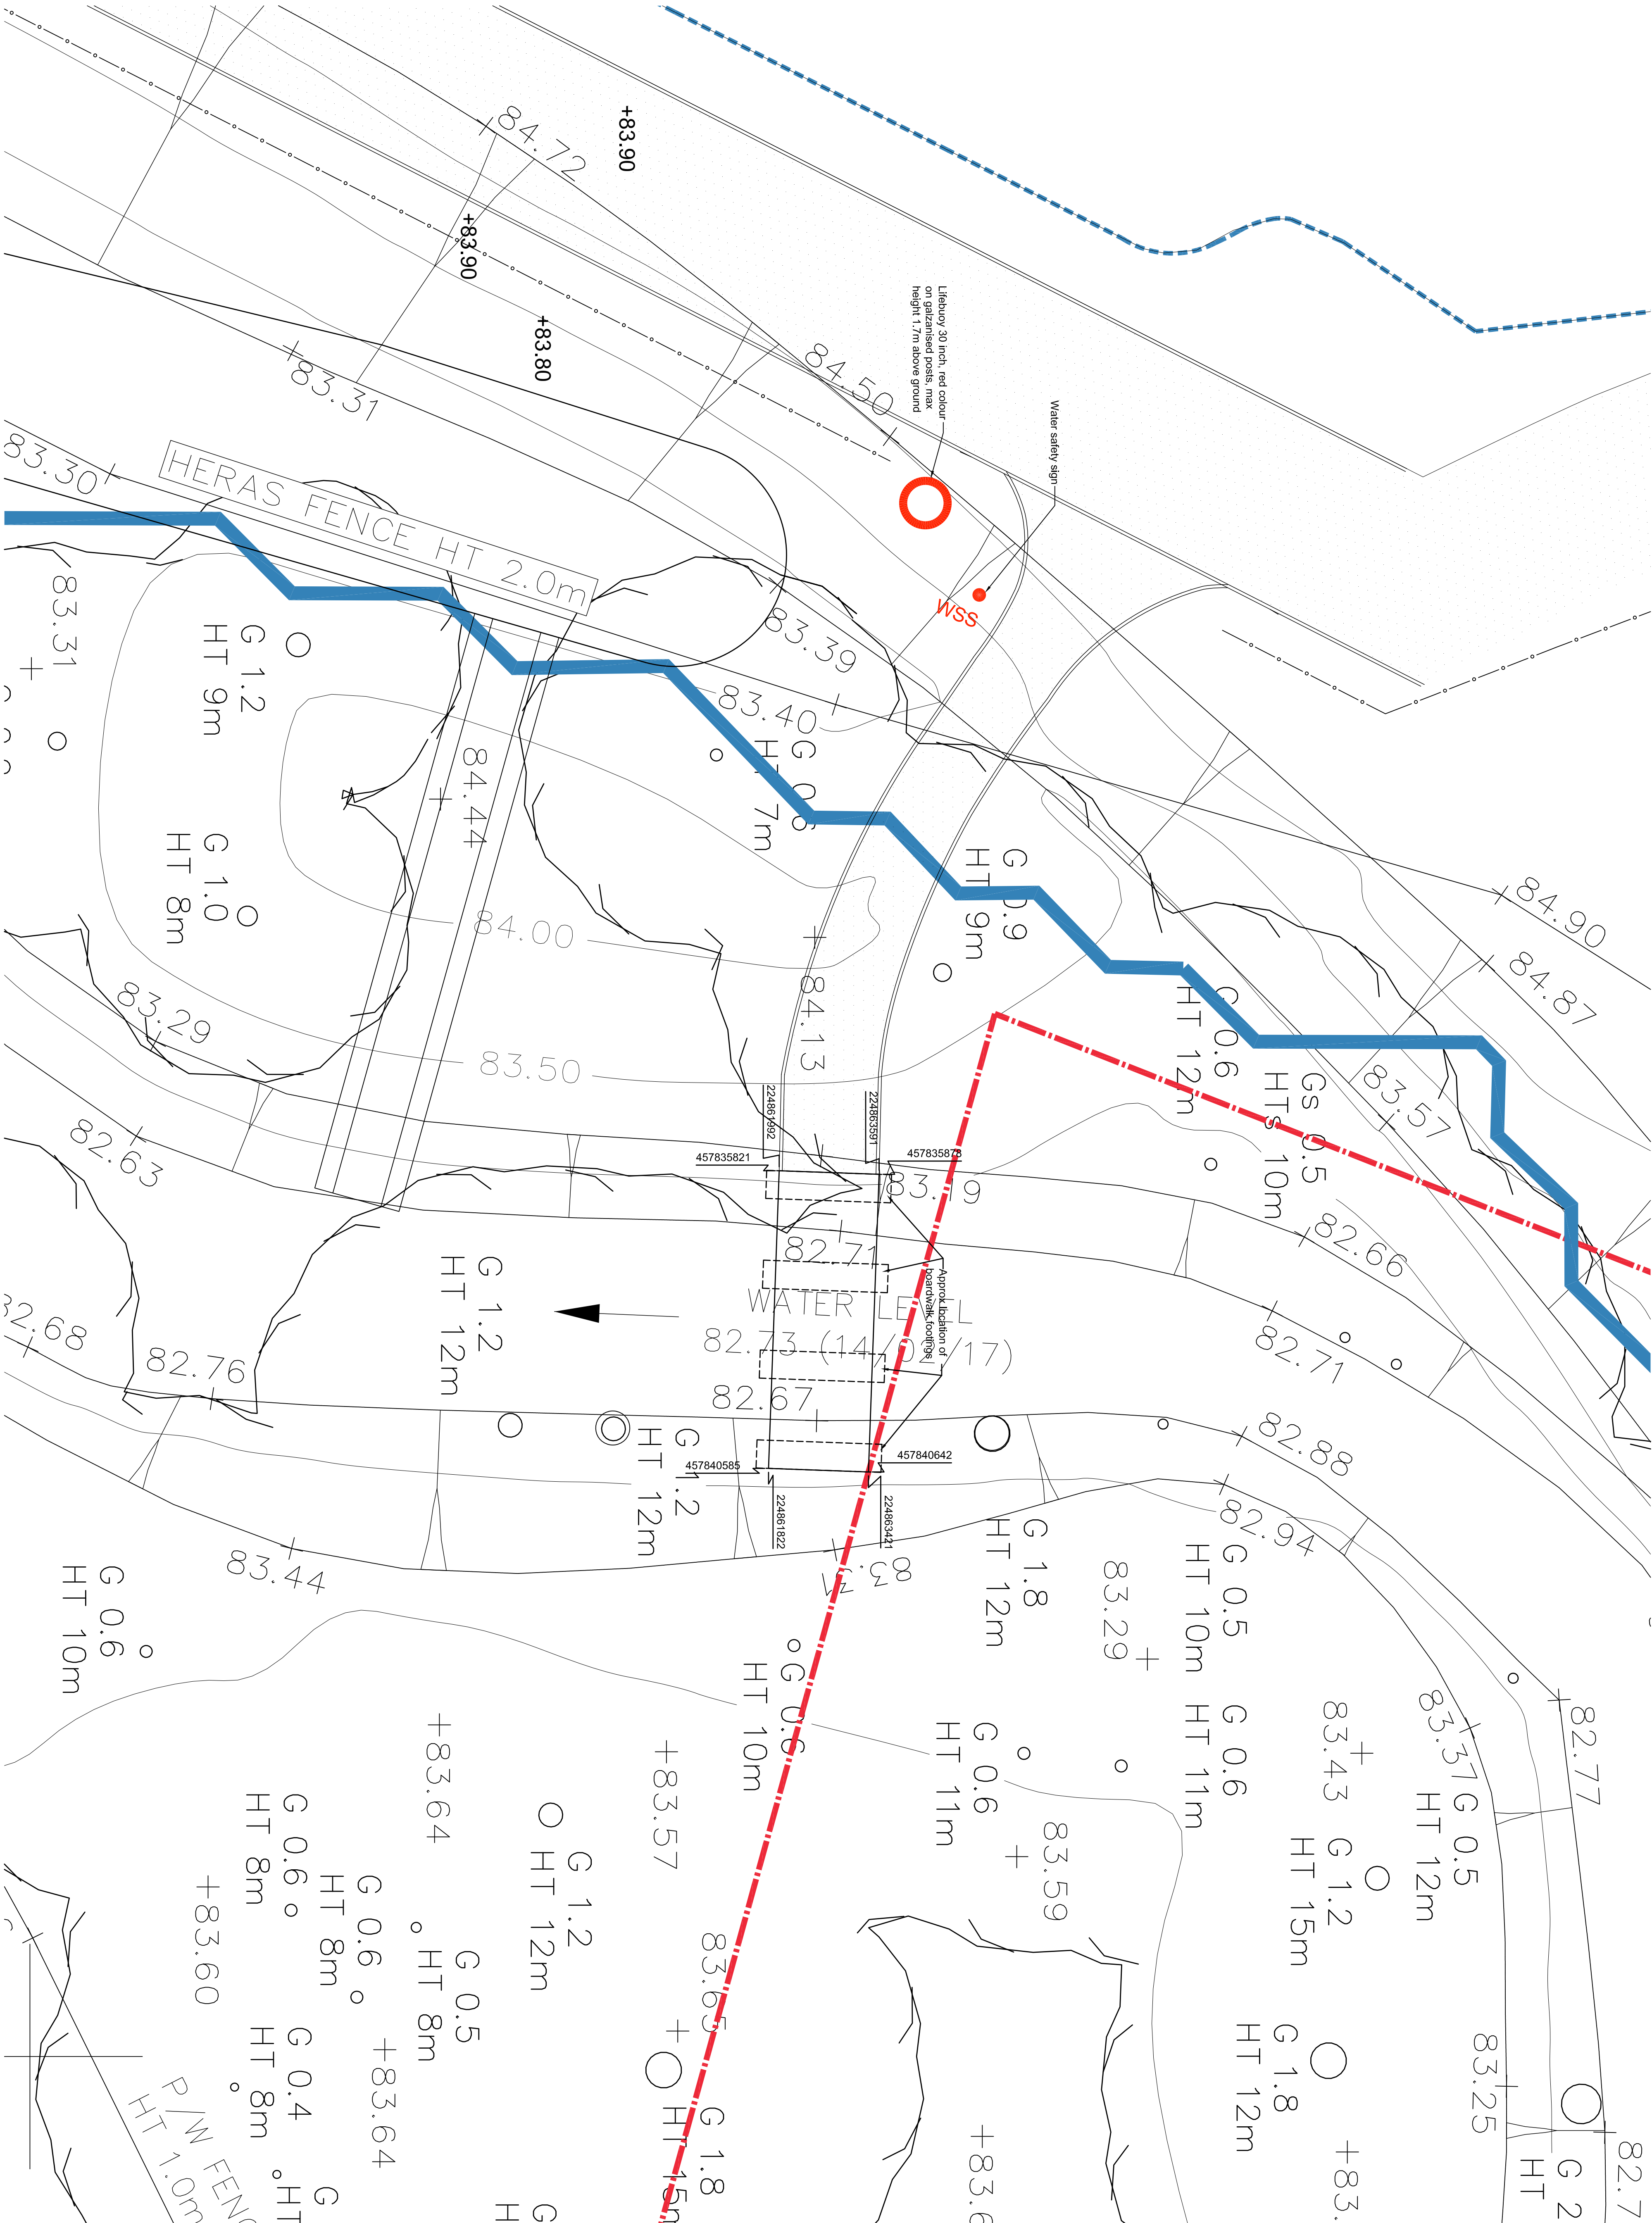

Rev	Date	Description	Dwn	Chd
A	18/07/18	RECORD COPY		
AL6157C_LSK006		RECORD COPY		
Drawn	MD	Checked	MD	Date
18/07/18		18/07/18		Scale @ A1 1:50