

Menu

Next


Advice : HSL-220622163250-963 Crosses Consultation Zone

Please enter further details about the proposed development by continuing with the enquiry on the HSE's Planning Advice Web App from the Previous Enquiries tab either now or at a later time, unless the Web App has stopped the process and notified you to contact HSE.

Your Ref: 31188FM-GWS

Development Name:

Comments:

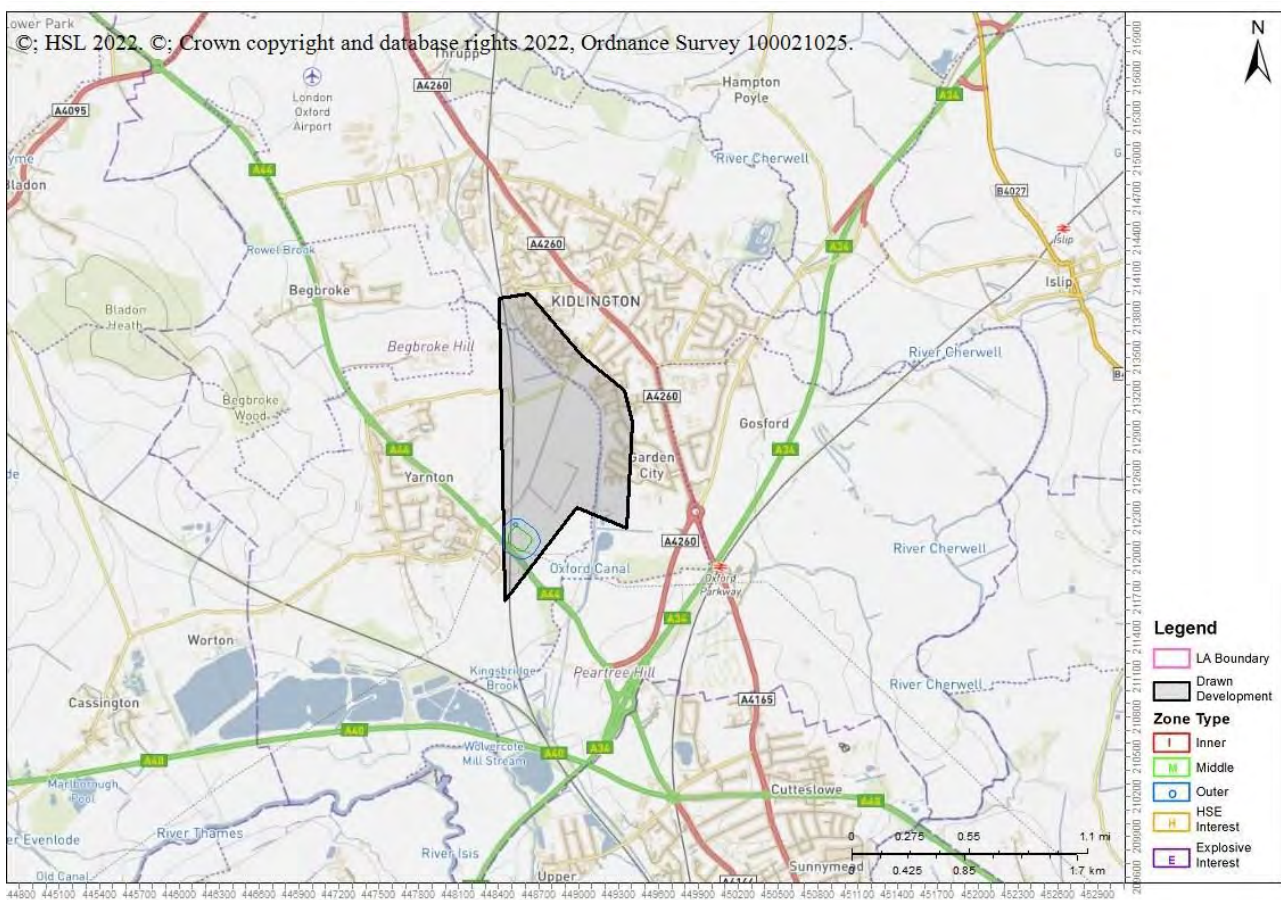

The proposed development site which you have identified currently lies within the consultation distance (CD) of at least one major hazard site and/or major accident hazard pipeline; HSE needs to be consulted on any developments on this site.

This advice report has been generated using information supplied by Francesca Margiotta at Groundwise Searches Ltd on 22 June 2022.

You may wish to contact HSE's Planning Advice team to discuss the above enquiry result on 0203 028 3708 or by email at lupenquiries@hse.gov.uk.

HSE's Advice

HSE Planning Advice has an interest in your enquiry, please download or print your report. **This does NOT mean your planning application has been rejected, but further information is required. For HSE's Planning Advice based on the type of development being proposed please continue your enquiry by clicking the Continue Application link below.**

Our Reference : **HSL-220622163758-963**

Your Reference : **31188FM-GWS**

Development Name :

Date Created : **22/06/2022 16:37:58**


Description/Comments : **STUDY**

Created By : **FMARGIOTTA@GROUNDWISE.COM**

Phase 1 documents
Hazard/Pipelines Report
(../Download/File/?HSLRefer=HSL-220622163758-963&DownloadType=HSEHasAnInterest)

Please check all mapping details, including the drawn planning boundary and background mapping, are correct.

Continue Application >>

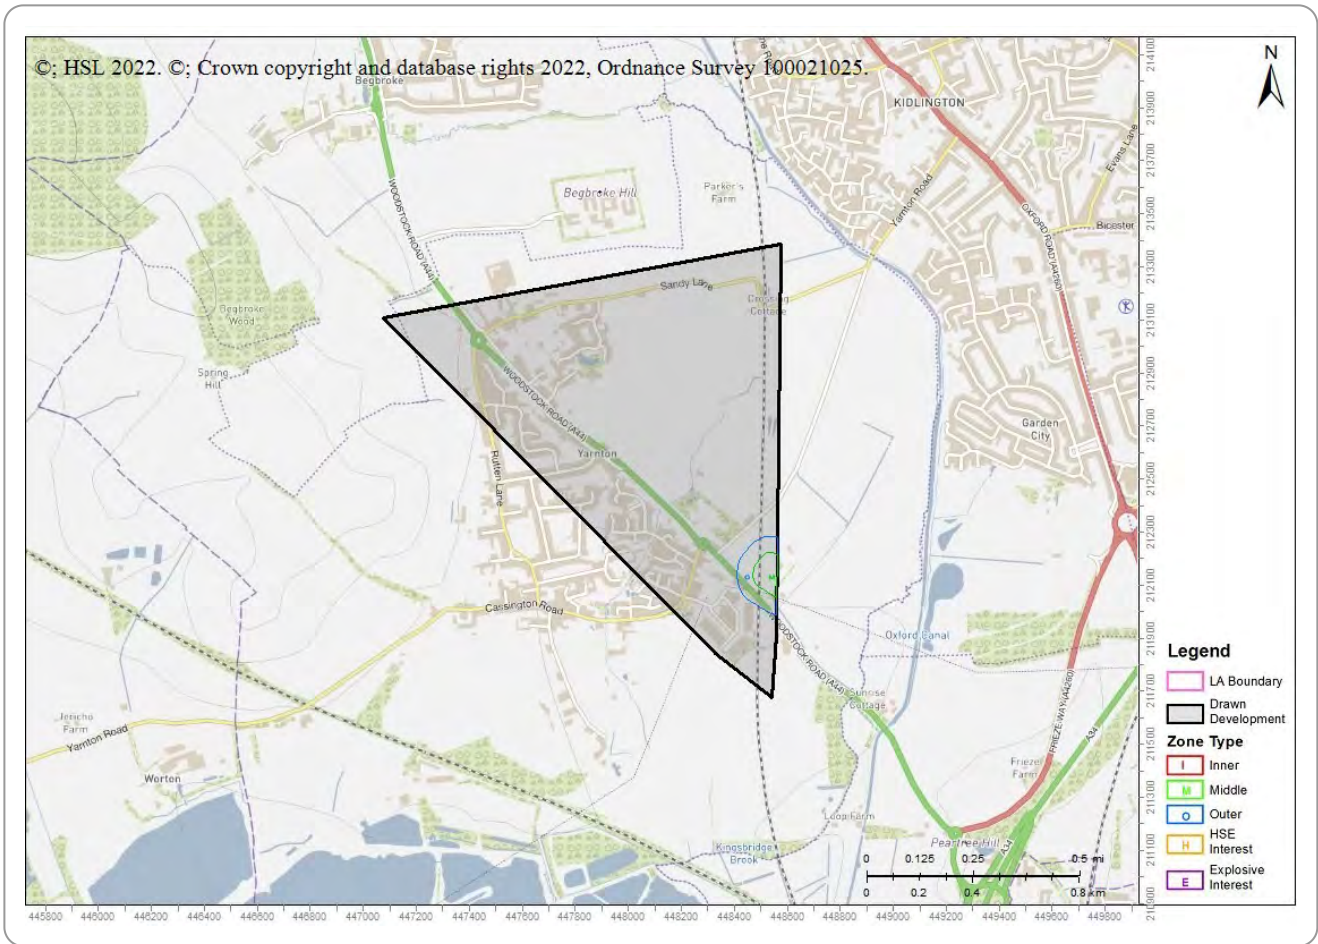

Menu

Next


Advice : HSL-220622163758-963 Crosses Consultation Zone

Please enter further details about the proposed development by continuing with the enquiry on the HSE's Planning Advice Web App from the Previous Enquiries tab either now or at a later time, unless the Web App has stopped the process and notified you to contact HSE.

Your Ref: 31188FM-GWS

Development Name:

Comments: STUDY

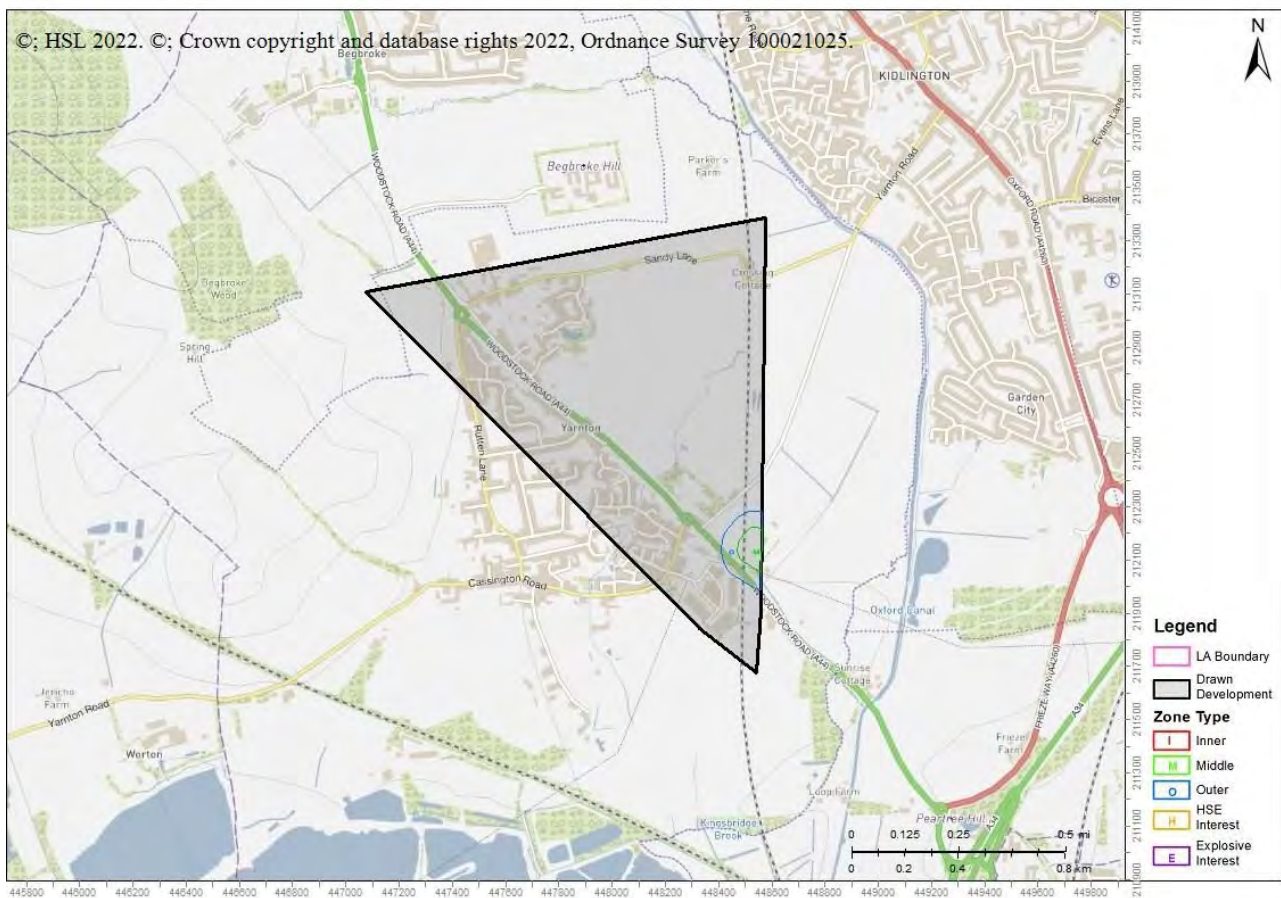

The proposed development site which you have identified currently lies within the consultation distance (CD) of at least one major hazard site and/or major accident hazard pipeline; HSE needs to be consulted on any developments on this site.

This advice report has been generated using information supplied by Francesca Margiotta at Groundwise Searches Ltd on 22 June 2022.

You may wish to contact HSE's Planning Advice team to discuss the above enquiry result on 0203 028 3708 or by email at lupenquiries@hse.gov.uk.

HSE's Advice

Your development does not intersect a pipeline or hazard zone, HSE Planning Advice does not have an interest in the development.

Our Reference : **HSL-220624123915-963**

Your Reference : **31188FM-GWS**

Development Name :


Date Created : **24/06/2022 12:39:15**

Description/Comments : **STUDY**

Created By : **FMARGIOTTA@GROUNDWISE.COM**

Phase 1 documents
 No HI/MHP Interest Report
 (../Download/File/?HSLRefer=HSL-220624123915-963&DownloadType=HSEHasNoInterest)

Please check all mapping details, including the drawn planning boundary and background mapping, are correct.

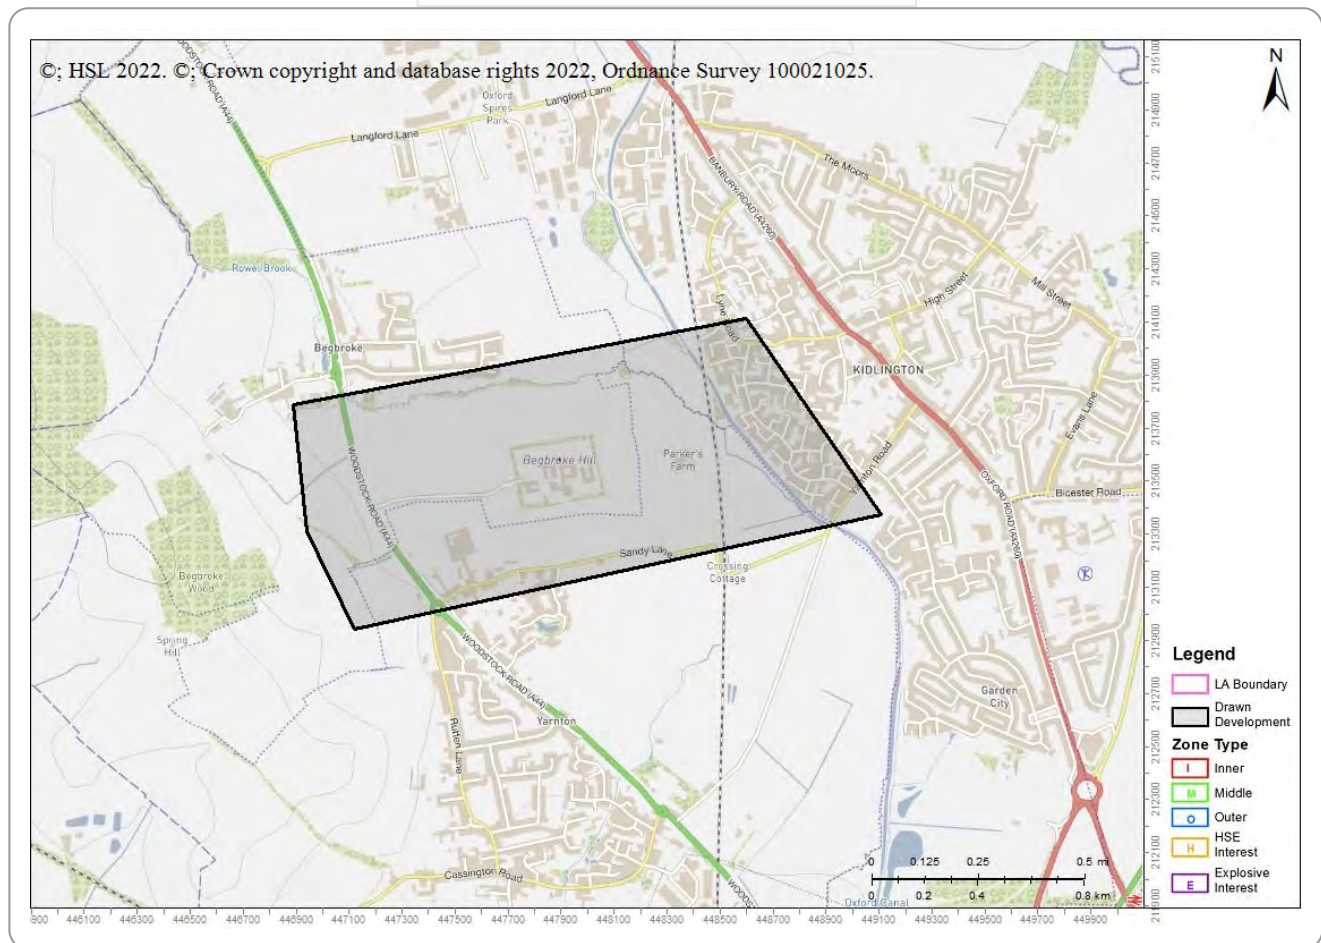


Menu

Advice : HSL-220624123915-963 Does Not Cross Any Consultation Zones

Your Ref: 31188FM-GWS

Development Name:

Comments: STUDY

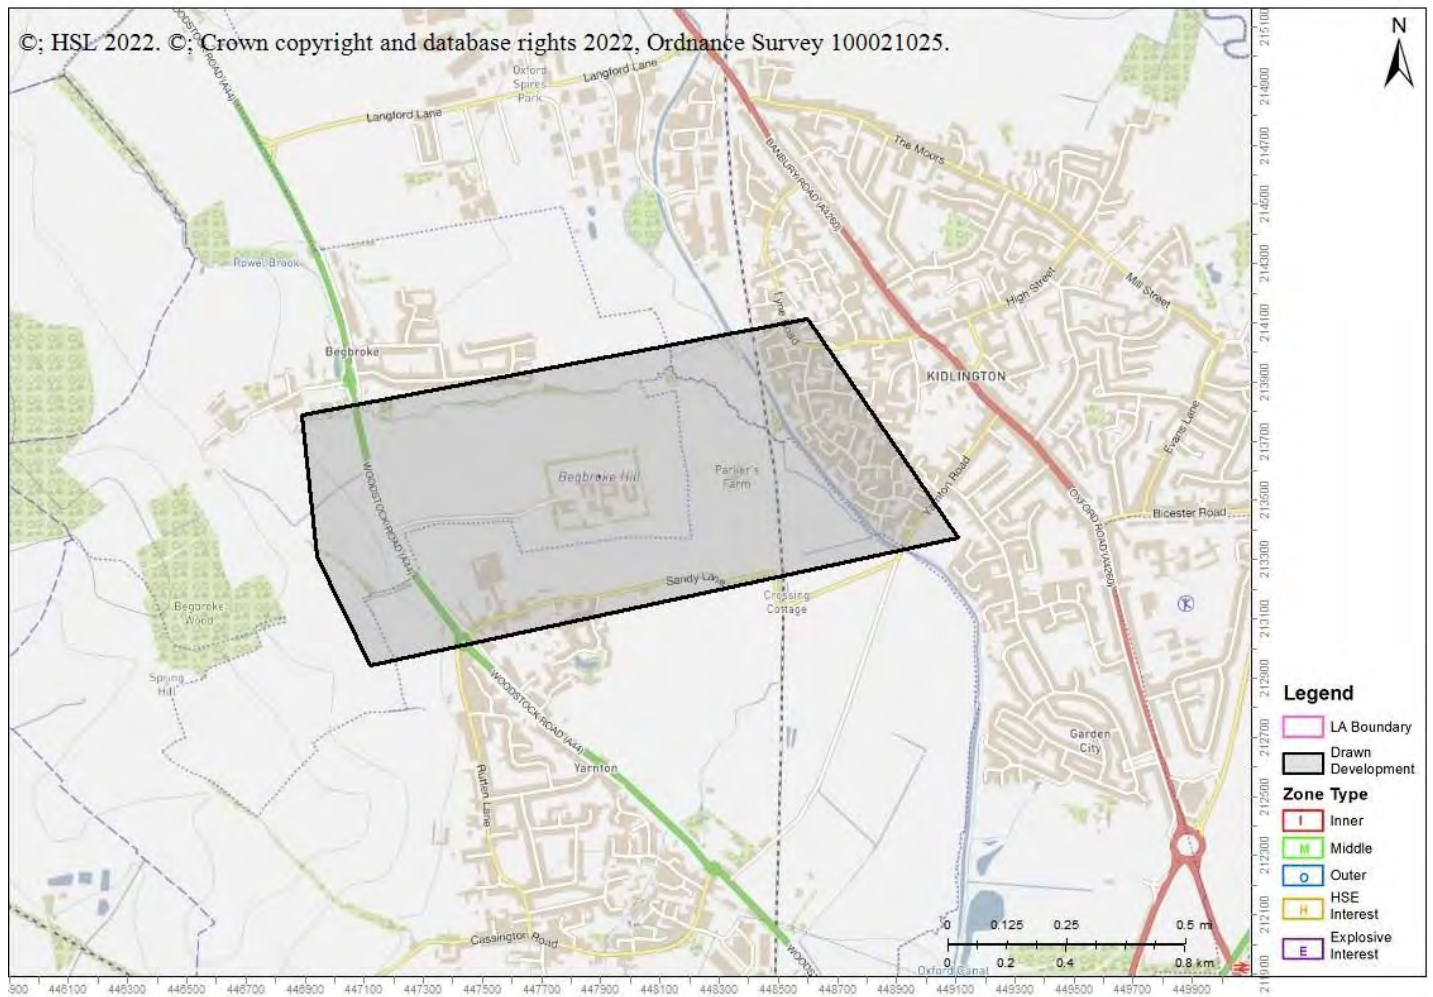

The proposed development site which you have identified does not currently lie within the consultation distance (CD) of a major hazard site or major accident hazard pipeline; therefore at present HSE does not need to be consulted on any developments on this site. However, should there be a delay submitting a planning application for the proposed development on this site, you may wish to approach HSE again to ensure that there have been no changes to CDs in this area in the intervening period.

This advice report has been generated using information supplied by Francesca Margiotta at Groundwise Searches Ltd on 24 June 2022.

HSE's Advice

Your development does not intersect a pipeline or hazard zone, HSE Planning Advice does not have an interest in the development.

Our Reference : **HSL-220624124504-963**

Your Reference : **31188FM-GWS**

Development Name :


Date Created : **24/06/2022 12:45:04**

Description/Comments : **STUDY**

Created By : **FMARGIOTTA@GROUNDWISE.COM**

Phase 1 documents
 No HI/MHP Interest Report
 (../Download/File/?HSLRefer=HSL-220624124504-963&DownloadType=HSEHasNoInterest)

Please check all mapping details, including the drawn planning boundary and background mapping, are correct.

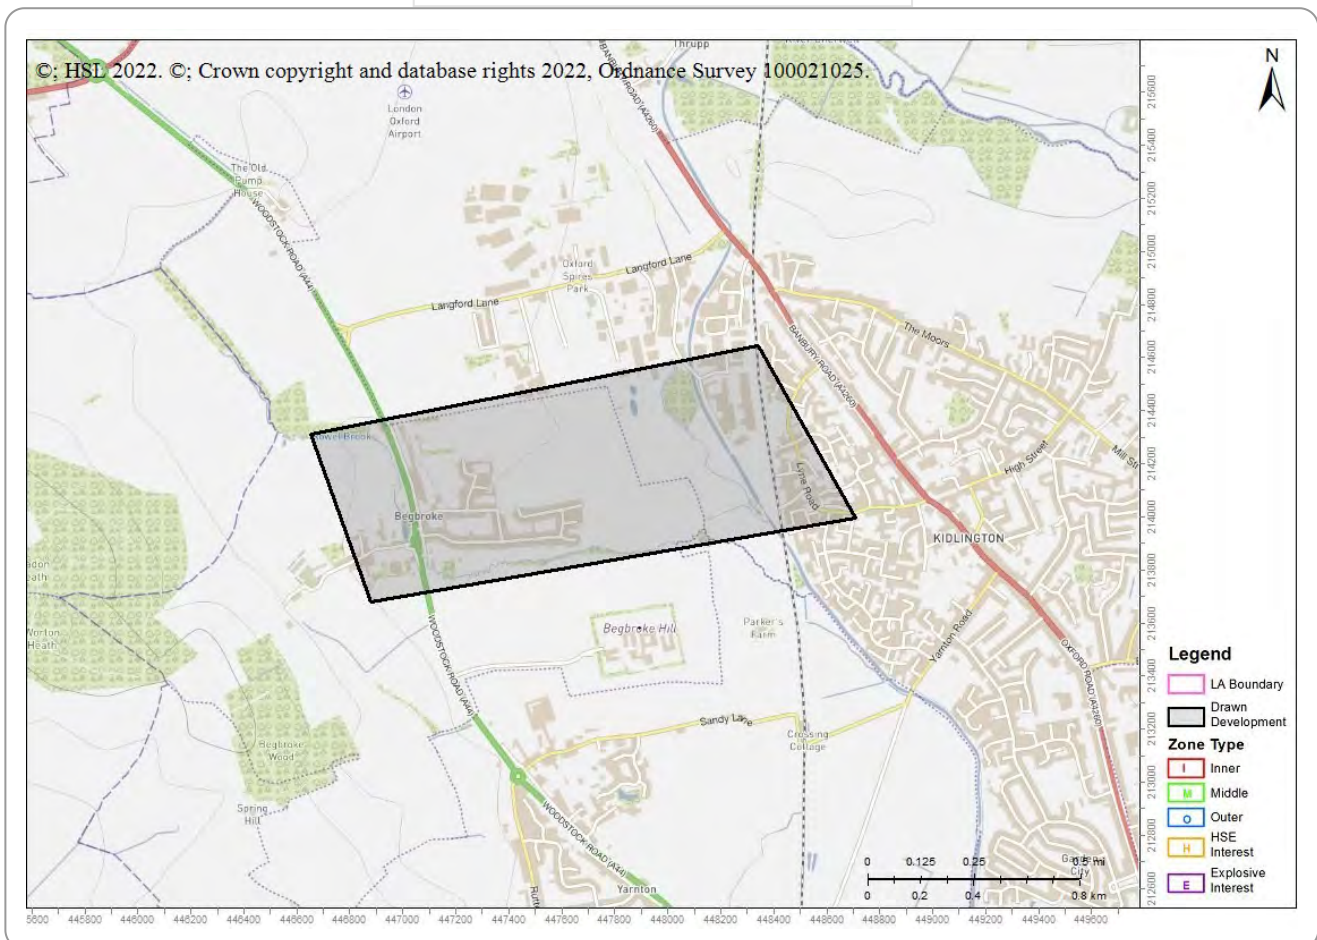


Menu

Advice : HSL-220624124504-963 Does Not Cross Any Consultation Zones

Your Ref: 31188FM-GWS

Development Name:

Comments: STUDY

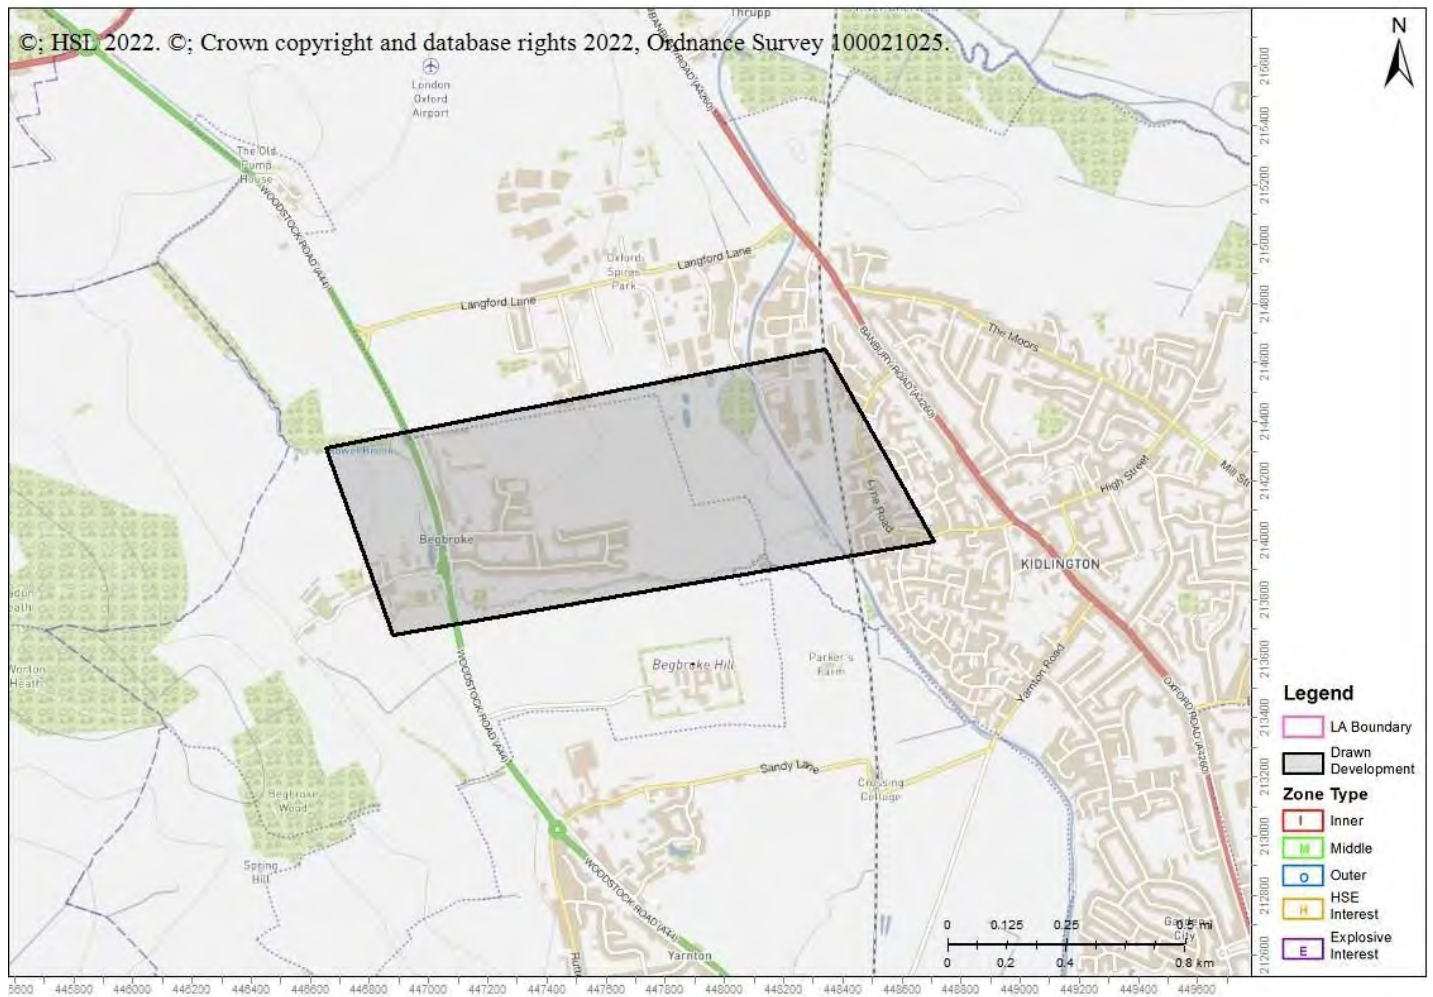

The proposed development site which you have identified does not currently lie within the consultation distance (CD) of a major hazard site or major accident hazard pipeline; therefore at present HSE does not need to be consulted on any developments on this site. However, should there be a delay submitting a planning application for the proposed development on this site, you may wish to approach HSE again to ensure that there have been no changes to CDs in this area in the intervening period.

This advice report has been generated using information supplied by Francesca Margiotta at Groundwise Searches Ltd on 24 June 2022.

Francesca Margiotta

From: Leep Electricity Networks <lenl@leeputilities.co.uk>
Sent: 23 June 2022 09:27
To: Francesca Margiotta
Subject: RE: Requests:URGENT Ref: 31188FM-GWS Site: Woodstock Road, Yarnton, Oxfordshire, OX5 1PF

Leep Electricity Networks Ltd & Leep Utilities have no apparatus in this area.

Regards
Hayley

Leep Electricity Networks
Take a look at our [website](#)

e: lenl@leeputilities.co.uk
w: www.leeputilities.co.uk
Privacy Notice



Leep Holdings (Utilities) Limited : Registered in England & Wales : Company Number 06729159 : Registered Office: The Greenhouse, MediaCity UK, Salford, M50 2EQ.

Please consider the environment before printing this email.


This message may contain confidential information. If you have received this message by mistake, please inform the sender by sending an e-mail reply. At the same time please delete the message and any attachments from your system without making, distributing or retaining any copies. Although all our e-mails messages and any attachments upon sending are automatically virus scanned we assume no responsibility for any loss or damage arising from the receipt and/or use.

From: Francesca Margiotta <FMargiotta@groundwise.com>
Sent: 22 June 2022 09:25
To: osm.enquiries@atkinglobal.com; plantenquiries@instalcom.co.uk; osp-team@uk.verizonbusiness.com; plantenquiries@catelecomuk.com; OPBuriedServicesEnquiries@networkrail.co.uk; plantenquiries@trafficmaster.co.uk; assetrecords@utilityassets.co.uk; NRSWA@sky.uk; mbnlplantenquiries@turntown.com; enquiries@eclipsepower.co.uk; assetenquiries@energyassetsnetworks.co.uk; Leep Electricity Networks <lenl@leeputilities.co.uk>; osm.enquiries@atkinglobal.com; plantenquiries@instalcom.co.uk; osp-team@uk.verizonbusiness.com; plantenquiries@catelecomuk.com; OPBuriedServicesEnquiries@networkrail.co.uk; plantenquiries@trafficmaster.co.uk; assetrecords@utilityassets.co.uk; NRSWA@sky.uk; mbnlplantenquiries@turntown.com; enquiries@eclipsepower.co.uk; assetenquiries@energyassetsnetworks.co.uk; Leep Electricity Networks <lenl@leeputilities.co.uk>
Subject: Requests:URGENT Ref: 31188FM-GWS Site: Woodstock Road, Yarnton, Oxfordshire, OX5 1PF

Enquirer			
Name	Mr Joe Shawyer	Phone	01702615566
Company	Groundwise Searches Ltd	Mobile	Not Supplied
Address	Suite 6 Princess Caroline House 1 High Street Southend on Sea Essex SS1 1JE		
Email	mail@groundwise.com		

Enquiry Details			
Scheme/Reference	31188_001		
Enquiry type	Initial Enquiry	Work category	Development Projects
Start date	16/06/2022	Work type	Commercial/industrial
End date	16/09/2022	Site size	960122 metres square
Searched location	XY= 448461, 214385	Work type buffer*	75 metres
Confirmed location	447899 213853		
Site Contact Name	Not Supplied	Site Phone No	Not Supplied
Description of Works			

* The WORK TYPE BUFFER is a distance added to your search area based on the Work type you have chosen.

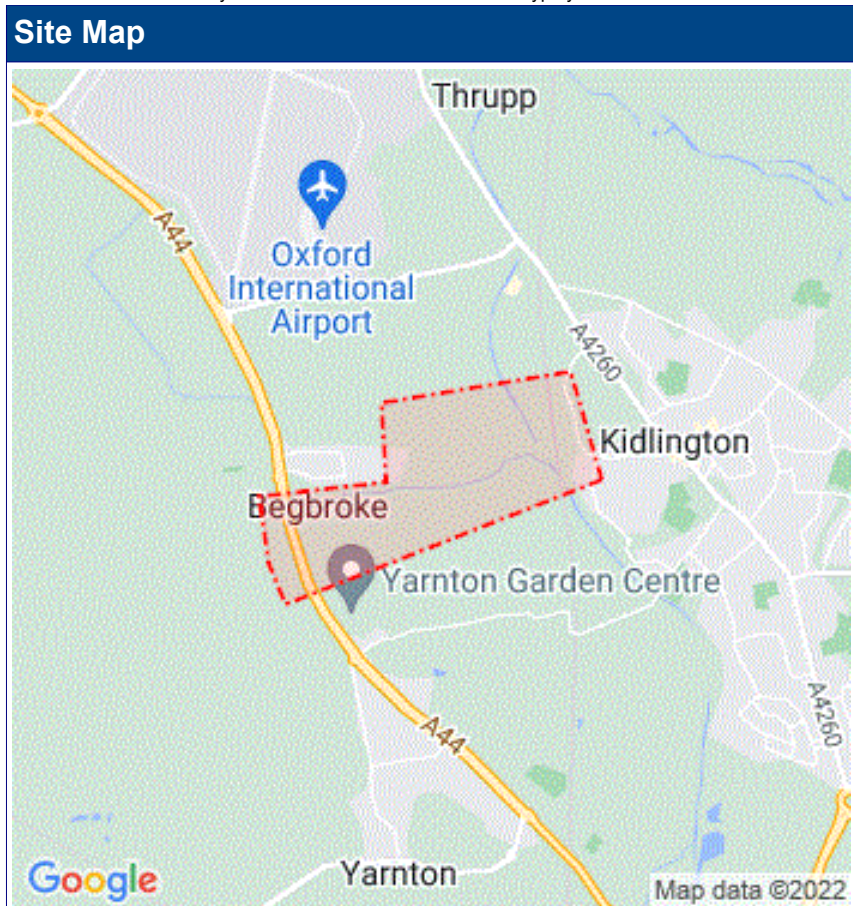

Asset Owners

Terms and Conditions. Please note that this enquiry is subject always to our standard terms and conditions available at www.linesearchbeforeudig.co.uk ("Terms of Use") and the disclaimer at the end of this document. Please note that in the event of any conflict or ambiguity between the terms of this Enquiry Confirmation and the Terms of Use, the Terms of Use shall take precedence.

Notes. Please ensure your contact details are correct and up to date on the system in case the LSBUD Members need to contact you.

Validity and search criteria. The results of this enquiry are based on the confirmed information you entered and are valid only as at the date of the enquiry. It is your responsibility to ensure that the Enquiry Details are correct, and LineSearchbeforeUdig accepts no responsibility for any errors or omissions in the Enquiry Details or any consequences thereof. LSBUD Members update their asset information on a regular basis so you are advised to consider this when undertaking any works. It is your responsibility to choose the period of time after which you need to resubmit any enquiry but the maximum time (after which your enquiry will no longer be dealt with by the LSBUD Helpdesk and LSBUD Members) is 28 days. If any details of the enquiry change, particularly including, but not limited to, the location of the work, then a further enquiry must be made.

Asset Owners & Responses. Please note the enquiry results include the following:

1. "LSBUD Members" who are asset owners who have registered their assets on the LSBUD service.
2. "Non LSBUD Members" are asset owners who have not registered their assets on the LSBUD service but LSBUD is aware of their existence. Please note that there could be other asset owners within your search area.

Below are three lists of asset owners:

1. **LSBUD Members who have assets registered within your search area. ("Affected")**
 - a. **These LSBUD Members will either:**
 - i. **Ask for further information ("Email Additional Info" noted in status). The additional information includes: Site contact name and number, Location plan, Detailed plan (minimum scale 1:2500), Cross sectional drawings (if available), Work Specification.**
 - ii. **Respond directly to you ("Await Response"). In this response they may either send plans directly to you or ask for further information before being able to do so, particularly if any payments or authorisations are required.**
2. **LSBUD Members who do not have assets registered within your search area. ("Not Affected")**
3. **Non LSBUD Members who may have assets within your search area. Please note that this list is not exhaustive and all details are provided as a guide only. It is your responsibility to identify and consult with all asset owners before proceeding.**

LSBUD Members who have assets registered on the LSBUD service within the vicinity of your search area.

List of affected LSBUD members

Asset Owner	Phone/Email	Emergency Only	Status
Scottish and Southern Electricity Networks	08000483516	08000727282	Await response
SGN	08009121722	0800111999	Await response
SSE Utility Solutions Limited	03450707386	Gas 0800111999 Enterprise Water and Electric 0345 078 3268	Await response

LSBUD Members who do not have assets registered on the LSBUD service within the vicinity of your search area. Please be aware that LSBUD Members make regular changes to their assets and this list may vary for new enquiries in the same area.

List of not affected LSBUD members

Angus Energy	AWE Pipeline	Balfour Beatty Investments Limited
BOC Limited (A Member of the Linde Group)	Box Broadband	BP Exploration Operating Company Limited
BPA	Cadent Gas	Carrington Gas Pipeline
CATS Pipeline c/o Wood Group PSN	Cemex	Centrica Storage Ltd
CNG Services Ltd	Concept Solutions People Ltd	ConocoPhillips (UK) Teesside Operator Ltd
D.S.Smith	Diamond Transmission Corporation	DIO (MOD Abandoned Pipelines)
DIO (MOD Live Pipelines)	E.ON UK CHP Limited	EirGrid
Eleclink Limited	Electricity North West Limited	Energy Assets Pipelines
ENI & Himor c/o Penspen Ltd	EnQuest NNS Limited	EP Langage Limited
ESP Utilities Group	ESSAR	Esso Petroleum Company Limited
euNetworks Fiber UK Ltd	EXA Infrastructure	Exolum Pipeline System
Fulcrum Electricity Assets Limited	Fulcrum Pipelines Limited	Gamma
Gas Networks Ireland (UK)	Gateshead Energy Company	Gigaclear Ltd
Harbour Energy	Heathrow Airport LTD	Humbly Grove Energy
IGas Energy	INEOS FPS Pipelines	INEOS Manufacturing (Scotland and TSEP)
INOVYN ChlorVinyls Limited	INOVYN Enterprises Limited	Intergen (Coryton Energy or Spalding Energy)
Jurassic Fibre Ltd	Last Mile	Mainline Pipelines Limited
Manchester Jetline Limited	Manx Cable Company	Marchwood Power Ltd (Gas Pipeline)
Melbourn Solar Limited	Moray East Offshore Windfarm	Murphy Utility Assets
National Grid Electricity Transmission	National Grid Gas Transmission	Neos Networks
Northumbrian Water Group	NPower CHP Pipelines	NTT Global Data Centers EMEA UK Ltd
NYnet Ltd	Oikos Storage Limited	Ørsted
Palm Paper Ltd	Perenco UK Limited (Purbeck Southampton Pipeline)	Petroineos
Phillips 66	Portsmouth Water	Premier Transmission Ltd (SNIP)
Redundant Pipelines - LPDA	RWE - Great Yarmouth Pipeline (Bacton to Great Yarmouth Power Station)	RWEnpower (Little Barford and South Haven)
SABIC UK Petrochemicals	SAS Utility Services Ltd	Scottish Power Generation

Seabank Power Ltd	SES Water	Shell
Shell NOP	SP Energy Networks	Squire Energy Networks
SSE Generation Ltd	SSE Transmission	Tata Communications (c/o JSM Construction Ltd)
Total Colnbrook Pipelines	Total Finaline Pipelines	Transmission Capital
UK Power Networks	Uniper UK Ltd	University of Cambridge Granta Backbone Network
Vattenfall	Veolia ES SELCHP Limited	Veolia ES Sheffield Ltd
Voneus Limited	VPI Power Limited	Wales and West Utilities
West of Duddon Sands Transmission Ltd	Western Power Distribution	Westminster City Council
Zayo Group UK Ltd c/o JSM Group Ltd		

The following Non-LSBUD Members may have assets in your search area. It is **YOUR RESPONSIBILITY** to contact them before proceeding. Please be aware this list is not exhaustive and it is your responsibility to identify and contact all asset owners within your search area.

Non-LSBUD members (Asset owners not registered on LSBUD)			
Asset Owner	Preferred contact method	Phone	Status
BT	https://www.swns.bt.com/pls/mbe/welcome.home	08000232023	Not Notified
CityFibre	asset.team@cityfibre.com	033 3150 7282	Not Notified
Colt	plantenquiries@catelecomuk.com	01227768427	Not Notified
ENGIE	nrswa.uk@engie.com	0800 130 3600	Not Notified
GTC	https://pe.gtc-uk.co.uk/PlantEnqMembership	01359240363	Not Notified
Lumen Technologies	plantenquiries@instalcom.co.uk	02087314613	Not Notified
Mobile Broadband Network Limited	mbnl.plant.enquiries@turntown.com	01212 621 100	Not Notified
Network Rail	OPBuriedServicesEnquiries@networkrail.co.uk	01904523401	Not Notified
Sota	SOTA.plantenquiries@instalcom.co.uk		Not Notified
Thames Water	http://www.digdat.co.uk	08450709145	Not Notified
Utility assets Ltd	assetrecords@utilityassets.co.uk		Not Notified
Verizon Business	osp-team@uk.verizonbusiness.com	01293611736	Not Notified
Virgin Media	http://www.digdat.co.uk	08708883116	Not Notified
Vodafone	osm.enquiries@atkinsglobal.com	01454662881	Not Notified

Disclaimer


Please refer to LineSearchbeforeUdig's Terms of Use for full terms of use available at www.linesearchbeforeudig.co.uk

The results of this Enquiry are personal to the Enquirer and shall not be shared with or relied upon by any other party. The asset information on which the Enquiry results are based has been provided by LSBUD Members, therefore LineSearchbeforeUdig will provide no guarantee that such information is accurate or reliable nor does it monitor such asset information for accuracy and reliability going forward. There may also be asset owners which do not participate in the enquiry service operated by LineSearchbeforeUdig, including but not exclusively those set out above. Therefore, LineSearchbeforeUdig cannot make any representation or give any guarantee or warranty as to the completeness of the information contained in the enquiry results or accept any responsibility for the accuracy of the mapping images used. LineSearchbeforeUdig and its employees, agents and consultants accept no liability (save that nothing in this Enquiry Confirmation excludes or limits our liability for death or personal injury arising from our negligence, or our fraud or fraudulent misrepresentation, or any other liability that cannot be excluded or limited by English law) arising in respect thereof or in any other way for errors or omissions including responsibility to any person by reason of negligence.

Enquirer			
Name	Mr Joe Shawyer	Phone	01702615566
Company	Groundwise Searches Ltd	Mobile	Not Supplied
Address	Suite 6 Princess Caroline House 1 High Street Southend on Sea Essex SS1 1JE		
Email	mail@groundwise.com		

Enquiry Details			
Scheme/Reference	31188_002		
Enquiry type	Initial Enquiry	Work category	Development Projects
Start date	16/06/2022	Work type	Commercial/industrial
End date	16/09/2022	Site size	990001 metres square
Searched location	XY= -1.306468, 51.821255 Long/Lat	Work type buffer*	75 metres
Confirmed location	448066 213346		
Site Contact Name	Not Supplied	Site Phone No	Not Supplied
Description of Works	- CONTINUED FROM JOB: 25880986 -		

* The WORK TYPE BUFFER is a distance added to your search area based on the Work type you have chosen.

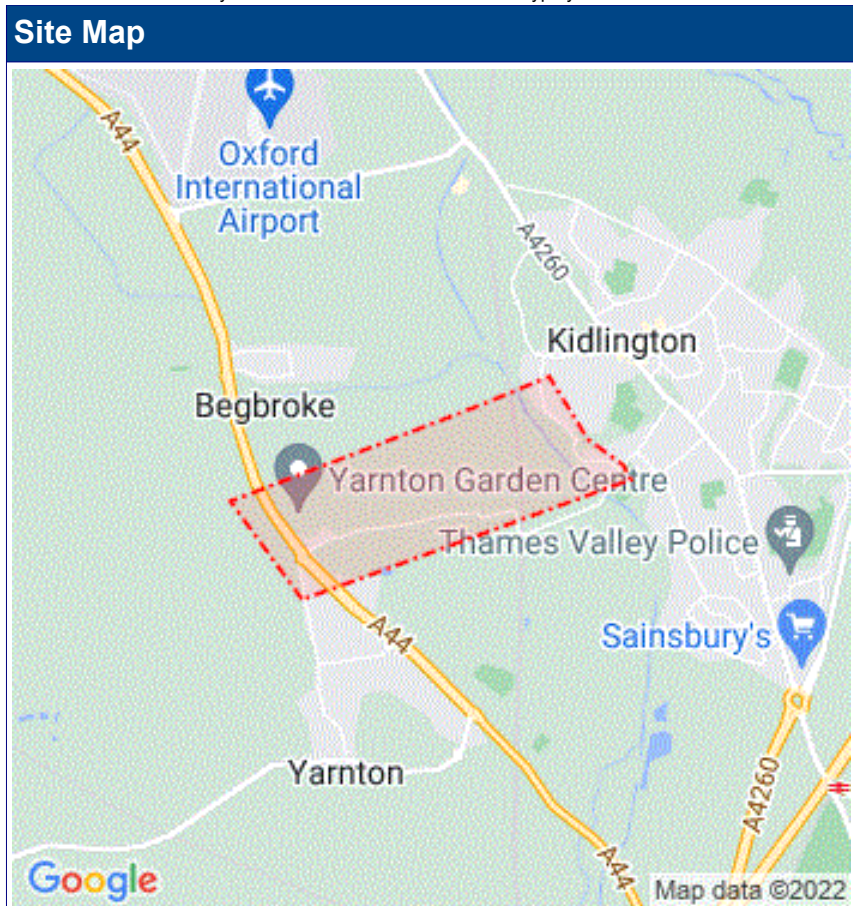

Asset Owners

Terms and Conditions. Please note that this enquiry is subject always to our standard terms and conditions available at www.linesearchbeforeudig.co.uk ("Terms of Use") and the disclaimer at the end of this document. Please note that in the event of any conflict or ambiguity between the terms of this Enquiry Confirmation and the Terms of Use, the Terms of Use shall take precedence.

Notes. Please ensure your contact details are correct and up to date on the system in case the LSBUD Members need to contact you.

Validity and search criteria. The results of this enquiry are based on the confirmed information you entered and are valid only as at the date of the enquiry. It is your responsibility to ensure that the Enquiry Details are correct, and LineSearchbeforeUdig accepts no responsibility for any errors or omissions in the Enquiry Details or any consequences thereof. LSBUD Members update their asset information on a regular basis so you are advised to consider this when undertaking any works. It is your responsibility to choose the period of time after which you need to resubmit any enquiry but the maximum time (after which your enquiry will no longer be dealt with by the LSBUD Helpdesk and LSBUD Members) is 28 days. If any details of the enquiry change, particularly including, but not limited to, the location of the work, then a further enquiry must be made.

Asset Owners & Responses. Please note the enquiry results include the following:

1. "LSBUD Members" who are asset owners who have registered their assets on the LSBUD service.
2. "Non LSBUD Members" are asset owners who have not registered their assets on the LSBUD service but LSBUD is aware of their existence. Please note that there could be other asset owners within your search area.

Below are three lists of asset owners:

1. **LSBUD Members who have assets registered within your search area. ("Affected")**
 - a. **These LSBUD Members will either:**
 - i. **Ask for further information ("Email Additional Info" noted in status). The additional information includes: Site contact name and number, Location plan, Detailed plan (minimum scale 1:2500), Cross sectional drawings (if available), Work Specification.**
 - ii. **Respond directly to you ("Await Response"). In this response they may either send plans directly to you or ask for further information before being able to do so, particularly if any payments or authorisations are required.**
2. **LSBUD Members who do not have assets registered within your search area. ("Not Affected")**
3. **Non LSBUD Members who may have assets within your search area. Please note that this list is not exhaustive and all details are provided as a guide only. It is your responsibility to identify and consult with all asset owners before proceeding.**

LSBUD Members who have assets registered on the LSBUD service within the vicinity of your search area.

List of affected LSBUD members

Asset Owner	Phone/Email	Emergency Only	Status
ESP Utilities Group	01372227560	01372227560	Await response
Last Mile	plantenquiries@lastmile-uk.com	0800111999	Await response
Scottish and Southern Electricity Networks	08000483516	08000727282	Await response
SGN	08009121722	0800111999	Await response
SSE Utility Solutions Limited	03450707386	Gas 0800111999 Enterprise Water and Electric 0345 078 3268	Await response

LSBUD Members who do not have assets registered on the LSBUD service within the vicinity of your search area. Please be aware that LSBUD Members make regular changes to their assets and this list may vary for new enquiries in the same area.

List of not affected LSBUD members

Angus Energy	AWE Pipeline	Balfour Beatty Investments Limited
BOC Limited (A Member of the Linde Group)	Box Broadband	BP Exploration Operating Company Limited
BPA	Cadent Gas	Carrington Gas Pipeline
CATS Pipeline c/o Wood Group PSN	Cemex	Centrica Storage Ltd
CNG Services Ltd	Concept Solutions People Ltd	ConocoPhillips (UK) Teesside Operator Ltd
D.S.Smith	Diamond Transmission Corporation	DIO (MOD Abandoned Pipelines)
DIO (MOD Live Pipelines)	E.ON UK CHP Limited	EirGrid
Eleclink Limited	Electricity North West Limited	Energy Assets Pipelines
ENI & Himor c/o Penspen Ltd	EnQuest NNS Limited	EP Langage Limited
ESSAR	Esso Petroleum Company Limited	euNetworks Fiber UK Ltd
EXA Infrastructure	Exolum Pipeline System	Fulcrum Electricity Assets Limited
Fulcrum Pipelines Limited	Gamma	Gas Networks Ireland (UK)
Gateshead Energy Company	Gigaclear Ltd	Harbour Energy
Heathrow Airport LTD	Humbly Grove Energy	IGas Energy
INEOS FPS Pipelines	INEOS Manufacturing (Scotland and TSEP)	INOVYN ChlorVinyls Limited
INOVYN Enterprises Limited	Intergen (Coryton Energy or Spalding Energy)	Jurassic Fibre Ltd
Mainline Pipelines Limited	Manchester Jetline Limited	Manx Cable Company
Marchwood Power Ltd (Gas Pipeline)	Melbourn Solar Limited	Moray East Offshore Windfarm
Murphy Utility Assets	National Grid Electricity Transmission	National Grid Gas Transmission
Neos Networks	Northumbrian Water Group	NPower CHP Pipelines
NTT Global Data Centers EMEA UK Ltd	NYnet Ltd	Oikos Storage Limited
Ørsted	Palm Paper Ltd	Perenco UK Limited (Purbeck Southampton Pipeline)
Petroineos	Phillips 66	Portsmouth Water
Premier Transmission Ltd (SNIP)	Redundant Pipelines - LPDA	RWE - Great Yarmouth Pipeline (Bacton to Great Yarmouth Power Station)

RWEpower (Little Barford and South Haven)	SABIC UK Petrochemicals	SAS Utility Services Ltd
Scottish Power Generation	Seabank Power Ltd	SES Water
Shell	Shell NOP	SP Energy Networks
Squire Energy Networks	SSE Generation Ltd	SSE Transmission
Tata Communications (c/o JSM Construction Ltd)	Total Colnbrook Pipelines	Total Finaline Pipelines
Transmission Capital	UK Power Networks	Uniper UK Ltd
University of Cambridge Granta Backbone Network	Vattenfall	Veolia ES SELCHP Limited
Veolia ES Sheffield Ltd	Voneus Limited	VPI Power Limited
Wales and West Utilities	West of Duddon Sands Transmission Ltd	Western Power Distribution
Westminster City Council	Zayo Group UK Ltd c/o JSM Group Ltd	

The following Non-LSBUD Members may have assets in your search area. It is **YOUR RESPONSIBILITY** to contact them before proceeding. Please be aware this list is not exhaustive and it is your responsibility to identify and contact all asset owners within your search area.

Non-LSBUD members (Asset owners not registered on LSBUD)			
Asset Owner	Preferred contact method	Phone	Status
BT	https://www.swns.bt.com/pls/mbe/welcome.home	08000232023	Not Notified
CityFibre	asset.team@cityfibre.com	033 3150 7282	Not Notified
Colt	plantenquiries@catelecomuk.com	01227768427	Not Notified
ENGIE	nrswa.uk@engie.com	0800 130 3600	Not Notified
GTC	https://pe.gtc-uk.co.uk/PlantEnqMembership	01359240363	Not Notified
Lumen Technologies	plantenquiries@instalcom.co.uk	02087314613	Not Notified
Mobile Broadband Network Limited	mbnl.plant.enquiries@turntown.com	01212 621 100	Not Notified
Network Rail	OPBuriedServicesEnquiries@networkrail.co.uk	01904523401	Not Notified
Sota	SOTA.plantenquiries@instalcom.co.uk		Not Notified
Thames Water	http://www.digdat.co.uk	08450709145	Not Notified
Utility assets Ltd	assetrecords@utilityassets.co.uk		Not Notified
Verizon Business	osp-team@uk.verizonbusiness.com	01293611736	Not Notified
Virgin Media	http://www.digdat.co.uk	08708883116	Not Notified
Vodafone	osm.enquiries@atkinsglobal.com	01454662881	Not Notified

Disclaimer


Please refer to LineSearchbeforeUdig's Terms of Use for full terms of use available at www.linesearchbeforeudig.co.uk

The results of this Enquiry are personal to the Enquirer and shall not be shared with or relied upon by any other party. The asset information on which the Enquiry results are based has been provided by LSBUD Members, therefore LineSearchbeforeUdig will provide no guarantee that such information is accurate or reliable nor does it monitor such asset information for accuracy and reliability going forward. There may also be asset owners which do not participate in the enquiry service operated by LineSearchbeforeUdig, including but not exclusively those set out above. Therefore, LineSearchbeforeUdig cannot make any representation or give any guarantee or warranty as to the completeness of the information contained in the enquiry results or accept any responsibility for the accuracy of the mapping images used. LineSearchbeforeUdig and its employees, agents and consultants accept no liability (save that nothing in this Enquiry Confirmation excludes or limits our liability for death or personal injury arising from our negligence, or our fraud or fraudulent misrepresentation, or any other liability that cannot be excluded or limited by English law) arising in respect thereof or in any other way for errors or omissions including responsibility to any person by reason of negligence.

Enquirer			
Name	Mr Joe Shawyer	Phone	01702615566
Company	Groundwise Searches Ltd	Mobile	Not Supplied
Address	Suite 6 Princess Caroline House 1 High Street Southend on Sea Essex SS1 1JE		
Email	mail@groundwise.com		

Enquiry Details			
Scheme/Reference	31188_003		
Enquiry type	Initial Enquiry	Work category	Development Projects
Start date	16/06/2022	Work type	Commercial/industrial
End date	16/09/2022	Site size	991294 metres square
Searched location	XY= -1.304112, 51.816686 Long/Lat	Work type buffer*	75 metres
Confirmed location	448662 213014		
Site Contact Name	Not Supplied	Site Phone No	Not Supplied
Description of Works	- CONTINUED FROM JOB: 25881010 -- CONTINUED FROM JOB: 25880986 -		

* The WORK TYPE BUFFER is a distance added to your search area based on the Work type you have chosen.

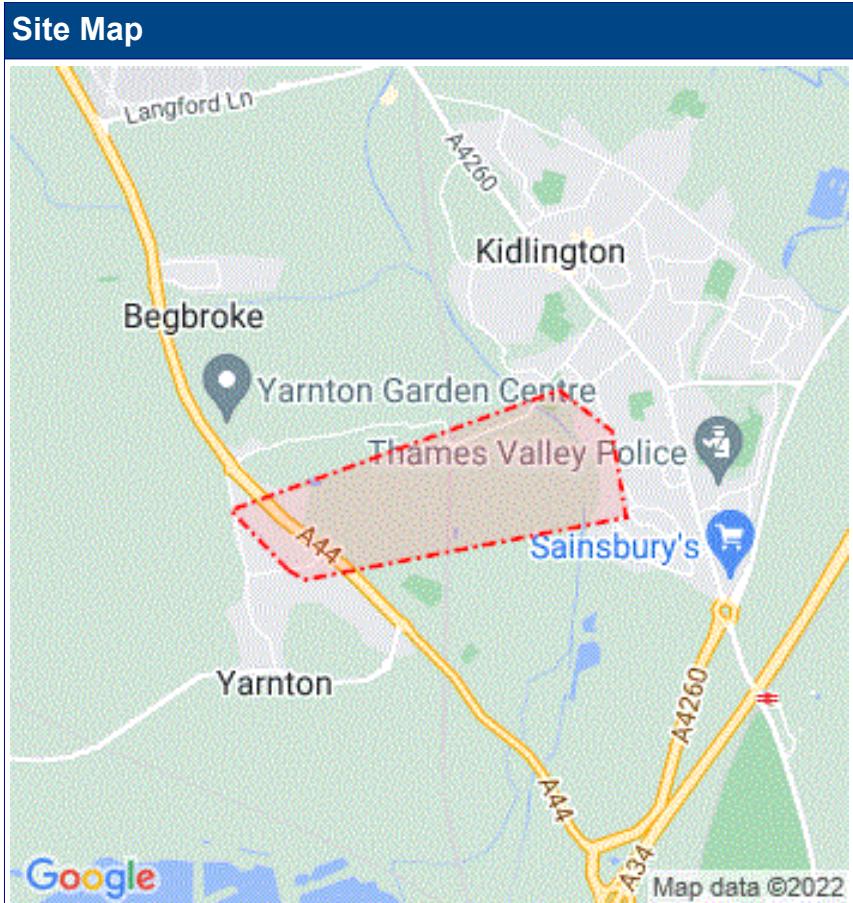

Asset Owners

Terms and Conditions. Please note that this enquiry is subject always to our standard terms and conditions available at www.lineasearchbeforeudig.co.uk ("Terms of Use") and the disclaimer at the end of this document. Please note that in the event of any conflict or ambiguity between the terms of this Enquiry Confirmation and the Terms of Use, the Terms of Use shall take precedence.

Notes. Please ensure your contact details are correct and up to date on the system in case the LSBUD Members need to contact you.

Validity and search criteria. The results of this enquiry are based on the confirmed information you entered and are valid only as at the date of the enquiry. It is your responsibility to ensure that the Enquiry Details are correct, and LineasearchbeforeUdig accepts no responsibility for any errors or omissions in the Enquiry Details or any consequences thereof. LSBUD Members update their asset information on a regular basis so you are advised to consider this when undertaking any works. It is your responsibility to choose the period of time after which you need to resubmit any enquiry but the maximum time (after which your enquiry will no longer be dealt with by the LSBUD Helpdesk and LSBUD Members) is 28 days. If any details of the enquiry change, particularly including, but not limited to, the location of the work, then a further enquiry must be made.

Asset Owners & Responses. Please note the enquiry results include the following:

1. "LSBUD Members" who are asset owners who have registered their assets on the LSBUD service.
2. "Non LSBUD Members" are asset owners who have not registered their assets on the LSBUD service but LSBUD is aware of their existence. Please note that there could be other asset owners within your search area.

Below are three lists of asset owners:

1. **LSBUD Members who have assets registered within your search area. ("Affected")**
 - a. **These LSBUD Members will either:**
 - i. **Ask for further information ("Email Additional Info" noted in status).** The additional information includes: Site contact name and number, Location plan, Detailed plan (minimum scale 1:2500), Cross sectional drawings (if available), Work Specification.
 - ii. **Respond directly to you ("Await Response").** In this response they may either send plans directly to you or ask for further information before being able to do so, particularly if any payments or authorisations are required.
2. **LSBUD Members who do not have assets registered within your search area. ("Not Affected")**
3. **Non LSBUD Members who may have assets within your search area.** Please note that this list is not exhaustive and all details are provided as a guide only. It is your responsibility to identify and consult with all asset owners before proceeding.

LSBUD Members who have assets registered on the LSBUD service within the vicinity of your search area.

List of affected LSBUD members

Asset Owner	Phone/Email	Emergency Only	Status
Scottish and Southern Electricity Networks	08000483516	08000727282	Await response
SGN	08009121722	0800111999	Await response

LSBUD Members who do not have assets registered on the LSBUD service within the vicinity of your search area. Please be aware that LSBUD Members make regular changes to their assets and this list may vary for new enquiries in the same area.

List of not affected LSBUD members

Angus Energy	AWE Pipeline	Balfour Beatty Investments Limited
BOC Limited (A Member of the Linde Group)	Box Broadband	BP Exploration Operating Company Limited
BPA	Cadent Gas	Carrington Gas Pipeline
CATS Pipeline c/o Wood Group PSN	Cemex	Centrica Storage Ltd
CNG Services Ltd	Concept Solutions People Ltd	ConocoPhillips (UK) Teesside Operator Ltd
D.S.Smith	Diamond Transmission Corporation	DIO (MOD Abandoned Pipelines)
DIO (MOD Live Pipelines)	E.ON UK CHP Limited	EirGrid
Eleclink Limited	Electricity North West Limited	Energy Assets Pipelines
ENI & Himor c/o Penspen Ltd	EnQuest NNS Limited	EP Langage Limited
ESP Utilities Group	ESSAR	Esso Petroleum Company Limited
euNetworks Fiber UK Ltd	EXA Infrastructure	Exolum Pipeline System
Fulcrum Electricity Assets Limited	Fulcrum Pipelines Limited	Gamma
Gas Networks Ireland (UK)	Gateshead Energy Company	Gigaclear Ltd
Harbour Energy	Heathrow Airport LTD	Humbly Grove Energy
IGas Energy	INEOS FPS Pipelines	INEOS Manufacturing (Scotland and TSEP)
INOVYN ChlorVinyls Limited	INOVYN Enterprises Limited	Intergen (Coryton Energy or Spalding Energy)
Jurassic Fibre Ltd	Last Mile	Mainline Pipelines Limited
Manchester Jetline Limited	Manx Cable Company	Marchwood Power Ltd (Gas Pipeline)
Melbourn Solar Limited	Moray East Offshore Windfarm	Murphy Utility Assets
National Grid Electricity Transmission	National Grid Gas Transmission	Neos Networks
Northumbrian Water Group	NPower CHP Pipelines	NTT Global Data Centers EMEA UK Ltd
NYnet Ltd	Oikos Storage Limited	Ørsted
Palm Paper Ltd	Perenco UK Limited (Purbeck Southampton Pipeline)	Petroineos
Phillips 66	Portsmouth Water	Premier Transmission Ltd (SNIP)
Redundant Pipelines - LPDA	RWE - Great Yarmouth Pipeline (Bacton to Great Yarmouth Power Station)	RWEnpower (Little Barford and South Haven)
SABIC UK Petrochemicals	SAS Utility Services Ltd	Scottish Power Generation
Seabank Power Ltd	SES Water	Shell
Shell NOP	SP Energy Networks	Squire Energy Networks
SSE Generation Ltd	SSE Transmission	SSE Utility Solutions Limited

Tata Communications (c/o JSM Construction Ltd)

Transmission Capital

University of Cambridge Granta Backbone Network

Veolia ES Sheffield Ltd

Wales and West Utilities

Westminster City Council

Total Colnbrook Pipelines

UK Power Networks

Vattenfall

Voneus Limited

West of Duddon Sands Transmission Ltd

Zayo Group UK Ltd c/o JSM Group Ltd

Total Finaline Pipelines

Uniper UK Ltd

Veolia ES SELCHP Limited

VPI Power Limited

Western Power Distribution

The following Non-LSBUD Members may have assets in your search area. It is YOUR RESPONSIBILITY to contact them before proceeding. Please be aware this list is not exhaustive and it is your responsibility to identify and contact all asset owners within your search area.

Non-LSBUD members (Asset owners not registered on LSBUD)

Asset Owner	Preferred contact method	Phone	Status
BT	https://www.swns.bt.com/pls/mbe/welcome.home	08000232023	Not Notified
CityFibre	asset.team@cityfibre.com	033 3150 7282	Not Notified
Colt	plantenquiries@catelecomuk.com	01227768427	Not Notified
ENGIE	nrswa.uk@engie.com	0800 130 3600	Not Notified
GTC	https://pe.gtc-uk.co.uk/PlantEnqMembership	01359240363	Not Notified
Lumen Technologies	plantenquiries@instalcom.co.uk	02087314613	Not Notified
Mobile Broadband Network Limited	mbnl.plant.enquiries@turntown.com	01212 621 100	Not Notified
Network Rail	OPBuriedServicesEnquiries@networkrail.co.uk	01904523401	Not Notified
Sota	SOTA.plantenquiries@instalcom.co.uk		Not Notified
Thames Water	http://www.digdat.co.uk	08450709145	Not Notified
Utility assets Ltd	assetrecords@utilityassets.co.uk		Not Notified
Verizon Business	osp-team@uk.verizonbusiness.com	01293611736	Not Notified
Virgin Media	http://www.digdat.co.uk	08708883116	Not Notified
Vodafone	osm.enquiries@atkinsglobal.com	01454662881	Not Notified

Disclaimer

Please refer to LineSearchbeforeUdig's Terms of Use for full terms of use available at www.linesearchbeforeudig.co.uk

The results of this Enquiry are personal to the Enquirer and shall not be shared with or relied upon by any other party. The asset information on which the Enquiry results are based has been provided by LSBUD Members, therefore LineSearchbeforeUdig will provide no guarantee that such information is accurate or reliable nor does it monitor such asset information for accuracy and reliability going forward. There may also be asset owners which do not participate in the enquiry service operated by LineSearchbeforeUdig, including but not exclusively those set out above. Therefore, LineSearchbeforeUdig cannot make any representation or give any guarantee or warranty as to the completeness of the information contained in the enquiry results or accept any responsibility for the accuracy of the mapping images used. LineSearchbeforeUdig and its employees, agents and consultants accept no liability (save that nothing in this Enquiry Confirmation excludes or limits our liability for death or personal injury arising from our negligence, or our fraud or fraudulent misrepresentation, or any other liability that cannot be excluded or limited by English law) arising in respect thereof or in any other way for errors or omissions including responsibility to any person by reason of negligence.


Enquirer

Name	Mr Joe Shawyer	Phone	01702615566
Company	Groundwise Searches Ltd	Mobile	Not Supplied
Address	Suite 6 Princess Caroline House 1 High Street Southend on Sea Essex SS1 1JE		
Email	mail@groundwise.com		

Enquiry Details

Scheme/Reference	31188_004		
Enquiry type	Initial Enquiry	Work category	Development Projects
Start date	16/06/2022	Work type	Commercial/industrial
End date	16/09/2022	Site size	705572 metres square
Searched location	XY= -1.295508, 51.813651 Long/Lat	Work type buffer*	75 metres
Confirmed location	448447 212278		
Site Contact Name	Not Supplied	Site Phone No	Not Supplied
Description of Works	- CONTINUED FROM JOB: 25881037 -- CONTINUED FROM JOB: 25881010 -- CONTINUED FROM JOB: 25880986 -		

* The WORK TYPE BUFFER is a distance added to your search area based on the Work type you have chosen.

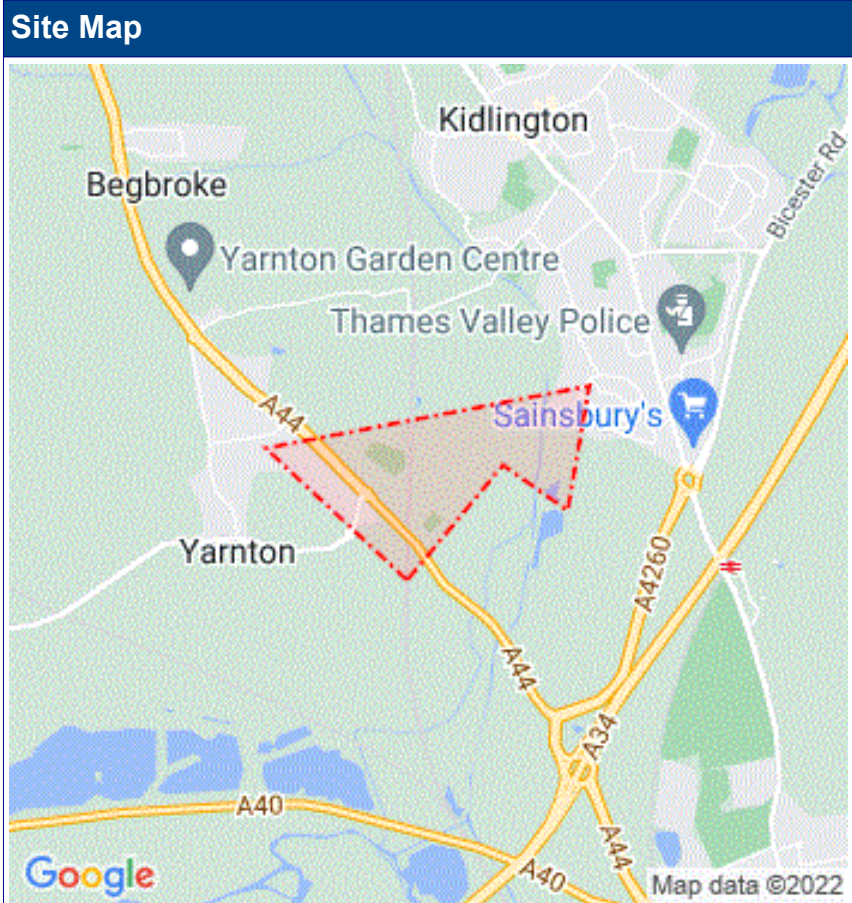

Asset Owners

Terms and Conditions. Please note that this enquiry is subject always to our standard terms and conditions available at www.linesearchbeforeudig.co.uk ("Terms of Use") and the disclaimer at the end of this document. Please note that in the event of any conflict or ambiguity between the terms of this Enquiry Confirmation and the Terms of Use, the Terms of Use shall take precedence.

Notes. Please ensure your contact details are correct and up to date on the system in case the LSBUD Members need to contact you.

Validity and search criteria. The results of this enquiry are based on the confirmed information you entered and are valid only as at the date of the enquiry. It is your responsibility to ensure that the Enquiry Details are correct, and LineSearchbeforeUdig accepts no responsibility for any errors or omissions in the Enquiry Details or any consequences thereof. LSBUD Members update their asset information on a regular basis so you are advised to consider this when undertaking any works. It is your responsibility to choose the period of time after which you need to resubmit any enquiry but the maximum time (after which your enquiry will no longer be dealt with by the LSBUD Helpdesk and LSBUD Members) is 28 days. If any details of the enquiry change, particularly including, but not limited to, the location of the work, then a further enquiry must be made.

Asset Owners & Responses. Please note the enquiry results include the following:

1. "LSBUD Members" who are asset owners who have registered their assets on the LSBUD service.
2. "Non LSBUD Members" are asset owners who have not registered their assets on the LSBUD service but LSBUD is aware of their existence. Please note that there could be other asset owners within your search area.

Below are three lists of asset owners:

1. **LSBUD Members who have assets registered within your search area. ("Affected")**
 - a. **These LSBUD Members will either:**
 - i. **Ask for further information ("Email Additional Info" noted in status).** The additional information includes: Site contact name and number, Location plan, Detailed plan (minimum scale 1:2500), Cross sectional drawings (if available), Work Specification.
 - ii. **Respond directly to you ("Await Response").** In this response they may either send plans directly to you or ask for further information before being able to do so, particularly if any payments or authorisations are required.
2. **LSBUD Members who do not have assets registered within your search area. ("Not Affected")**
3. **Non LSBUD Members who may have assets within your search area.** Please note that this list is not exhaustive and all details are provided as a guide only. It is your responsibility to identify and consult with all asset owners before proceeding.

LSBUD Members who have assets registered on the LSBUD service within the vicinity of your search area.

List of affected LSBUD members			
Asset Owner	Phone/Email	Emergency Only	Status
Scottish and Southern Electricity Networks	08000483516	08000727282	Await response
SGN	08009121722	0800111999	Await response
SSE Utility Solutions Limited	03450707386	Gas 0800111999 Enterprise Water and Electric 0345 078 3268	Await response

LSBUD Members who do not have assets registered on the LSBUD service within the vicinity of your search area. Please be aware that LSBUD Members make regular changes to their assets and this list may vary for new enquiries in the same area.

List of not affected LSBUD members		
Angus Energy	AWE Pipeline	Balfour Beatty Investments Limited
BOC Limited (A Member of the Linde Group)	Box Broadband	BP Exploration Operating Company Limited
BPA	Cadent Gas	Carrington Gas Pipeline
CATS Pipeline c/o Wood Group PSN	Cemex	Centrica Storage Ltd
CNG Services Ltd	Concept Solutions People Ltd	ConocoPhillips (UK) Teesside Operator Ltd
D.S.Smith	Diamond Transmission Corporation	DIO (MOD Abandoned Pipelines)
DIO (MOD Live Pipelines)	E.ON UK CHP Limited	EirGrid
Eleclink Limited	Electricity North West Limited	Energy Assets Pipelines
ENI & Himor c/o Penspen Ltd	EnQuest NNS Limited	EP Langage Limited
ESP Utilities Group	ESSAR	Esso Petroleum Company Limited
euNetworks Fiber UK Ltd	EXA Infrastructure	Exolum Pipeline System
Fulcrum Electricity Assets Limited	Fulcrum Pipelines Limited	Gamma
Gas Networks Ireland (UK)	Gateshead Energy Company	Gigaclear Ltd
Harbour Energy	Heathrow Airport LTD	Humbly Grove Energy
IGas Energy	INEOS FPS Pipelines	INEOS Manufacturing (Scotland and TSEP)
INOVYN ChlorVinyls Limited	INOVYN Enterprises Limited	Intergen (Coryton Energy or Spalding Energy)
Jurassic Fibre Ltd	Last Mile	Mainline Pipelines Limited
Manchester Jetline Limited	Manx Cable Company	Marchwood Power Ltd (Gas Pipeline)
Melbourn Solar Limited	Moray East Offshore Windfarm	Murphy Utility Assets
National Grid Electricity Transmission	National Grid Gas Transmission	Neos Networks
Northumbrian Water Group	NPower CHP Pipelines	NTT Global Data Centers EMEA UK Ltd
NYnet Ltd	Oikos Storage Limited	Ørsted
Palm Paper Ltd	Perenco UK Limited (Purbeck Southampton Pipeline)	Petroineos
Phillips 66	Portsmouth Water	Premier Transmission Ltd (SNIP)
Redundant Pipelines - LPDA	RWE - Great Yarmouth Pipeline (Bacton to Great Yarmouth Power Station)	RWEnpower (Little Barford and South Haven)
SABIC UK Petrochemicals	SAS Utility Services Ltd	Scottish Power Generation

Seabank Power Ltd	SES Water	Shell
Shell NOP	SP Energy Networks	Squire Energy Networks
SSE Generation Ltd	SSE Transmission	Tata Communications (c/o JSM Construction Ltd)
Total Colnbrook Pipelines	Total Finaline Pipelines	Transmission Capital
UK Power Networks	Uniper UK Ltd	University of Cambridge Granta Backbone Network
Vattenfall	Veolia ES SELCHP Limited	Veolia ES Sheffield Ltd
Voneus Limited	VPI Power Limited	Wales and West Utilities
West of Duddon Sands Transmission Ltd	Western Power Distribution	Westminster City Council
Zayo Group UK Ltd c/o JSM Group Ltd		

The following Non-LSBUD Members may have assets in your search area. It is **YOUR RESPONSIBILITY** to contact them before proceeding. Please be aware this list is not exhaustive and it is your responsibility to identify and contact all asset owners within your search area.

Non-LSBUD members (Asset owners not registered on LSBUD)

Asset Owner	Preferred contact method	Phone	Status
BT	https://www.swns.bt.com/pls/mbe/welcome.home	08000232023	Not Notified
CityFibre	asset.team@cityfibre.com	033 3150 7282	Not Notified
Colt	plantenquiries@catelecomuk.com	01227768427	Not Notified
ENGIE	nrswa.uk@engie.com	0800 130 3600	Not Notified
GTC	https://pe.gtc-uk.co.uk/PlantEnqMembership	01359240363	Not Notified
Lumen Technologies	plantenquiries@instalcom.co.uk	02087314613	Not Notified
Mobile Broadband Network Limited	mbnl.plant.enquiries@turntown.com	01212 621 100	Not Notified
Network Rail	OPBuriedServicesEnquiries@networkrail.co.uk	01904523401	Not Notified
Sota	SOTA.plantenquiries@instalcom.co.uk		Not Notified
Thames Water	http://www.digdat.co.uk	08450709145	Not Notified
Utility assets Ltd	assetrecords@utilityassets.co.uk		Not Notified
Verizon Business	osp-team@uk.verizonbusiness.com	01293611736	Not Notified
Virgin Media	http://www.digdat.co.uk	08708883116	Not Notified
Vodafone	osm.enquiries@atkinsglobal.com	01454662881	Not Notified

Disclaimer

Please refer to LineSearchbeforeUdig's Terms of Use for full terms of use available at www.linesearchbeforeudig.co.uk

The results of this Enquiry are personal to the Enquirer and shall not be shared with or relied upon by any other party. The asset information on which the Enquiry results are based has been provided by LSBUD Members, therefore LineSearchbeforeUdig will provide no guarantee that such information is accurate or reliable nor does it monitor such asset information for accuracy and reliability going forward. There may also be asset owners which do not participate in the enquiry service operated by LineSearchbeforeUdig, including but not exclusively those set out above. Therefore, LineSearchbeforeUdig cannot make any representation or give any guarantee or warranty as to the completeness of the information contained in the enquiry results or accept any responsibility for the accuracy of the mapping images used. LineSearchbeforeUdig and its employees, agents and consultants accept no liability (save that nothing in this Enquiry Confirmation excludes or limits our liability for death or personal injury arising from our negligence, or our fraud or fraudulent misrepresentation, or any other liability that cannot be excluded or limited by English law) arising in respect thereof or in any other way for errors or omissions including responsibility to any person by reason of negligence.

Our Ref: 25881050 Your Ref: 31188_004

Friday, 24 June 2022

Joe Shawyer
Suite 6 Princess Caroline House 1 High Street
Southend on Sea
Essex
SS1 1JE

Dear Joe Shawyer

Indigo Pipelines Ltd - Asset Network Plans

In response to your enquiry regarding the location of network and equipment at the requested location, copies of our Record Plans are enclosed.

The plans show the positions and normal depths for the buried Indigo Pipelines Ltd Gas Plant. When they were installed. It must be stressed, however, that alterations to road alignments, surface levels and buildings may have been made subsequent to the records being taken. If you find buried Gas Plant that are not marked or are incorrectly marked, then you are required to contact us as soon as possible to give us the opportunity to amend our records.

Please note that the plans supplied are based on the location/map information supplied by yourselves and, therefore, YOU MUST SATISFY YOURSELF THAT OUR PLANS SUPPLIED ADEQUATELY COVER THE AREA THAT YOU REQUIRE.

Please note that these records only show Gas plant owned by Indigo Pipelines Ltd. There may be other privately owned buried Gas Plant in the area, which is outside the control of Indigo Pipelines Ltd. You should also check with the Local Authority, Cadent; Southern Gas Networks, Scotland Gas networks & Wales & West Utilities before proceeding.

For more information, consult the Health & Safety Executive's booklet HS (G) 47 - obtainable from the HSE.

I would particularly draw your attention to the need to take trial holes to determine the exact position and depth of buried Gas Plant to avoid the risk of injury to staff or damage to the existing Plant.

General Advice:

-
- a) Please ensure, where appropriate, that your CONTRACTORS have a copy of this letter and the enclosed plan(s).
 - b) Please note that the cost of any repairs or claims against Indigo Pipelines Ltd as a result of your works will be invoiced to you or your contractor.
 - c) Indigo Pipelines Ltd retains the right to its property, including disconnected cables and recoverable materials.

Should you require further information, please do not hesitate to contact me on the below telephone number.

Kind regards,

Indigo Pipelines Ltd

Contact Us

Emergency and Supply issues

In an emergency call 0800 111 999, 24 hours a day.

Mapping Enquiries


If you have an enquiry relating to this letter or the attached map plan, please contact us using the following information:

Telephone: 0345 070 7386.
Email: DBYDEnterpriseEnquiries@sse.com

LineSearchbeforeUdig

If you have an enquiry relating to the use of the LineSearchbeforeUdig website please contact LineSearchbeforeUdig using the following information:

Telephone: 0845 437 7365
Email: enquiries@linesearchbeforeudig.co.uk
Website: www.linesearchbeforeudig.co.uk

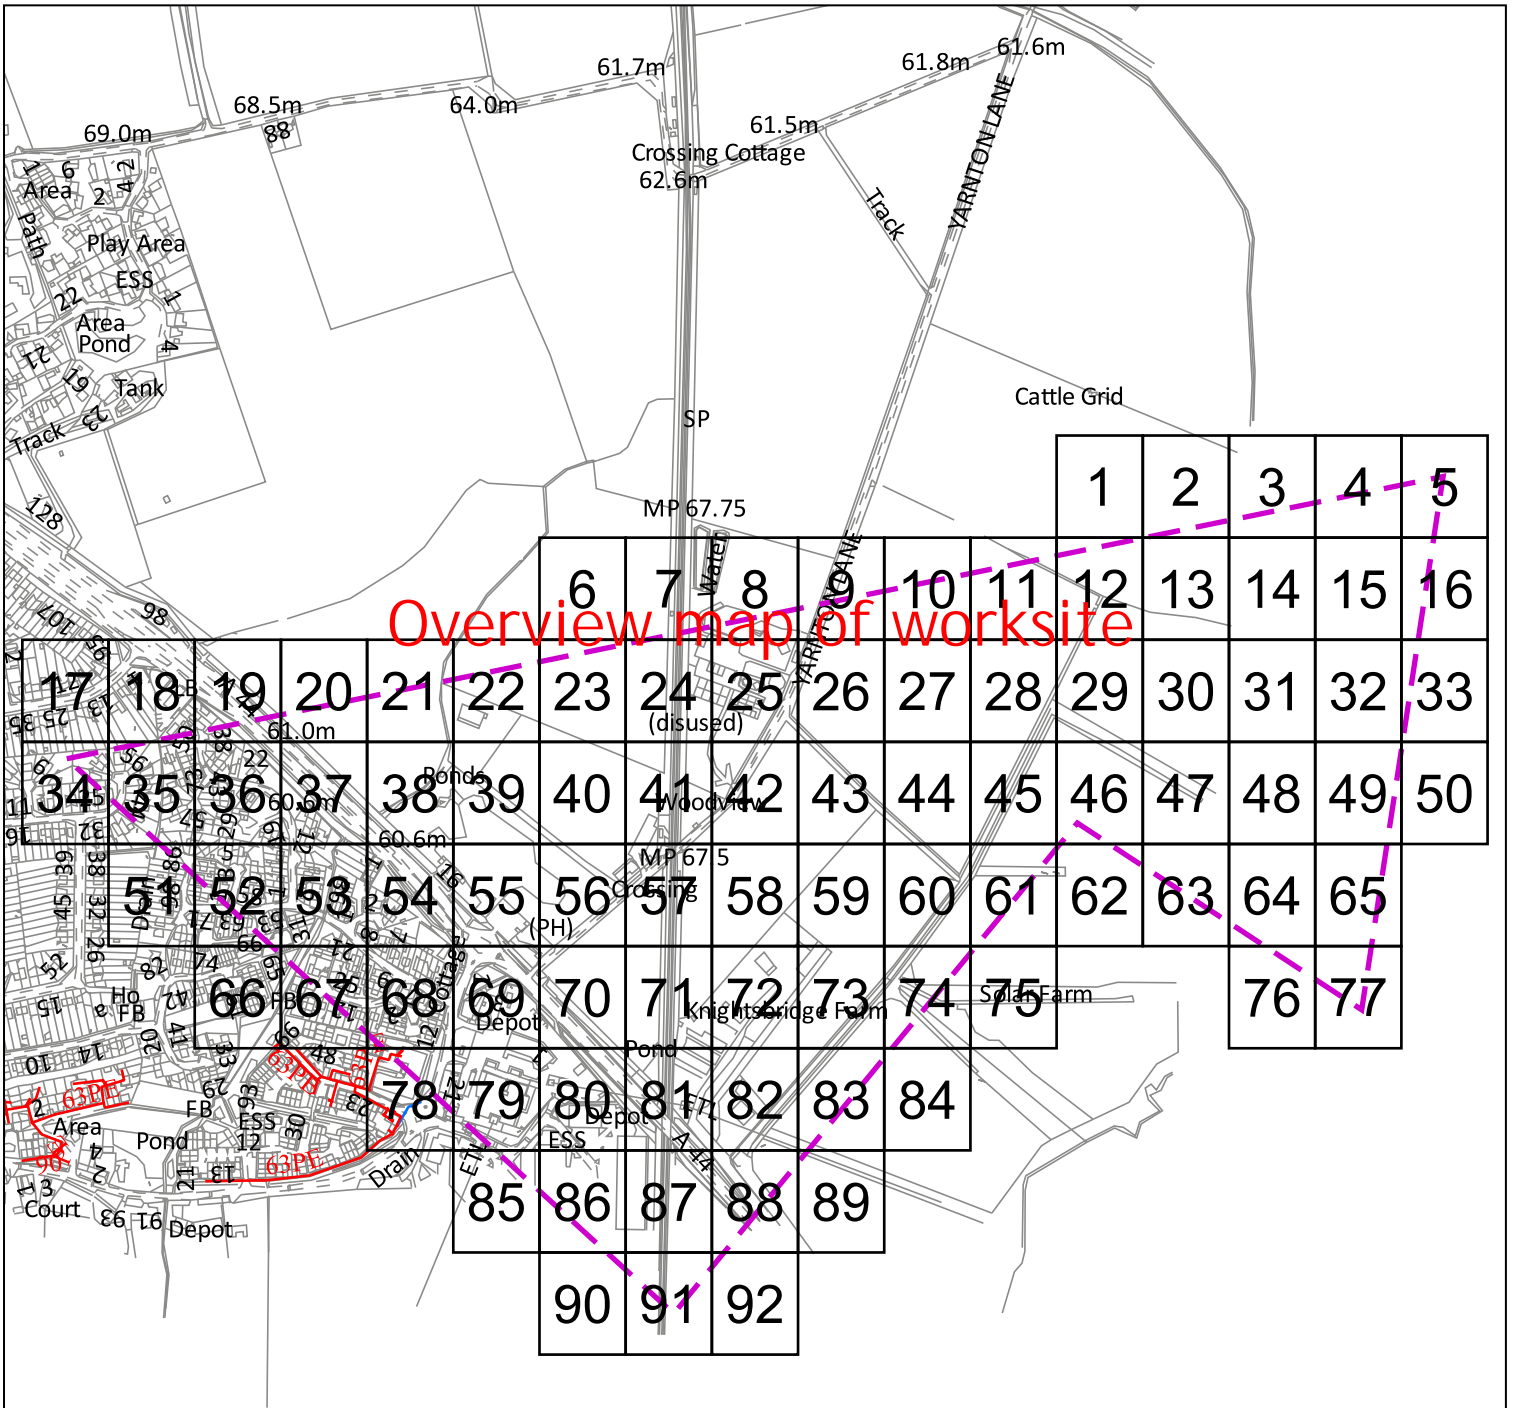

Warning: PDF designed for A4 colour print only with no page scaling












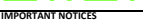
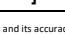
<p>Dig Sites Area: Line: </p>																
<p>Date Requested: 24/06/2022 Job Reference: 25881050 Site Location: 448447 212278 Requested by: Mr Joe Shawyer Your Scheme/Reference: 31188_004</p>	<table border="0"> <tr> <td> LP Main</td> <td> Valve Closed</td> <td> Reducer</td> </tr> <tr> <td> LP Service</td> <td> Valve Open</td> <td> Ducting</td> </tr> <tr> <td> MP Main</td> <td> CSEP</td> <td> Gas Supply Point</td> </tr> <tr> <td> MP Service</td> <td> Pressure Reduction Station</td> <td></td> </tr> <tr> <td> IP Main</td> <td> End Closure</td> <td></td> </tr> </table>	LP Main	Valve Closed	Reducer	LP Service	Valve Open	Ducting	MP Main	CSEP	Gas Supply Point	MP Service	Pressure Reduction Station		IP Main	End Closure	
LP Main	Valve Closed	Reducer														
LP Service	Valve Open	Ducting														
MP Main	CSEP	Gas Supply Point														
MP Service	Pressure Reduction Station															
IP Main	End Closure															
<p>IMPORTANT NOTICES</p> <ul style="list-style-type: none"> This information is given as a guide only and its accuracy cannot be guaranteed The plan only shows pipes owned by SSE Utility Solutions Limited, Indigo Pipelines Limited Service pipes etc. may not be shown but their presence should be anticipated You must use safe digging practices in accordance with H5(G)47 to establish the actual position of mains, services and other apparatus before any mechanical excavation is used It is your responsibility to ensure this information is provided to all persons working near our plant If in doubt call the SSE Enterprise Dial Before You Dig team on 0345 070 7386. <p>Please note: If you have overlaps or misalignments between base maps that make it difficult to understand please contact DBYDEnterpriseEnquiries@sse.com or call 0345 070 7386</p>																
<p>Scale: 1:8712 (When plotted at A4)</p>																

<p>Indigo Pipelines Ltd. Registered Office: Loddon Reach, Reading Road, Arborfield, Reading, Berkshire, RG2 9HU</p>	

Warning: PDF designed for A4 colour print only with no page scaling

0  20m Dig Sites Area:  Line: 

Date Requested: 24/06/2022
 Job Reference: 25881050
 Site Location: 448447 212278
 Requested by: Mr Joe Shawyer
 Your Scheme/Reference: 31188_004

	LP Main		Valve Closed		Reducer
	LP Service		Valve Open		Ducting
	MP Main		CSEP		Gas Supply Point
	MP Service		Pressure Reduction Station		
	IP Main		End Closure		

IMPORTANT NOTICES

- This information is given as a guide only and its accuracy cannot be guaranteed
- The plan only shows pipes owned by SSE Utility Solutions Limited, Indigo Pipelines Limited
- Service pipes etc. may not be shown but their presence should be anticipated
- You must use safe digging practices in accordance with H5(G)47 to establish the actual position of mains, services and other apparatus before any mechanical excavation is used
- It is your responsibility to ensure this information is provided to all persons working near our plant
- If in doubt call the SSE Enterprise Dial Before You Dig team on 0345 070 7386.

Please note: If you have overlaps or misalignments between base maps that make it difficult to understand please contact DBYDEnterpriseEnquiries@sse.com or call 0345 070 7386
















Indigo Pipelines Ltd.
 Registered Office:
 Loddon Reach,
 Reading Road,
 Arborfield,
 Reading,
 Berkshire, RG2 9HU

Scale: 1:500 (When plotted at A4)

Warning: PDF designed for A4 colour print only with no page scaling

0  20m Dig Sites Area:  Line: 

Date Requested: 24/06/2022
 Job Reference: 25881050
 Site Location: 448447 212278
 Requested by: Mr Joe Shawyer
 Your Scheme/Reference: 31188_004

 	LP Main		Valve Closed		Reducer
	LP Service		Valve Open		Ducting
	MP Main		CSEP		Gas Supply Point
	MP Service		Pressure Reduction Station		
	IP Main		End Closure		

IMPORTANT NOTICES

- This information is given as a guide only and its accuracy cannot be guaranteed
- The plan only shows pipes owned by SSE Utility Solutions Limited, Indigo Pipelines Limited
- Service pipes etc. may not be shown but their presence should be anticipated
- You must use safe digging practices in accordance with H5(G)47 to establish the actual position of mains, services and other apparatus before any mechanical excavation is used
- It is your responsibility to ensure this information is provided to all persons working near our plant
- If in doubt call the SSE Enterprise Dial Before You Dig team on 0345 070 7386.

Please note: If you have overlaps or misalignments between base maps that make it difficult to understand please contact DBYDEnterpriseEnquiries@sse.com or call 0345 070 7386
















Indigo Pipelines Ltd.
 Registered Office:
 Loddon Reach,
 Reading Road,
 Arborfield,
 Reading,
 Berkshire, RG2 9HU

Scale: 1:500 (When plotted at A4)

Warning: PDF designed for A4 colour print only with no page scaling

0  20m Dig Sites Area:  Line: 

Date Requested: 24/06/2022
 Job Reference: 25881050
 Site Location: 448447 212278
 Requested by: Mr Joe Shawyer
 Your Scheme/Reference: 31188_004

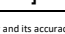	LP Main		Valve Closed		Reducer
	LP Service		Valve Open		Ducting
	MP Main		CSEP		Gas Supply Point
	MP Service		Pressure Reduction Station		
	IP Main		End Closure		


IMPORTANT NOTICES

- This information is given as a guide only and its accuracy cannot be guaranteed
- The plan only shows pipes owned by SSE Utility Solutions Limited, Indigo Pipelines Limited
- Service pipes etc. may not be shown but their presence should be anticipated
- You must use safe digging practices in accordance with H5(G)47 to establish the actual position of mains, services and other apparatus before any mechanical excavation is used
- It is your responsibility to ensure this information is provided to all persons working near our plant
- If in doubt call the SSE Enterprise Dial Before You Dig team on 0345 070 7386.

Please note: If you have overlaps or misalignments between base maps that make it difficult to understand please contact DBYDEnterpriseEnquiries@sse.com or call 0345 070 7386



Indigo Pipelines Ltd.
 Registered Office:
 Loddon Reach,
 Reading Road,
 Arborfield,
 Reading,
 Berkshire, RG2 9HU

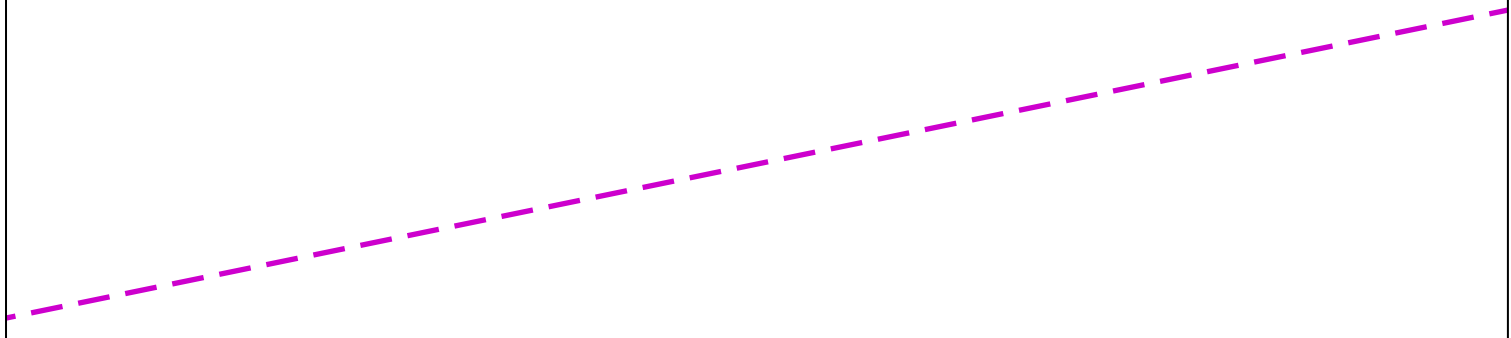

Warning: PDF designed for A4 colour print only with no page scaling

0 20m Dig Sites Area: Line:

	LP Main		Valve Closed		Reducer
	LP Service		Valve Open		Ducting
	MP Main		CSEP		Gas Supply Point
	MP Service		Pressure Reduction Station		
	IP Main		End Closure		

IMPORTANT NOTICES


- This information is given as a guide only and its accuracy cannot be guaranteed
- The plan only shows pipes owned by SSE Utility Solutions Limited, Indigo Pipelines Limited
- Service pipes etc. may not be shown but their presence should be anticipated
- You must use safe digging practices in accordance with H5(G)47 to establish the actual position of mains, services and other apparatus before any mechanical excavation is used
- It is your responsibility to ensure this information is provided to all persons working near our plant
- If in doubt call the SSE Enterprise Dial Before You Dig team on 0345 070 7386.

Please note: If you have overlaps or misalignments between base maps that make it difficult to understand please contact DBYDEnterpriseEnquiries@sse.com or call 0345 070 7386

Scale: 1:500 (When plotted at A4)



Indigo Pipelines Ltd.
 Registered Office:
 Loddon Reach,
 Reading Road,
 Arborfield,
 Reading,
 Berkshire, RG2 9HU

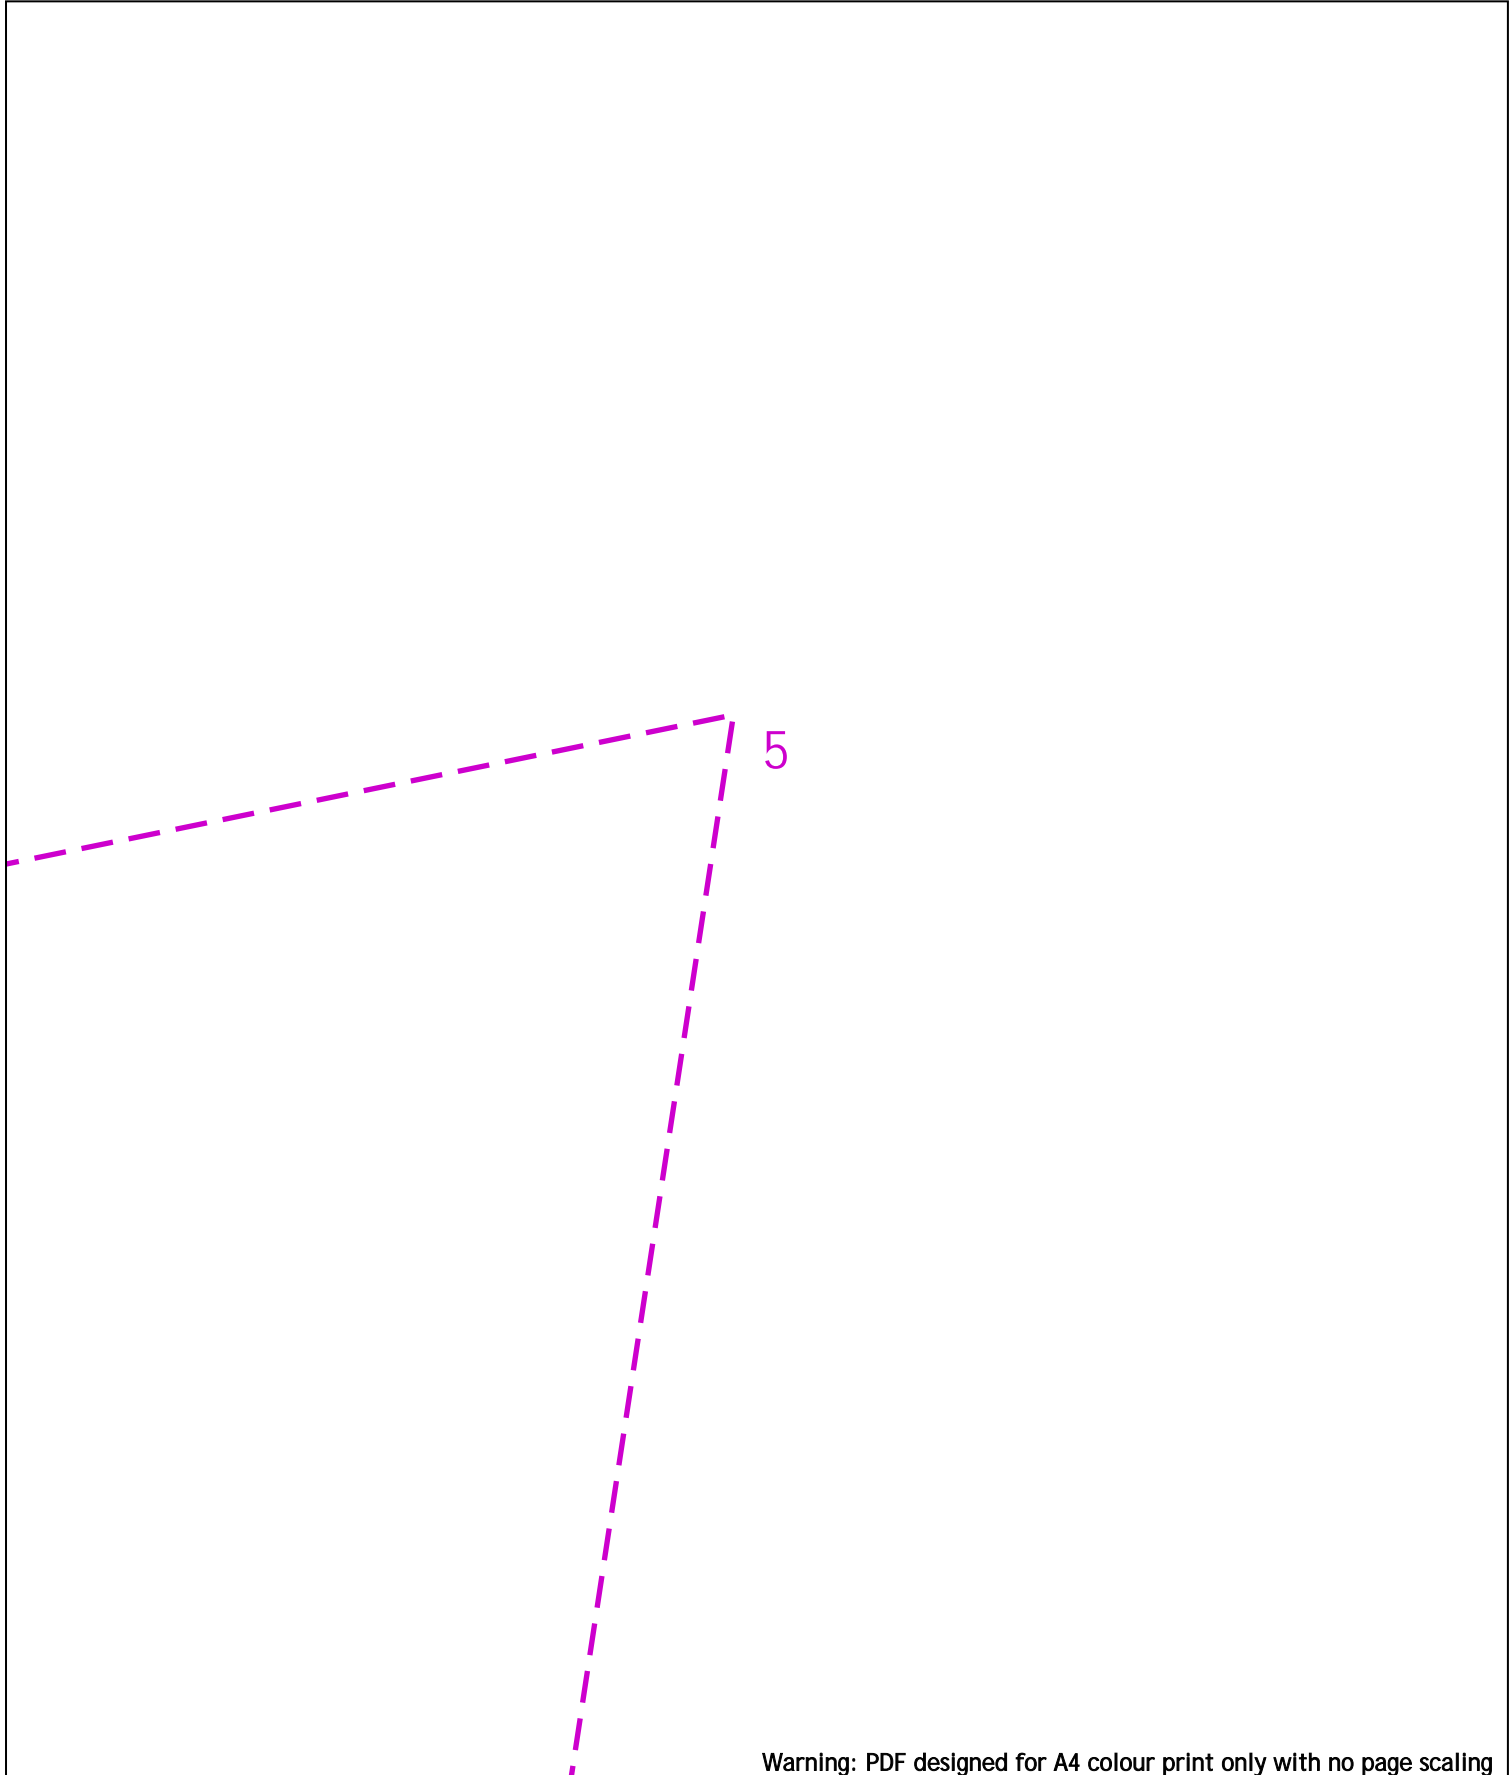

Warning: PDF designed for A4 colour print only with no page scaling

0 20m Dig Sites Area: Line:

	LP Main		Valve Closed		Reducer
	LP Service		Valve Open		Ducting
	MP Main		CSEP		Gas Supply Point
	MP Service		Pressure Reduction Station		
	IP Main		End Closure		

IMPORTANT NOTICES

- This information is given as a guide only and its accuracy cannot be guaranteed
- The plan only shows pipes owned by SSE Utility Solutions Limited, Indigo Pipelines Limited
- Service pipes etc. may not be shown but their presence should be anticipated
- You must use safe digging practices in accordance with H5(G)47 to establish the actual position of mains, services and other apparatus before any mechanical excavation is used
- It is your responsibility to ensure this information is provided to all persons working near our plant
- If in doubt call the SSE Enterprise Dial Before You Dig team on 0345 070 7386.

Please note: If you have overlaps or misalignments between base maps that make it difficult to understand please contact DBYDEnterpriseEnquiries@sse.com or call 0345 070 7386

Scale: 1:500 (When plotted at A4)
















Indigo Pipelines Ltd.
 Registered Office:
 Loddon Reach,
 Reading Road,
 Arborfield,
 Reading,
 Berkshire, RG2 9HU

Warning: PDF designed for A4 colour print only with no page scaling

0  20m Dig Sites Area:  Line: 

Date Requested: 24/06/2022
 Job Reference: 25881050
 Site Location: 448447 212278
 Requested by: Mr Joe Shawyer
 Your Scheme/Reference: 31188_004

 
	LP Main		Valve Closed		Reducer
	LP Service		Valve Open		Ducting
	MP Main		CSEP		Gas Supply Point
	MP Service		Pressure Reduction Station		
	IP Main		End Closure		

IMPORTANT NOTICES

- This information is given as a guide only and its accuracy cannot be guaranteed
 - The plan only shows pipes owned by SSE Utility Solutions Limited, Indigo Pipelines Limited
 - Service pipes etc. may not be shown but their presence should be anticipated
 - You must use safe digging practices in accordance with H5(G)47 to establish the actual position of mains, services and other apparatus before any mechanical excavation is used
 - It is your responsibility to ensure this information is provided to all persons working near our plant
 - If in doubt call the SSE Enterprise Dial Before You Dig team on 0345 070 7386.
- Please note:** If you have overlaps or misalignments between base maps that make it difficult to understand please contact DBYDEnterpriseEnquiries@sse.com or call 0345 070 7386



Indigo Pipelines Ltd.
 Registered Office:
 Loddon Reach,
 Reading Road,
 Arborfield,
 Reading,
 Berkshire, RG2 9HU

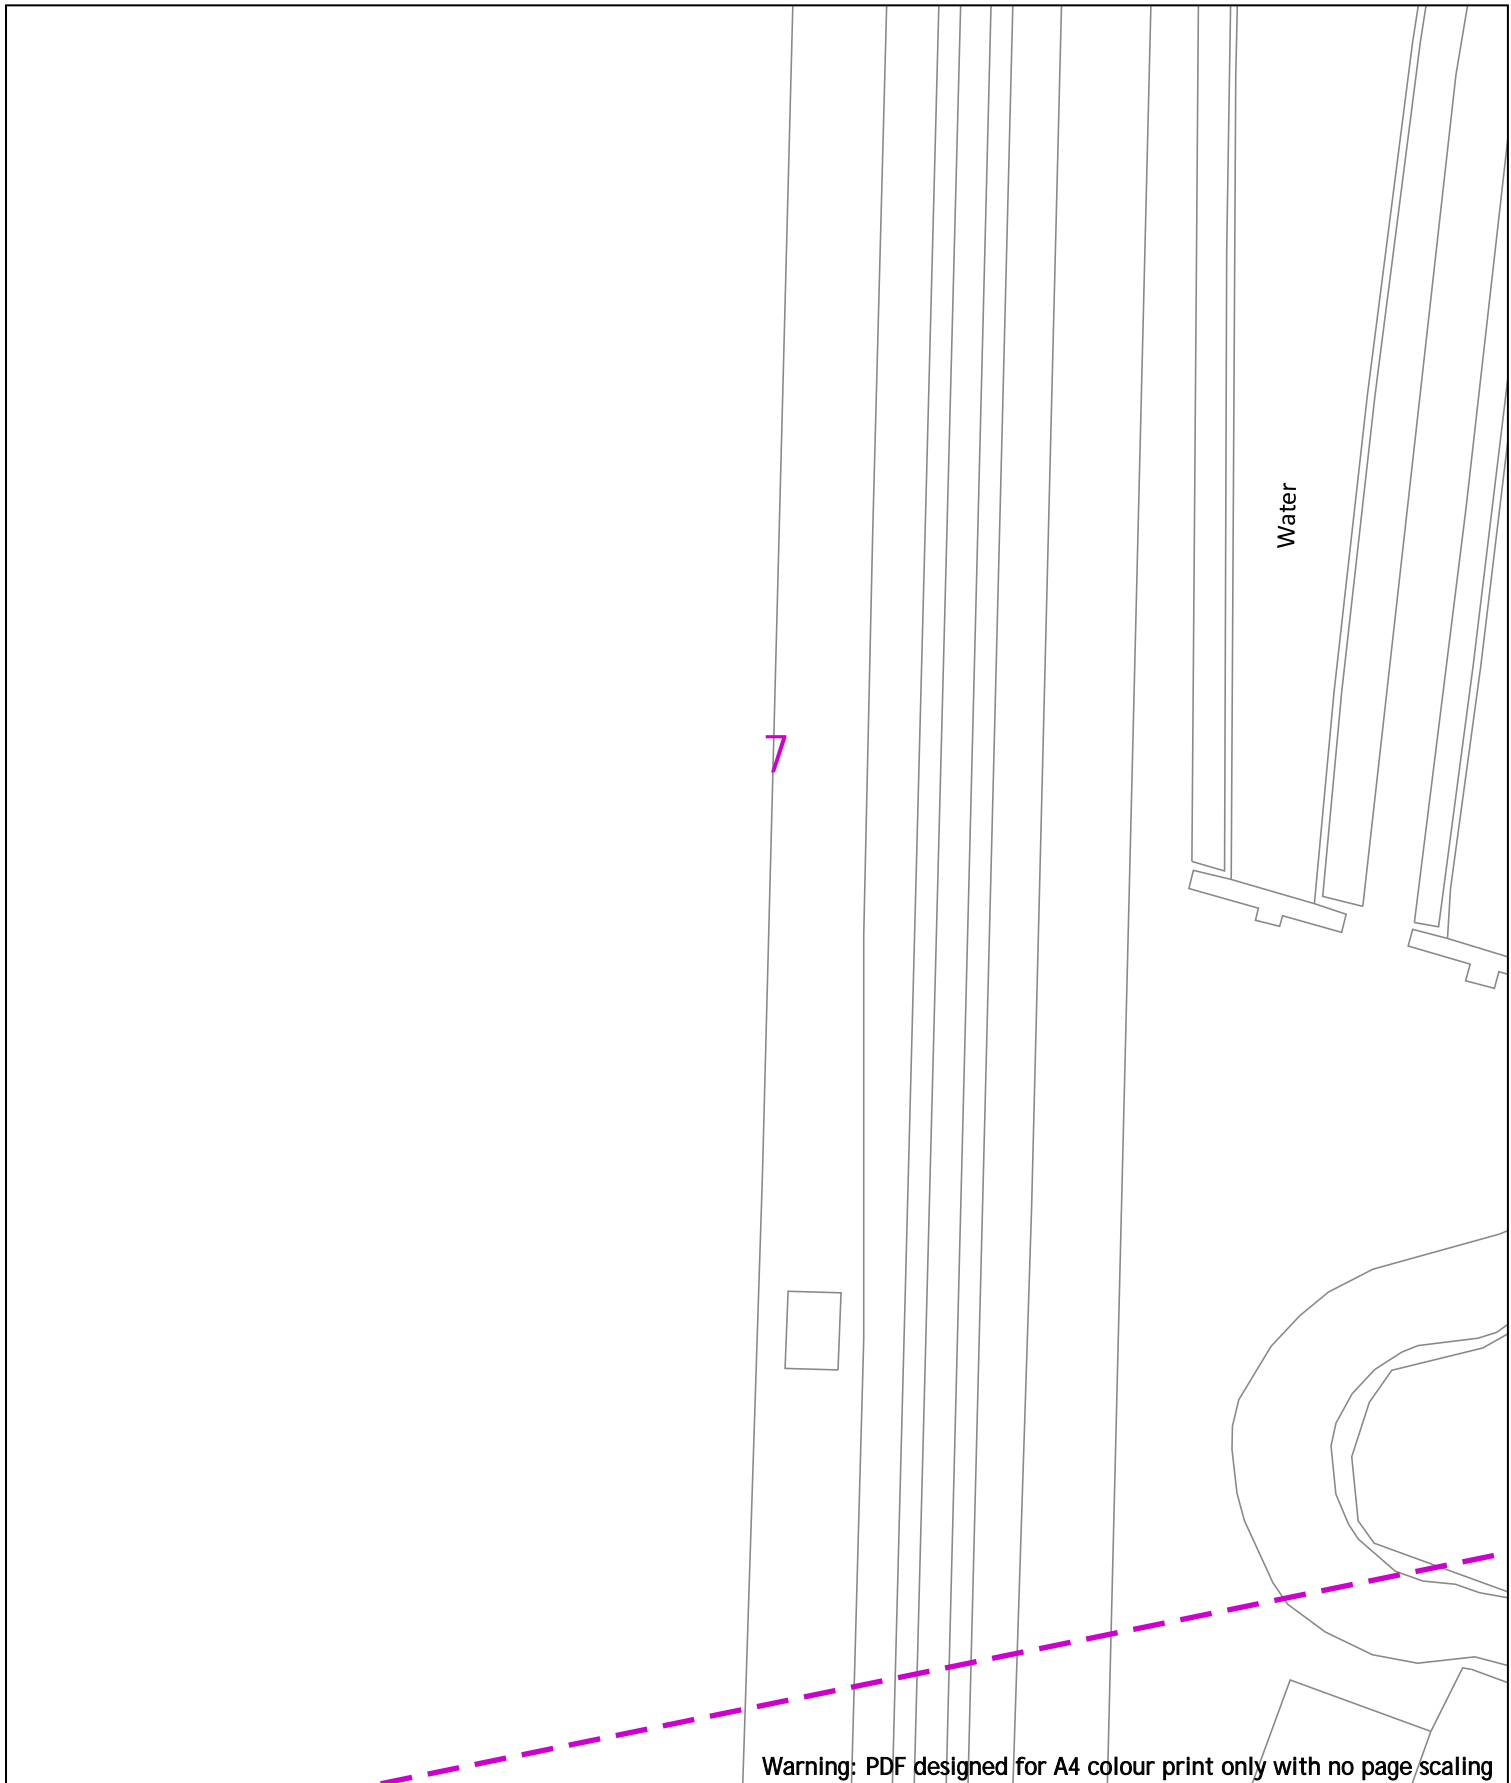

Warning: PDF designed for A4 colour print only with no page scaling

0 20m Dig Sites Area: Line:

LP Main	Valve Closed	Reducer
LP Service	Valve Open	Ducting
MP Main	CSEP	Gas Supply Point
MP Service	Pressure Reduction Station	
IP Main	End Closure	

IMPORTANT NOTICES


- This information is given as a guide only and its accuracy cannot be guaranteed
- The plan only shows pipes owned by SSE Utility Solutions Limited, Indigo Pipelines Limited
- Service pipes etc. may not be shown but their presence should be anticipated
- You must use safe digging practices in accordance with H5(G)47 to establish the actual position of mains, services and other apparatus before any mechanical excavation is used
- It is your responsibility to ensure this information is provided to all persons working near our plant
- If in doubt call the SSE Enterprise Dial Before You Dig team on 0345 070 7386.

Please note: If you have overlaps or misalignments between base maps that make it difficult to understand please contact DBYDEnterpriseEnquiries@sse.com or call 0345 070 7386

Date Requested: 24/06/2022
 Job Reference: 25881050
 Site Location: 448447 212278
 Requested by: Mr Joe Shawyer
 Your Scheme/Reference: 31188_004

Scale: 1:500 (When plotted at A4)

Indigo Pipelines Ltd.
 Registered Office:
 Loddon Reach,
 Reading Road,
 Arborfield,
 Reading,
 Berkshire, RG2 9HU

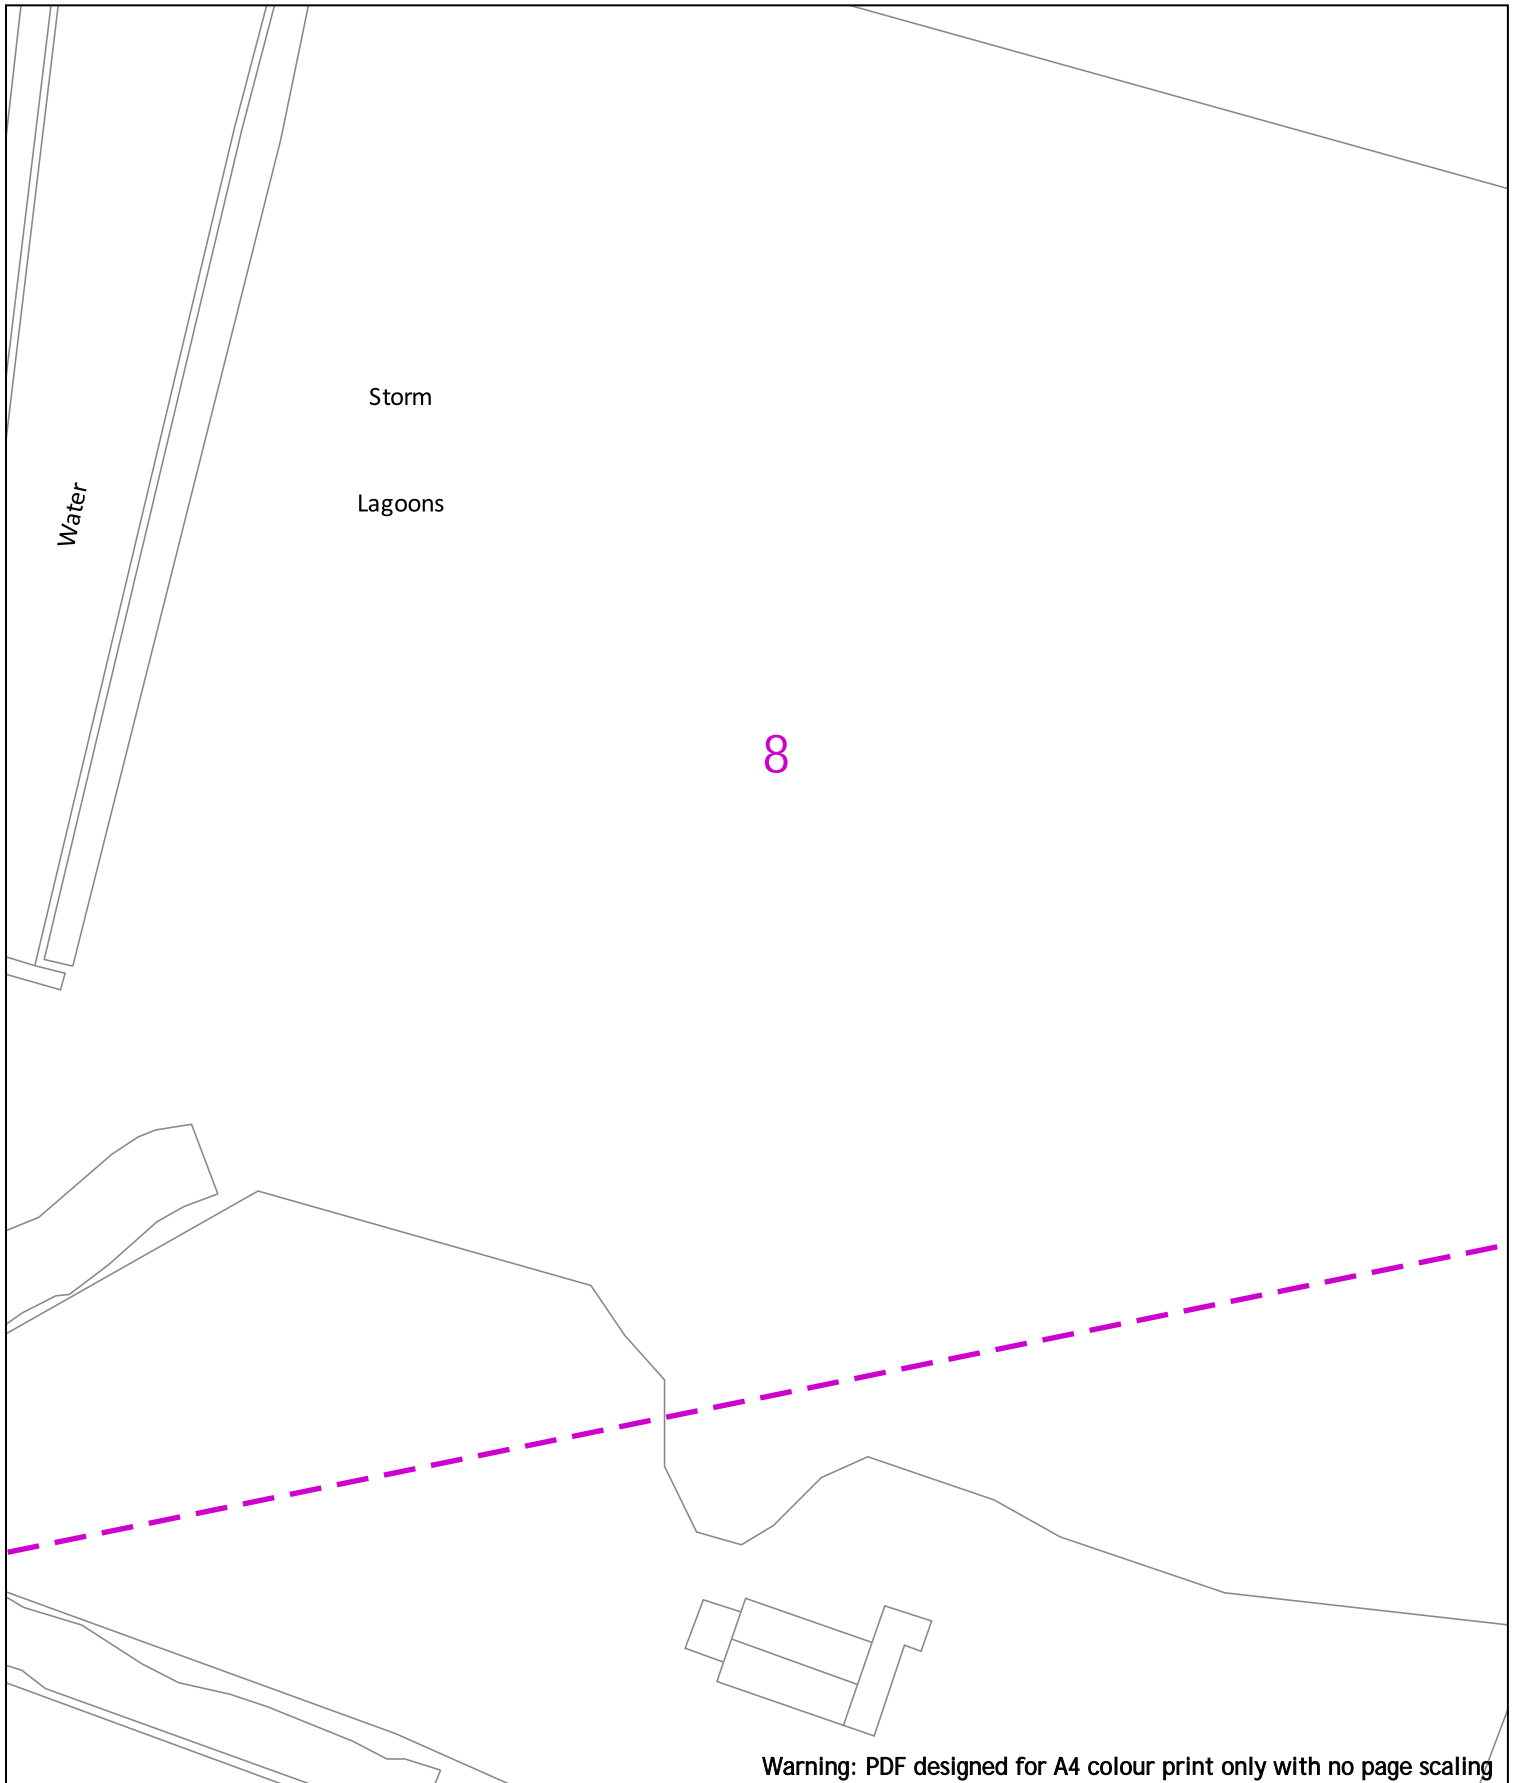

Warning: PDF designed for A4 colour print only with no page scaling

0 20m Dig Sites Area: Line:

LP Main	Valve Closed	Reducer
LP Service	Valve Open	Ducting
MP Main	CSEP	Gas Supply Point
MP Service	Pressure Reduction Station	
IP Main	End Closure	

IMPORTANT NOTICES


- This information is given as a guide only and its accuracy cannot be guaranteed
- The plan only shows pipes owned by SSE Utility Solutions Limited, Indigo Pipelines Limited
- Service pipes etc. may not be shown but their presence should be anticipated
- You must use safe digging practices in accordance with H5(G)47 to establish the actual position of mains, services and other apparatus before any mechanical excavation is used
- It is your responsibility to ensure this information is provided to all persons working near our plant
- If in doubt call the SSE Enterprise Dial Before You Dig team on 0345 070 7386.

Please note: If you have overlaps or misalignments between base maps that make it difficult to understand please contact DBYDEnterpriseEnquiries@sse.com or call 0345 070 7386

Date Requested: 24/06/2022
 Job Reference: 25881050
 Site Location: 448447 212278
 Requested by: Mr Joe Shawyer
 Your Scheme/Reference: 31188_004

Scale: 1:500 (When plotted at A4)

Indigo Pipelines Ltd.
 Registered Office:
 Loddon Reach,
 Reading Road,
 Arborfield,
 Reading,
 Berkshire, RG2 9HU

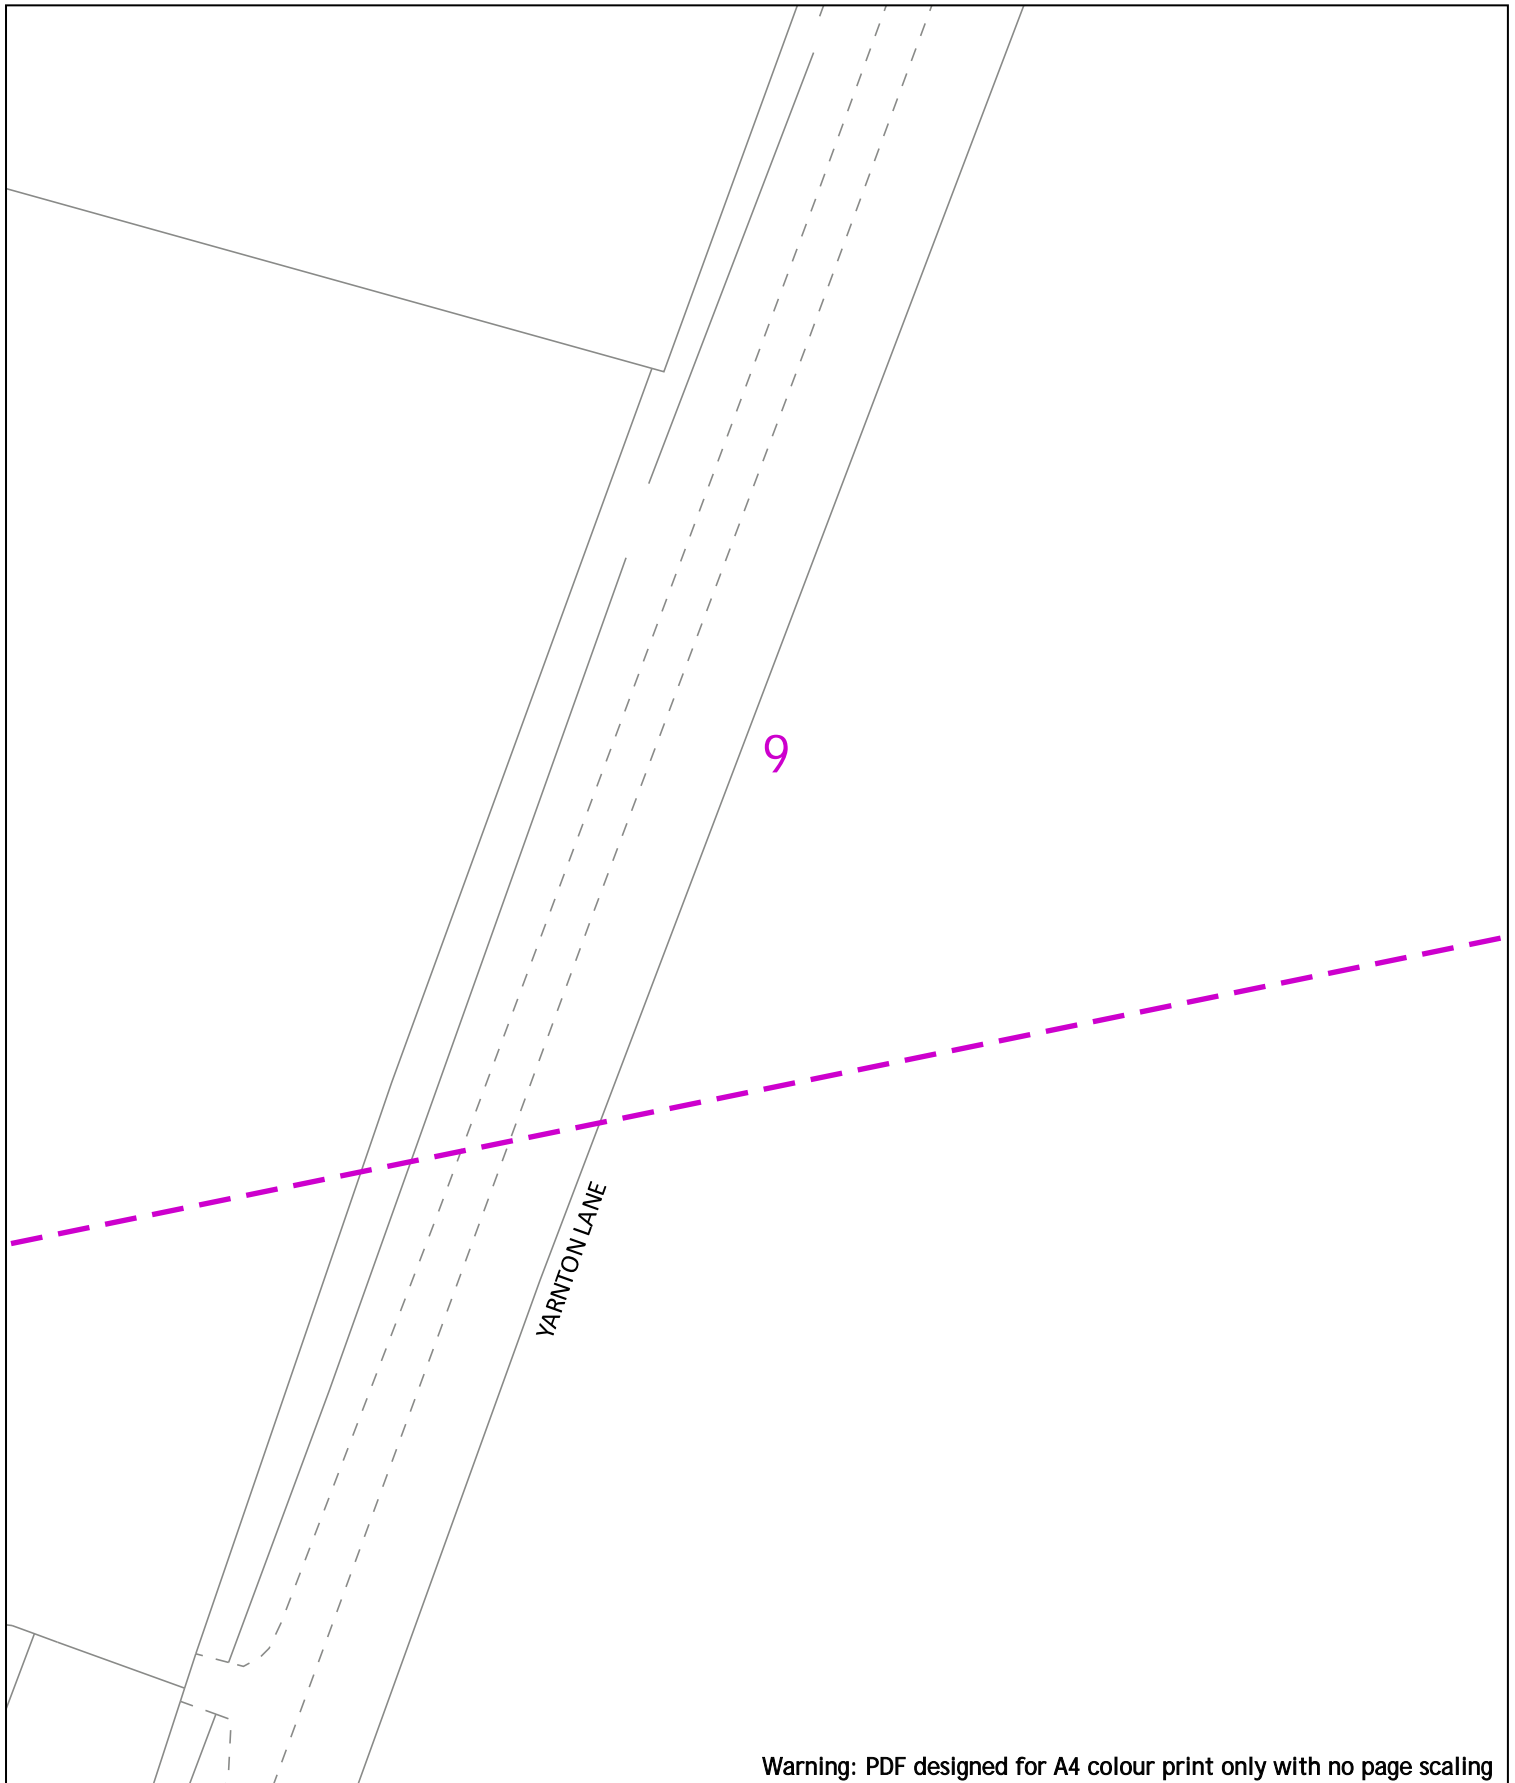

Warning: PDF designed for A4 colour print only with no page scaling

0 20m Dig Sites Area: Line:

LP Main	Valve Closed	Reducer
LP Service	Valve Open	Ducting
MP Main	CSEP	Gas Supply Point
MP Service	Pressure Reduction Station	
IP Main	End Closure	

IMPORTANT NOTICES


- This information is given as a guide only and its accuracy cannot be guaranteed
- The plan only shows pipes owned by SSE Utility Solutions Limited, Indigo Pipelines Limited
- Service pipes etc. may not be shown but their presence should be anticipated
- You must use safe digging practices in accordance with H5(G)47 to establish the actual position of mains, services and other apparatus before any mechanical excavation is used
- It is your responsibility to ensure this information is provided to all persons working near our plant
- If in doubt call the SSE Enterprise Dial Before You Dig team on 0345 070 7386.

Please note: If you have overlaps or misalignments between base maps that make it difficult to understand please contact DBYDEnterpriseEnquiries@sse.com or call 0345 070 7386

Scale: 1:500 (When plotted at A4)




Indigo Pipelines Ltd.
 Registered Office:
 Loddon Reach,
 Reading Road,
 Arborfield,
 Reading,
 Berkshire, RG2 9HU

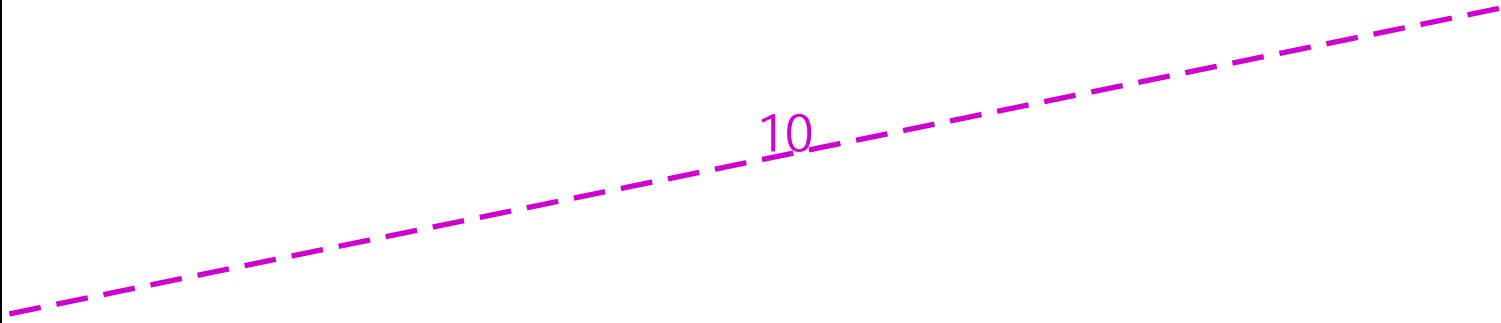

Warning: PDF designed for A4 colour print only with no page scaling

0 20m Dig Sites Area: Line:

Date Requested: 24/06/2022
 Job Reference: 25881050
 Site Location: 448447 212278
 Requested by: Mr Joe Shawyer
 Your Scheme/Reference: 31188_004

	LP Main		Valve Closed		Reducer
	LP Service		Valve Open		Ducting
	MP Main		CSEP		Gas Supply Point
	MP Service		Pressure Reduction Station		
	IP Main		End Closure		




Indigo Pipelines Ltd.
 Registered Office:
 Loddon Reach,
 Reading Road,
 Arborfield,
 Reading,
 Berkshire, RG2 9HU

IMPORTANT NOTICES

- This information is given as a guide only and its accuracy cannot be guaranteed
- The plan only shows pipes owned by SSE Utility Solutions Limited, Indigo Pipelines Limited
- Service pipes etc. may not be shown but their presence should be anticipated
- You must use safe digging practices in accordance with H5(G)47 to establish the actual position of mains, services and other apparatus before any mechanical excavation is used
- It is your responsibility to ensure this information is provided to all persons working near our plant
- If in doubt call the SSE Enterprise Dial Before You Dig team on 0345 070 7386.




Please note: If you have overlaps or misalignments between base maps that make it difficult to understand please contact DBYDEnterpriseEnquiries@sse.com or call 0345 070 7386

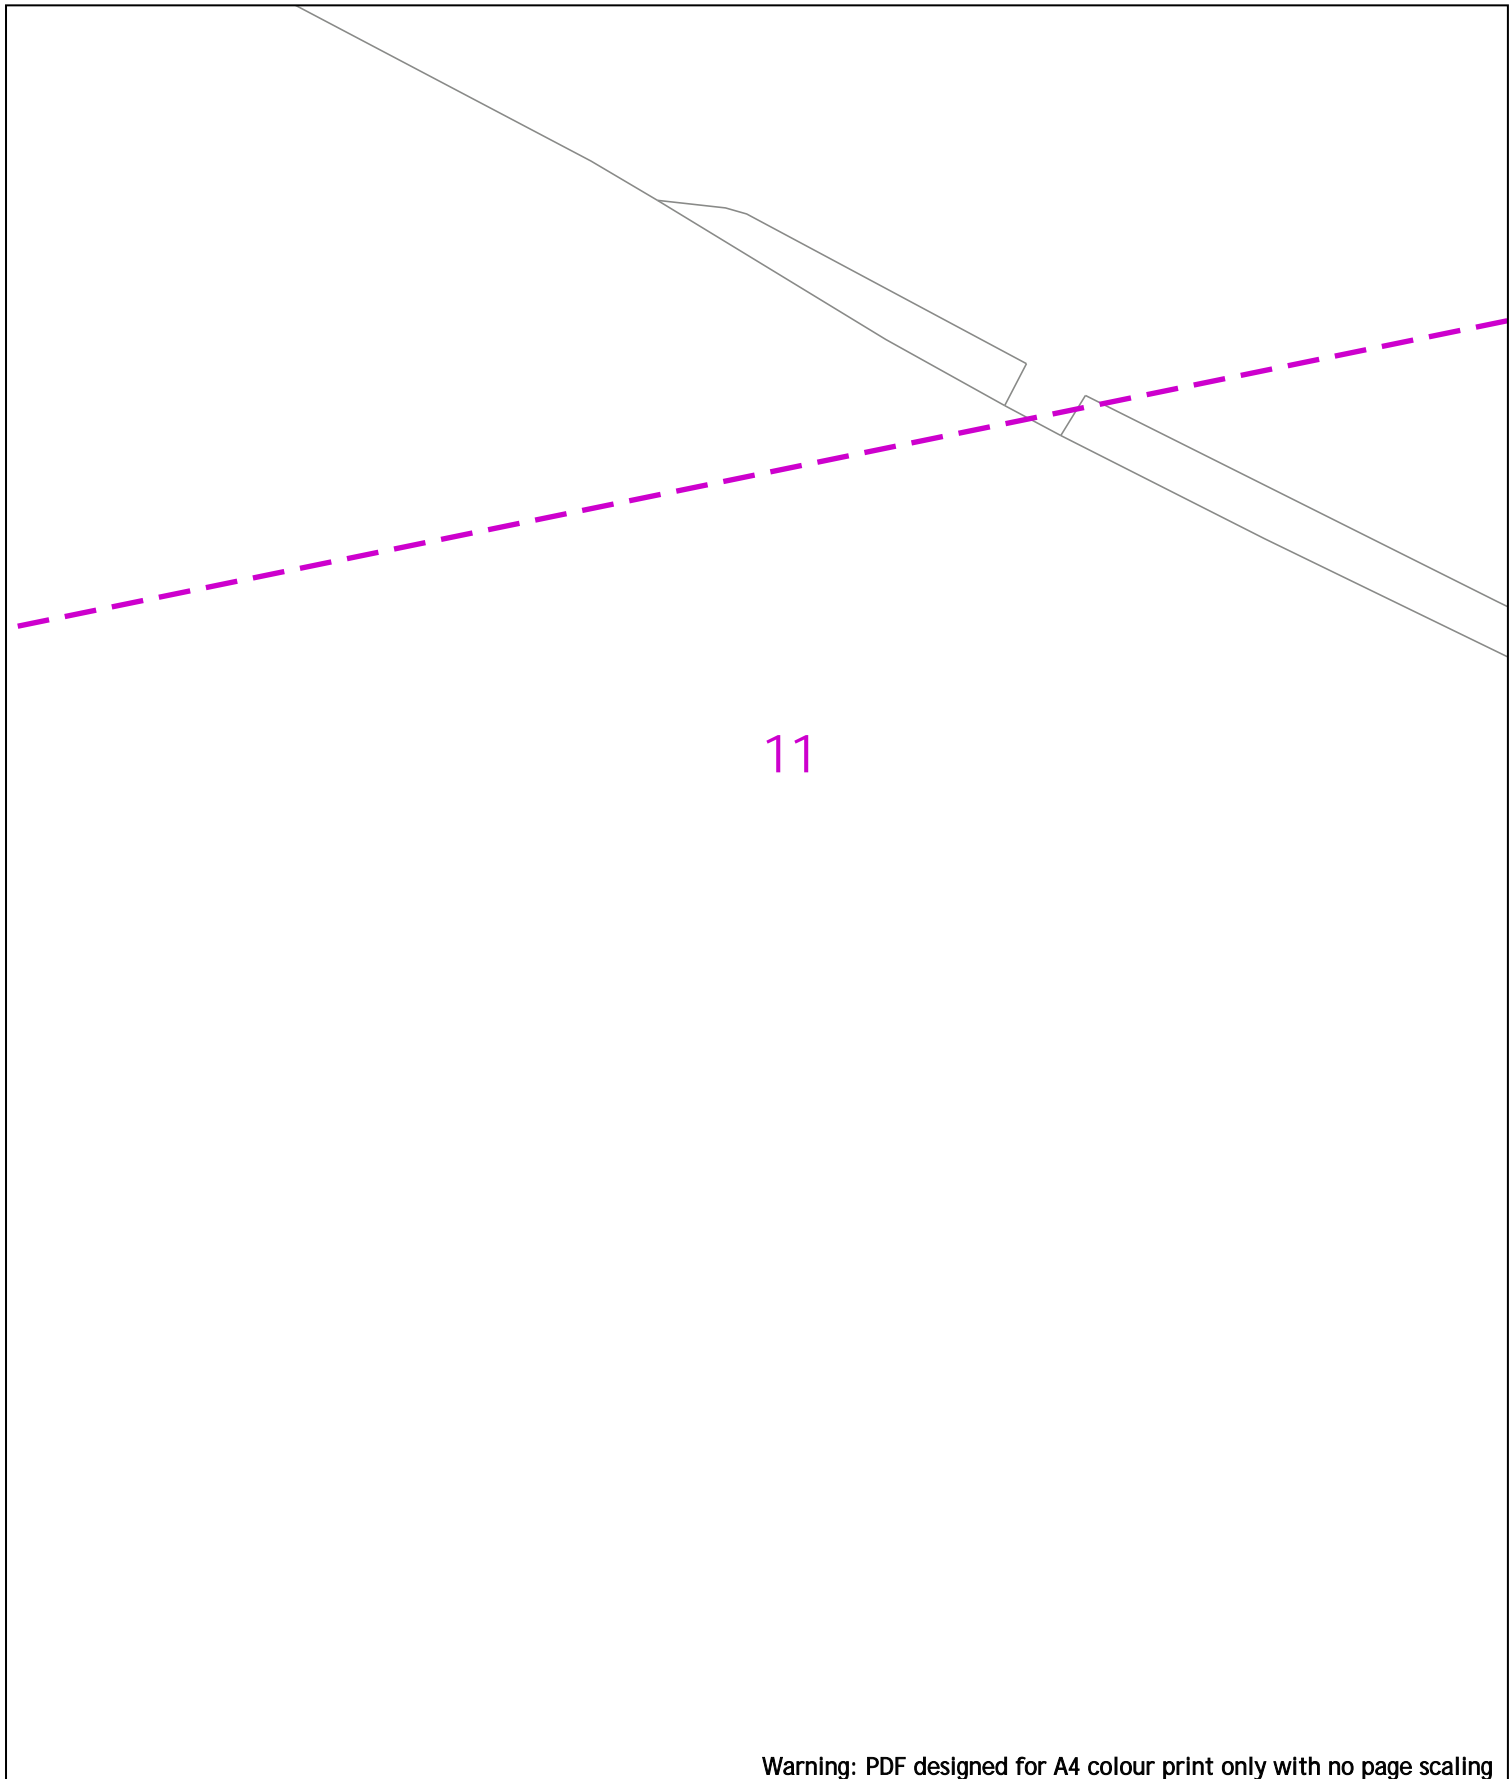










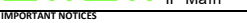
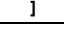
Scale: 1:500 (When plotted at A4)



11

Warning: PDF designed for A4 colour print only with no page scaling

0  20m Dig Sites Area:  Line: 

 LP Main	 Valve Closed	 Reducer
 LP Service	 Valve Open	 Ducting
 MP Main	 CSEP	 Gas Supply Point
 MP Service	 Pressure Reduction Station	
 IP Main	 End Closure	

IMPORTANT NOTICES


- This information is given as a guide only and its accuracy cannot be guaranteed
- The plan only shows pipes owned by SSE Utility Solutions Limited, Indigo Pipelines Limited
- Service pipes etc. may not be shown but their presence should be anticipated
- You must use safe digging practices in accordance with H5(G)47 to establish the actual position of mains, services and other apparatus before any mechanical excavation is used
- It is your responsibility to ensure this information is provided to all persons working near our plant
- If in doubt call the SSE Enterprise Dial Before You Dig team on 0345 070 7386.

Please note: If you have overlaps or misalignments between base maps that make it difficult to understand please contact DBYDEnterpriseEnquiries@sse.com or call 0345 070 7386

Scale: 1:500 (When plotted at A4)




Indigo Pipelines Ltd.
 Registered Office:
 Loddon Reach,
 Reading Road,
 Arborfield,
 Reading,
 Berkshire, RG2 9HU

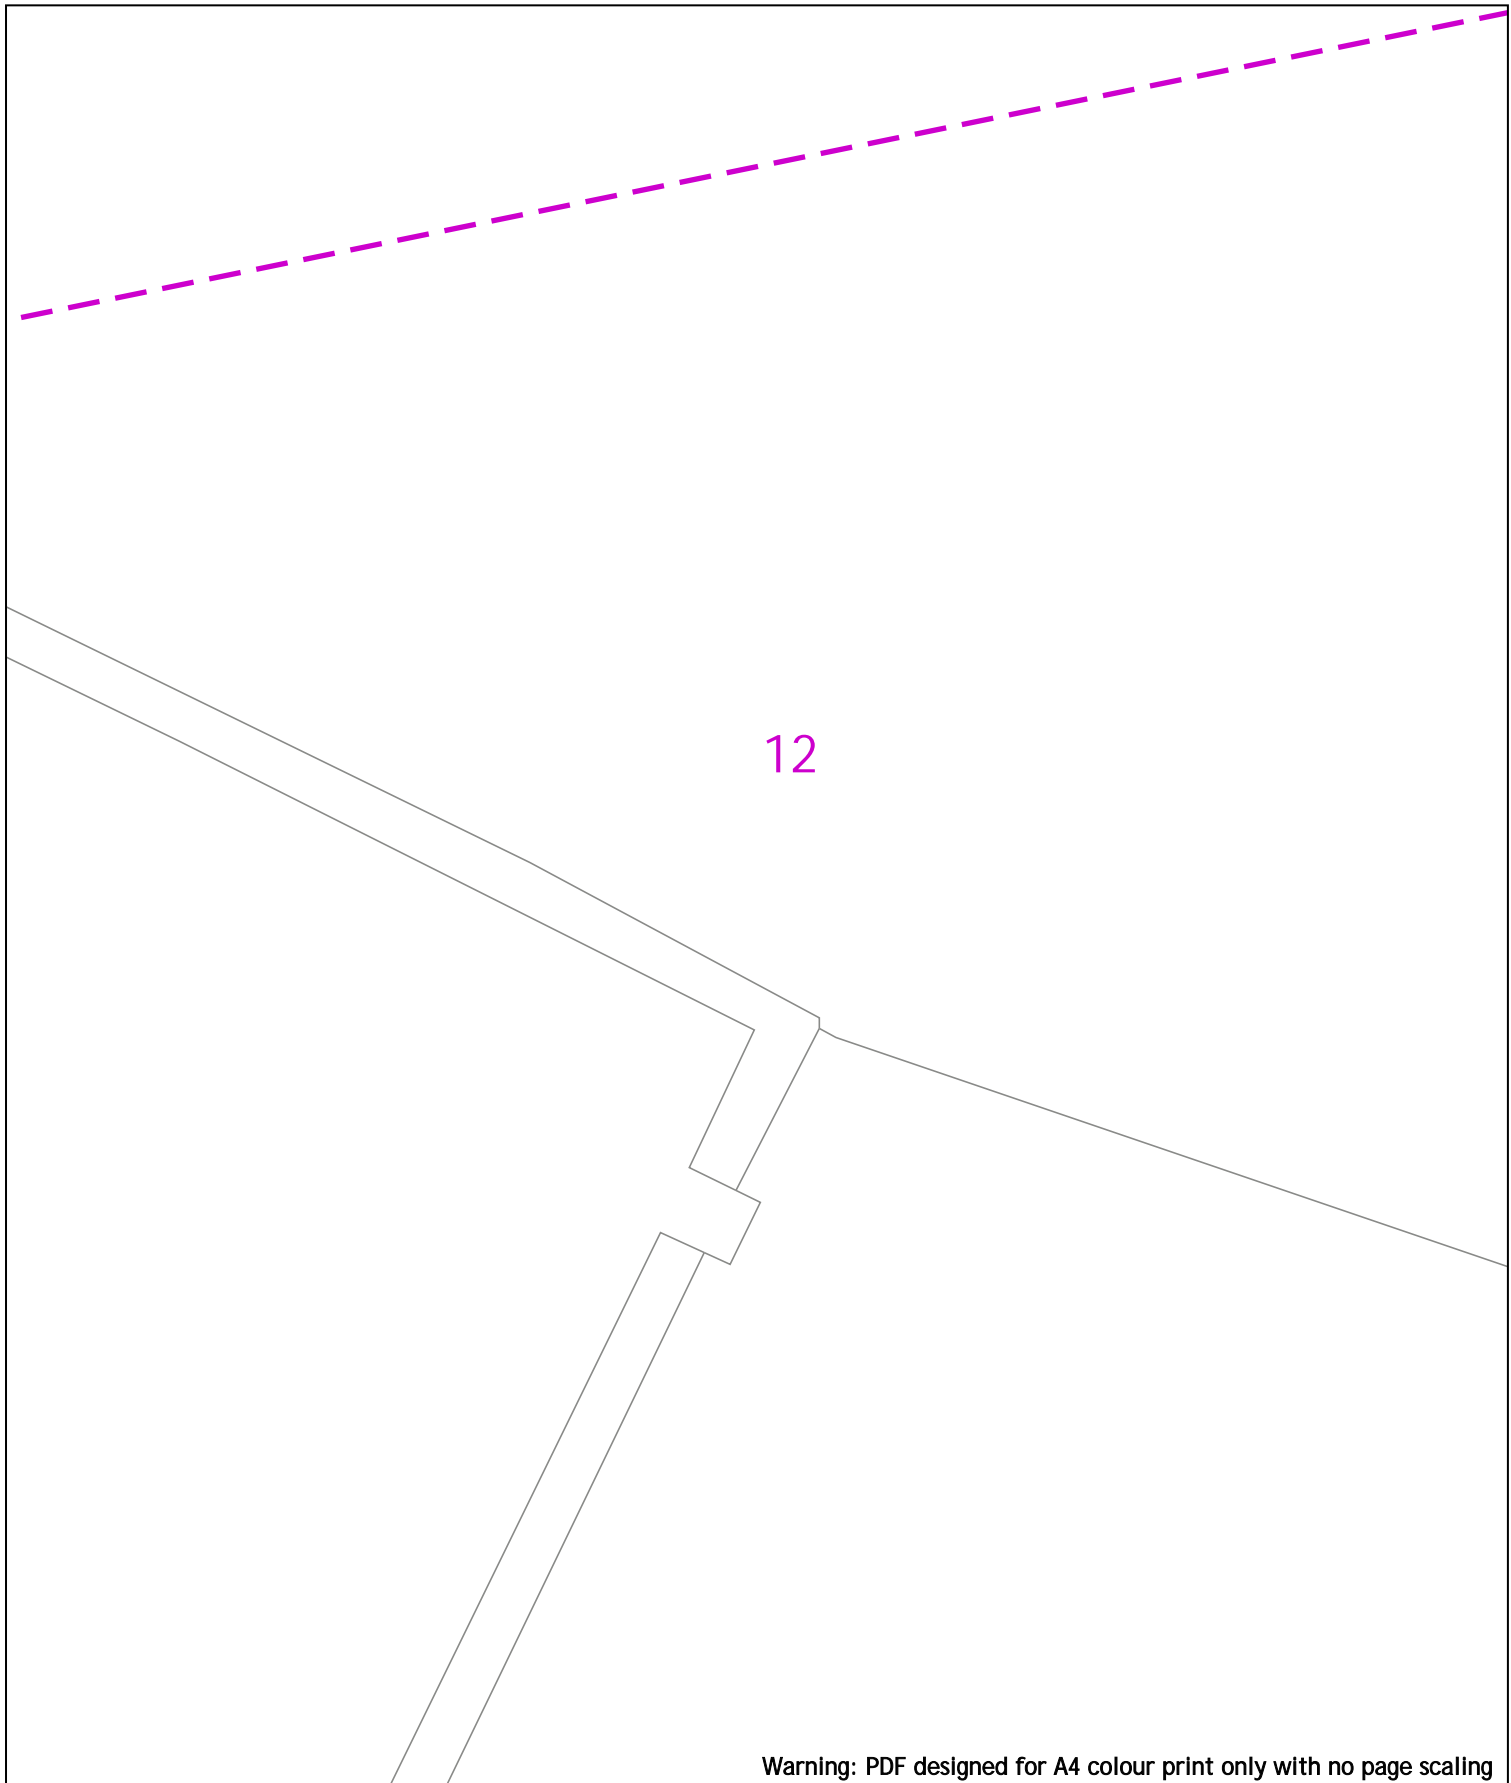








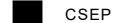





Warning: PDF designed for A4 colour print only with no page scaling

<p>0 20m Dig Sites Area: Line: </p>	<p> </p>															
<p>Date Requested: 24/06/2022 Job Reference: 25881050 Site Location: 448447 212278 Requested by: Mr Joe Shawyer Your Scheme/Reference: 31188_004</p>	<table border="0"> <tr> <td> LP Main</td> <td> Valve Closed</td> <td> Reducer</td> </tr> <tr> <td> LP Service</td> <td> Valve Open</td> <td> Ducting</td> </tr> <tr> <td> MP Main</td> <td> CSEP</td> <td> Gas Supply Point</td> </tr> <tr> <td> MP Service</td> <td> Pressure Reduction Station</td> <td></td> </tr> <tr> <td> IP Main</td> <td> End Closure</td> <td></td> </tr> </table>	LP Main	Valve Closed	Reducer	LP Service	Valve Open	Ducting	MP Main	CSEP	Gas Supply Point	MP Service	Pressure Reduction Station		IP Main	End Closure	
LP Main	Valve Closed	Reducer														
LP Service	Valve Open	Ducting														
MP Main	CSEP	Gas Supply Point														
MP Service	Pressure Reduction Station															
IP Main	End Closure															
<p>Scale: 1:500 (When plotted at A4)</p>	<p>IMPORTANT NOTICES</p> <ul style="list-style-type: none"> This information is given as a guide only and its accuracy cannot be guaranteed The plan only shows pipes owned by SSE Utility Solutions Limited, Indigo Pipelines Limited Service pipes etc. may not be shown but their presence should be anticipated You must use safe digging practices in accordance with H5(G)47 to establish the actual position of mains, services and other apparatus before any mechanical excavation is used It is your responsibility to ensure this information is provided to all persons working near our plant If in doubt call the SSE Enterprise Dial Before You Dig team on 0345 070 7386. <p>Please note: If you have overlaps or misalignments between base maps that make it difficult to understand please contact DBYDEnterpriseEnquiries@sse.com or call 0345 070 7386</p>															

Warning: PDF designed for A4 colour print only with no page scaling

0  20m Dig Sites Area:  Line: 

Date Requested: 24/06/2022
 Job Reference: 25881050
 Site Location: 448447 212278
 Requested by: Mr Joe Shawyer
 Your Scheme/Reference: 31188_004

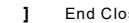 LP Main	 Valve Closed	 Reducer
 LP Service	 Valve Open	 Ducting
 MP Main	 CSEP	 Gas Supply Point
 MP Service	 Pressure Reduction Station	
 IP Main	 End Closure	



Indigo Pipelines Ltd.
 Registered Office:
 Loddon Reach,
 Reading Road,
 Arborfield,
 Reading,
 Berkshire, RG2 9HU


IMPORTANT NOTICES

- This information is given as a guide only and its accuracy cannot be guaranteed
- The plan only shows pipes owned by SSE Utility Solutions Limited, Indigo Pipelines Limited
- Service pipes etc. may not be shown but their presence should be anticipated
- You must use safe digging practices in accordance with H5(G)47 to establish the actual position of mains, services and other apparatus before any mechanical excavation is used
- It is your responsibility to ensure this information is provided to all persons working near our plant
- If in doubt call the SSE Enterprise Dial Before You Dig team on 0345 070 7386.














Please note: If you have overlaps or misalignments between base maps that make it difficult to understand please contact DBYDEnterpriseEnquiries@sse.com or call 0345 070 7386

Scale: 1:500 (When plotted at A4)

Warning: PDF designed for A4 colour print only with no page scaling

0  20m Dig Sites Area:  Line: 

Date Requested: 24/06/2022
 Job Reference: 25881050
 Site Location: 448447 212278
 Requested by: Mr Joe Shawyer
 Your Scheme/Reference: 31188_004

	LP Main		Valve Closed		Reducer
	LP Service		Valve Open		Ducting
	MP Main		CSEP		Gas Supply Point
	MP Service		Pressure Reduction Station		
	IP Main		End Closure		

IMPORTANT NOTICES

- This information is given as a guide only and its accuracy cannot be guaranteed
- The plan only shows pipes owned by SSE Utility Solutions Limited, Indigo Pipelines Limited
- Service pipes etc. may not be shown but their presence should be anticipated
- You must use safe digging practices in accordance with H5(G)47 to establish the actual position of mains, services and other apparatus before any mechanical excavation is used
- It is your responsibility to ensure this information is provided to all persons working near our plant
- If in doubt call the SSE Enterprise Dial Before You Dig team on 0345 070 7386.

Please note: If you have overlaps or misalignments between base maps that make it difficult to understand please contact DBYDEnterpriseEnquiries@sse.com or call 0345 070 7386
















Indigo Pipelines Ltd.
 Registered Office:
 Loddon Reach,
 Reading Road,
 Arborfield,
 Reading,
 Berkshire, RG2 9HU

Scale: 1:500 (When plotted at A4)

Warning: PDF designed for A4 colour print only with no page scaling

0  20m Dig Sites Area:  Line: 

Date Requested: 24/06/2022
 Job Reference: 25881050
 Site Location: 448447 212278
 Requested by: Mr Joe Shawyer
 Your Scheme/Reference: 31188_004

 	LP Main		Valve Closed		Reducer
	LP Service		Valve Open		Ducting
	MP Main		CSEP		Gas Supply Point
	MP Service		Pressure Reduction Station		
	IP Main		End Closure		

IMPORTANT NOTICES

- This information is given as a guide only and its accuracy cannot be guaranteed
- The plan only shows pipes owned by SSE Utility Solutions Limited, Indigo Pipelines Limited
- Service pipes etc. may not be shown but their presence should be anticipated
- You must use safe digging practices in accordance with H5(G)47 to establish the actual position of mains, services and other apparatus before any mechanical excavation is used
- It is your responsibility to ensure this information is provided to all persons working near our plant
- If in doubt call the SSE Enterprise Dial Before You Dig team on 0345 070 7386.

Please note: If you have overlaps or misalignments between base maps that make it difficult to understand please contact DBYDEnterpriseEnquiries@sse.com or call 0345 070 7386



Indigo Pipelines Ltd.
 Registered Office:
 Loddon Reach,
 Reading Road,
 Arborfield,
 Reading,
 Berkshire, RG2 9HU














Scale: 1:500 (When plotted at A4)

16

Warning: PDF designed for A4 colour print only with no page scaling

0  20m Dig Sites Area:  Line: 

Date Requested: 24/06/2022
Job Reference: 25881050
Site Location: 448447 212278
Requested by: Mr Joe Shawyer
Your Scheme/Reference: 31188_004

 	LP Main		Valve Closed		Reducer
	LP Service		Valve Open		Ducting
	MP Main		CSEP		Gas Supply Point
	MP Service		Pressure Reduction Station		
	IP Main		End Closure		


IMPORTANT NOTICES

- This information is given as a guide only and its accuracy cannot be guaranteed
- The plan only shows pipes owned by SSE Utility Solutions Limited, Indigo Pipelines Limited
- Service pipes etc. may not be shown but their presence should be anticipated
- You must use safe digging practices in accordance with H5(G)47 to establish the actual position of mains, services and other apparatus before any mechanical excavation is used
- It is your responsibility to ensure this information is provided to all persons working near our plant
- If in doubt call the SSE Enterprise Dial Before You Dig team on 0345 070 7386.

Please note: If you have overlaps or misalignments between base maps that make it difficult to understand please contact DBYDEnterpriseEnquiries@sse.com or call 0345 070 7386



Indigo Pipelines Ltd.
Registered Office:
Loddon Reach,
Reading Road,
Arborfield,
Reading,
Berkshire, RG2 9HU

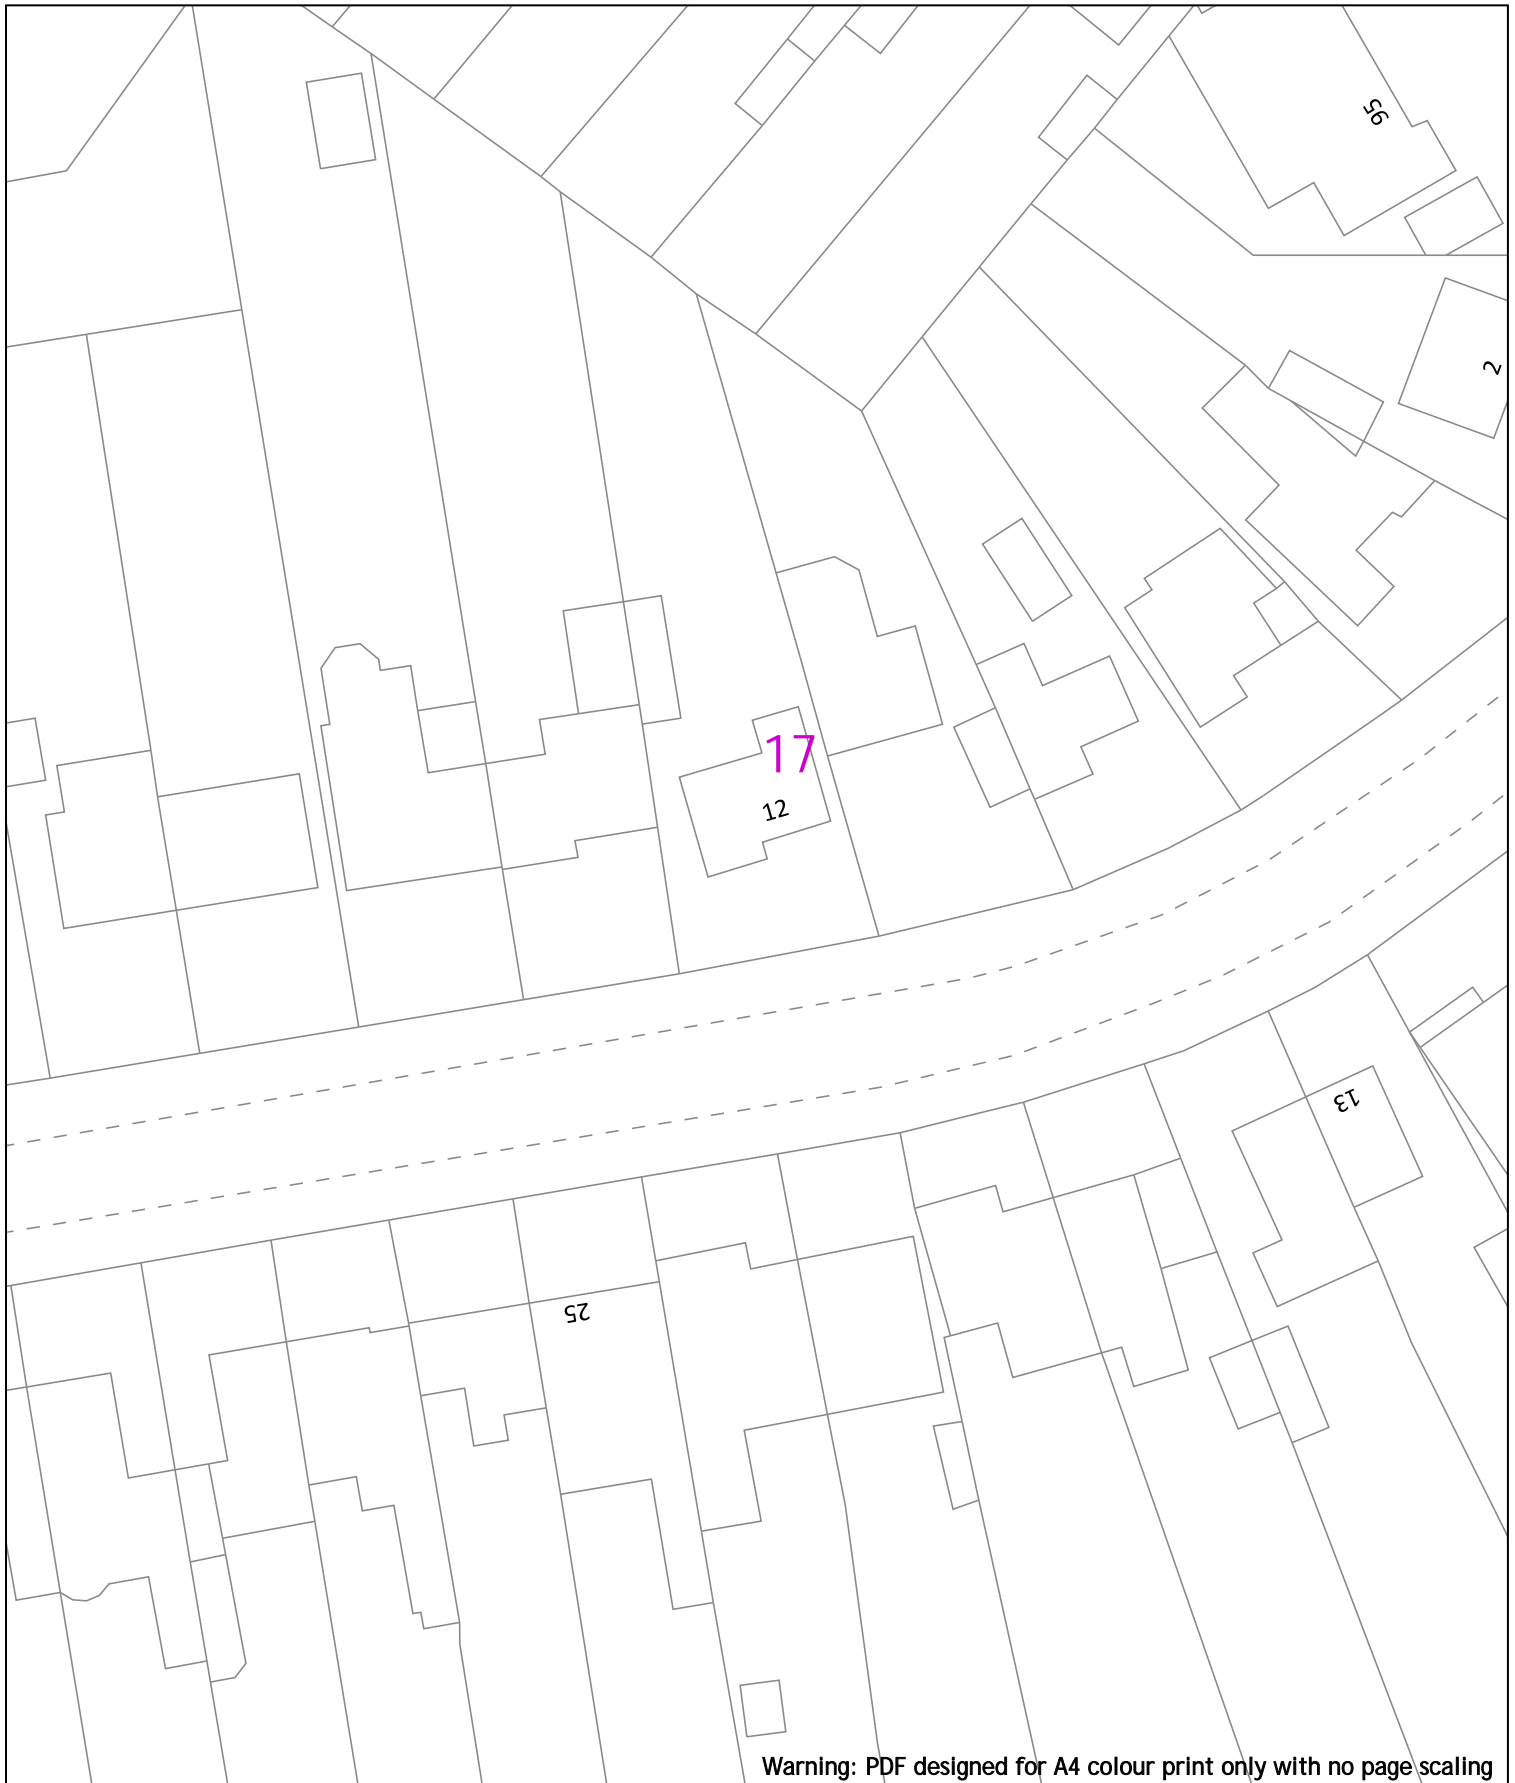

Warning: PDF designed for A4 colour print only with no page scaling

0 20m Dig Sites Area: Line:

Date Requested: 24/06/2022
 Job Reference: 25881050
 Site Location: 448447 212278
 Requested by: Mr Joe Shawyer
 Your Scheme/Reference: 31188_004

	LP Main		Valve Closed		Reducer
	LP Service		Valve Open		Ducting
	MP Main		CSEP		Gas Supply Point
	MP Service		Pressure Reduction Station		
	IP Main		End Closure		




Indigo Pipelines Ltd.
 Registered Office:
 Loddon Reach,
 Reading Road,
 Arborfield,
 Reading,
 Berkshire, RG2 9HU

IMPORTANT NOTICES

- This information is given as a guide only and its accuracy cannot be guaranteed
- The plan only shows pipes owned by SSE Utility Solutions Limited, Indigo Pipelines Limited
- Service pipes etc. may not be shown but their presence should be anticipated
- You must use safe digging practices in accordance with H5(G)47 to establish the actual position of mains, services and other apparatus before any mechanical excavation is used
- It is your responsibility to ensure this information is provided to all persons working near our plant
- If in doubt call the SSE Enterprise Dial Before You Dig team on 0345 070 7386

Please note: If you have overlaps or misalignments between base maps that make it difficult to understand please contact DBVEnterpriseEnquiries@sse.com or call 0345 070 7386

Scale: 1:500 (When plotted at A4)

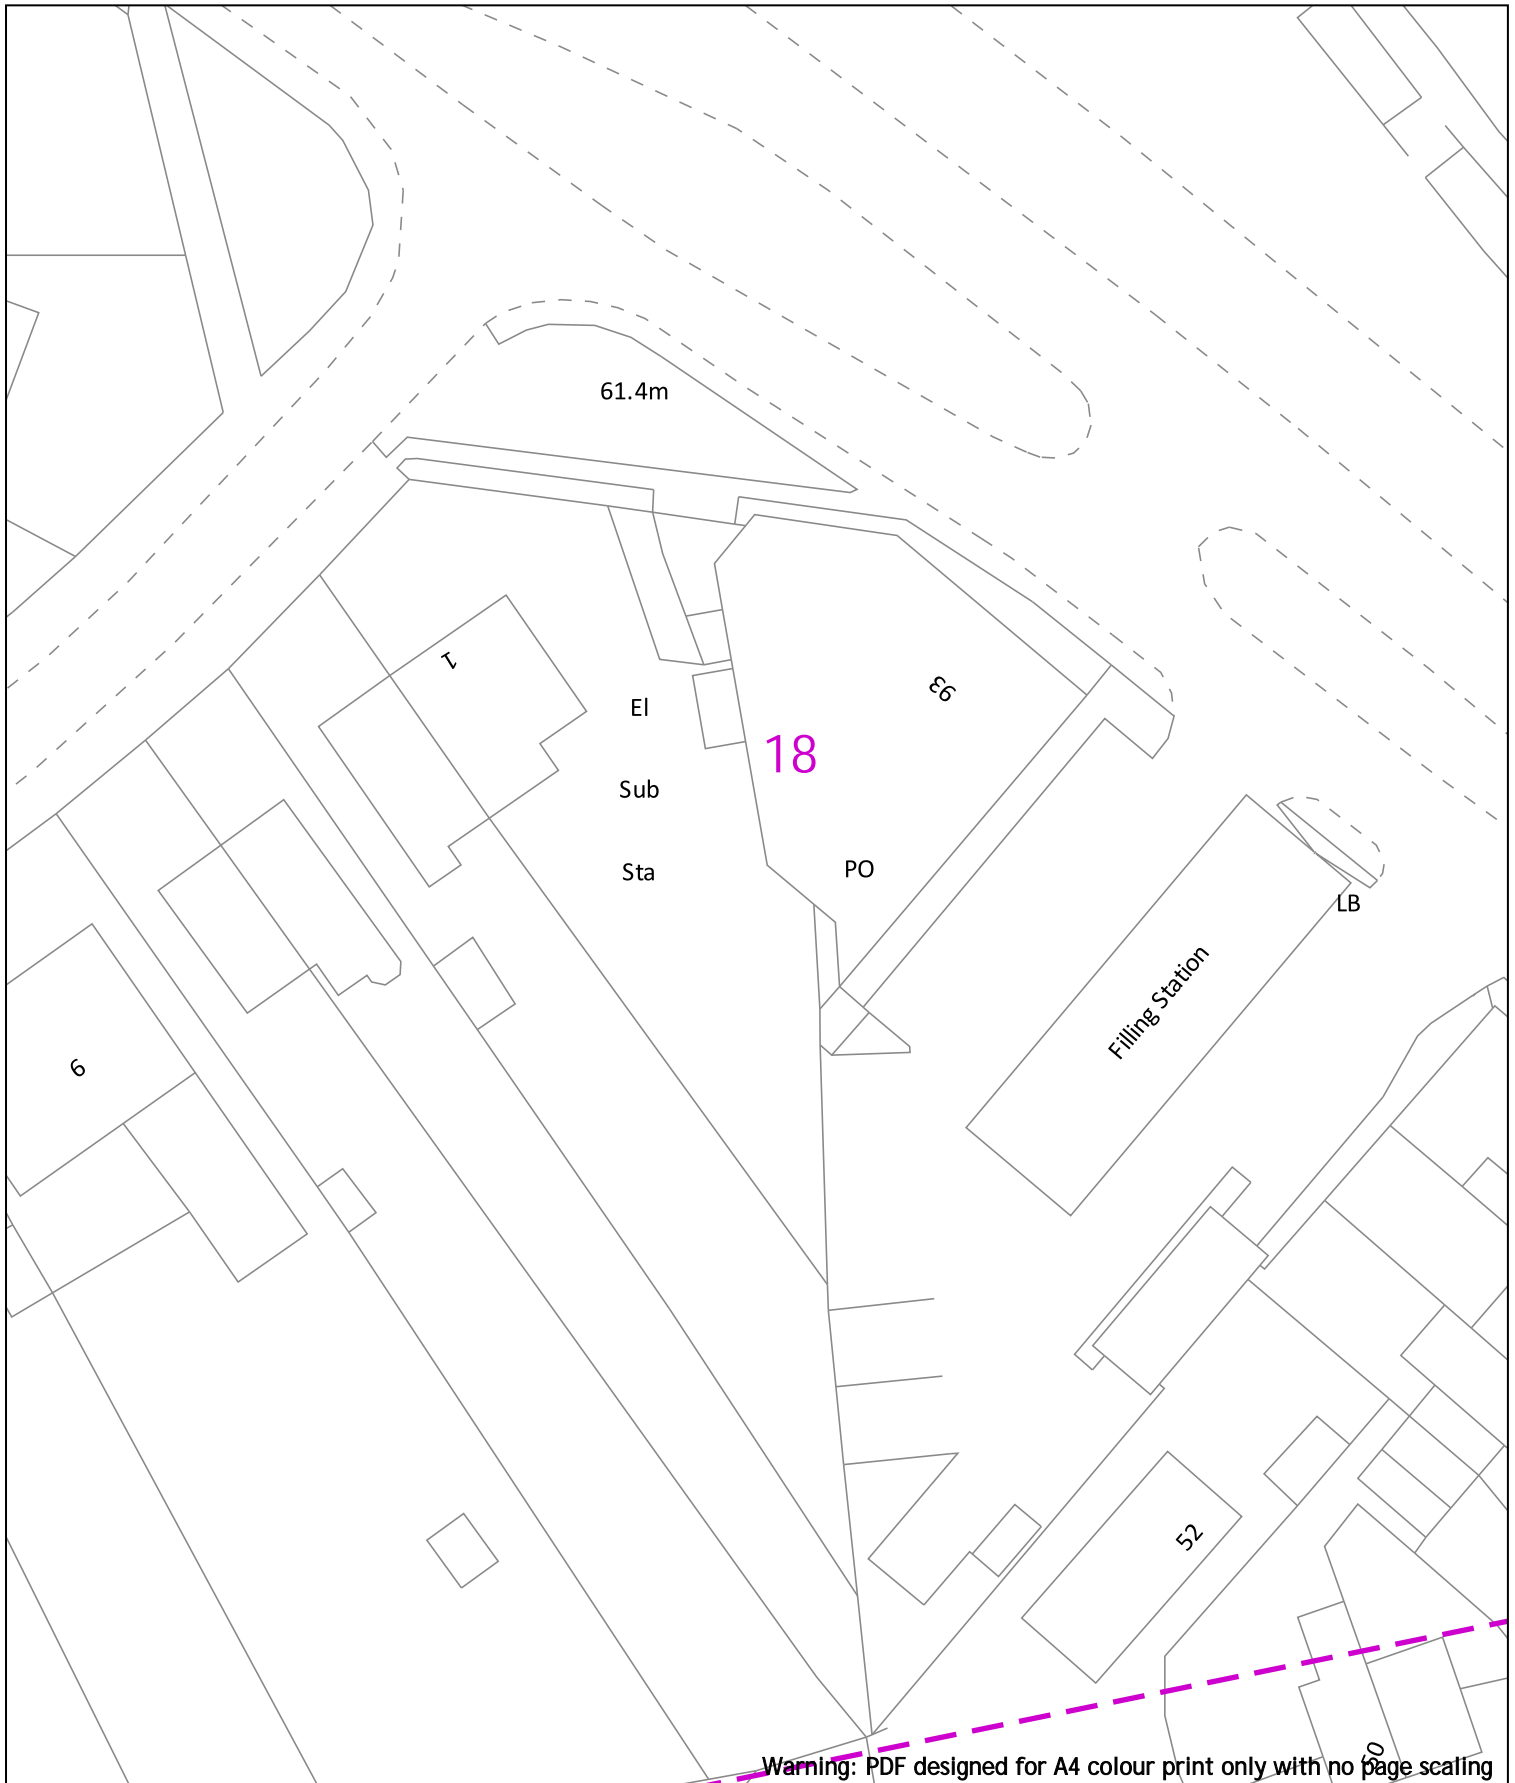

0 20m Dig Sites Area: Line:

LP Main	Valve Closed	Reducer
LP Service	Valve Open	Ducting
MP Main	CSEP	Gas Supply Point
MP Service	Pressure Reduction Station	
IP Main	End Closure	


IMPORTANT NOTICES

- This information is given as a guide only and its accuracy cannot be guaranteed
- The plan only shows pipes owned by SSE Utility Solutions Limited, Indigo Pipelines Limited
- Service pipes etc. may not be shown but their presence should be anticipated
- You must use safe digging practices in accordance with H5(G)47 to establish the actual position of mains, services and other apparatus before any mechanical excavation is used
- It is your responsibility to ensure this information is provided to all persons working near our plant
- If in doubt call the SSE Enterprise Dial Before You Dig team on 0345 070 7386.

Please note: If you have overlaps or misalignments between base maps that make it difficult to understand please contact DBYDEnterpriseEnquiries@sse.com or call 0345 070 7386

Scale: 1:500 (When plotted at A4)

Indigo Pipelines Ltd.
Registered Office:
Loddon Reach,
Reading Road,
Arborfield,
Reading,
Berkshire, RG2 9HU

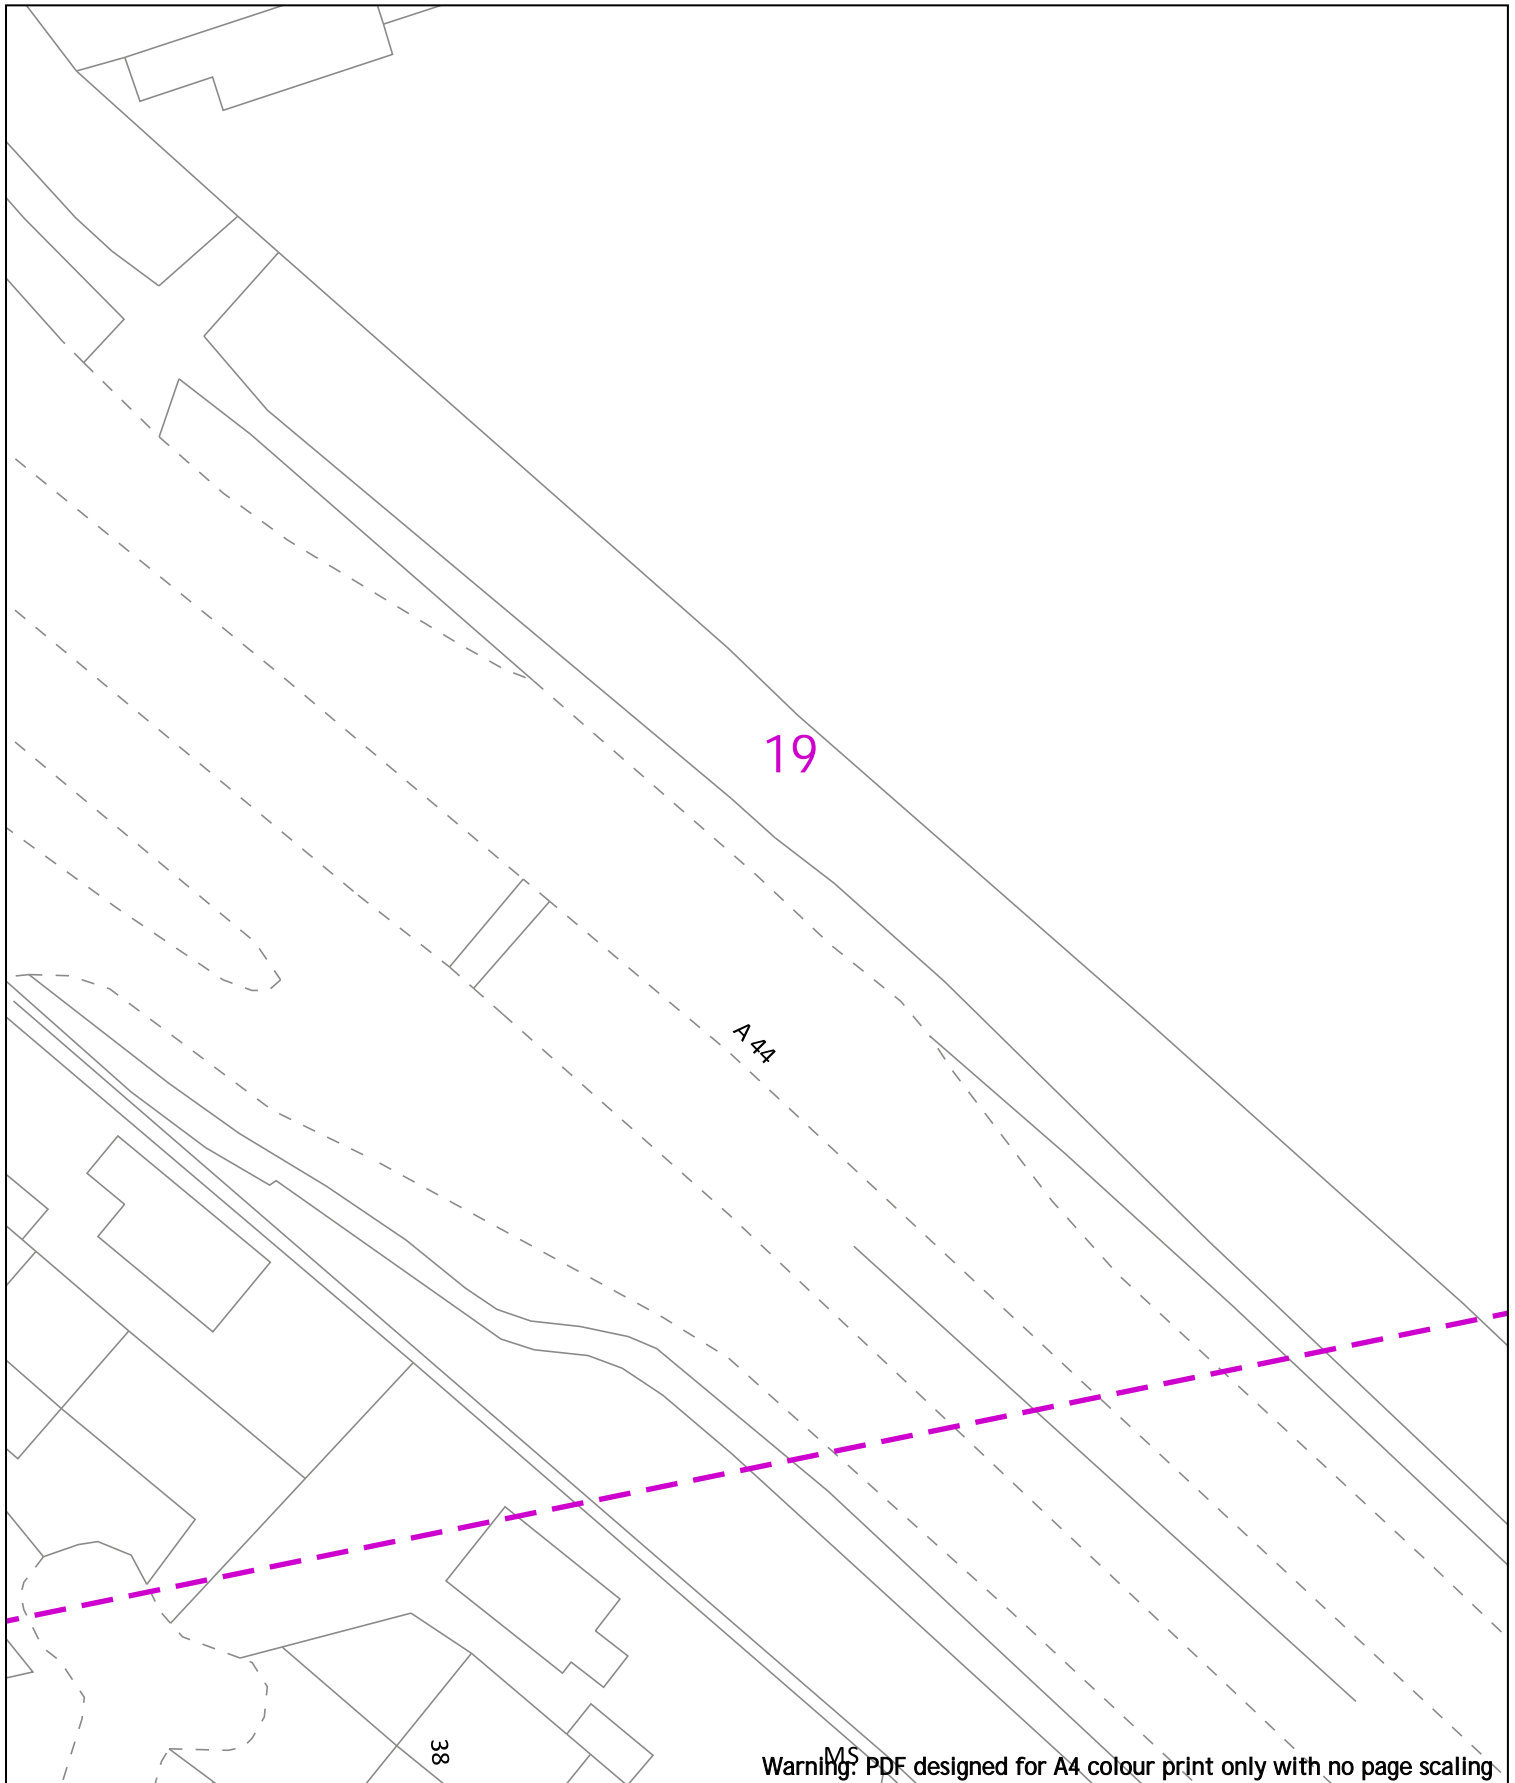

Warning: PDF designed for A4 colour print only with no page scaling

0 20m Dig Sites Area: Line:

LP Main	Valve Closed	Reducer
LP Service	Valve Open	Ducting
MP Main	CSEP	Gas Supply Point
MP Service	Pressure Reduction Station	
IP Main	End Closure	

IMPORTANT NOTICES

- This information is given as a guide only and its accuracy cannot be guaranteed
- The plan only shows pipes owned by SSE Utility Solutions Limited, Indigo Pipelines Limited
- Service pipes etc. may not be shown but their presence should be anticipated
- You must use safe digging practices in accordance with H5(G)47 to establish the actual position of mains, services and other apparatus before any mechanical excavation is used
- It is your responsibility to ensure this information is provided to all persons working near our plant
- If in doubt call the SSE Enterprise Dial Before You Dig team on 0345 070 7386.

Please note: If you have overlaps or misalignments between base maps that make it difficult to understand please contact DBYDEnterpriseEnquiries@sse.com or call 0345 070 7386

Scale: 1:500 (When plotted at A4)

Indigo Pipelines Ltd.
Registered Office:
Loddon Reach,
Reading Road,
Arborfield,
Reading,
Berkshire, RG2 9HU














20

61.0m

Warning: PDF designed for A4 colour print only with no page scaling

0  20m Dig Sites Area:  Line: 

Date Requested: 24/06/2022
Job Reference: 25881050
Site Location: 448447 212278
Requested by: Mr Joe Shawyer
Your Scheme/Reference: 31188_004

	LP Main		Valve Closed		Reducer
	LP Service		Valve Open		Ducting
	MP Main		CSEP		Gas Supply Point
	MP Service		Pressure Reduction Station		
	IP Main		End Closure		

IMPORTANT NOTICES


- This information is given as a guide only and its accuracy cannot be guaranteed
- The plan only shows pipes owned by SSE Utility Solutions Limited, Indigo Pipelines Limited
- Service pipes etc. may not be shown but their presence should be anticipated
- You must use safe digging practices in accordance with H5(G)47 to establish the actual position of mains, services and other apparatus before any mechanical excavation is used
- It is your responsibility to ensure this information is provided to all persons working near our plant
- If in doubt call the SSE Enterprise Dial Before You Dig team on 0345 070 7386.

Please note: If you have overlaps or misalignments between base maps that make it difficult to understand please contact DBYDEnterpriseEnquiries@sse.com or call 0345 070 7386



Indigo Pipelines Ltd.
Registered Office:
Loddon Reach,
Reading Road,
Arborfield,
Reading,
Berkshire, RG2 9HU

Scale: 1:500 (When plotted at A4)

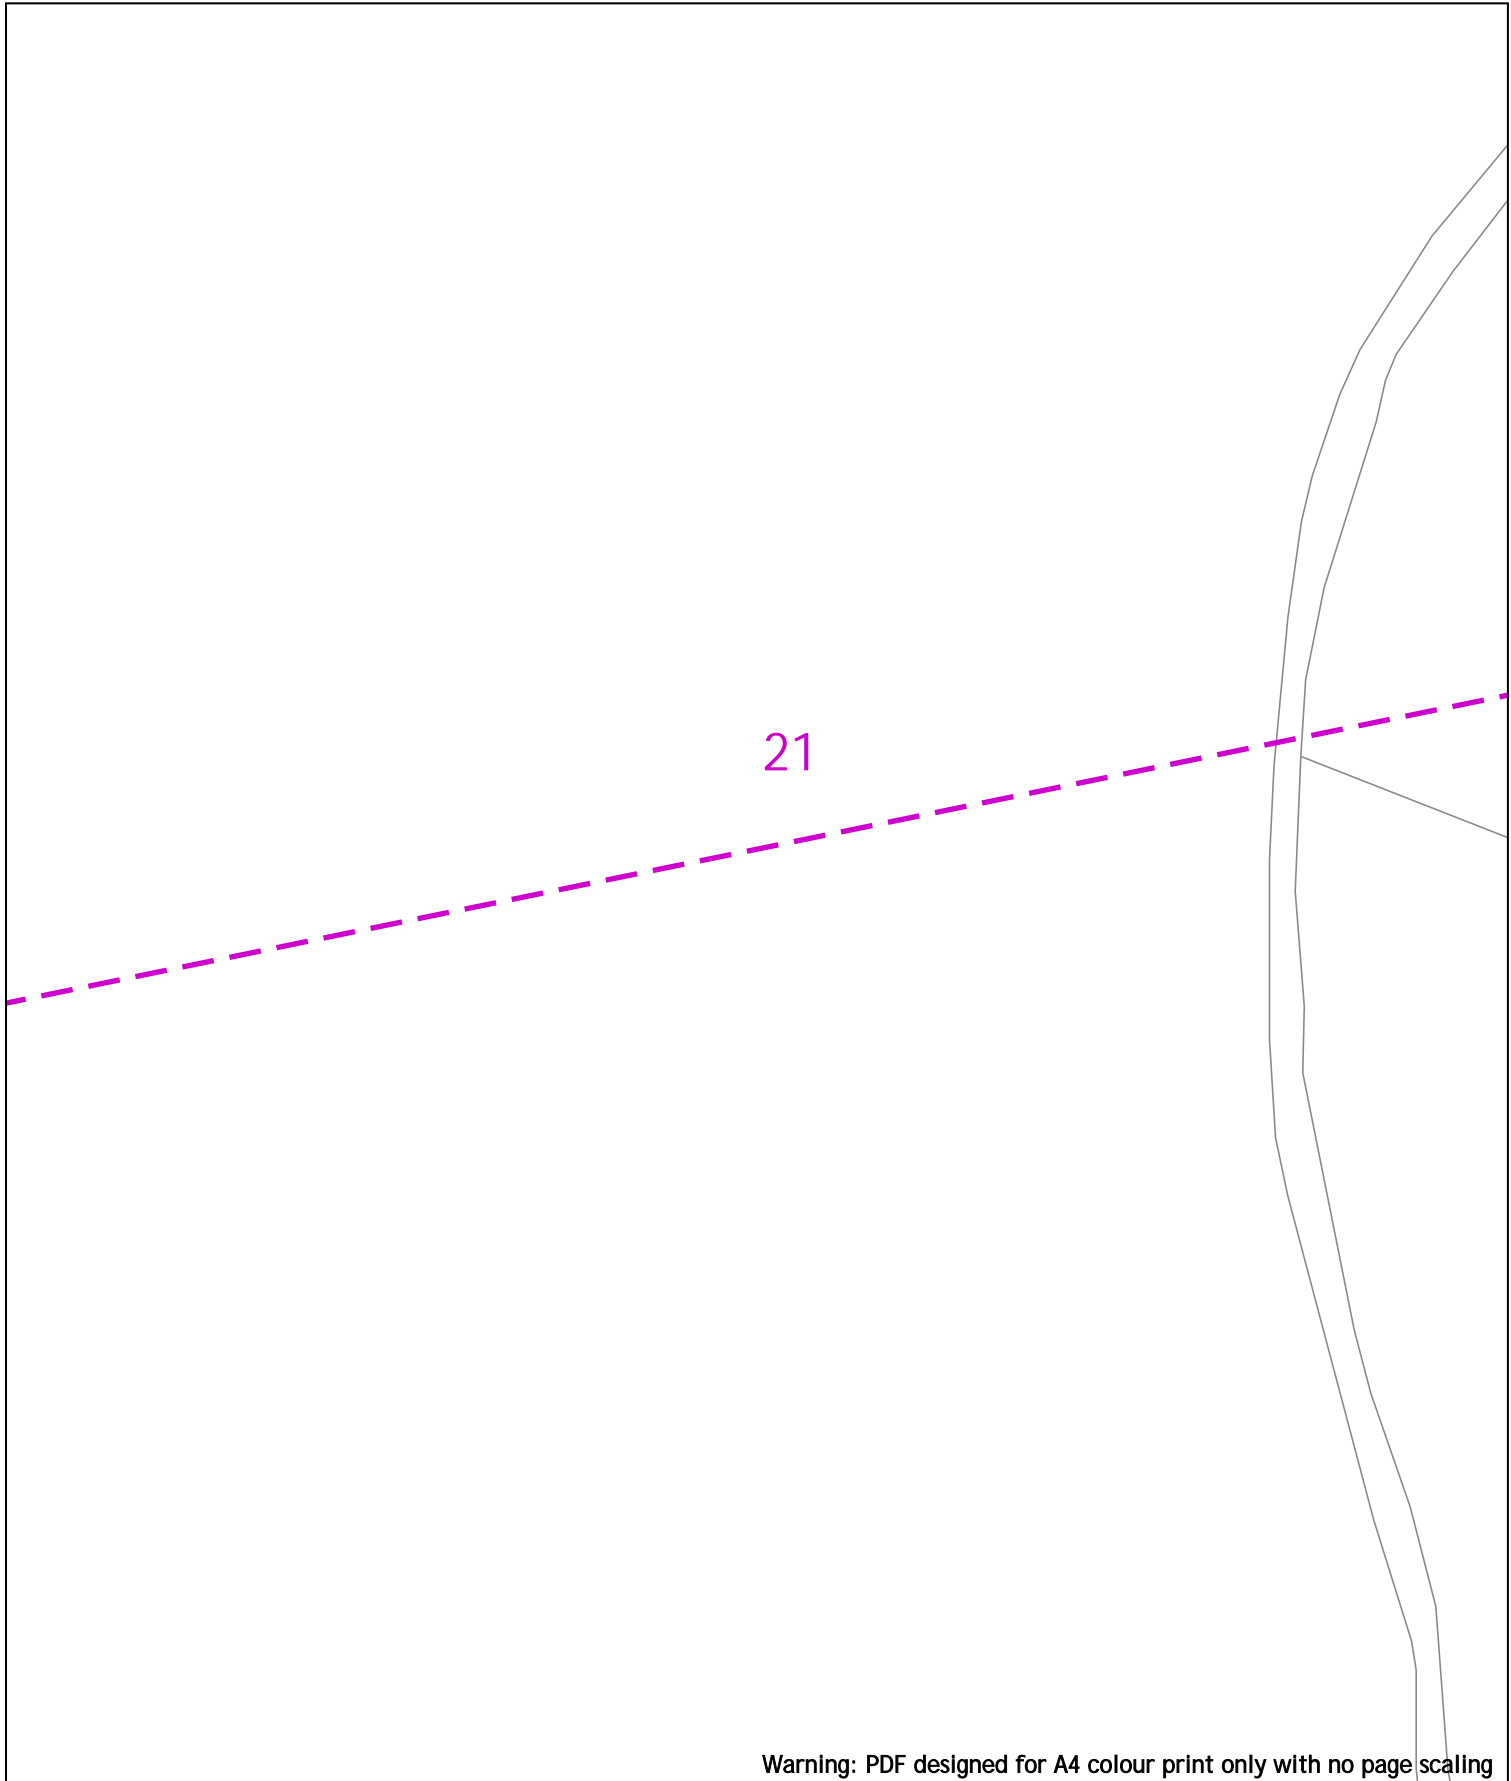

Warning: PDF designed for A4 colour print only with no page scaling

0 20m Dig Sites Area: Line:

LP Main	Valve Closed	Reducer
LP Service	Valve Open	Ducting
MP Main	CSEP	Gas Supply Point
MP Service	Pressure Reduction Station	
IP Main	End Closure	

IMPORTANT NOTICES


- This information is given as a guide only and its accuracy cannot be guaranteed
- The plan only shows pipes owned by SSE Utility Solutions Limited, Indigo Pipelines Limited
- Service pipes etc. may not be shown but their presence should be anticipated
- You must use safe digging practices in accordance with H5(G)47 to establish the actual position of mains, services and other apparatus before any mechanical excavation is used
- It is your responsibility to ensure this information is provided to all persons working near our plant
- If in doubt call the SSE Enterprise Dial Before You Dig team on 0345 070 7386.

Please note: If you have overlaps or misalignments between base maps that make it difficult to understand please contact DBYDEnterpriseEnquiries@sse.com or call 0345 070 7386

Date Requested: 24/06/2022
 Job Reference: 25881050
 Site Location: 448447 212278
 Requested by: Mr Joe Shawyer
 Your Scheme/Reference: 31188_004

Scale: 1:500 (When plotted at A4)

Indigo Pipelines Ltd.
 Registered Office:
 Loddon Reach,
 Reading Road,
 Arborfield,
 Reading,
 Berkshire, RG2 9HU

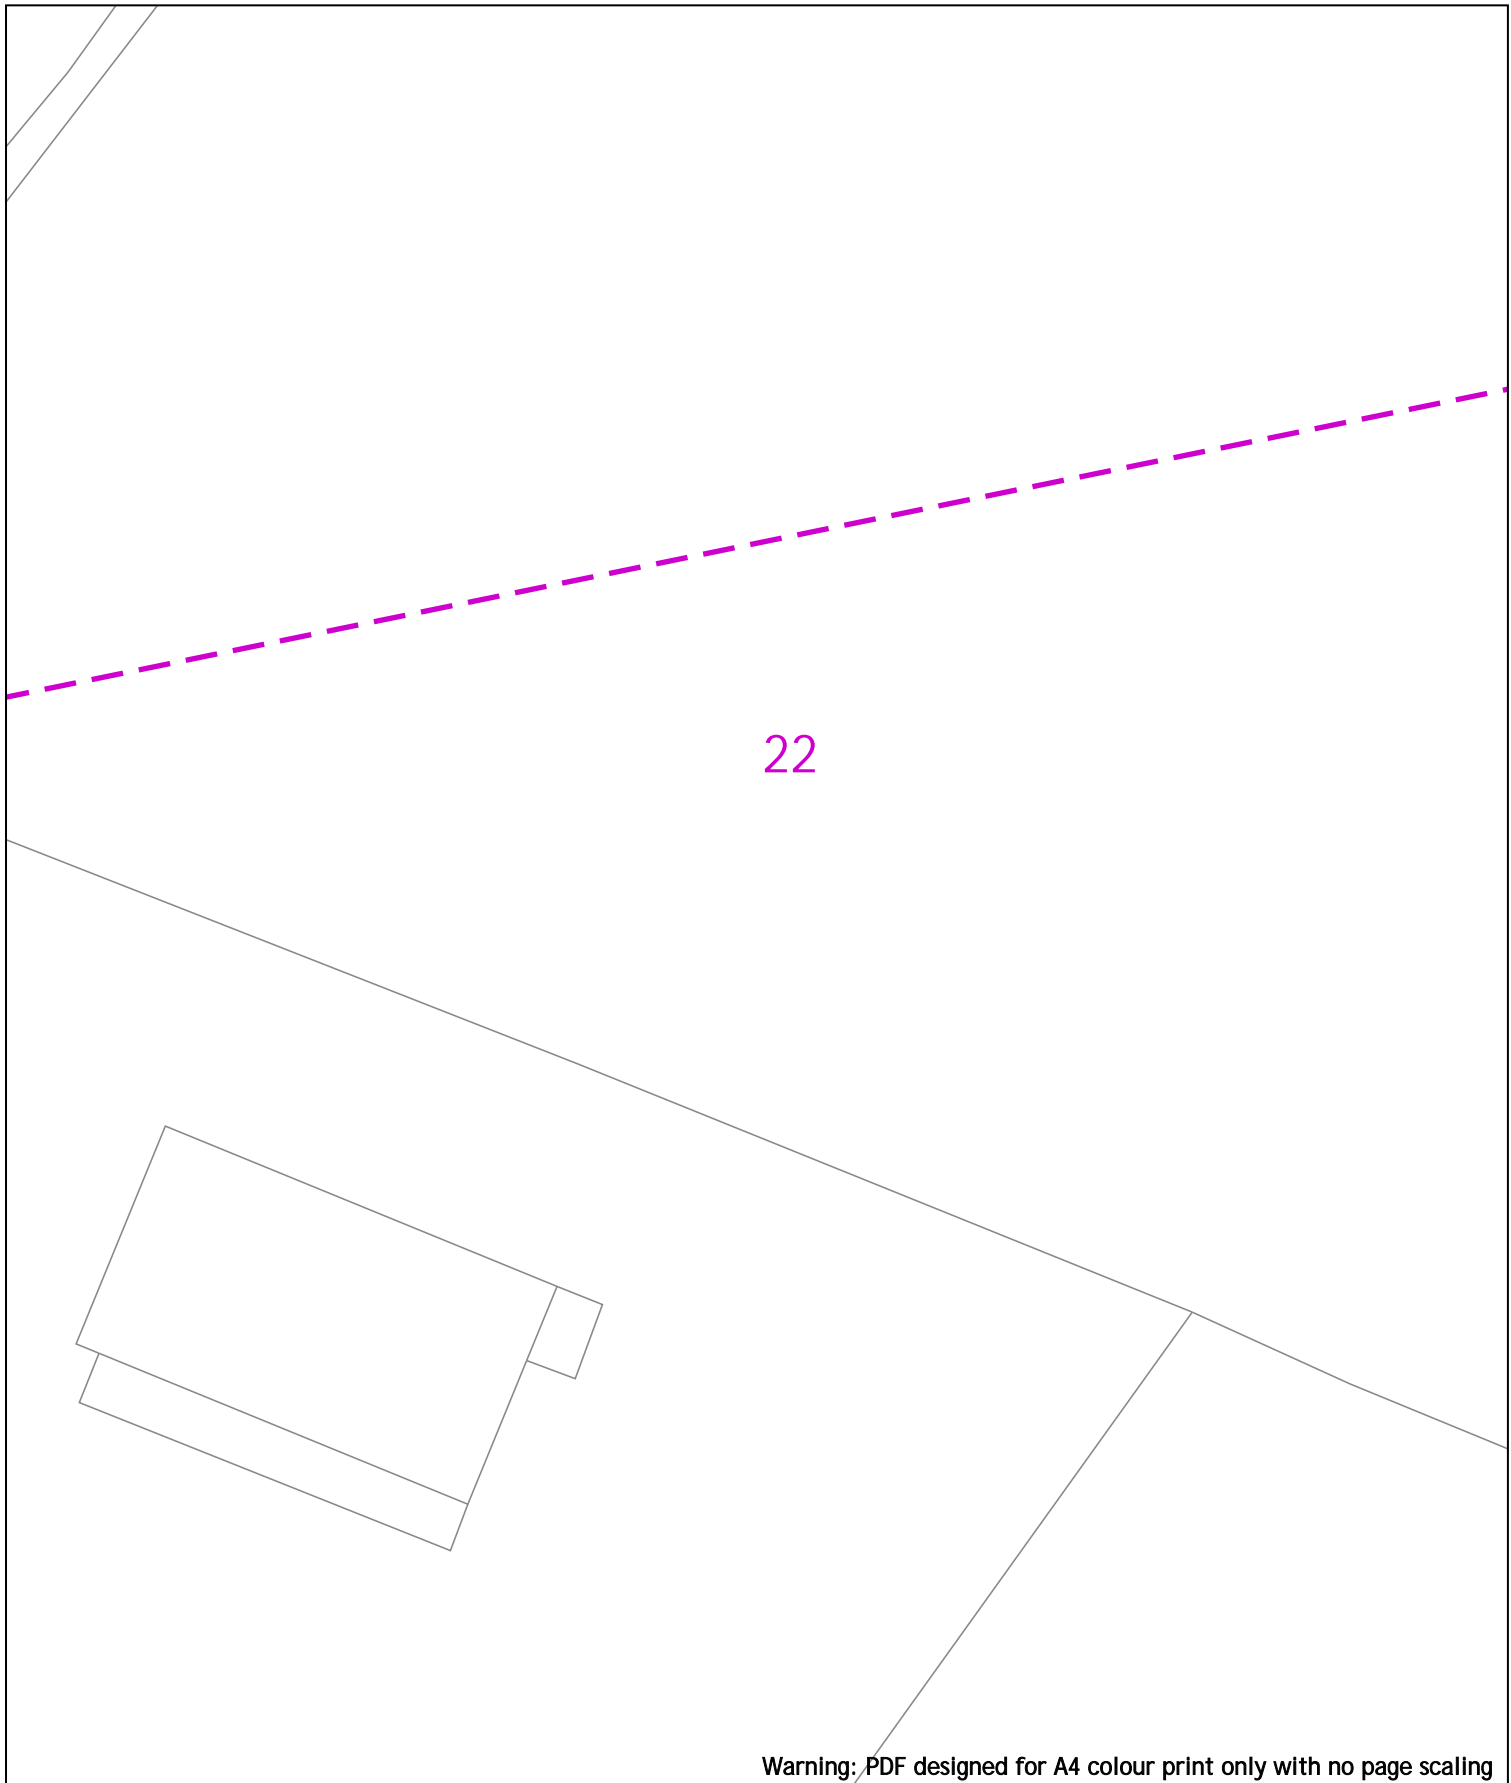


22














Warning: PDF designed for A4 colour print only with no page scaling

<p>0 20m Dig Sites Area: Line: </p>	<p>Date Requested: 24/06/2022 Job Reference: 25881050 Site Location: 448447 212278 Requested by: Mr Joe Shawyer Your Scheme/Reference: 31188_004</p>																
<p>Scale: 1:500 (When plotted at A4)</p>	<table border="0"> <tr> <td> LP Main</td> <td> Valve Closed</td> <td> Reducer</td> </tr> <tr> <td> LP Service</td> <td> Valve Open</td> <td> Ducting</td> </tr> <tr> <td> MP Main</td> <td> CSEP</td> <td> Gas Supply Point</td> </tr> <tr> <td> MP Service</td> <td> Pressure Reduction Station</td> <td></td> </tr> <tr> <td> IP Main</td> <td> End Closure</td> <td></td> </tr> </table>	LP Main	Valve Closed	Reducer	LP Service	Valve Open	Ducting	MP Main	CSEP	Gas Supply Point	MP Service	Pressure Reduction Station		IP Main	End Closure		<p>Indigo Pipelines Ltd. Registered Office: Loddon Reach, Reading Road, Arborfield, Reading, Berkshire, RG2 9HU</p>
LP Main	Valve Closed	Reducer															
LP Service	Valve Open	Ducting															
MP Main	CSEP	Gas Supply Point															
MP Service	Pressure Reduction Station																
IP Main	End Closure																
<p>IMPORTANT NOTICES</p> <ul style="list-style-type: none"> This information is given as a guide only and its accuracy cannot be guaranteed The plan only shows pipes owned by SSE Utility Solutions Limited, Indigo Pipelines Limited Service pipes etc. may not be shown but their presence should be anticipated You must use safe digging practices in accordance with H5(G)47 to establish the actual position of mains, services and other apparatus before any mechanical excavation is used It is your responsibility to ensure this information is provided to all persons working near our plant If in doubt call the SSE Enterprise Dial Before You Dig team on 0345 070 7386. <p>Please note: If you have overlaps or misalignments between base maps that make it difficult to understand please contact DBYDEnterpriseEnquiries@sse.com or call 0345 070 7386</p> <p><small>Crown Copyright. © - Reproduced by permission of Ordnance Survey on behalf of HMSO, and database right 2019. All rights reserved. Ordnance Survey Licence number 100030994 (ESRI) and 100048660 (direct). Plans generated by DigSAFE Pro™ software provided by LinesearchbeforeUdig.</small></p>																	

Warning: PDF designed for A4 colour print only with no page scaling

0  20m Dig Sites Area:  Line: 

Date Requested: 24/06/2022
 Job Reference: 25881050
 Site Location: 448447 212278
 Requested by: Mr Joe Shawyer
 Your Scheme/Reference: 31188_004

 	LP Main		Valve Closed		Reducer
	LP Service		Valve Open		Ducting
	MP Main		CSEP		Gas Supply Point
	MP Service		Pressure Reduction Station		
	IP Main		End Closure		

IMPORTANT NOTICES


- This information is given as a guide only and its accuracy cannot be guaranteed
- The plan only shows pipes owned by SSE Utility Solutions Limited, Indigo Pipelines Limited
- Service pipes etc. may not be shown but their presence should be anticipated
- You must use safe digging practices in accordance with H5(G)47 to establish the actual position of mains, services and other apparatus before any mechanical excavation is used
- It is your responsibility to ensure this information is provided to all persons working near our plant
- If in doubt call the SSE Enterprise Dial Before You Dig team on 0345 070 7386.

Please note: If you have overlaps or misalignments between base maps that make it difficult to understand please contact DBYDEnterpriseEnquiries@sse.com or call 0345 070 7386



Indigo Pipelines Ltd.
 Registered Office:
 Loddon Reach,
 Reading Road,
 Arborfield,
 Reading,
 Berkshire, RG2 9HU

Scale: 1:500 (When plotted at A4)

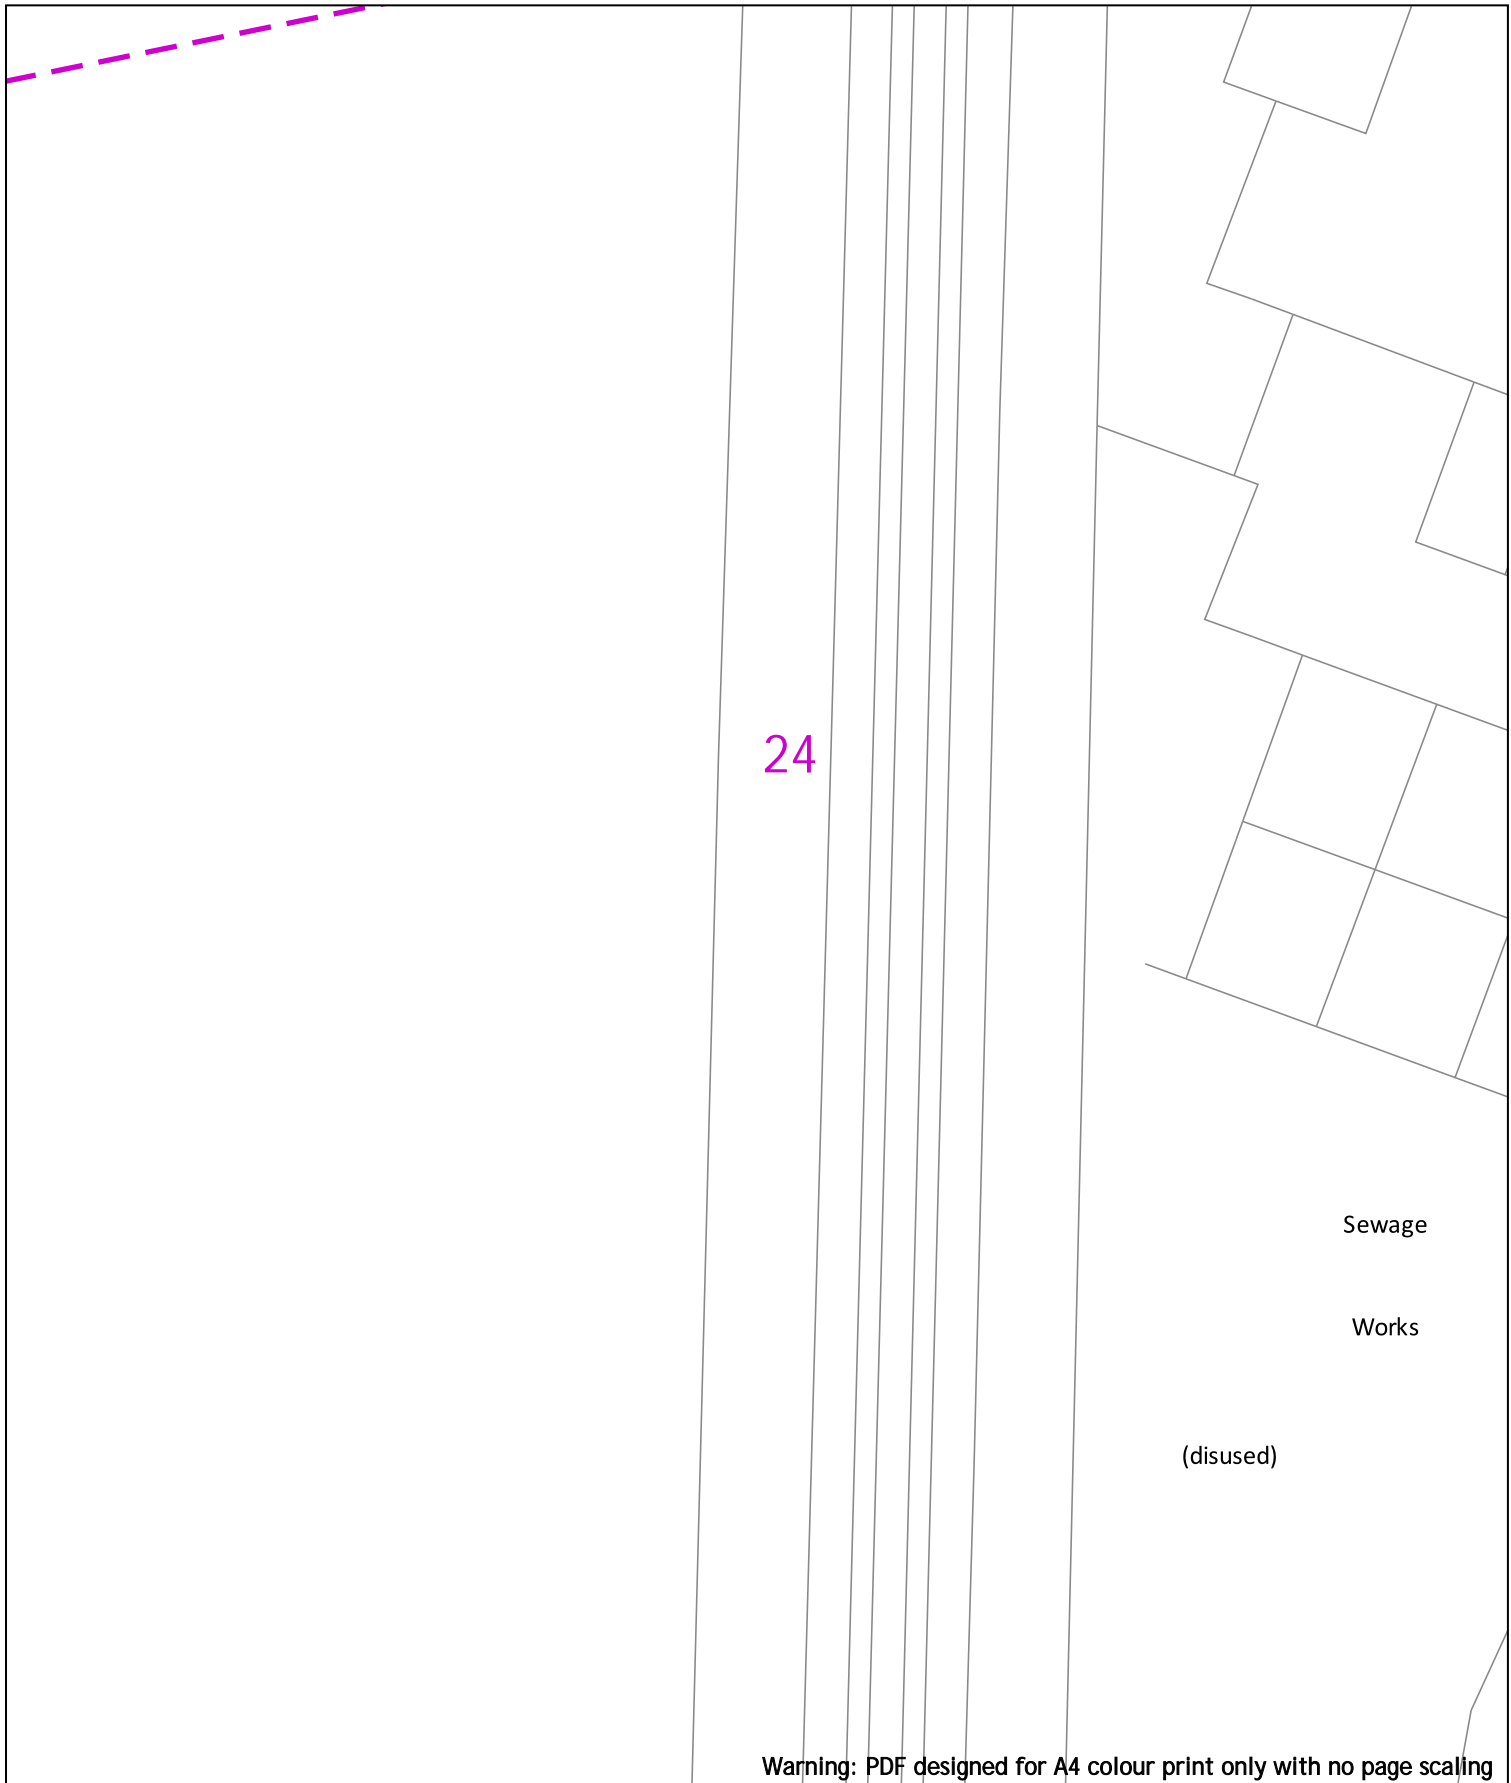

Warning: PDF designed for A4 colour print only with no page scaling

0 20m Dig Sites Area: Line:

LP Main	Valve Closed	Reducer
LP Service	Valve Open	Ducting
MP Main	CSEP	Gas Supply Point
MP Service	Pressure Reduction Station	
IP Main	End Closure	

IMPORTANT NOTICES

- This information is given as a guide only and its accuracy cannot be guaranteed
- The plan only shows pipes owned by SSE Utility Solutions Limited, Indigo Pipelines Limited
- Service pipes etc. may not be shown but their presence should be anticipated
- You must use safe digging practices in accordance with H5(G)47 to establish the actual position of mains, services and other apparatus before any mechanical excavation is used
- It is your responsibility to ensure this information is provided to all persons working near our plant
- If in doubt call the SSE Enterprise Dial Before You Dig team on 0345 070 7386.


Please note: If you have overlaps or misalignments between base maps that make it difficult to understand please contact DBYDEnterpriseEnquiries@sse.com or call 0345 070 7386

Date Requested: 24/06/2022
 Job Reference: 25881050
 Site Location: 448447 212278
 Requested by: Mr Joe Shawyer
 Your Scheme/Reference: 31188_004

Scale: 1:500 (When plotted at A4)




Indigo Pipelines Ltd.
 Registered Office:
 Loddon Reach,
 Reading Road,
 Arborfield,
 Reading,
 Berkshire, RG2 9HU

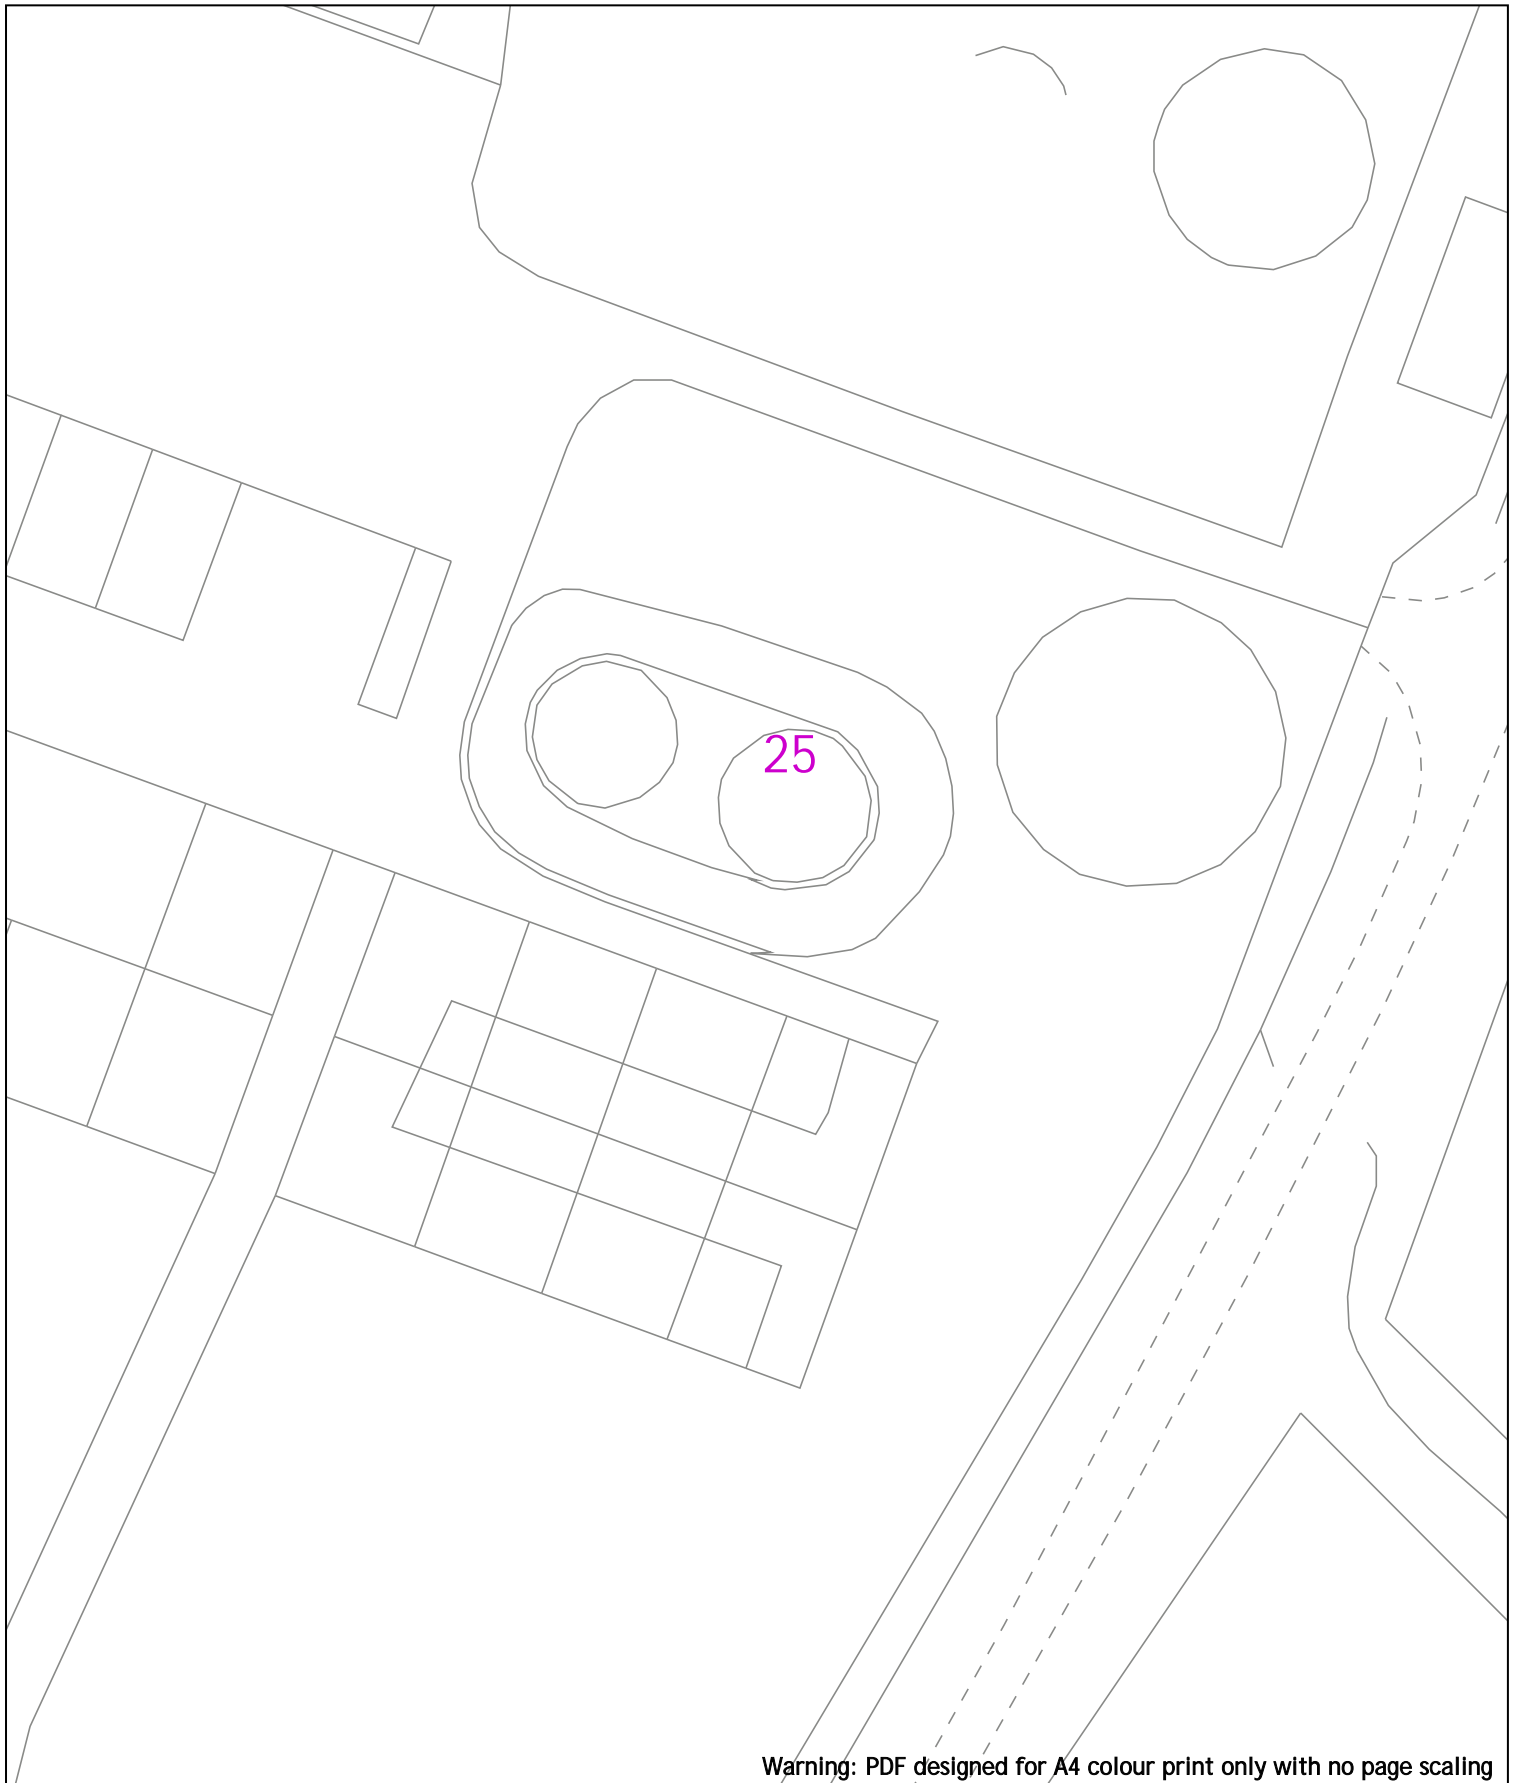

Warning: PDF designed for A4 colour print only with no page scaling

0 20m

Dig Sites Area: Line:

Date Requested: 24/06/2022
 Job Reference: 25881050
 Site Location: 448447 212278
 Requested by: Mr Joe Shawyer
 Your Scheme/Reference: 31188_004

	LP Main		Valve Closed		Reducer
	LP Service		Valve Open		Ducting
	MP Main		CSEP		Gas Supply Point
	MP Service		Pressure Reduction Station		
	IP Main		End Closure		

IMPORTANT NOTICES

- This information is given as a guide only and its accuracy cannot be guaranteed
- The plan only shows pipes owned by SSE Utility Solutions Limited, Indigo Pipelines Limited
- Service pipes etc. may not be shown but their presence should be anticipated
- You must use safe digging practices in accordance with H5(G)47 to establish the actual position of mains, services and other apparatus before any mechanical excavation is used
- It is your responsibility to ensure this information is provided to all persons working near our plant
- If in doubt call the SSE Enterprise Dial Before You Dig team on 0345 070 7386.

Please note: If you have overlaps or misalignments between base maps that make it difficult to understand please contact DBYDEnterpriseEnquiries@sse.com or call 0345 070 7386
















Indigo Pipelines Ltd.
 Registered Office:
 Loddon Reach,
 Reading Road,
 Arborfield,
 Reading,
 Berkshire, RG2 9HU

Scale: 1:500 (When plotted at A4)

Warning: PDF designed for A4 colour print only with no page scaling

0  20m Dig Sites Area:  Line: 

Date Requested: 24/06/2022
 Job Reference: 25881050
 Site Location: 448447 212278
 Requested by: Mr Joe Shawyer
 Your Scheme/Reference: 31188_004

 	LP Main		Valve Closed		Reducer
	LP Service		Valve Open		Ducting
	MP Main		CSEP		Gas Supply Point
	MP Service		Pressure Reduction Station		
	IP Main		End Closure		

IMPORTANT NOTICES

- This information is given as a guide only and its accuracy cannot be guaranteed
- The plan only shows pipes owned by SSE Utility Solutions Limited, Indigo Pipelines Limited
- Service pipes etc. may not be shown but their presence should be anticipated
- You must use safe digging practices in accordance with H5(G)47 to establish the actual position of mains, services and other apparatus before any mechanical excavation is used
- It is your responsibility to ensure this information is provided to all persons working near our plant
- If in doubt call the SSE Enterprise Dial Before You Dig team on 0345 070 7386.




Please note: If you have overlaps or misalignments between base maps that make it difficult to understand please contact DBYDEnterpriseEnquiries@sse.com or call 0345 070 7386










 





Indigo Pipelines Ltd.
 Registered Office:
 Loddon Reach,
 Reading Road,
 Arborfield,
 Reading,
 Berkshire, RG2 9HU

Scale: 1:500 (When plotted at A4)

Warning: PDF designed for A4 colour print only with no page scaling

0  20m Dig Sites Area:  Line: 


<p>Date Requested: 24/06/2022 Job Reference: 25881050 Site Location: 448447 212278 Requested by: Mr Joe Shawyer Your Scheme/Reference: 31188_004</p>	<p>  LP Main  LP Service  MP Main  MP Service  IP Main </p>	<p>  Valve Closed  Valve Open  CSEP  Pressure Reduction Station  End Closure </p>	<p>  Reducer  Ducting  Gas Supply Point </p>
<p>IMPORTANT NOTICES</p> <ul style="list-style-type: none"> This information is given as a guide only and its accuracy cannot be guaranteed The plan only shows pipes owned by SSE Utility Solutions Limited, Indigo Pipelines Limited Service pipes etc. may not be shown but their presence should be anticipated You must use safe digging practices in accordance with H5(G)47 to establish the actual position of mains, services and other apparatus before any mechanical excavation is used It is your responsibility to ensure this information is provided to all persons working near our plant If in doubt call the SSE Enterprise Dial Before You Dig team on 0345 070 7386. <p>Please note: If you have overlaps or misalignments between base maps that make it difficult to understand please contact DBYDEnterpriseEnquiries@sse.com or call 0345 070 7386</p>			

Scale: 1:500 (When plotted at A4)
















Indigo Pipelines Ltd.
 Registered Office:
 Loddon Reach,
 Reading Road,
 Arborfield,
 Reading,
 Berkshire, RG2 9HU

Warning: PDF designed for A4 colour print only with no page scaling

0  20m Dig Sites Area:  Line: 

Date Requested: 24/06/2022
 Job Reference: 25881050
 Site Location: 448447 212278
 Requested by: Mr Joe Shawyer
 Your Scheme/Reference: 31188_004

 	LP Main		Valve Closed		Reducer
	LP Service		Valve Open		Ducting
	MP Main		CSEP		Gas Supply Point
	MP Service		Pressure Reduction Station		
	IP Main		End Closure		

IMPORTANT NOTICES

- This information is given as a guide only and its accuracy cannot be guaranteed
- The plan only shows pipes owned by SSE Utility Solutions Limited, Indigo Pipelines Limited
- Service pipes etc. may not be shown but their presence should be anticipated
- You must use safe digging practices in accordance with H5(G)47 to establish the actual position of mains, services and other apparatus before any mechanical excavation is used
- It is your responsibility to ensure this information is provided to all persons working near our plant
- If in doubt call the SSE Enterprise Dial Before You Dig team on 0345 070 7386.


Please note: If you have overlaps or misalignments between base maps that make it difficult to understand please contact DBYDEnterpriseEnquiries@sse.com or call 0345 070 7386










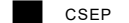





Indigo Pipelines Ltd.
 Registered Office:
 Loddon Reach,
 Reading Road,
 Arborfield,
 Reading,
 Berkshire, RG2 9HU

Scale: 1:500 (When plotted at A4)

Warning: PDF designed for A4 colour print only with no page scaling

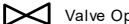 0  20m Dig Sites Area:  Line: 

Date Requested: 24/06/2022
 Job Reference: 25881050
 Site Location: 448447 212278
 Requested by: Mr Joe Shawyer
 Your Scheme/Reference: 31188_004

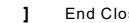	LP Main		Valve Closed		Reducer
	LP Service		Valve Open		Ducting
	MP Main		CSEP		Gas Supply Point
	MP Service		Pressure Reduction Station		
	IP Main		End Closure		

IMPORTANT NOTICES

- This information is given as a guide only and its accuracy cannot be guaranteed
- The plan only shows pipes owned by SSE Utility Solutions Limited, Indigo Pipelines Limited
- Service pipes etc. may not be shown but their presence should be anticipated
- You must use safe digging practices in accordance with H5(G)47 to establish the actual position of mains, services and other apparatus before any mechanical excavation is used
- It is your responsibility to ensure this information is provided to all persons working near our plant
- If in doubt call the SSE Enterprise Dial Before You Dig team on 0345 070 7386.

Please note: If you have overlaps or misalignments between base maps that make it difficult to understand please contact DBYDEnterpriseEnquiries@sse.com or call 0345 070 7386
















Indigo Pipelines Ltd.
 Registered Office:
 Loddon Reach,
 Reading Road,
 Arborfield,
 Reading,
 Berkshire, RG2 9HU

Scale: 1:500 (When plotted at A4)

Warning: PDF designed for A4 colour print only with no page scaling

0  20m Dig Sites Area:  Line: 

Date Requested: 24/06/2022
 Job Reference: 25881050
 Site Location: 448447 212278
 Requested by: Mr Joe Shawyer
 Your Scheme/Reference: 31188_004

 	LP Main		Valve Closed		Reducer
	LP Service		Valve Open		Ducting
	MP Main		CSEP		Gas Supply Point
	MP Service		Pressure Reduction Station		
	IP Main		End Closure		

IMPORTANT NOTICES

- This information is given as a guide only and its accuracy cannot be guaranteed
- The plan only shows pipes owned by SSE Utility Solutions Limited, Indigo Pipelines Limited
- Service pipes etc. may not be shown but their presence should be anticipated
- You must use safe digging practices in accordance with H5(G)47 to establish the actual position of mains, services and other apparatus before any mechanical excavation is used
- It is your responsibility to ensure this information is provided to all persons working near our plant
- If in doubt call the SSE Enterprise Dial Before You Dig team on 0345 070 7386.



Please note: If you have overlaps or misalignments between base maps that make it difficult to understand please contact DBYDEnterpriseEnquiries@sse.com or call 0345 070 7386
















Indigo Pipelines Ltd.
 Registered Office:
 Loddon Reach,
 Reading Road,
 Arborfield,
 Reading,
 Berkshire, RG2 9HU

Scale: 1:500 (When plotted at A4)

Warning: PDF designed for A4 colour print only with no page scaling

0  20m Dig Sites Area:  Line: 

Date Requested: 24/06/2022
 Job Reference: 25881050
 Site Location: 448447 212278
 Requested by: Mr Joe Shawyer
 Your Scheme/Reference: 31188_004

 	LP Main		Valve Closed		Reducer
	LP Service		Valve Open		Ducting
	MP Main		CSEP		Gas Supply Point
	MP Service		Pressure Reduction Station		
	IP Main		End Closure		

IMPORTANT NOTICES

- This information is given as a guide only and its accuracy cannot be guaranteed
- The plan only shows pipes owned by SSE Utility Solutions Limited, Indigo Pipelines Limited
- Service pipes etc. may not be shown but their presence should be anticipated
- You must use safe digging practices in accordance with H5(G)47 to establish the actual position of mains, services and other apparatus before any mechanical excavation is used
- It is your responsibility to ensure this information is provided to all persons working near our plant
- If in doubt call the SSE Enterprise Dial Before You Dig team on 0345 070 7386.

Please note: If you have overlaps or misalignments between base maps that make it difficult to understand please contact DBYDEnterpriseEnquiries@sse.com or call 0345 070 7386
















Indigo Pipelines Ltd.
 Registered Office:
 Loddon Reach,
 Reading Road,
 Arborfield,
 Reading,
 Berkshire, RG2 9HU

Scale: 1:500 (When plotted at A4)

Warning: PDF designed for A4 colour print only with no page scaling

0  20m Dig Sites Area:  Line: 

Date Requested: 24/06/2022
 Job Reference: 25881050
 Site Location: 448447 212278
 Requested by: Mr Joe Shawyer
 Your Scheme/Reference: 31188_004

	LP Main		Valve Closed		Reducer
	LP Service		Valve Open		Ducting
	MP Main		CSEP		Gas Supply Point
	MP Service		Pressure Reduction Station		
	IP Main		End Closure		

IMPORTANT NOTICES

- This information is given as a guide only and its accuracy cannot be guaranteed
- The plan only shows pipes owned by SSE Utility Solutions Limited, Indigo Pipelines Limited
- Service pipes etc. may not be shown but their presence should be anticipated
- You must use safe digging practices in accordance with H5(G)47 to establish the actual position of mains, services and other apparatus before any mechanical excavation is used
- It is your responsibility to ensure this information is provided to all persons working near our plant
- If in doubt call the SSE Enterprise Dial Before You Dig team on 0345 070 7386.


Please note: If you have overlaps or misalignments between base maps that make it difficult to understand please contact DBYDEnterpriseEnquiries@sse.com or call 0345 070 7386
















Indigo Pipelines Ltd.
 Registered Office:
 Loddon Reach,
 Reading Road,
 Arborfield,
 Reading,
 Berkshire, RG2 9HU

Scale: 1:500 (When plotted at A4)

Warning: PDF designed for A4 colour print only with no page scaling

0  20m Dig Sites Area:  Line: 

Date Requested: 24/06/2022
 Job Reference: 25881050
 Site Location: 448447 212278
 Requested by: Mr Joe Shawyer
 Your Scheme/Reference: 31188_004

  LP Main	 Valve Closed	 Reducer
 LP Service	 Valve Open	 Ducting
 MP Main	 CSEP	 Gas Supply Point
 MP Service	 Pressure Reduction Station	
 IP Main	 End Closure	




Indigo Pipelines Ltd.
 Registered Office:
 Loddon Reach,
 Reading Road,
 Arborfield,
 Reading,
 Berkshire, RG2 9HU

IMPORTANT NOTICES

- This information is given as a guide only and its accuracy cannot be guaranteed
- The plan only shows pipes owned by SSE Utility Solutions Limited, Indigo Pipelines Limited
- Service pipes etc. may not be shown but their presence should be anticipated
- You must use safe digging practices in accordance with H5(G)47 to establish the actual position of mains, services and other apparatus before any mechanical excavation is used
- It is your responsibility to ensure this information is provided to all persons working near our plant
- If in doubt call the SSE Enterprise Dial Before You Dig team on 0345 070 7386.

Please note: If you have overlaps or misalignments between base maps that make it difficult to understand please contact DBYDEnterpriseEnquiries@sse.com or call 0345 070 7386

Scale: 1:500 (When plotted at A4)

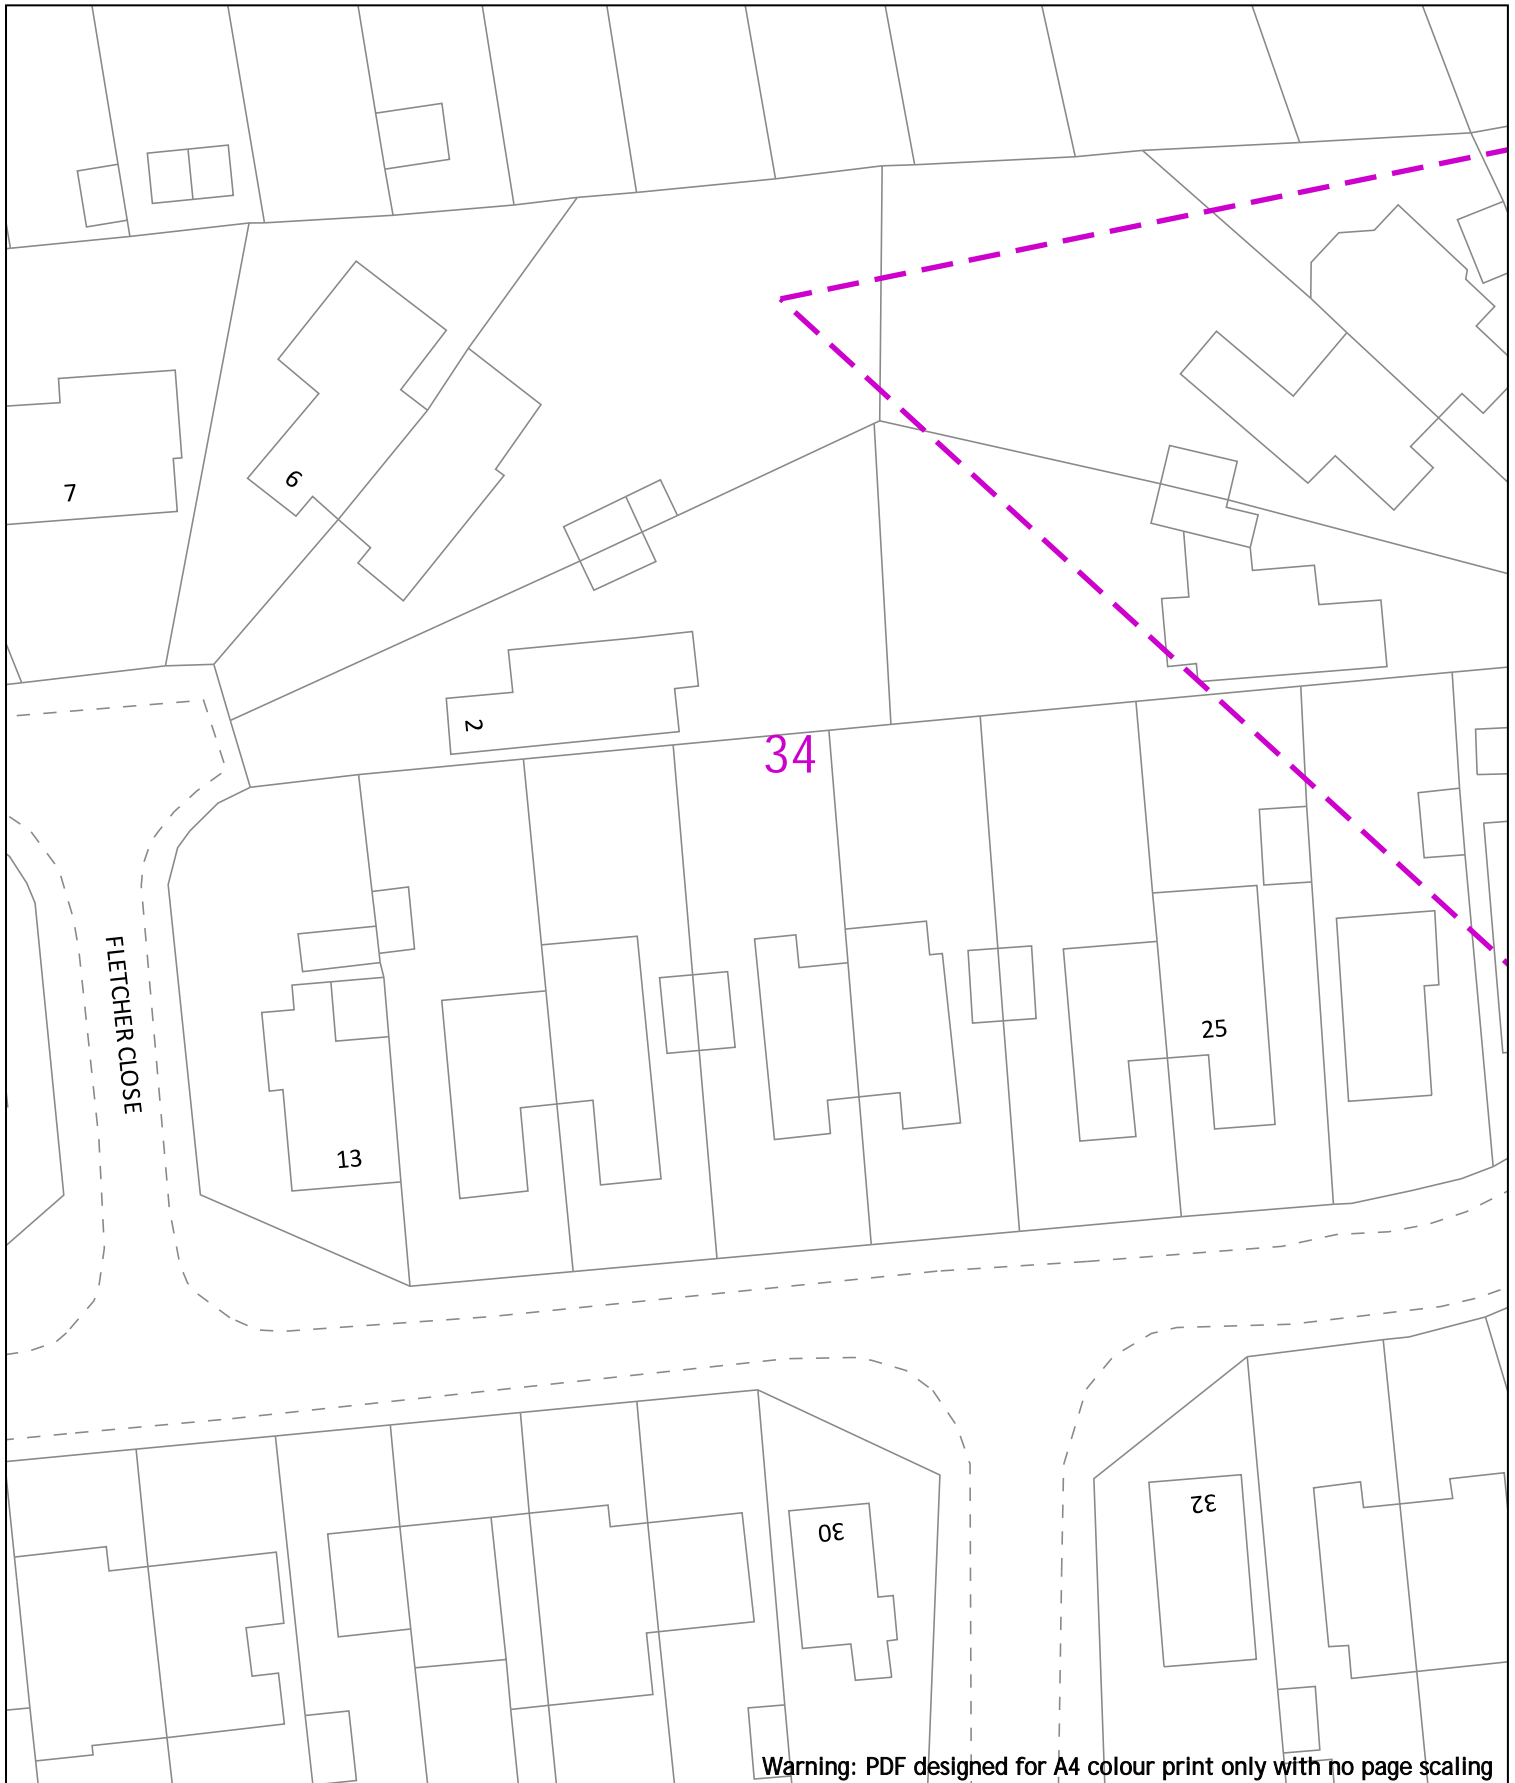

0 20m Dig Sites Area: Line:

LP Main	Valve Closed	Reducer
LP Service	Valve Open	Ducting
MP Main	CSEP	Gas Supply Point
MP Service	Pressure Reduction Station	
IP Main	End Closure	

IMPORTANT NOTICES


- This information is given as a guide only and its accuracy cannot be guaranteed
- The plan only shows pipes owned by SSE Utility Solutions Limited, Indigo Pipelines Limited
- Service pipes etc. may not be shown but their presence should be anticipated
- You must use safe digging practices in accordance with H5(G)47 to establish the actual position of mains, services and other apparatus before any mechanical excavation is used
- It is your responsibility to ensure this information is provided to all persons working near our plant
- If in doubt call the SSE Enterprise Dial Before You Dig team on 0345 070 7386.

Please note: If you have overlaps or misalignments between base maps that make it difficult to understand please contact DBYDEnterpriseEnquiries@sse.com or call 0345 070 7386

Date Requested: 24/06/2022
 Job Reference: 25881050
 Site Location: 448447 212278
 Requested by: Mr Joe Shawyer
 Your Scheme/Reference: 31188_004

Scale: 1:500 (When plotted at A4)

Indigo Pipelines Ltd.
 Registered Office:
 Loddon Reach,
 Reading Road,
 Arborfield,
 Reading,
 Berkshire, RG2 9HU

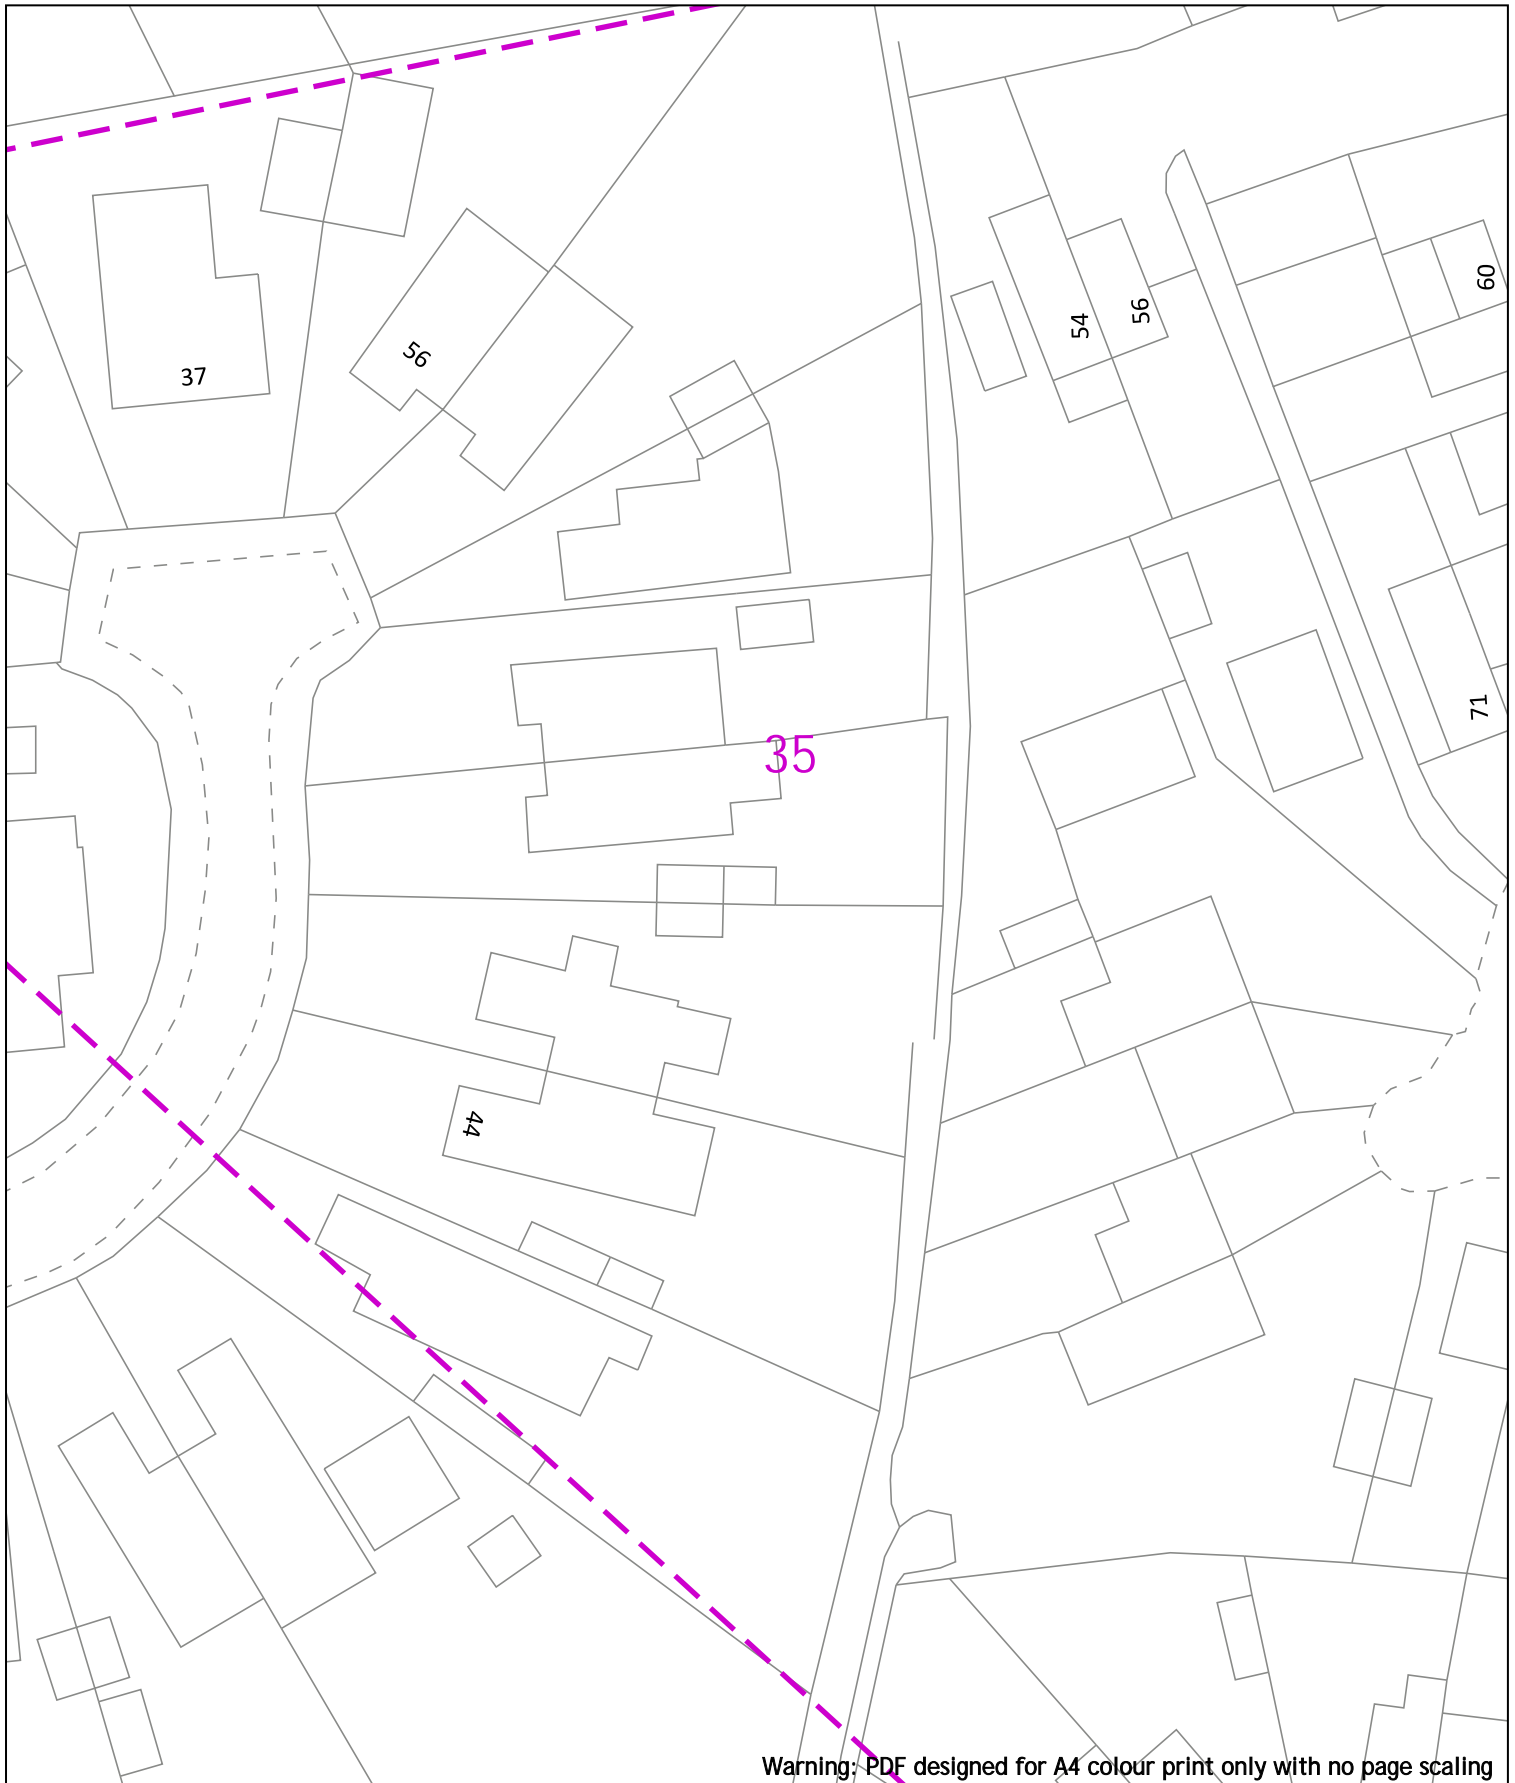

Warning: PDF designed for A4 colour print only with no page scaling

0 20m Dig Sites Area: Line:

Date Requested: 24/06/2022
 Job Reference: 25881050
 Site Location: 448447 212278
 Requested by: Mr Joe Shawyer
 Your Scheme/Reference: 31188_004

	LP Main		Valve Closed		Reducer
	LP Service		Valve Open		Ducting
	MP Main		CSEP		Gas Supply Point
	MP Service		Pressure Reduction Station		
	IP Main		End Closure		

IMPORTANT NOTICES


- This information is given as a guide only and its accuracy cannot be guaranteed
- The plan only shows pipes owned by SSE Utility Solutions Limited, Indigo Pipelines Limited
- Service pipes etc. may not be shown but their presence should be anticipated
- You must use safe digging practices in accordance with H5(G)47 to establish the actual position of mains, services and other apparatus before any mechanical excavation is used
- It is your responsibility to ensure this information is provided to all persons working near our plant
- If in doubt call the SSE Enterprise Dial Before You Dig team on 0345 070 7386.

Please note: If you have overlaps or misalignments between base maps that make it difficult to understand please contact DBYDEnterpriseEnquiries@sse.com or call 0345 070 7386



Indigo Pipelines Ltd.
 Registered Office:
 Loddon Reach,
 Reading Road,
 Arborfield,
 Reading,
 Berkshire, RG2 9HU

Scale: 1:500 (When plotted at A4)

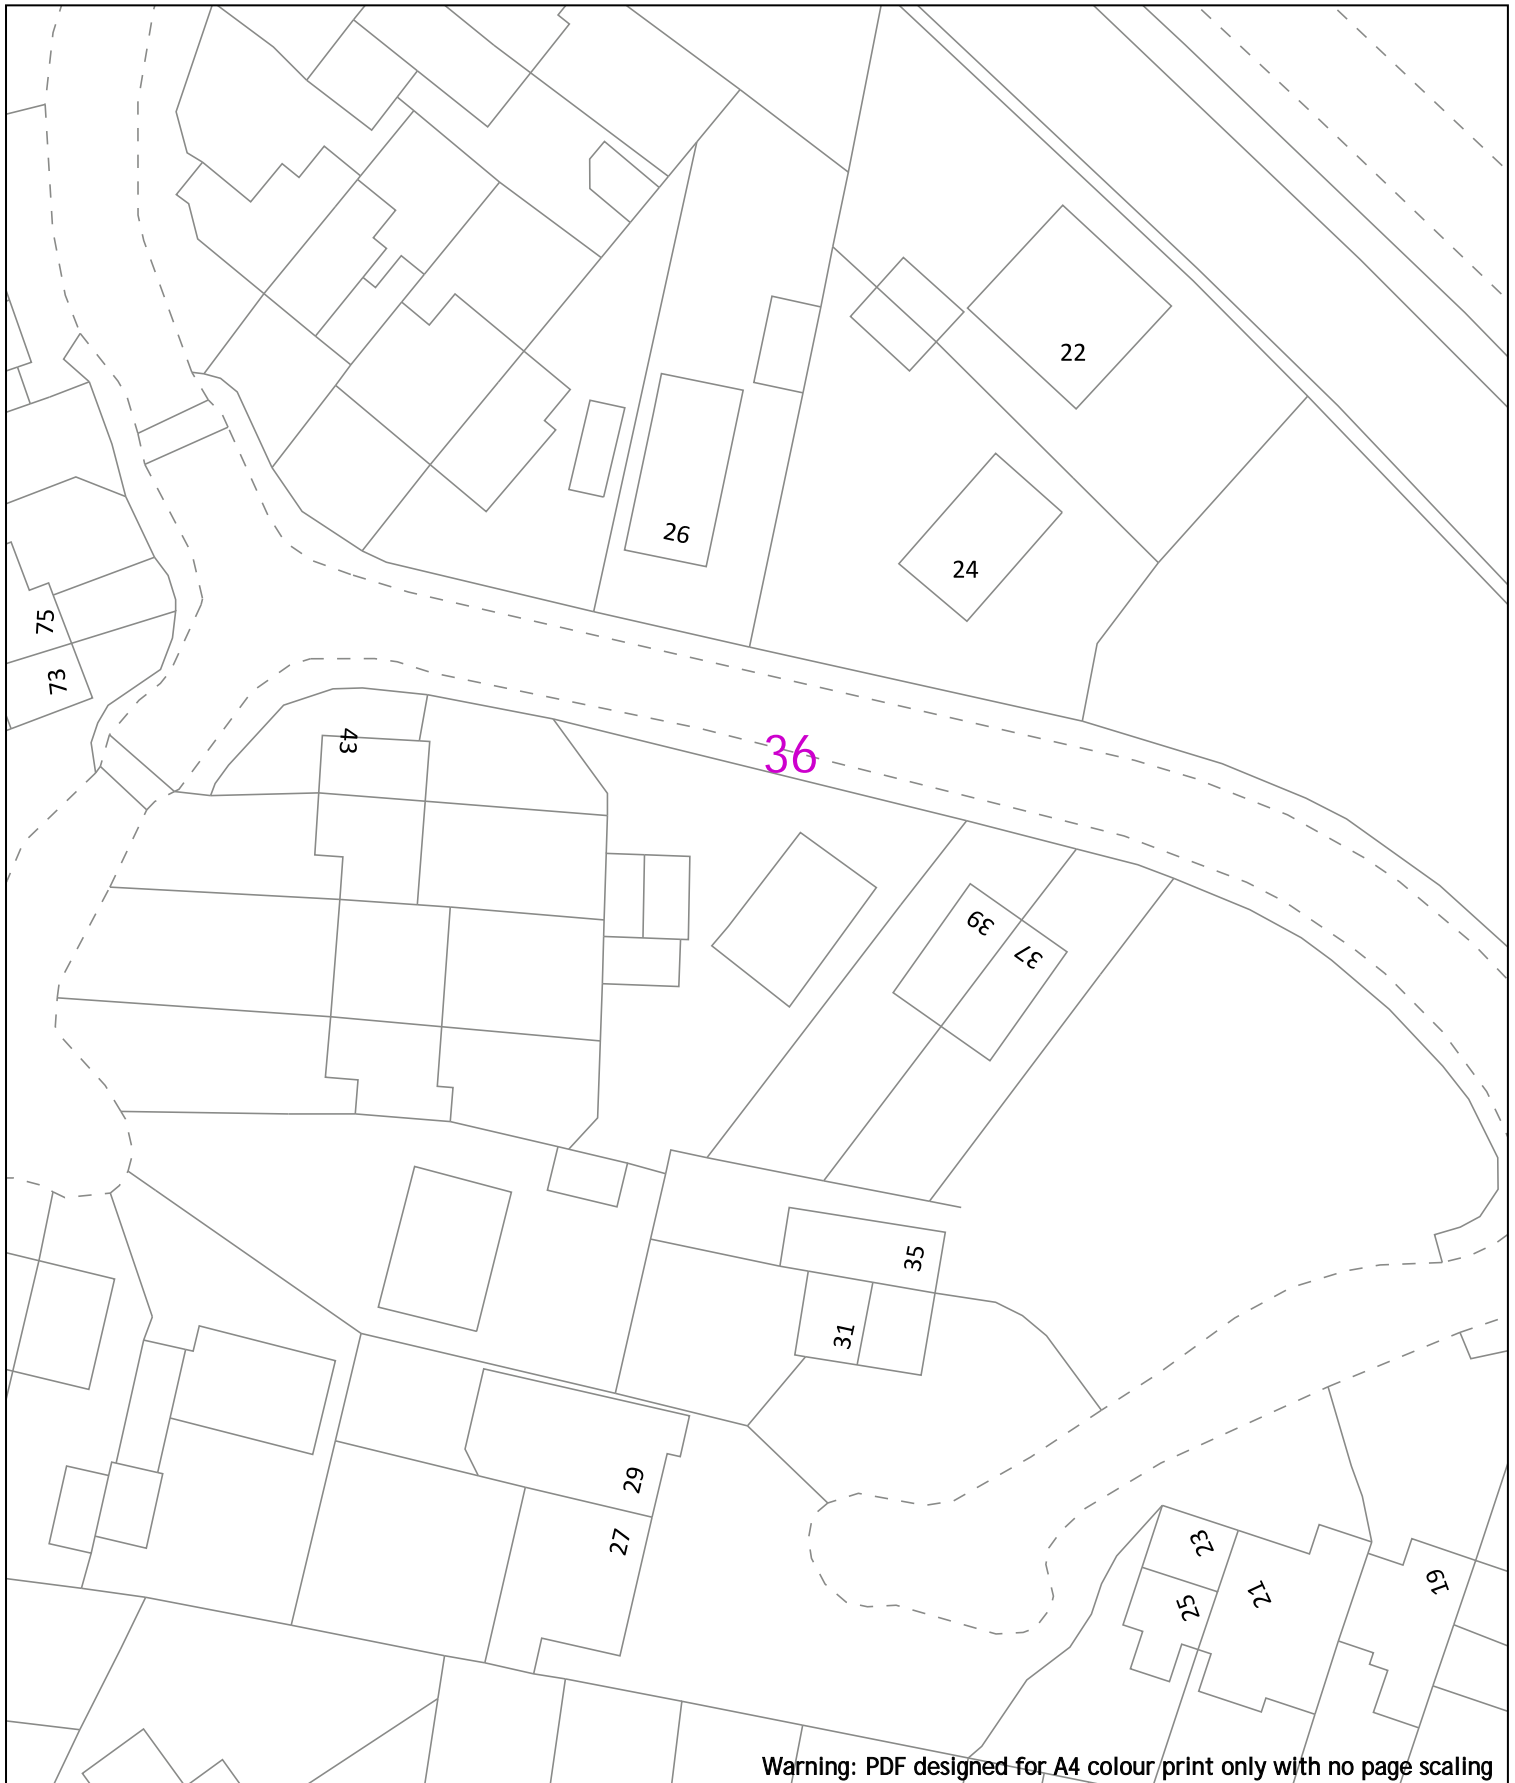

Warning: PDF designed for A4 colour print only with no page scaling



Date Requested: 24/06/2022
 Job Reference: 25881050
 Site Location: 448447 212278
 Requested by: Mr Joe Shawyer
 Your Scheme/Reference: 31188_004

	LP Main		Valve Closed		Reducer
	LP Service		Valve Open		Ducting
	MP Main		CSEP		Gas Supply Point
	MP Service		Pressure Reduction Station		
	IP Main		End Closure		

IMPORTANT NOTICES


- This information is given as a guide only and its accuracy cannot be guaranteed
- The plan only shows pipes owned by SSE Utility Solutions Limited, Indigo Pipelines Limited
- Service pipes etc. may not be shown but their presence should be anticipated
- You must use safe digging practices in accordance with H5(G)47 to establish the actual position of mains, services and other apparatus before any mechanical excavation is used
- It is your responsibility to ensure this information is provided to all persons working near our plant
- If in doubt call the SSE Enterprise Dial Before You Dig team on 0345 070 7386.

Please note: If you have overlaps or misalignments between base maps that make it difficult to understand please contact DBYDEnterpriseEnquiries@sse.com or call 0345 070 7386



Indigo Pipelines Ltd.
 Registered Office:
 Loddon Reach,
 Reading Road,
 Arborfield,
 Reading,
 Berkshire, RG2 9HU

Scale: 1:500 (When plotted at A4)

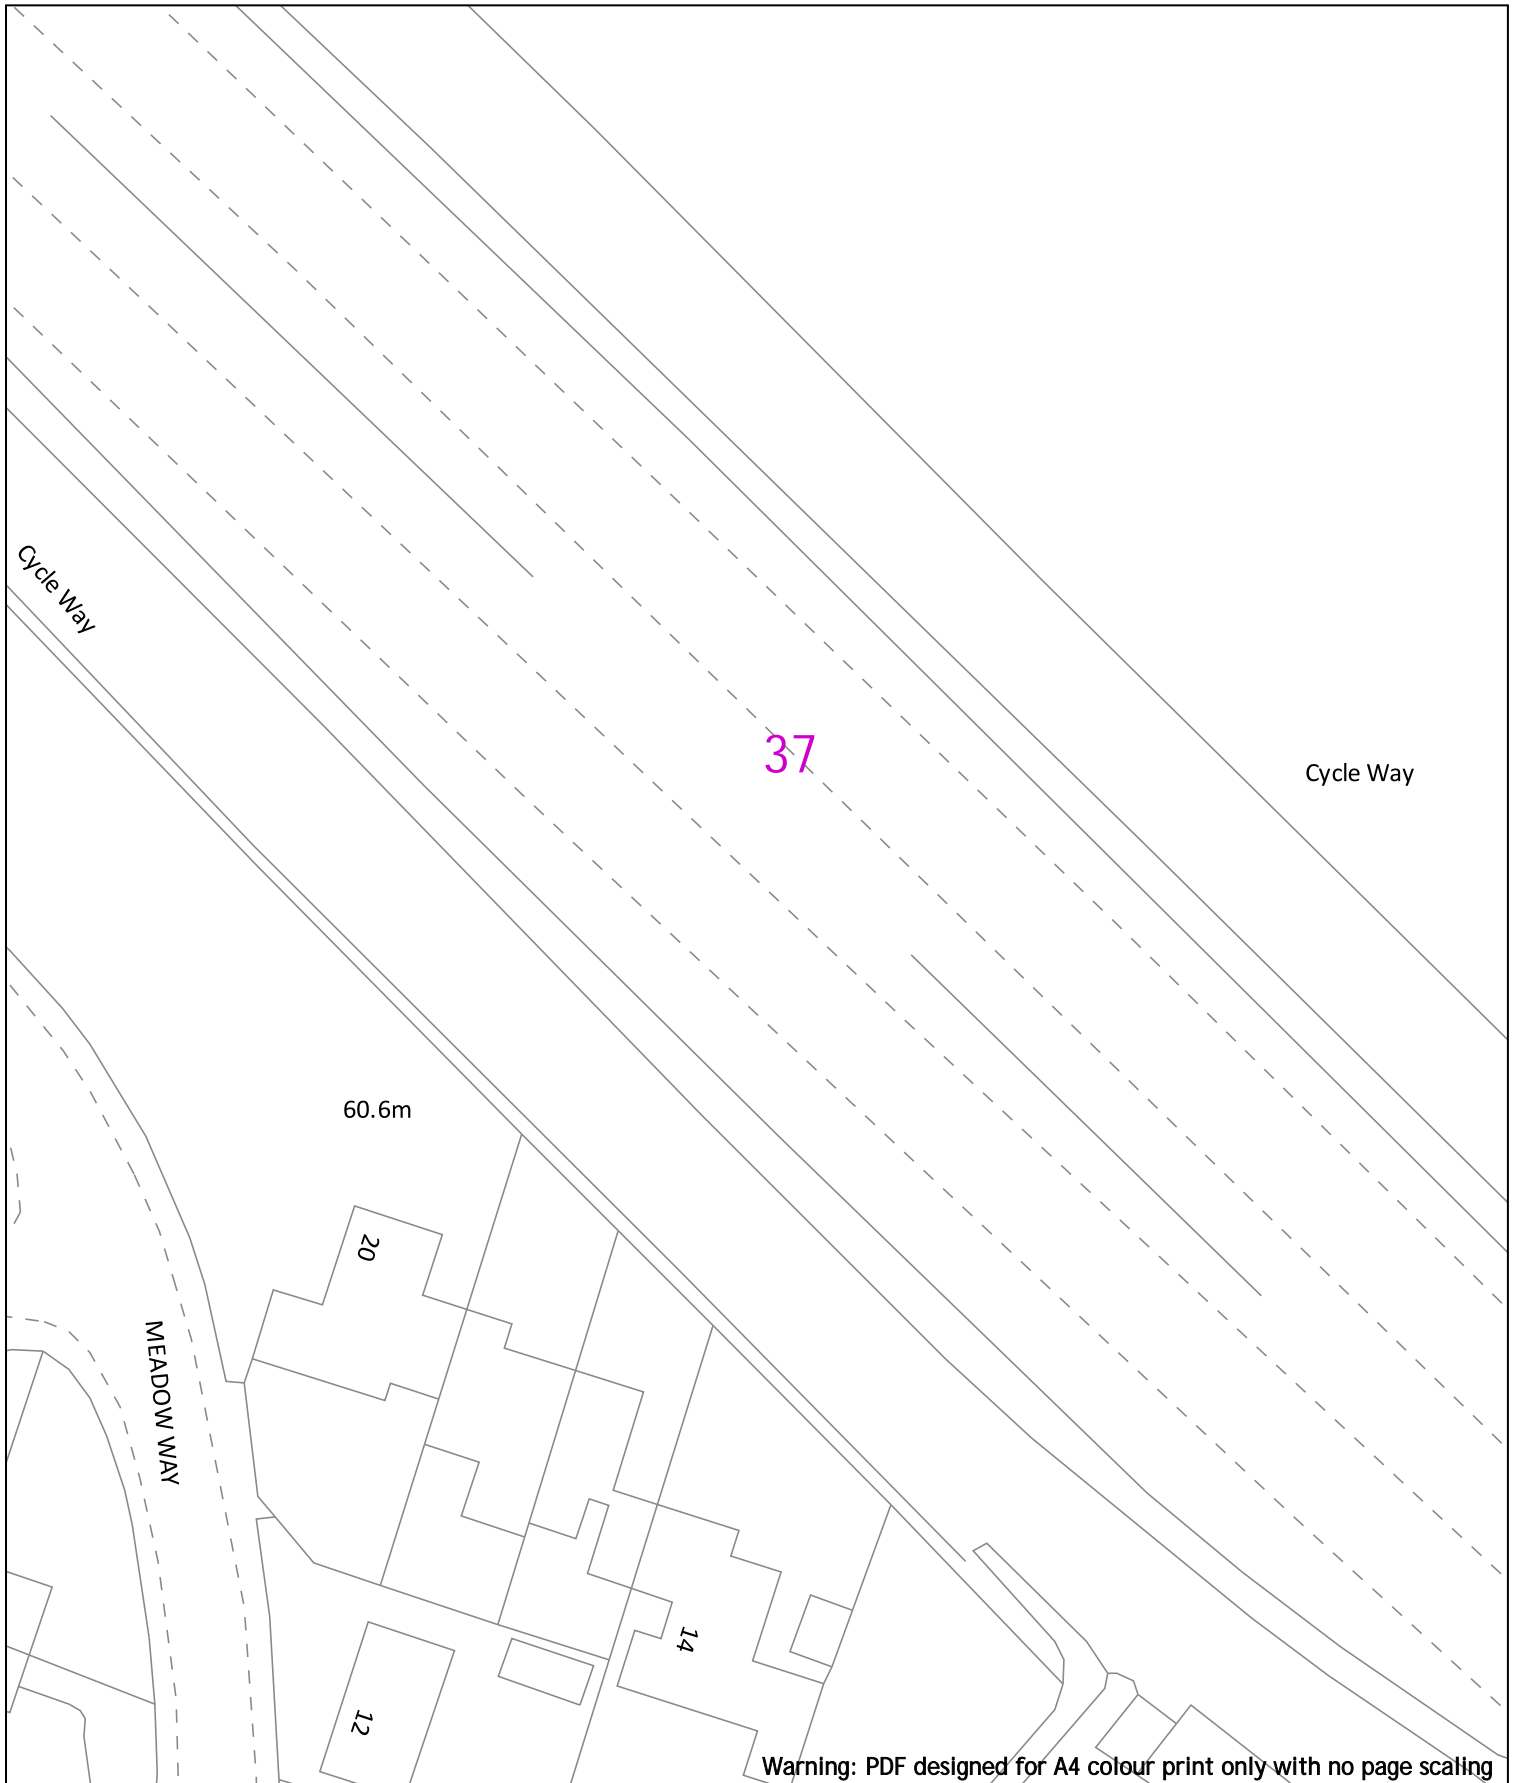

0 20m Dig Sites Area: Line:

LP Main	Valve Closed	Reducer
LP Service	Valve Open	Ducting
MP Main	CSEP	Gas Supply Point
MP Service	Pressure Reduction Station	
IP Main	End Closure	

IMPORTANT NOTICES


- This information is given as a guide only and its accuracy cannot be guaranteed
- The plan only shows pipes owned by SSE Utility Solutions Limited, Indigo Pipelines Limited
- Service pipes etc. may not be shown but their presence should be anticipated
- You must use safe digging practices in accordance with H5(G)47 to establish the actual position of mains, services and other apparatus before any mechanical excavation is used
- It is your responsibility to ensure this information is provided to all persons working near our plant
- If in doubt call the SSE Enterprise Dial Before You Dig team on 0345 070 7386.

Please note: If you have overlaps or misalignments between base maps that make it difficult to understand please contact DBYDEnterpriseEnquiries@sse.com or call 0345 070 7386

Date Requested: 24/06/2022
 Job Reference: 25881050
 Site Location: 448447 212278
 Requested by: Mr Joe Shawyer
 Your Scheme/Reference: 31188_004

Scale: 1:500 (When plotted at A4)

Indigo Pipelines Ltd.
 Registered Office:
 Loddon Reach,
 Reading Road,
 Arborfield,
 Reading,
 Berkshire, RG2 9HU

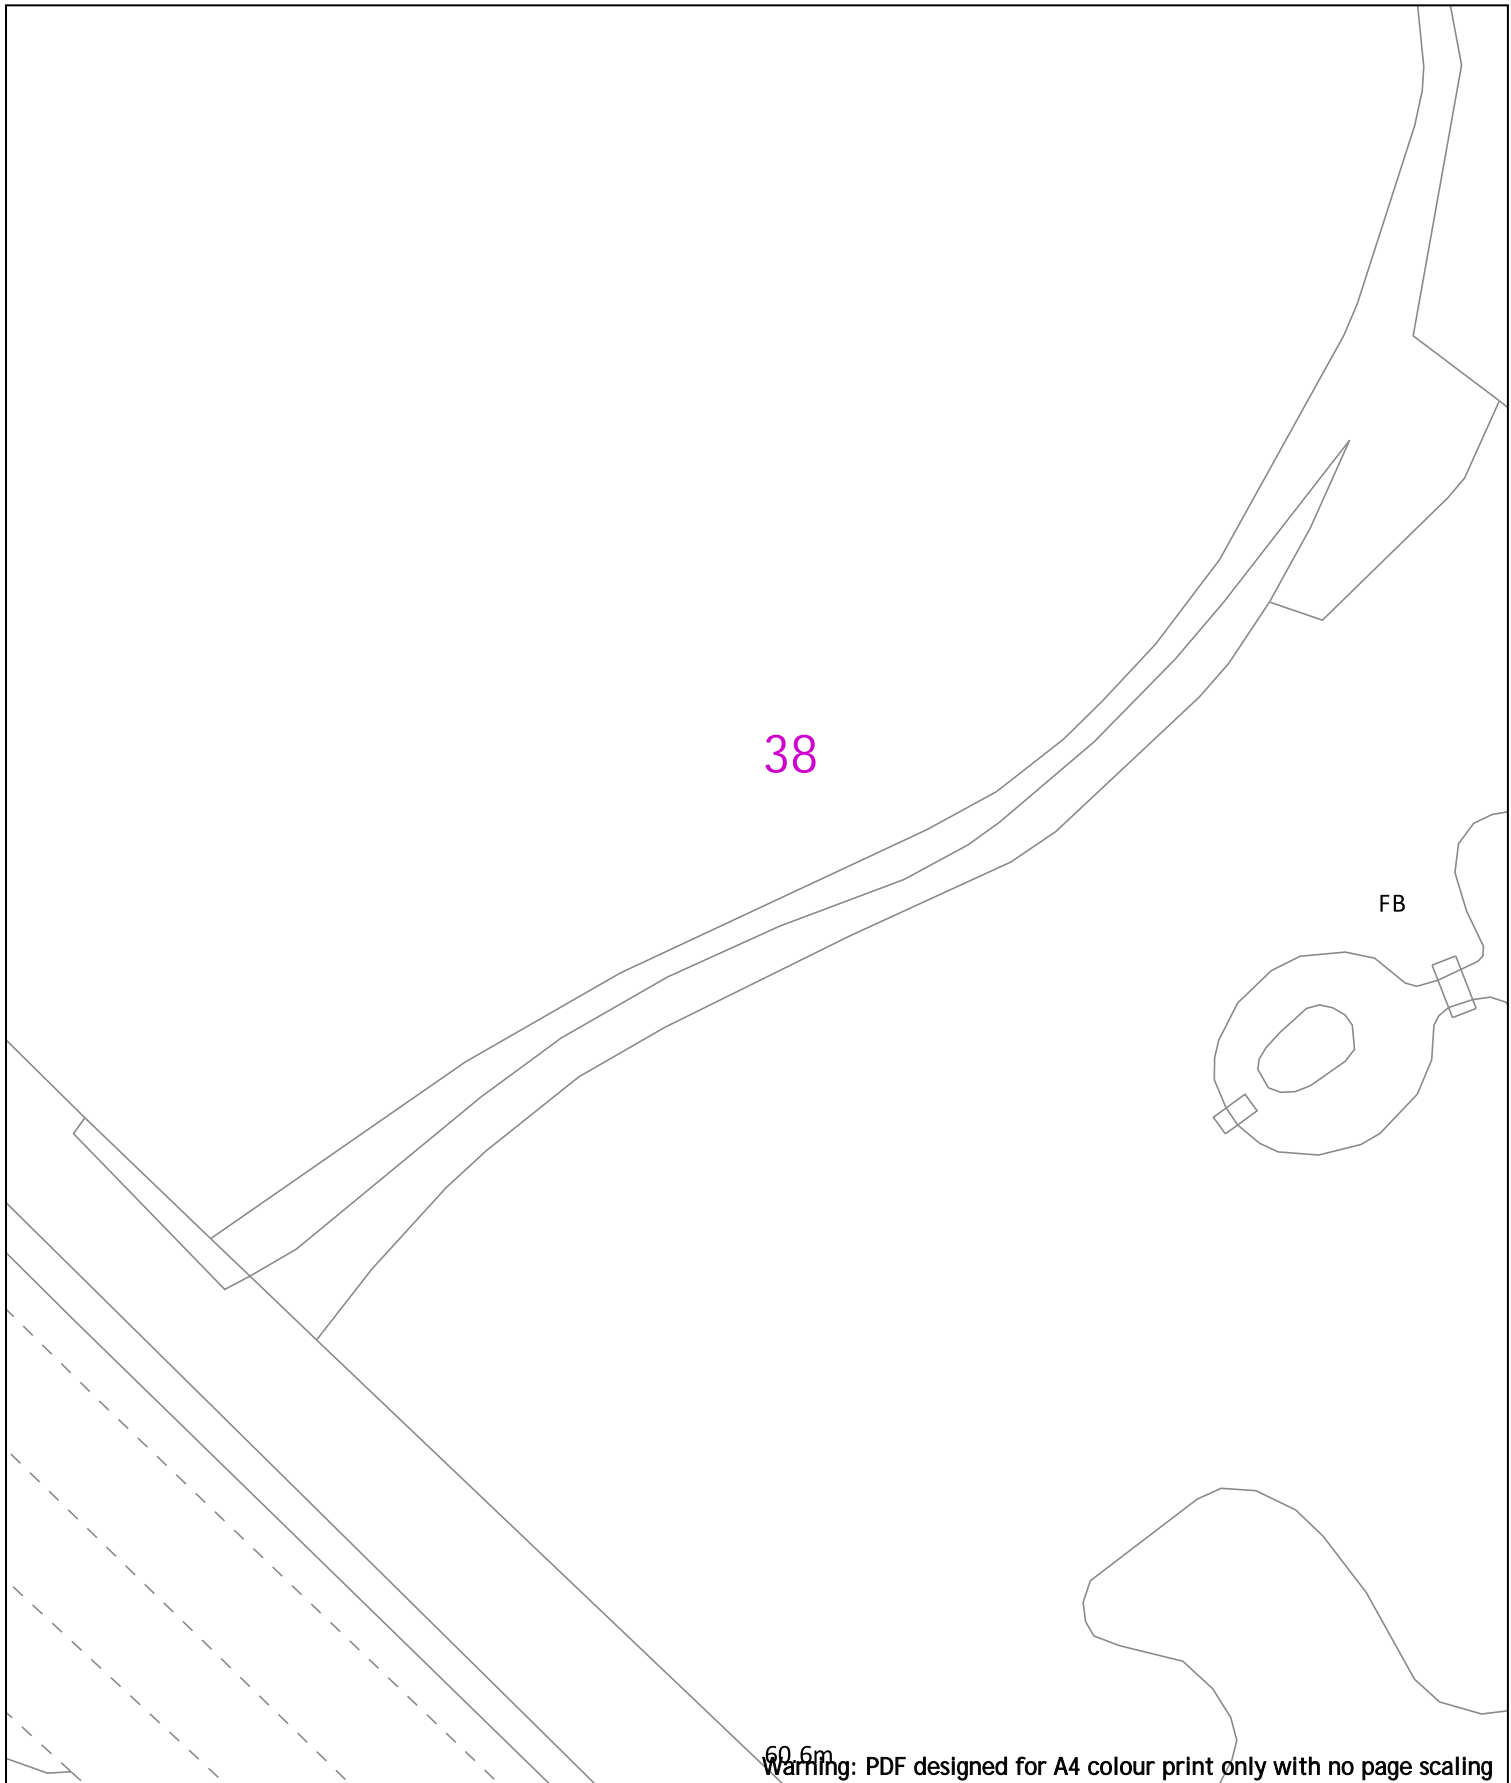

Warning: PDF designed for A4 colour print only with no page scaling

0 20m Dig Sites Area: Line:

	LP Main		Valve Closed		Reducer
	LP Service		Valve Open		Ducting
	MP Main		CSEP		Gas Supply Point
	MP Service		Pressure Reduction Station		
	IP Main		End Closure		

IMPORTANT NOTICES

- This information is given as a guide only and its accuracy cannot be guaranteed
- The plan only shows pipes owned by SSE Utility Solutions Limited, Indigo Pipelines Limited
- Service pipes etc. may not be shown but their presence should be anticipated
- You must use safe digging practices in accordance with H5(G)47 to establish the actual position of mains, services and other apparatus before any mechanical excavation is used
- It is your responsibility to ensure this information is provided to all persons working near our plant
- If in doubt call the SSE Enterprise Dial Before You Dig team on 0345 070 7386.

Please note: If you have overlaps or misalignments between base maps that make it difficult to understand please contact DBYDEnterpriseEnquiries@sse.com or call 0345 070 7386


Date Requested: 24/06/2022
 Job Reference: 25881050
 Site Location: 448447 212278
 Requested by: Mr Joe Shawyer
 Your Scheme/Reference: 31188_004

Scale: 1:500 (When plotted at A4)














Indigo Pipelines Ltd.
 Registered Office:
 Loddon Reach,
 Reading Road,
 Arborfield,
 Reading,
 Berkshire, RG2 9HU

39

Warning: PDF designed for A4 colour print only with no page scaling

0  20m Dig Sites Area:  Line: 

Date Requested: 24/06/2022
Job Reference: 25881050
Site Location: 448447 212278
Requested by: Mr Joe Shawyer
Your Scheme/Reference: 31188_004

 	LP Main		Valve Closed		Reducer
	LP Service		Valve Open		Ducting
	MP Main		CSEP		Gas Supply Point
	MP Service		Pressure Reduction Station		
	IP Main		End Closure		

IMPORTANT NOTICES

- This information is given as a guide only and its accuracy cannot be guaranteed
- The plan only shows pipes owned by SSE Utility Solutions Limited, Indigo Pipelines Limited
- Service pipes etc. may not be shown but their presence should be anticipated
- You must use safe digging practices in accordance with H5(G)47 to establish the actual position of mains, services and other apparatus before any mechanical excavation is used
- It is your responsibility to ensure this information is provided to all persons working near our plant
- If in doubt call the SSE Enterprise Dial Before You Dig team on 0345 070 7386.

Please note: If you have overlaps or misalignments between base maps that make it difficult to understand please contact DBYDEnterpriseEnquiries@sse.com or call 0345 070 7386



Indigo Pipelines Ltd.
Registered Office:
Loddon Reach,
Reading Road,
Arborfield,
Reading,
Berkshire, RG2 9HU














40

Sports Ground

Warning: PDF designed for A4 colour print only with no page scaling

0  20m Dig Sites Area:  Line: 

Date Requested: 24/06/2022
Job Reference: 25881050
Site Location: 448447 212278
Requested by: Mr Joe Shawyer
Your Scheme/Reference: 31188_004

  LP Main	 Valve Closed	 Reducer
 LP Service	 Valve Open	 Ducting
 MP Main	 CSEP	 Gas Supply Point
 MP Service	 Pressure Reduction Station	
 IP Main	 End Closure	


IMPORTANT NOTICES

- This information is given as a guide only and its accuracy cannot be guaranteed
 - The plan only shows pipes owned by SSE Utility Solutions Limited, Indigo Pipelines Limited
 - Service pipes etc. may not be shown but their presence should be anticipated
 - You must use safe digging practices in accordance with H5(G)47 to establish the actual position of mains, services and other apparatus before any mechanical excavation is used
 - It is your responsibility to ensure this information is provided to all persons working near our plant
 - If in doubt call the SSE Enterprise Dial Before You Dig team on 0345 070 7386.
- Please note:** If you have overlaps or misalignments between base maps that make it difficult to understand please contact DBYDEnterpriseEnquiries@sse.com or call 0345 070 7386



Indigo Pipelines Ltd.
Registered Office:
Loddon Reach,
Reading Road,
Arborfield,
Reading,
Berkshire, RG2 9HU

Scale: 1:500 (When plotted at A4)

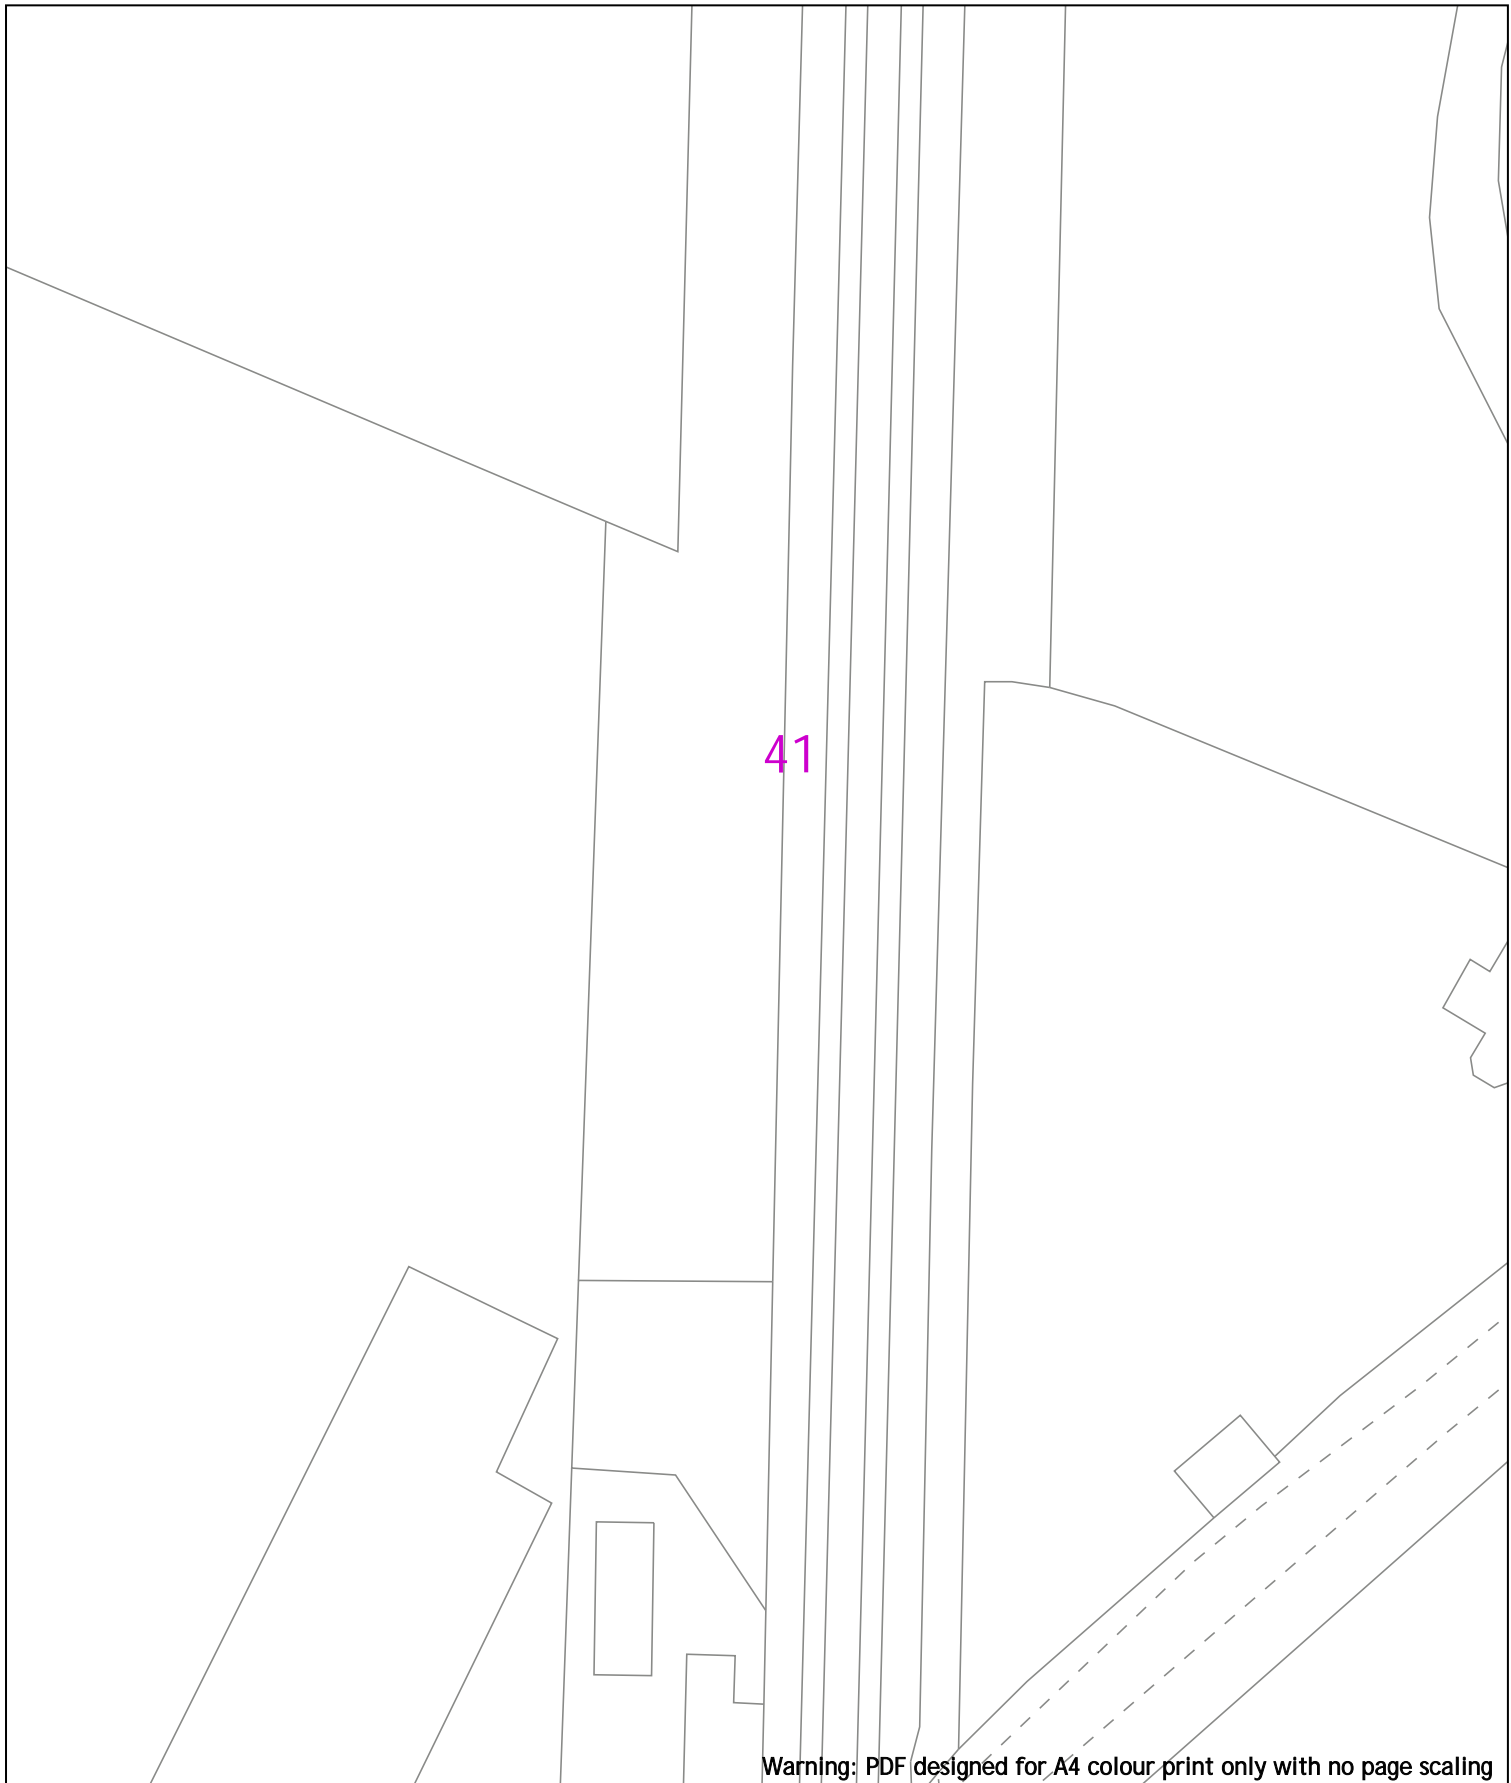

Warning: PDF designed for A4 colour print only with no page scaling

0 20m Dig Sites Area: Line:

LP Main	Valve Closed	Reducer
LP Service	Valve Open	Ducting
MP Main	CSEP	Gas Supply Point
MP Service	Pressure Reduction Station	
IP Main	End Closure	

IMPORTANT NOTICES


- This information is given as a guide only and its accuracy cannot be guaranteed
- The plan only shows pipes owned by SSE Utility Solutions Limited, Indigo Pipelines Limited
- Service pipes etc. may not be shown but their presence should be anticipated
- You must use safe digging practices in accordance with H5(G)47 to establish the actual position of mains, services and other apparatus before any mechanical excavation is used
- It is your responsibility to ensure this information is provided to all persons working near our plant
- If in doubt call the SSE Enterprise Dial Before You Dig team on 0345 070 7386.

Please note: If you have overlaps or misalignments between base maps that make it difficult to understand please contact DBYDEnterpriseEnquiries@sse.com or call 0345 070 7386







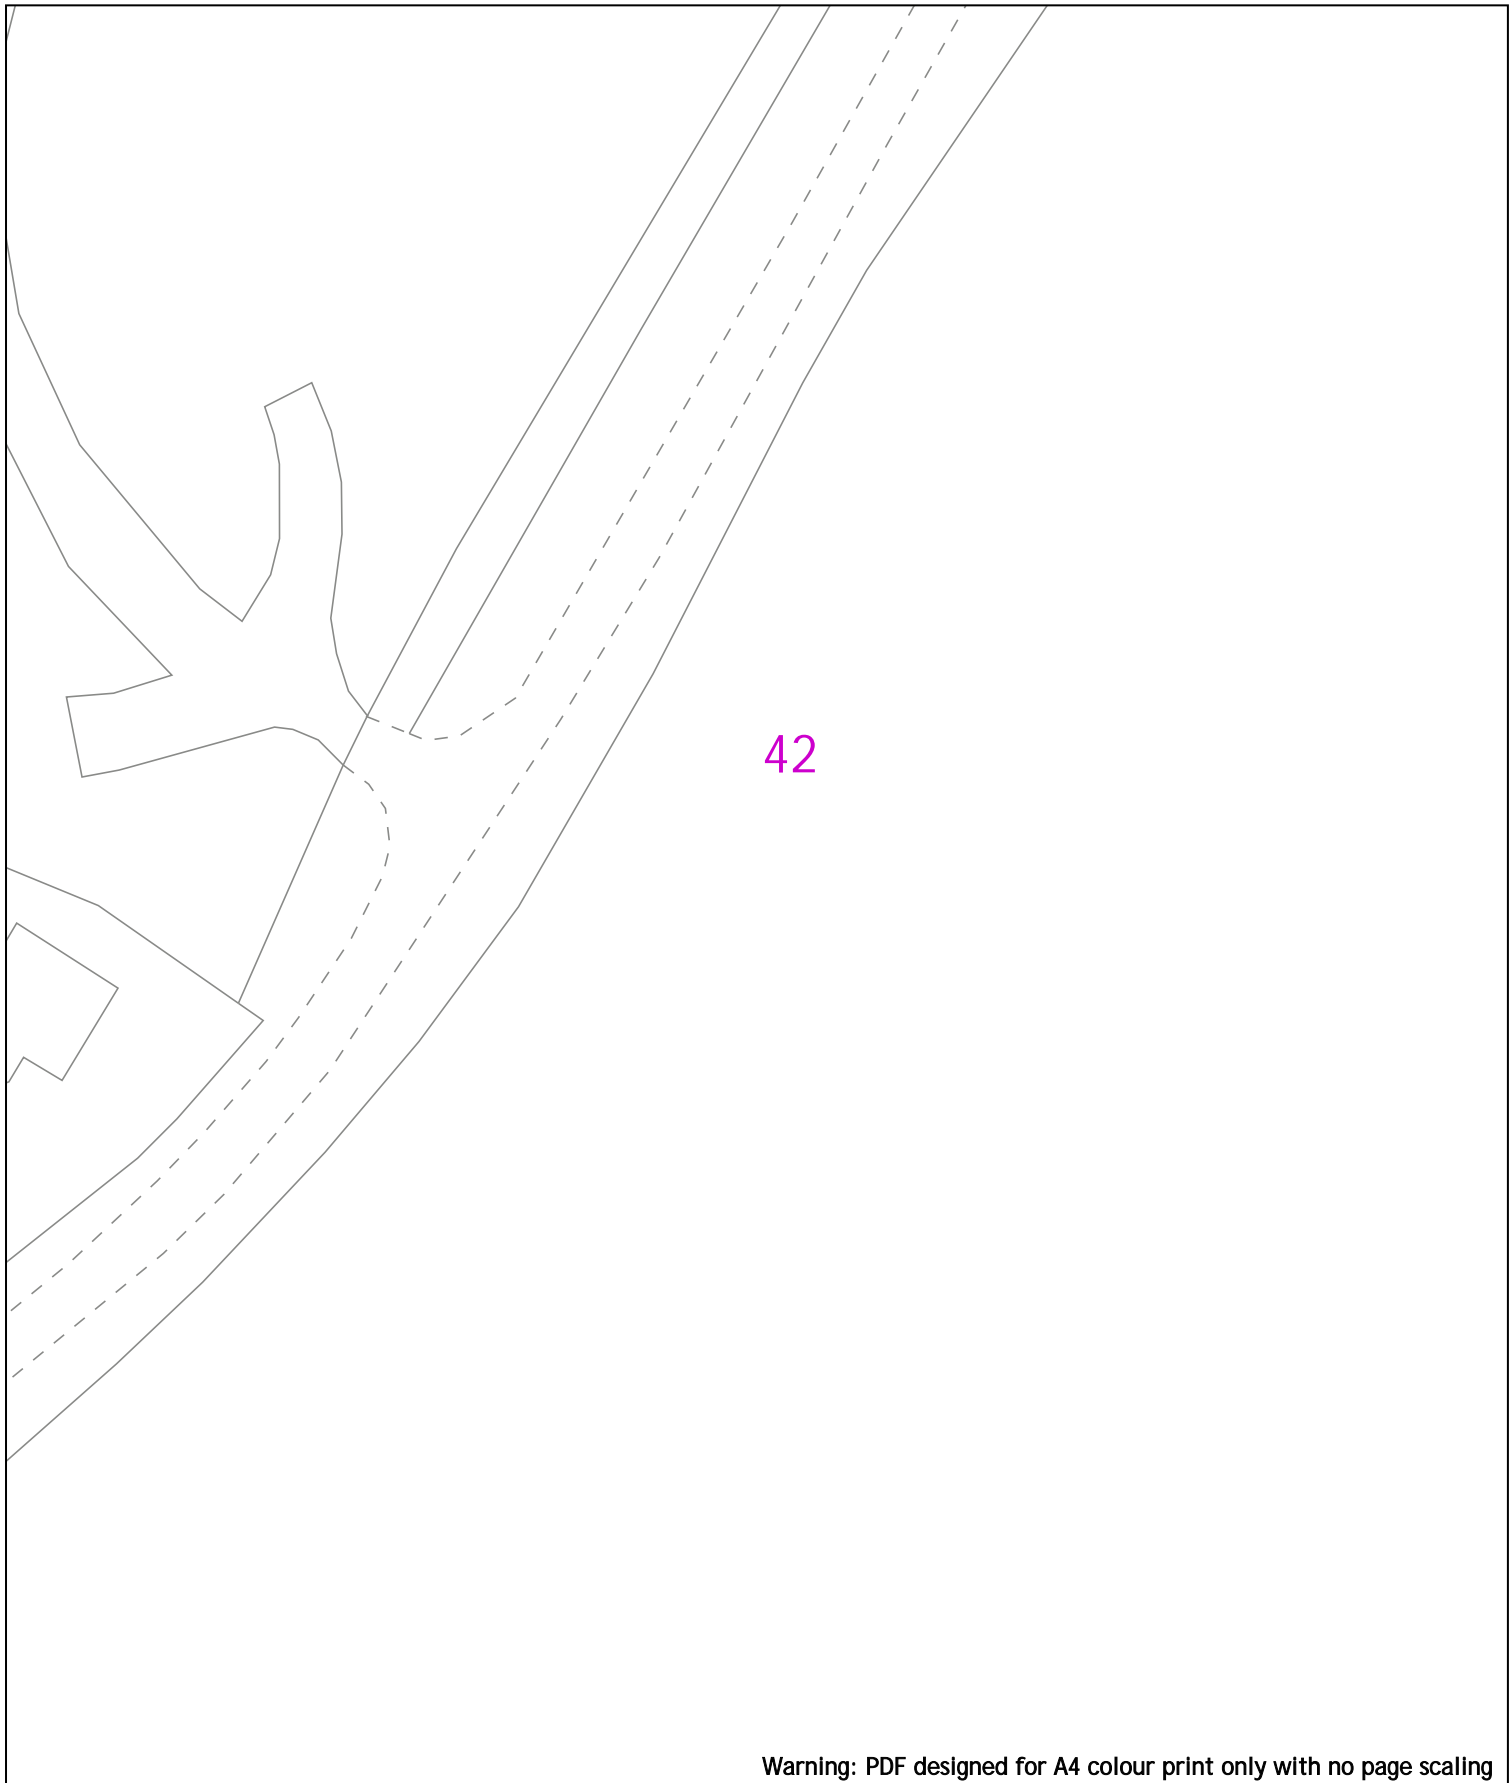





































Date Requested: 24/06/2022
 Job Reference: 25881050
 Site Location: 448447 212278
 Requested by: Mr Joe Shawyer
 Your Scheme/Reference: 31188_004

Scale: 1:500 (When plotted at A4)

Indigo Pipelines Ltd.
 Registered Office:
 Loddon Reach,
 Reading Road,
 Arborfield,
 Reading,
 Berkshire, RG2 9HU





Warning: PDF designed for A4 colour print only with no page scaling














<p>0  20m Dig Sites Area:  Line: </p>	<p>Date Requested: 24/06/2022 Job Reference: 25881050 Site Location: 448447 212278 Requested by: Mr Joe Shawyer Your Scheme/Reference: 31188_004</p>	 															
<p>Scale: 1:500 (When plotted at A4)</p>	<table border="0"> <tr> <td> LP Main</td> <td> Valve Closed</td> <td> Reducer</td> </tr> <tr> <td> LP Service</td> <td> Valve Open</td> <td> Ducting</td> </tr> <tr> <td> MP Main</td> <td> CSEP</td> <td> Gas Supply Point</td> </tr> <tr> <td> MP Service</td> <td> Pressure Reduction Station</td> <td></td> </tr> <tr> <td> IP Main</td> <td> End Closure</td> <td></td> </tr> </table> <p>IMPORTANT NOTICES</p> <ul style="list-style-type: none"> This information is given as a guide only and its accuracy cannot be guaranteed The plan only shows pipes owned by SSE Utility Solutions Limited, Indigo Pipelines Limited Service pipes etc. may not be shown but their presence should be anticipated You must use safe digging practices in accordance with H5(G)47 to establish the actual position of mains, services and other apparatus before any mechanical excavation is used It is your responsibility to ensure this information is provided to all persons working near our plant If in doubt call the SSE Enterprise Dial Before You Dig team on 0345 070 7386. <p>Please note: If you have overlaps or misalignments between base maps that make it difficult to understand please contact DBYDEnterpriseEnquiries@sse.com or call 0345 070 7386</p>	 LP Main	 Valve Closed	 Reducer	 LP Service	 Valve Open	 Ducting	 MP Main	 CSEP	 Gas Supply Point	 MP Service	 Pressure Reduction Station		 IP Main	 End Closure		<p>Indigo Pipelines Ltd. Registered Office: Loddon Reach, Reading Road, Arborfield, Reading, Berkshire, RG2 9HU</p>
 LP Main	 Valve Closed	 Reducer															
 LP Service	 Valve Open	 Ducting															
 MP Main	 CSEP	 Gas Supply Point															
 MP Service	 Pressure Reduction Station																
 IP Main	 End Closure																

43

Warning: PDF designed for A4 colour print only with no page scaling

0  20m Dig Sites Area:  Line: 

Date Requested: 24/06/2022
Job Reference: 25881050
Site Location: 448447 212278
Requested by: Mr Joe Shawyer
Your Scheme/Reference: 31188_004

  LP Main	 Valve Closed	 Reducer
 LP Service	 Valve Open	 Ducting
 MP Main	 CSEP	 Gas Supply Point
 MP Service	 Pressure Reduction Station	
 IP Main	 End Closure	

IMPORTANT NOTICES


- This information is given as a guide only and its accuracy cannot be guaranteed
- The plan only shows pipes owned by SSE Utility Solutions Limited, Indigo Pipelines Limited
- Service pipes etc. may not be shown but their presence should be anticipated
- You must use safe digging practices in accordance with H5(G)47 to establish the actual position of mains, services and other apparatus before any mechanical excavation is used
- It is your responsibility to ensure this information is provided to all persons working near our plant
- If in doubt call the SSE Enterprise Dial Before You Dig team on 0345 070 7386.

Please note: If you have overlaps or misalignments between base maps that make it difficult to understand please contact DBYDEnterpriseEnquiries@sse.com or call 0345 070 7386







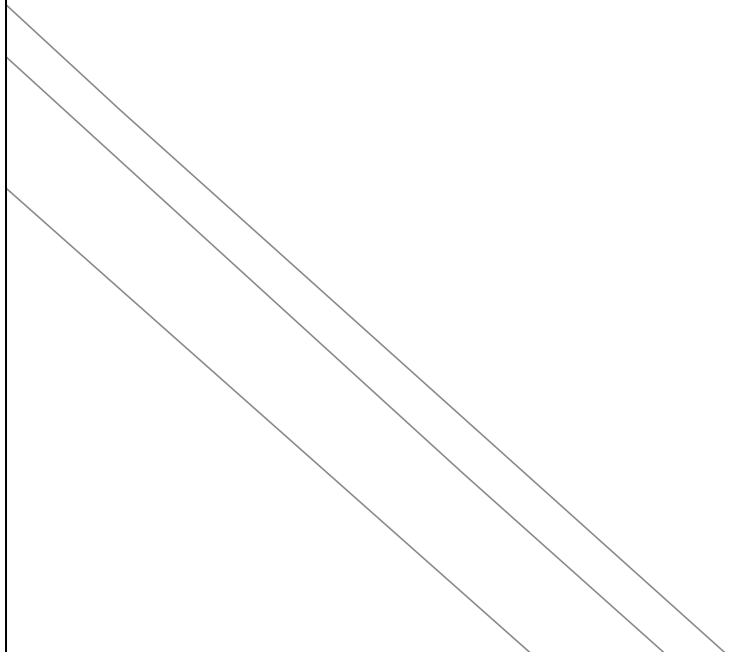

















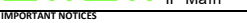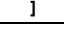


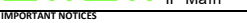
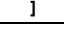











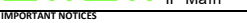
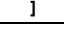


Indigo Pipelines Ltd.
Registered Office:
Loddon Reach,
Reading Road,
Arborfield,
Reading,
Berkshire, RG2 9HU

Scale: 1:500 (When plotted at A4)



Warning: PDF designed for A4 colour print only with no page scaling


<p>0  20m Dig Sites Area:  Line: </p>	<table border="0"> <tr> <td> LP Main</td> <td> Valve Closed</td> <td> Reducer</td> </tr> <tr> <td> LP Service</td> <td> Valve Open</td> <td> Ducting</td> </tr> <tr> <td> MP Main</td> <td> CSEP</td> <td> Gas Supply Point</td> </tr> <tr> <td> MP Service</td> <td> Pressure Reduction Station</td> <td></td> </tr> <tr> <td> IP Main</td> <td> End Closure</td> <td></td> </tr> </table>	 LP Main	 Valve Closed	 Reducer	 LP Service	 Valve Open	 Ducting	 MP Main	 CSEP	 Gas Supply Point	 MP Service	 Pressure Reduction Station		 IP Main	 End Closure	
 LP Main	 Valve Closed	 Reducer														
 LP Service	 Valve Open	 Ducting														
 MP Main	 CSEP	 Gas Supply Point														
 MP Service	 Pressure Reduction Station															
 IP Main	 End Closure															
<p>Date Requested: 24/06/2022 Job Reference: 25881050 Site Location: 448447 212278 Requested by: Mr Joe Shawyer Your Scheme/Reference: 31188_004</p> <p>Scale: 1:500 (When plotted at A4)</p>	<p>IMPORTANT NOTICES</p> <ul style="list-style-type: none"> This information is given as a guide only and its accuracy cannot be guaranteed The plan only shows pipes owned by SSE Utility Solutions Limited, Indigo Pipelines Limited Service pipes etc. may not be shown but their presence should be anticipated You must use safe digging practices in accordance with H5(G)47 to establish the actual position of mains, services and other apparatus before any mechanical excavation is used It is your responsibility to ensure this information is provided to all persons working near our plant If in doubt call the SSE Enterprise Dial Before You Dig team on 0345 070 7386. <p>Please note: If you have overlaps or misalignments between base maps that make it difficult to understand please contact DBYDEnterpriseEnquiries@sse.com or call 0345 070 7386</p>															
















Indigo Pipelines Ltd.
 Registered Office:
 Loddon Reach,
 Reading Road,
 Arborfield,
 Reading,
 Berkshire, RG2 9HU

45

Warning: PDF designed for A4 colour print only with no page scaling

0  20m Dig Sites Area:  Line: 

Date Requested: 24/06/2022
Job Reference: 25881050
Site Location: 448447 212278
Requested by: Mr Joe Shawyer
Your Scheme/Reference: 31188_004

	LP Main		Valve Closed		Reducer
	LP Service		Valve Open		Ducting
	MP Main		CSEP		Gas Supply Point
	MP Service		Pressure Reduction Station		
	IP Main		End Closure		


IMPORTANT NOTICES

- This information is given as a guide only and its accuracy cannot be guaranteed
- The plan only shows pipes owned by SSE Utility Solutions Limited, Indigo Pipelines Limited
- Service pipes etc. may not be shown but their presence should be anticipated
- You must use safe digging practices in accordance with H5(G)47 to establish the actual position of mains, services and other apparatus before any mechanical excavation is used
- It is your responsibility to ensure this information is provided to all persons working near our plant
- If in doubt call the SSE Enterprise Dial Before You Dig team on 0345 070 7386.

Please note: If you have overlaps or misalignments between base maps that make it difficult to understand please contact DBYDEnterpriseEnquiries@sse.com or call 0345 070 7386



Indigo Pipelines Ltd.
Registered Office:
Loddon Reach,
Reading Road,
Arborfield,
Reading,
Berkshire, RG2 9HU

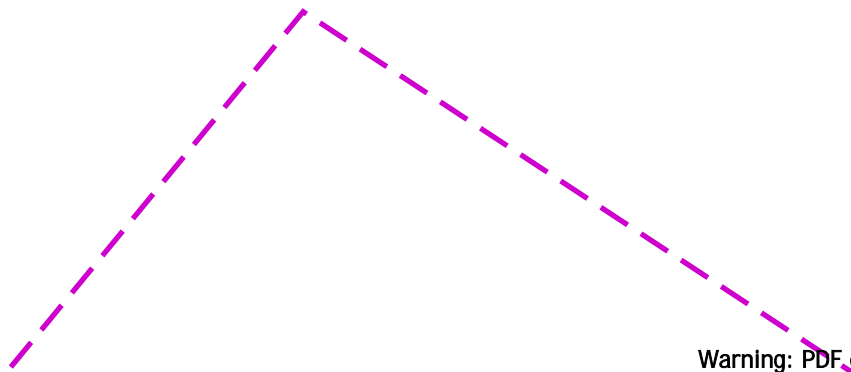

Warning: PDF designed for A4 colour print only with no page scaling

0 20m Dig Sites Area: Line:

Date Requested: 24/06/2022
 Job Reference: 25881050
 Site Location: 448447 212278
 Requested by: Mr Joe Shawyer
 Your Scheme/Reference: 31188_004

	LP Main		Valve Closed		Reducer
	LP Service		Valve Open		Ducting
	MP Main		CSEP		Gas Supply Point
	MP Service		Pressure Reduction Station		
	IP Main		End Closure		

IMPORTANT NOTICES


- This information is given as a guide only and its accuracy cannot be guaranteed
- The plan only shows pipes owned by SSE Utility Solutions Limited, Indigo Pipelines Limited
- Service pipes etc. may not be shown but their presence should be anticipated
- You must use safe digging practices in accordance with H5(G)47 to establish the actual position of mains, services and other apparatus before any mechanical excavation is used
- It is your responsibility to ensure this information is provided to all persons working near our plant
- If in doubt call the SSE Enterprise Dial Before You Dig team on 0345 070 7386.

Please note: If you have overlaps or misalignments between base maps that make it difficult to understand please contact DBYDEnterpriseEnquiries@sse.com or call 0345 070 7386



Indigo Pipelines Ltd.
 Registered Office:
 Loddon Reach,
 Reading Road,
 Arborfield,
 Reading,
 Berkshire, RG2 9HU

Scale: 1:500 (When plotted at A4)

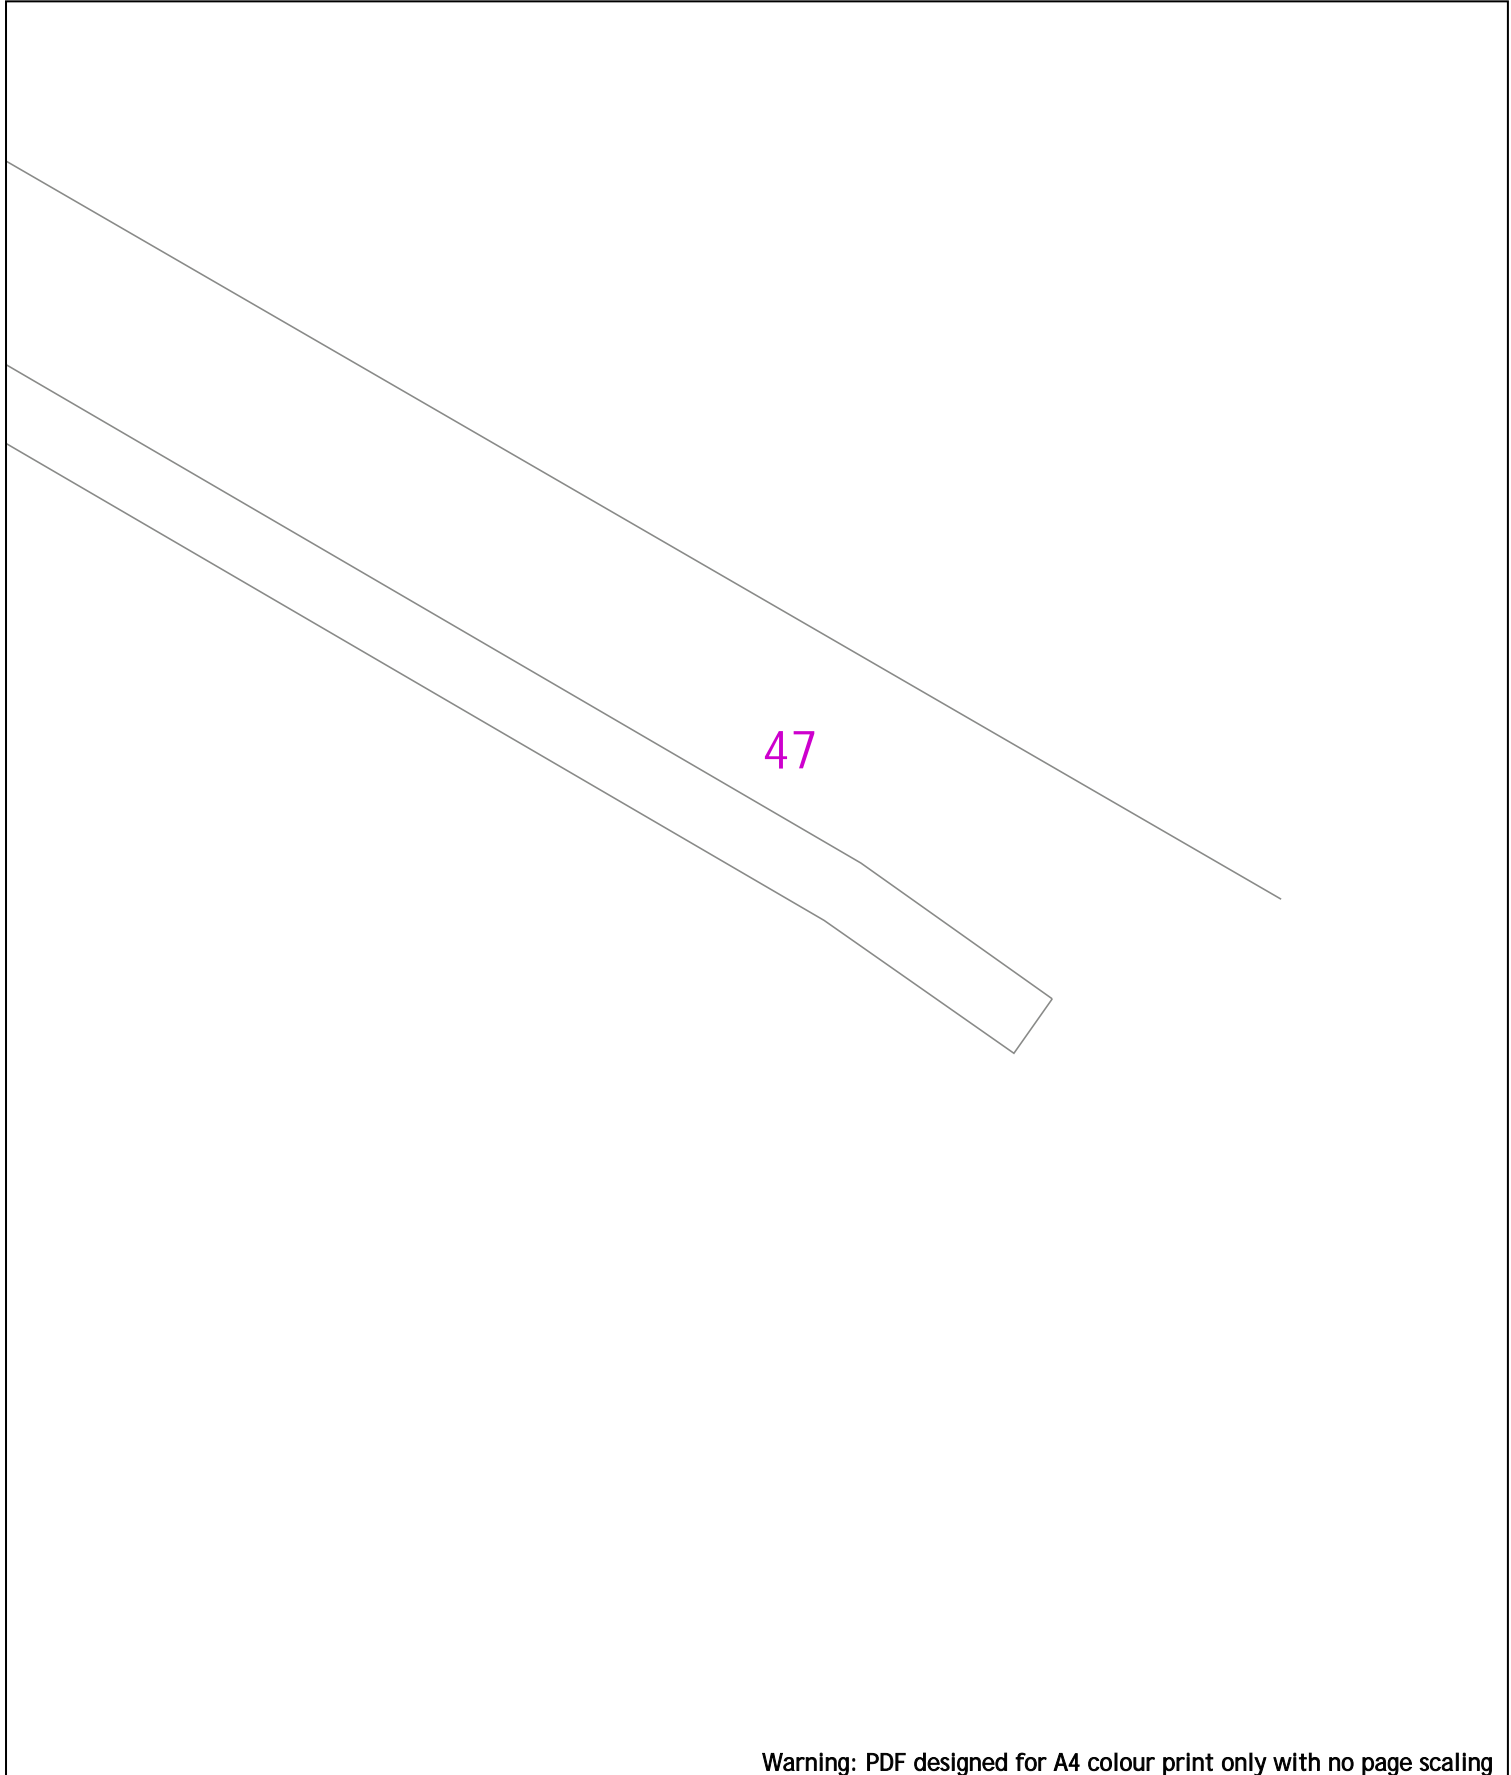

Warning: PDF designed for A4 colour print only with no page scaling

0 20m Dig Sites Area: Line:

LP Main	Valve Closed	Reducer
LP Service	Valve Open	Ducting
MP Main	CSEP	Gas Supply Point
MP Service	Pressure Reduction Station	
IP Main	End Closure	

IMPORTANT NOTICES

- This information is given as a guide only and its accuracy cannot be guaranteed
- The plan only shows pipes owned by SSE Utility Solutions Limited, Indigo Pipelines Limited
- Service pipes etc. may not be shown but their presence should be anticipated
- You must use safe digging practices in accordance with H5(G)47 to establish the actual position of mains, services and other apparatus before any mechanical excavation is used
- It is your responsibility to ensure this information is provided to all persons working near our plant
- If in doubt call the SSE Enterprise Dial Before You Dig team on 0345 070 7386.

Please note: If you have overlaps or misalignments between base maps that make it difficult to understand please contact DBYDEnterpriseEnquiries@sse.com or call 0345 070 7386

Date Requested: 24/06/2022
 Job Reference: 25881050
 Site Location: 448447 212278
 Requested by: Mr Joe Shawyer
 Your Scheme/Reference: 31188_004

Scale: 1:500 (When plotted at A4)
















Indigo Pipelines Ltd.
 Registered Office:
 Loddon Reach,
 Reading Road,
 Arborfield,
 Reading,
 Berkshire, RG2 9HU

Warning: PDF designed for A4 colour print only with no page scaling

0  20m Dig Sites Area:  Line: 

Date Requested: 24/06/2022
 Job Reference: 25881050
 Site Location: 448447 212278
 Requested by: Mr Joe Shawyer
 Your Scheme/Reference: 31188_004

 	LP Main		Valve Closed		Reducer
	LP Service		Valve Open		Ducting
	MP Main		CSEP		Gas Supply Point
	MP Service		Pressure Reduction Station		
	IP Main		End Closure		




Indigo Pipelines Ltd.
 Registered Office:
 Loddon Reach,
 Reading Road,
 Arborfield,
 Reading,
 Berkshire, RG2 9HU

IMPORTANT NOTICES


- This information is given as a guide only and its accuracy cannot be guaranteed
- The plan only shows pipes owned by SSE Utility Solutions Limited, Indigo Pipelines Limited
- Service pipes etc. may not be shown but their presence should be anticipated
- You must use safe digging practices in accordance with H5(G)47 to establish the actual position of mains, services and other apparatus before any mechanical excavation is used
- It is your responsibility to ensure this information is provided to all persons working near our plant
- If in doubt call the SSE Enterprise Dial Before You Dig team on 0345 070 7386.

Please note: If you have overlaps or misalignments between base maps that make it difficult to understand please contact DBYDEnterpriseEnquiries@sse.com or call 0345 070 7386



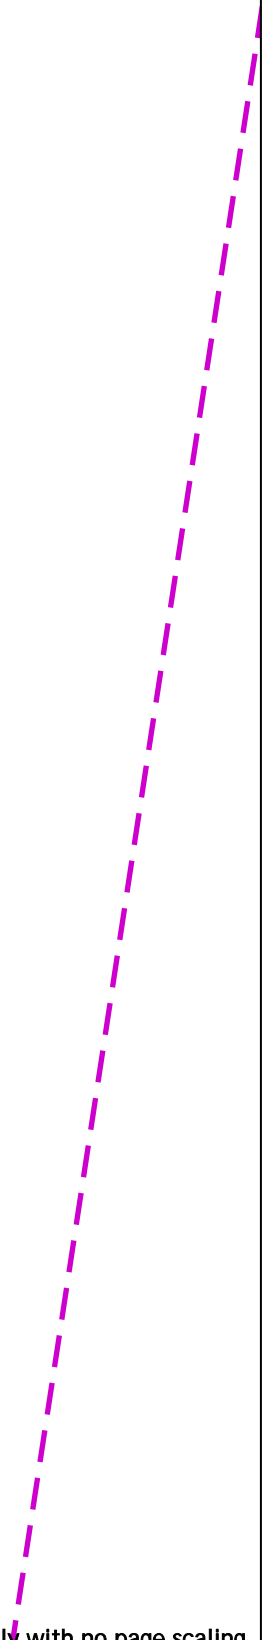










Scale: 1:500 (When plotted at A4)



Warning: PDF designed for A4 colour print only with no page scaling

0  20m Dig Sites Area:  Line: 

Date Requested: 24/06/2022
 Job Reference: 25881050
 Site Location: 448447 212278
 Requested by: Mr Joe Shawyer
 Your Scheme/Reference: 31188_004

 	LP Main		Valve Closed		Reducer
	LP Service		Valve Open		Ducting
	MP Main		CSEP		Gas Supply Point
	MP Service		Pressure Reduction Station		
	IP Main		End Closure		

IMPORTANT NOTICES

- This information is given as a guide only and its accuracy cannot be guaranteed
- The plan only shows pipes owned by SSE Utility Solutions Limited, Indigo Pipelines Limited
- Service pipes etc. may not be shown but their presence should be anticipated
- You must use safe digging practices in accordance with H5(G)47 to establish the actual position of mains, services and other apparatus before any mechanical excavation is used
- It is your responsibility to ensure this information is provided to all persons working near our plant
- If in doubt call the SSE Enterprise Dial Before You Dig team on 0345 070 7386.

Please note: If you have overlaps or misalignments between base maps that make it difficult to understand please contact DBYDEnterpriseEnquiries@sse.com or call 0345 070 7386















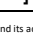
Indigo Pipelines Ltd.
 Registered Office:
 Loddon Reach,
 Reading Road,
 Arborfield,
 Reading,
 Berkshire, RG2 9HU

Scale: 1:500 (When plotted at A4)

Warning: PDF designed for A4 colour print only with no page scaling

0  20m Dig Sites Area:  Line: 

Date Requested: 24/06/2022
 Job Reference: 25881050
 Site Location: 448447 212278
 Requested by: Mr Joe Shawyer
 Your Scheme/Reference: 31188_004

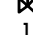	LP Main		Valve Closed		Reducer
	LP Service		Valve Open		Ducting
	MP Main		CSEP		Gas Supply Point
	MP Service		Pressure Reduction Station		
	IP Main		End Closure		

IMPORTANT NOTICES


- This information is given as a guide only and its accuracy cannot be guaranteed
- The plan only shows pipes owned by SSE Utility Solutions Limited, Indigo Pipelines Limited
- Service pipes etc. may not be shown but their presence should be anticipated
- You must use safe digging practices in accordance with H5(G)47 to establish the actual position of mains, services and other apparatus before any mechanical excavation is used
- It is your responsibility to ensure this information is provided to all persons working near our plant
- If in doubt call the SSE Enterprise Dial Before You Dig team on 0345 070 7386.

Please note: If you have overlaps or misalignments between base maps that make it difficult to understand please contact DBYDEnterpriseEnquiries@sse.com or call 0345 070 7386



Indigo Pipelines Ltd.
 Registered Office:
 Loddon Reach,
 Reading Road,
 Arborfield,
 Reading,
 Berkshire, RG2 9HU

Scale: 1:500 (When plotted at A4)

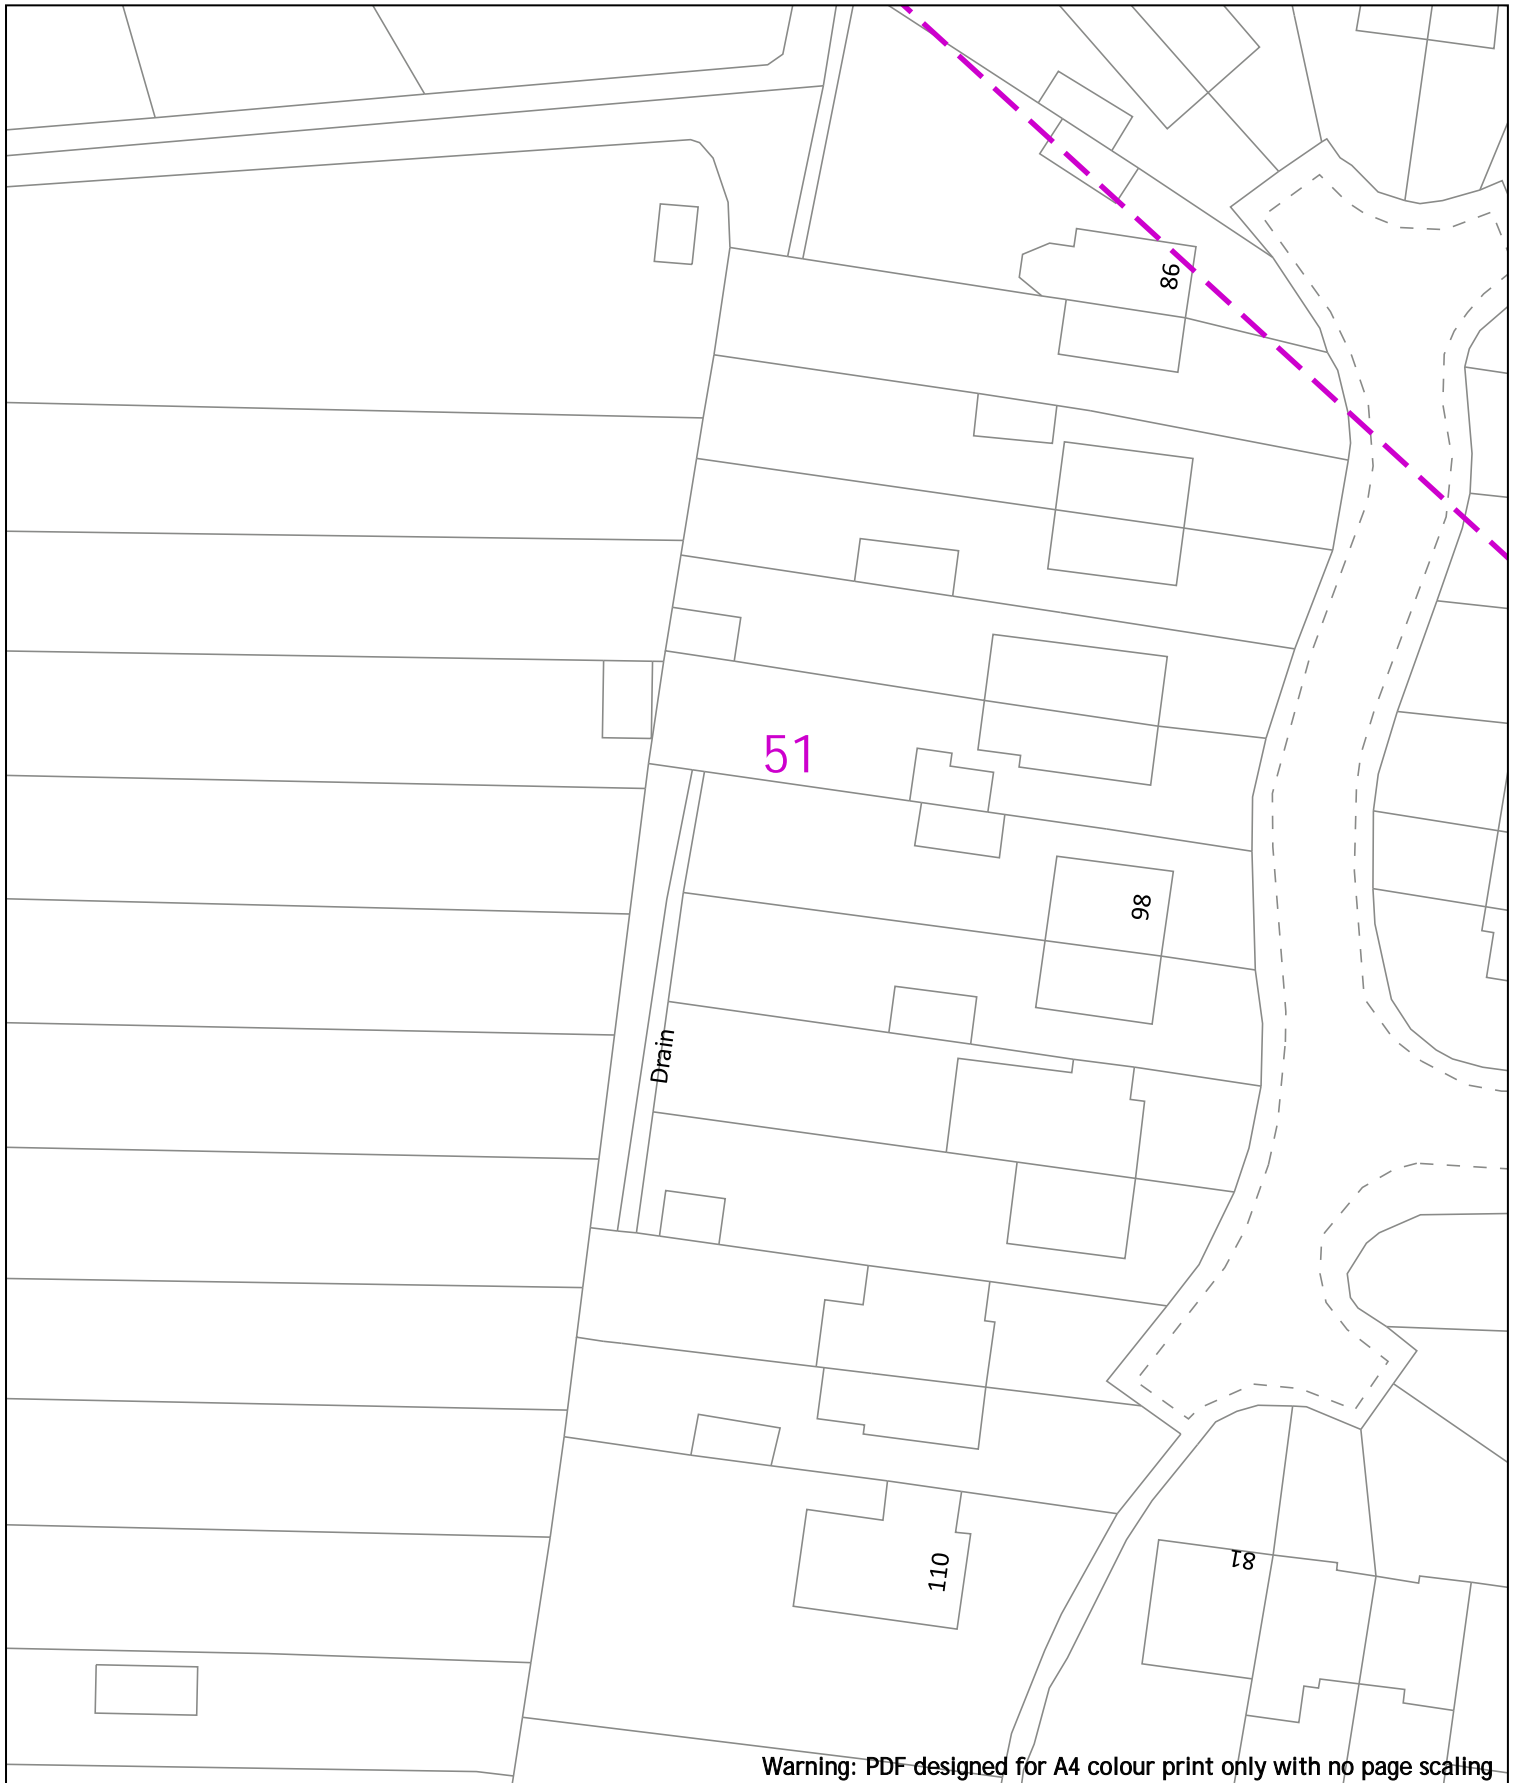

Warning: PDF designed for A4 colour print only with no page scaling

0 20m Dig Sites Area: Line:

LP Main	Valve Closed	Reducer
LP Service	Valve Open	Ducting
MP Main	CSEP	Gas Supply Point
MP Service	Pressure Reduction Station	
IP Main	End Closure	

IMPORTANT NOTICES

- This information is given as a guide only and its accuracy cannot be guaranteed
- The plan only shows pipes owned by SSE Utility Solutions Limited, Indigo Pipelines Limited
- Service pipes etc. may not be shown but their presence should be anticipated
- You must use safe digging practices in accordance with H5(G)47 to establish the actual position of mains, services and other apparatus before any mechanical excavation is used
- It is your responsibility to ensure this information is provided to all persons working near our plant
- If in doubt call the SSE Enterprise Dial Before You Dig team on 0345 070 7386.

Please note: If you have overlaps or misalignments between base maps that make it difficult to understand please contact DBYDEnterpriseEnquiries@sse.com or call 0345 070 7386

Date Requested: 24/06/2022
 Job Reference: 25881050
 Site Location: 448447 212278
 Requested by: Mr Joe Shawyer
 Your Scheme/Reference: 31188_004

Scale: 1:500 (When plotted at A4)

Indigo Pipelines Ltd.
 Registered Office:
 Loddon Reach,
 Reading Road,
 Arborfield,
 Reading,
 Berkshire, RG2 9HU



Warning: PDF designed for A4 colour print only with no page scaling

0 20m Dig Sites Area: Line:

LP Main	Valve Closed	Reducer
LP Service	Valve Open	Ducting
MP Main	CSEP	Gas Supply Point
MP Service	Pressure Reduction Station	
IP Main	End Closure	

IMPORTANT NOTICES


- This information is given as a guide only and its accuracy cannot be guaranteed
- The plan only shows pipes owned by SSE Utility Solutions Limited, Indigo Pipelines Limited
- Service pipes etc. may not be shown but their presence should be anticipated
- You must use safe digging practices in accordance with H5(G)47 to establish the actual position of mains, services and other apparatus before any mechanical excavation is used
- It is your responsibility to ensure this information is provided to all persons working near our plant
- If in doubt call the SSE Enterprise Dial Before You Dig team on 0345 070 7386.

Please note: If you have overlaps or misalignments between base maps that make it difficult to understand please contact DBYDEnterpriseEnquiries@sse.com or call 0345 070 7386

Date Requested: 24/06/2022
 Job Reference: 25881050
 Site Location: 448447 212278
 Requested by: Mr Joe Shawyer
 Your Scheme/Reference: 31188_004

Scale: 1:500 (When plotted at A4)

Indigo Pipelines Ltd.
 Registered Office:
 Loddon Reach,
 Reading Road,
 Arborfield,
 Reading,
 Berkshire, RG2 9HU

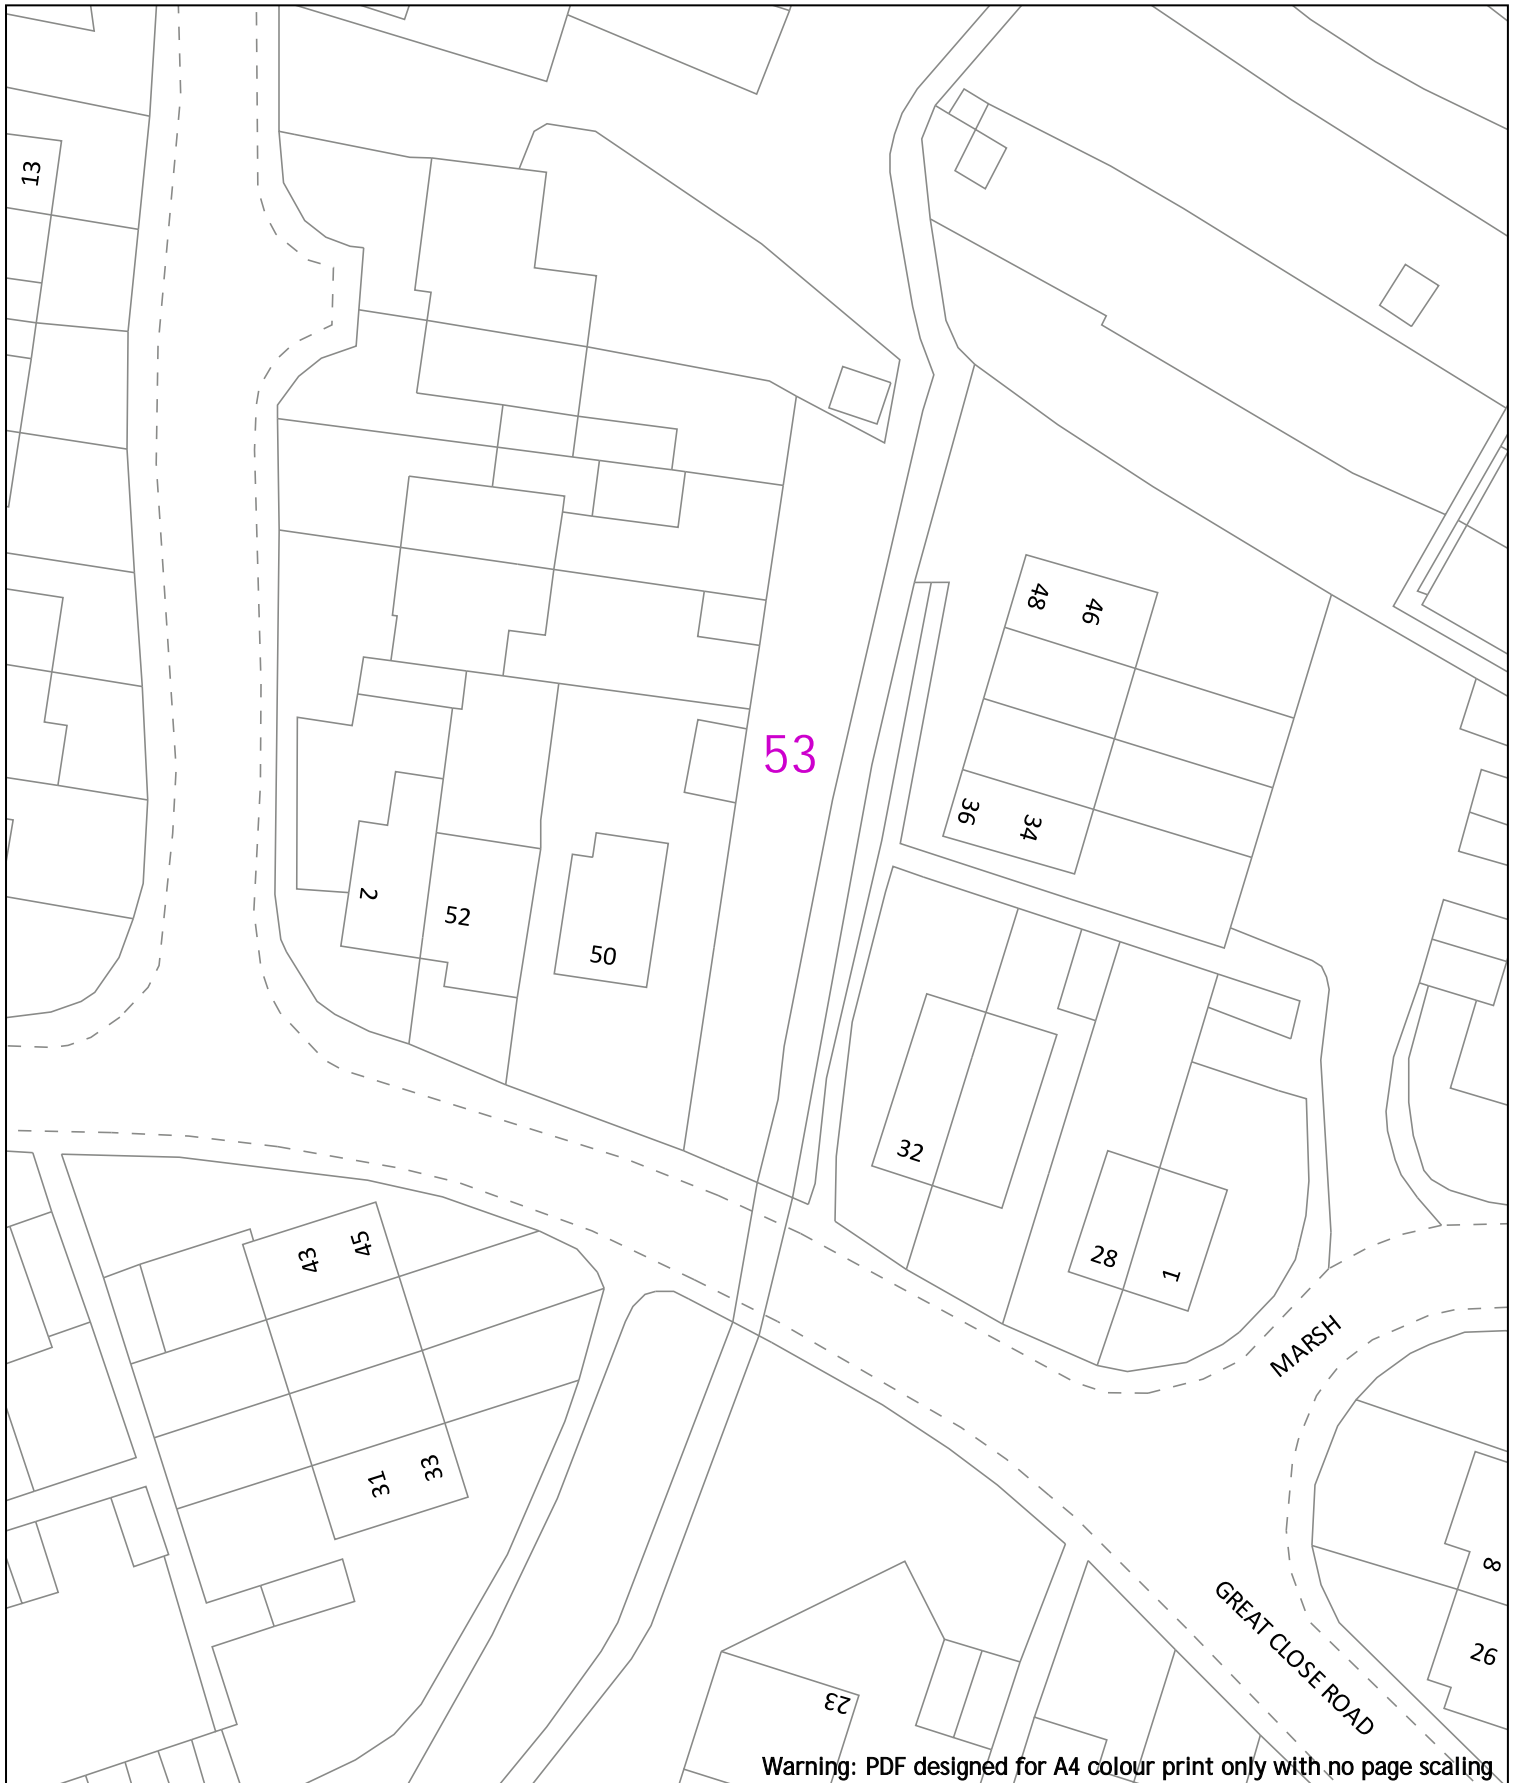

Warning: PDF designed for A4 colour print only with no page scaling

0 20m Dig Sites Area: Line:

Date Requested: 24/06/2022
 Job Reference: 25881050
 Site Location: 448447 212278
 Requested by: Mr Joe Shawyer
 Your Scheme/Reference: 31188_004

	LP Main		Valve Closed		Reducer
	LP Service		Valve Open		Ducting
	MP Main		CSEP		Gas Supply Point
	MP Service		Pressure Reduction Station		
	IP Main		End Closure		




Indigo Pipelines Ltd.
 Registered Office:
 Loddon Reach,
 Reading Road,
 Arborfield,
 Reading,
 Berkshire, RG2 9HU

IMPORTANT NOTICES

- This information is given as a guide only and its accuracy cannot be guaranteed
- The plan only shows pipes owned by SSE Utility Solutions Limited, Indigo Pipelines Limited
- Service pipes etc. may not be shown but their presence should be anticipated
- You must use safe digging practices in accordance with H5(G)47 to establish the actual position of mains, services and other apparatus before any mechanical excavation is used
- It is your responsibility to ensure this information is provided to all persons working near our plant
- If in doubt call the SSE Enterprise Dial Before You Dig team on 0345 070 7386.

Please note: If you have overlaps or misalignments between base maps that make it difficult to understand please contact DBYDEnterpriseEnquiries@sse.com or call 0345 070 7386

Scale: 1:500 (When plotted at A4)

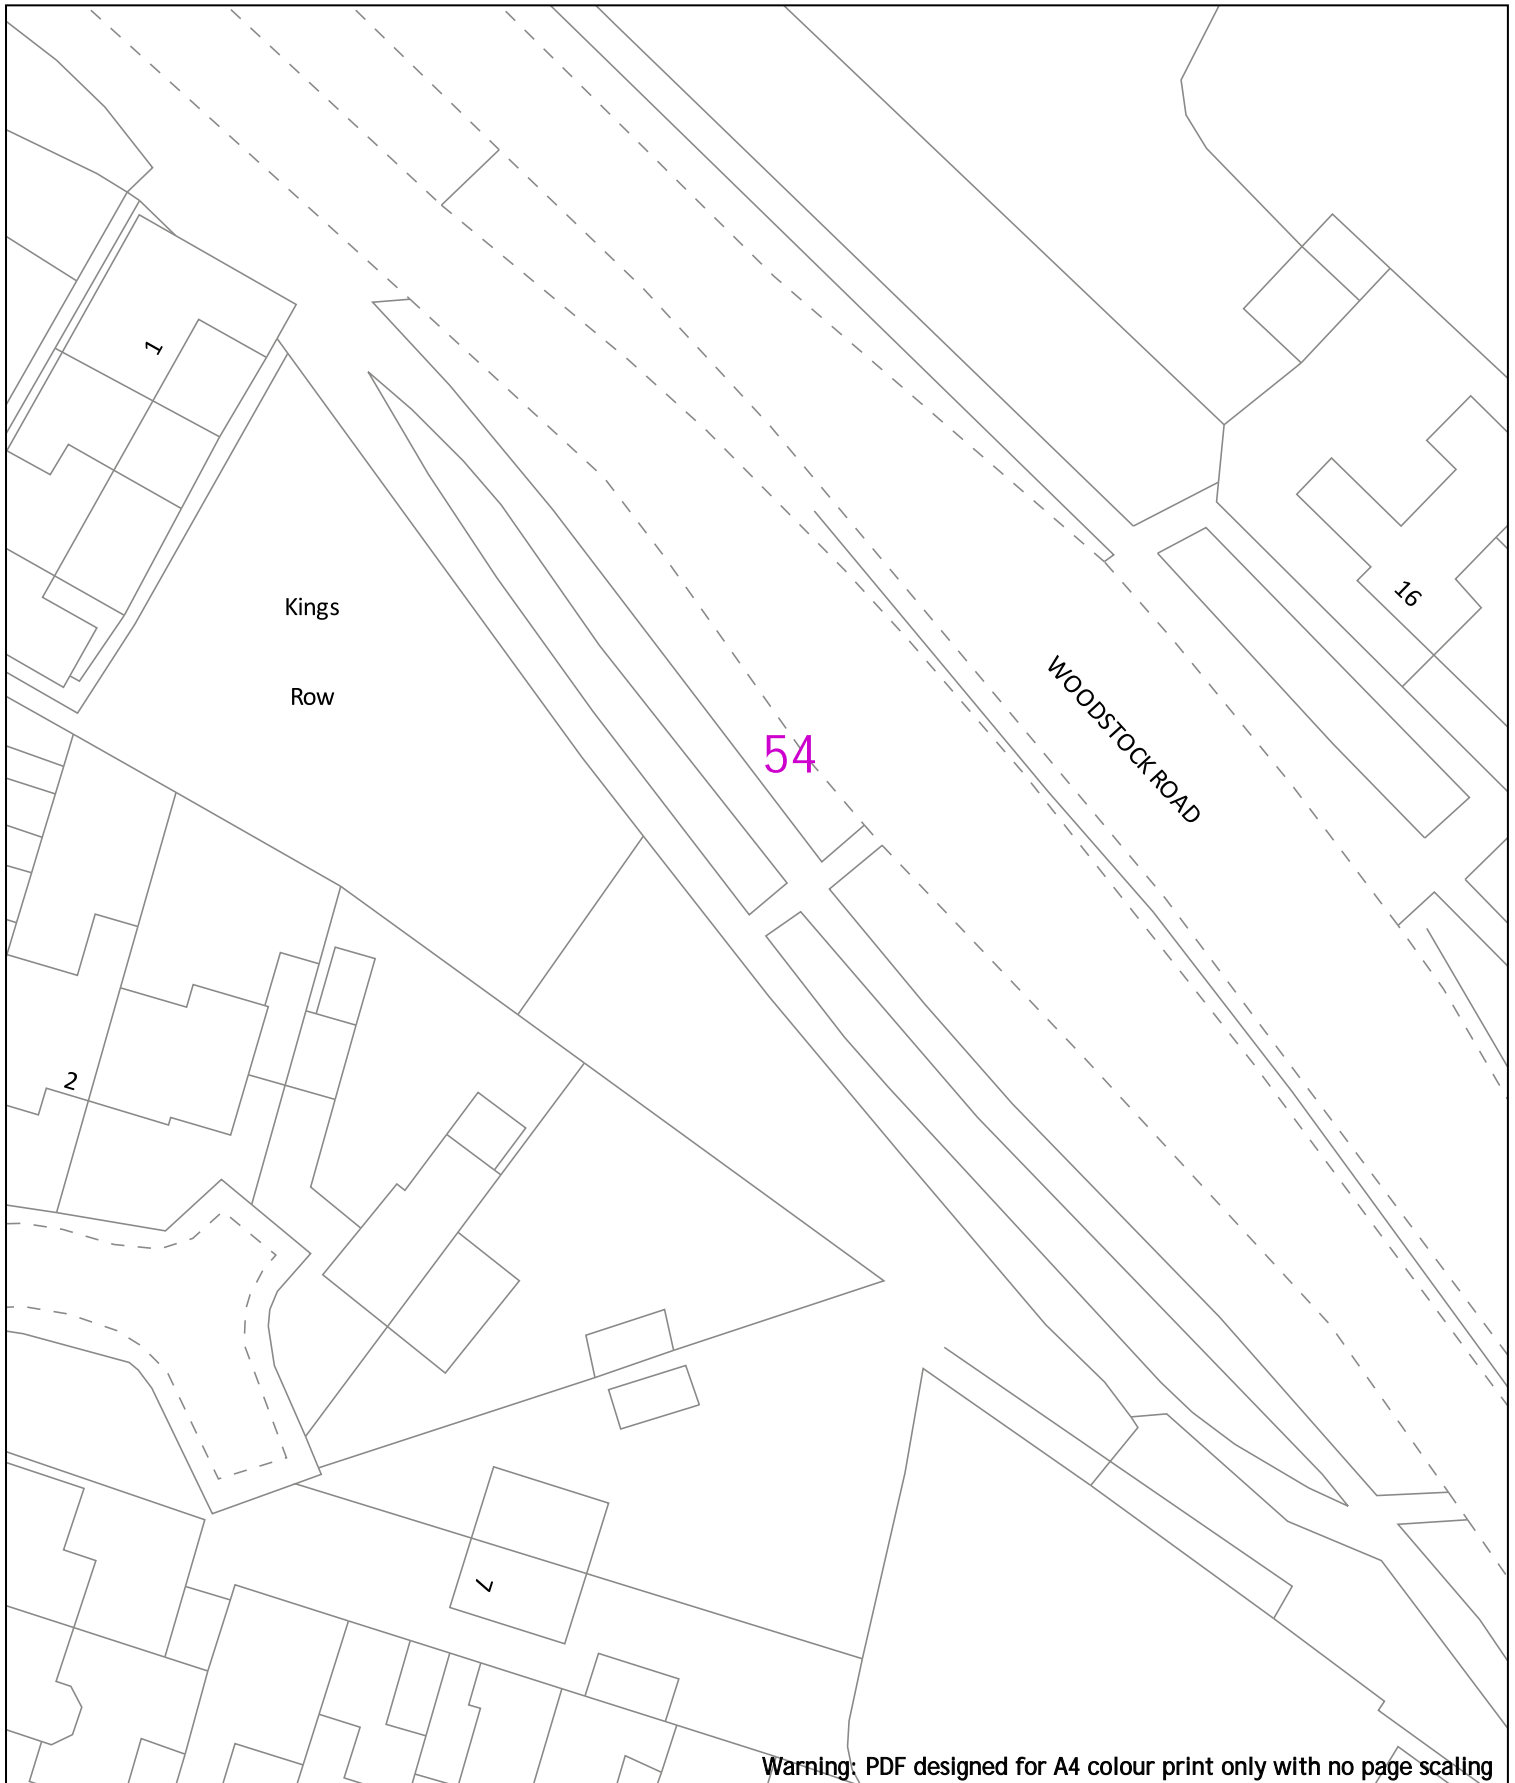

Warning: PDF designed for A4 colour print only with no page scaling

0 20m Dig Sites Area: Line:

LP Main	Valve Closed	Reducer
LP Service	Valve Open	Ducting
MP Main	CSEP	Gas Supply Point
MP Service	Pressure Reduction Station	
IP Main	End Closure	

IMPORTANT NOTICES

- This information is given as a guide only and its accuracy cannot be guaranteed
- The plan only shows pipes owned by SSE Utility Solutions Limited, Indigo Pipelines Limited
- Service pipes etc. may not be shown but their presence should be anticipated
- You must use safe digging practices in accordance with H5(G)47 to establish the actual position of mains, services and other apparatus before any mechanical excavation is used
- It is your responsibility to ensure this information is provided to all persons working near our plant
- If in doubt call the SSE Enterprise Dial Before You Dig team on 0345 070 7386.

Please note: If you have overlaps or misalignments between base maps that make it difficult to understand please contact DBYDEnterpriseEnquiries@sse.com or call 0345 070 7386

Date Requested: 24/06/2022
 Job Reference: 25881050
 Site Location: 448447 212278
 Requested by: Mr Joe Shawyer
 Your Scheme/Reference: 31188_004



Scale: 1:500 (When plotted at A4)
















Indigo Pipelines Ltd.
 Registered Office:
 Loddon Reach,
 Reading Road,
 Arborfield,
 Reading,
 Berkshire, RG2 9HU

55

Warning: PDF designed for A4 colour print only with no page scaling

0  20m Dig Sites Area:  Line: 

Date Requested: 24/06/2022
Job Reference: 25881050
Site Location: 448447 212278
Requested by: Mr Joe Shawyer
Your Scheme/Reference: 31188_004

 	LP Main		Valve Closed		Reducer
	LP Service		Valve Open		Ducting
	MP Main		CSEP		Gas Supply Point
	MP Service		Pressure Reduction Station		
	IP Main		End Closure		

IMPORTANT NOTICES


- This information is given as a guide only and its accuracy cannot be guaranteed
- The plan only shows pipes owned by SSE Utility Solutions Limited, Indigo Pipelines Limited
- Service pipes etc. may not be shown but their presence should be anticipated
- You must use safe digging practices in accordance with H5(G)47 to establish the actual position of mains, services and other apparatus before any mechanical excavation is used
- It is your responsibility to ensure this information is provided to all persons working near our plant
- If in doubt call the SSE Enterprise Dial Before You Dig team on 0345 070 7386.

Please note: If you have overlaps or misalignments between base maps that make it difficult to understand please contact DBYDEnterpriseEnquiries@sse.com or call 0345 070 7386



Indigo Pipelines Ltd.
Registered Office:
Loddon Reach,
Reading Road,
Arborfield,
Reading,
Berkshire, RG2 9HU

Scale: 1:500 (When plotted at A4)

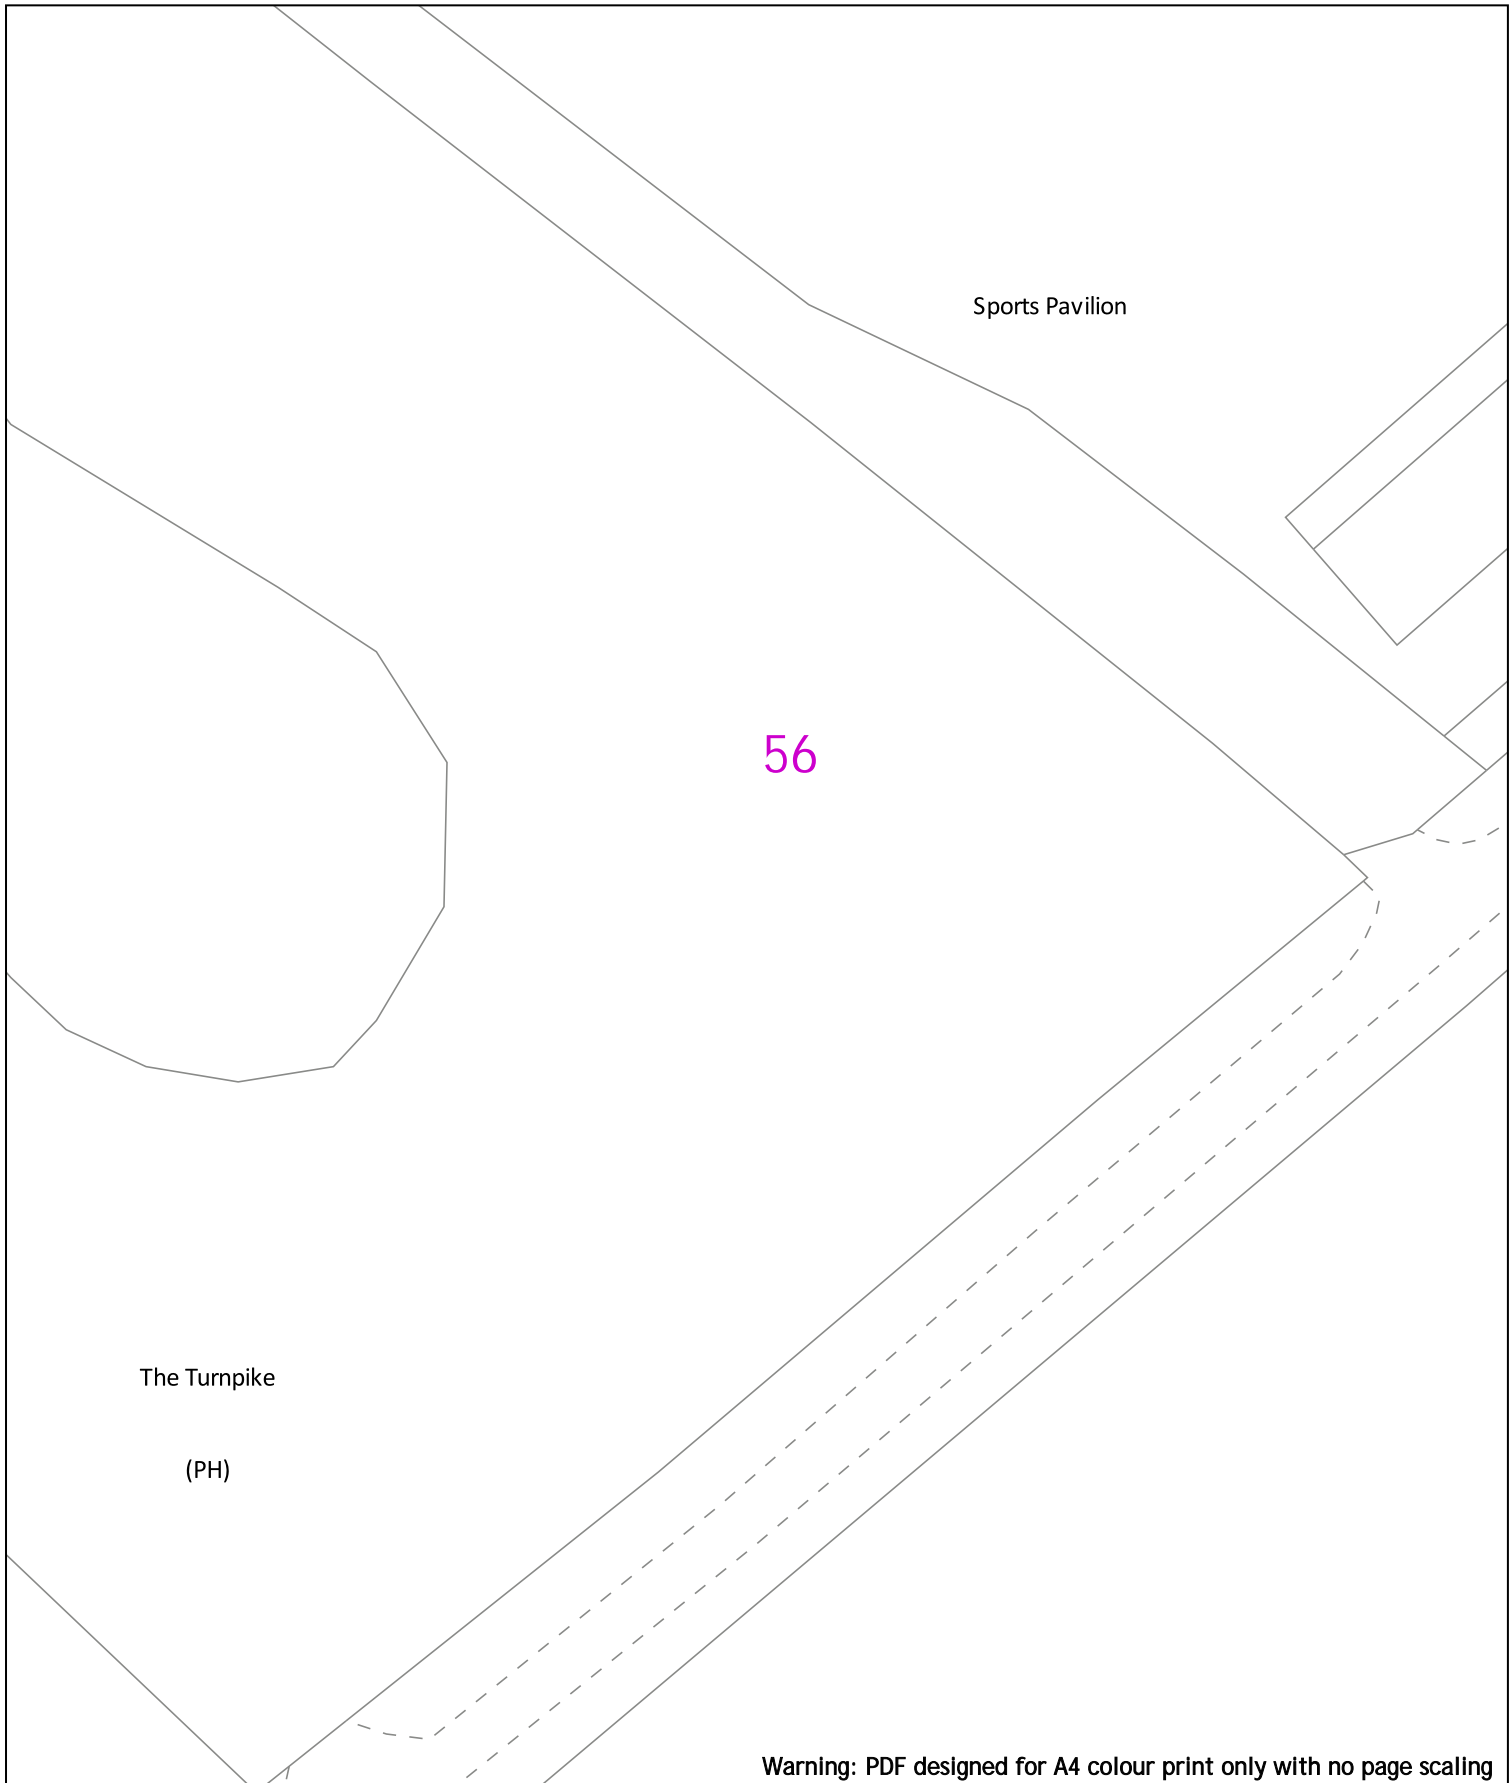

Warning: PDF designed for A4 colour print only with no page scaling

0 20m Dig Sites Area: Line:

LP Main	Valve Closed	Reducer
LP Service	Valve Open	Ducting
MP Main	CSEP	Gas Supply Point
MP Service	Pressure Reduction Station	
IP Main	End Closure	

IMPORTANT NOTICES


- This information is given as a guide only and its accuracy cannot be guaranteed
- The plan only shows pipes owned by SSE Utility Solutions Limited, Indigo Pipelines Limited
- Service pipes etc. may not be shown but their presence should be anticipated
- You must use safe digging practices in accordance with H5(G)47 to establish the actual position of mains, services and other apparatus before any mechanical excavation is used
- It is your responsibility to ensure this information is provided to all persons working near our plant
- If in doubt call the SSE Enterprise Dial Before You Dig team on 0345 070 7386.

Please note: If you have overlaps or misalignments between base maps that make it difficult to understand please contact DBYDEnterpriseEnquiries@sse.com or call 0345 070 7386

Date Requested: 24/06/2022
 Job Reference: 25881050
 Site Location: 448447 212278
 Requested by: Mr Joe Shawyer
 Your Scheme/Reference: 31188_004

Scale: 1:500 (When plotted at A4)

Indigo Pipelines Ltd.
 Registered Office:
 Loddon Reach,
 Reading Road,
 Arborfield,
 Reading,
 Berkshire, RG2 9HU

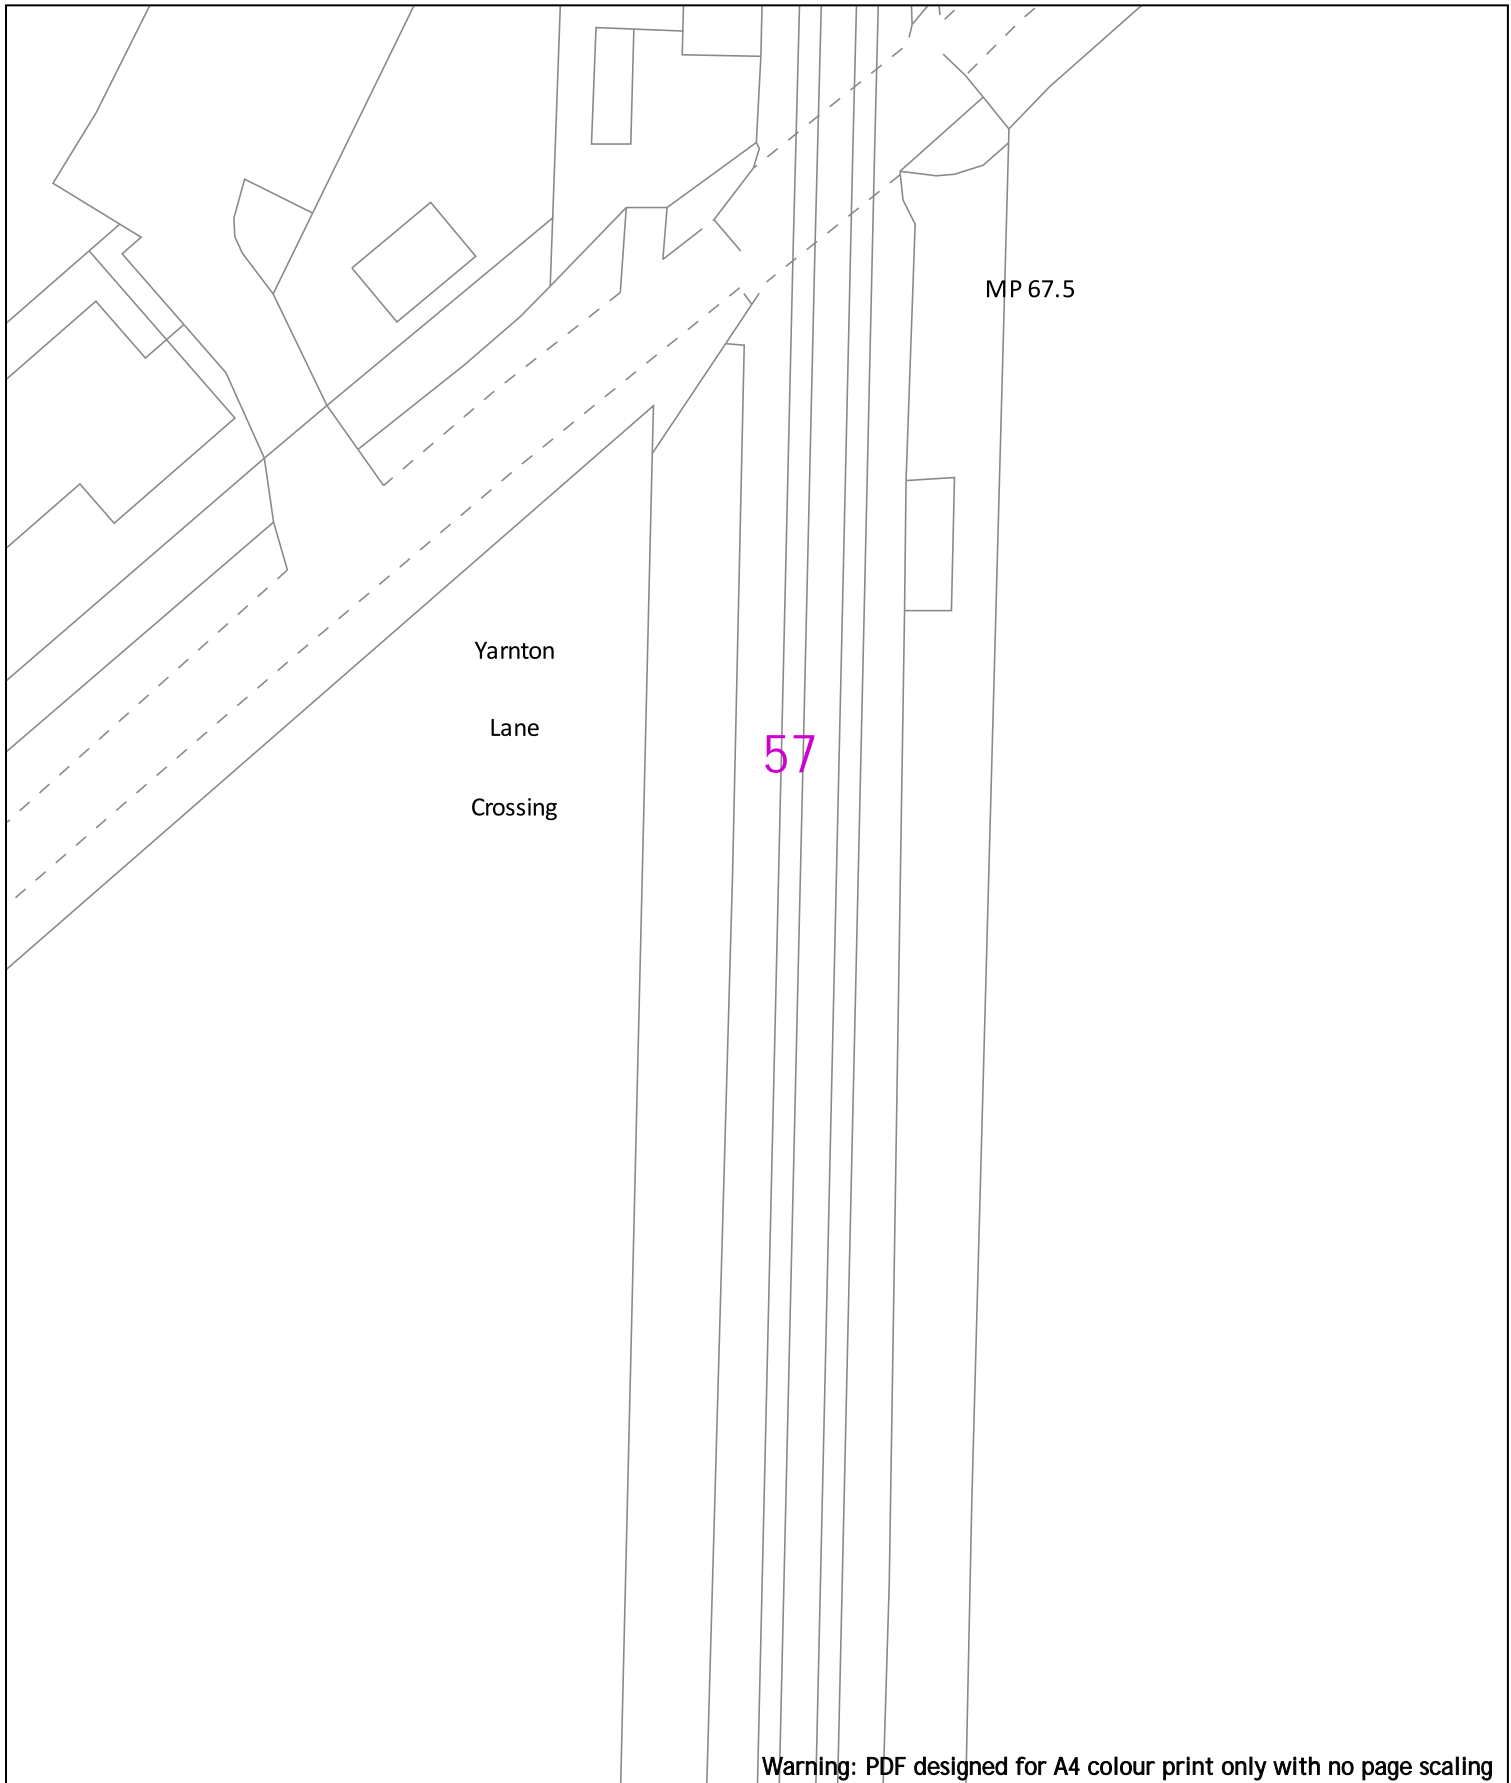

Warning: PDF designed for A4 colour print only with no page scaling

0 20m Dig Sites Area: Line:

LP Main	Valve Closed	Reducer
LP Service	Valve Open	Ducting
MP Main	CSEP	Gas Supply Point
MP Service	Pressure Reduction Station	
IP Main	End Closure	

IMPORTANT NOTICES

- This information is given as a guide only and its accuracy cannot be guaranteed
- The plan only shows pipes owned by SSE Utility Solutions Limited, Indigo Pipelines Limited
- Service pipes etc. may not be shown but their presence should be anticipated
- You must use safe digging practices in accordance with H5(G)47 to establish the actual position of mains, services and other apparatus before any mechanical excavation is used
- It is your responsibility to ensure this information is provided to all persons working near our plant
- If in doubt call the SSE Enterprise Dial Before You Dig team on 0345 070 7386.


Please note: If you have overlaps or misalignments between base maps that make it difficult to understand please contact DBYDEnterpriseEnquiries@sse.com or call 0345 070 7386

Date Requested: 24/06/2022
 Job Reference: 25881050
 Site Location: 448447 212278
 Requested by: Mr Joe Shawyer
 Your Scheme/Reference: 31188_004














Scale: 1:500 (When plotted at A4)

Indigo Pipelines Ltd.
 Registered Office:
 Loddon Reach,
 Reading Road,
 Arborfield,
 Reading,
 Berkshire, RG2 9HU

Warning: PDF designed for A4 colour print only with no page scaling

0  20m Dig Sites Area:  Line: 

Date Requested: 24/06/2022
 Job Reference: 25881050
 Site Location: 448447 212278
 Requested by: Mr Joe Shawyer
 Your Scheme/Reference: 31188_004

 	LP Main		Valve Closed		Reducer
	LP Service		Valve Open		Ducting
	MP Main		CSEP		Gas Supply Point
	MP Service		Pressure Reduction Station		
	IP Main		End Closure		

IMPORTANT NOTICES

- This information is given as a guide only and its accuracy cannot be guaranteed
- The plan only shows pipes owned by SSE Utility Solutions Limited, Indigo Pipelines Limited
- Service pipes etc. may not be shown but their presence should be anticipated
- You must use safe digging practices in accordance with H5(G)47 to establish the actual position of mains, services and other apparatus before any mechanical excavation is used
- It is your responsibility to ensure this information is provided to all persons working near our plant
- If in doubt call the SSE Enterprise Dial Before You Dig team on 0345 070 7386.

Please note: If you have overlaps or misalignments between base maps that make it difficult to understand please contact DBYDEnterpriseEnquiries@sse.com or call 0345 070 7386




Indigo Pipelines Ltd.
 Registered Office:
 Loddon Reach,
 Reading Road,
 Arborfield,
 Reading,
 Berkshire, RG2 9HU














Scale: 1:500 (When plotted at A4)

59

Warning: PDF designed for A4 colour print only with no page scaling

0  20m Dig Sites Area:  Line: 

Date Requested: 24/06/2022
Job Reference: 25881050
Site Location: 448447 212278
Requested by: Mr Joe Shawyer
Your Scheme/Reference: 31188_004

  LP Main	 Valve Closed	 Reducer
 LP Service	 Valve Open	 Ducting
 MP Main	 CSEP	 Gas Supply Point
 MP Service	 Pressure Reduction Station	
 IP Main	 End Closure	

IMPORTANT NOTICES

- This information is given as a guide only and its accuracy cannot be guaranteed
- The plan only shows pipes owned by SSE Utility Solutions Limited, Indigo Pipelines Limited
- Service pipes etc. may not be shown but their presence should be anticipated
- You must use safe digging practices in accordance with H5(G)47 to establish the actual position of mains, services and other apparatus before any mechanical excavation is used
- It is your responsibility to ensure this information is provided to all persons working near our plant
- If in doubt call the SSE Enterprise Dial Before You Dig team on 0345 070 7386.

Please note: If you have overlaps or misalignments between base maps that make it difficult to understand please contact DBYDEnterpriseEnquiries@sse.com or call 0345 070 7386




Indigo Pipelines Ltd.
Registered Office:
Loddon Reach,
Reading Road,
Arborfield,
Reading,
Berkshire, RG2 9HU














Scale: 1:500 (When plotted at A4)

60

Warning: PDF designed for A4 colour print only with no page scaling

0  20m Dig Sites Area:  Line: 

Date Requested: 24/06/2022
Job Reference: 25881050
Site Location: 448447 212278
Requested by: Mr Joe Shawyer
Your Scheme/Reference: 31188_004

  LP Main	 Valve Closed	 Reducer
 LP Service	 Valve Open	 Ducting
 MP Main	 CSEP	 Gas Supply Point
 MP Service	 Pressure Reduction Station	
 IP Main	 End Closure	

IMPORTANT NOTICES


- This information is given as a guide only and its accuracy cannot be guaranteed
- The plan only shows pipes owned by SSE Utility Solutions Limited, Indigo Pipelines Limited
- Service pipes etc. may not be shown but their presence should be anticipated
- You must use safe digging practices in accordance with H5(G)47 to establish the actual position of mains, services and other apparatus before any mechanical excavation is used
- It is your responsibility to ensure this information is provided to all persons working near our plant
- If in doubt call the SSE Enterprise Dial Before You Dig team on 0345 070 7386.

Please note: If you have overlaps or misalignments between base maps that make it difficult to understand please contact DBYDEnterpriseEnquiries@sse.com or call 0345 070 7386



Indigo Pipelines Ltd.
Registered Office:
Loddon Reach,
Reading Road,
Arborfield,
Reading,
Berkshire, RG2 9HU

Scale: 1:500 (When plotted at A4)

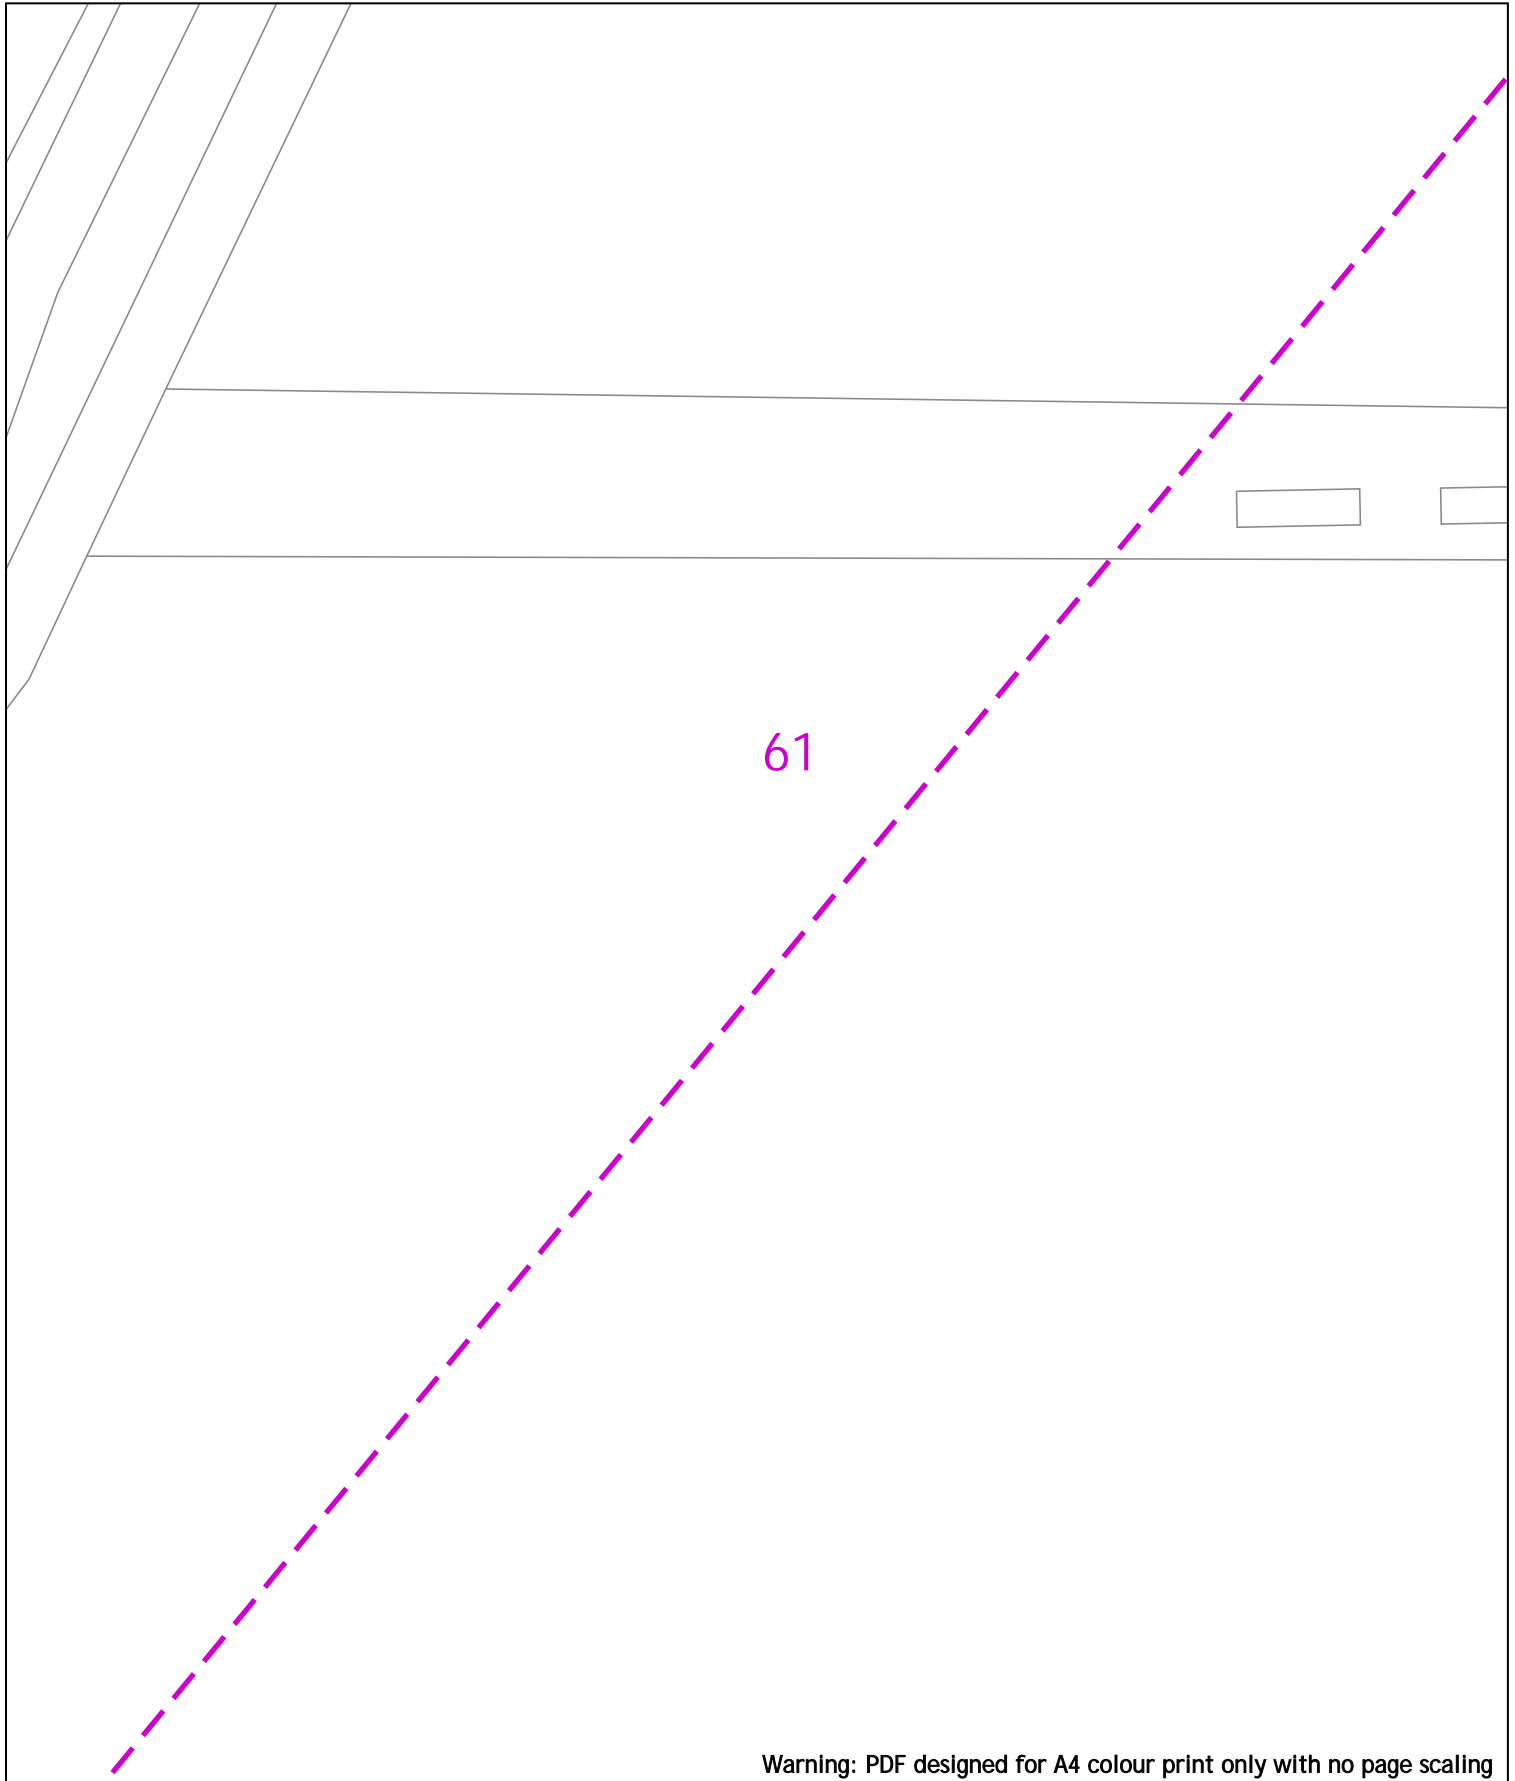

Warning: PDF designed for A4 colour print only with no page scaling

0 20m Dig Sites Area: Line:

LP Main	Valve Closed	Reducer
LP Service	Valve Open	Ducting
MP Main	CSEP	Gas Supply Point
MP Service	Pressure Reduction Station	
IP Main	End Closure	

IMPORTANT NOTICES

- This information is given as a guide only and its accuracy cannot be guaranteed
- The plan only shows pipes owned by SSE Utility Solutions Limited, Indigo Pipelines Limited
- Service pipes etc. may not be shown but their presence should be anticipated
- You must use safe digging practices in accordance with H5(G)47 to establish the actual position of mains, services and other apparatus before any mechanical excavation is used
- It is your responsibility to ensure this information is provided to all persons working near our plant
- If in doubt call the SSE Enterprise Dial Before You Dig team on 0345 070 7386.

Please note: If you have overlaps or misalignments between base maps that make it difficult to understand please contact DBYDEnterpriseEnquiries@sse.com or call 0345 070 7386



Date Requested: 24/06/2022
 Job Reference: 25881050
 Site Location: 448447 212278
 Requested by: Mr Joe Shawyer
 Your Scheme/Reference: 31188_004

Scale: 1:500 (When plotted at A4)














Indigo Pipelines Ltd.
 Registered Office:
 Loddon Reach,
 Reading Road,
 Arborfield,
 Reading,
 Berkshire, RG2 9HU

62

Warning: PDF designed for A4 colour print only with no page scaling

0  20m Dig Sites Area:  Line: 

Date Requested: 24/06/2022
Job Reference: 25881050
Site Location: 448447 212278
Requested by: Mr Joe Shawyer
Your Scheme/Reference: 31188_004

  LP Main	 Valve Closed	 Reducer
 LP Service	 Valve Open	 Ducting
 MP Main	 CSEP	 Gas Supply Point
 MP Service	 Pressure Reduction Station	
 IP Main	 End Closure	

IMPORTANT NOTICES


- This information is given as a guide only and its accuracy cannot be guaranteed
- The plan only shows pipes owned by SSE Utility Solutions Limited, Indigo Pipelines Limited
- Service pipes etc. may not be shown but their presence should be anticipated
- You must use safe digging practices in accordance with H5(G)47 to establish the actual position of mains, services and other apparatus before any mechanical excavation is used
- It is your responsibility to ensure this information is provided to all persons working near our plant
- If in doubt call the SSE Enterprise Dial Before You Dig team on 0345 070 7386.

Please note: If you have overlaps or misalignments between base maps that make it difficult to understand please contact DBYDEnterpriseEnquiries@sse.com or call 0345 070 7386



Indigo Pipelines Ltd.
Registered Office:
Loddon Reach,
Reading Road,
Arborfield,
Reading,
Berkshire, RG2 9HU

Scale: 1:500 (When plotted at A4)

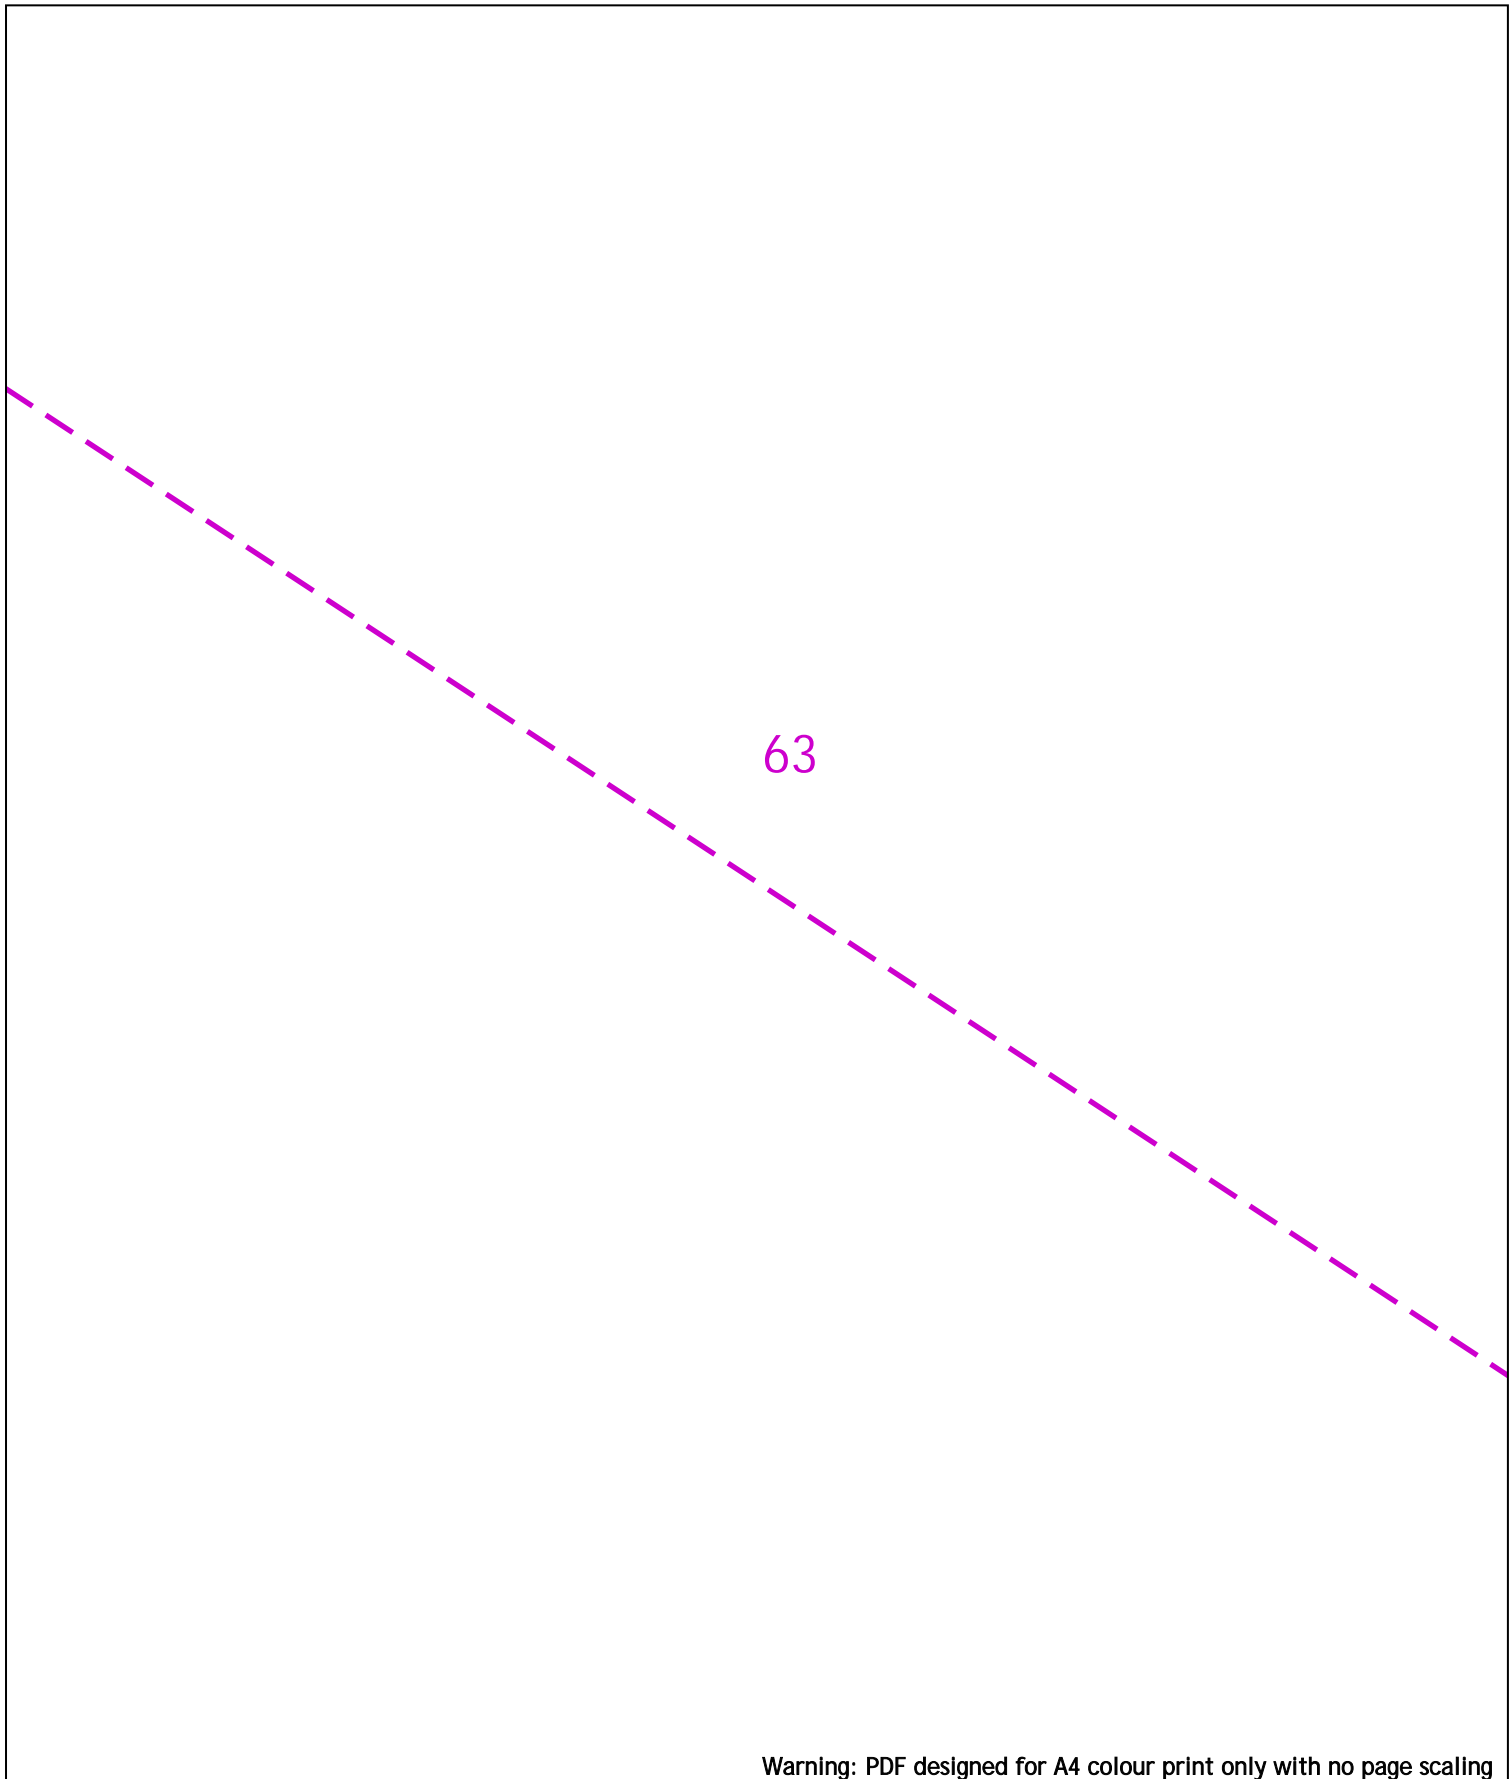

Warning: PDF designed for A4 colour print only with no page scaling

0 20m Dig Sites Area: Line:

LP Main	Valve Closed	Reducer
LP Service	Valve Open	Ducting
MP Main	CSEP	Gas Supply Point
MP Service	Pressure Reduction Station	
IP Main	End Closure	

IMPORTANT NOTICES

- This information is given as a guide only and its accuracy cannot be guaranteed
- The plan only shows pipes owned by SSE Utility Solutions Limited, Indigo Pipelines Limited
- Service pipes etc. may not be shown but their presence should be anticipated
- You must use safe digging practices in accordance with H5(G)47 to establish the actual position of mains, services and other apparatus before any mechanical excavation is used
- It is your responsibility to ensure this information is provided to all persons working near our plant
- If in doubt call the SSE Enterprise Dial Before You Dig team on 0345 070 7386.


Please note: If you have overlaps or misalignments between base maps that make it difficult to understand please contact DBYDEnterpriseEnquiries@sse.com or call 0345 070 7386

Date Requested: 24/06/2022
 Job Reference: 25881050
 Site Location: 448447 212278
 Requested by: Mr Joe Shawyer
 Your Scheme/Reference: 31188_004







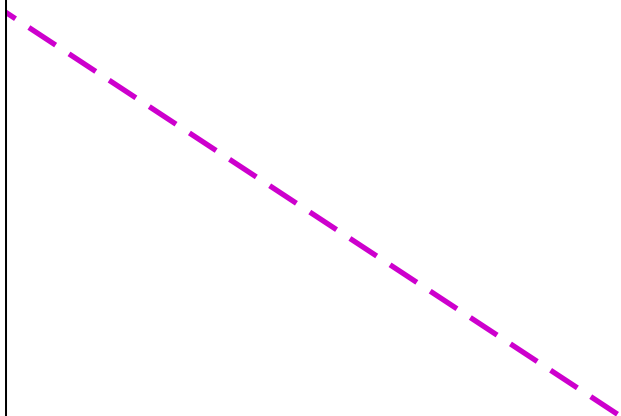

















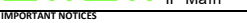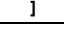


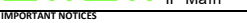
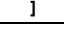











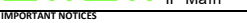
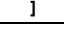
Scale: 1:500 (When plotted at A4)



Indigo Pipelines Ltd.
 Registered Office:
 Loddon Reach,
 Reading Road,
 Arborfield,
 Reading,
 Berkshire, RG2 9HU




Warning: PDF designed for A4 colour print only with no page scaling

<p>0  20m Dig Sites Area:  Line: </p>	<table border="0"> <tr> <td> LP Main</td> <td> Valve Closed</td> <td> Reducer</td> </tr> <tr> <td> LP Service</td> <td> Valve Open</td> <td> Ducting</td> </tr> <tr> <td> MP Main</td> <td> CSEP</td> <td> Gas Supply Point</td> </tr> <tr> <td> MP Service</td> <td> Pressure Reduction Station</td> <td></td> </tr> <tr> <td> IP Main</td> <td> End Closure</td> <td></td> </tr> </table> <p>IMPORTANT NOTICES</p> <ul style="list-style-type: none"> This information is given as a guide only and its accuracy cannot be guaranteed The plan only shows pipes owned by SSE Utility Solutions Limited, Indigo Pipelines Limited Service pipes etc. may not be shown but their presence should be anticipated You must use safe digging practices in accordance with H5(G)47 to establish the actual position of mains, services and other apparatus before any mechanical excavation is used It is your responsibility to ensure this information is provided to all persons working near our plant If in doubt call the SSE Enterprise Dial Before You Dig team on 0345 070 7386. <p>Please note: If you have overlaps or misalignments between base maps that make it difficult to understand please contact DBYDEnterpriseEnquiries@sse.com or call 0345 070 7386</p>	 LP Main	 Valve Closed	 Reducer	 LP Service	 Valve Open	 Ducting	 MP Main	 CSEP	 Gas Supply Point	 MP Service	 Pressure Reduction Station		 IP Main	 End Closure	
 LP Main	 Valve Closed	 Reducer														
 LP Service	 Valve Open	 Ducting														
 MP Main	 CSEP	 Gas Supply Point														
 MP Service	 Pressure Reduction Station															
 IP Main	 End Closure															



Indigo Pipelines Ltd.
 Registered Office:
 Loddon Reach,
 Reading Road,
 Arborfield,
 Reading,
 Berkshire, RG2 9HU



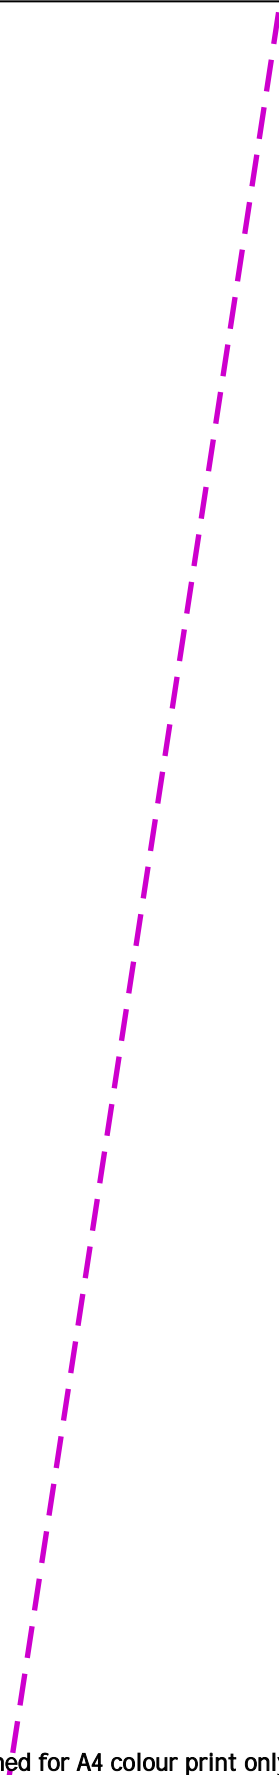










65



Warning: PDF designed for A4 colour print only with no page scaling

0  20m Dig Sites Area:  Line: 

Date Requested: 24/06/2022
Job Reference: 25881050
Site Location: 448447 212278
Requested by: Mr Joe Shawyer
Your Scheme/Reference: 31188_004

 	LP Main		Valve Closed		Reducer
	LP Service		Valve Open		Ducting
	MP Main		CSEP		Gas Supply Point
	MP Service		Pressure Reduction Station		
	IP Main		End Closure		

IMPORTANT NOTICES

- This information is given as a guide only and its accuracy cannot be guaranteed
- The plan only shows pipes owned by SSE Utility Solutions Limited, Indigo Pipelines Limited
- Service pipes etc. may not be shown but their presence should be anticipated
- You must use safe digging practices in accordance with H5(G)47 to establish the actual position of mains, services and other apparatus before any mechanical excavation is used
- It is your responsibility to ensure this information is provided to all persons working near our plant
- If in doubt call the SSE Enterprise Dial Before You Dig team on 0345 070 7386.

Please note: If you have overlaps or misalignments between base maps that make it difficult to understand please contact DBYDEnterpriseEnquiries@sse.com or call 0345 070 7386



Indigo Pipelines Ltd.
Registered Office:
Loddon Reach,
Reading Road,
Arborfield,
Reading,
Berkshire, RG2 9HU

Scale: 1:500 (When plotted at A4)



Warning: PDF designed for A4 colour print only with no page scaling

0 20m Dig Sites Area: Line:

LP Main	Valve Closed	Reducer
LP Service	Valve Open	Ducting
MP Main	CSEP	Gas Supply Point
MP Service	Pressure Reduction Station	
IP Main	End Closure	

IMPORTANT NOTICES


- This information is given as a guide only and its accuracy cannot be guaranteed
- The plan only shows pipes owned by SSE Utility Solutions Limited, Indigo Pipelines Limited
- Service pipes etc. may not be shown but their presence should be anticipated
- You must use safe digging practices in accordance with H5(G)47 to establish the actual position of mains, services and other apparatus before any mechanical excavation is used
- It is your responsibility to ensure this information is provided to all persons working near our plant
- If in doubt call the SSE Enterprise Dial Before You Dig team on 0345 070 7386.

Please note: If you have overlaps or misalignments between base maps that make it difficult to understand please contact DBYDEnterpriseEnquiries@sse.com or call 0345 070 7386

Scale: 1:500 (When plotted at A4)



Indigo Pipelines Ltd.
 Registered Office:
 Loddon Reach,
 Reading Road,
 Arborfield,
 Reading,
 Berkshire, RG2 9HU

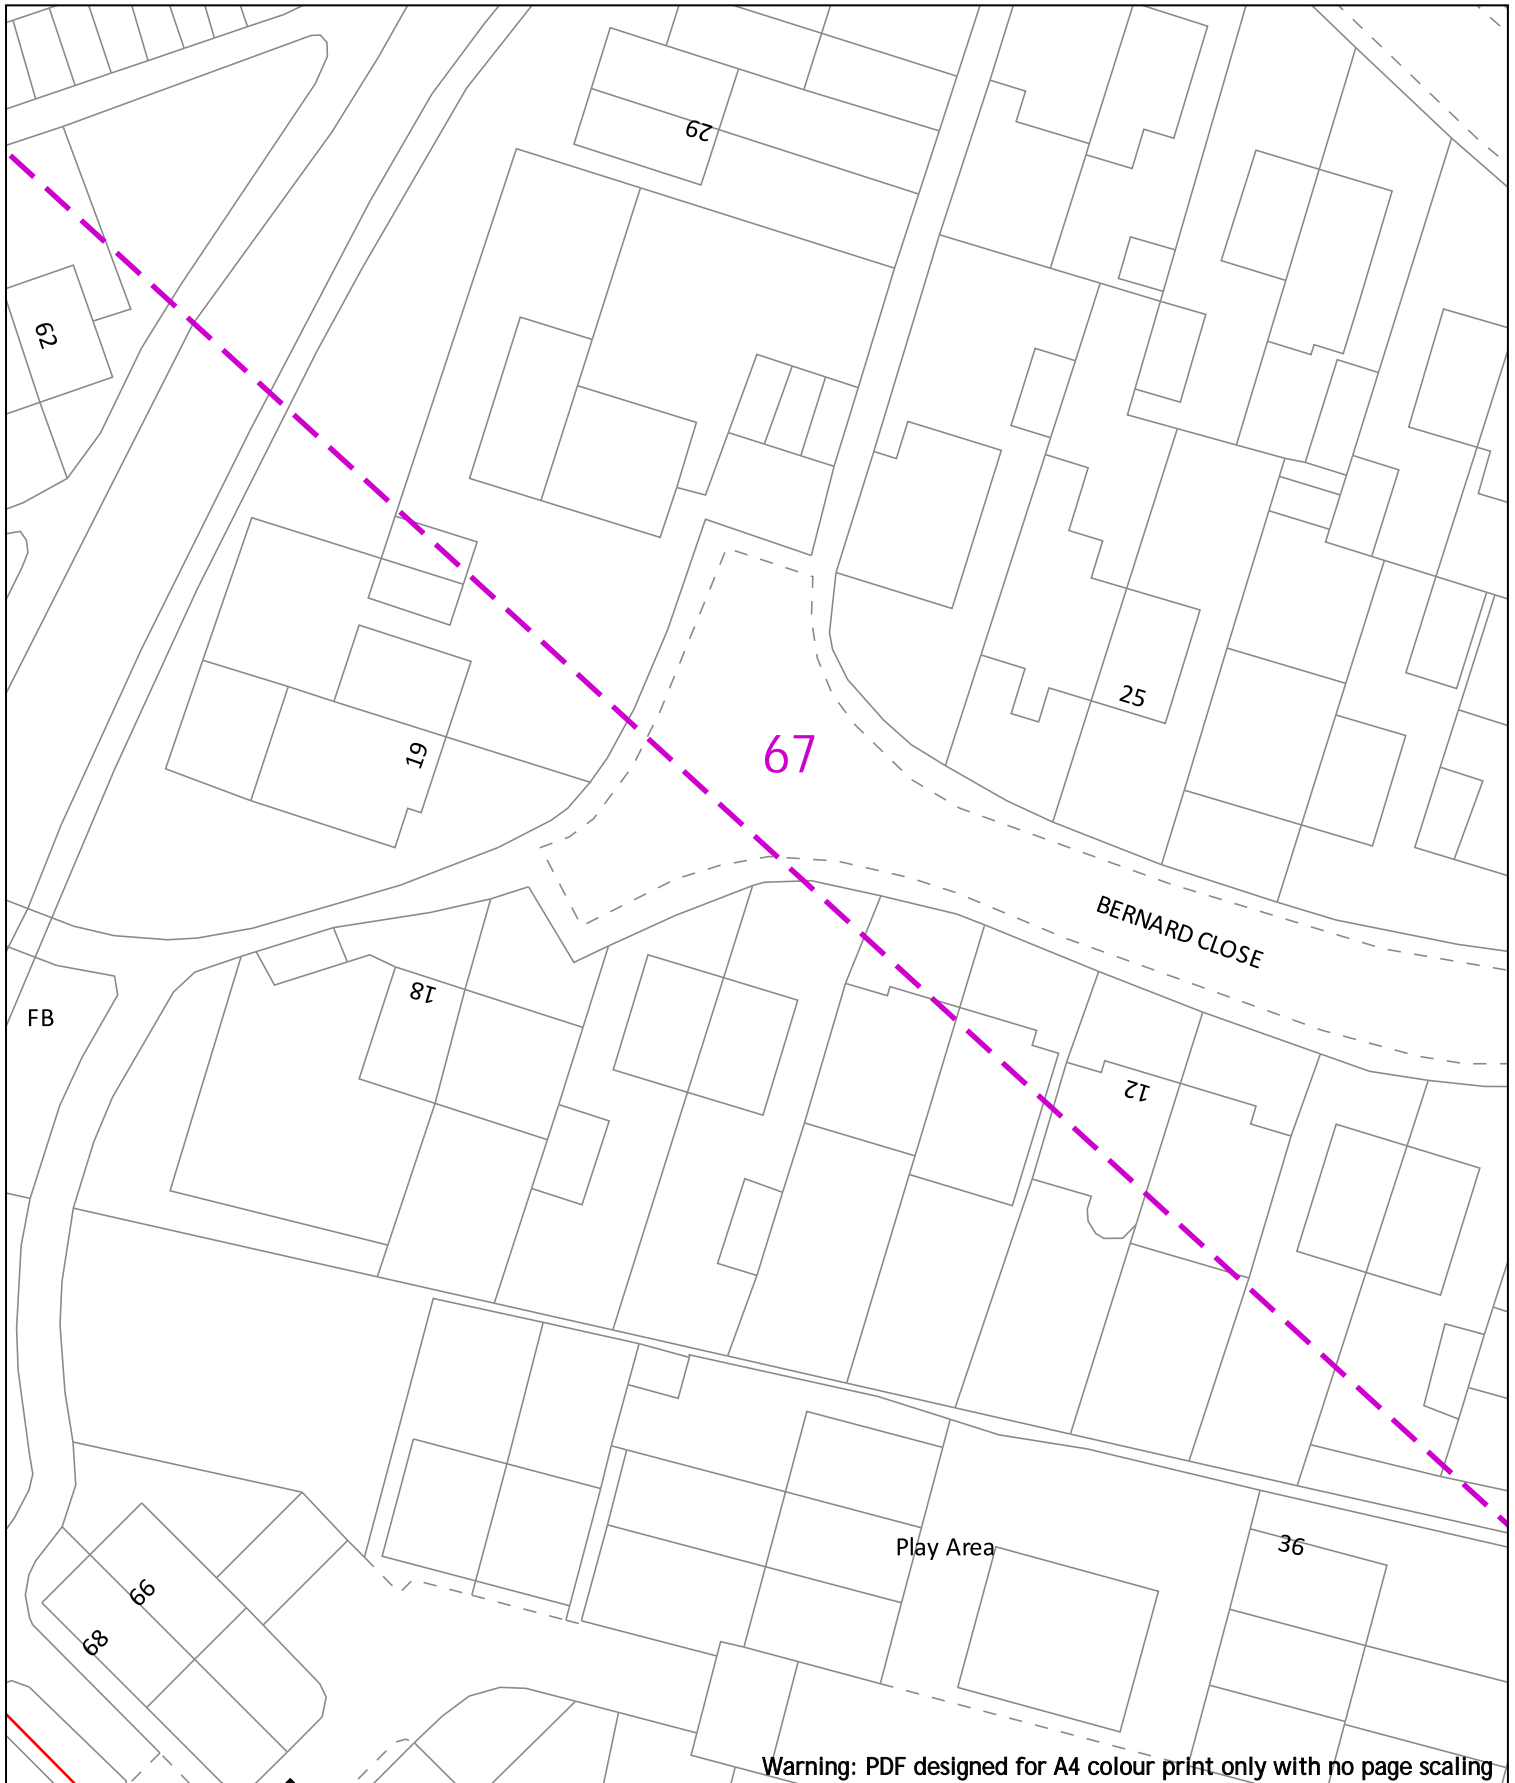

Warning: PDF designed for A4 colour print only with no page scaling

0 20m Dig Sites Area: Line:

	LP Main		Valve Closed		Reducer
	LP Service		Valve Open		Ducting
	MP Main		CSEP		Gas Supply Point
	MP Service		Pressure Reduction Station		
	IP Main		End Closure		

IMPORTANT NOTICES


- This information is given as a guide only and its accuracy cannot be guaranteed
- The plan only shows pipes owned by SSE Utility Solutions Limited, Indigo Pipelines Limited
- Service pipes etc. may not be shown but their presence should be anticipated
- You must use safe digging practices in accordance with H5(G)47 to establish the actual position of mains, services and other apparatus before any mechanical excavation is used
- It is your responsibility to ensure this information is provided to all persons working near our plant
- If in doubt call the SSE Enterprise Dial Before You Dig team on 0345 070 7386.

Please note: If you have overlaps or misalignments between base maps that make it difficult to understand please contact DBYDEnterpriseEnquiries@sse.com or call 0345 070 7386

Date Requested: 24/06/2022
 Job Reference: 25881050
 Site Location: 448447 212278
 Requested by: Mr Joe Shawyer
 Your Scheme/Reference: 31188_004

Scale: 1:500 (When plotted at A4)

Indigo Pipelines Ltd.
 Registered Office:
 Loddon Reach,
 Reading Road,
 Arborfield,
 Reading,
 Berkshire, RG2 9HU

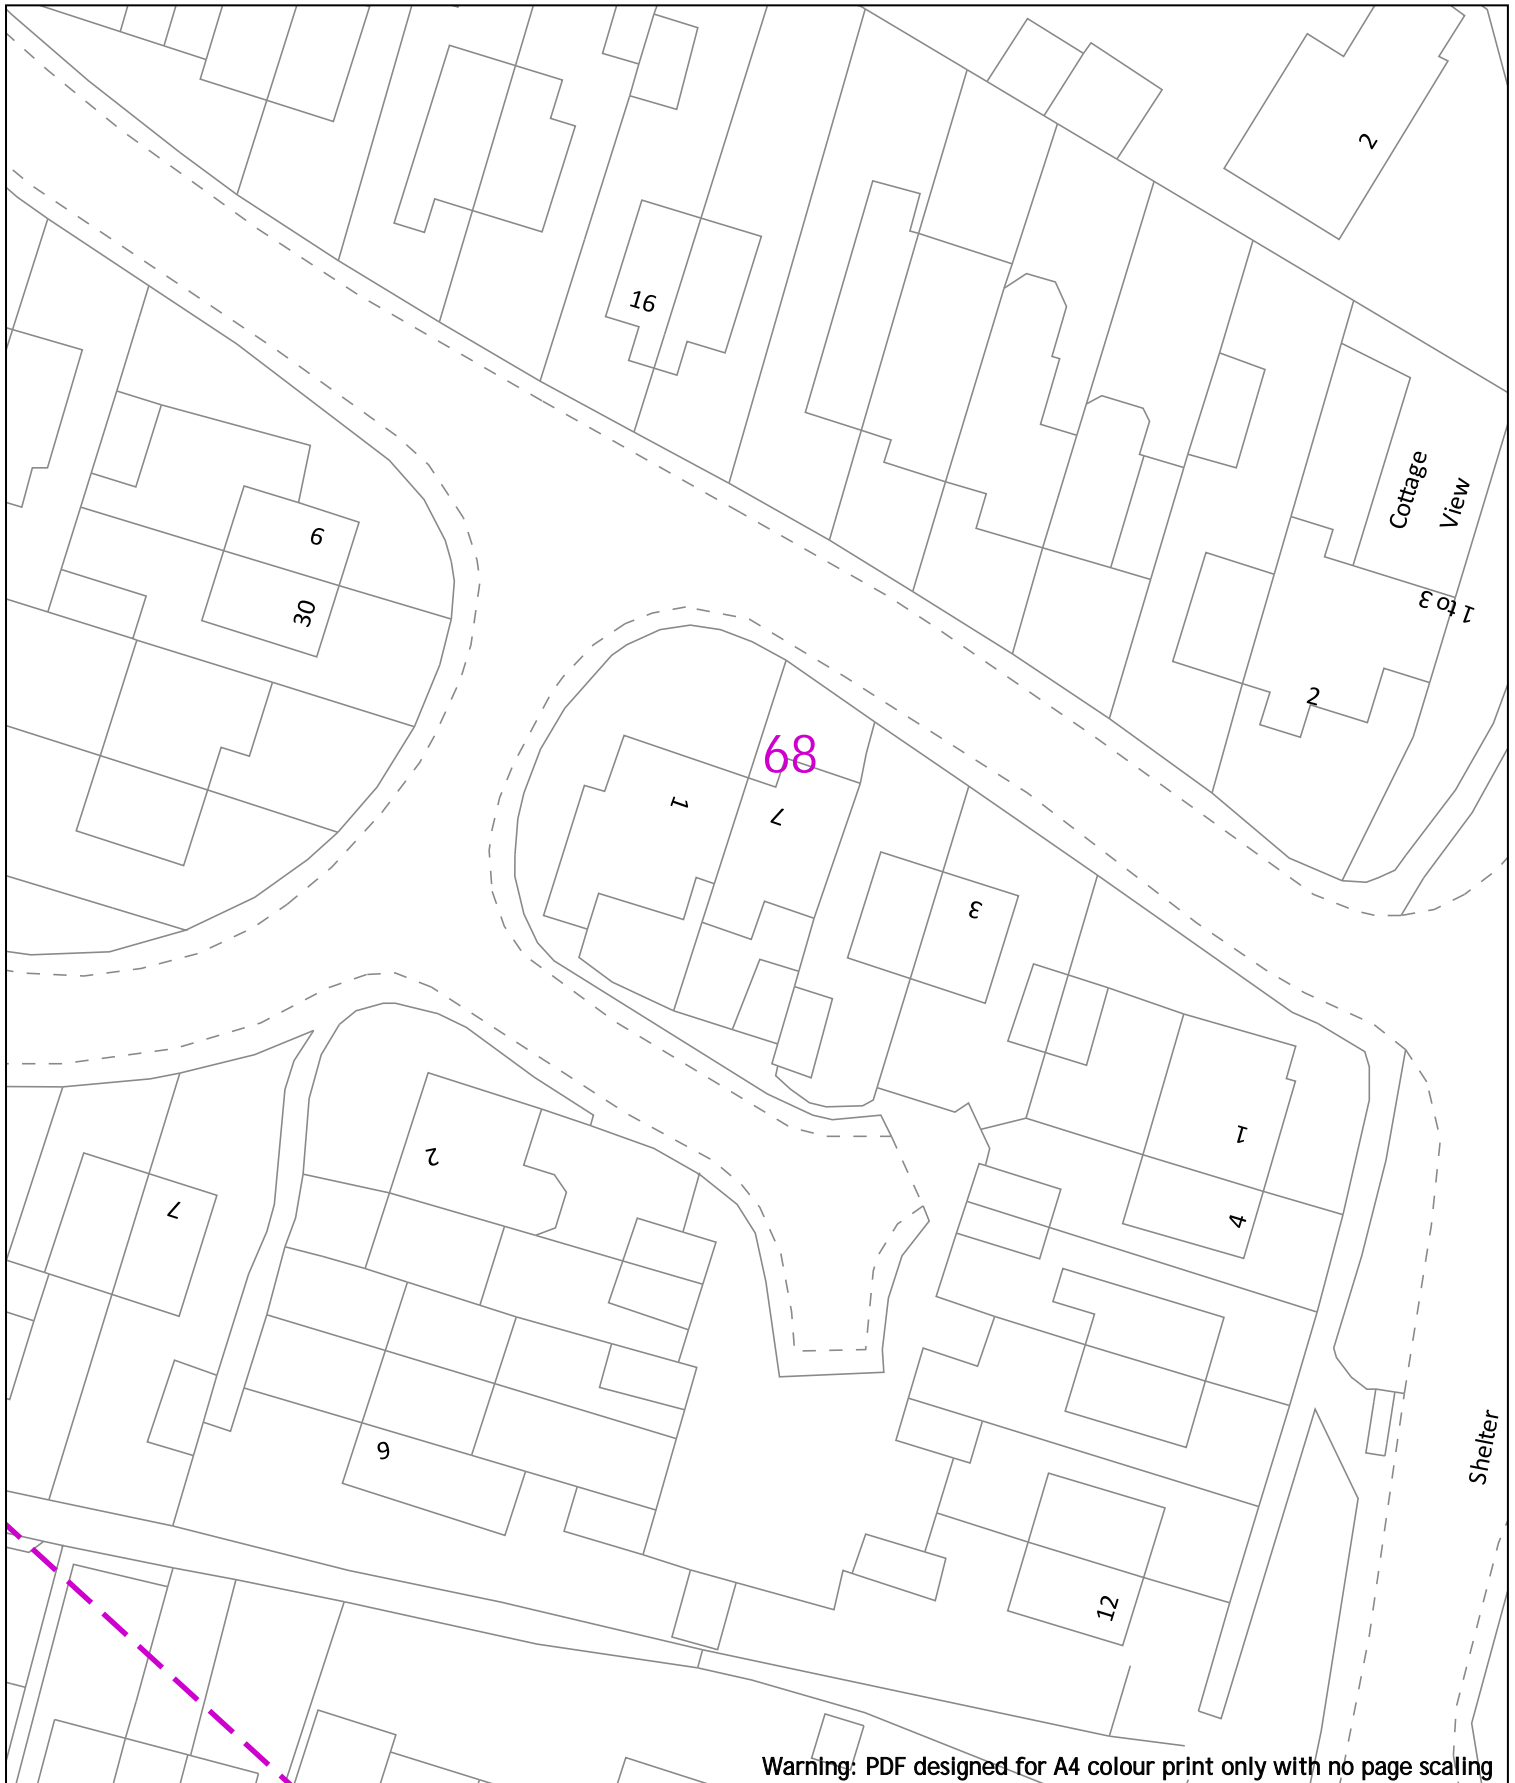

Warning: PDF designed for A4 colour print only with no page scaling

0 20m Dig Sites Area: Line:

Date Requested: 24/06/2022
 Job Reference: 25881050
 Site Location: 448447 212278
 Requested by: Mr Joe Shawyer
 Your Scheme/Reference: 31188_004

	LP Main		Valve Closed		Reducer
	LP Service		Valve Open		Ducting
	MP Main		CSEP		Gas Supply Point
	MP Service		Pressure Reduction Station		
	IP Main		End Closure		

IMPORTANT NOTICES


- This information is given as a guide only and its accuracy cannot be guaranteed
- The plan only shows pipes owned by SSE Utility Solutions Limited, Indigo Pipelines Limited
- Service pipes etc. may not be shown but their presence should be anticipated
- You must use safe digging practices in accordance with H5(G)47 to establish the actual position of mains, services and other apparatus before any mechanical excavation is used
- It is your responsibility to ensure this information is provided to all persons working near our plant
- If in doubt call the SSE Enterprise Dial Before You Dig team on 0345 070 7386.

Please note: If you have overlaps or misalignments between base maps that make it difficult to understand please contact DBYEnterpriseEnquiries@sse.com or call 0345 070 7386



Indigo Pipelines Ltd.
 Registered Office:
 Loddon Reach,
 Reading Road,
 Arborfield,
 Reading,
 Berkshire, RG2 9HU

Scale: 1:500 (When plotted at A4)

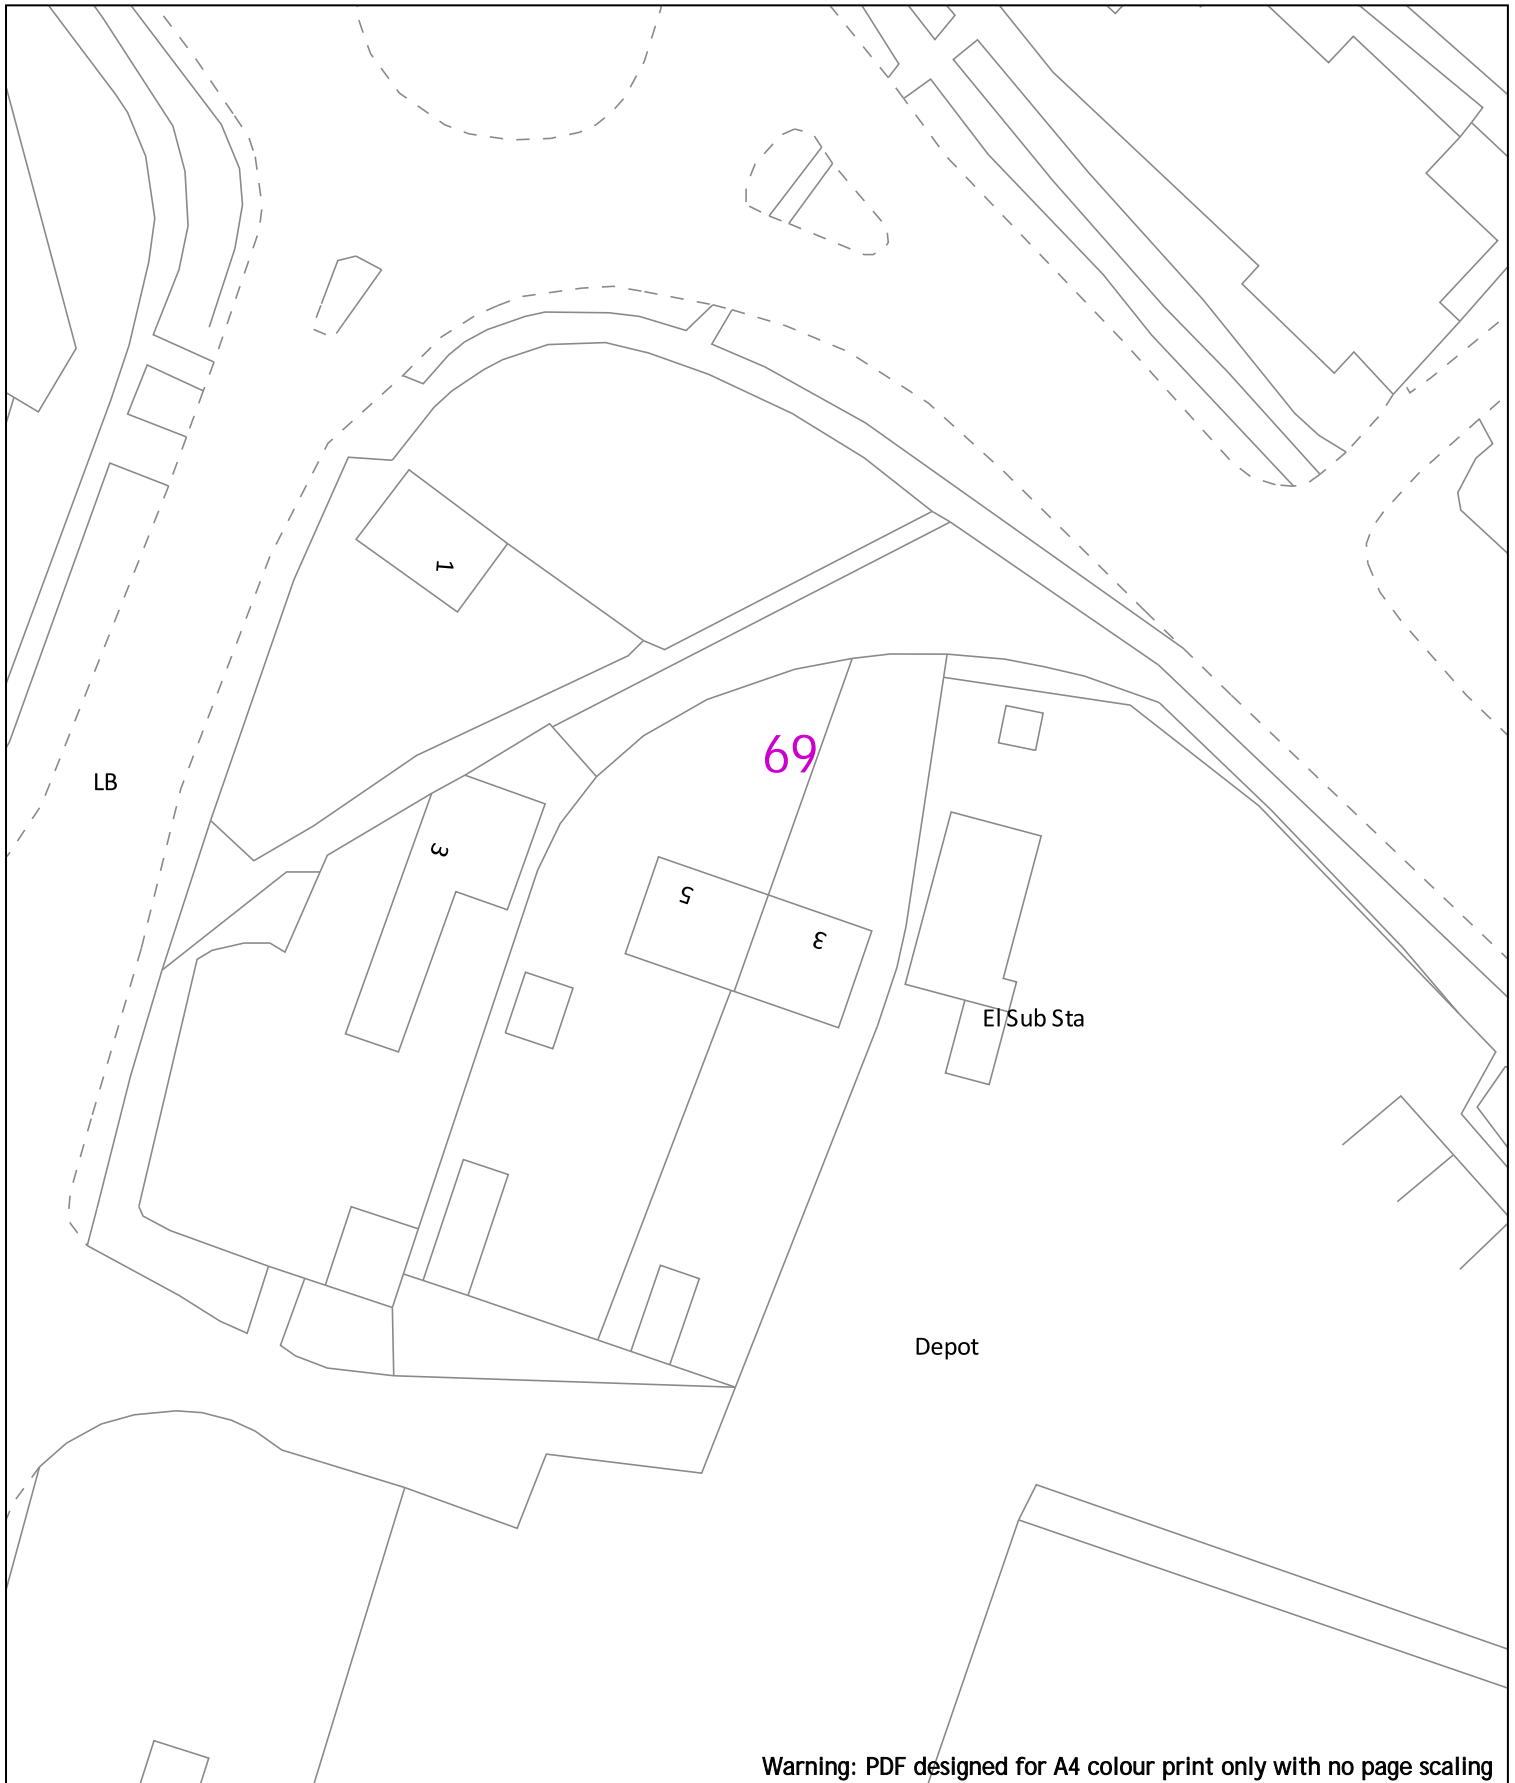

Warning: PDF designed for A4 colour print only with no page scaling

0 20m Dig Sites Area: Line:

	LP Main		Valve Closed		Reducer
	LP Service		Valve Open		Ducting
	MP Main		CSEP		Gas Supply Point
	MP Service		Pressure Reduction Station		
	IP Main		End Closure		

IMPORTANT NOTICES


- This information is given as a guide only and its accuracy cannot be guaranteed
- The plan only shows pipes owned by SSE Utility Solutions Limited, Indigo Pipelines Limited
- Service pipes etc. may not be shown but their presence should be anticipated
- You must use safe digging practices in accordance with H5(G)47 to establish the actual position of mains, services and other apparatus before any mechanical excavation is used
- It is your responsibility to ensure this information is provided to all persons working near our plant
- If in doubt call the SSE Enterprise Dial Before You Dig team on 0345 070 7386.

Please note: If you have overlaps or misalignments between base maps that make it difficult to understand please contact DBYDEnterpriseEnquiries@sse.com or call 0345 070 7386

Date Requested: 24/06/2022
 Job Reference: 25881050
 Site Location: 448447 212278
 Requested by: Mr Joe Shawyer
 Your Scheme/Reference: 31188_004

Scale: 1:500 (When plotted at A4)

Indigo Pipelines Ltd.
 Registered Office:
 Loddon Reach,
 Reading Road,
 Arborfield,
 Reading,
 Berkshire, RG2 9HU

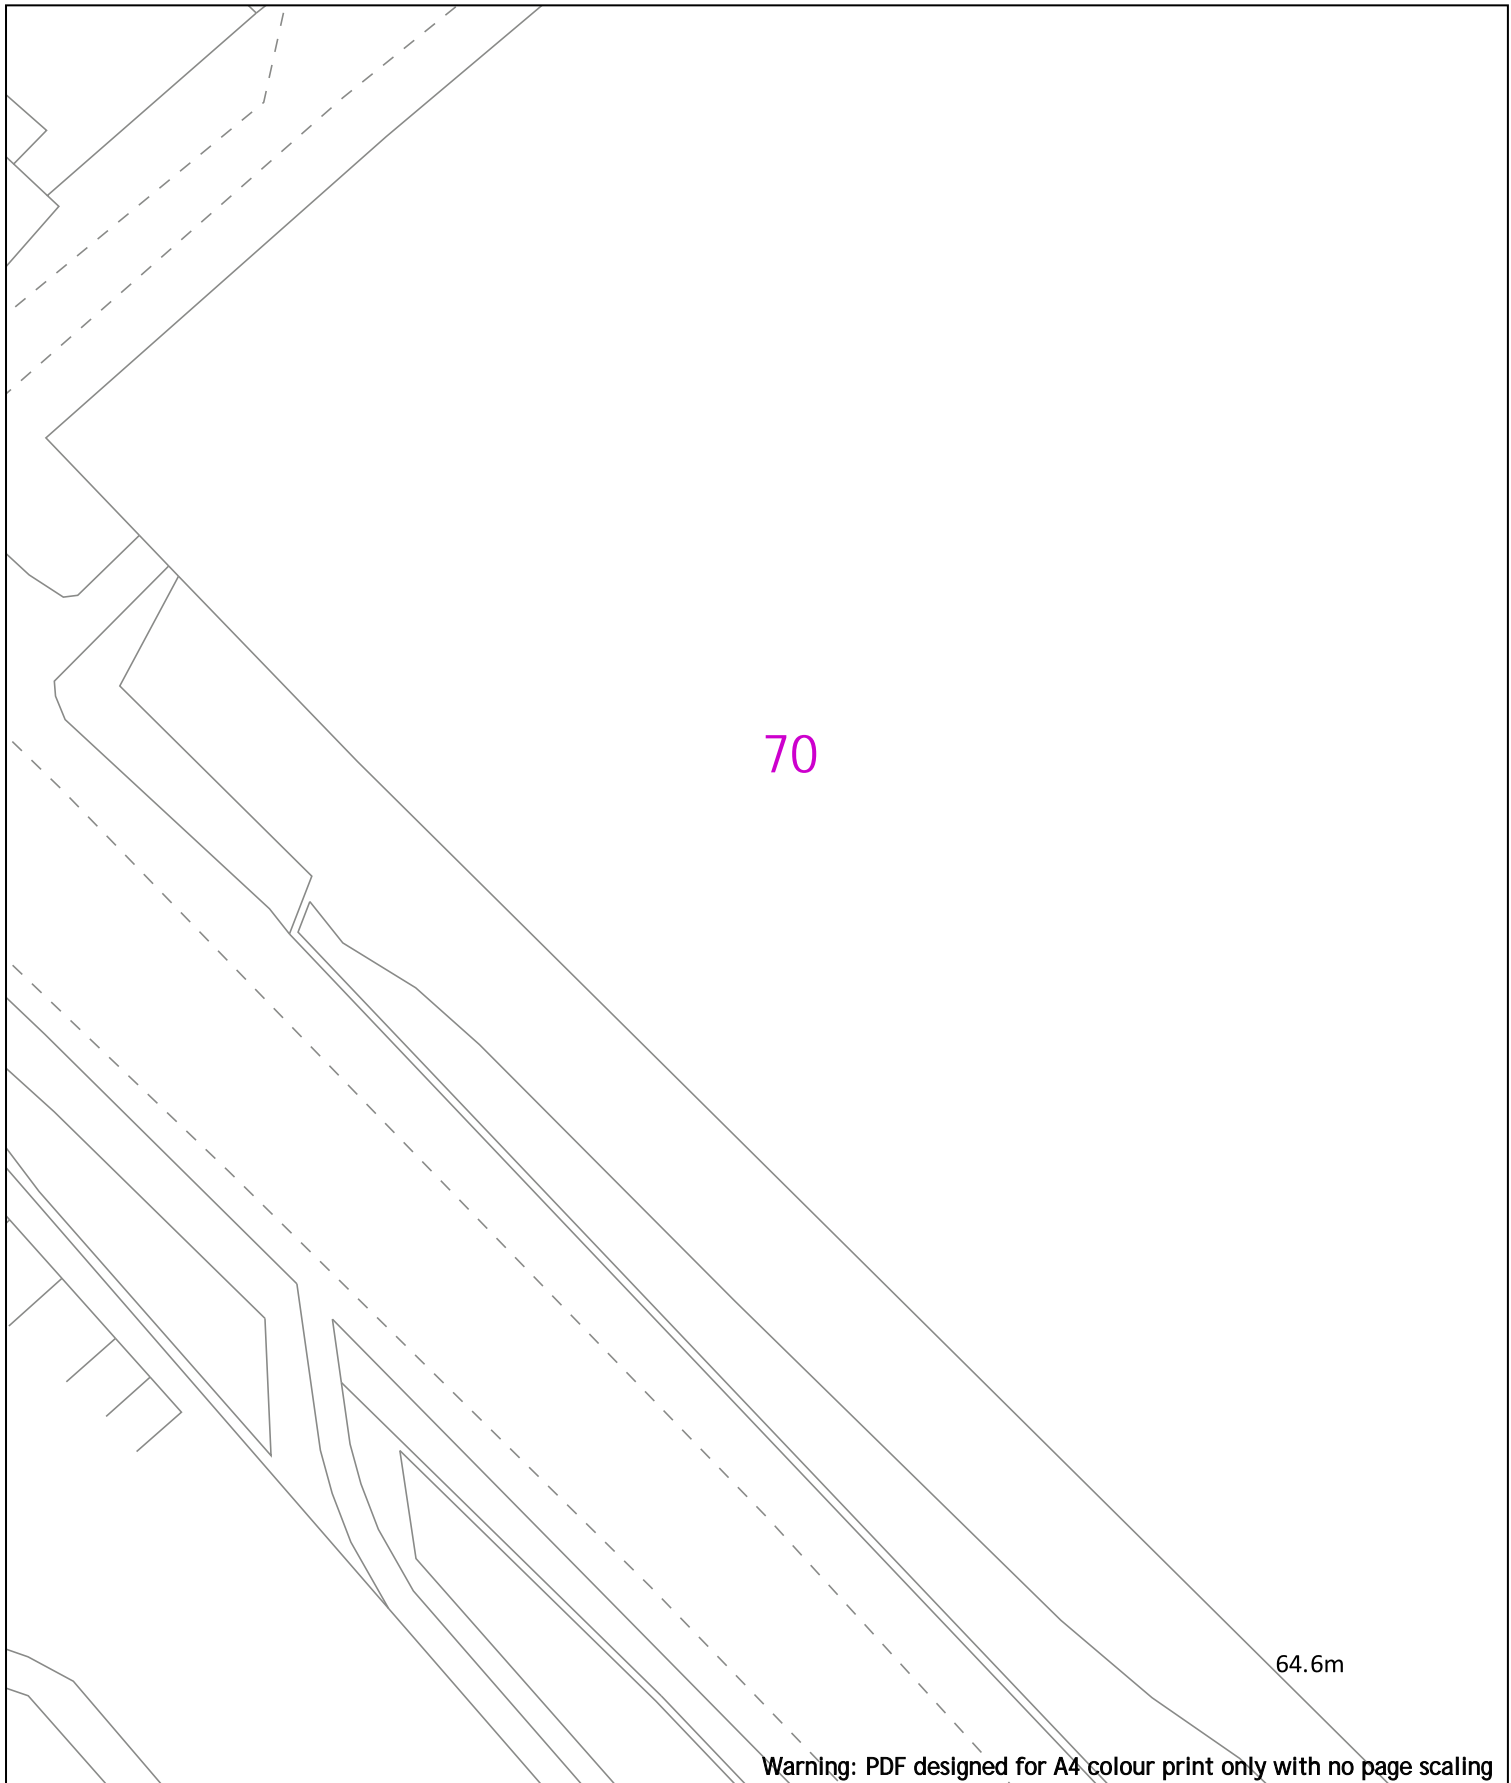

Warning: PDF designed for A4 colour print only with no page scaling

0 20m Dig Sites Area: Line:

LP Main	Valve Closed	Reducer
LP Service	Valve Open	Ducting
MP Main	CSEP	Gas Supply Point
MP Service	Pressure Reduction Station	
IP Main	End Closure	

IMPORTANT NOTICES

- This information is given as a guide only and its accuracy cannot be guaranteed
- The plan only shows pipes owned by SSE Utility Solutions Limited, Indigo Pipelines Limited
- Service pipes etc. may not be shown but their presence should be anticipated
- You must use safe digging practices in accordance with H5(G)47 to establish the actual position of mains, services and other apparatus before any mechanical excavation is used
- It is your responsibility to ensure this information is provided to all persons working near our plant
- If in doubt call the SSE Enterprise Dial Before You Dig team on 0345 070 7386.

Please note: If you have overlaps or misalignments between base maps that make it difficult to understand please contact DBYDEnterpriseEnquiries@sse.com or call 0345 070 7386




Date Requested: 24/06/2022
 Job Reference: 25881050
 Site Location: 448447 212278
 Requested by: Mr Joe Shawyer
 Your Scheme/Reference: 31188_004

Scale: 1:500 (When plotted at A4)














Indigo Pipelines Ltd.
 Registered Office:
 Loddon Reach,
 Reading Road,
 Arborfield,
 Reading,
 Berkshire, RG2 9HU

71

Warning: PDF designed for A4 colour print only with no page scaling.

0  20m Dig Sites Area:  Line: 

Date Requested: 24/06/2022
Job Reference: 25881050
Site Location: 448447 212278
Requested by: Mr Joe Shawyer
Your Scheme/Reference: 31188_004

 	LP Main		Valve Closed		Reducer
	LP Service		Valve Open		Ducting
	MP Main		CSEP		Gas Supply Point
	MP Service		Pressure Reduction Station		
	IP Main		End Closure		

IMPORTANT NOTICES


- This information is given as a guide only and its accuracy cannot be guaranteed
- The plan only shows pipes owned by SSE Utility Solutions Limited, Indigo Pipelines Limited
- Service pipes etc. may not be shown but their presence should be anticipated
- You must use safe digging practices in accordance with H5(G)47 to establish the actual position of mains, services and other apparatus before any mechanical excavation is used
- It is your responsibility to ensure this information is provided to all persons working near our plant
- If in doubt call the SSE Enterprise Dial Before You Dig team on 0345 070 7386.

Please note: If you have overlaps or misalignments between base maps that make it difficult to understand please contact DBYDEnterpriseEnquiries@sse.com or call 0345 070 7386



Indigo Pipelines Ltd.
Registered Office:
Loddon Reach,
Reading Road,
Arborfield,
Reading,
Berkshire, RG2 9HU

Scale: 1:500 (When plotted at A4)

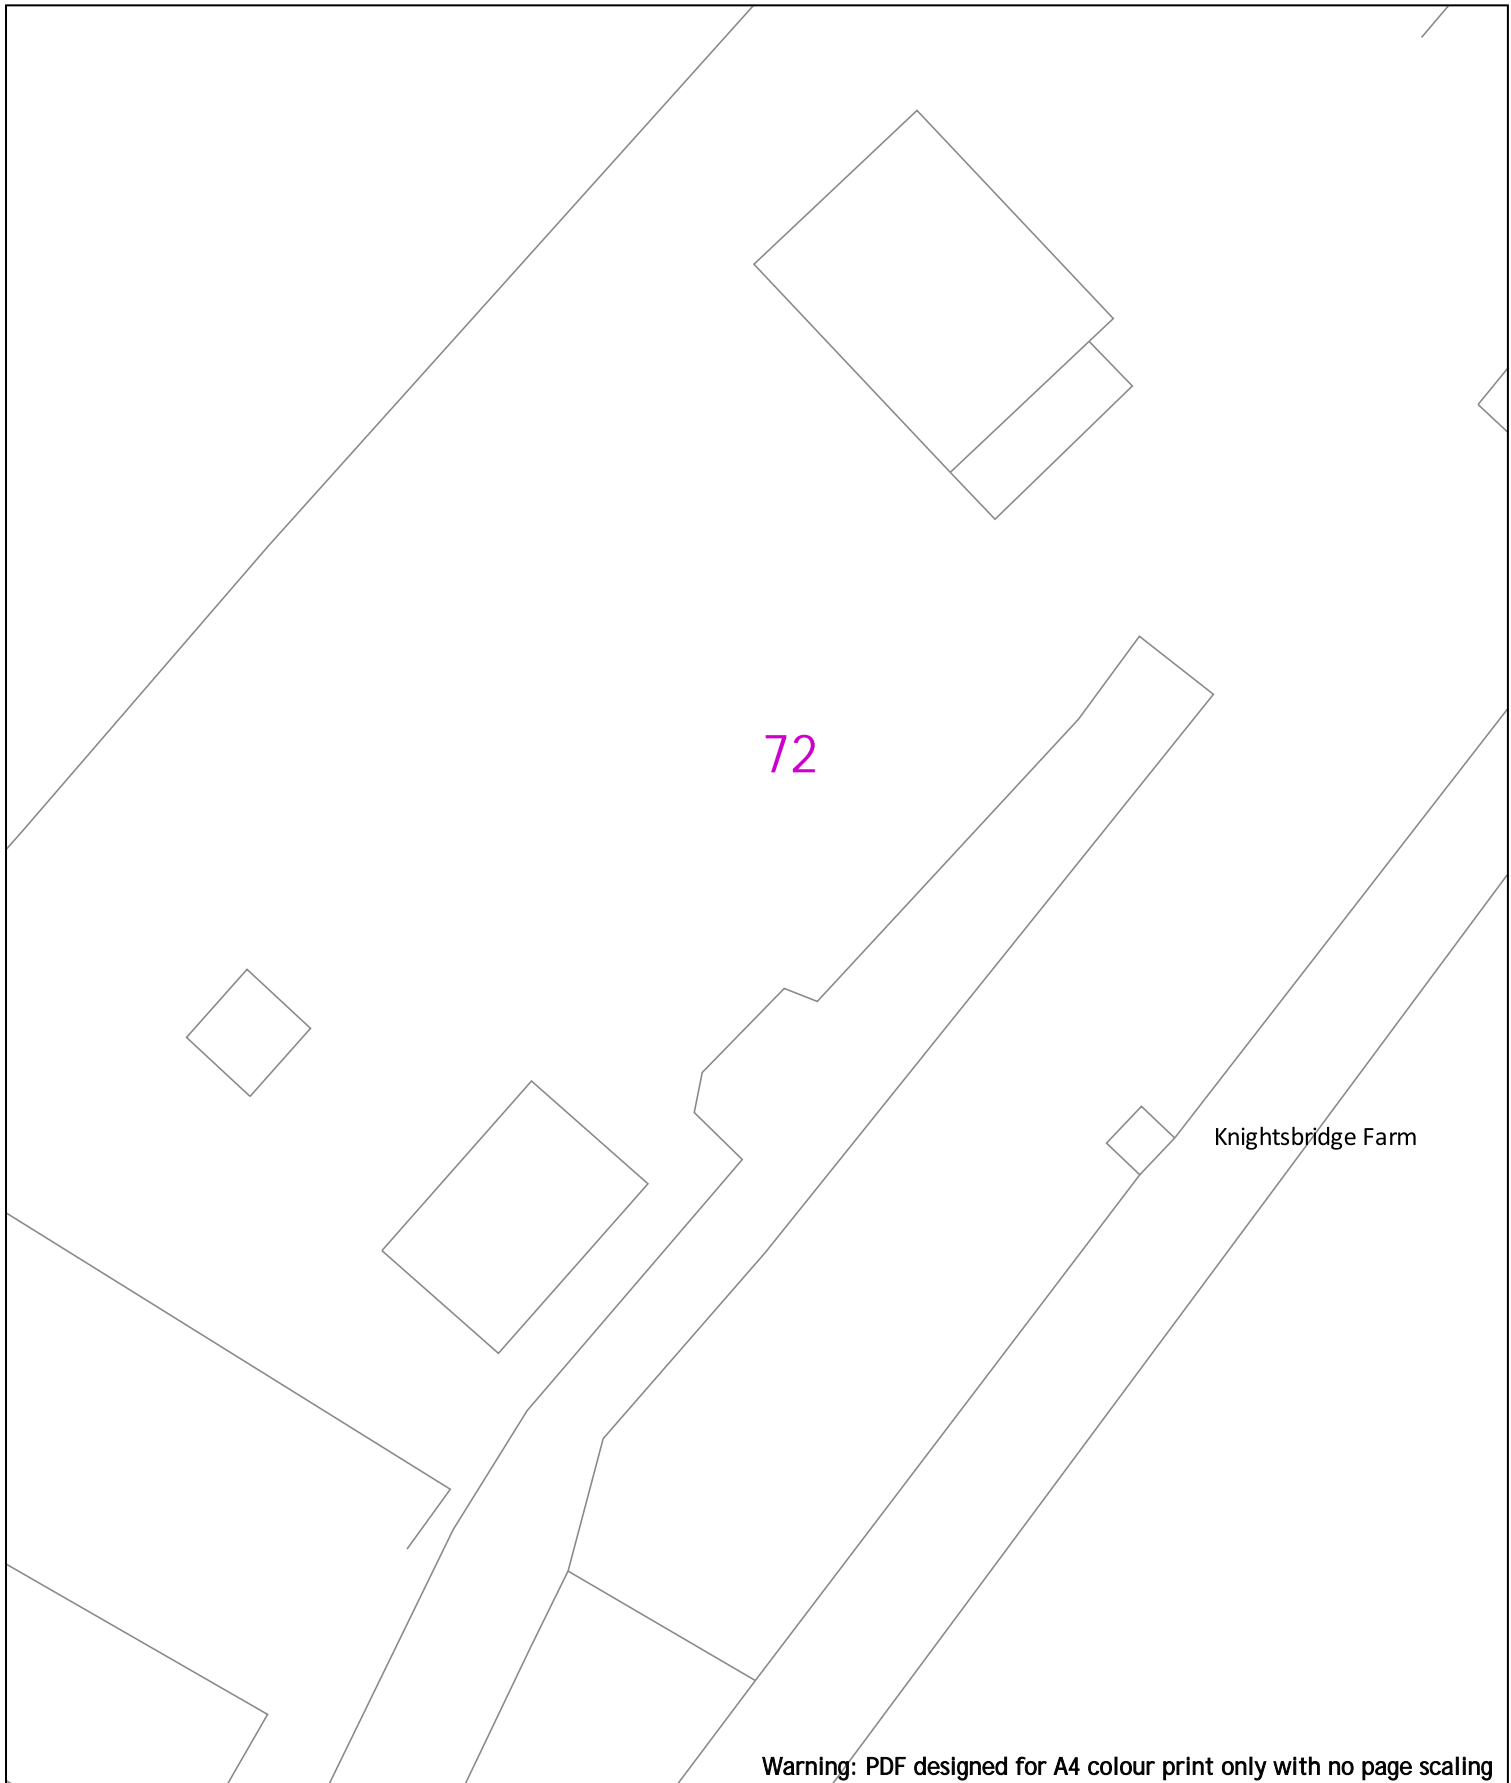

Warning: PDF designed for A4 colour print only with no page scaling

0 20m Dig Sites Area: Line:

LP Main	Valve Closed	Reducer
LP Service	Valve Open	Ducting
MP Main	CSEP	Gas Supply Point
MP Service	Pressure Reduction Station	
IP Main	End Closure	

IMPORTANT NOTICES

- This information is given as a guide only and its accuracy cannot be guaranteed
- The plan only shows pipes owned by SSE Utility Solutions Limited, Indigo Pipelines Limited
- Service pipes etc. may not be shown but their presence should be anticipated
- You must use safe digging practices in accordance with H5(G)47 to establish the actual position of mains, services and other apparatus before any mechanical excavation is used
- It is your responsibility to ensure this information is provided to all persons working near our plant
- If in doubt call the SSE Enterprise Dial Before You Dig team on 0345 070 7386.

Please note: If you have overlaps or misalignments between base maps that make it difficult to understand please contact DBYDEnterpriseEnquiries@sse.com or call 0345 070 7386


Date Requested: 24/06/2022
 Job Reference: 25881050
 Site Location: 448447 212278
 Requested by: Mr Joe Shawyer
 Your Scheme/Reference: 31188_004

Scale: 1:500 (When plotted at A4)














Indigo Pipelines Ltd.
 Registered Office:
 Loddon Reach,
 Reading Road,
 Arborfield,
 Reading,
 Berkshire, RG2 9HU

73

Warning: PDF designed for A4 colour print only with no page scaling

0  20m Dig Sites Area:  Line: 

Date Requested: 24/06/2022
Job Reference: 25881050
Site Location: 448447 212278
Requested by: Mr Joe Shawyer
Your Scheme/Reference: 31188_004

  LP Main	 Valve Closed	 Reducer
 LP Service	 Valve Open	 Ducting
 MP Main	 CSEP	 Gas Supply Point
 MP Service	 Pressure Reduction Station	
 IP Main	 End Closure	

IMPORTANT NOTICES


- This information is given as a guide only and its accuracy cannot be guaranteed
- The plan only shows pipes owned by SSE Utility Solutions Limited, Indigo Pipelines Limited
- Service pipes etc. may not be shown but their presence should be anticipated
- You must use safe digging practices in accordance with H5(G)47 to establish the actual position of mains, services and other apparatus before any mechanical excavation is used
- It is your responsibility to ensure this information is provided to all persons working near our plant
- If in doubt call the SSE Enterprise Dial Before You Dig team on 0345 070 7386.

Please note: If you have overlaps or misalignments between base maps that make it difficult to understand please contact DBYDEnterpriseEnquiries@sse.com or call 0345 070 7386



Indigo Pipelines Ltd.
Registered Office:
Loddon Reach,
Reading Road,
Arborfield,
Reading,
Berkshire, RG2 9HU

Scale: 1:500 (When plotted at A4)

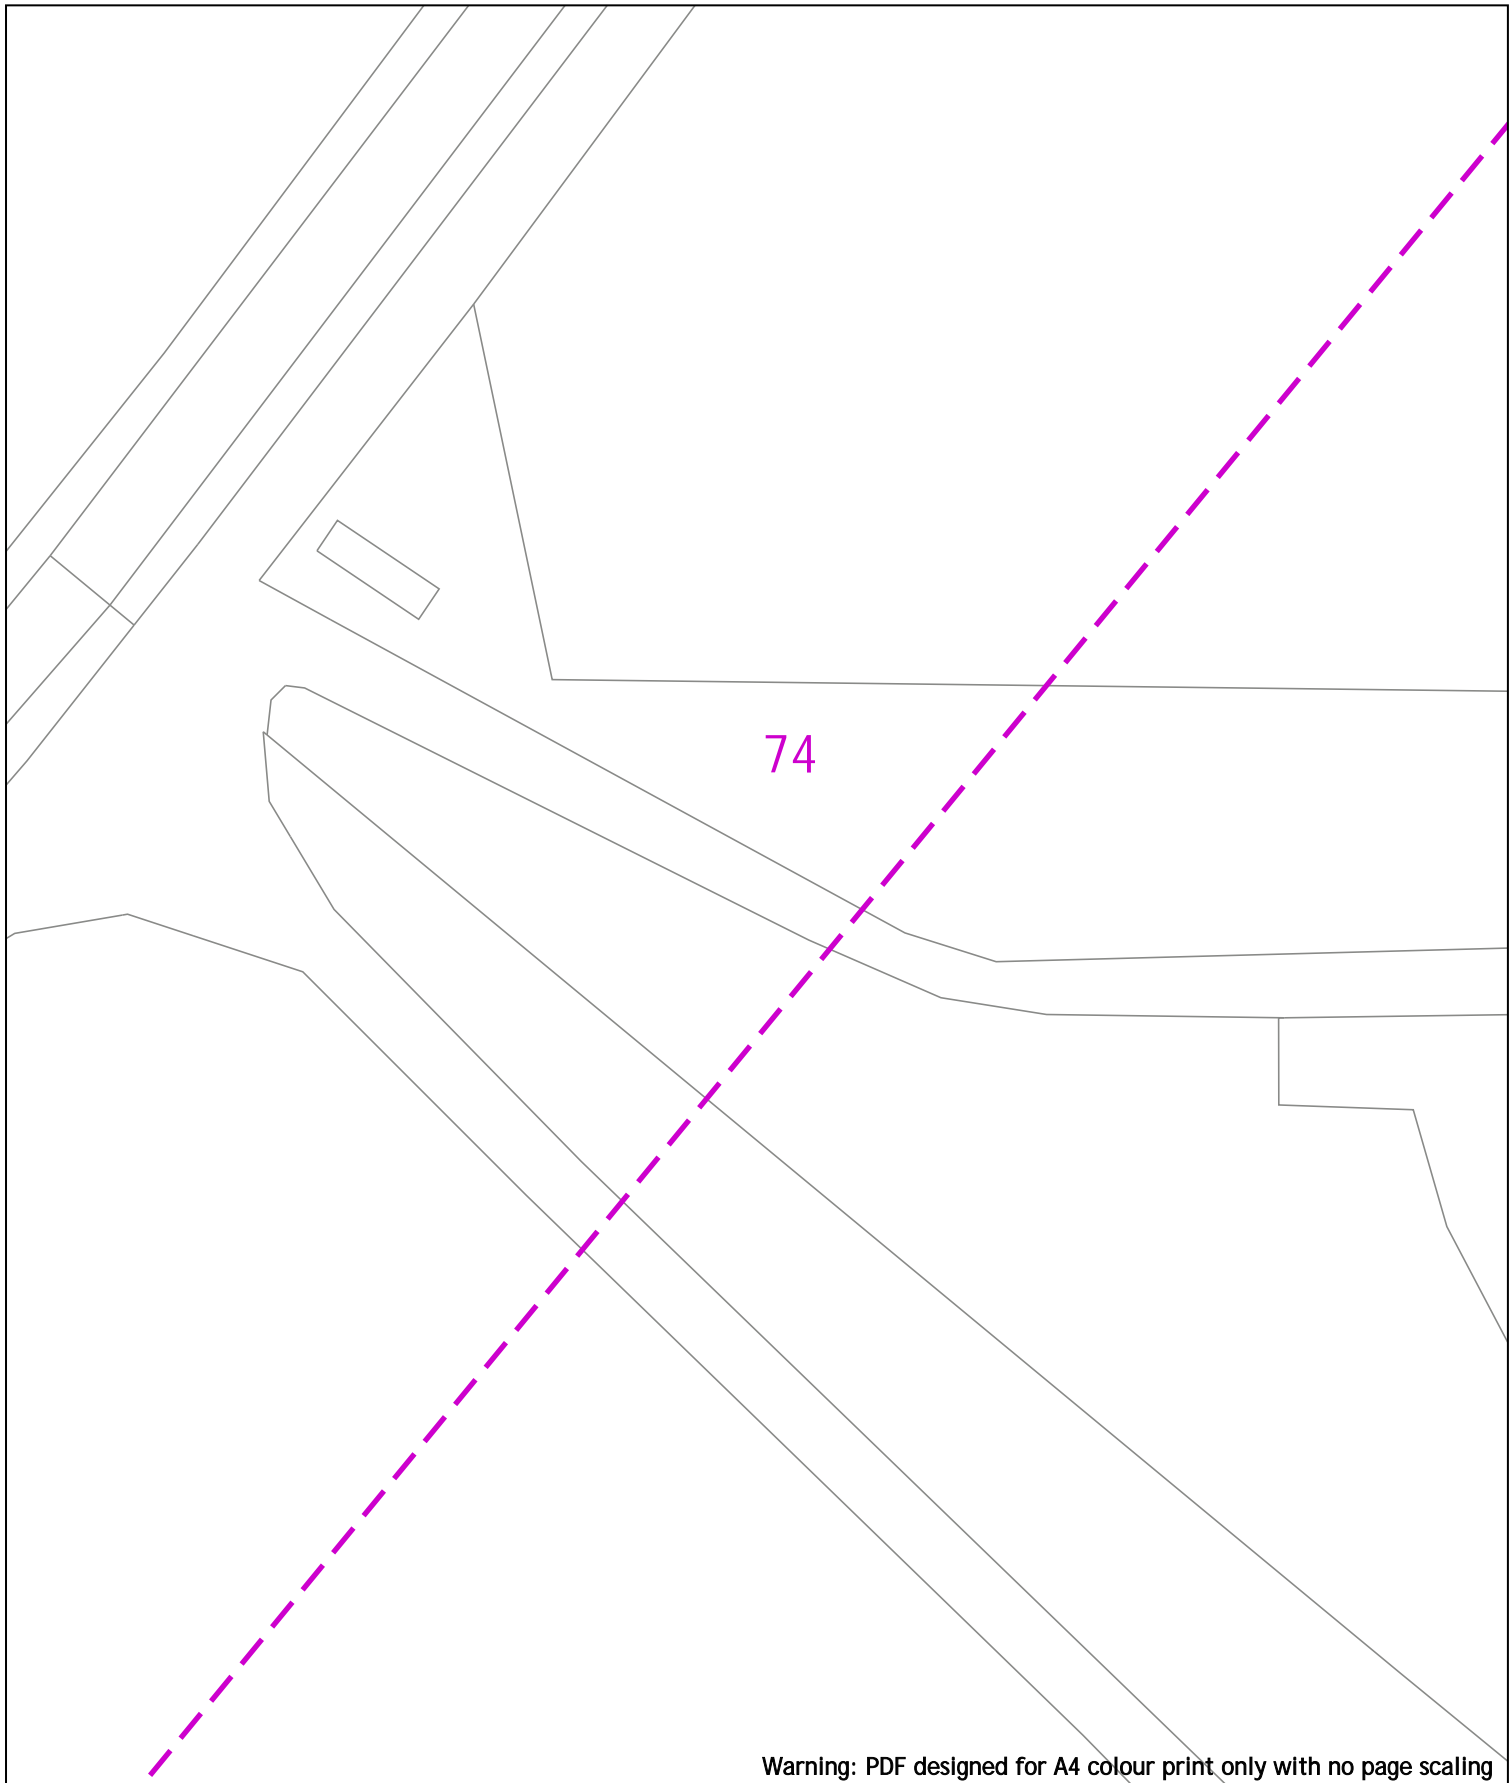

Warning: PDF designed for A4 colour print only with no page scaling

0 20m Dig Sites Area: Line:

LP Main	Valve Closed	Reducer
LP Service	Valve Open	Ducting
MP Main	CSEP	Gas Supply Point
MP Service	Pressure Reduction Station	
IP Main	End Closure	

IMPORTANT NOTICES

- This information is given as a guide only and its accuracy cannot be guaranteed
- The plan only shows pipes owned by SSE Utility Solutions Limited, Indigo Pipelines Limited
- Service pipes etc. may not be shown but their presence should be anticipated
- You must use safe digging practices in accordance with H5(G)47 to establish the actual position of mains, services and other apparatus before any mechanical excavation is used
- It is your responsibility to ensure this information is provided to all persons working near our plant
- If in doubt call the SSE Enterprise Dial Before You Dig team on 0345 070 7386.

Please note: If you have overlaps or misalignments between base maps that make it difficult to understand please contact DBYDEnterpriseEnquiries@sse.com or call 0345 070 7386

Date Requested: 24/06/2022
 Job Reference: 25881050
 Site Location: 448447 212278
 Requested by: Mr Joe Shawyer
 Your Scheme/Reference: 31188_004

Scale: 1:500 (When plotted at A4)

Indigo Pipelines Ltd.
 Registered Office:
 Loddon Reach,
 Reading Road,
 Arborfield,
 Reading,
 Berkshire, RG2 9HU














75

Solar Farm

Warning: PDF designed for A4 colour print only with no page scaling

0  20m Dig Sites Area:  Line: 

Date Requested: 24/06/2022
Job Reference: 25881050
Site Location: 448447 212278
Requested by: Mr Joe Shawyer
Your Scheme/Reference: 31188_004

  LP Main	 Valve Closed	 Reducer
 LP Service	 Valve Open	 Ducting
 MP Main	 CSEP	 Gas Supply Point
 MP Service	 Pressure Reduction Station	
 IP Main	 End Closure	

IMPORTANT NOTICES

- This information is given as a guide only and its accuracy cannot be guaranteed
- The plan only shows pipes owned by SSE Utility Solutions Limited, Indigo Pipelines Limited
- Service pipes etc. may not be shown but their presence should be anticipated
- You must use safe digging practices in accordance with H5(G)47 to establish the actual position of mains, services and other apparatus before any mechanical excavation is used
- It is your responsibility to ensure this information is provided to all persons working near our plant
- If in doubt call the SSE Enterprise Dial Before You Dig team on 0345 070 7386.

Please note: If you have overlaps or misalignments between base maps that make it difficult to understand please contact DBYDEnterpriseEnquiries@sse.com or call 0345 070 7386
















Indigo Pipelines Ltd.
Registered Office:
Loddon Reach,
Reading Road,
Arborfield,
Reading,
Berkshire, RG2 9HU

Warning: PDF designed for A4 colour print only with no page scaling

0  20m Dig Sites Area:  Line: 

Date Requested: 24/06/2022
 Job Reference: 25881050
 Site Location: 448447 212278
 Requested by: Mr Joe Shawyer
 Your Scheme/Reference: 31188_004

 	LP Main		Valve Closed		Reducer
	LP Service		Valve Open		Ducting
	MP Main		CSEP		Gas Supply Point
	MP Service		Pressure Reduction Station		
	IP Main		End Closure		

IMPORTANT NOTICES


- This information is given as a guide only and its accuracy cannot be guaranteed
- The plan only shows pipes owned by SSE Utility Solutions Limited, Indigo Pipelines Limited
- Service pipes etc. may not be shown but their presence should be anticipated
- You must use safe digging practices in accordance with H5(G)47 to establish the actual position of mains, services and other apparatus before any mechanical excavation is used
- It is your responsibility to ensure this information is provided to all persons working near our plant
- If in doubt call the SSE Enterprise Dial Before You Dig team on 0345 070 7386.

Please note: If you have overlaps or misalignments between base maps that make it difficult to understand please contact DBYDEnterpriseEnquiries@sse.com or call 0345 070 7386



Indigo Pipelines Ltd.
 Registered Office:
 Loddon Reach,
 Reading Road,
 Arborfield,
 Reading,
 Berkshire, RG2 9HU

Scale: 1:500 (When plotted at A4)

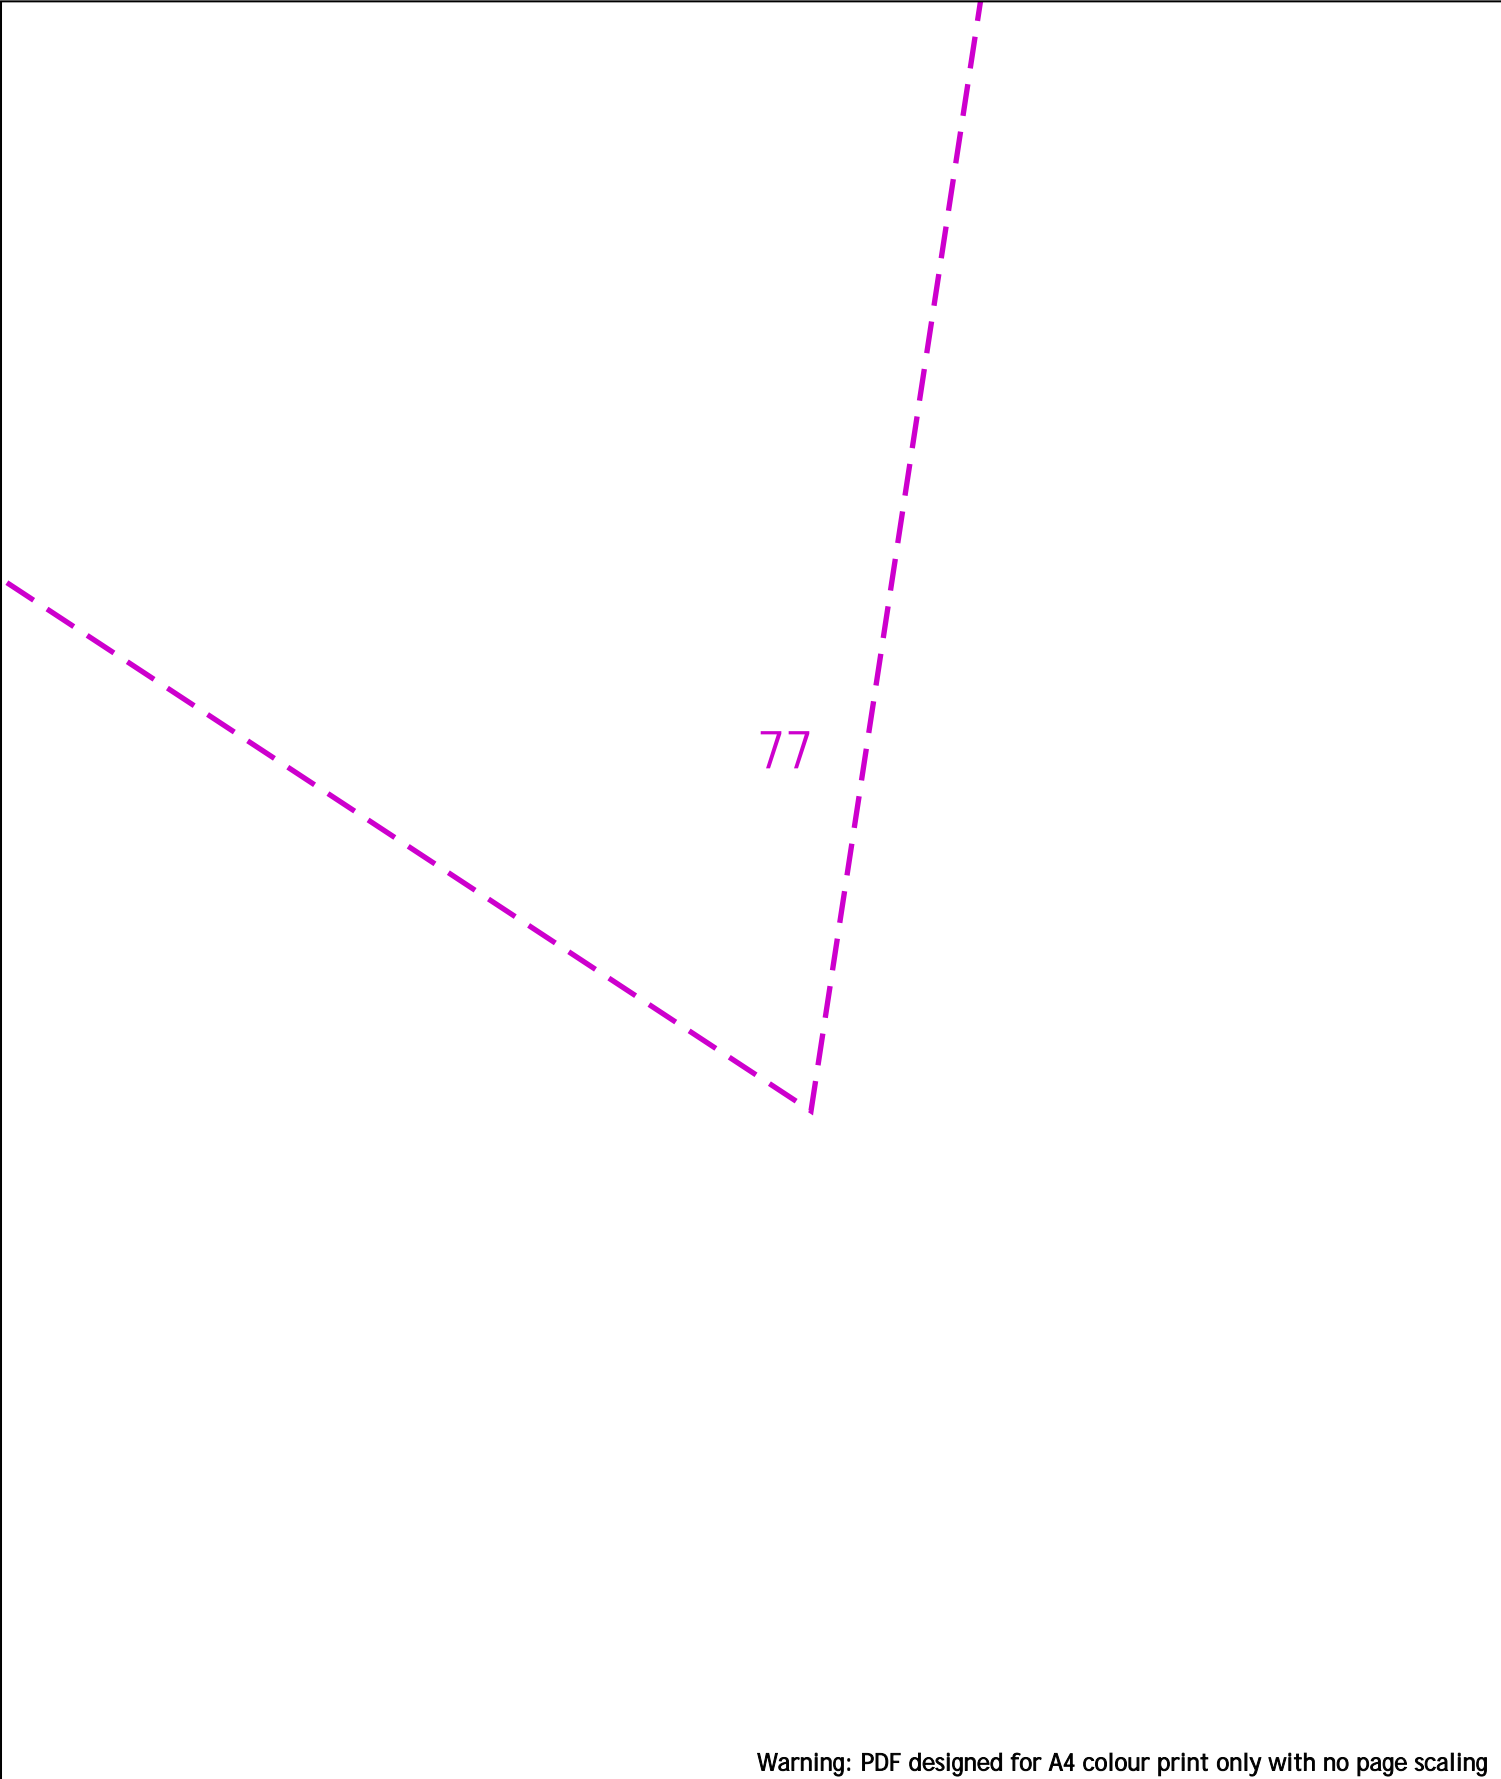

Warning: PDF designed for A4 colour print only with no page scaling

0 20m Dig Sites Area: Line:

LP Main	Valve Closed	Reducer
LP Service	Valve Open	Ducting
MP Main	CSEP	Gas Supply Point
MP Service	Pressure Reduction Station	
IP Main	End Closure	

IMPORTANT NOTICES


- This information is given as a guide only and its accuracy cannot be guaranteed
- The plan only shows pipes owned by SSE Utility Solutions Limited, Indigo Pipelines Limited
- Service pipes etc. may not be shown but their presence should be anticipated
- You must use safe digging practices in accordance with H5(G)47 to establish the actual position of mains, services and other apparatus before any mechanical excavation is used
- It is your responsibility to ensure this information is provided to all persons working near our plant
- If in doubt call the SSE Enterprise Dial Before You Dig team on 0345 070 7386.

Please note: If you have overlaps or misalignments between base maps that make it difficult to understand please contact DBYDEnterpriseEnquiries@sse.com or call 0345 070 7386

Date Requested: 24/06/2022
 Job Reference: 25881050
 Site Location: 448447 212278
 Requested by: Mr Joe Shawyer
 Your Scheme/Reference: 31188_004

Scale: 1:500 (When plotted at A4)

Indigo Pipelines Ltd.
 Registered Office:
 Loddon Reach,
 Reading Road,
 Arborfield,
 Reading,
 Berkshire, RG2 9HU

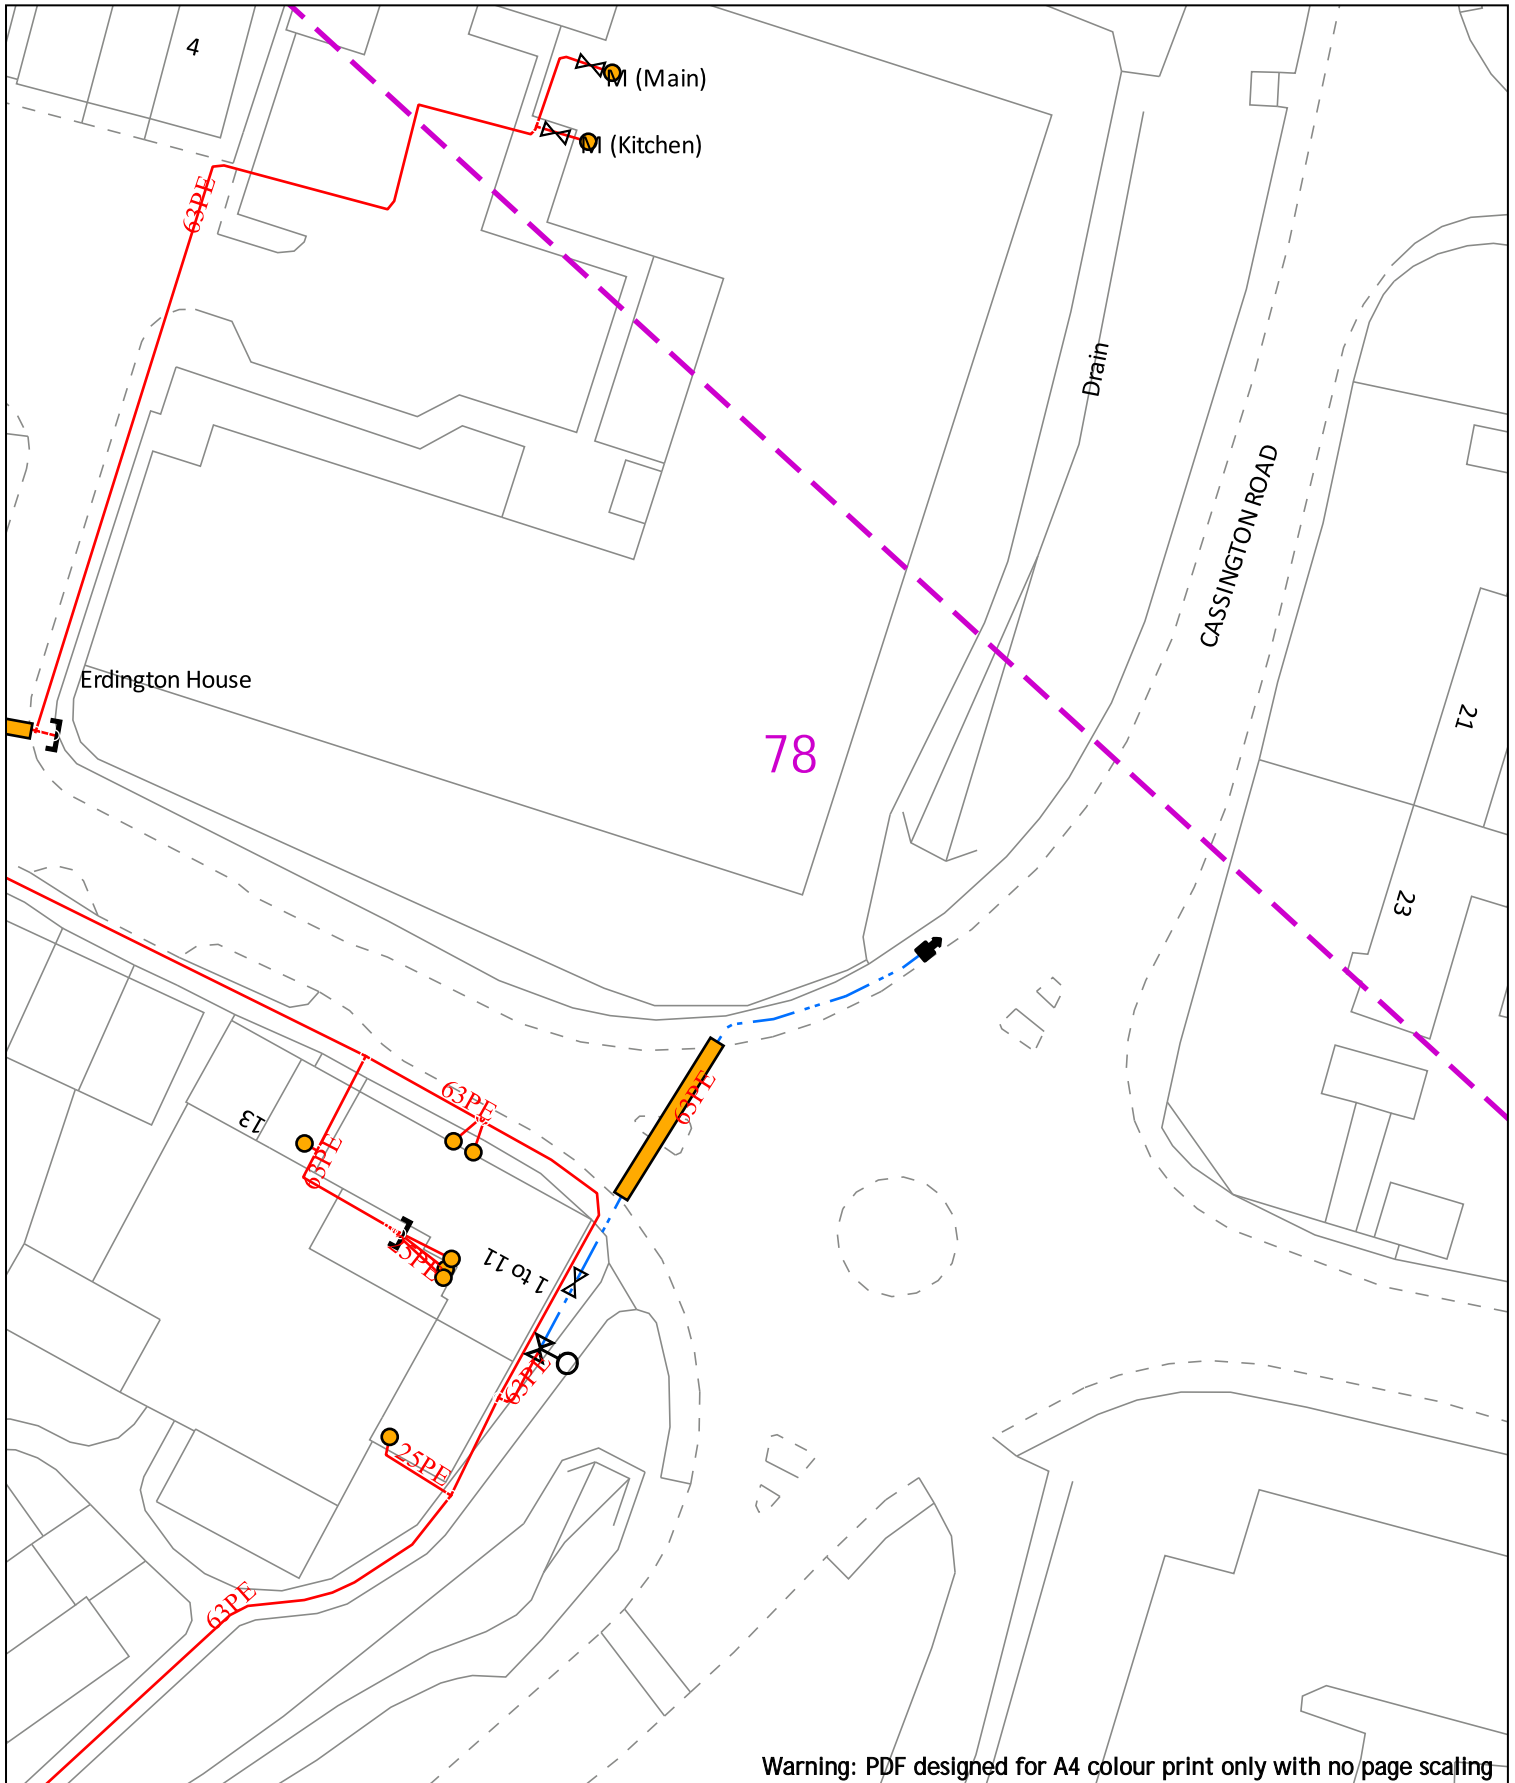

Warning: PDF designed for A4 colour print only with no page scaling

0 20m Dig Sites Area: Line:

	LP Main		Valve Closed		Reducer
	LP Service		Valve Open		Ducting
	MP Main		CSEP		Gas Supply Point
	MP Service		Pressure Reduction Station		
	IP Main		End Closure		

IMPORTANT NOTICES


- This information is given as a guide only and its accuracy cannot be guaranteed
- The plan only shows pipes owned by SSE Utility Solutions Limited, Indigo Pipelines Limited
- Service pipes etc. may not be shown but their presence should be anticipated
- You must use safe digging practices in accordance with H5(G)47 to establish the actual position of mains, services and other apparatus before any mechanical excavation is used
- It is your responsibility to ensure this information is provided to all persons working near our plant
- If in doubt call the SSE Enterprise Dial Before You Dig team on 0345 070 7386.

Please note: If you have overlaps or misalignments between base maps that make it difficult to understand please contact DBYDEnterpriseEnquiries@sse.com or call 0345 070 7386

Date Requested: 24/06/2022
 Job Reference: 25881050
 Site Location: 448447 212278
 Requested by: Mr Joe Shawyer
 Your Scheme/Reference: 31188_004

Scale: 1:500 (When plotted at A4)

Indigo Pipelines Ltd.
 Registered Office:
 Loddon Reach,
 Reading Road,
 Arborfield,
 Reading,
 Berkshire, RG2 9HU

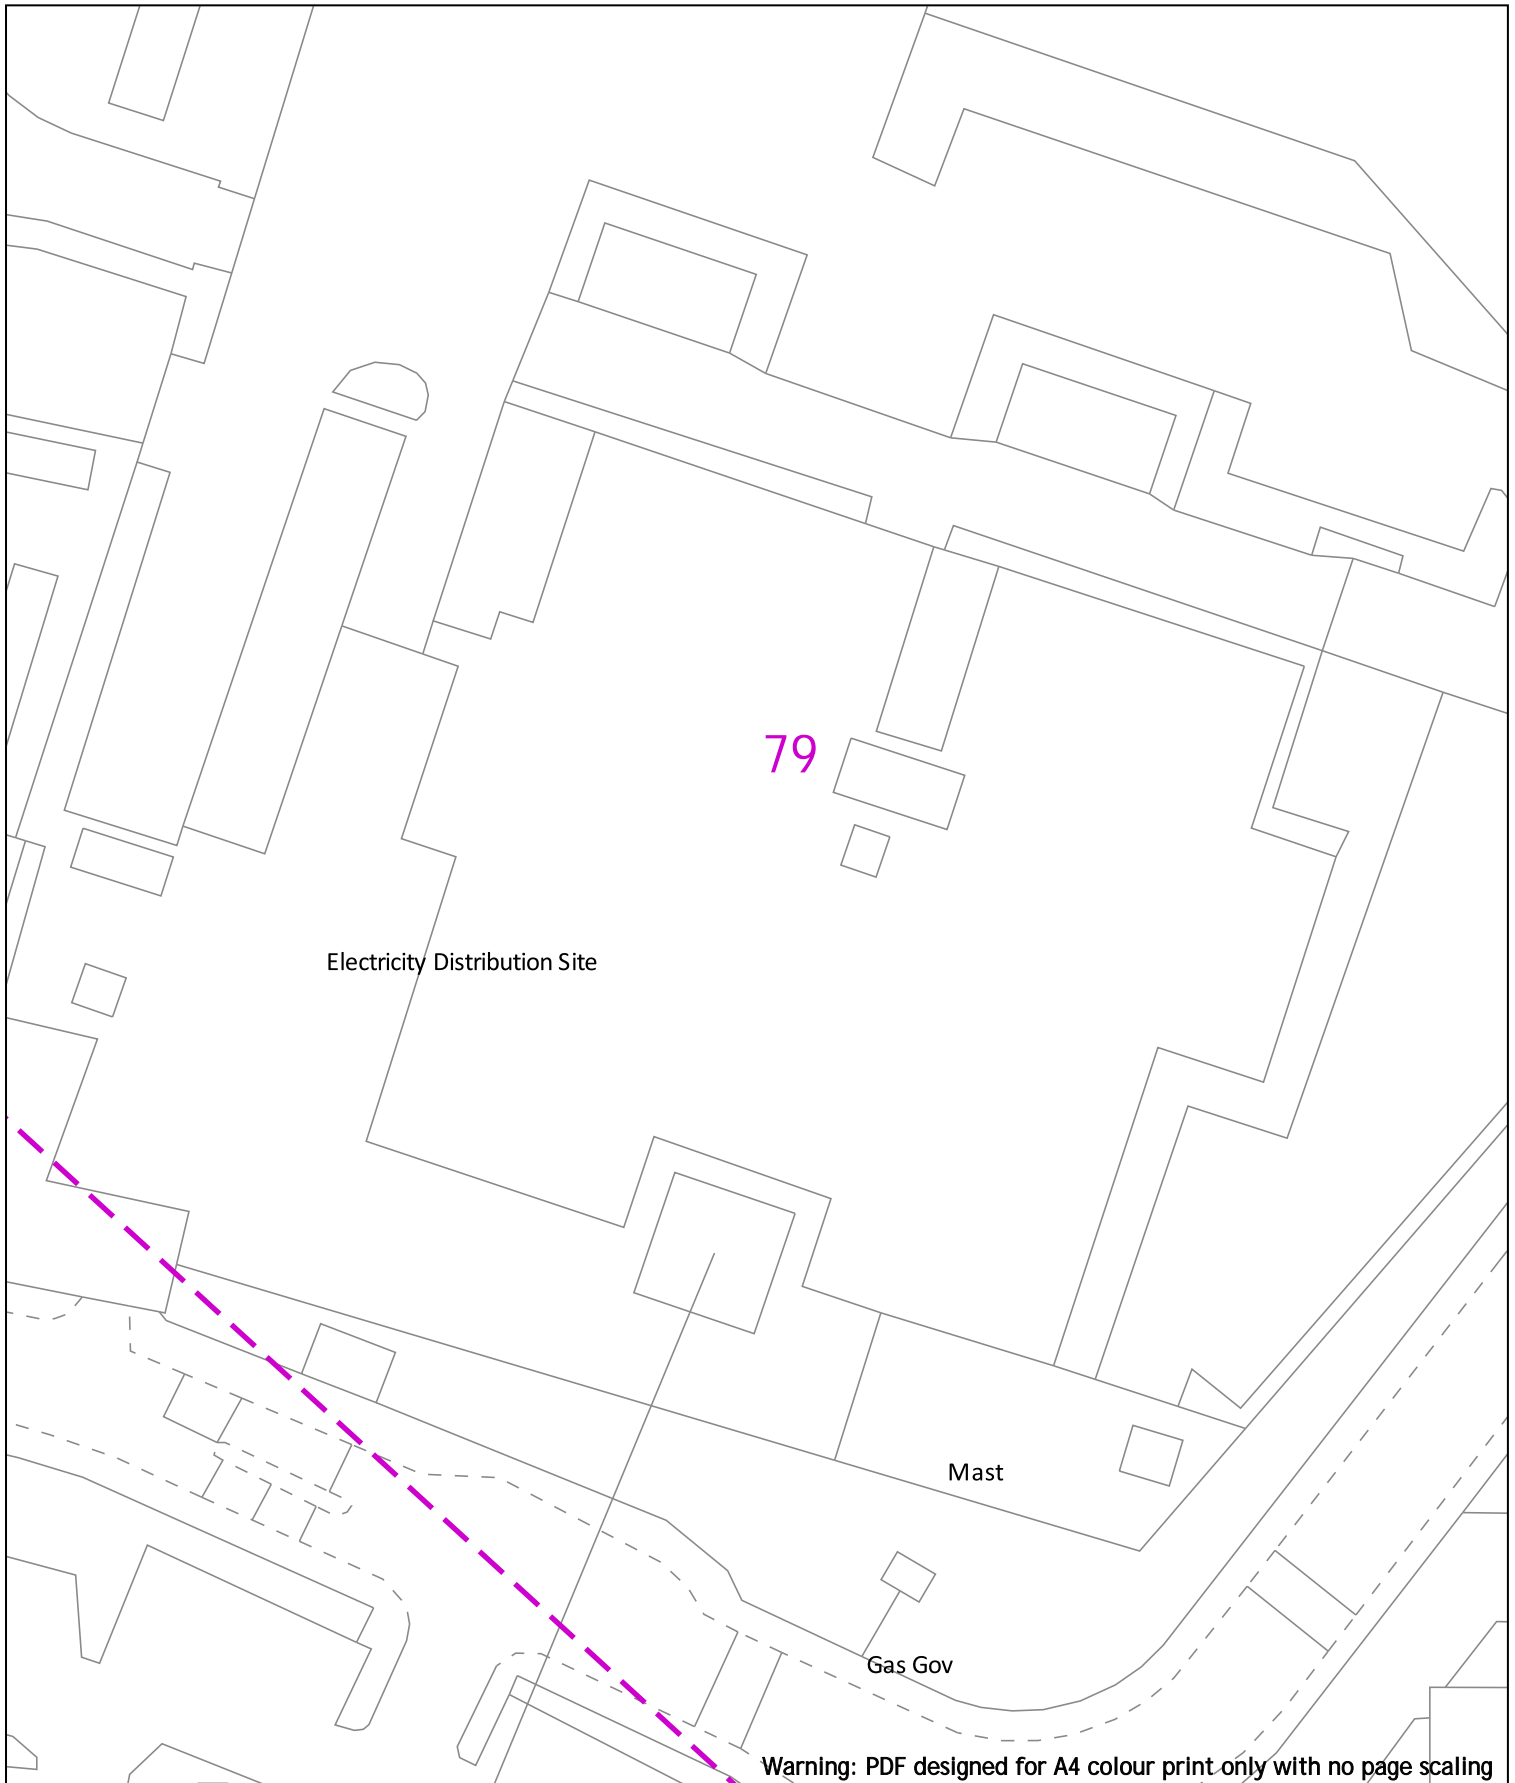

Warning: PDF designed for A4 colour print only with no page scaling

0 20m Dig Sites Area: Line:

LP Main	Valve Closed	Reducer
LP Service	Valve Open	Ducting
MP Main	CSEP	Gas Supply Point
MP Service	Pressure Reduction Station	
IP Main	End Closure	

IMPORTANT NOTICES


- This information is given as a guide only and its accuracy cannot be guaranteed
- The plan only shows pipes owned by SSE Utility Solutions Limited, Indigo Pipelines Limited
- Service pipes etc. may not be shown but their presence should be anticipated
- You must use safe digging practices in accordance with H5(G)47 to establish the actual position of mains, services and other apparatus before any mechanical excavation is used
- It is your responsibility to ensure this information is provided to all persons working near our plant
- If in doubt call the SSE Enterprise Dial Before You Dig team on 0345 070 7386.

Please note: If you have overlaps or misalignments between base maps that make it difficult to understand please contact DBYDEnterpriseEnquiries@sse.com or call 0345 070 7386

Date Requested: 24/06/2022
 Job Reference: 25881050
 Site Location: 448447 212278
 Requested by: Mr Joe Shawyer
 Your Scheme/Reference: 31188_004

Scale: 1:500 (When plotted at A4)

Indigo Pipelines Ltd.
 Registered Office:
 Loddon Reach,
 Reading Road,
 Arborfield,
 Reading,
 Berkshire, RG2 9HU

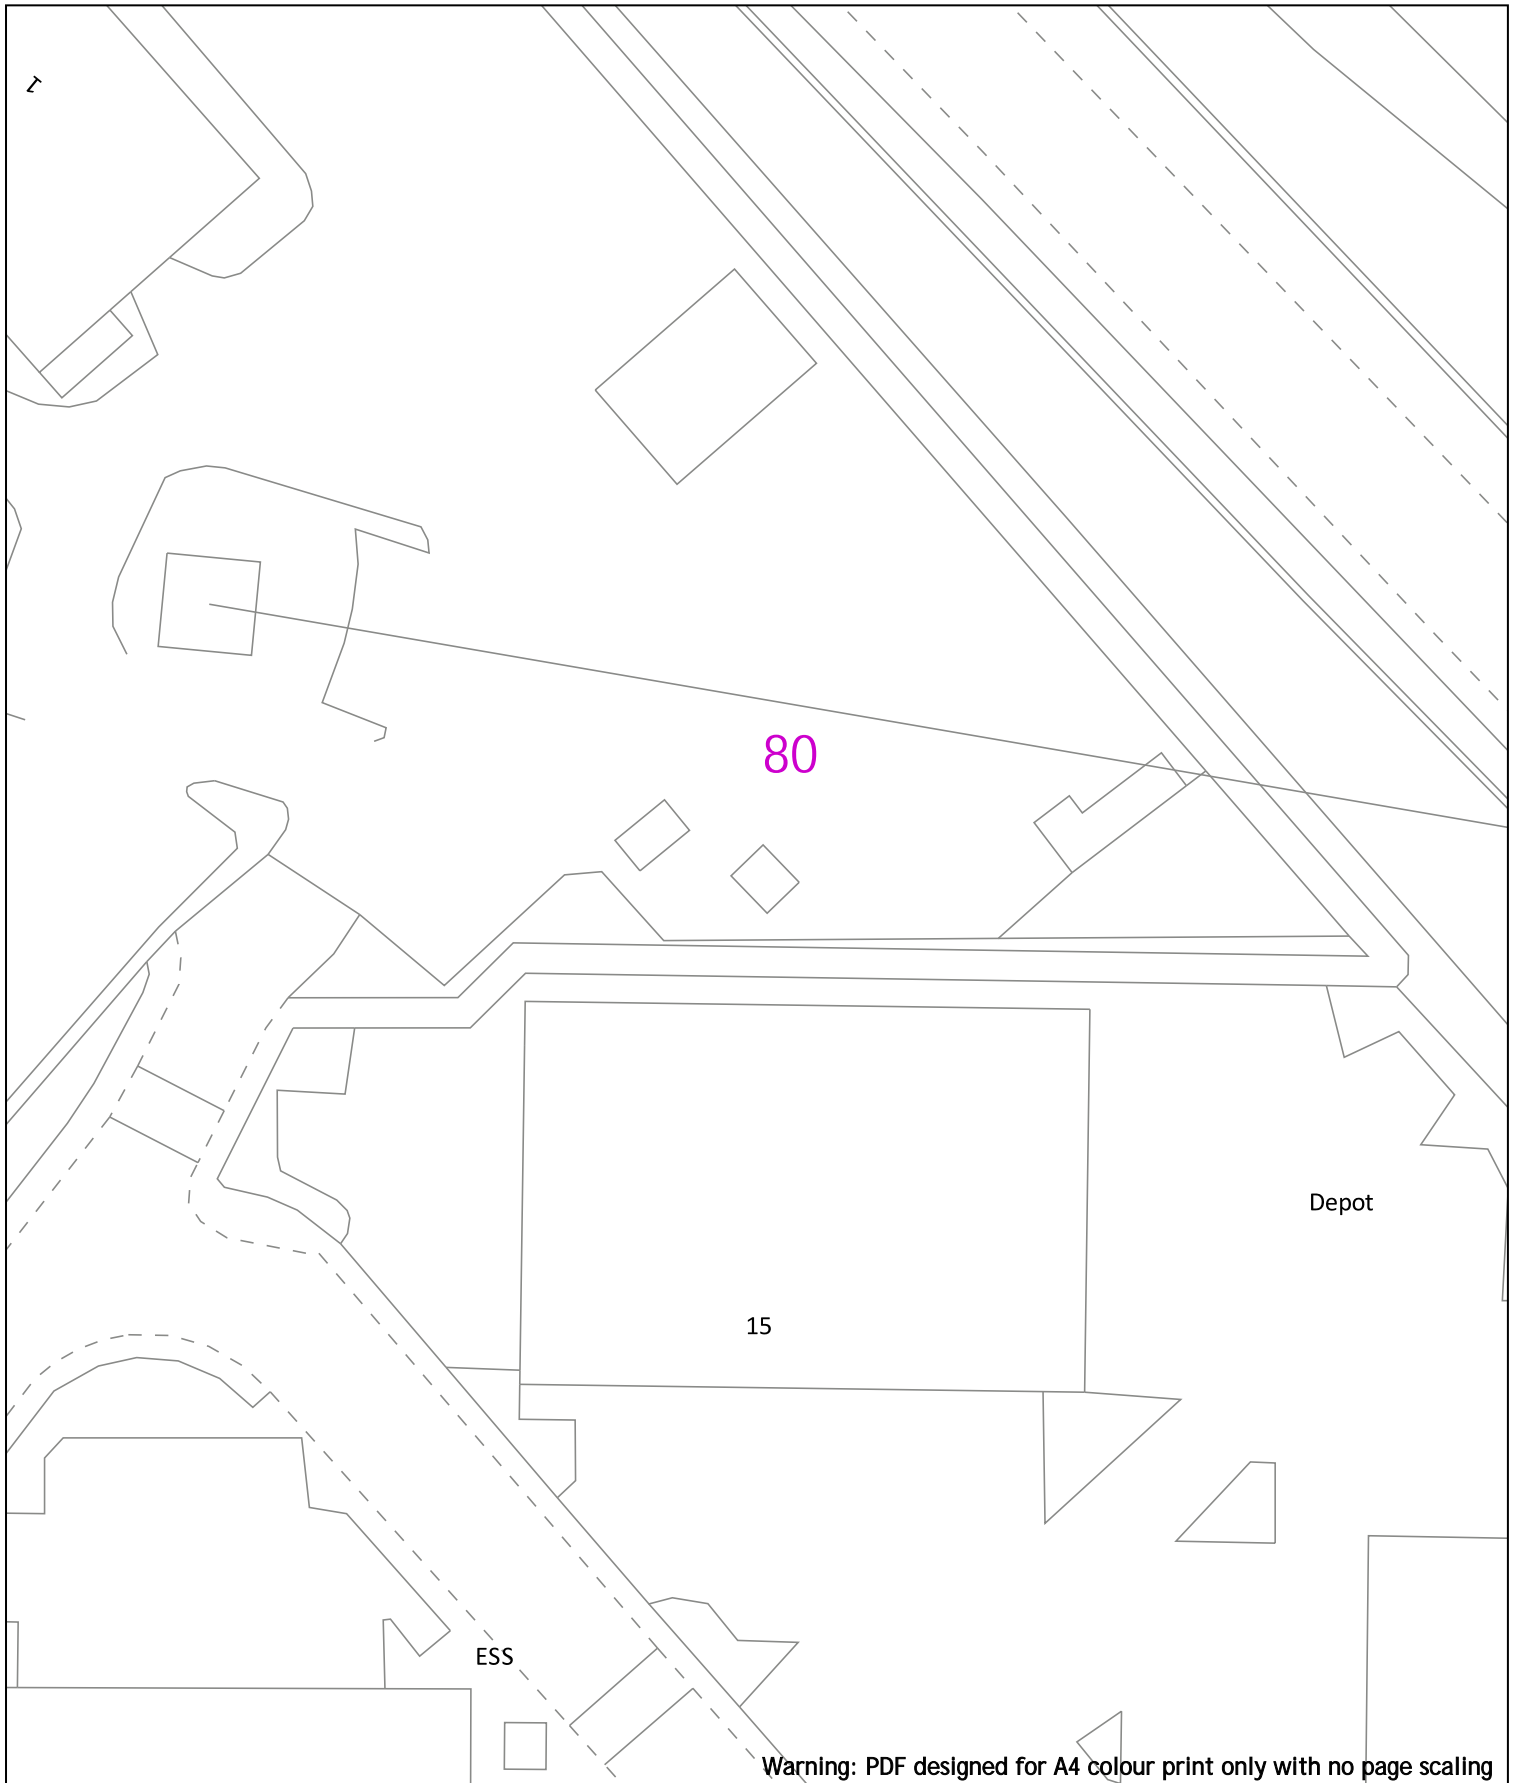

Warning: PDF designed for A4 colour print only with no page scaling

0 20m Dig Sites Area: Line:

LP Main	Valve Closed	Reducer
LP Service	Valve Open	Ducting
MP Main	CSEP	Gas Supply Point
MP Service	Pressure Reduction Station	
IP Main	End Closure	

IMPORTANT NOTICES

- This information is given as a guide only and its accuracy cannot be guaranteed
- The plan only shows pipes owned by SSE Utility Solutions Limited, Indigo Pipelines Limited
- Service pipes etc. may not be shown but their presence should be anticipated
- You must use safe digging practices in accordance with H5(G)47 to establish the actual position of mains, services and other apparatus before any mechanical excavation is used
- It is your responsibility to ensure this information is provided to all persons working near our plant
- If in doubt call the SSE Enterprise Dial Before You Dig team on 0345 070 7386.

Please note: If you have overlaps or misalignments between base maps that make it difficult to understand please contact DBYDEnterpriseEnquiries@sse.com or call 0345 070 7386

Date Requested: 24/06/2022
 Job Reference: 25881050
 Site Location: 448447 212278
 Requested by: Mr Joe Shawyer
 Your Scheme/Reference: 31188_004

Scale: 1:500 (When plotted at A4)



Indigo Pipelines Ltd.
 Registered Office:
 Loddon Reach,
 Reading Road,
 Arborfield,
 Reading,
 Berkshire, RG2 9HU




Pond

81








 





ETL

66.0m

Warning: PDF designed for A4 colour print only with no page scaling

0  20m Dig Sites Area:  Line: 

Date Requested: 24/06/2022
Job Reference: 25881050
Site Location: 448447 212278
Requested by: Mr Joe Shawyer
Your Scheme/Reference: 31188_004

 	LP Main		Valve Closed		Reducer
	LP Service		Valve Open		Ducting
	MP Main		CSEP		Gas Supply Point
	MP Service		Pressure Reduction Station		
	IP Main		End Closure		

IMPORTANT NOTICES


- This information is given as a guide only and its accuracy cannot be guaranteed
- The plan only shows pipes owned by SSE Utility Solutions Limited, Indigo Pipelines Limited
- Service pipes etc. may not be shown but their presence should be anticipated
- You must use safe digging practices in accordance with H5(G)47 to establish the actual position of mains, services and other apparatus before any mechanical excavation is used
- It is your responsibility to ensure this information is provided to all persons working near our plant
- If in doubt call the SSE Enterprise Dial Before You Dig team on 0345 070 7386.

Please note: If you have overlaps or misalignments between base maps that make it difficult to understand please contact DBYDEnterpriseEnquiries@sse.com or call 0345 070 7386



Indigo Pipelines Ltd.
Registered Office:
Loddon Reach,
Reading Road,
Arborfield,
Reading,
Berkshire, RG2 9HU

Scale: 1:500 (When plotted at A4)

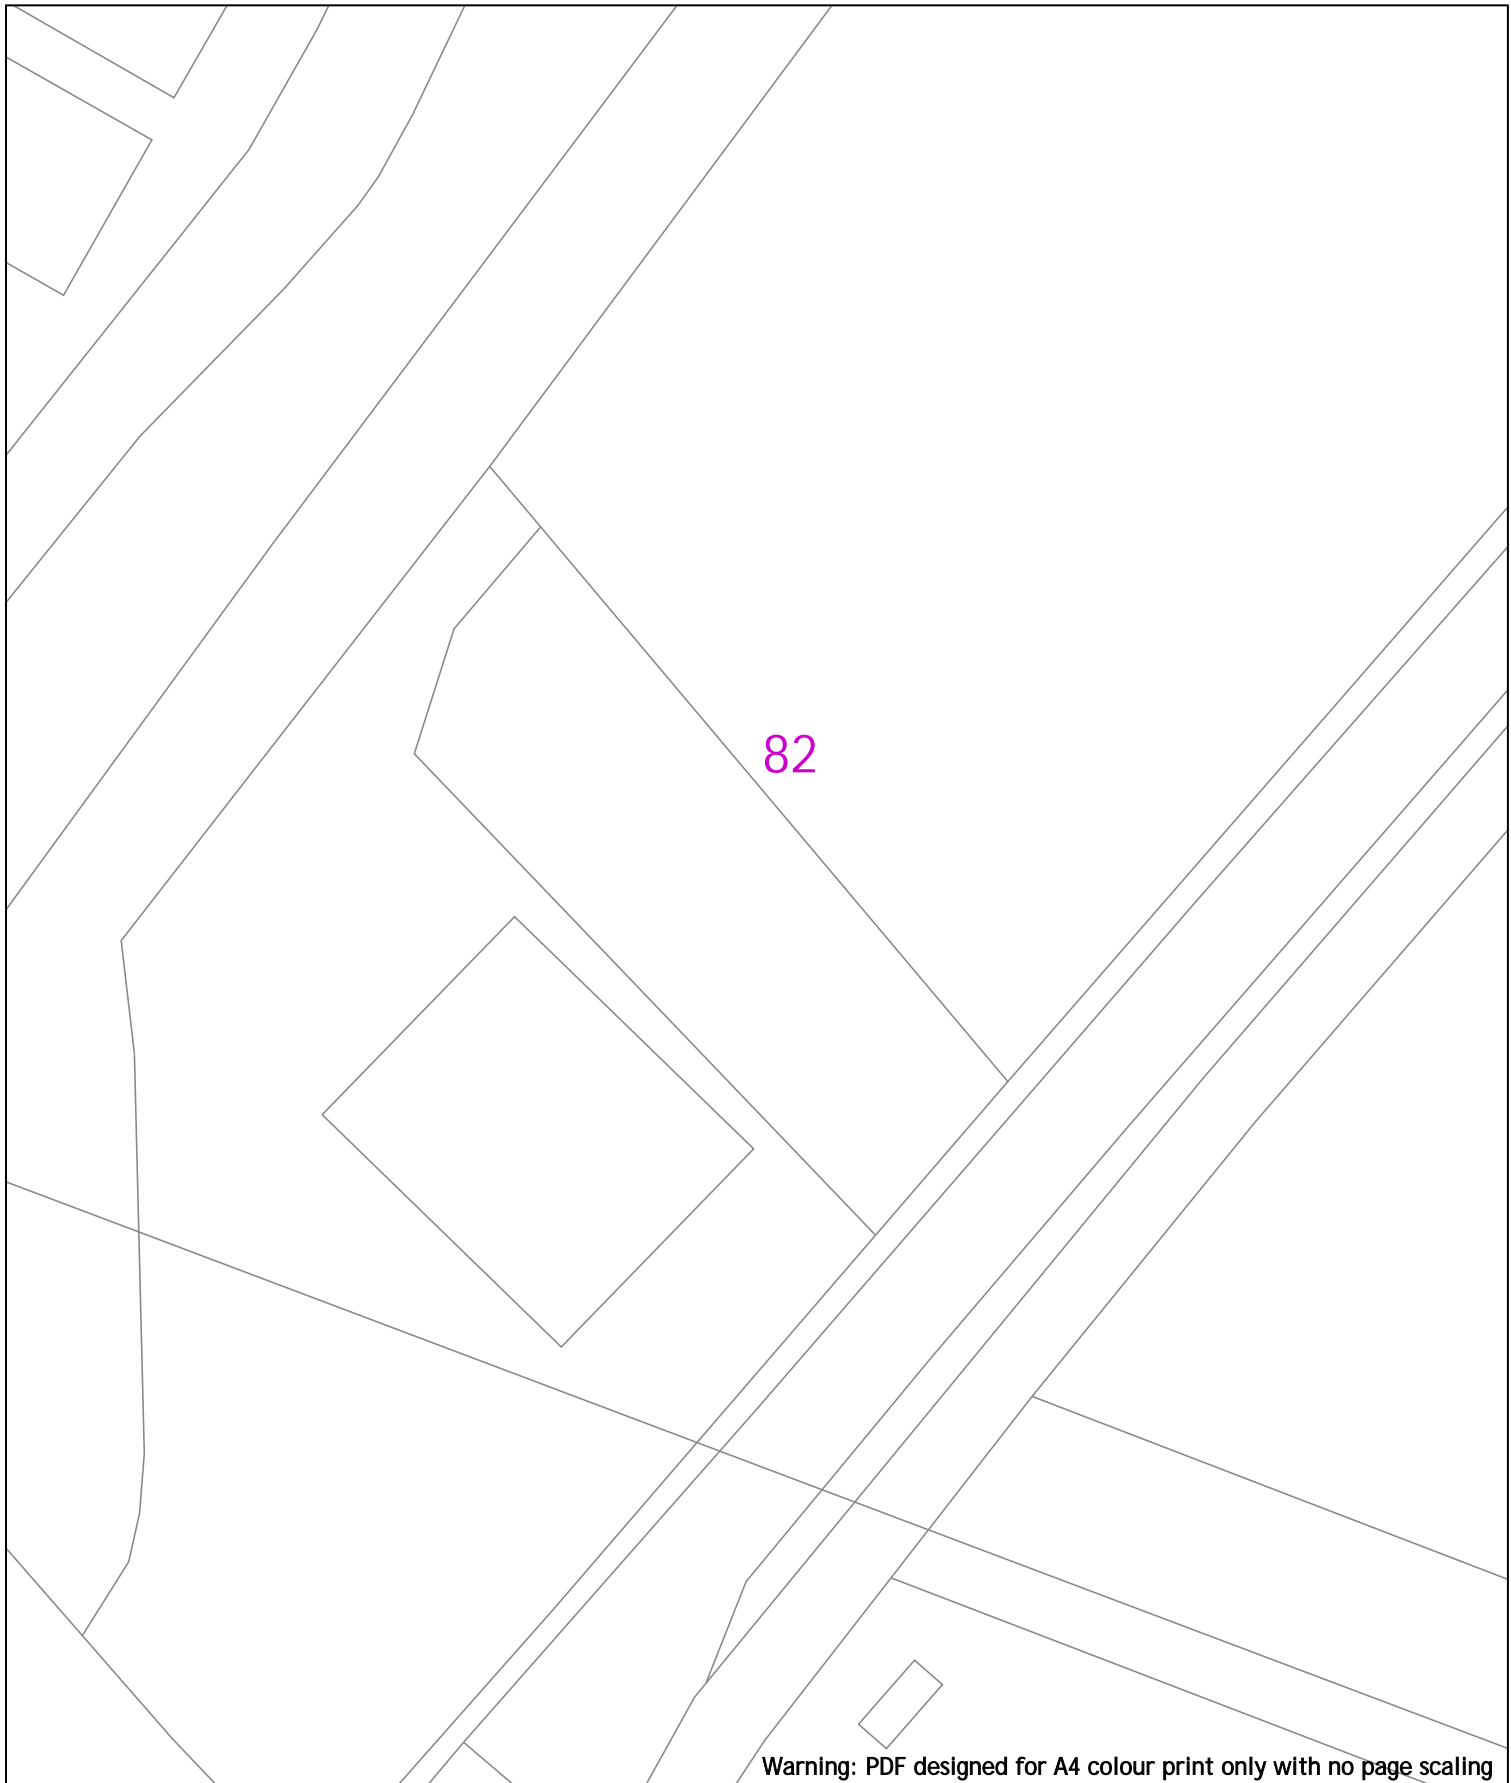

Warning: PDF designed for A4 colour print only with no page scaling

0 20m Dig Sites Area: Line:

	LP Main		Valve Closed		Reducer
	LP Service		Valve Open		Ducting
	MP Main		CSEP		Gas Supply Point
	MP Service		Pressure Reduction Station		
	IP Main		End Closure		

IMPORTANT NOTICES


- This information is given as a guide only and its accuracy cannot be guaranteed
- The plan only shows pipes owned by SSE Utility Solutions Limited, Indigo Pipelines Limited
- Service pipes etc. may not be shown but their presence should be anticipated
- You must use safe digging practices in accordance with H5(G)47 to establish the actual position of mains, services and other apparatus before any mechanical excavation is used
- It is your responsibility to ensure this information is provided to all persons working near our plant
- If in doubt call the SSE Enterprise Dial Before You Dig team on 0345 070 7386.

Please note: If you have overlaps or misalignments between base maps that make it difficult to understand please contact DBYDEnterpriseEnquiries@sse.com or call 0345 070 7386

Date Requested: 24/06/2022
 Job Reference: 25881050
 Site Location: 448447 212278
 Requested by: Mr Joe Shawyer
 Your Scheme/Reference: 31188_004

Scale: 1:500 (When plotted at A4)

Indigo Pipelines Ltd.
 Registered Office:
 Loddon Reach,
 Reading Road,
 Arborfield,
 Reading,
 Berkshire, RG2 9HU

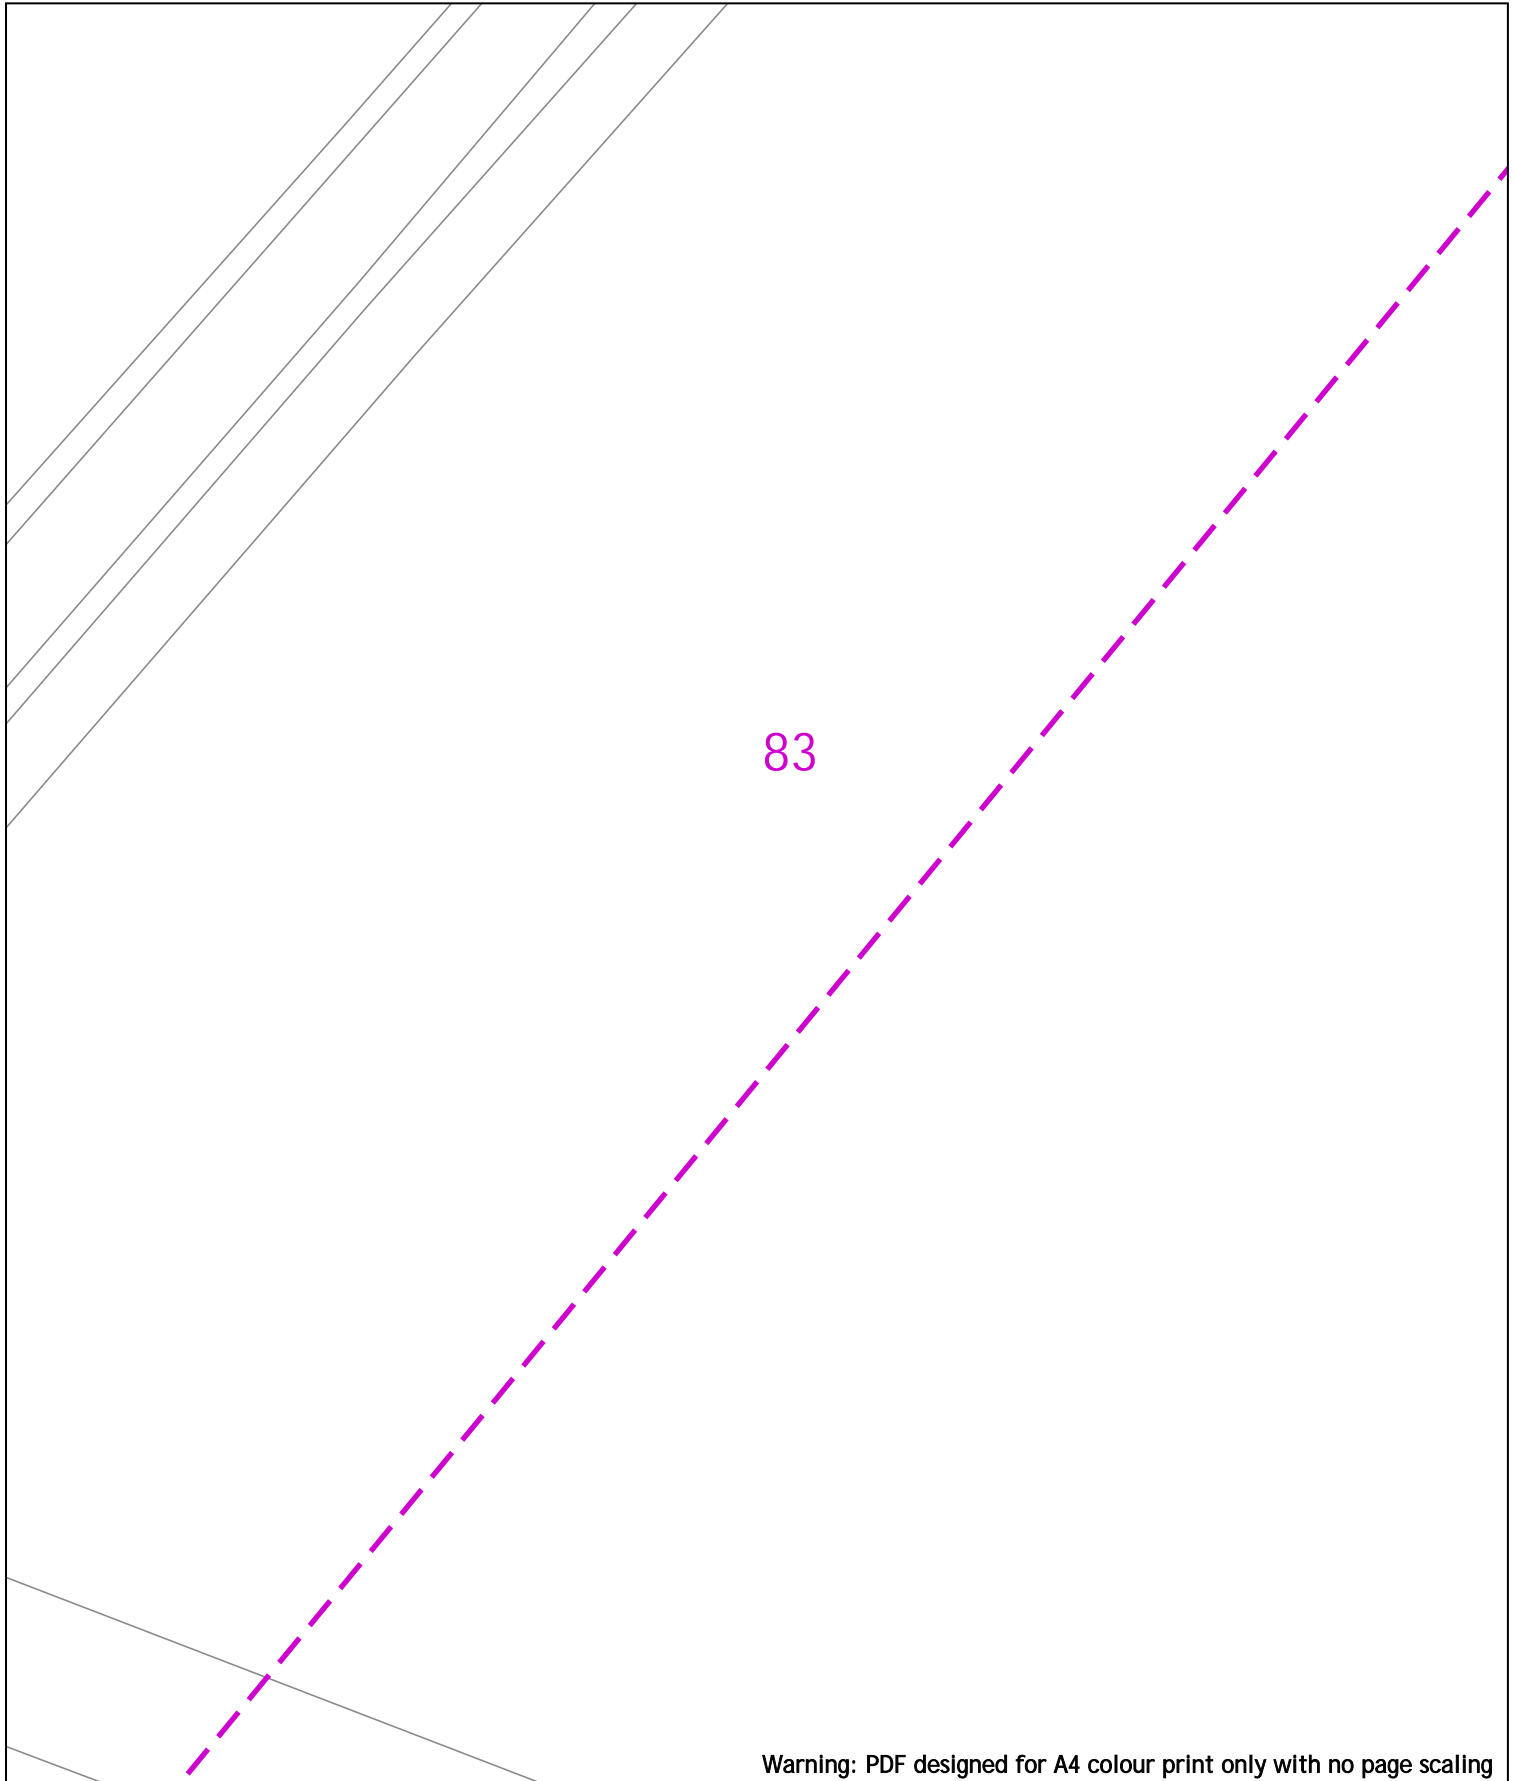














Warning: PDF designed for A4 colour print only with no page scaling

<p>0 20m Dig Sites Area: Line: </p>	<p>Date Requested: 24/06/2022 Job Reference: 25881050 Site Location: 448447 212278 Requested by: Mr Joe Shawyer Your Scheme/Reference: 31188_004</p>	<p> </p>															
<p>Scale: 1:500 (When plotted at A4)</p>	<table border="0"> <tr> <td> LP Main</td> <td> Valve Closed</td> <td> Reducer</td> </tr> <tr> <td> LP Service</td> <td> Valve Open</td> <td> Ducting</td> </tr> <tr> <td> MP Main</td> <td> CSEP</td> <td> Gas Supply Point</td> </tr> <tr> <td> MP Service</td> <td> Pressure Reduction Station</td> <td></td> </tr> <tr> <td> IP Main</td> <td> End Closure</td> <td></td> </tr> </table>	LP Main	Valve Closed	Reducer	LP Service	Valve Open	Ducting	MP Main	CSEP	Gas Supply Point	MP Service	Pressure Reduction Station		IP Main	End Closure		<p>Indigo Pipelines Ltd. Registered Office: Loddon Reach, Reading Road, Arborfield, Reading, Berkshire, RG2 9HU</p>
LP Main	Valve Closed	Reducer															
LP Service	Valve Open	Ducting															
MP Main	CSEP	Gas Supply Point															
MP Service	Pressure Reduction Station																
IP Main	End Closure																
<p>IMPORTANT NOTICES</p> <ul style="list-style-type: none"> This information is given as a guide only and its accuracy cannot be guaranteed The plan only shows pipes owned by SSE Utility Solutions Limited, Indigo Pipelines Limited Service pipes etc. may not be shown but their presence should be anticipated You must use safe digging practices in accordance with H5(G)47 to establish the actual position of mains, services and other apparatus before any mechanical excavation is used It is your responsibility to ensure this information is provided to all persons working near our plant If in doubt call the SSE Enterprise Dial Before You Dig team on 0345 070 7386. <p><small>Please note: If you have overlaps or misalignments between base maps that make it difficult to understand please contact DBYDEnterpriseEnquiries@sse.com or call 0345 070 7386</small></p> <p><small>Crown Copyright. © - Reproduced by permission of Ordnance Survey on behalf of HMSO, and database right 2019. All rights reserved. Ordnance Survey licence number 100030994 (ESRI) and 100048660 (direct). Plans generated by DigSAFE Pro™ software provided by LinesearchbeforeUdig.</small></p>																	

Warning: PDF designed for A4 colour print only with no page scaling

0  20m Dig Sites Area:  Line: 

Date Requested: 24/06/2022
 Job Reference: 25881050
 Site Location: 448447 212278
 Requested by: Mr Joe Shawyer
 Your Scheme/Reference: 31188_004

 	LP Main		Valve Closed		Reducer
	LP Service		Valve Open		Ducting
	MP Main		CSEP		Gas Supply Point
	MP Service		Pressure Reduction Station		
	IP Main		End Closure		

IMPORTANT NOTICES


- This information is given as a guide only and its accuracy cannot be guaranteed
- The plan only shows pipes owned by SSE Utility Solutions Limited, Indigo Pipelines Limited
- Service pipes etc. may not be shown but their presence should be anticipated
- You must use safe digging practices in accordance with H5(G)47 to establish the actual position of mains, services and other apparatus before any mechanical excavation is used
- It is your responsibility to ensure this information is provided to all persons working near our plant
- If in doubt call the SSE Enterprise Dial Before You Dig team on 0345 070 7386.

Please note: If you have overlaps or misalignments between base maps that make it difficult to understand please contact DBYDEnterpriseEnquiries@sse.com or call 0345 070 7386



Indigo Pipelines Ltd.
 Registered Office:
 Loddon Reach,
 Reading Road,
 Arborfield,
 Reading,
 Berkshire, RG2 9HU

Scale: 1:500 (When plotted at A4)

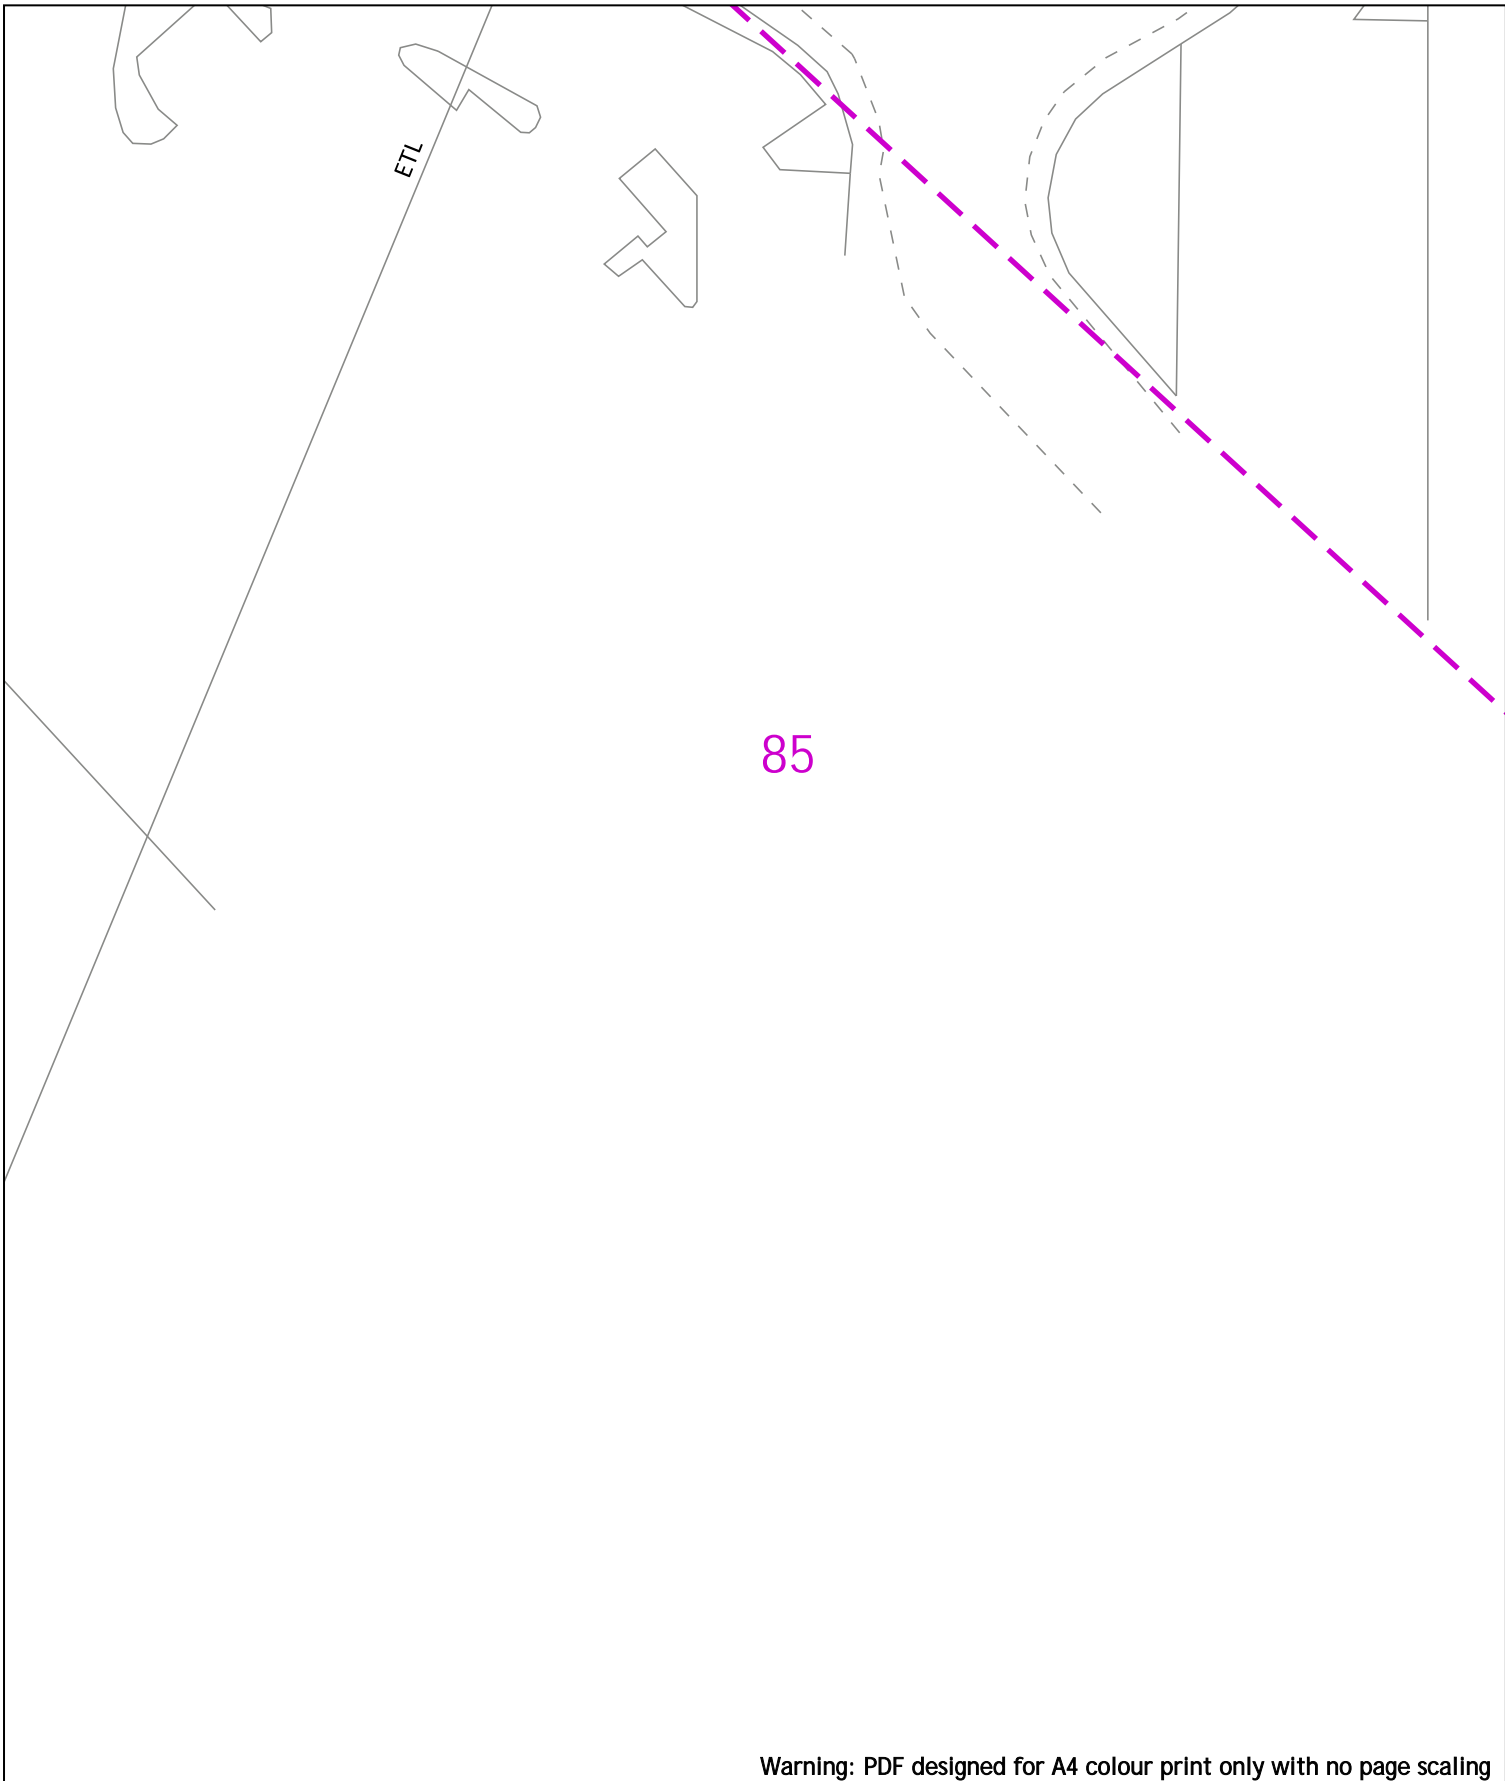

Warning: PDF designed for A4 colour print only with no page scaling

0 20m Dig Sites Area: Line:

Date Requested: 24/06/2022
 Job Reference: 25881050
 Site Location: 448447 212278
 Requested by: Mr Joe Shawyer
 Your Scheme/Reference: 31188_004

	LP Main		Valve Closed		Reducer
	LP Service		Valve Open		Ducting
	MP Main		CSEP		Gas Supply Point
	MP Service		Pressure Reduction Station		
	IP Main		End Closure		


IMPORTANT NOTICES

- This information is given as a guide only and its accuracy cannot be guaranteed
- The plan only shows pipes owned by SSE Utility Solutions Limited, Indigo Pipelines Limited
- Service pipes etc. may not be shown but their presence should be anticipated
- You must use safe digging practices in accordance with H5(G)47 to establish the actual position of mains, services and other apparatus before any mechanical excavation is used
- It is your responsibility to ensure this information is provided to all persons working near our plant
- If in doubt call the SSE Enterprise Dial Before You Dig team on 0345 070 7386.

Please note: If you have overlaps or misalignments between base maps that make it difficult to understand please contact DBYDEnterpriseEnquiries@sse.com or call 0345 070 7386



Indigo Pipelines Ltd.
 Registered Office:
 Loddon Reach,
 Reading Road,
 Arborfield,
 Reading,
 Berkshire, RG2 9HU

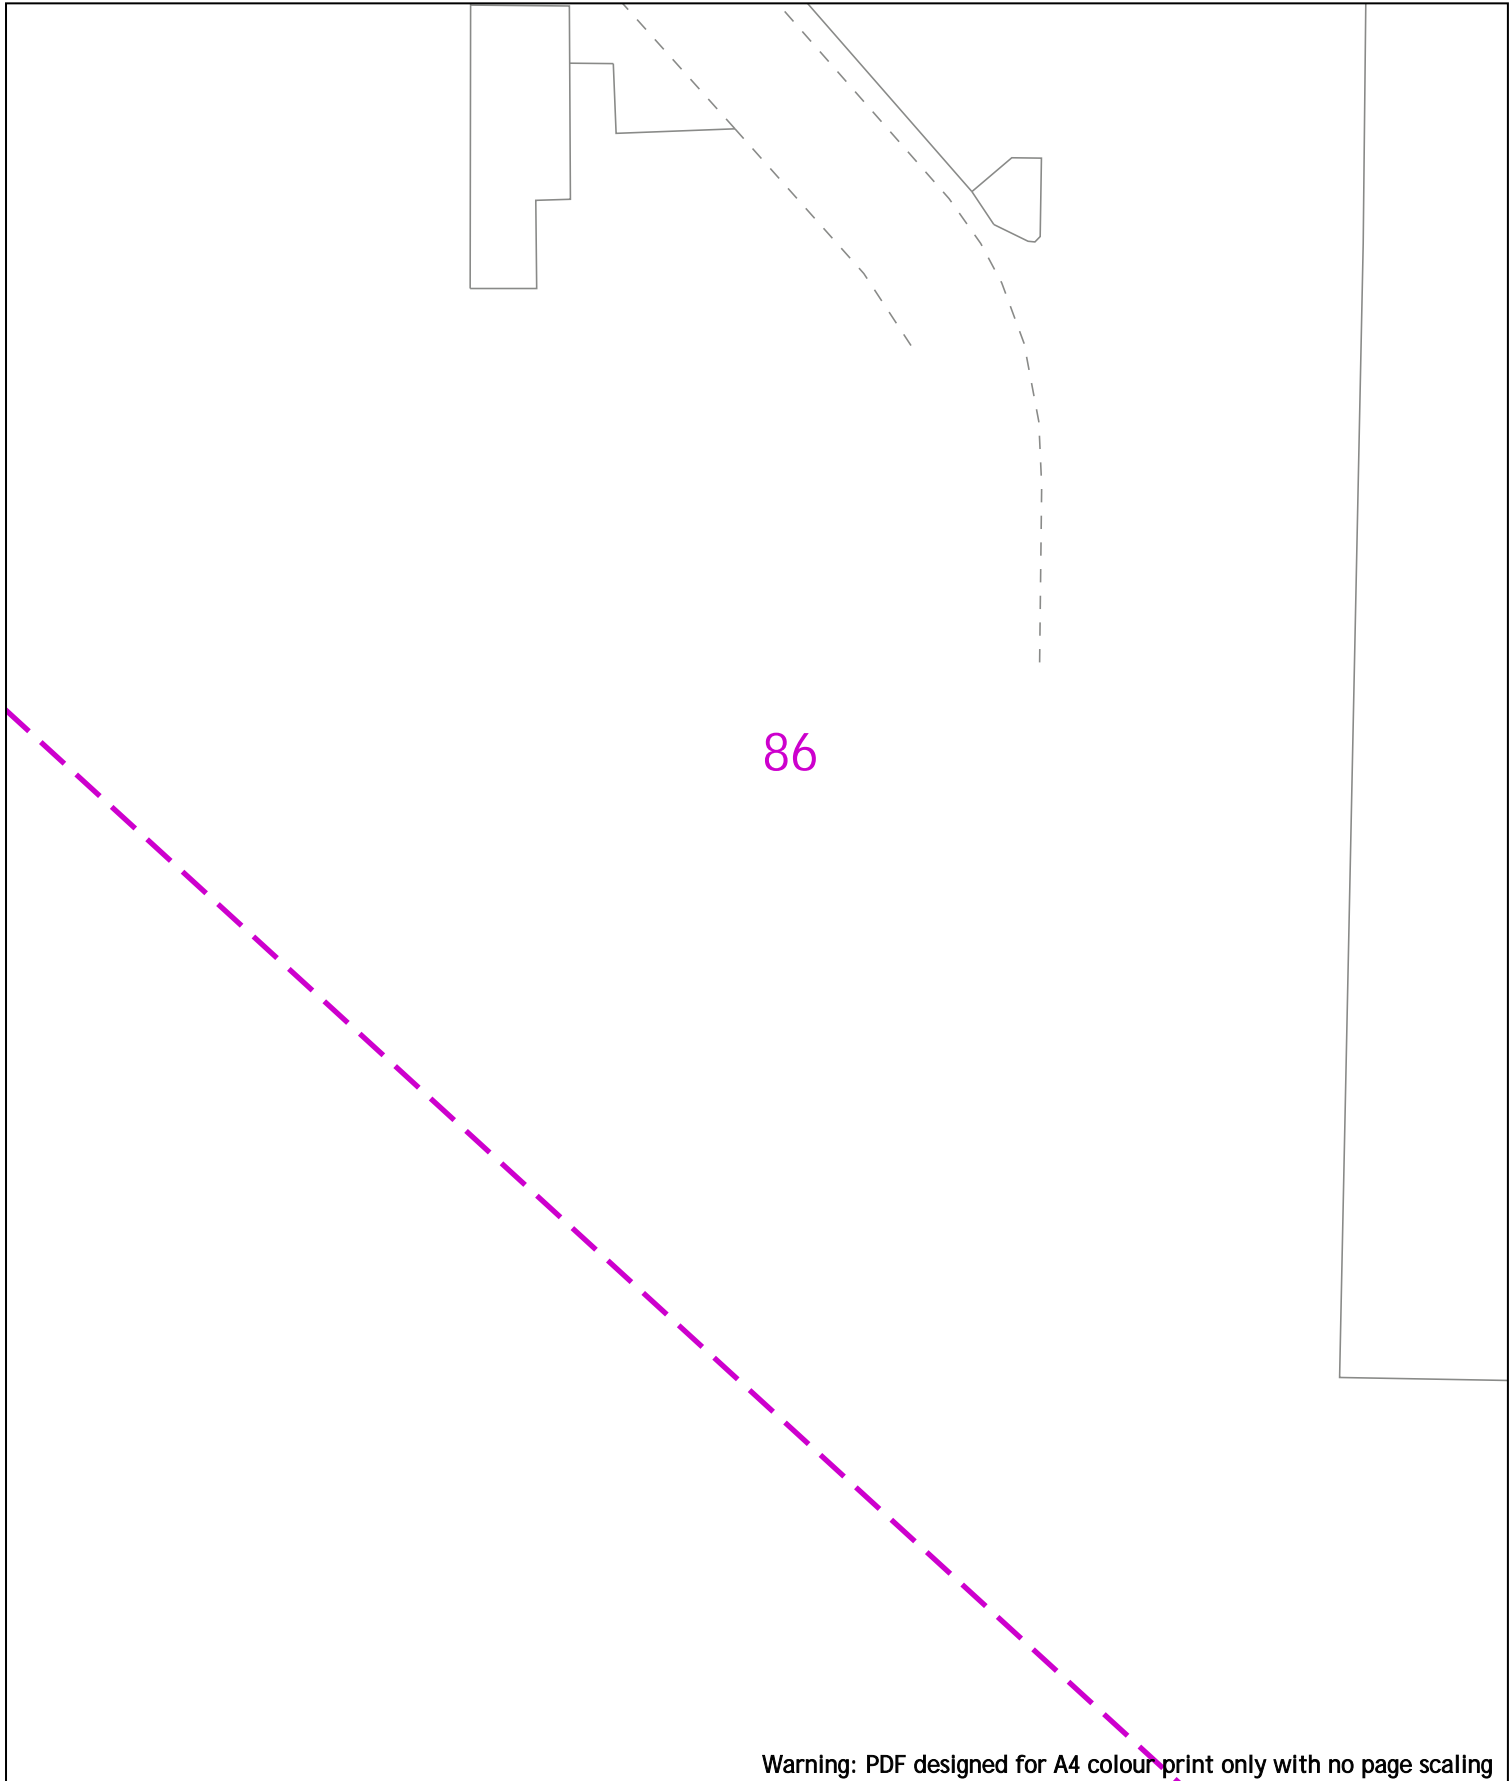

86

Warning: PDF designed for A4 colour print only with no page scaling

0 20m Dig Sites Area: Line:

LP Main	Valve Closed	Reducer
LP Service	Valve Open	Ducting
MP Main	CSEP	Gas Supply Point
MP Service	Pressure Reduction Station	
IP Main	End Closure	

IMPORTANT NOTICES

- This information is given as a guide only and its accuracy cannot be guaranteed
- The plan only shows pipes owned by SSE Utility Solutions Limited, Indigo Pipelines Limited
- Service pipes etc. may not be shown but their presence should be anticipated
- You must use safe digging practices in accordance with H5(G)47 to establish the actual position of mains, services and other apparatus before any mechanical excavation is used
- It is your responsibility to ensure this information is provided to all persons working near our plant
- If in doubt call the SSE Enterprise Dial Before You Dig team on 0345 070 7386.

Please note: If you have overlaps or misalignments between base maps that make it difficult to understand please contact DBYDEnterpriseEnquiries@sse.com or call 0345 070 7386




Scale: 1:500 (When plotted at A4)














Indigo Pipelines Ltd.
Registered Office:
Loddon Reach,
Reading Road,
Arborfield,
Reading,
Berkshire, RG2 9HU

A44

87

Warning: PDF designed for A4 colour print only with no page scaling

0  20m Dig Sites Area:  Line: 

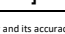 LP Main	 Valve Closed	 Reducer
 LP Service	 Valve Open	 Ducting
 MP Main	 CSEP	 Gas Supply Point
 MP Service	 Pressure Reduction Station	
 IP Main	 End Closure	




Indigo Pipelines Ltd.
 Registered Office:
 Loddon Reach,
 Reading Road,
 Arborfield,
 Reading,
 Berkshire, RG2 9HU

IMPORTANT NOTICES

- This information is given as a guide only and its accuracy cannot be guaranteed
- The plan only shows pipes owned by SSE Utility Solutions Limited, Indigo Pipelines Limited
- Service pipes etc. may not be shown but their presence should be anticipated
- You must use safe digging practices in accordance with H5(G)47 to establish the actual position of mains, services and other apparatus before any mechanical excavation is used
- It is your responsibility to ensure this information is provided to all persons working near our plant
- If in doubt call the SSE Enterprise Dial Before You Dig team on 0345 070 7386.

Please note: If you have overlaps or misalignments between base maps that make it difficult to understand please contact DBYDEnterpriseEnquiries@sse.com or call 0345 070 7386

Scale: 1:500 (When plotted at A4)

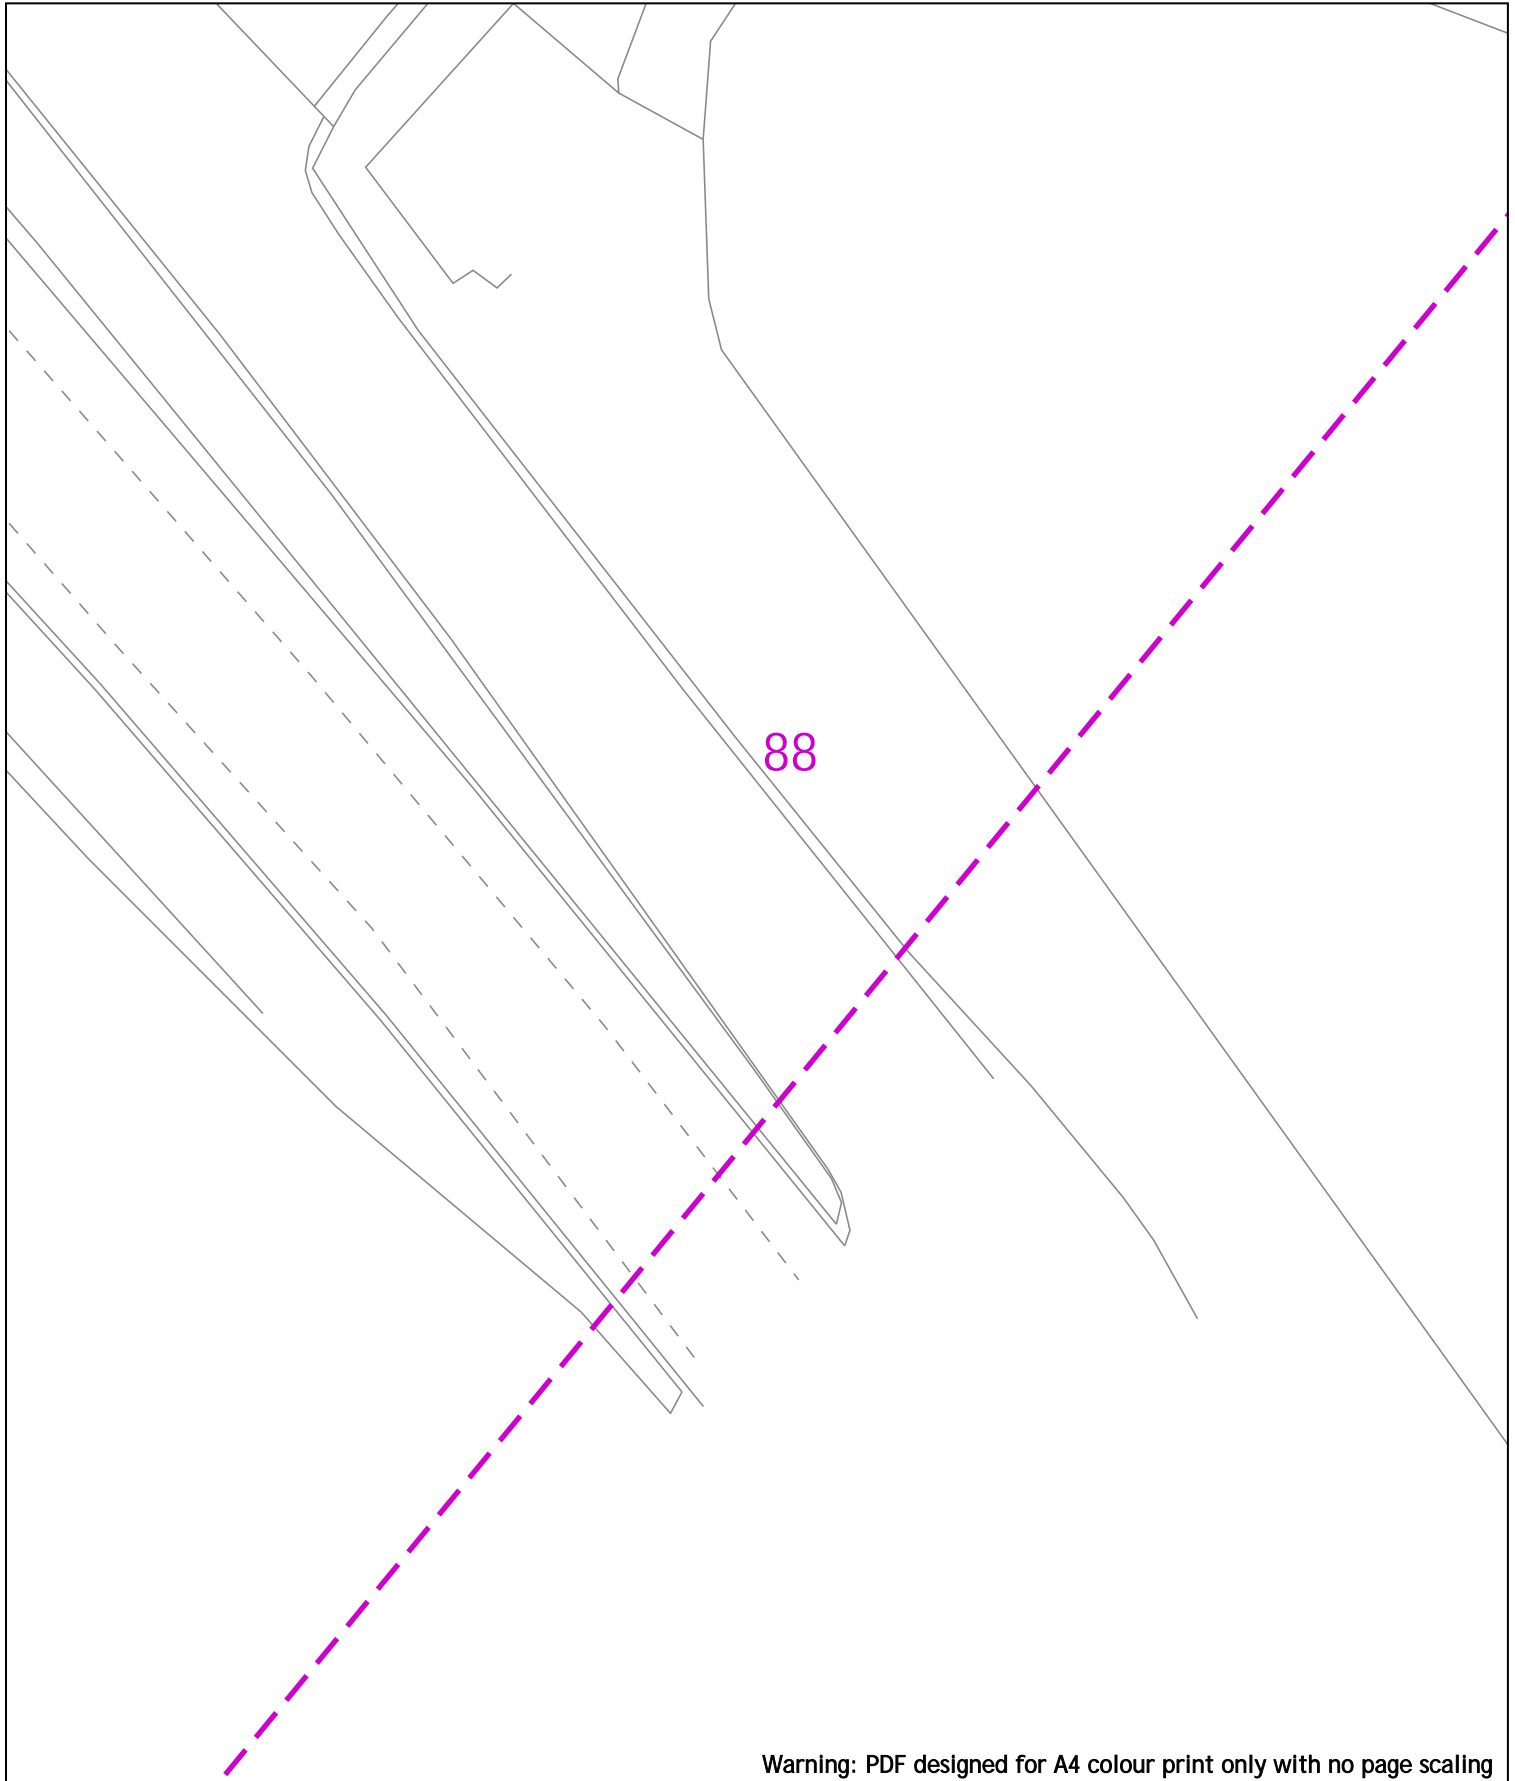

Warning: PDF designed for A4 colour print only with no page scaling

0 20m Dig Sites Area: Line:

LP Main	Valve Closed	Reducer
LP Service	Valve Open	Ducting
MP Main	CSEP	Gas Supply Point
MP Service	Pressure Reduction Station	
IP Main	End Closure	

IMPORTANT NOTICES

- This information is given as a guide only and its accuracy cannot be guaranteed
- The plan only shows pipes owned by SSE Utility Solutions Limited, Indigo Pipelines Limited
- Service pipes etc. may not be shown but their presence should be anticipated
- You must use safe digging practices in accordance with H5(G)47 to establish the actual position of mains, services and other apparatus before any mechanical excavation is used
- It is your responsibility to ensure this information is provided to all persons working near our plant
- If in doubt call the SSE Enterprise Dial Before You Dig team on 0345 070 7386.


Please note: If you have overlaps or misalignments between base maps that make it difficult to understand please contact DBYDEnterpriseEnquiries@sse.com or call 0345 070 7386

Date Requested: 24/06/2022
 Job Reference: 25881050
 Site Location: 448447 212278
 Requested by: Mr Joe Shawyer
 Your Scheme/Reference: 31188_004














Scale: 1:500 (When plotted at A4)

Indigo Pipelines Ltd.
 Registered Office:
 Loddon Reach,
 Reading Road,
 Arborfield,
 Reading,
 Berkshire, RG2 9HU

Warning: PDF designed for A4 colour print only with no page scaling

0  20m Dig Sites Area:  Line: 

Date Requested: 24/06/2022
 Job Reference: 25881050
 Site Location: 448447 212278
 Requested by: Mr Joe Shawyer
 Your Scheme/Reference: 31188_004

 	LP Main		Valve Closed		Reducer
	LP Service		Valve Open		Ducting
	MP Main		CSEP		Gas Supply Point
	MP Service		Pressure Reduction Station		
	IP Main		End Closure		

IMPORTANT NOTICES

- This information is given as a guide only and its accuracy cannot be guaranteed
- The plan only shows pipes owned by SSE Utility Solutions Limited, Indigo Pipelines Limited
- Service pipes etc. may not be shown but their presence should be anticipated
- You must use safe digging practices in accordance with H5(G)47 to establish the actual position of mains, services and other apparatus before any mechanical excavation is used
- It is your responsibility to ensure this information is provided to all persons working near our plant
- If in doubt call the SSE Enterprise Dial Before You Dig team on 0345 070 7386.

Please note: If you have overlaps or misalignments between base maps that make it difficult to understand please contact DBYDEnterpriseEnquiries@sse.com or call 0345 070 7386




Indigo Pipelines Ltd.
 Registered Office:
 Loddon Reach,
 Reading Road,
 Arborfield,
 Reading,
 Berkshire, RG2 9HU














Scale: 1:500 (When plotted at A4)

90

Warning: PDF designed for A4 colour print only with no page scaling

0  20m Dig Sites Area:  Line: 

Date Requested: 24/06/2022
Job Reference: 25881050
Site Location: 448447 212278
Requested by: Mr Joe Shawyer
Your Scheme/Reference: 31188_004

  LP Main	 Valve Closed	 Reducer
 LP Service	 Valve Open	 Ducting
 MP Main	 CSEP	 Gas Supply Point
 MP Service	 Pressure Reduction Station	
 IP Main	 End Closure	

IMPORTANT NOTICES


- This information is given as a guide only and its accuracy cannot be guaranteed
- The plan only shows pipes owned by SSE Utility Solutions Limited, Indigo Pipelines Limited
- Service pipes etc. may not be shown but their presence should be anticipated
- You must use safe digging practices in accordance with H5(G)47 to establish the actual position of mains, services and other apparatus before any mechanical excavation is used
- It is your responsibility to ensure this information is provided to all persons working near our plant
- If in doubt call the SSE Enterprise Dial Before You Dig team on 0345 070 7386.

Please note: If you have overlaps or misalignments between base maps that make it difficult to understand please contact DBYDEnterpriseEnquiries@sse.com or call 0345 070 7386



Indigo Pipelines Ltd.
Registered Office:
Loddon Reach,
Reading Road,
Arborfield,
Reading,
Berkshire, RG2 9HU

Scale: 1:500 (When plotted at A4)

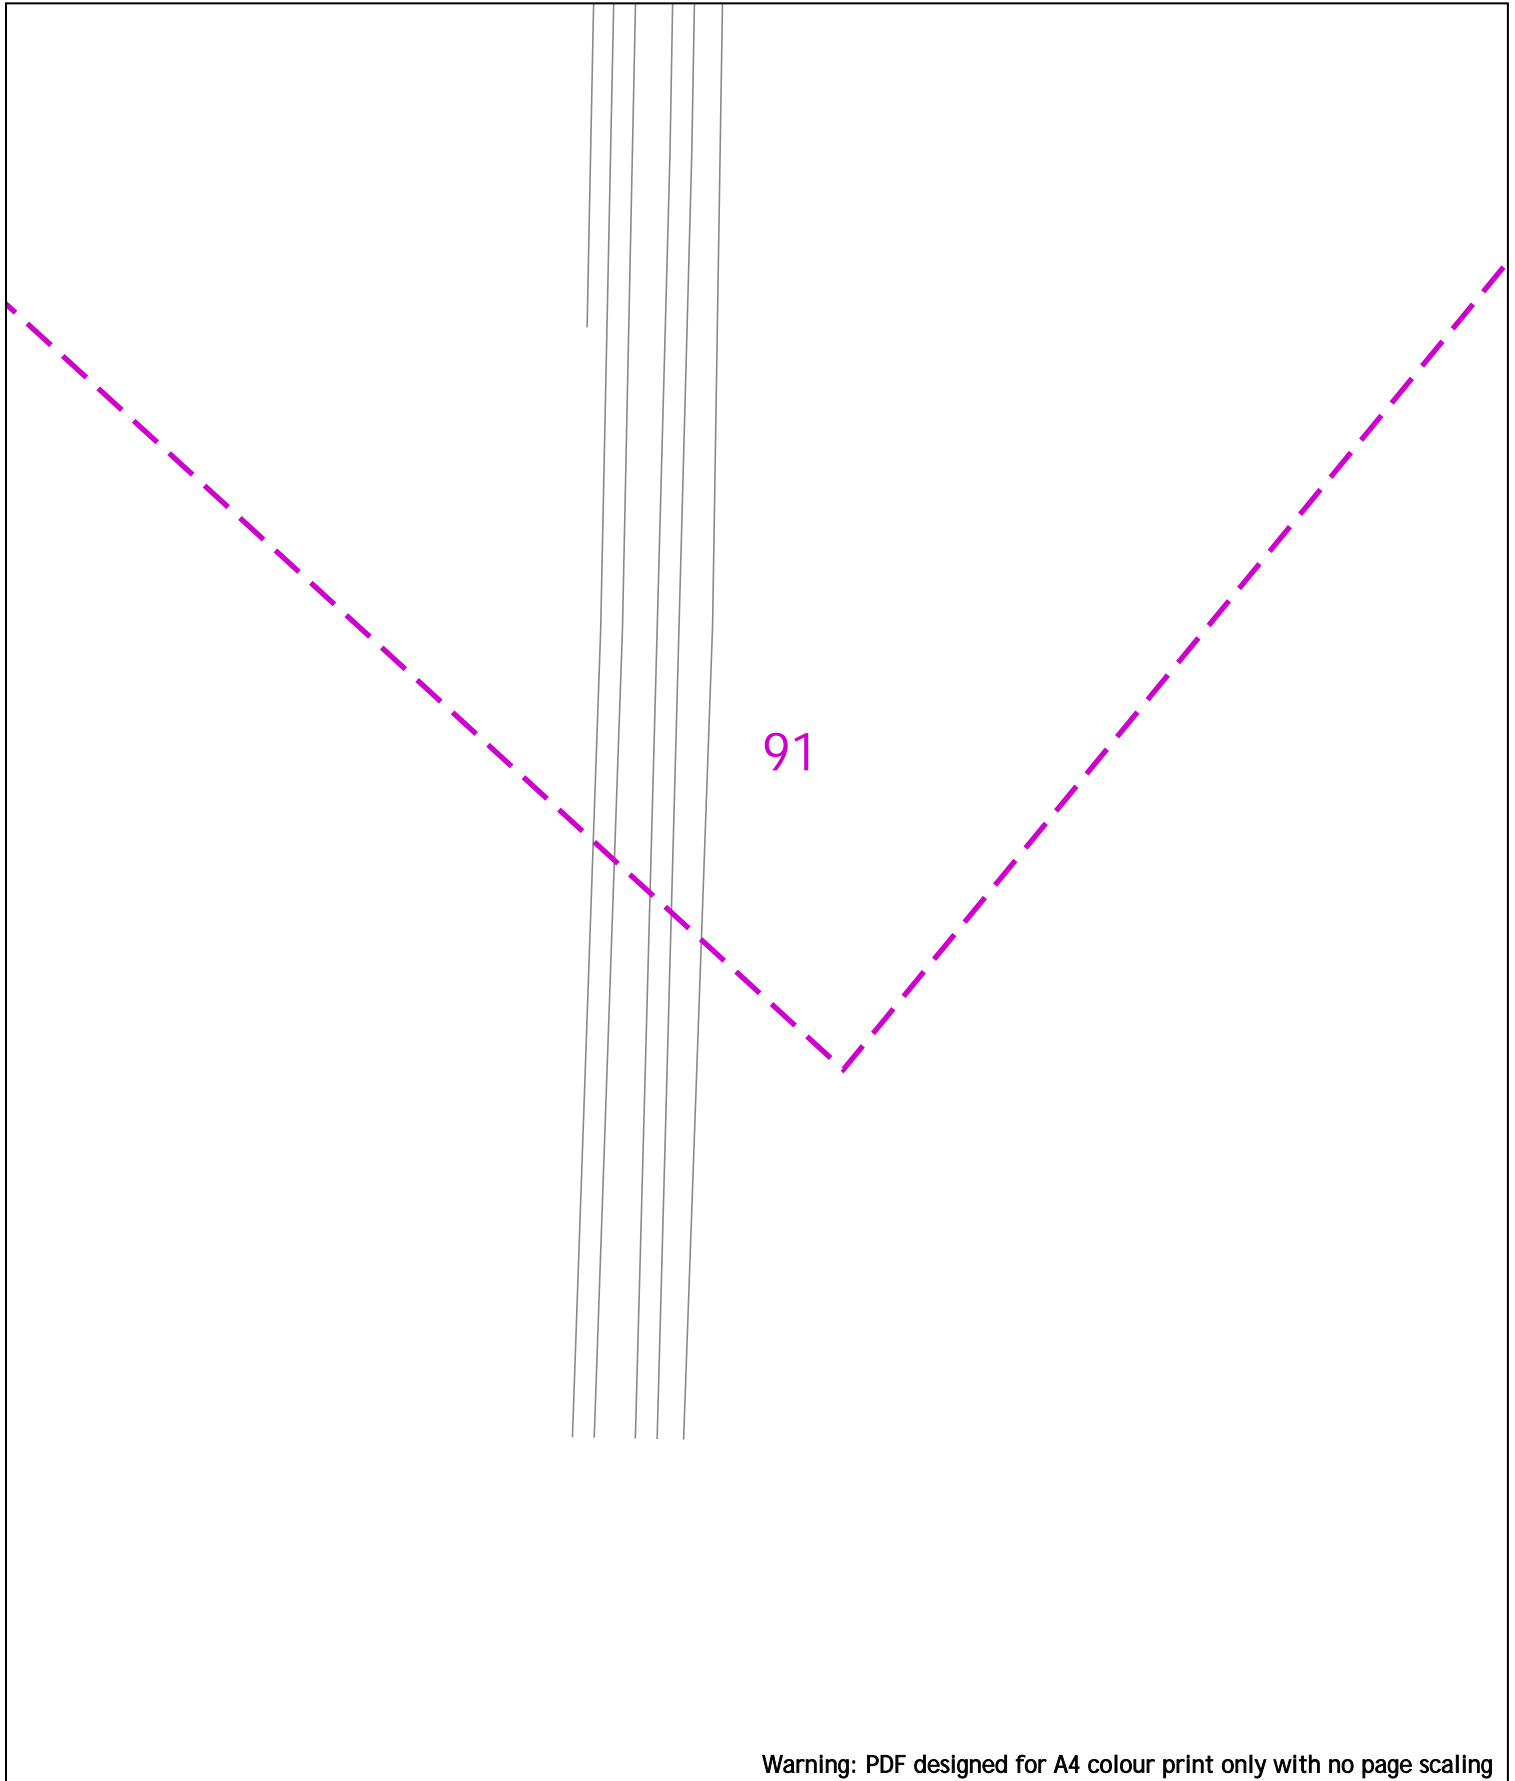

Warning: PDF designed for A4 colour print only with no page scaling

0 20m Dig Sites Area: Line:

LP Main	Valve Closed	Reducer
LP Service	Valve Open	Ducting
MP Main	CSEP	Gas Supply Point
MP Service	Pressure Reduction Station	
IP Main	End Closure	

IMPORTANT NOTICES

- This information is given as a guide only and its accuracy cannot be guaranteed
- The plan only shows pipes owned by SSE Utility Solutions Limited, Indigo Pipelines Limited
- Service pipes etc. may not be shown but their presence should be anticipated
- You must use safe digging practices in accordance with H5(G)47 to establish the actual position of mains, services and other apparatus before any mechanical excavation is used
- It is your responsibility to ensure this information is provided to all persons working near our plant
- If in doubt call the SSE Enterprise Dial Before You Dig team on 0345 070 7386.

Please note: If you have overlaps or misalignments between base maps that make it difficult to understand please contact DBYDEnterpriseEnquiries@sse.com or call 0345 070 7386














Scale: 1:500 (When plotted at A4)

Indigo Pipelines Ltd.
 Registered Office:
 Loddon Reach,
 Reading Road,
 Arborfield,
 Reading,
 Berkshire, RG2 9HU

Warning: PDF designed for A4 colour print only with no page scaling

0  20m Dig Sites Area:  Line: 

Date Requested: 24/06/2022
 Job Reference: 25881050
 Site Location: 448447 212278
 Requested by: Mr Joe Shawyer
 Your Scheme/Reference: 31188_004

 	LP Main		Valve Closed		Reducer
	LP Service		Valve Open		Ducting
	MP Main		CSEP		Gas Supply Point
	MP Service		Pressure Reduction Station		
	IP Main		End Closure		

IMPORTANT NOTICES

- This information is given as a guide only and its accuracy cannot be guaranteed
- The plan only shows pipes owned by SSE Utility Solutions Limited, Indigo Pipelines Limited
- Service pipes etc. may not be shown but their presence should be anticipated
- You must use safe digging practices in accordance with H5(G)47 to establish the actual position of mains, services and other apparatus before any mechanical excavation is used
- It is your responsibility to ensure this information is provided to all persons working near our plant
- If in doubt call the SSE Enterprise Dial Before You Dig team on 0345 070 7386.

Please note: If you have overlaps or misalignments between base maps that make it difficult to understand please contact DBYDEnterpriseEnquiries@sse.com or call 0345 070 7386



Indigo Pipelines Ltd.
 Registered Office:
 Loddon Reach,
 Reading Road,
 Arborfield,
 Reading,
 Berkshire, RG2 9HU

Scale: 1:500 (When plotted at A4)

Our Ref: 25880986 Your Ref: 31188_001

Friday, 24 June 2022

Joe Shawyer
Suite 6 Princess Caroline House 1 High Street
Southend on Sea
Essex
SS1 1JE

Dear Joe Shawyer

Indigo Pipelines Ltd - Asset Network Plans

In response to your enquiry regarding the location of network and equipment at the requested location, copies of our Record Plans are enclosed.

The plans show the positions and normal depths for the buried Indigo Pipelines Ltd Gas Plant. When they were installed. It must be stressed, however, that alterations to road alignments, surface levels and buildings may have been made subsequent to the records being taken. If you find buried Gas Plant that are not marked or are incorrectly marked, then you are required to contact us as soon as possible to give us the opportunity to amend our records.

Please note that the plans supplied are based on the location/map information supplied by yourselves and, therefore, YOU MUST SATISFY YOURSELF THAT OUR PLANS SUPPLIED ADEQUATELY COVER THE AREA THAT YOU REQUIRE.

Please note that these records only show Gas plant owned by Indigo Pipelines Ltd. There may be other privately owned buried Gas Plant in the area, which is outside the control of Indigo Pipelines Ltd. You should also check with the Local Authority, Cadent; Southern Gas Networks, Scotland Gas networks & Wales & West Utilities before proceeding.

For more information, consult the Health & Safety Executive's booklet HS (G) 47 - obtainable from the HSE.

I would particularly draw your attention to the need to take trial holes to determine the exact position and depth of buried Gas Plant to avoid the risk of injury to staff or damage to the existing Plant.

General Advice:

-
- a) Please ensure, where appropriate, that your CONTRACTORS have a copy of this letter and the enclosed plan(s).
 - b) Please note that the cost of any repairs or claims against Indigo Pipelines Ltd as a result of your works will be invoiced to you or your contractor.
 - c) Indigo Pipelines Ltd retains the right to its property, including disconnected cables and recoverable materials.

Should you require further information, please do not hesitate to contact me on the below telephone number.

Kind regards,

Indigo Pipelines Ltd

Contact Us

Emergency and Supply issues

In an emergency call 0800 111 999, 24 hours a day.

Mapping Enquiries

If you have an enquiry relating to this letter or the attached map plan, please contact us using the following information:


Telephone: 0345 070 7386.
Email: DBYDEnterpriseEnquiries@sse.com

LineSearchbeforeUdig

If you have an enquiry relating to the use of the LineSearchbeforeUdig website please contact LineSearchbeforeUdig using the following information:

Telephone: 0845 437 7365
Email: enquiries@linesearchbeforeudig.co.uk
Website: www.linesearchbeforeudig.co.uk

Overview map of worksite

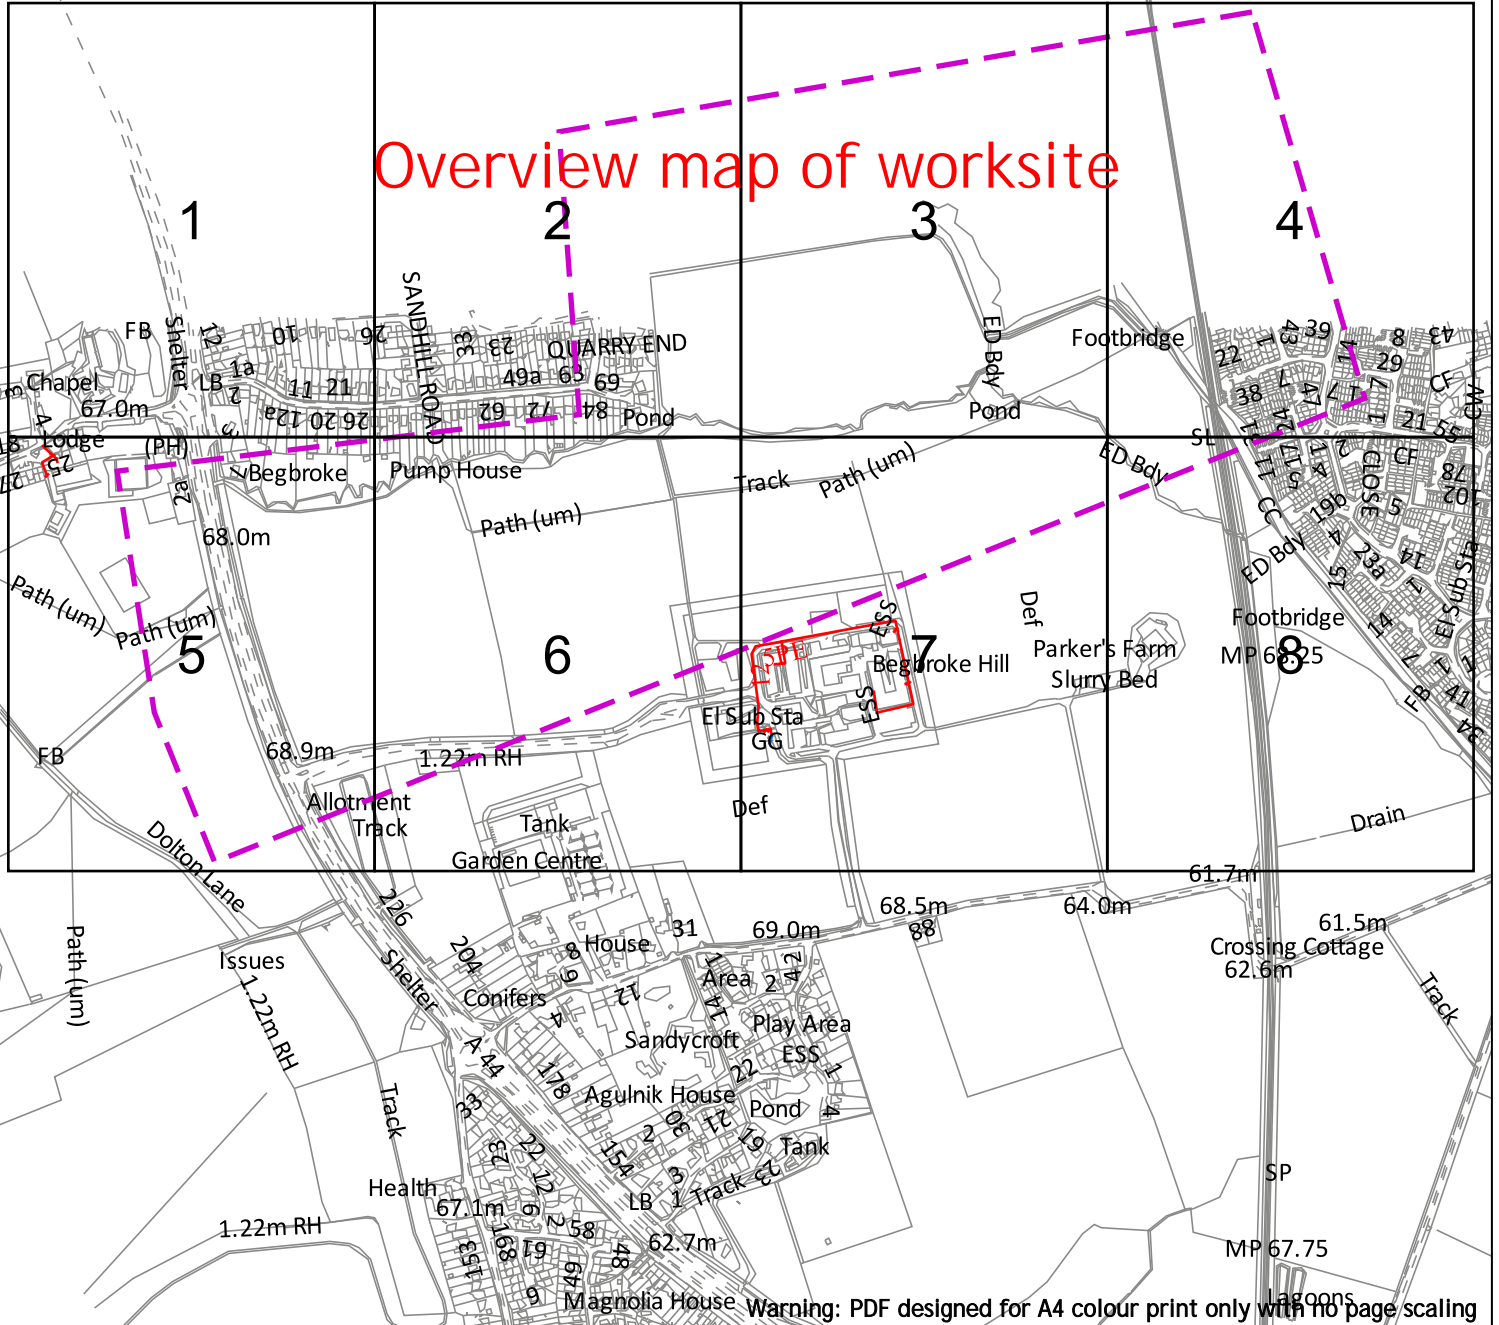

Dig Sites Area: Line:

Date Requested: 24/06/2022
 Job Reference: 25880986
 Site Location: 447899 213853
 Requested by: Mr Joe Shawyer
 Your Scheme/Reference: 31188_001

	LP Main		Valve Closed		Reducer
	LP Service		Valve Open		Ducting
	MP Main		CSEP		Gas Supply Point
	MP Service		Pressure Reduction Station		
	IP Main		End Closure		

IMPORTANT NOTICES


- This information is given as a guide only and its accuracy cannot be guaranteed
- The plan only shows pipes owned by SSE Utility Solutions Limited, Indigo Pipelines Limited
- Service pipes etc. may not be shown but their presence should be anticipated
- You must use safe digging practices in accordance with H5(G)47 to establish the actual position of mains, services and other apparatus before any mechanical excavation is used
- It is your responsibility to ensure this information is provided to all persons working near our plant
- If in doubt call the SSE Enterprise Dial Before You Dig team on 0345 070 7386.

Please note: If you have overlaps or misalignments between base maps that make it difficult to understand please contact DBVEnterpriseEnquiries@sse.com or call 0345 070 7386

Scale: 1:10250 (When plotted at A4)



Indigo Pipelines Ltd.
 Registered Office:
 Loddon Reach,
 Reading Road,
 Arborfield,
 Reading,
 Berkshire, RG2 9HU

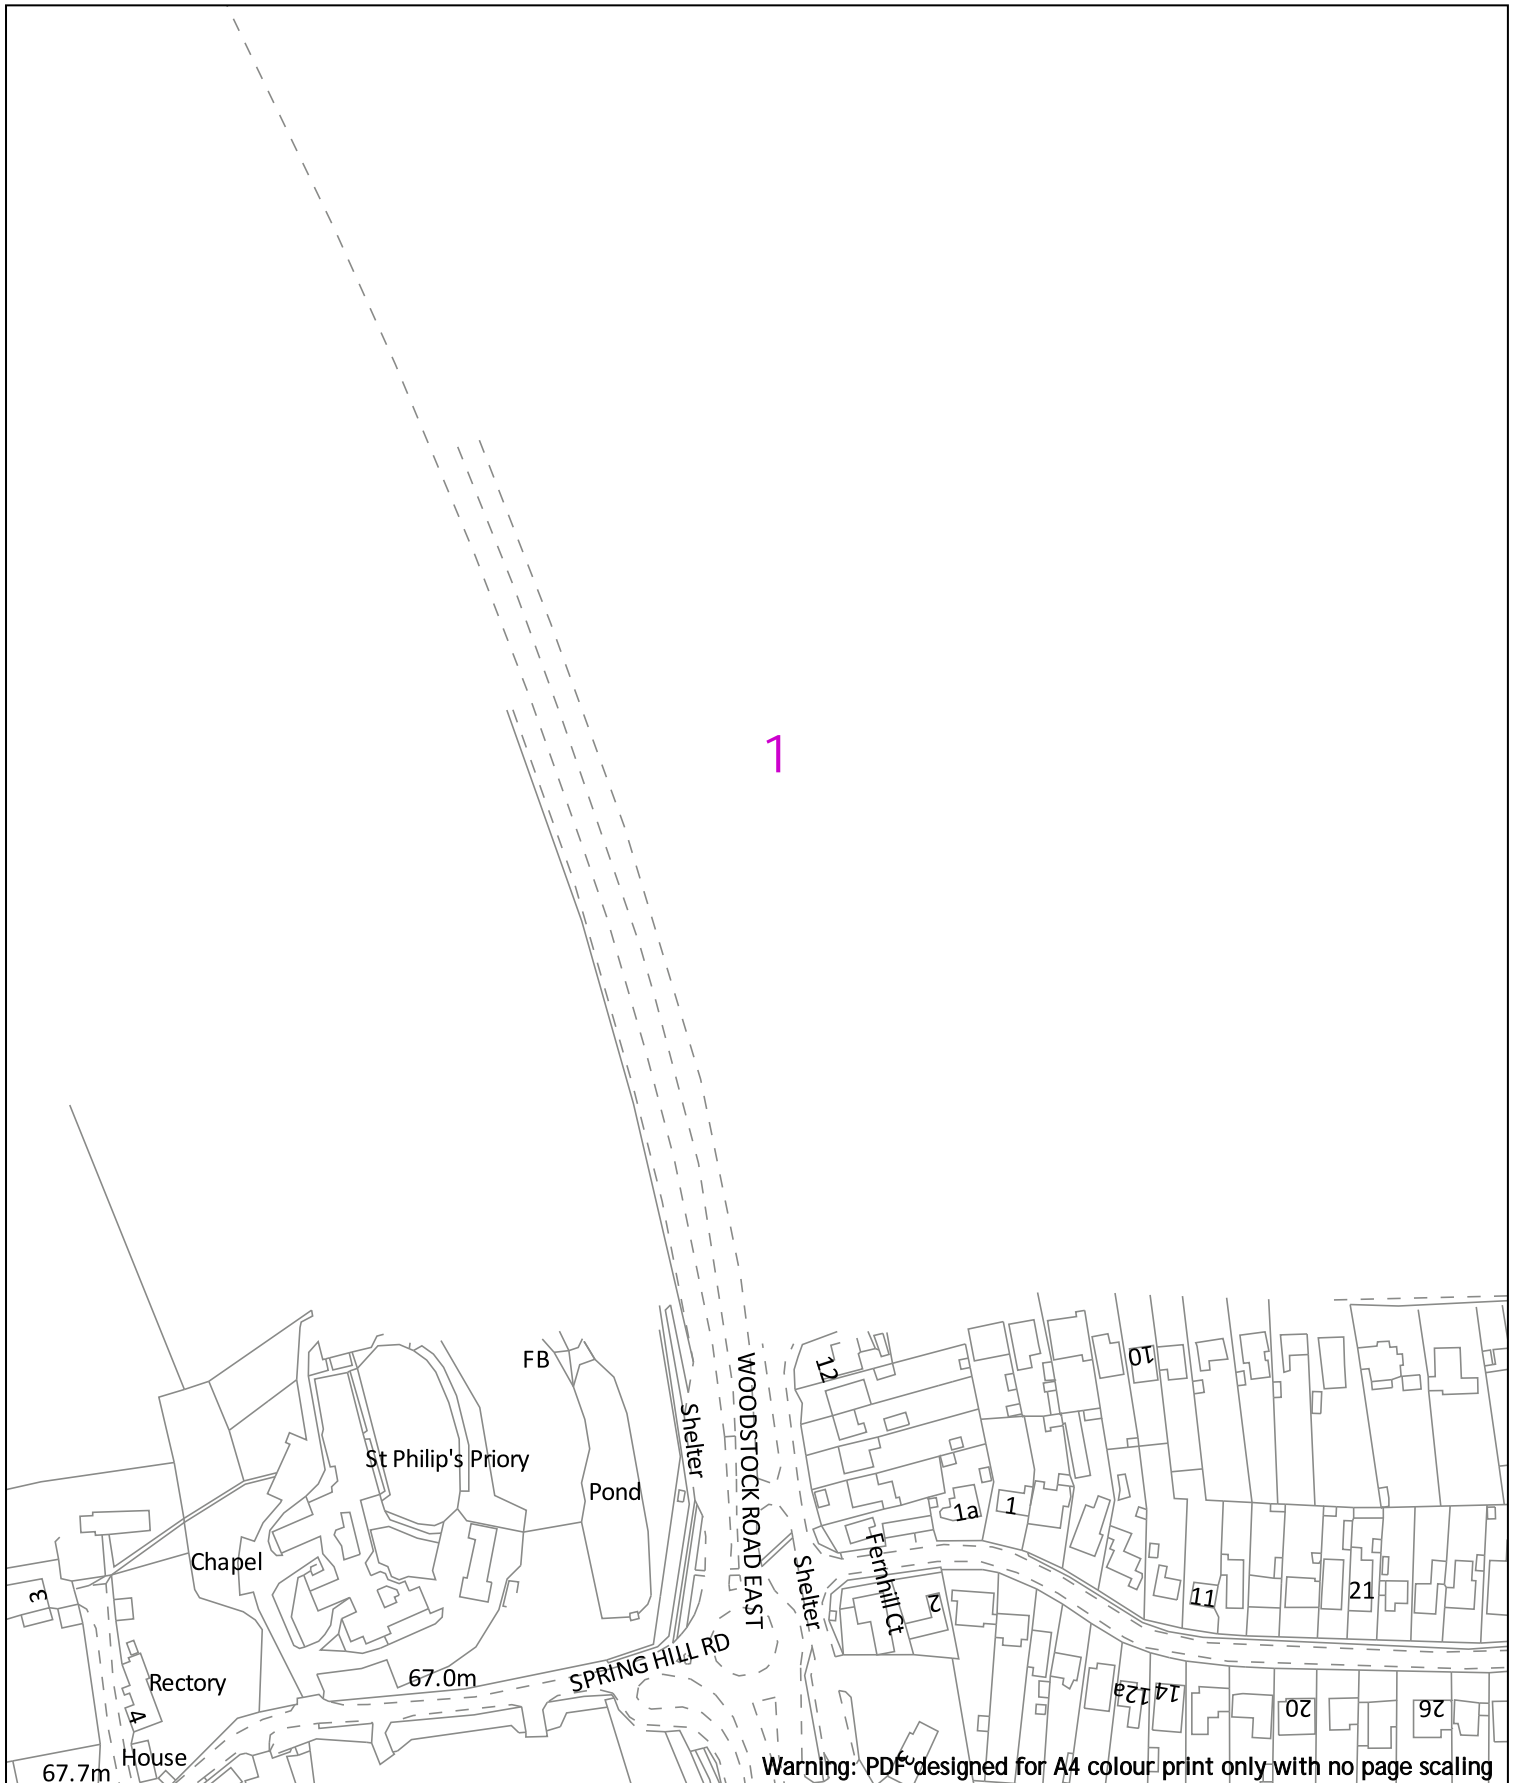

Warning: PDF designed for A4 colour print only with no page scaling

0 20m Dig Sites Area: Line:

	LP Main		Valve Closed		Reducer
	LP Service		Valve Open		Ducting
	MP Main		CSEP		Gas Supply Point
	MP Service		Pressure Reduction Station		
	IP Main		End Closure		

IMPORTANT NOTICES


- This information is given as a guide only and its accuracy cannot be guaranteed
- The plan only shows pipes owned by SSE Utility Solutions Limited, Indigo Pipelines Limited
- Service pipes etc. may not be shown but their presence should be anticipated
- You must use safe digging practices in accordance with H5(G)47 to establish the actual position of mains, services and other apparatus before any mechanical excavation is used
- It is your responsibility to ensure this information is provided to all persons working near our plant
- If in doubt call the SSE Enterprise Dial Before You Dig team on 0345 070 7386.

Please note: If you have overlaps or misalignments between base maps that make it difficult to understand please contact DBYDEnterpriseEnquiries@sse.com or call 0345 070 7386



Indigo Pipelines Ltd.
 Registered Office:
 Loddon Reach,
 Reading Road,
 Arborfield,
 Reading,
 Berkshire, RG2 9HU

Scale: 1:2500 (When plotted at A4)

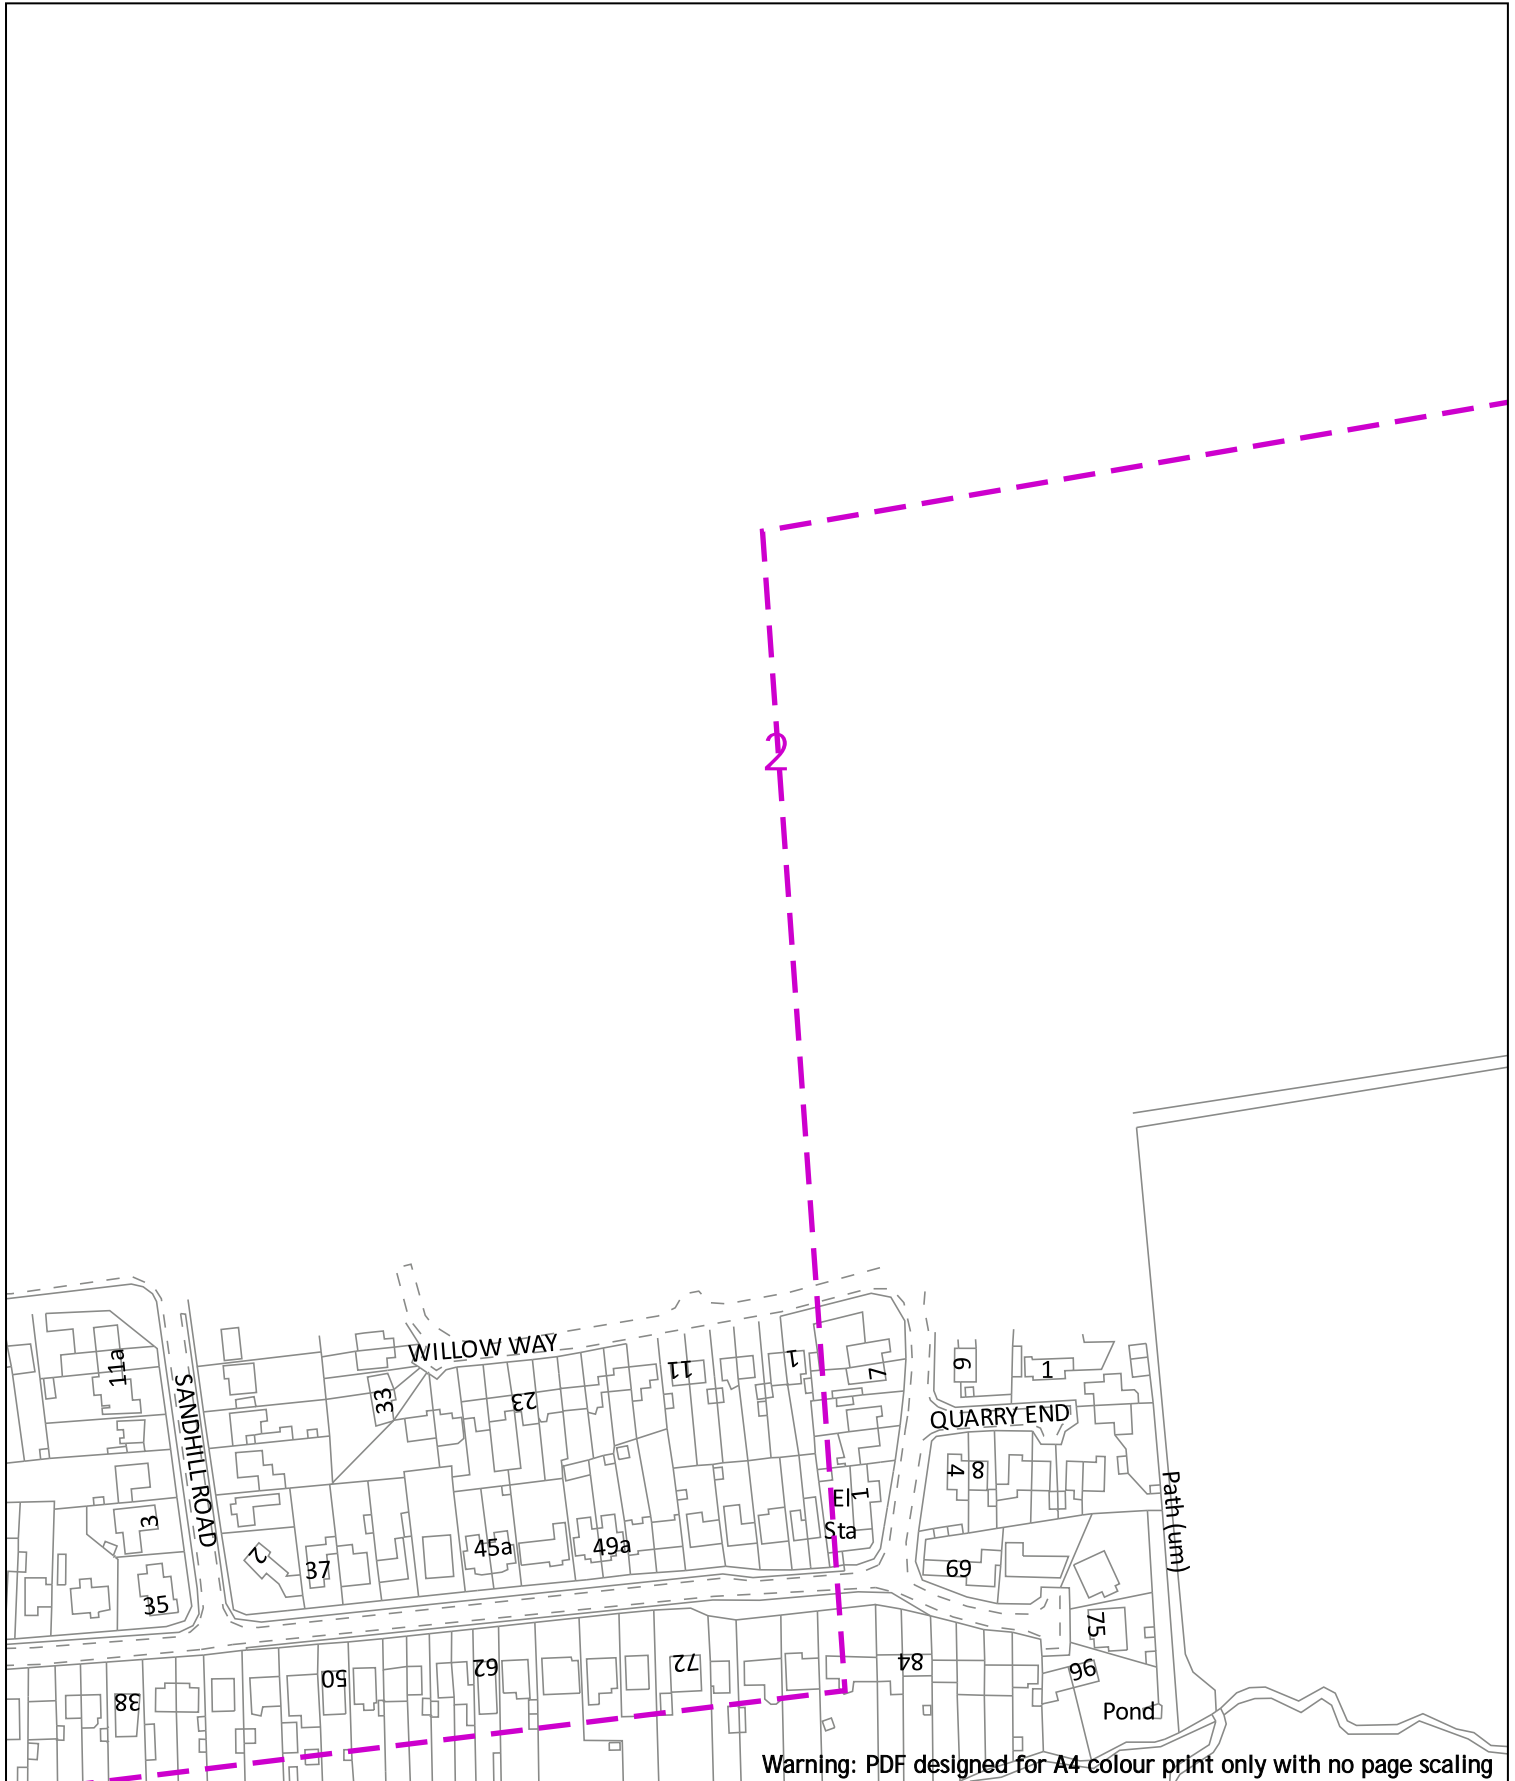

0 20m Dig Sites Area: Line:

LP Main	Valve Closed	Reducer
LP Service	Valve Open	Ducting
MP Main	CSEP	Gas Supply Point
MP Service	Pressure Reduction Station	
IP Main	End Closure	

IMPORTANT NOTICES


- This information is given as a guide only and its accuracy cannot be guaranteed
- The plan only shows pipes owned by SSE Utility Solutions Limited, Indigo Pipelines Limited
- Service pipes etc. may not be shown but their presence should be anticipated
- You must use safe digging practices in accordance with H5(G)47 to establish the actual position of mains, services and other apparatus before any mechanical excavation is used
- It is your responsibility to ensure this information is provided to all persons working near our plant
- If in doubt call the SSE Enterprise Dial Before You Dig team on 0345 070 7386.

Please note: If you have overlaps or misalignments between base maps that make it difficult to understand please contact DBYDEnterpriseEnquiries@sse.com or call 0345 070 7386

Date Requested: 24/06/2022
 Job Reference: 25880986
 Site Location: 447899 213853
 Requested by: Mr Joe Shawyer
 Your Scheme/Reference: 31188_001

Scale: 1:2500 (When plotted at A4)

Indigo Pipelines Ltd.
 Registered Office:
 Loddon Reach,
 Reading Road,
 Arborfield,
 Reading,
 Berkshire, RG2 9HU

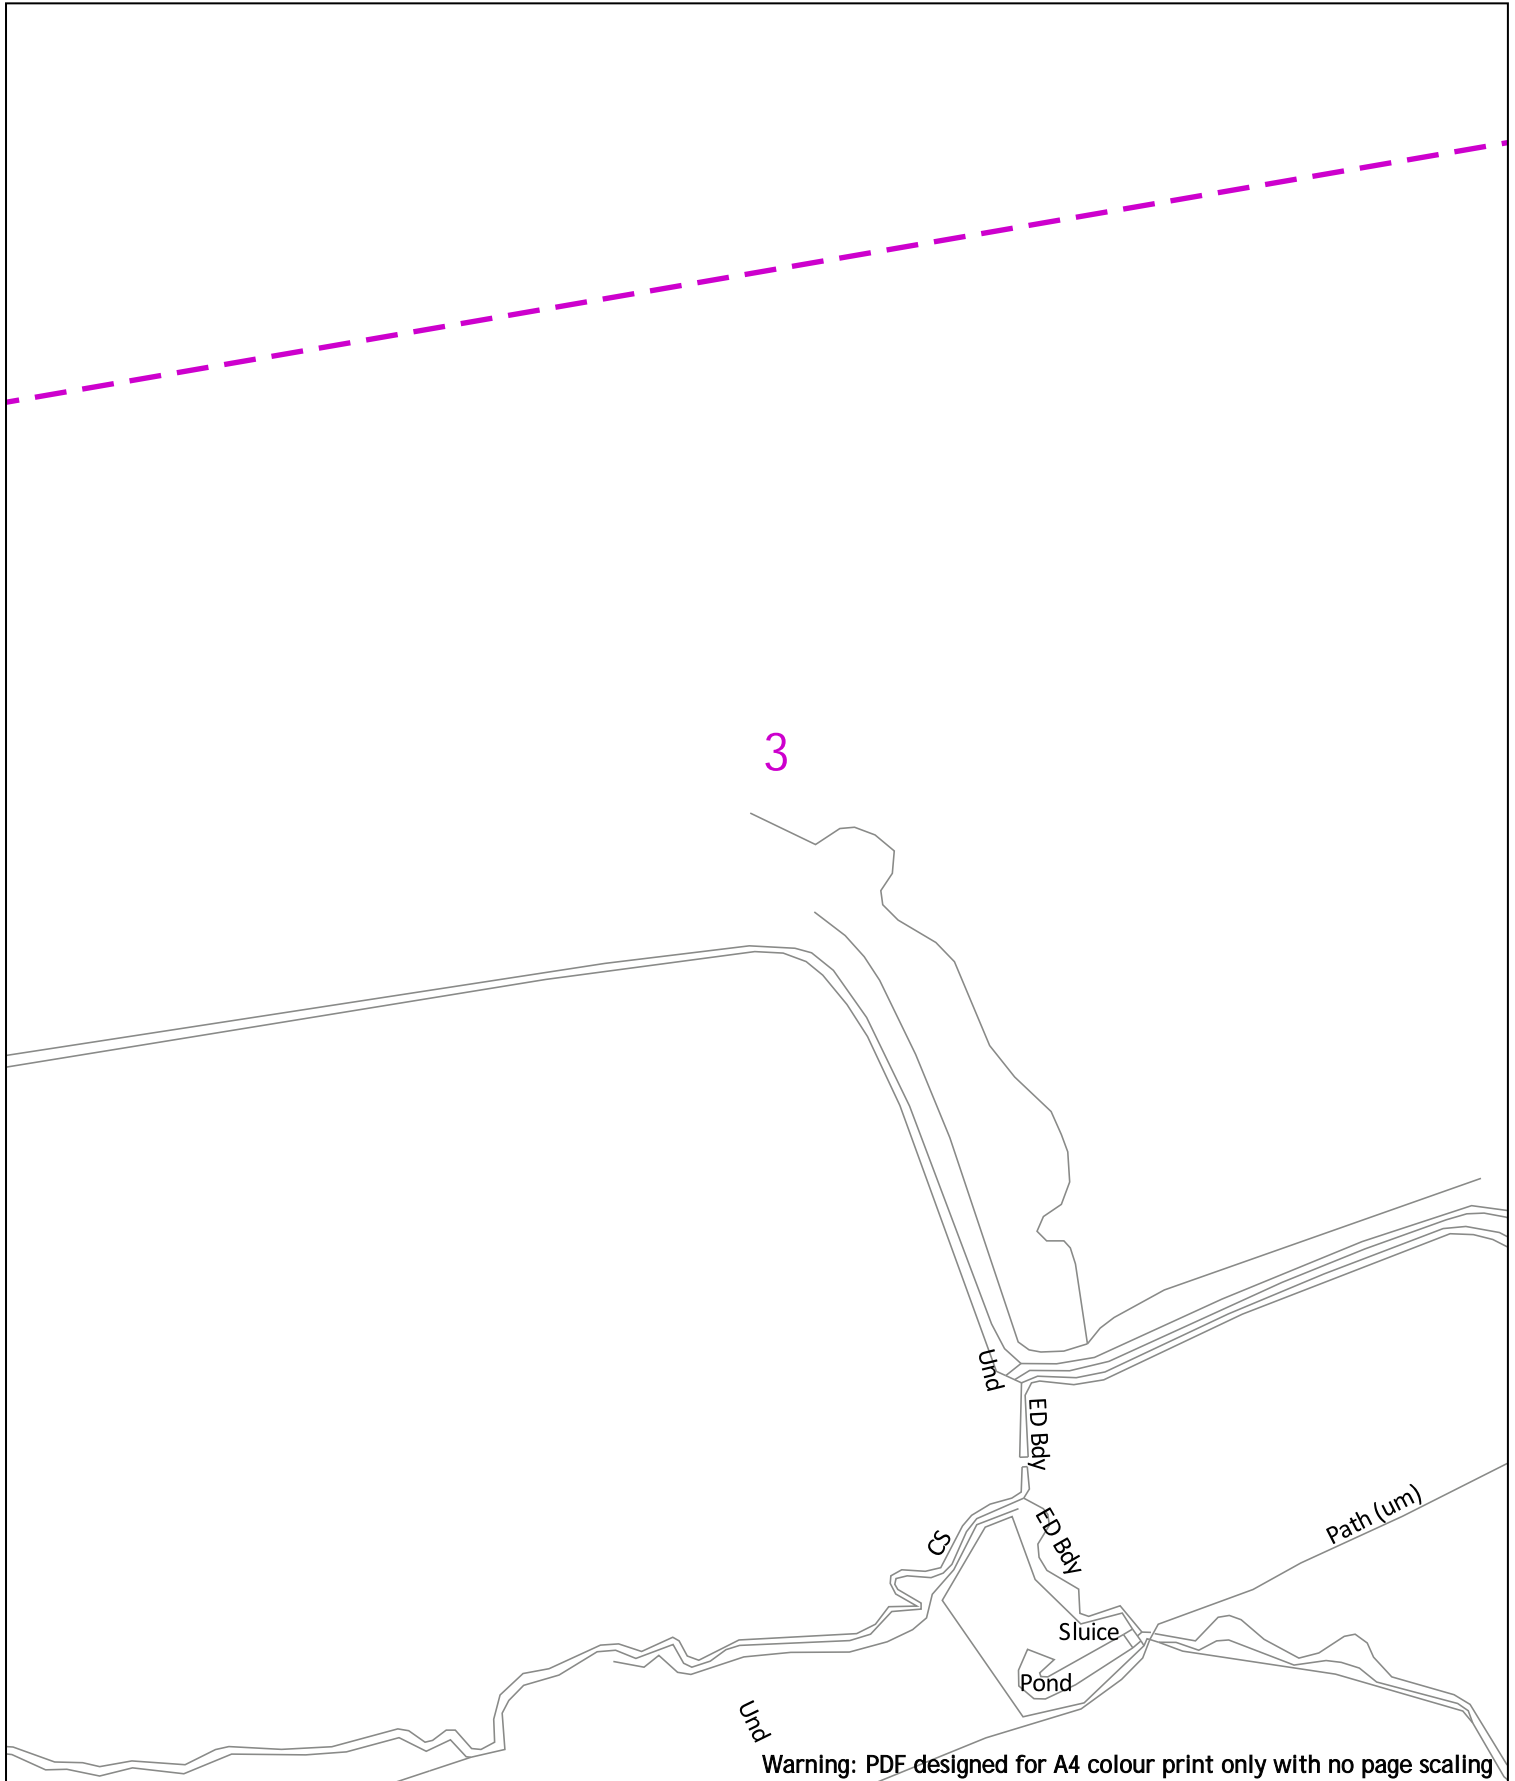

Warning: PDF designed for A4 colour print only with no page scaling

0 20m Dig Sites Area: Line:

LP Main	Valve Closed	Reducer
LP Service	Valve Open	Ducting
MP Main	CSEP	Gas Supply Point
MP Service	Pressure Reduction Station	
IP Main	End Closure	

IMPORTANT NOTICES


- This information is given as a guide only and its accuracy cannot be guaranteed
- The plan only shows pipes owned by SSE Utility Solutions Limited, Indigo Pipelines Limited
- Service pipes etc. may not be shown but their presence should be anticipated
- You must use safe digging practices in accordance with H5(G)47 to establish the actual position of mains, services and other apparatus before any mechanical excavation is used
- It is your responsibility to ensure this information is provided to all persons working near our plant
- If in doubt call the SSE Enterprise Dial Before You Dig team on 0345 070 7386.

Please note: If you have overlaps or misalignments between base maps that make it difficult to understand please contact DBYDEnterpriseEnquiries@sse.com or call 0345 070 7386

Date Requested: 24/06/2022
 Job Reference: 25880986
 Site Location: 447899 213853
 Requested by: Mr Joe Shawyer
 Your Scheme/Reference: 31188_001

Scale: 1:2500 (When plotted at A4)

Indigo Pipelines Ltd.
 Registered Office:
 Loddon Reach,
 Reading Road,
 Arborfield,
 Reading,
 Berkshire, RG2 9HU

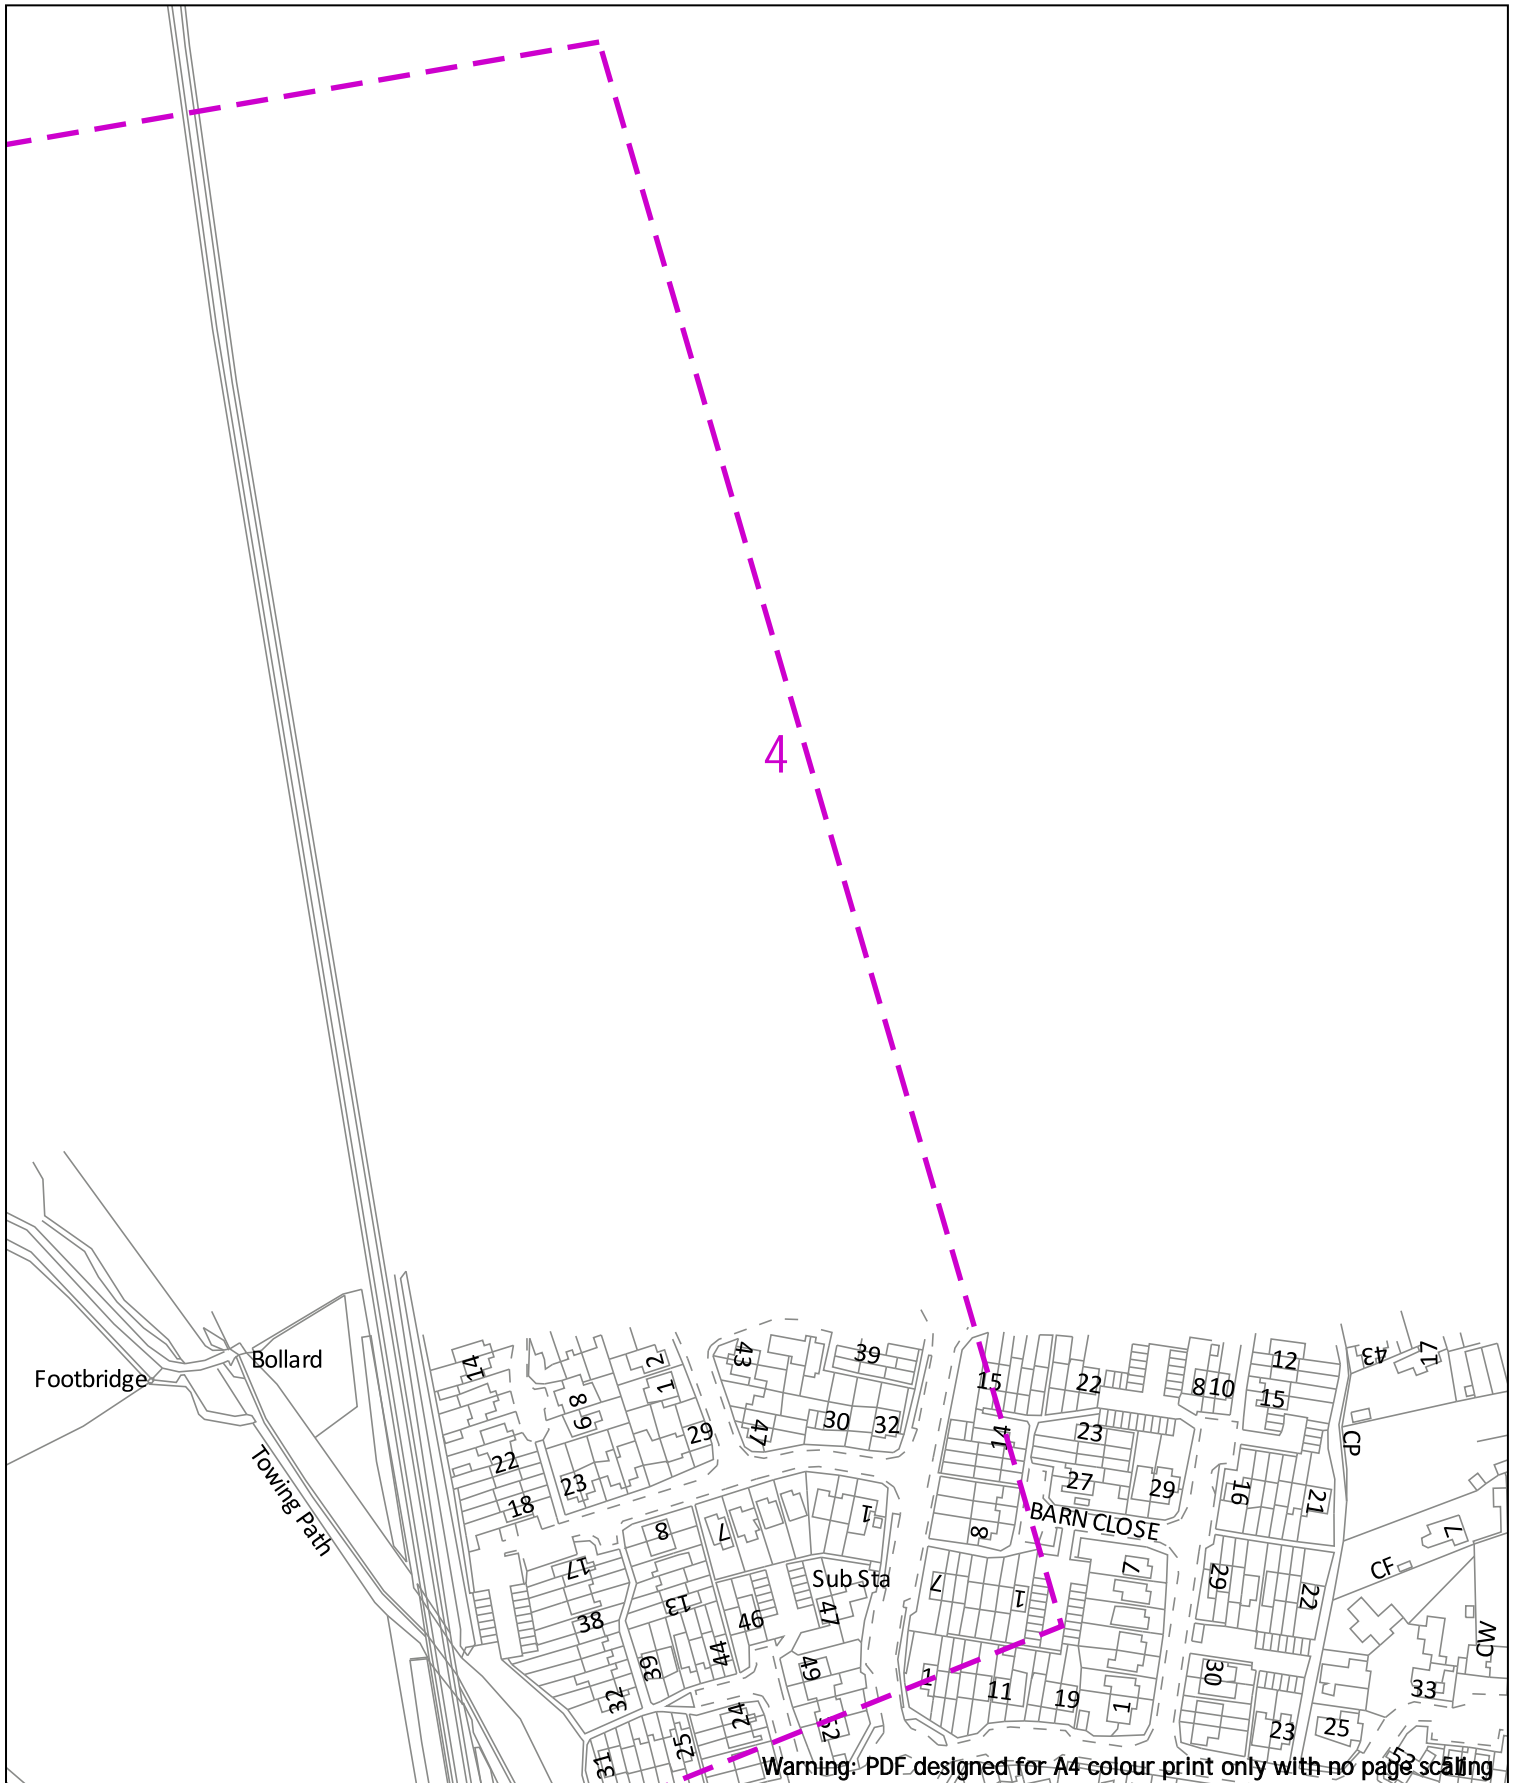

Warning: PDF designed for A4 colour print only with no page scaling

0 20m Dig Sites Area: Line:

LP Main	Valve Closed	Reducer
LP Service	Valve Open	Ducting
MP Main	CSEP	Gas Supply Point
MP Service	Pressure Reduction Station	
IP Main	End Closure	


IMPORTANT NOTICES

- This information is given as a guide only and its accuracy cannot be guaranteed
- The plan only shows pipes owned by SSE Utility Solutions Limited, Indigo Pipelines Limited
- Service pipes etc. may not be shown but their presence should be anticipated
- You must use safe digging practices in accordance with H5(G)47 to establish the actual position of mains, services and other apparatus before any mechanical excavation is used
- It is your responsibility to ensure this information is provided to all persons working near our plant
- If in doubt call the SSE Enterprise Dial Before You Dig team on 0345 070 7386

Please note: If you have overlaps or misalignments between base maps that make it difficult to understand please contact DBYDEnterpriseEnquiries@sse.com or call 0345 070 7386



Indigo Pipelines Ltd.
 Registered Office:
 Loddon Reach,
 Reading Road,
 Arborfield,
 Reading,
 Berkshire, RG2 9HU

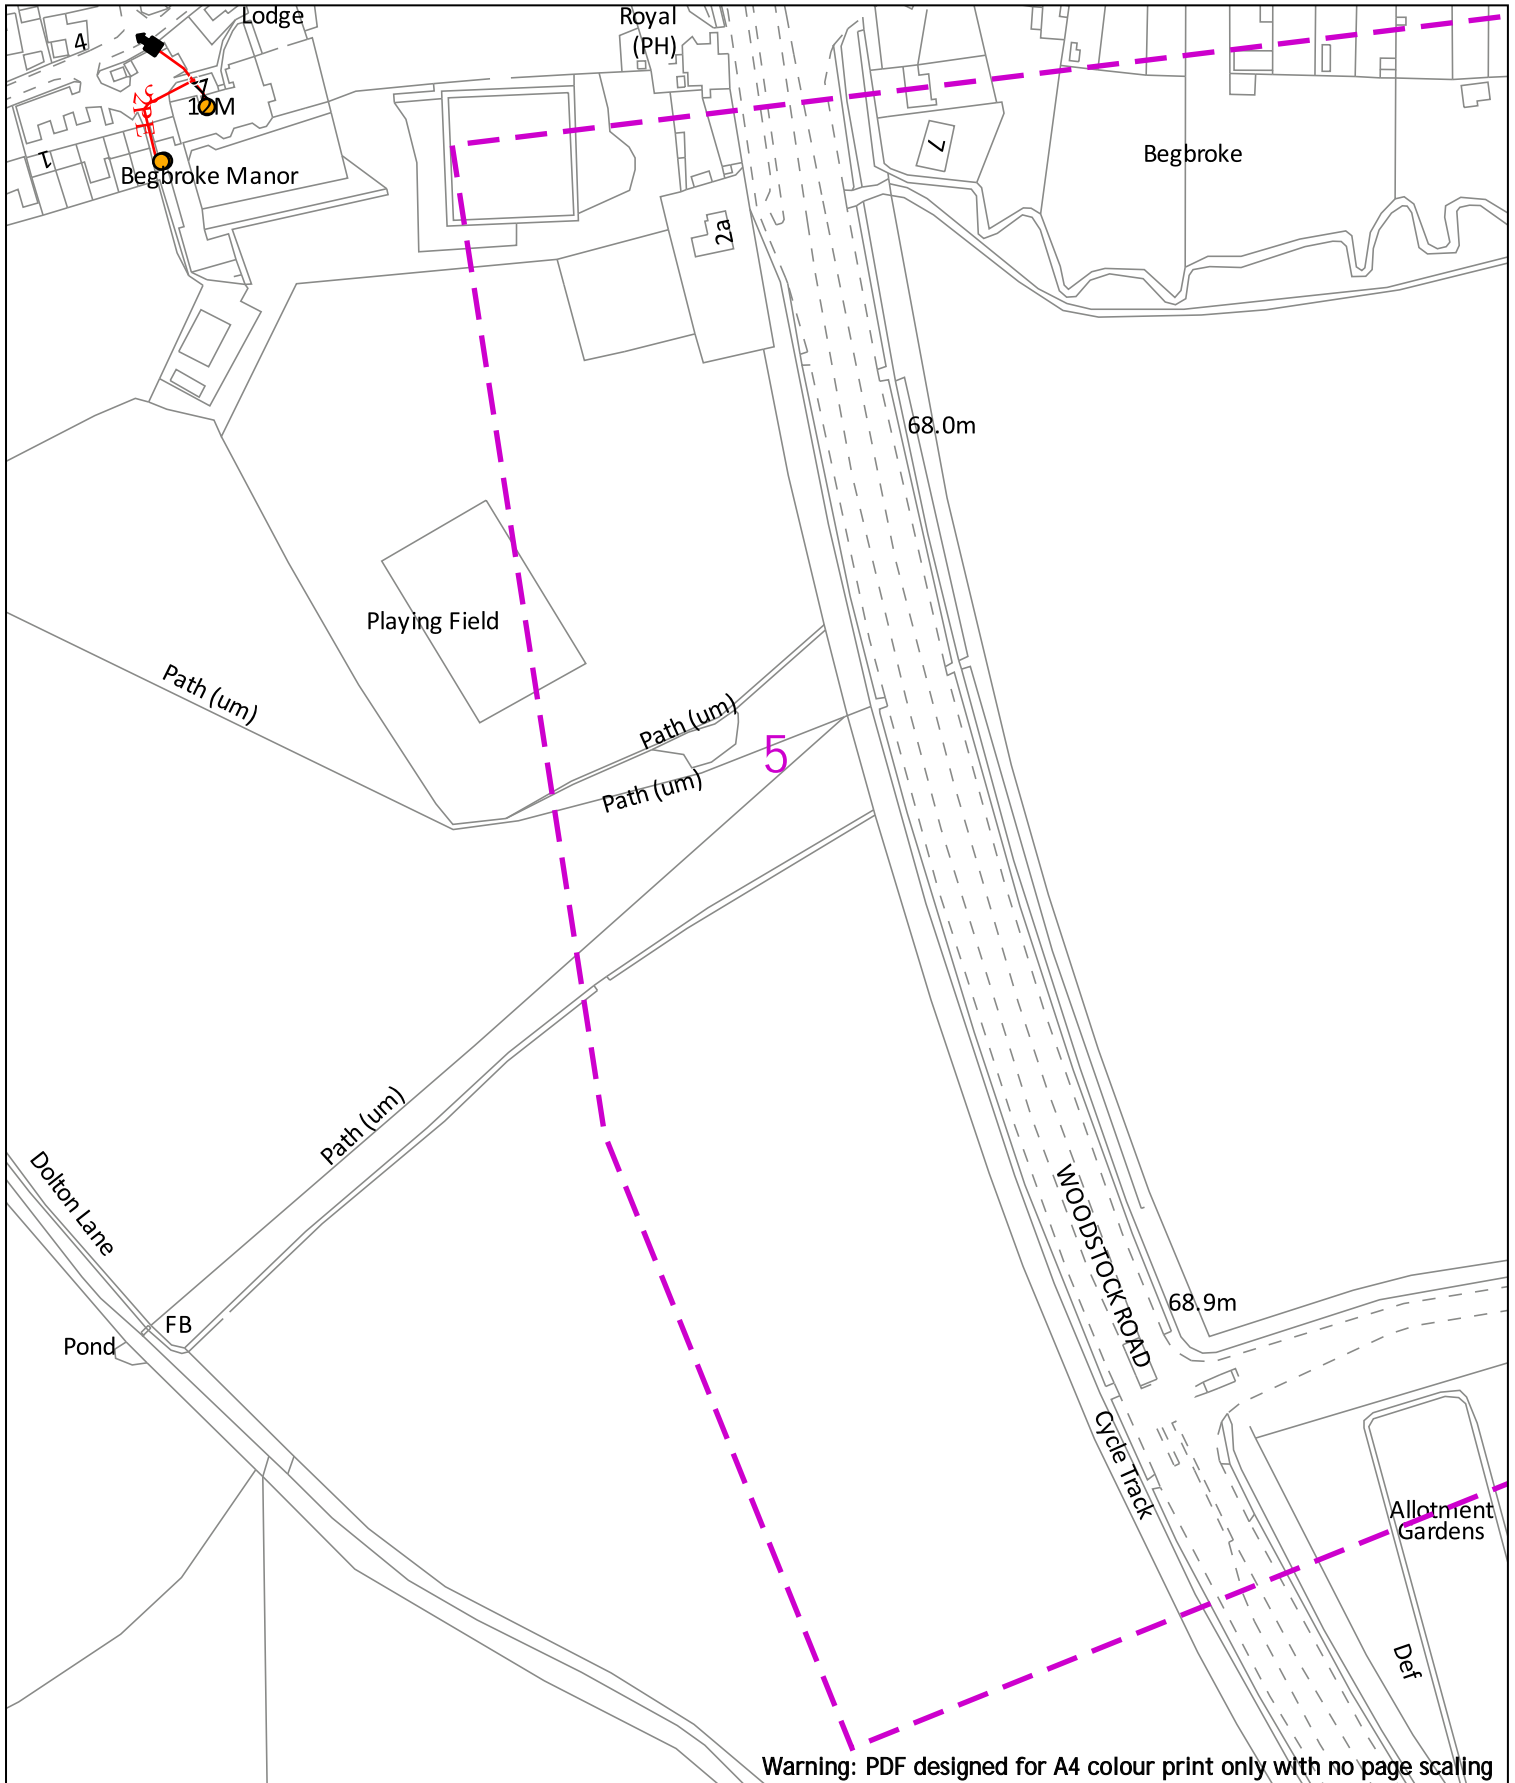

Warning: PDF designed for A4 colour print only with no page scaling

0 20m Dig Sites Area: Line:

Date Requested: 24/06/2022
 Job Reference: 25880986
 Site Location: 447899 213853
 Requested by: Mr Joe Shawyer
 Your Scheme/Reference: 31188_001

Scale: 1:2500 (When plotted at A4)

	LP Main		Valve Closed		Reducer
	LP Service		Valve Open		Ducting
	MP Main		CSEP		Gas Supply Point
	MP Service		Pressure Reduction Station		
	IP Main		End Closure		


IMPORTANT NOTICES

- This information is given as a guide only and its accuracy cannot be guaranteed
- The plan only shows pipes owned by SSE Utility Solutions Limited, Indigo Pipelines Limited
- Service pipes etc. may not be shown but their presence should be anticipated
- You must use safe digging practices in accordance with H5(G)47 to establish the actual position of mains, services and other apparatus before any mechanical excavation is used
- It is your responsibility to ensure this information is provided to all persons working near our plant
- If in doubt call the SSE Enterprise Dial Before You Dig team on 0345 070 7386.

Please note: If you have overlaps or misalignments between base maps that make it difficult to understand please contact DBYDEnterpriseEnquiries@sse.com or call 0345 070 7386



Indigo Pipelines Ltd.
 Registered Office:
 Loddon Reach,
 Reading Road,
 Arborfield,
 Reading,
 Berkshire, RG2 9HU

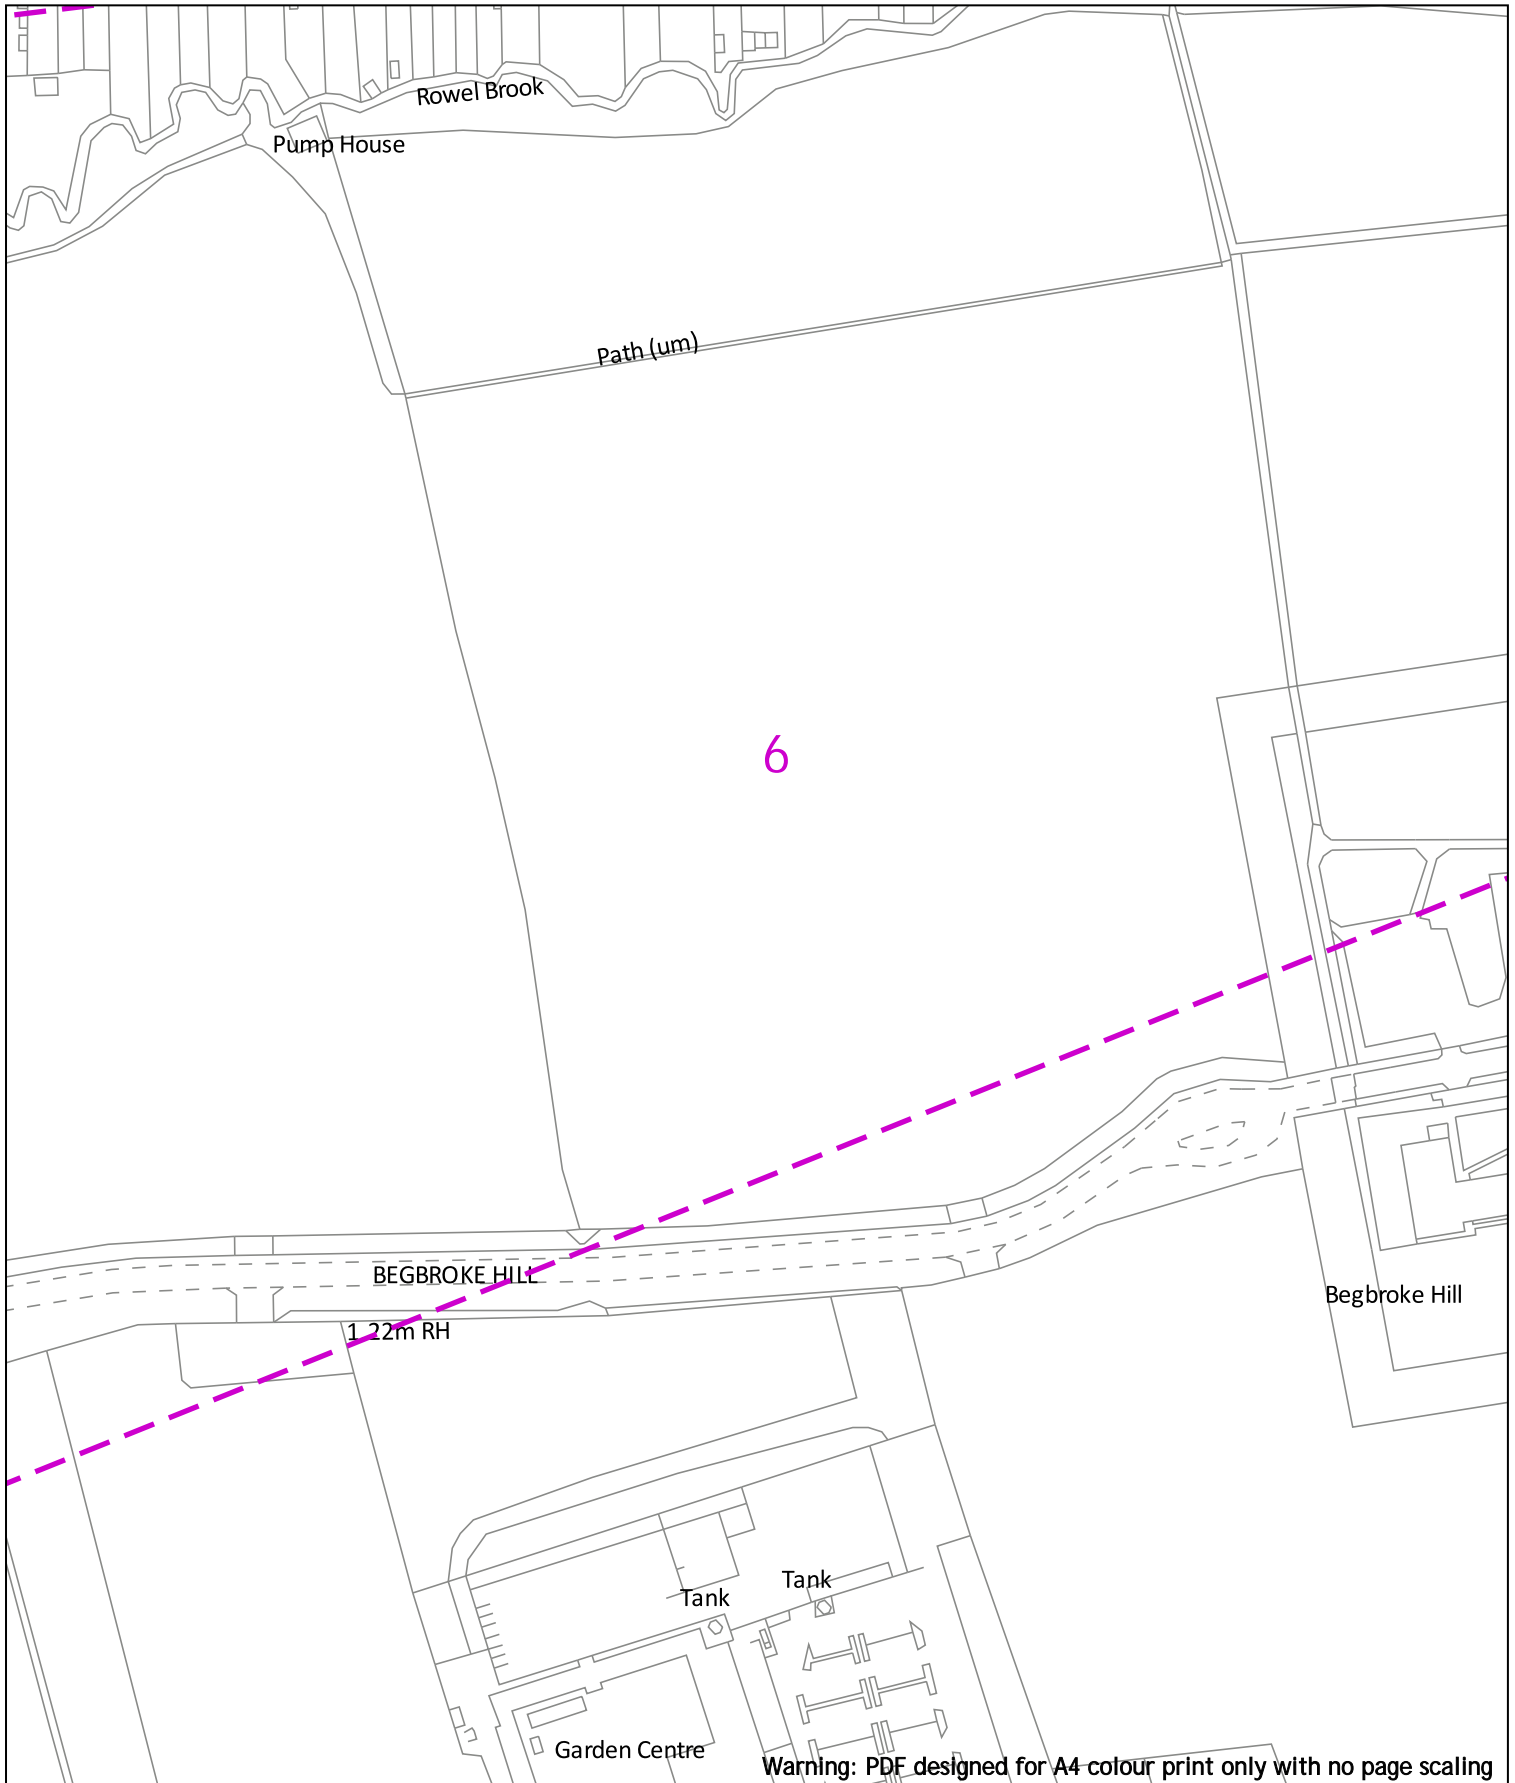

Warning: PDF designed for A4 colour print only with no page scaling

0 20m Dig Sites Area: Line:

Date Requested: 24/06/2022
 Job Reference: 25880986
 Site Location: 447899 213853
 Requested by: Mr Joe Shawyer
 Your Scheme/Reference: 31188_001

	LP Main		Valve Closed		Reducer
	LP Service		Valve Open		Ducting
	MP Main		CSEP		Gas Supply Point
	MP Service		Pressure Reduction Station		
	IP Main		End Closure		

IMPORTANT NOTICES


- This information is given as a guide only and its accuracy cannot be guaranteed
- The plan only shows pipes owned by SSE Utility Solutions Limited, Indigo Pipelines Limited
- Service pipes etc. may not be shown but their presence should be anticipated
- You must use safe digging practices in accordance with H5(G)47 to establish the actual position of mains, services and other apparatus before any mechanical excavation is used
- It is your responsibility to ensure this information is provided to all persons working near our plant
- If in doubt call the SSE Enterprise Dial Before You Dig team on 0345 070 7386.

Please note: If you have overlaps or misalignments between base maps that make it difficult to understand please contact DBYDEnterpriseEnquiries@sse.com or call 0345 070 7386



Indigo Pipelines Ltd.
 Registered Office:
 Loddon Reach,
 Reading Road,
 Arborfield,
 Reading,
 Berkshire, RG2 9HU

Scale: 1:2500 (When plotted at A4)

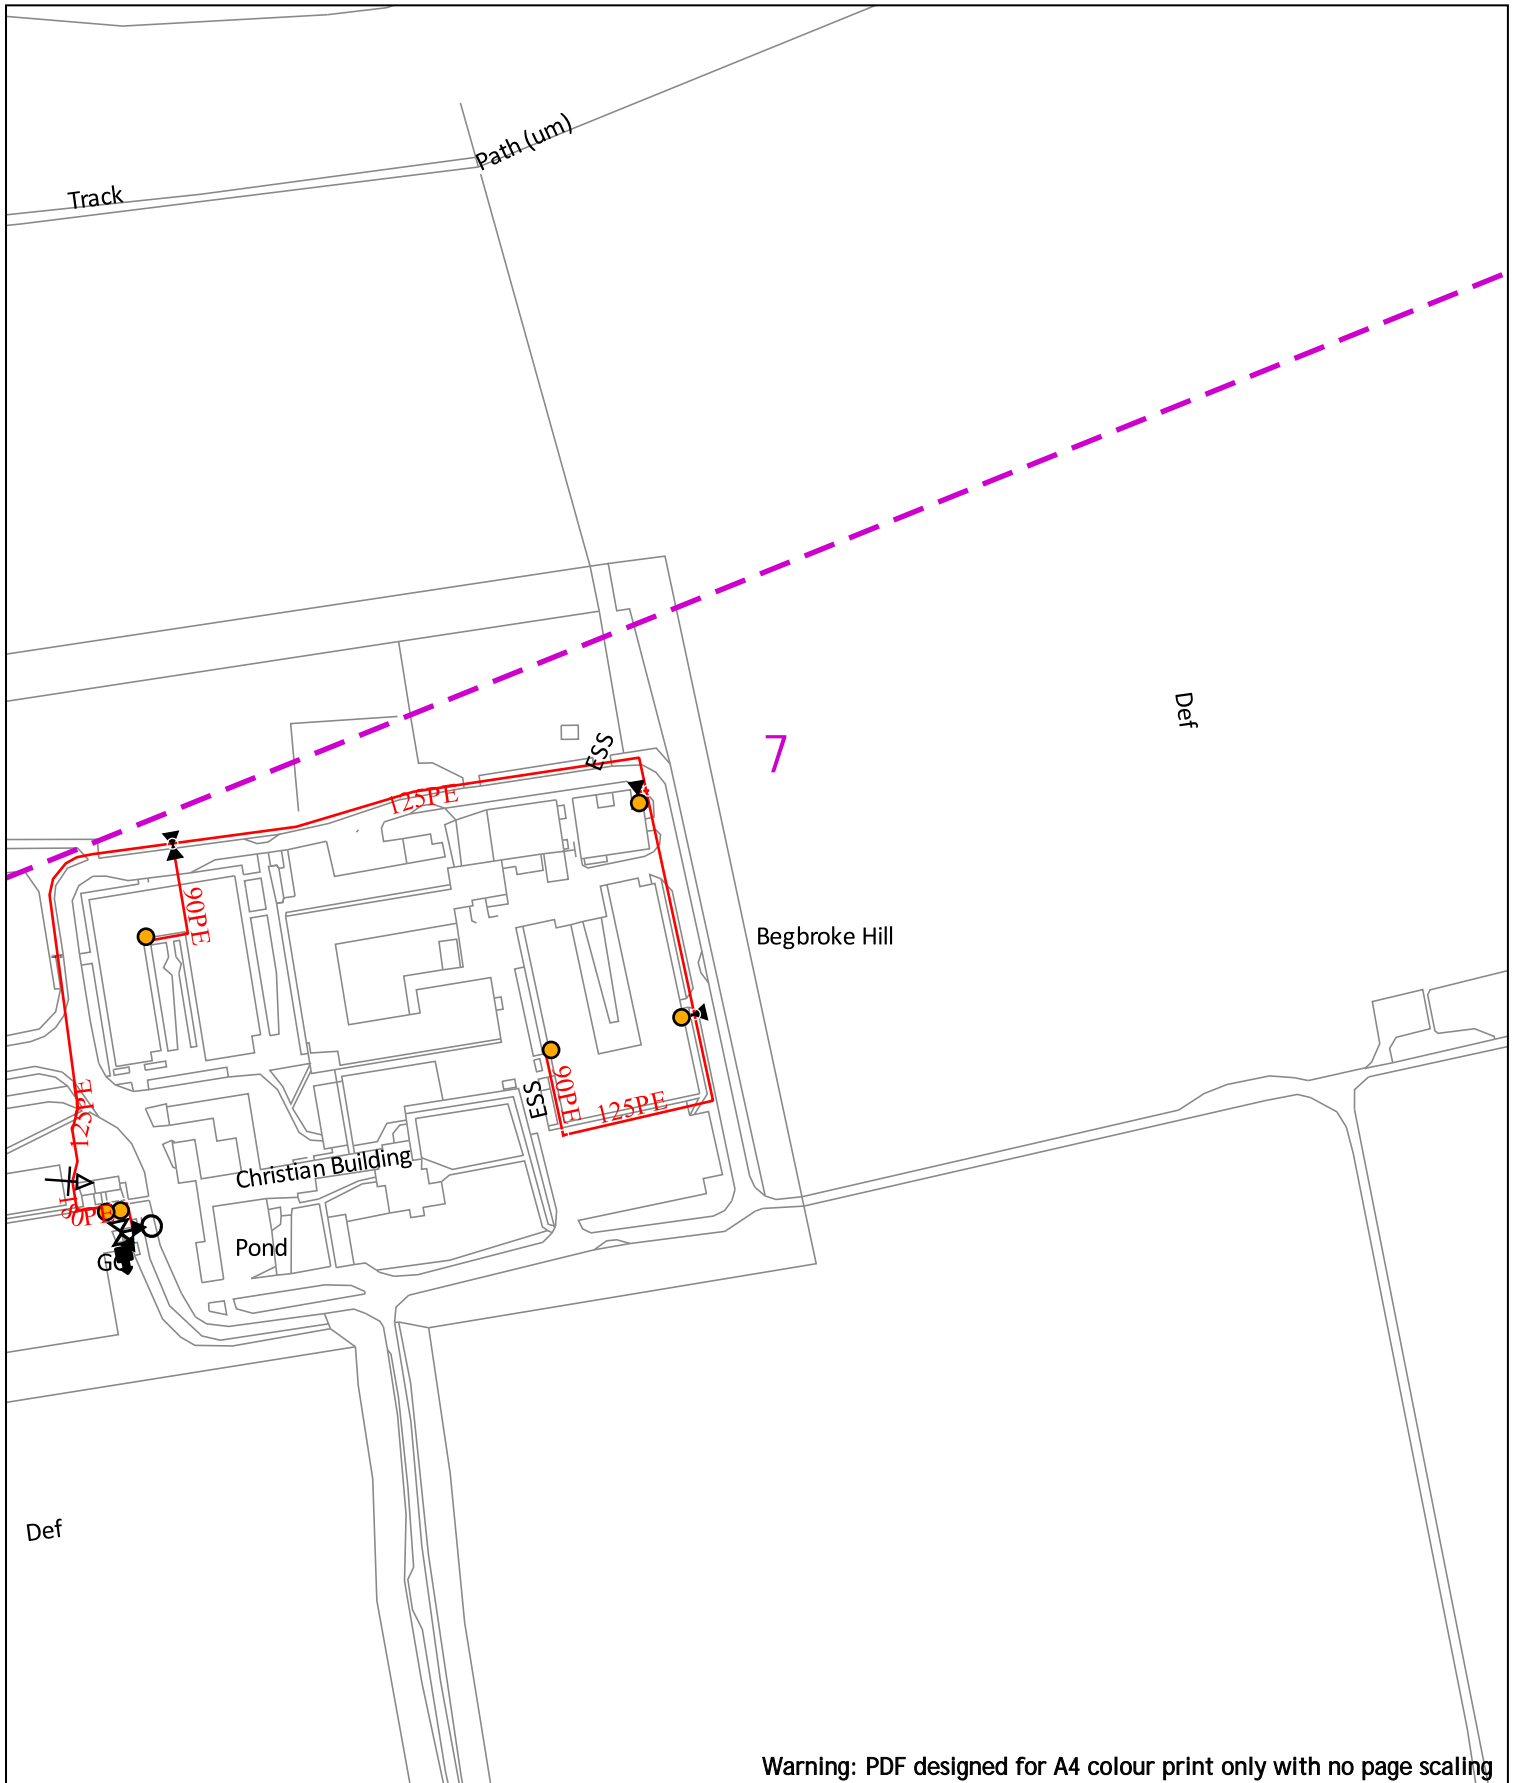

Warning: PDF designed for A4 colour print only with no page scaling

0 20m Dig Sites Area: Line:

Date Requested: 24/06/2022
 Job Reference: 25880986
 Site Location: 447899 213853
 Requested by: Mr Joe Shawyer
 Your Scheme/Reference: 31188_001

	LP Main		Valve Closed		Reducer
	LP Service		Valve Open		Ducting
	MP Main		CSEP		Gas Supply Point
	MP Service		Pressure Reduction Station		
	IP Main		End Closure		

IMPORTANT NOTICES


- This information is given as a guide only and its accuracy cannot be guaranteed
- The plan only shows pipes owned by SSE Utility Solutions Limited, Indigo Pipelines Limited
- Service pipes etc. may not be shown but their presence should be anticipated
- You must use safe digging practices in accordance with H5(G)47 to establish the actual position of mains, services and other apparatus before any mechanical excavation is used
- It is your responsibility to ensure this information is provided to all persons working near our plant
- If in doubt call the SSE Enterprise Dial Before You Dig team on 0345 070 7386.

Please note: If you have overlaps or misalignments between base maps that make it difficult to understand please contact DBYDEnterpriseEnquiries@sse.com or call 0345 070 7386

Scale: 1:2500 (When plotted at A4)



Indigo Pipelines Ltd.
 Registered Office:
 Loddon Reach,
 Reading Road,
 Arborfield,
 Reading,
 Berkshire, RG2 9HU

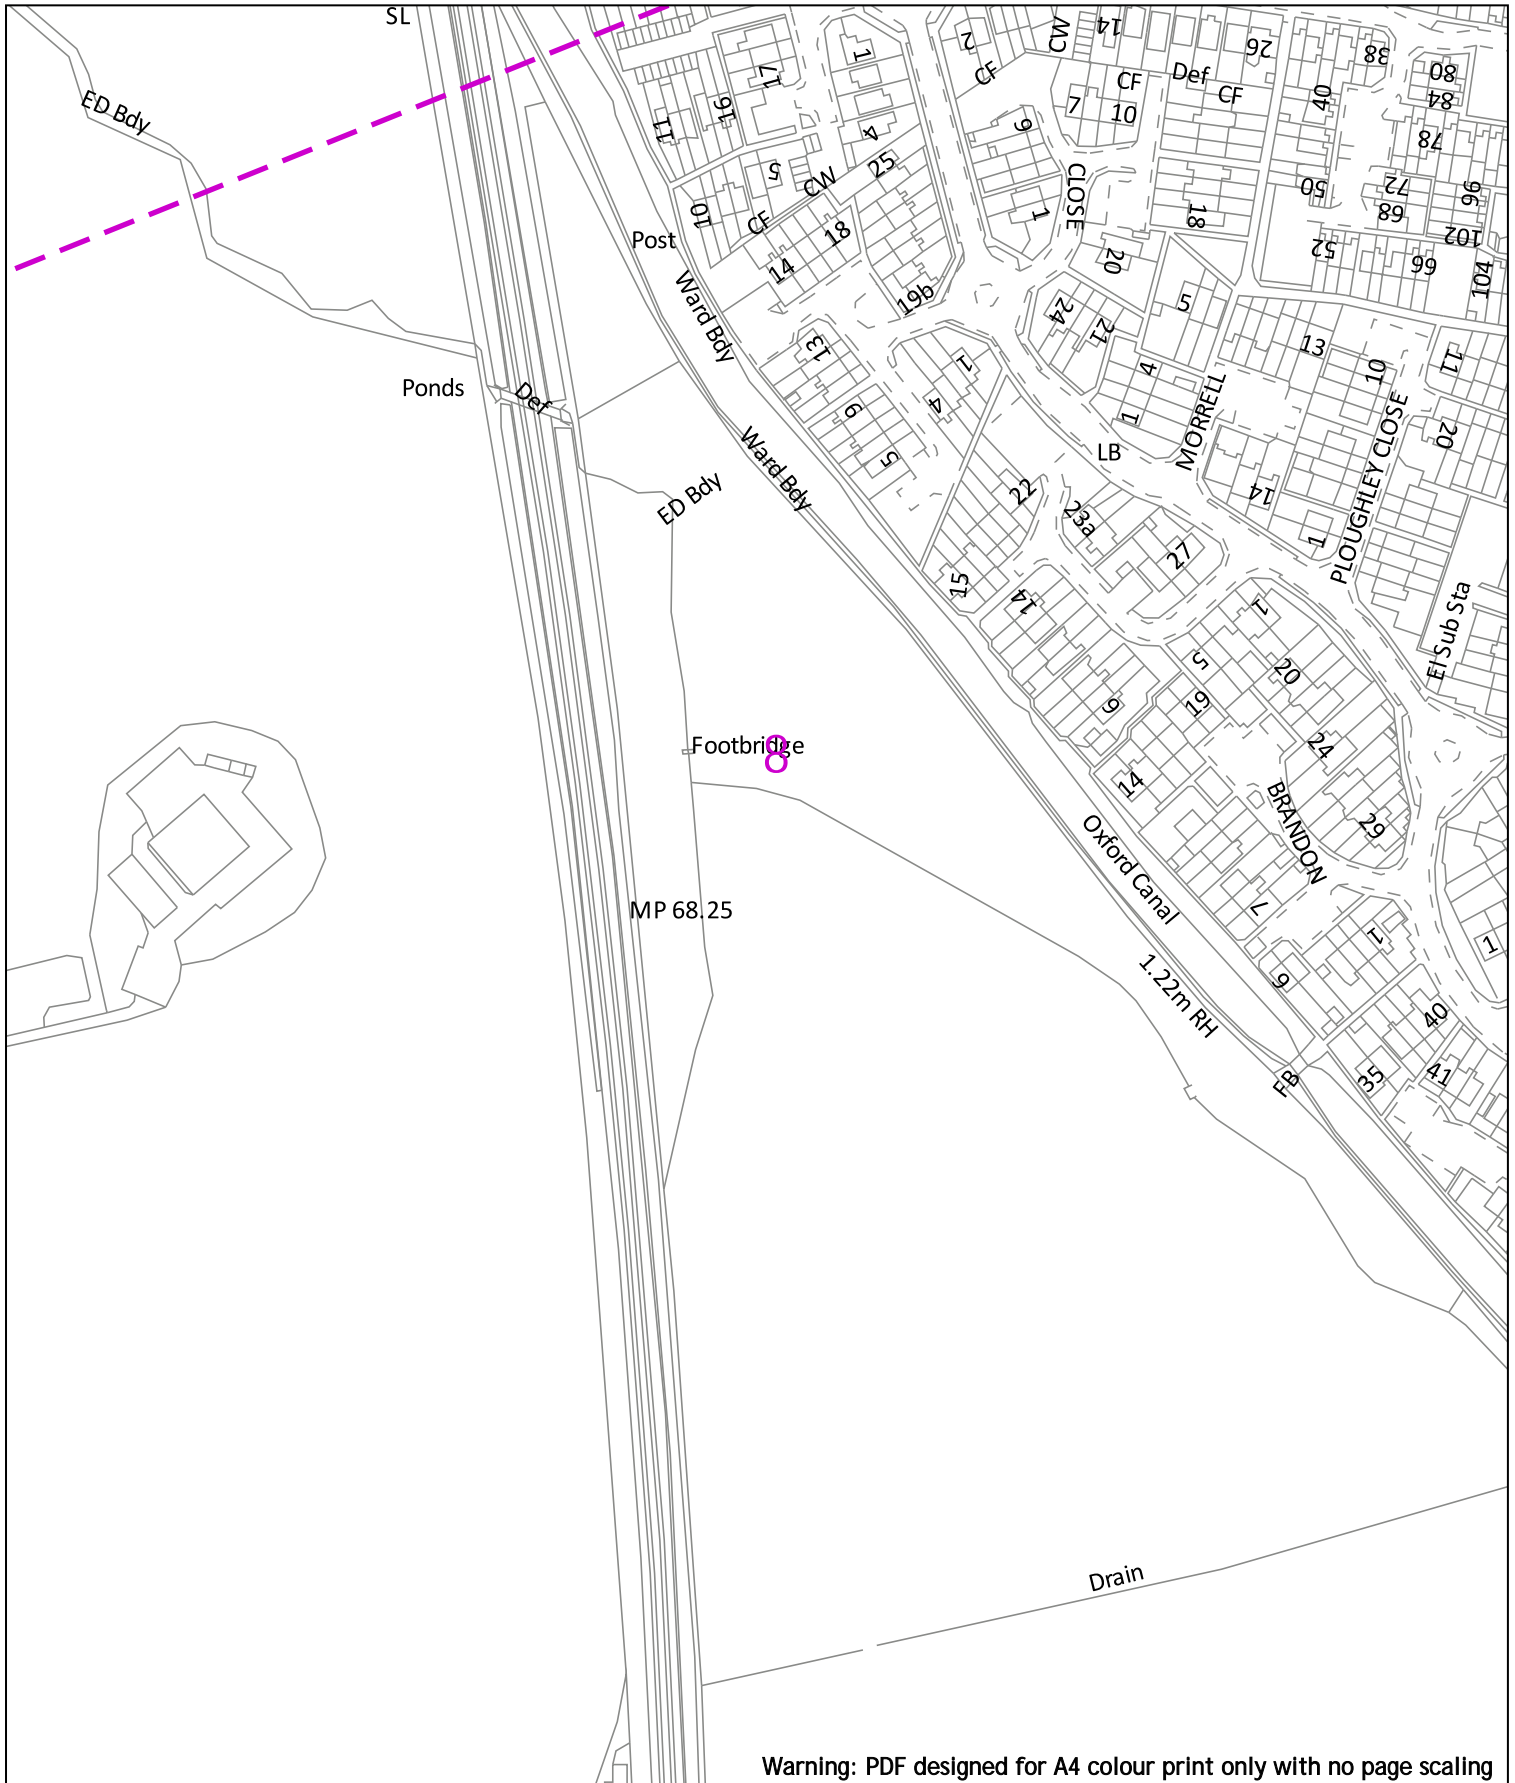

Warning: PDF designed for A4 colour print only with no page scaling

0 20m Dig Sites Area: Line:

Date Requested: 24/06/2022
 Job Reference: 25880986
 Site Location: 447899 213853
 Requested by: Mr Joe Shawyer
 Your Scheme/Reference: 31188_001

	LP Main		Valve Closed		Reducer
	LP Service		Valve Open		Ducting
	MP Main		CSEP		Gas Supply Point
	MP Service		Pressure Reduction Station		
	IP Main		End Closure		



Indigo Pipelines Ltd.
 Registered Office:
 Loddon Reach,
 Reading Road,
 Arborfield,
 Reading,
 Berkshire, RG2 9HU

IMPORTANT NOTICES

- This information is given as a guide only and its accuracy cannot be guaranteed
- The plan only shows pipes owned by SSE Utility Solutions Limited, Indigo Pipelines Limited
- Service pipes etc. may not be shown but their presence should be anticipated
- You must use safe digging practices in accordance with H5(G)47 to establish the actual position of mains, services and other apparatus before any mechanical excavation is used
- It is your responsibility to ensure this information is provided to all persons working near our plant
- If in doubt call the SSE Enterprise Dial Before You Dig team on 0345 070 7386.

Please note: If you have overlaps or misalignments between base maps that make it difficult to understand please contact DBYEnterpriseEnquiries@sse.com or call 0345 070 7386

Scale: 1:2500 (When plotted at A4)

Our Ref: 25881010 Your Ref: 31188_002

Friday, 24 June 2022

Joe Shawyer
Suite 6 Princess Caroline House 1 High Street
Southend on Sea
Essex
SS1 1JE

Dear Joe Shawyer

Indigo Pipelines Ltd - Asset Network Plans

In response to your enquiry regarding the location of network and equipment at the requested location, copies of our Record Plans are enclosed.

The plans show the positions and normal depths for the buried Indigo Pipelines Ltd Gas Plant. When they were installed. It must be stressed, however, that alterations to road alignments, surface levels and buildings may have been made subsequent to the records being taken. If you find buried Gas Plant that are not marked or are incorrectly marked, then you are required to contact us as soon as possible to give us the opportunity to amend our records.

Please note that the plans supplied are based on the location/map information supplied by yourselves and, therefore, YOU MUST SATISFY YOURSELF THAT OUR PLANS SUPPLIED ADEQUATELY COVER THE AREA THAT YOU REQUIRE.

Please note that these records only show Gas plant owned by Indigo Pipelines Ltd. There may be other privately owned buried Gas Plant in the area, which is outside the control of Indigo Pipelines Ltd. You should also check with the Local Authority, Cadent; Southern Gas Networks, Scotland Gas networks & Wales & West Utilities before proceeding.

For more information, consult the Health & Safety Executive's booklet HS (G) 47 - obtainable from the HSE.

I would particularly draw your attention to the need to take trial holes to determine the exact position and depth of buried Gas Plant to avoid the risk of injury to staff or damage to the existing Plant.

General Advice:

-
- a) Please ensure, where appropriate, that your CONTRACTORS have a copy of this letter and the enclosed plan(s).
 - b) Please note that the cost of any repairs or claims against Indigo Pipelines Ltd as a result of your works will be invoiced to you or your contractor.
 - c) Indigo Pipelines Ltd retains the right to its property, including disconnected cables and recoverable materials.

Should you require further information, please do not hesitate to contact me on the below telephone number.

Kind regards,

Indigo Pipelines Ltd

Contact Us

Emergency and Supply issues

In an emergency call 0800 111 999, 24 hours a day.

Mapping Enquiries


If you have an enquiry relating to this letter or the attached map plan, please contact us using the following information:

Telephone: 0345 070 7386.
Email: DBYDEnterpriseEnquiries@sse.com

LineSearchbeforeUdig

If you have an enquiry relating to the use of the LineSearchbeforeUdig website please contact LineSearchbeforeUdig using the following information:

Telephone: 0845 437 7365
Email: enquiries@linesearchbeforeudig.co.uk
Website: www.linesearchbeforeudig.co.uk

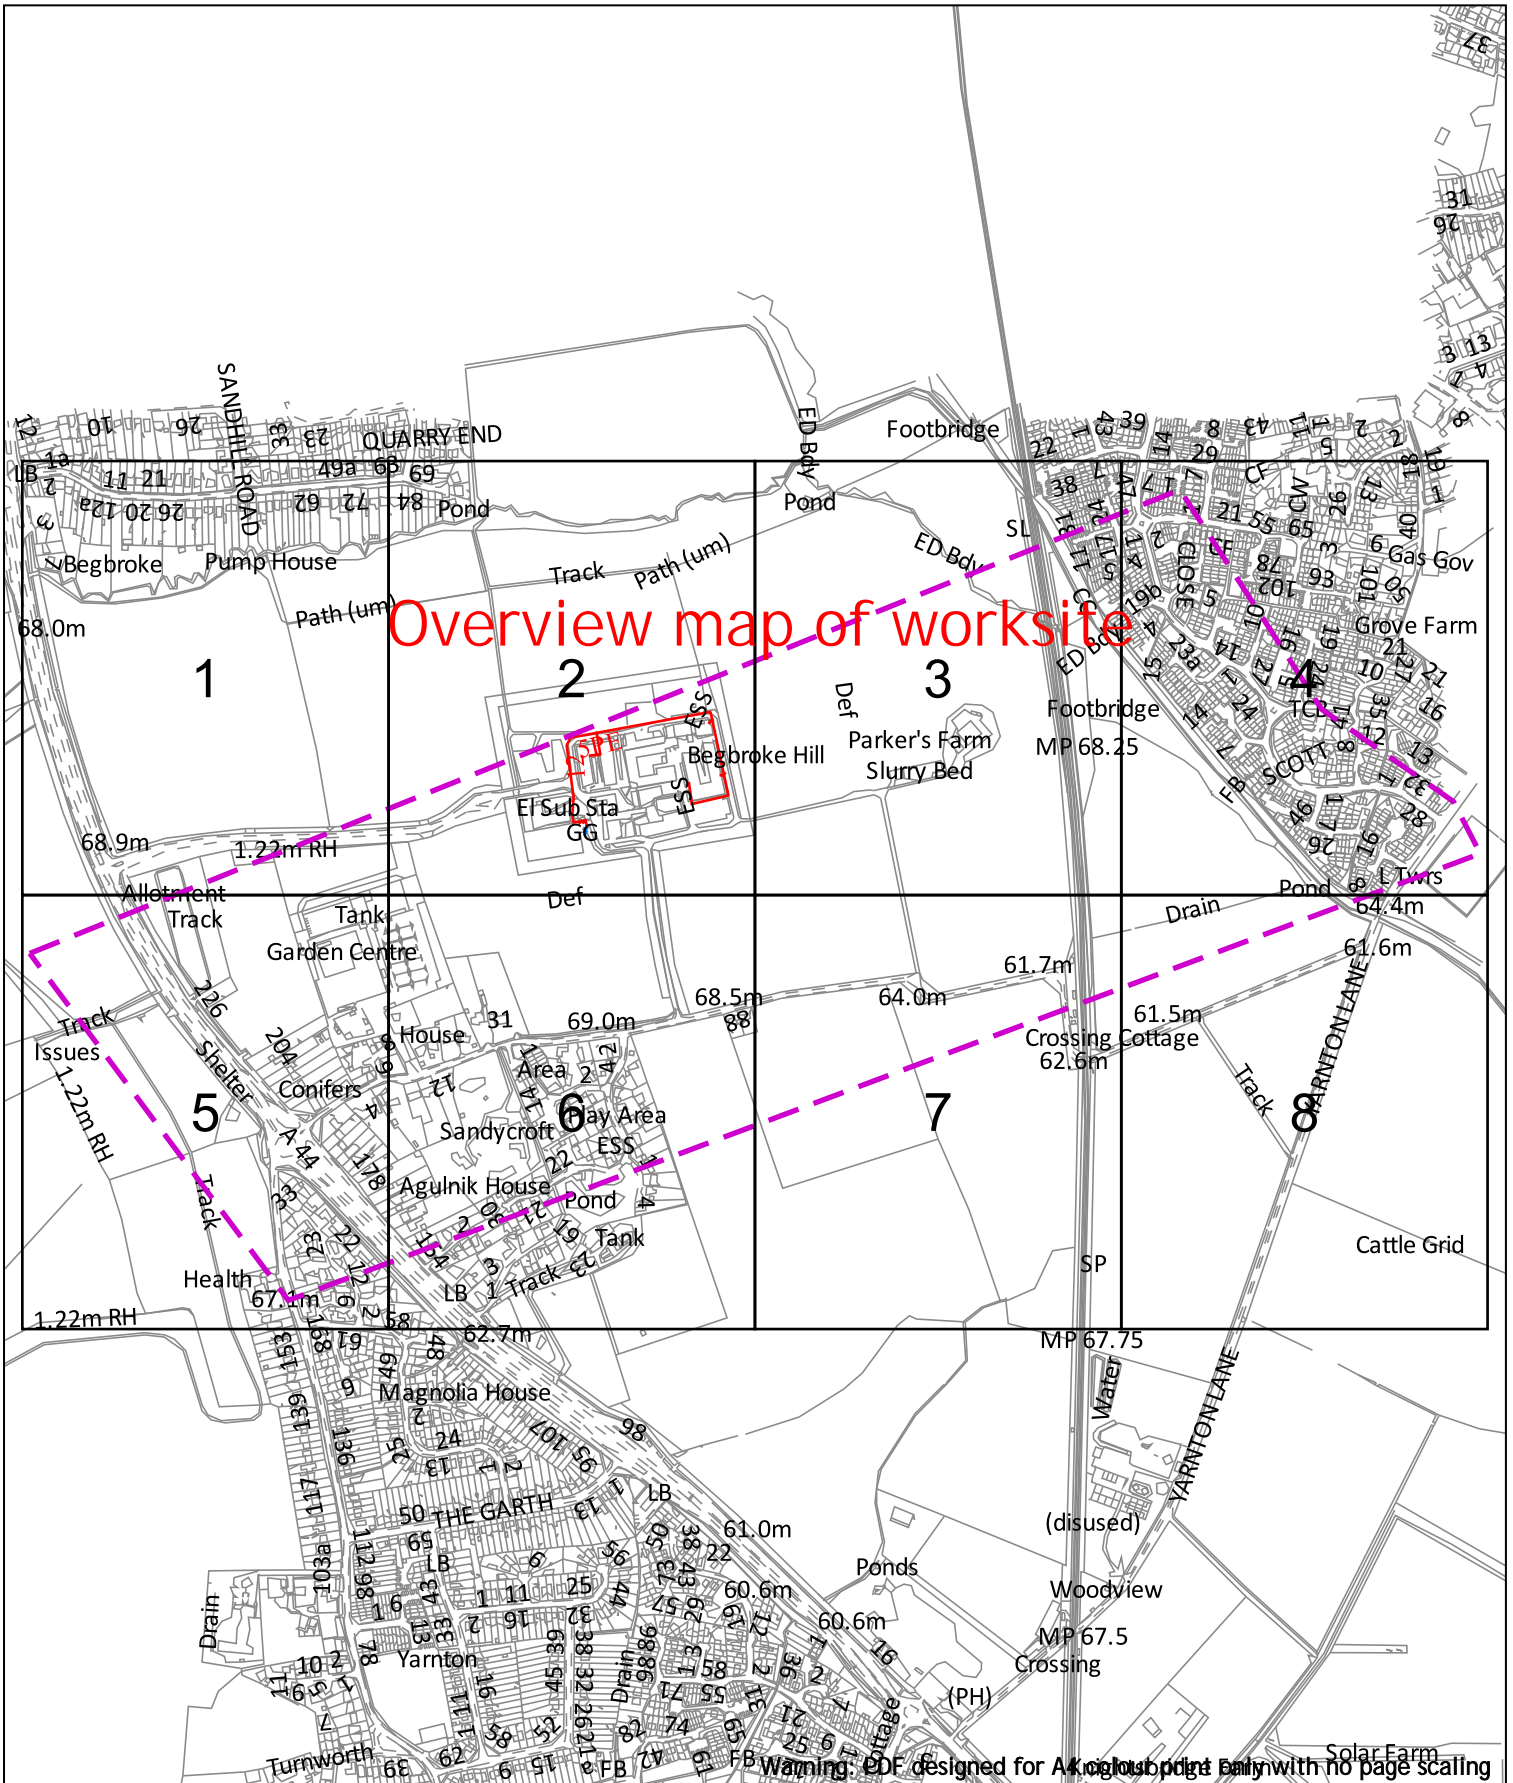

Dig Sites Area: Line:

Date Requested: 24/06/2022
 Job Reference: 25881010
 Site Location: 448066 213346
 Requested by: Mr Joe Shawyer
 Your Scheme/Reference: 31188_002

	LP Main		Valve Closed		Reducer
	LP Service		Valve Open		Ducting
	MP Main		CSEP		Gas Supply Point
	MP Service		Pressure Reduction Station		
	IP Main		End Closure		

IMPORTANT NOTICES


- This information is given as a guide only and its accuracy cannot be guaranteed
- The plan only shows pipes owned by SSE Utility Solutions Limited, Indigo Pipelines Limited
- Service pipes etc. may not be shown but their presence should be anticipated
- You must use safe digging practices in accordance with H5(G)47 to establish the actual position of mains, services and other apparatus before any mechanical excavation is used
- It is your responsibility to ensure this information is provided to all persons working near our plant
- If in doubt call the SSE Enterprise Dial Before You Dig team on 0345 070 7386.

Please note: If you have overlaps or misalignments between base maps that make it difficult to understand please contact DBYEnterpriseEnquiries@sse.com or call 0345 070 7386



Indigo Pipelines Ltd.
 Registered Office:
 Loddon Reach,
 Reading Road,
 Arborfield,
 Reading,
 Berkshire, RG2 9HU

Scale: 1:10250 (When plotted at A4)

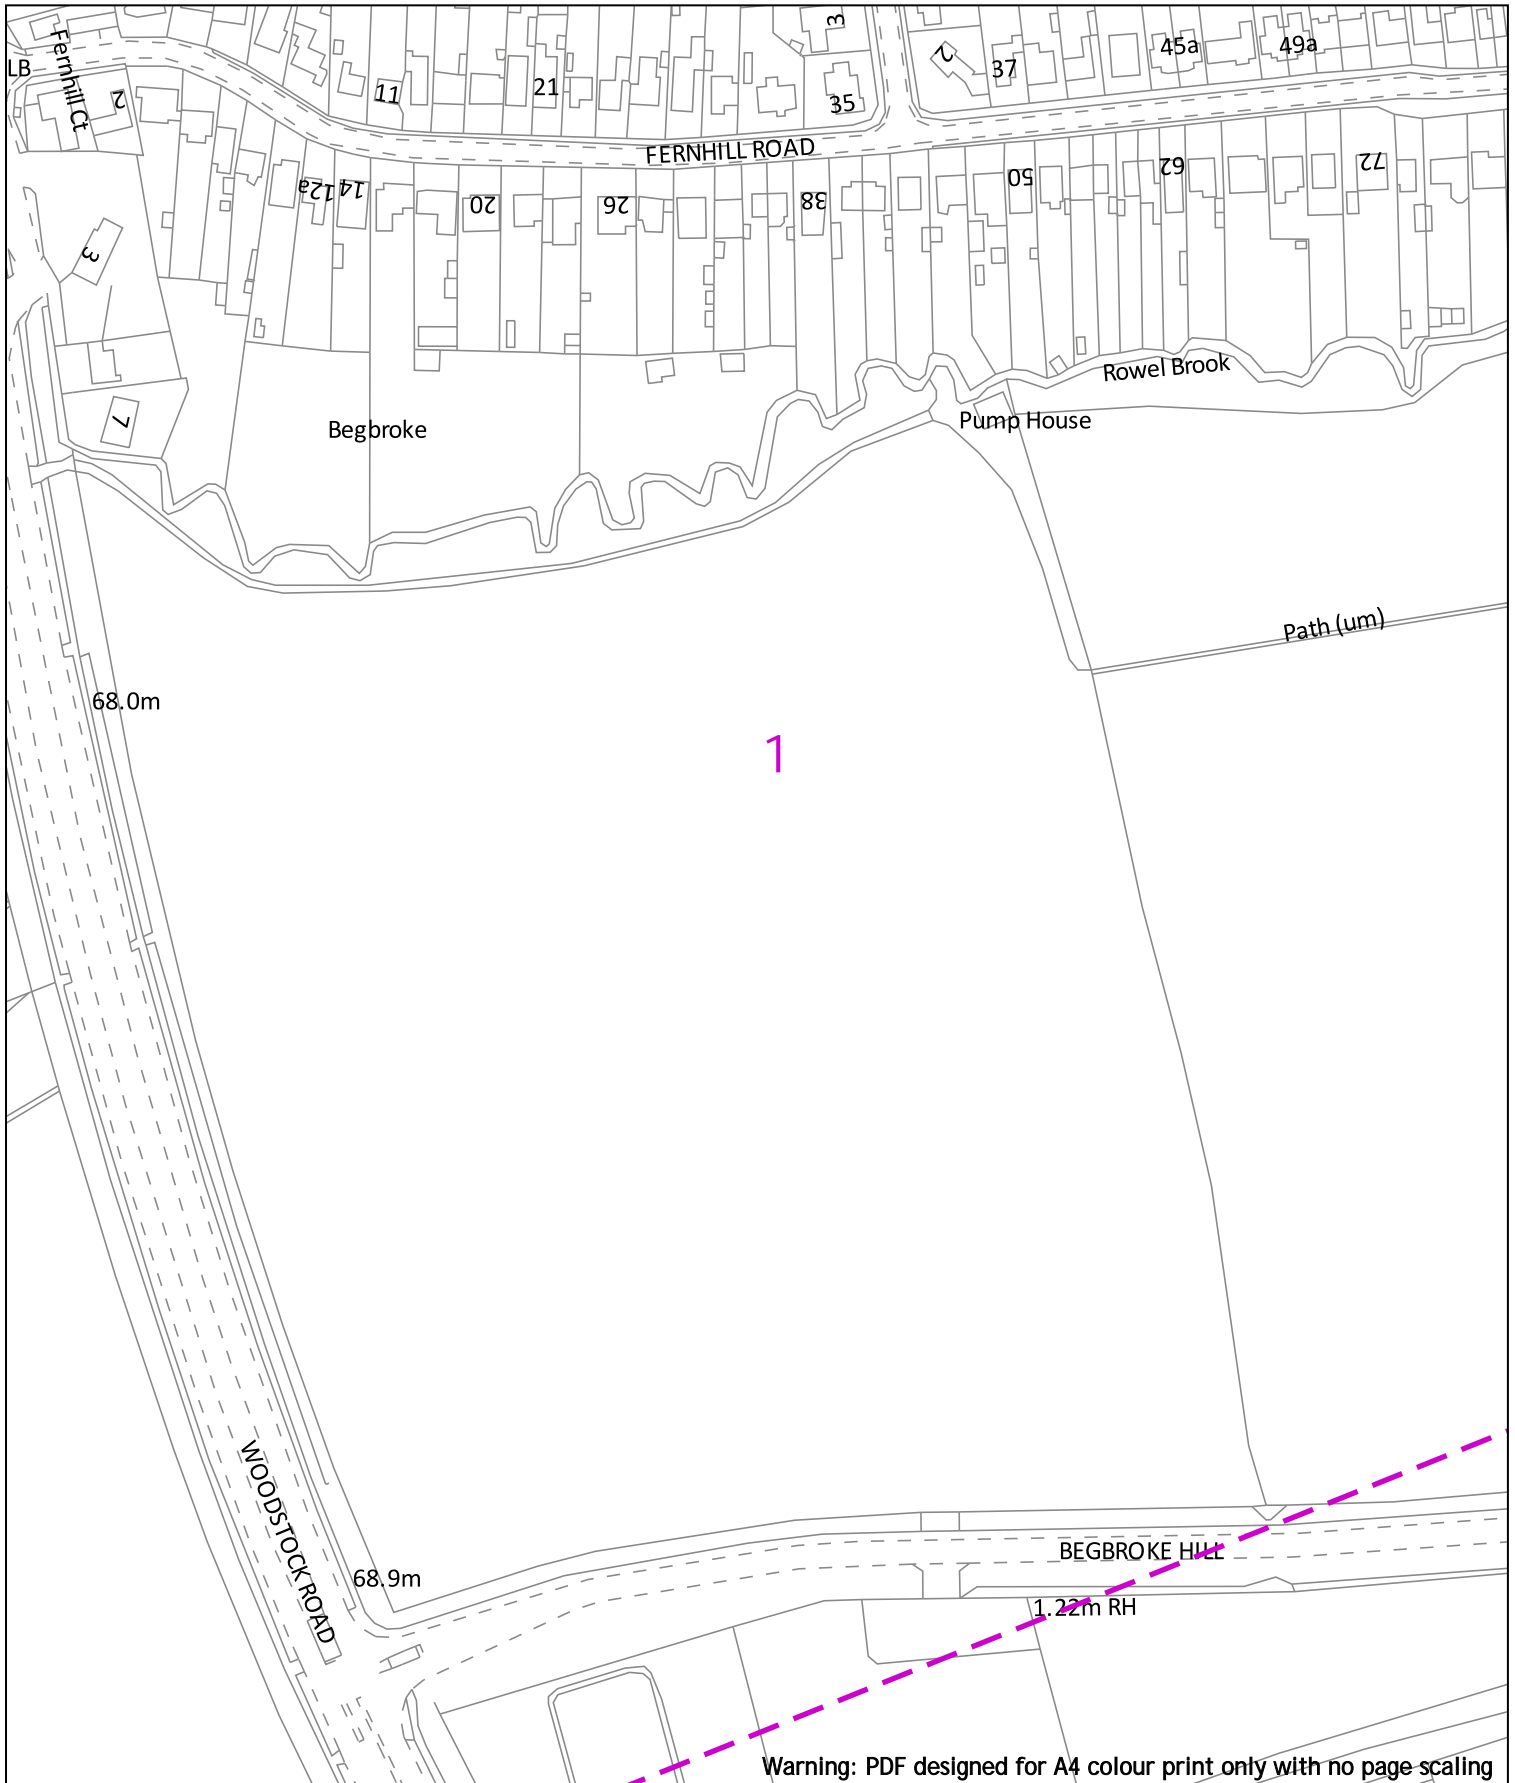


Warning: PDF designed for A4 colour print only with no page scaling

0 20m
 Date Requested: 24/06/2022
 Job Reference: 25881010
 Site Location: 448066 213346
 Requested by: Mr Joe Shawyer
 Your Scheme/Reference: 31188_002
 Scale: 1:2500 (When plotted at A4)

<p>Dig Sites Area: Line: </p> <p> LP Main LP Service MP Main MP Service IP Main </p>	<p> Valve Closed Valve Open CSEP Pressure Reduction Station End Closure </p>	<p> Reducer Ducting Gas Supply Point </p>
<p>IMPORTANT NOTICES</p> <ul style="list-style-type: none"> This information is given as a guide only and its accuracy cannot be guaranteed The plan only shows pipes owned by SSE Utility Solutions Limited, Indigo Pipelines Limited Service pipes etc. may not be shown but their presence should be anticipated You must use safe digging practices in accordance with H5(G)47 to establish the actual position of mains, services and other apparatus before any mechanical excavation is used It is your responsibility to ensure this information is provided to all persons working near our plant If in doubt call the SSE Enterprise Dial Before You Dig team on 0345 070 7386. <p>Please note: If you have overlaps or misalignments between base maps that make it difficult to understand please contact DBYEnterpriseEnquiries@sse.com or call 0345 070 7386</p>		

Indigo Pipelines Ltd.
 Registered Office:
 Loddon Reach,
 Reading Road,
 Arborfield,
 Reading,
 Berkshire, RG2 9HU

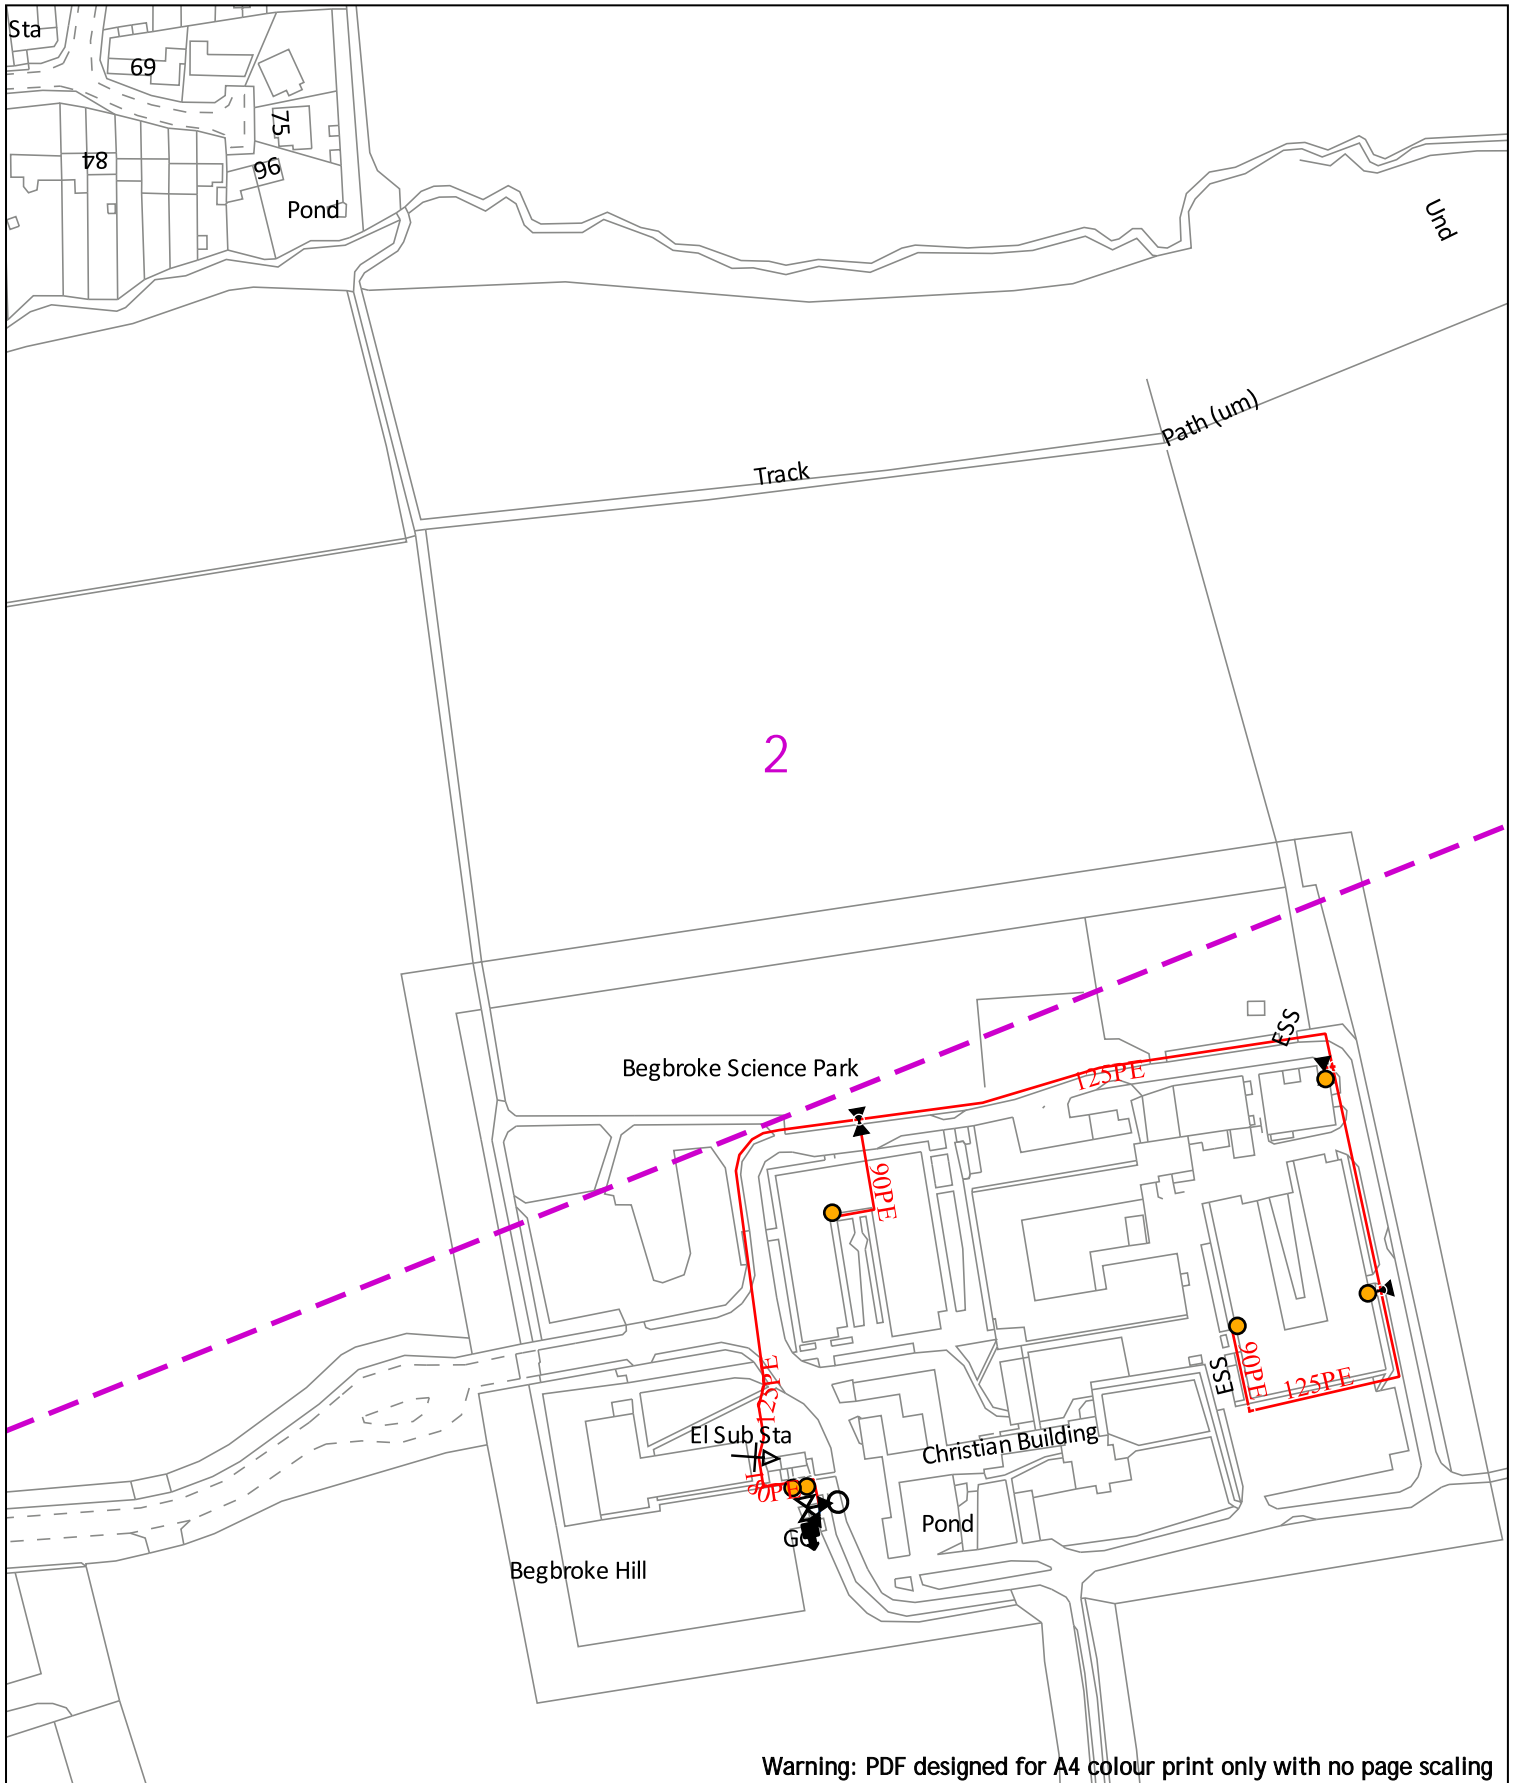

Warning: PDF designed for A4 colour print only with no page scaling

0 20m

Dig Sites Area: Line:

Date Requested: 24/06/2022
 Job Reference: 25881010
 Site Location: 448066 213346
 Requested by: Mr Joe Shawyer
 Your Scheme/Reference: 31188_002

	LP Main		Valve Closed		Reducer
	LP Service		Valve Open		Ducting
	MP Main		CSEP		Gas Supply Point
	MP Service		Pressure Reduction Station		
	IP Main		End Closure		

IMPORTANT NOTICES


- This information is given as a guide only and its accuracy cannot be guaranteed
- The plan only shows pipes owned by SSE Utility Solutions Limited, Indigo Pipelines Limited
- Service pipes etc. may not be shown but their presence should be anticipated
- You must use safe digging practices in accordance with H5(G)47 to establish the actual position of mains, services and other apparatus before any mechanical excavation is used
- It is your responsibility to ensure this information is provided to all persons working near our plant
- If in doubt call the SSE Enterprise Dial Before You Dig team on 0345 070 7386.

Please note: If you have overlaps or misalignments between base maps that make it difficult to understand please contact DBYDEnterpriseEnquiries@sse.com or call 0345 070 7386



Indigo Pipelines Ltd.
 Registered Office:
 Loddon Reach,
 Reading Road,
 Arborfield,
 Reading,
 Berkshire, RG2 9HU

Scale: 1:2500 (When plotted at A4)

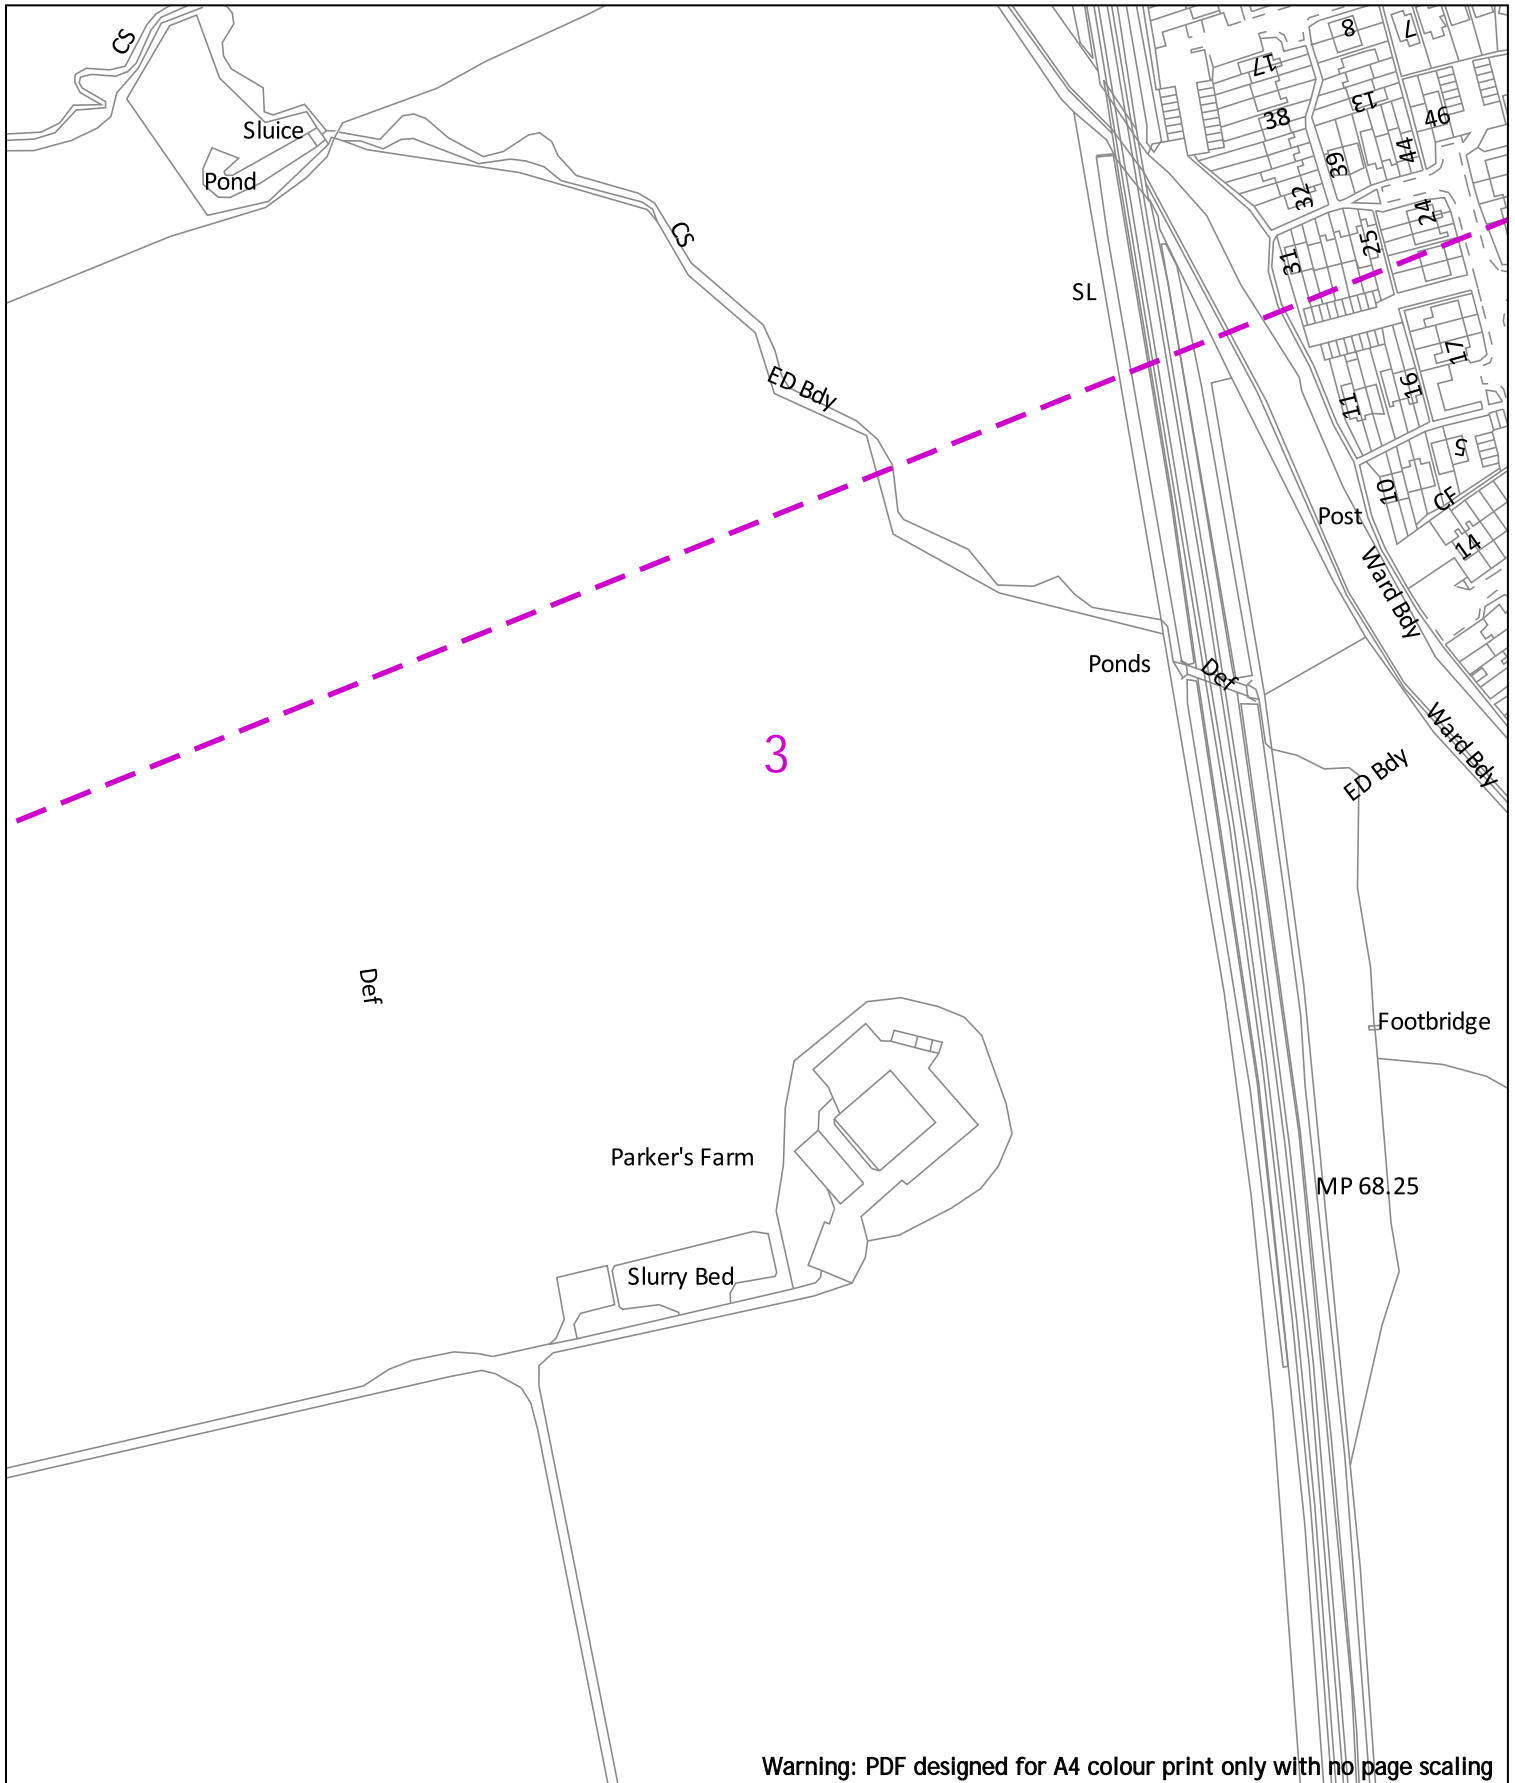

Warning: PDF designed for A4 colour print only with no page scaling

0 20m

Dig Sites Area: Line:

Date Requested: 24/06/2022
 Job Reference: 25881010
 Site Location: 448066 213346
 Requested by: Mr Joe Shawyer
 Your Scheme/Reference: 31188_002

	LP Main		Valve Closed		Reducer
	LP Service		Valve Open		Ducting
	MP Main		CSEP		Gas Supply Point
	MP Service		Pressure Reduction Station		
	IP Main		End Closure		

IMPORTANT NOTICES


- This information is given as a guide only and its accuracy cannot be guaranteed
- The plan only shows pipes owned by SSE Utility Solutions Limited, Indigo Pipelines Limited
- Service pipes etc. may not be shown but their presence should be anticipated
- You must use safe digging practices in accordance with H5(G)47 to establish the actual position of mains, services and other apparatus before any mechanical excavation is used
- It is your responsibility to ensure this information is provided to all persons working near our plant
- If in doubt call the SSE Enterprise Dial Before You Dig team on 0345 070 7386.

Please note: If you have overlaps or misalignments between base maps that make it difficult to understand please contact DBYEnterpriseEnquiries@sse.com or call 0345 070 7386



Indigo Pipelines Ltd.
 Registered Office:
 Loddon Reach,
 Reading Road,
 Arborfield,
 Reading,
 Berkshire, RG2 9HU

Scale: 1:2500 (When plotted at A4)

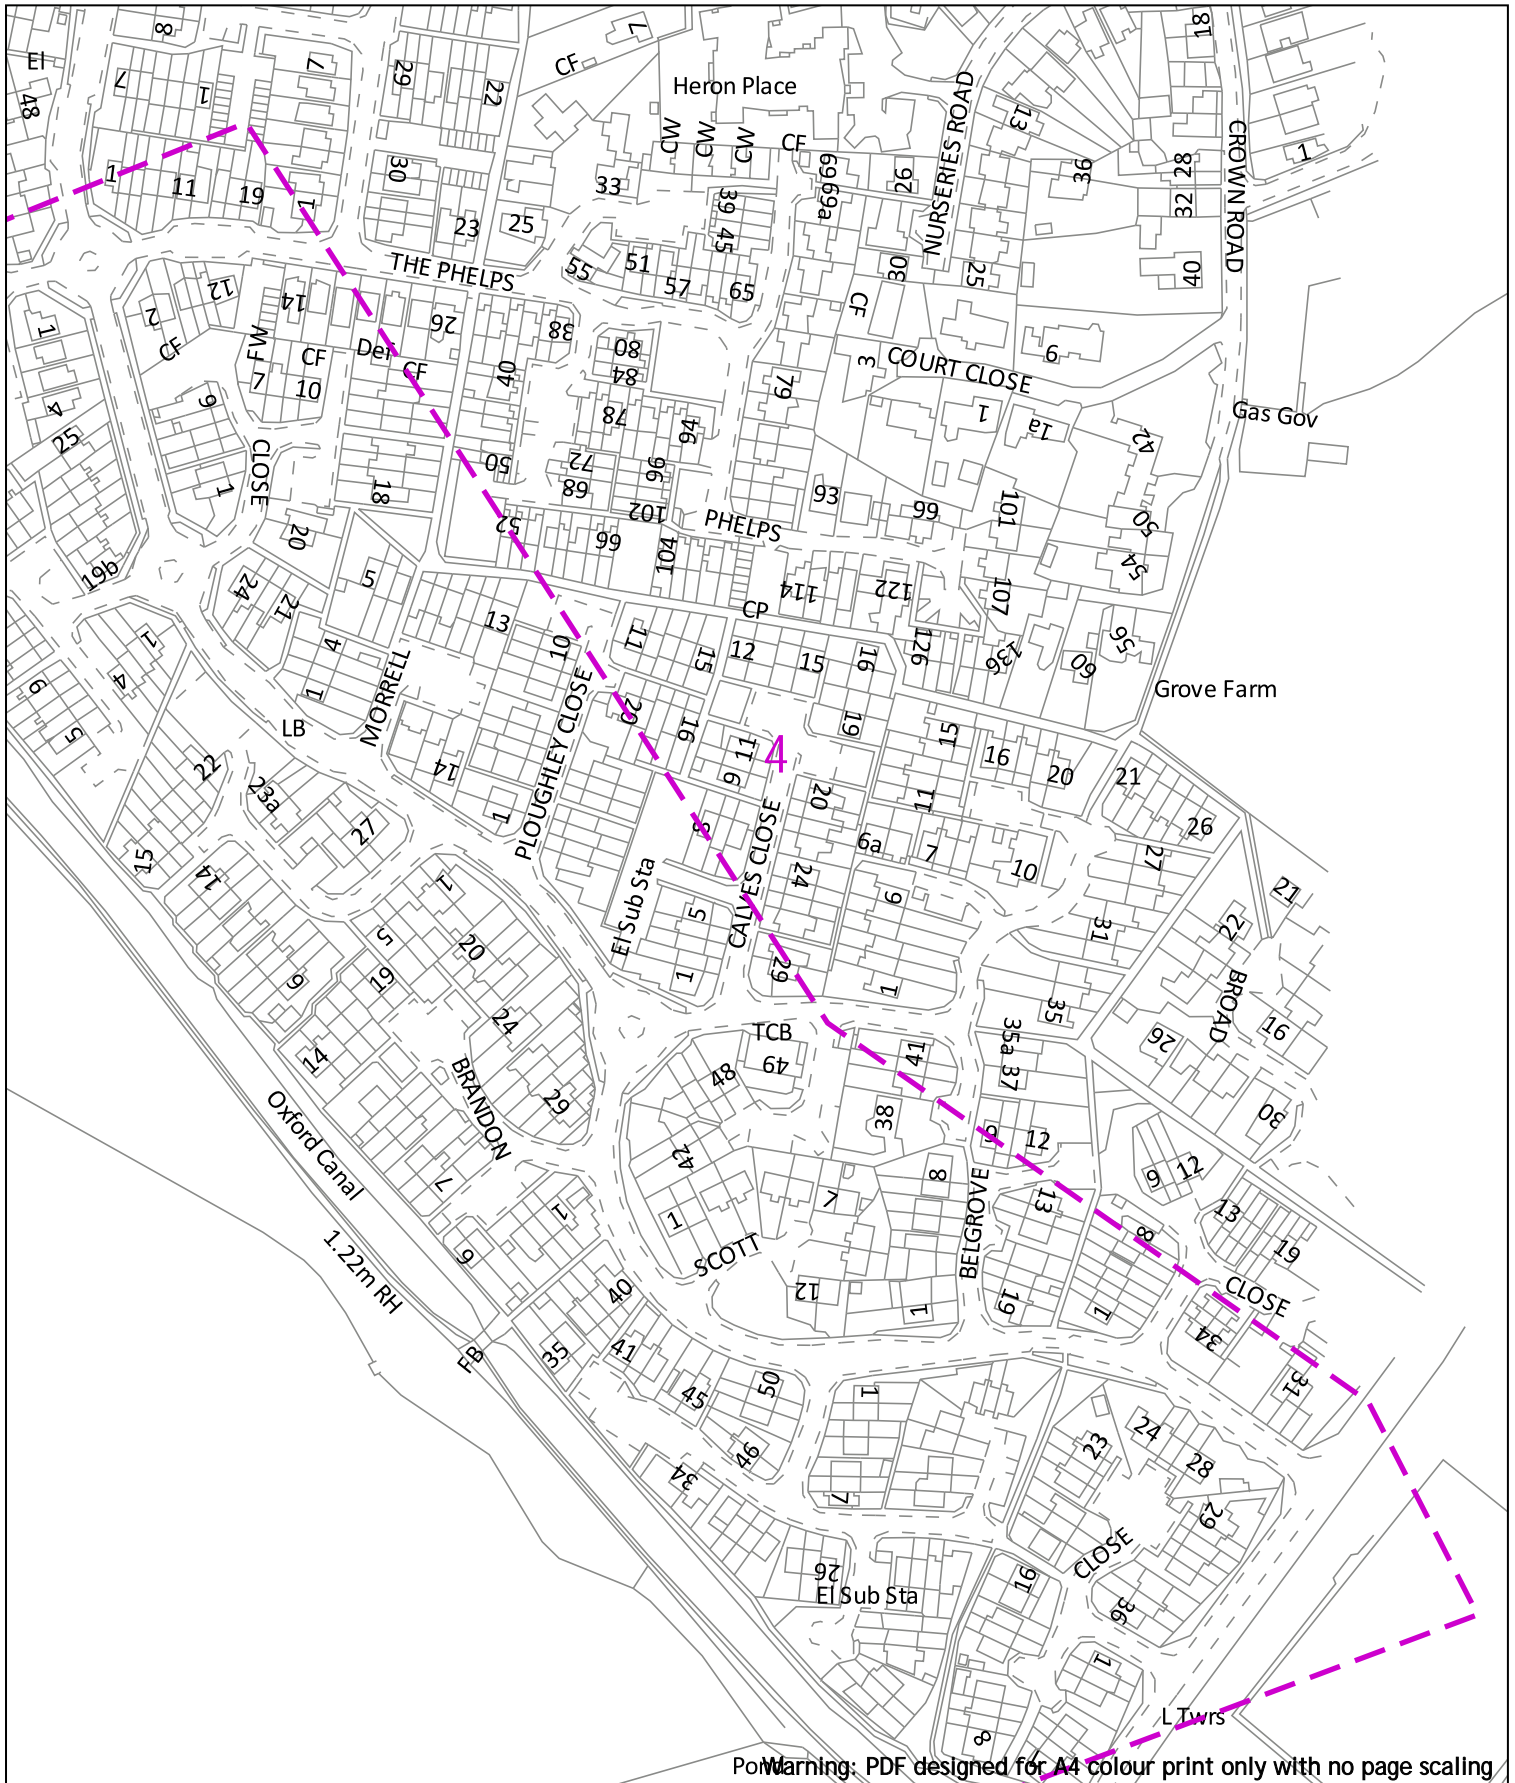

Warning: PDF designed for A4 colour print only with no page scaling



Date Requested: 24/06/2022
 Job Reference: 25881010
 Site Location: 448066 213346
 Requested by: Mr Joe Shawyer
 Your Scheme/Reference: 31188_002

	LP Main		Valve Closed		Reducer
	LP Service		Valve Open		Ducting
	MP Main		CSEP		Gas Supply Point
	MP Service		Pressure Reduction Station		
	IP Main		End Closure		

IMPORTANT NOTICES


- This information is given as a guide only and its accuracy cannot be guaranteed
- The plan only shows pipes owned by SSE Utility Solutions Limited, Indigo Pipelines Limited
- Service pipes etc. may not be shown but their presence should be anticipated
- You must use safe digging practices in accordance with H5(G)47 to establish the actual position of mains, services and other apparatus before any mechanical excavation is used
- It is your responsibility to ensure this information is provided to all persons working near our plant
- If in doubt call the SSE Enterprise Dial Before You Dig team on 0345 070 7386.

Please note: If you have overlaps or misalignments between base maps that make it difficult to understand please contact DBYDEnterpriseEnquiries@sse.com or call 0345 070 7386

Scale: 1:2500 (When plotted at A4)



Indigo Pipelines Ltd.
 Registered Office:
 Loddon Reach,
 Reading Road,
 Arborfield,
 Reading,
 Berkshire, RG2 9HU

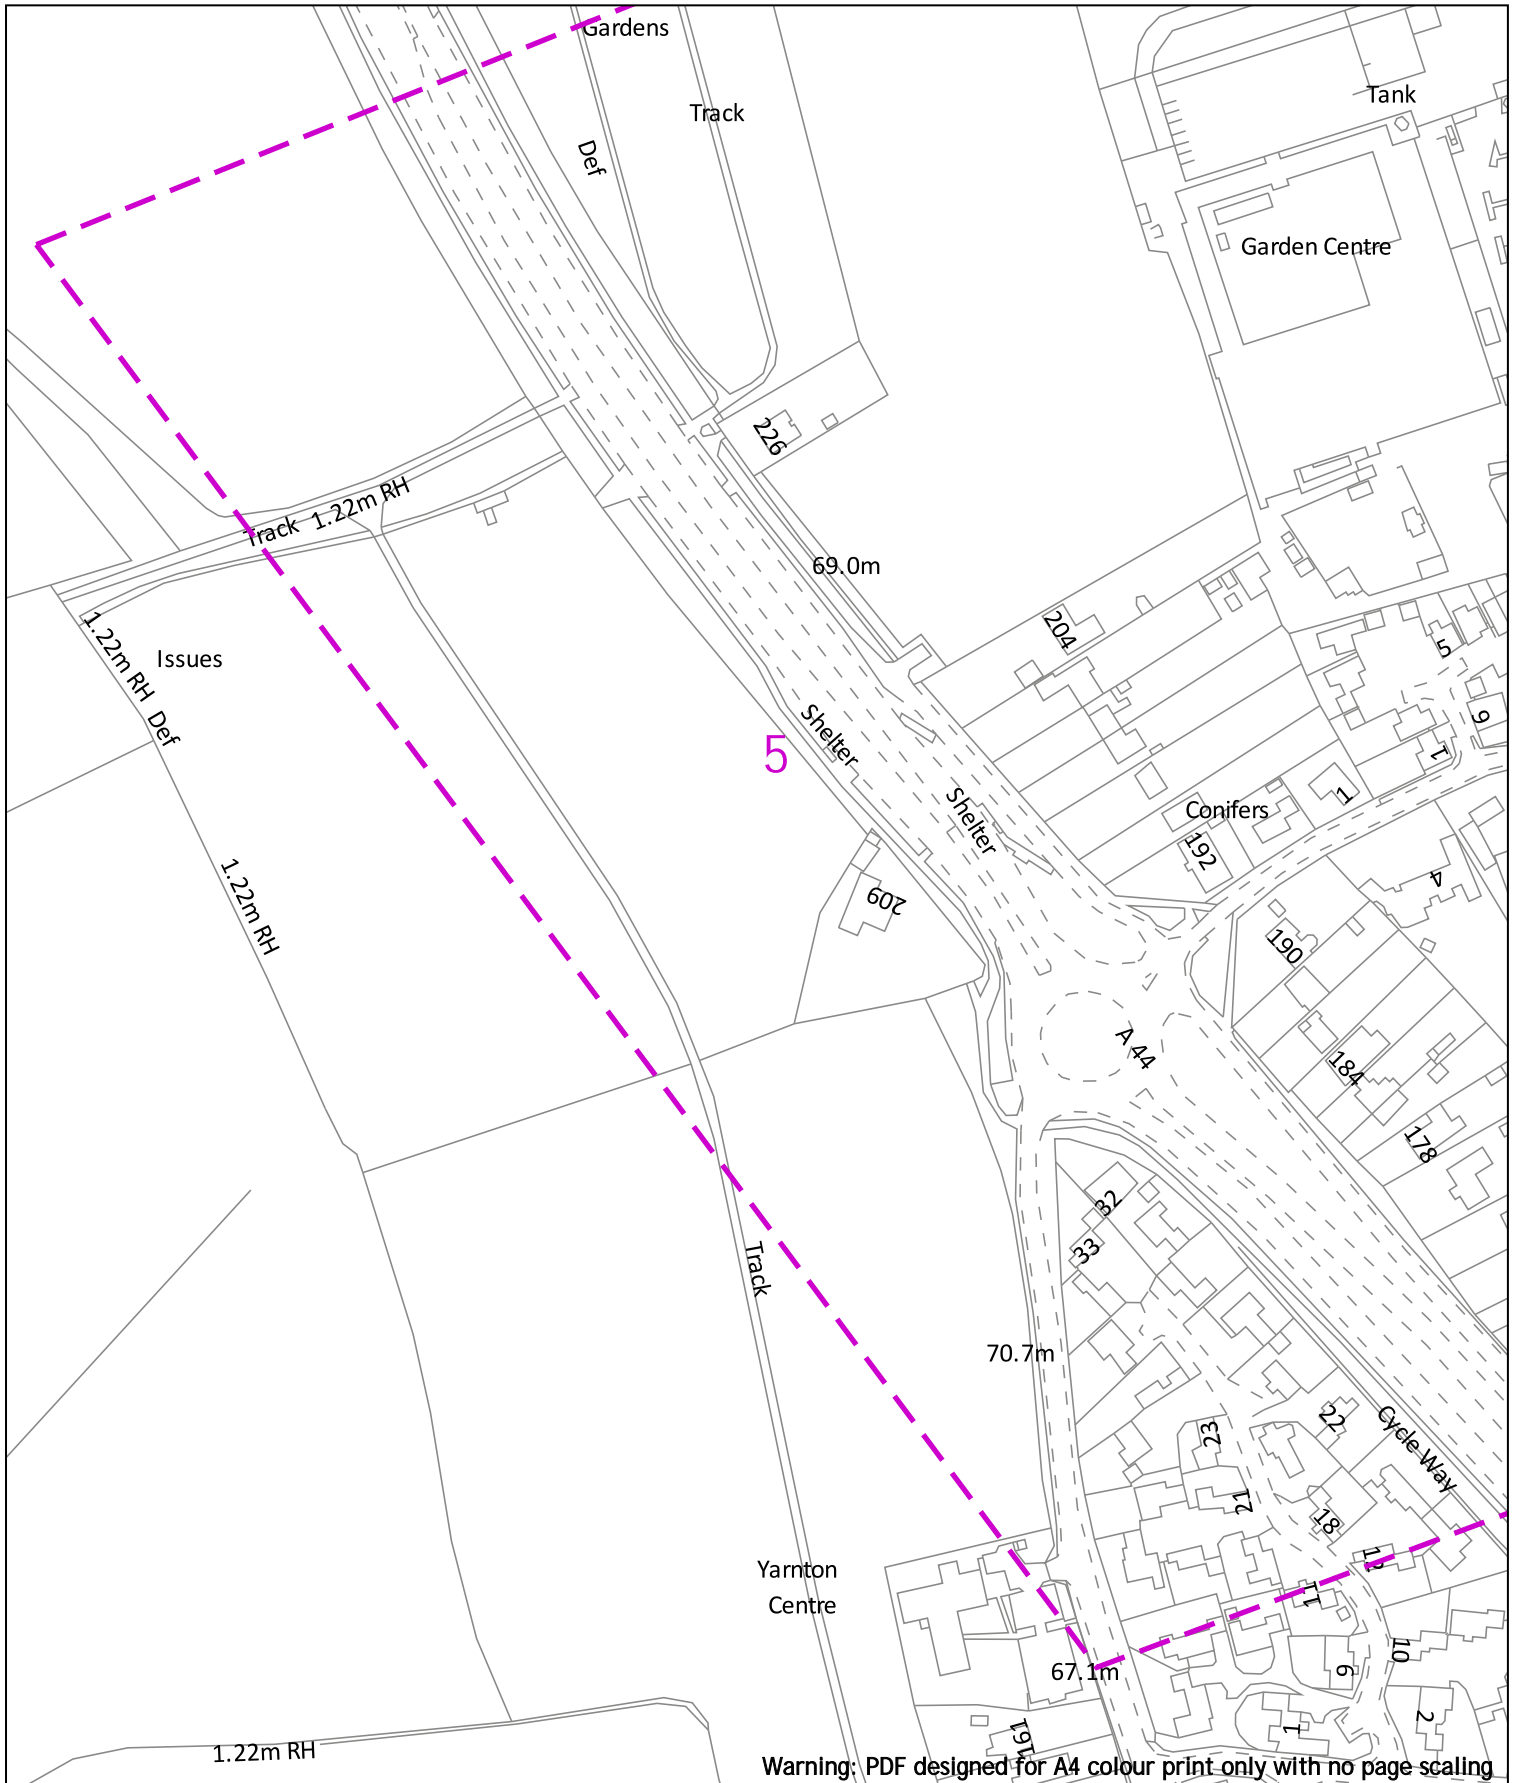

0 20m Dig Sites Area: Line:

LP Main	Valve Closed	Reducer
LP Service	Valve Open	Ducting
MP Main	CSEP	Gas Supply Point
MP Service	Pressure Reduction Station	
IP Main	End Closure	


IMPORTANT NOTICES

- This information is given as a guide only and its accuracy cannot be guaranteed
- The plan only shows pipes owned by SSE Utility Solutions Limited, Indigo Pipelines Limited
- Service pipes etc. may not be shown but their presence should be anticipated
- You must use safe digging practices in accordance with H5(G)47 to establish the actual position of mains, services and other apparatus before any mechanical excavation is used
- It is your responsibility to ensure this information is provided to all persons working near our plant
- If in doubt call the SSE Enterprise Dial Before You Dig team on 0345 070 7386.

Please note: If you have overlaps or misalignments between base maps that make it difficult to understand please contact DBYDEnterpriseEnquiries@sse.com or call 0345 070 7386

Scale: 1:2500 (When plotted at A4)

Indigo Pipelines Ltd.
Registered Office:
Loddon Reach,
Reading Road,
Arborfield,
Reading,
Berkshire, RG2 9HU

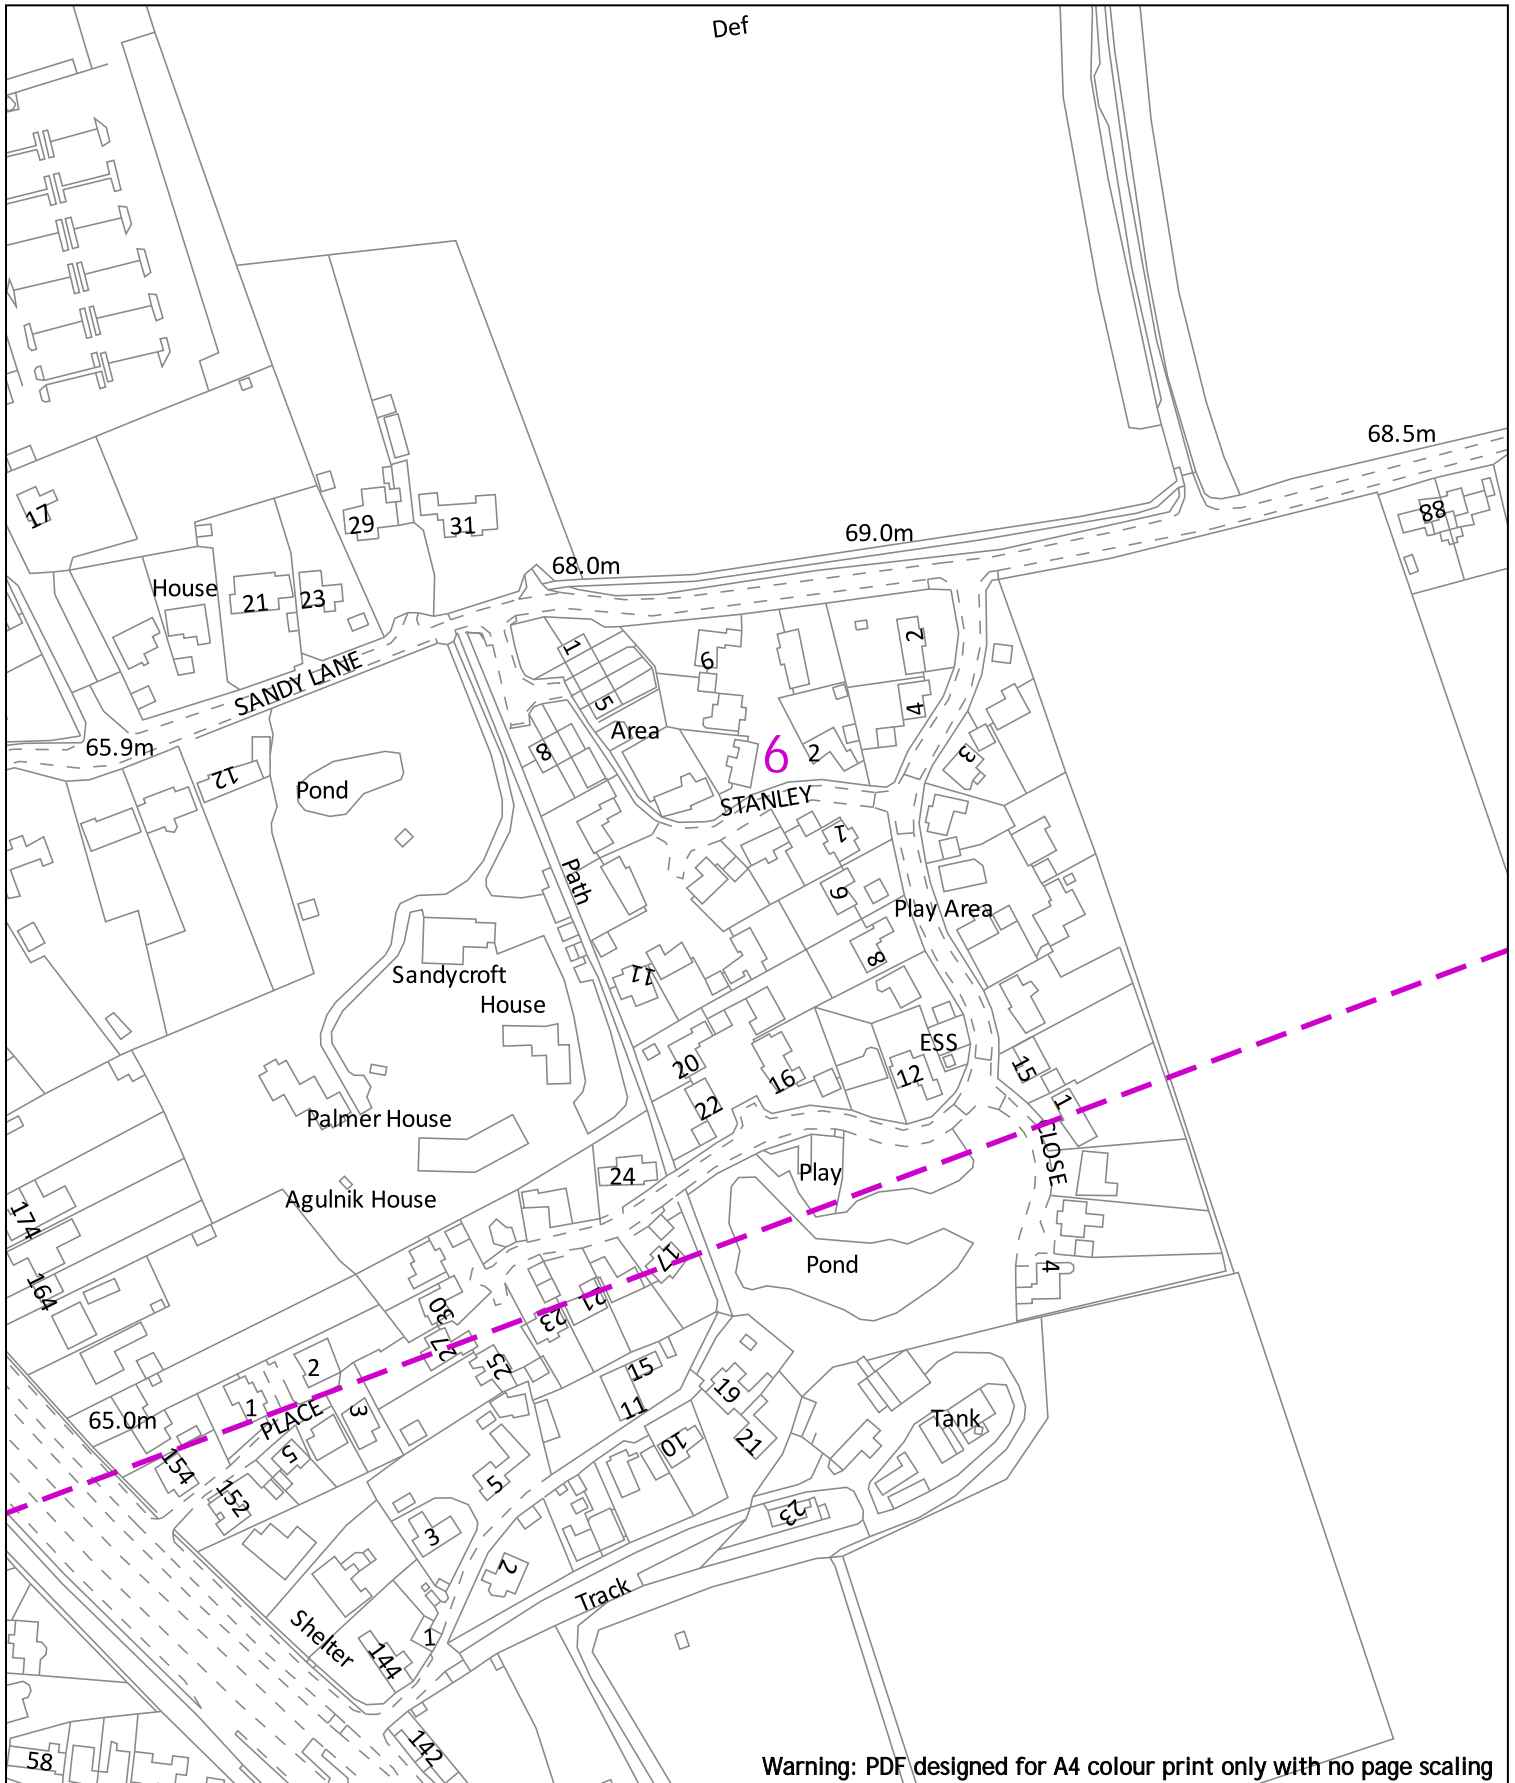

Warning: PDF designed for A4 colour print only with no page scaling

0 20m Dig Sites Area: Line:

LP Main	Valve Closed	Reducer
LP Service	Valve Open	Ducting
MP Main	CSEP	Gas Supply Point
MP Service	Pressure Reduction Station	
IP Main	End Closure	

IMPORTANT NOTICES


- This information is given as a guide only and its accuracy cannot be guaranteed
- The plan only shows pipes owned by SSE Utility Solutions Limited, Indigo Pipelines Limited
- Service pipes etc. may not be shown but their presence should be anticipated
- You must use safe digging practices in accordance with H5(G)47 to establish the actual position of mains, services and other apparatus before any mechanical excavation is used
- It is your responsibility to ensure this information is provided to all persons working near our plant
- If in doubt call the SSE Enterprise Dial Before You Dig team on 0345 070 7386

Please note: If you have overlaps or misalignments between base maps that make it difficult to understand please contact DBYDEnterpriseEnquiries@sse.com or call 0345 070 7386

Date Requested: 24/06/2022
 Job Reference: 25881010
 Site Location: 448066 213346
 Requested by: Mr Joe Shawyer
 Your Scheme/Reference: 31188_002

Scale: 1:2500 (When plotted at A4)

Indigo Pipelines Ltd.
 Registered Office:
 Loddon Reach,
 Reading Road,
 Arborfield,
 Reading,
 Berkshire, RG2 9HU

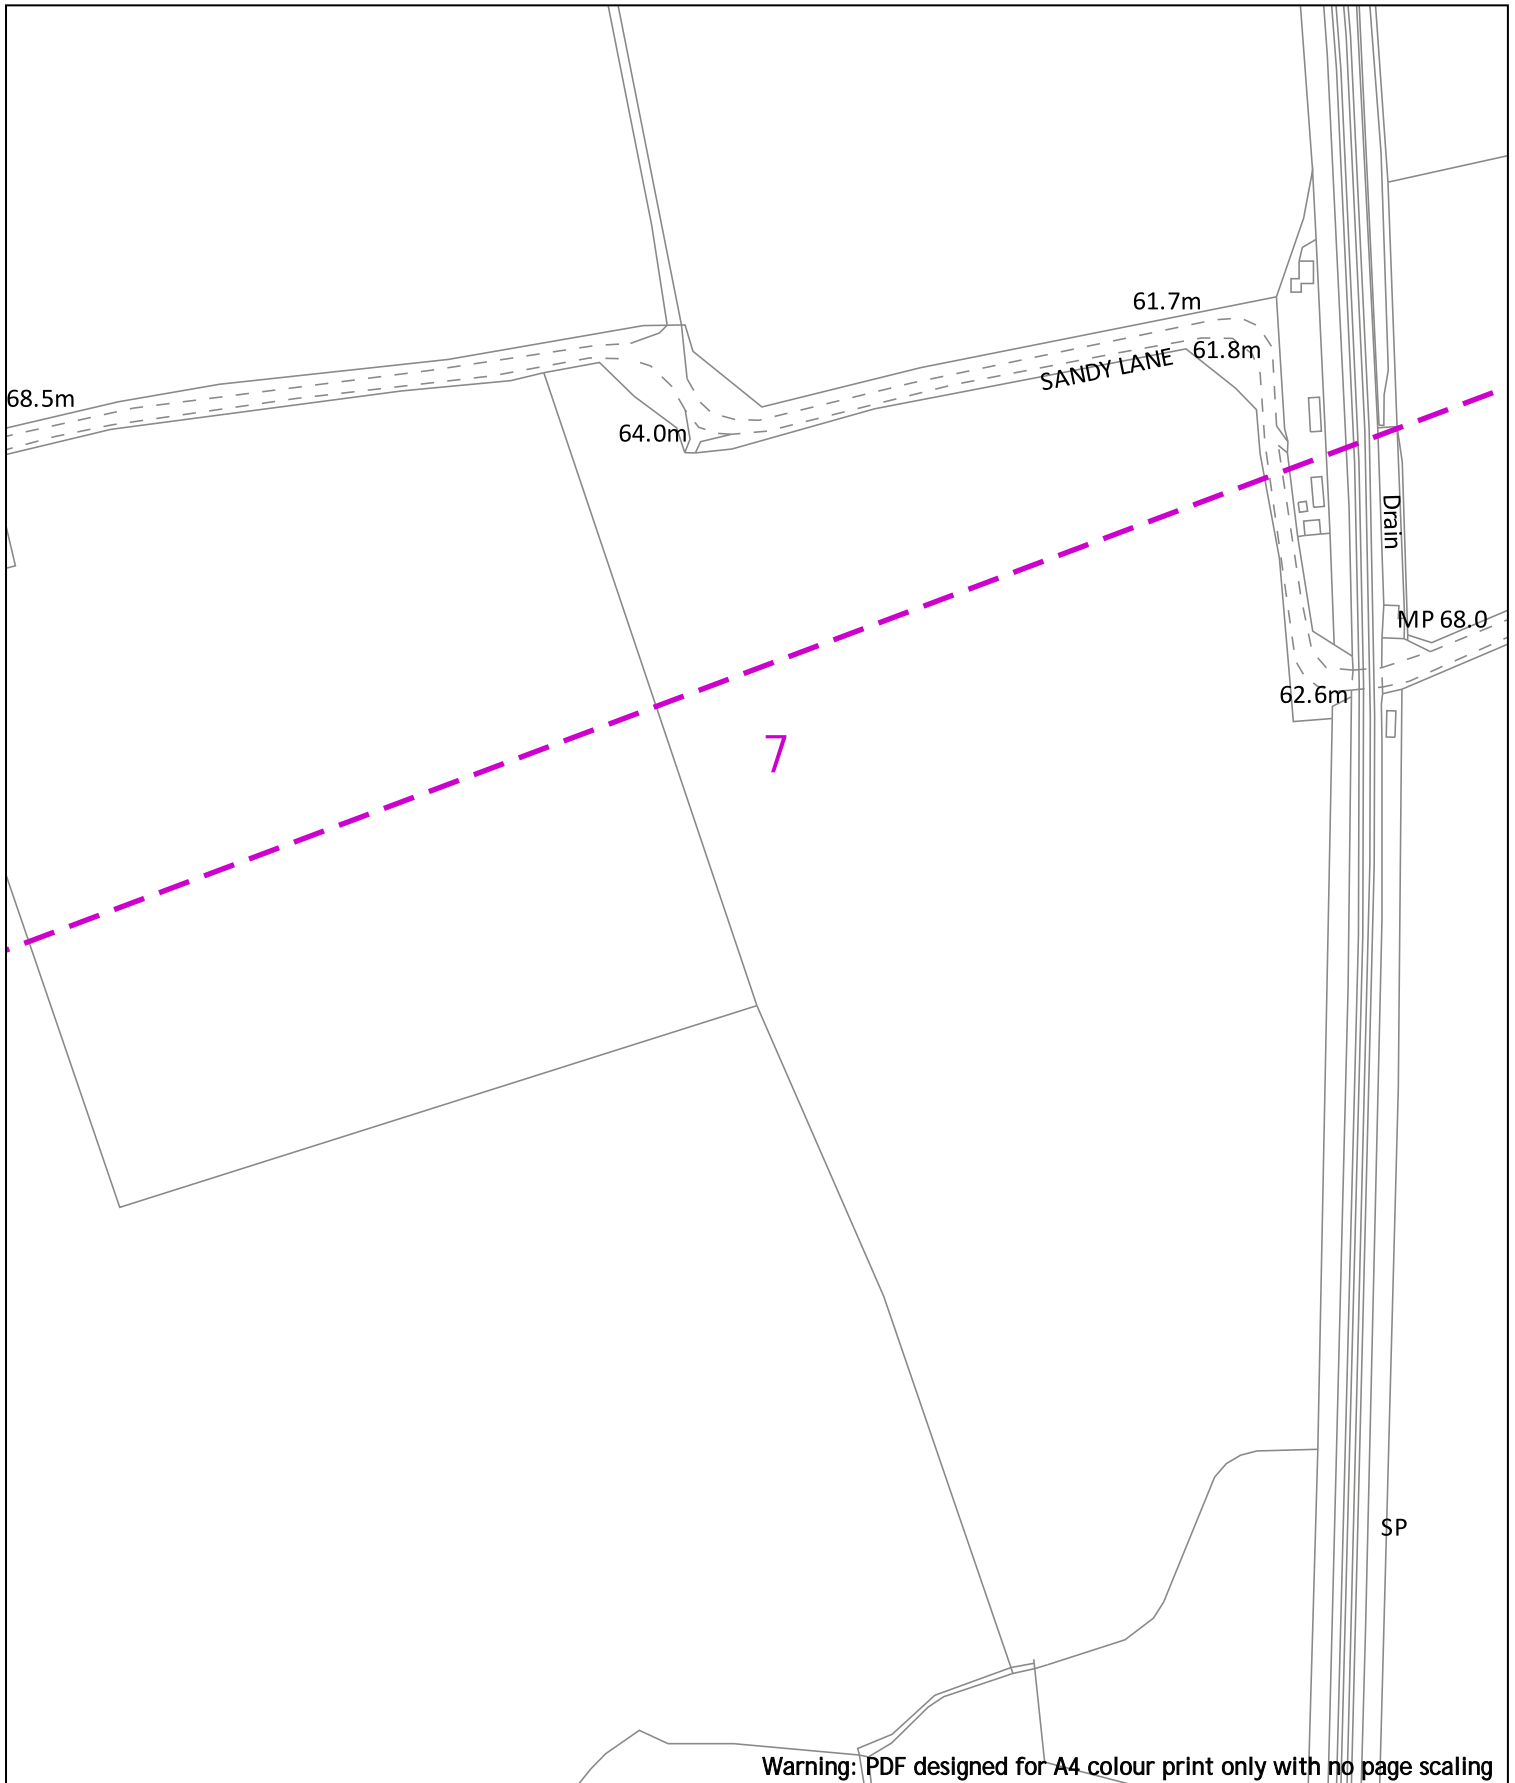

Warning: PDF designed for A4 colour print only with no page scaling

0 20m Dig Sites Area: Line:

LP Main	Valve Closed	Reducer
LP Service	Valve Open	Ducting
MP Main	CSEP	Gas Supply Point
MP Service	Pressure Reduction Station	
IP Main	End Closure	

IMPORTANT NOTICES


- This information is given as a guide only and its accuracy cannot be guaranteed
- The plan only shows pipes owned by SSE Utility Solutions Limited, Indigo Pipelines Limited
- Service pipes etc. may not be shown but their presence should be anticipated
- You must use safe digging practices in accordance with H5(G)47 to establish the actual position of mains, services and other apparatus before any mechanical excavation is used
- It is your responsibility to ensure this information is provided to all persons working near our plant
- If in doubt call the SSE Enterprise Dial Before You Dig team on 0345 070 7386.

Please note: If you have overlaps or misalignments between base maps that make it difficult to understand please contact DBYDEnterpriseEnquiries@sse.com or call 0345 070 7386

Scale: 1:2500 (When plotted at A4)



Indigo Pipelines Ltd.
 Registered Office:
 Loddon Reach,
 Reading Road,
 Arborfield,
 Reading,
 Berkshire, RG2 9HU

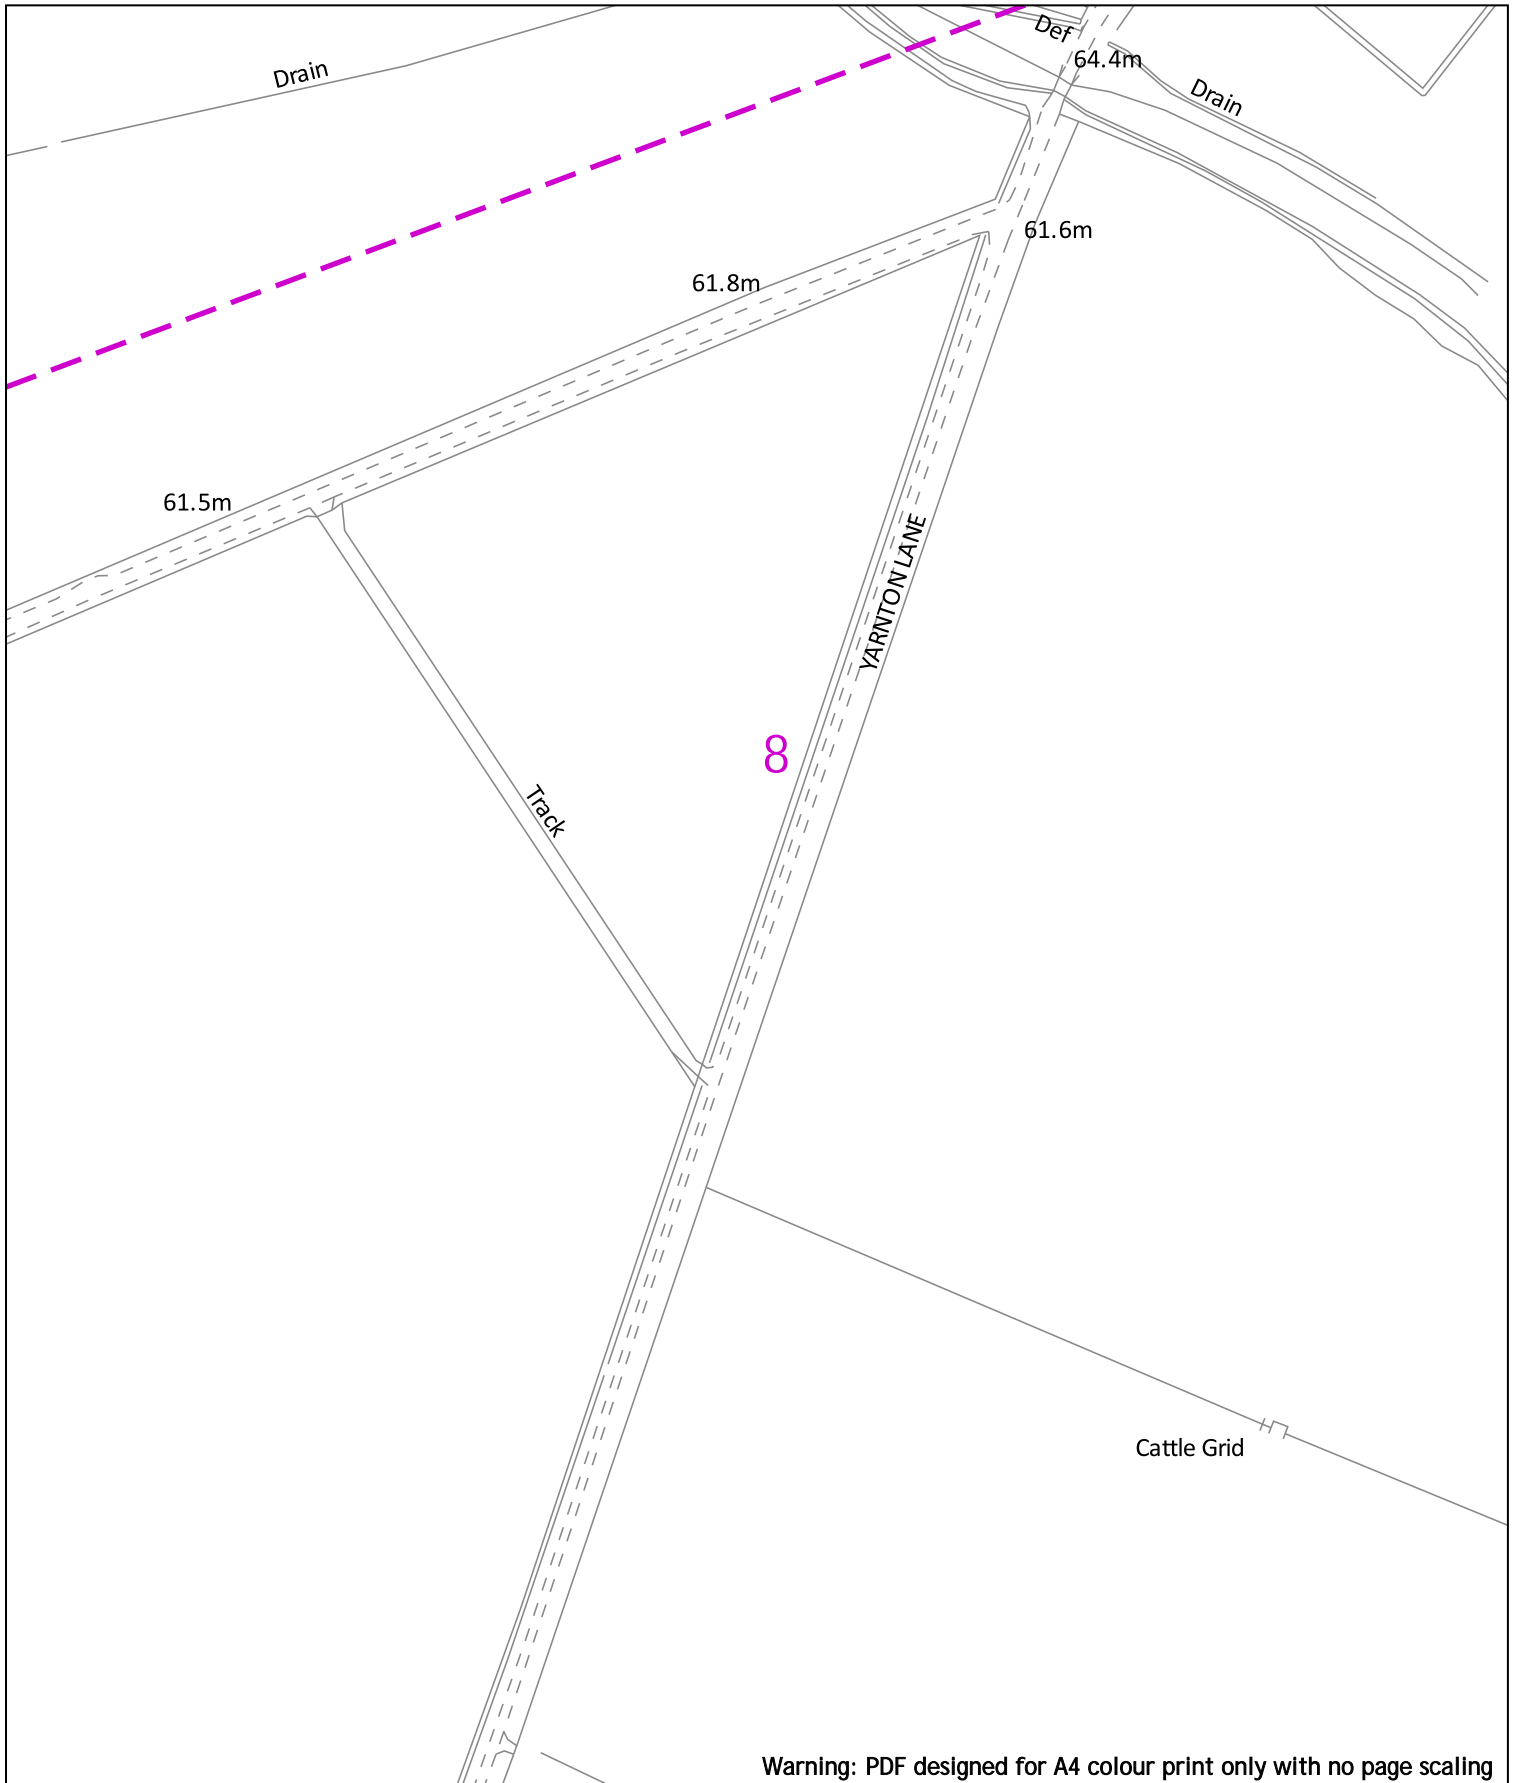

Warning: PDF designed for A4 colour print only with no page scaling

0 20m Dig Sites Area: Line:

LP Main	Valve Closed	Reducer
LP Service	Valve Open	Ducting
MP Main	CSEP	Gas Supply Point
MP Service	Pressure Reduction Station	
IP Main	End Closure	

IMPORTANT NOTICES

- This information is given as a guide only and its accuracy cannot be guaranteed
- The plan only shows pipes owned by SSE Utility Solutions Limited, Indigo Pipelines Limited
- Service pipes etc. may not be shown but their presence should be anticipated
- You must use safe digging practices in accordance with H5(G)47 to establish the actual position of mains, services and other apparatus before any mechanical excavation is used
- It is your responsibility to ensure this information is provided to all persons working near our plant
- If in doubt call the SSE Enterprise Dial Before You Dig team on 0345 070 7386.

Please note: If you have overlaps or misalignments between base maps that make it difficult to understand please contact DBYDEnterpriseEnquiries@sse.com or call 0345 070 7386

Scale: 1:2500 (When plotted at A4)

Indigo Pipelines Ltd.
 Registered Office:
 Loddon Reach,
 Reading Road,
 Arborfield,
 Reading,
 Berkshire, RG2 9HU

General Conditions to be observed for the Protection of Apparatus and the Prevention of Disruption to Gas Supplies

General conditions affecting the design, construction or maintenance of services and/or structures or other works in the vicinity of Indigo Pipelines' plant, pipelines and associated installations:

These general conditions apply only to the gas apparatus and pipes operated by Indigo Pipelines. It is possible that there may be other gas transporters with apparatus in the vicinity, therefore you should ensure that you have made enquiries of them and have complied with their requirements.

1. GRAPHIC REPRESENTATION OF GAS MAINS

Any plans supplied or marked up by Indigo will indicate the **APPROXIMATE** location of its apparatus. This information is provided as a general guide only; its accuracy cannot be guaranteed and is given without obligation or warranty. Service pipes are not shown but their presence should be anticipated. No liability whatsoever is accepted by Indigo Pipelines, its agents or servants for any error, omission, discrepancy or deviation. Plans on site should be current, i.e. no older than 28 days from the date of issue. Gas pipes owned by other Gas Transporters, or otherwise privately owned, may be present in this area; information with regard to such pipes should be obtained from the relevant owners.

Should you require assistance on site locating Indigo Pipelines' apparatus, please contact our Gas Asset Management team on 0345 072 1919.

2. METHODS OF WORKING

The following methods of work shall not normally be permitted within the limits of distance indicated (relative to the established pipe position). Any variances must have consent from Indigo Pipelines before works commence on site:

Mechanical Excavation	3m (1m for low pressure mains)	Hydraulic Testing	8 m
Piling / Pile removing / Boring	15m	Welding or other hot works*	15m
Directional Drill Operations	15m	Explosives	250m

* NOTE: Welding or other hot works involving naked flames shall be carried out at a safe distance to the satisfaction of an Indigo Pipelines Engineer. A check should be made prior to the commencement of works, to ensure a gas free atmosphere exists. It is also necessary to monitor the atmosphere at regular intervals for the duration of the works. In no case shall such activities take place in any Indigo Pipelines Utilities Easement without the written consent and in the presence of an Indigo representative.

Indigo Pipelines must be consulted prior to carrying out any excavation work within **10m** of any above or below ground gas installations or pipeline

In addition to the above methods of working, Indigo Pipelines must be contacted prior to any External Wall Installation (EWI) schemes, proposed solar farms and wind turbine installations.

No work shall be undertaken near, nor heavy plant or equipment moved over, any gas pipeline or apparatus until all of the conditions specified by Indigo Pipelines have been complied with.

Where Indigo Pipelines have apparatus in the vicinity of your work, any damage to it could have serious consequences. In view of this and in the interests of safety, a meeting should be arranged before the commencement of work on site between Indigo Pipeline representatives, representatives of the promoting authority, the contractors and any other interested parties. At this meeting the suggested programme of site works and plant safety should be discussed. It is essential that this meeting is convened well in advance of commencement on site. Access to Indigo plant and facilities for inspection by Indigo Pipelines staff must not be affected. Where formal consent has been given, **A MINIMUM OF SEVEN DAYS NOTICE IS REQUIRED** before carrying out work in Indigo Pipelines easements, or the appropriate notice under the New Roads & Street Works Act (NRSWA) where existing plant is situated within the public highway.

Further guidance can also be sought from the document **HS(G)47 – Avoiding Danger from Underground Services** from the HSE website.

3. PROXIMITY OF OTHER PLANT

A minimum clearance of **600 millimetres (mm)** should be allowed between all plant being installed and an existing gas main operating above 2 bar medium pressure (MP), whether the adjacent plant is parallel to or crossing the gas pipe. For mains operating at MP or below, this distance can be reduced to 300mm. **NO APPARATUS SHOULD BE LAID OVER AND ALONG THE LINE OF A GAS PIPE, IRRESPECTIVE OF CLEARANCE.**

No manhole or chamber shall be built over or around a gas pipe and no work should be carried out which results in a reduction of

cover or protection over a pipe without consultation with and the agreement of Indigo Pipelines staff.

4. PROTECTION

Where any works cross or run in close proximity to Indigo Pipelines apparatus, periodic visits must be made by an Indigo Pipelines engineer. Their requests for protection or support to the apparatus shall be immediately observed.

Suitably designed crossing points are to be constructed to the satisfaction of an Indigo Pipelines Engineer. These crossing points shall be clearly indicated by the erection of bunting and crossings at other places should be prevented.

Backfill material adjacent to Indigo Pipelines apparatus shall be soft fill or sand, containing no stones, bricks, or lumps of concrete etc., placed to a minimum 150mm around the mains and is to be well compacted by hand. No power consolidation shall take place above the main until 300mm of soft fill has been compacted by hand.

5. DAMAGE TO COATINGS

Where a gas pipe is coated with special wrapping and this is damaged, even to a minor extent, Indigo Pipelines must be notified so that repairs can be made to prevent future corrosion and subsequent leakage. **WHERE MINOR DAMAGE TO COATING IS REPORTED TO INDIGO PIPELINES PRIOR TO BACKFILL, THE NECESSARY REPAIR WILL BE MADE FREE OF CHARGE.**

6. CATHODIC PROTECTION

Where Indigo Pipelines apparatus is cathodically protected either by sacrificial anode or impressed current systems and where new apparatus is to be laid and is to be similarly protected, Indigo Pipelines will require to carry out interaction tests to determine whether its own system is adversely affected. The cost of any mutually agreed remedial action will be recharged to the authority installing the new apparatus. If any bond wires, test leads etc., used in connection with cathodic protection systems are damaged or found to be in poor condition, broken or disconnected, Indigo must be notified prior to backfilling so that a repair can be made.

7. HOT WORKS

Even when a gas free atmosphere exists care must be taken when carrying out hot works in close proximity to gas plant in order to ensure that no damage occurs. Particular care must be taken to avoid damage by heat or naked flames to plastic gas pipes or to the protective coatings on other pipes.

8. DEMOLITION

Live gas services must be disconnected **PRIOR** to demolishing any property, arrangements must be made for Indigo to check for the presence of any live gas services.

9. TREE PLANTING

Indigo must be contacted prior to all tree-planting works above or near our apparatus. Further information can then be made available.

10. DEEP EXCAVATIONS

Any work involving deep excavations (1.5m or more) will be subject to the "Model Consultative Procedure for Pipeline Construction involving Deep Excavations". This may require the diversion of Indigo Pipelines apparatus prior to the commencement of your works.

Detailed plans and cross sections will be required in order to determine the effect of these works on Indigo Pipelines apparatus.

11. RENEWABLE ENERGY INSTALLATIONS

Wind Turbines – Indigo Pipelines must be advised of any planned development of wind turbines in the vicinity of an above 2 bar gas pipelines to ensure the development does not impact on the future safe operation of the pipeline. Industry guidance states that any wind turbine must be sited no closer than 1.5 times the proposed height of the turbine mast away from the nearest edge of the pipeline.

Solar Farms – Indigo Pipelines must be contacted regarding planned solar farms being considered in the vicinity of Indigo gas pipelines.

EWI – Indigo must be contacted regarding any EWI scheme to ensure the scheme does not impact upon Indigo's apparatus.

12. LEAKAGE FROM GAS MAINS OR SERVICES

If damage or leakage is caused or an escape of gas is smelt or suspected the following action should be taken at once:

- Remove all personnel from the immediate vicinity of the escape.
- Inform the 24hr Gas Emergency Service on **0800 111 999**
- Prevent any approach by the public, prohibit smoking, and extinguish all naked flames or other sources of ignition for at least 15 metres from the leakage. Do not operate any electrical switches in the vicinity of the escape.
- Assist gas personnel, Police and/or Fire Services as requested.

IN THE EVENT OF A LEAK, OBSERVE THE ABOVE BUT DO NOT ATTEMPT TO SEAL THE LEAK



Utilities

REMEMBER – IF IN DOUBT; CONTACT 24HR GAS EMERGENCY LINE 0800 111 999

13. BUILDING PROXIMITIES

There are minimum proximity distances for buildings from Indigo Pipelines mains depending on both the operating pressure and the material of the main. Advice should be sought from Indigo prior to building works taking place to confirm these distances. For High Pressure pipelines you must seek further guidance from the HSE and Local Authority Planning team regarding their PADHI distances regarding building proximities as these may be in addition to Indigo Pipelines proximity distances for a pipeline.

Temporary buildings should not be placed above any gas pipe or within 3.0 metres of mains operating above 75mbar (medium, intermediate and high-pressure mains) during construction activities and in no circumstances should permanent structures be built over any pipe transporting gas.

14. SITE RESPONSIBILITIES

All costs incurred by Indigo for the repair of direct or consequential damage to gas plant will be rechargeable (with the exception of paragraph 5). Indigo reserves the right to divert any affected apparatus or alternatively specify suitable protection of its apparatus. If proved necessary during the course of site works, the cost of which will be chargeable.

The above requirements do not relieve you of the responsibility of taking all precautions necessary to safeguard the Company's plant and to avoid risk to persons and property. The persons for whom the works are being undertaken, their servants, agents and contractors shall indemnify Indigo's servants, agents and contractors against any loss, damage, expenses, claims and actions incurred or brought against Indigo Pipelines, its servants, agents and contractors in consequence of the provision of these works and activities associated therewith or ancillary thereto.

KEY TO MAPS

LP	Low Pressure	PE	Polyethylene
MP	Medium Pressure	ST	Steel
IP	Intermediate Pressure		

Asset location search



Property Searches

Joe Shawyer
Groundwise Searches Ltd
Suite 8 Suite 6 Princess Caroline Hous
1 High Street
SOUTHEND-ON-SEA
SS1 1JE

Search address supplied 447850 213550
Oxford
OX5 1PF

Your reference 31188

Our reference ALS/ALS Standard/2022_4659012

Search date 30 June 2022

Knowledge of features below the surface is essential for every development

The benefits of this knowledge not only include ensuring due diligence and avoiding risk, but also being able to ascertain the feasibility of any development.

Did you know that Thames Water Property Searches can also provide a variety of utility searches including a more comprehensive view of utility providers' assets (across up to 35-45 different providers), as well as more focused searches relating to specific major utility companies such as National Grid (gas and electric).

Contact us to find out more.



Thames Water Utilities Ltd
Property Searches, PO Box 3189, Slough SL1 4WW
DX 151280 Slough 13



searches@thameswater.co.uk
www.thameswater-propertysearches.co.uk



0800 009 4540

Search address supplied: 447850 213550, Oxford, OX5 1PF

Dear Sir / Madam

An Asset Location Search is recommended when undertaking a site development. It is essential to obtain information on the size and location of clean water and sewerage assets to safeguard against expensive damage and allow cost-effective service design.

The following records were searched in compiling this report: - the map of public sewers & the map of waterworks. Thames Water Utilities Ltd (TWUL) holds all of these.

This search provides maps showing the position, size of Thames Water assets close to the proposed development and also manhole cover and invert levels, where available.

Please note that none of the charges made for this report relate to the provision of Ordnance Survey mapping information. The replies contained in this letter are given following inspection of the public service records available to this company. No responsibility can be accepted for any error or omission in the replies.

You should be aware that the information contained on these plans is current only on the day that the plans are issued. The plans should only be used for the duration of the work that is being carried out at the present time. Under no circumstances should this data be copied or transmitted to parties other than those for whom the current work is being carried out.

Thames Water do update these service plans on a regular basis and failure to observe the above conditions could lead to damage arising to new or diverted services at a later date.

Contact Us

If you have any further queries regarding this enquiry please feel free to contact a member of the team on 0800 009 4540, or use the address below:

Thames Water Utilities Ltd
Property Searches
PO Box 3189
Slough
SL1 4WW

Email: searches@thameswater.co.uk

Web: www.thameswater-propertysearches.co.uk

Waste Water Services

Please provide a copy extract from the public sewer map.

The following quartiles have been printed as they fall within Thames' sewerage area:

SP4813SW
SP4712NW
SP4813NE
SP4814SW
SP4713NW
SP4812NE
SP4812SW
SP4912NW
SP4712SE
SP4811NW
SP4713SE
SP4613NE
SP4713NE
SP4714SE
SP4713SW
SP4813NW
SP4712NE
SP4813SE
SP4811NE
SP4913SW
SP4912SW
SP4814SE
SP4812NW
SP4812SE

Enclosed is a map showing the approximate lines of our sewers. Our plans do not show sewer connections from individual properties or any sewers not owned by Thames Water unless specifically annotated otherwise. Records such as "private" pipework are in some cases available from the Building Control Department of the relevant Local Authority.

Where the Local Authority does not hold such plans it might be advisable to consult the property deeds for the site or contact neighbouring landowners.

This report relates only to sewerage apparatus of Thames Water Utilities Ltd, it does not disclose details of cables and or communications equipment that may be running through or around such apparatus.

The sewer level information contained in this response represents all of the level data available in our existing records. Should you require any further Information, please refer to the relevant section within the 'Further Contacts' page found later in this document.

The following quartiles have not been printed as they contain no assets:

SP4613SE

For your guidance:

- The Company is not generally responsible for rivers, watercourses, ponds, culverts or highway drains. If any of these are shown on the copy extract they are shown for information only.
- Any private sewers or lateral drains which are indicated on the extract of the public sewer map as being subject to an agreement under Section 104 of the Water Industry Act 1991 are not an 'as constructed' record. It is recommended these details be checked with the developer.

Clean Water Services

Please provide a copy extract from the public water main map.

The following quartiles have been printed as they fall within Thames' water area:

SP4813SW
SP4712NW
SP4813NE
SP4814SW
SP4713NW
SP4812SW
SP4912NW
SP4712SE
SP4811NW
SP4713SE
SP4613NE
SP4713NE
SP4714SE
SP4713SW
SP4813NW
SP4712NE
SP4813SE
SP4811NE
SP4913SW
SP4814SE
SP4812NW
SP4812SE

Enclosed is a map showing the approximate positions of our water mains and associated apparatus. Please note that records are not kept of the positions of individual domestic supplies.

For your information, there will be a pressure of at least 10m head at the outside stop valve. If you would like to know the static pressure, please contact our Customer

Centre on 0800 316 9800. The Customer Centre can also arrange for a full flow and pressure test to be carried out for a fee.

The following quartiles have not been printed as they contain no assets:

SP4812NE
SP4912SW
SP4613SE

For your guidance:

- Assets other than vested water mains may be shown on the plan, for information only.
- If an extract of the public water main record is enclosed, this will show known public water mains in the vicinity of the property. It should be possible to estimate the likely length and route of any private water supply pipe connecting the property to the public water network.

Payment for this Search

An invoice is enclosed. Please send remittance to Thames Water Utilities Ltd., PO Box 3189, Slough, SL1 4WW.

Further contacts:

Waste Water queries

Should you require verification of the invert levels of public sewers, by site measurement, you will need to approach the relevant Thames Water Area Network Office for permission to lift the appropriate covers. This permission will usually involve you completing a TWOSA form. For further information please contact our Customer Centre on Tel: 0845 920 0800. Alternatively, a survey can be arranged, for a fee, through our Customer Centre on the above number.

If you have any questions regarding sewer connections, budget estimates, diversions, building over issues or any other questions regarding operational issues please direct them to our service desk. Which can be contacted by writing to:

Developer Services (Waste Water)
Thames Water
Clearwater Court
Vastern Road
Reading
RG1 8DB

Tel: 0800 009 3921
Email: developer.services@thameswater.co.uk

Clean Water queries

Should you require any advice concerning clean water operational issues or clean water connections, please contact:

Developer Services (Clean Water)
Thames Water
Clearwater Court
Vastern Road
Reading
RG1 8DB

Tel: 0800 009 3921
Email: developer.services@thameswater.co.uk




The width of the displayed area is 500m and the centre of the map is located at OS coordinates 448250,213250
The position of the apparatus shown on this plan is given without obligation and warranty, and the accuracy cannot be guaranteed. Service pipes are not shown but their presence should be anticipated. No liability of any kind whatsoever is accepted by Thames Water for any kind or omission. The actual position of mains and services must be verified and established on site before any works are undertaken.

Based on the Ordnance Survey Map (2020) with the Sanction of the controller of H.M. Stationery Office, License no. 100019345 Crown Copyright Reserved.

NB. Levels quoted in metres Ordnance Newlyn Datum. The value -9999.00 indicates that no survey information is available

Manhole Reference	Manhole Cover Level	Manhole Invert Level
n/a	n/a	n/a

The position of the apparatus shown on this plan is given without obligation and warranty, and the accuracy cannot be guaranteed. Service pipes are not shown but their presence should be anticipated. No liability of any kind whatsoever is accepted by Thames Water for any error or omission. The actual position of mains and services must be verified and established on site before any works are undertaken.

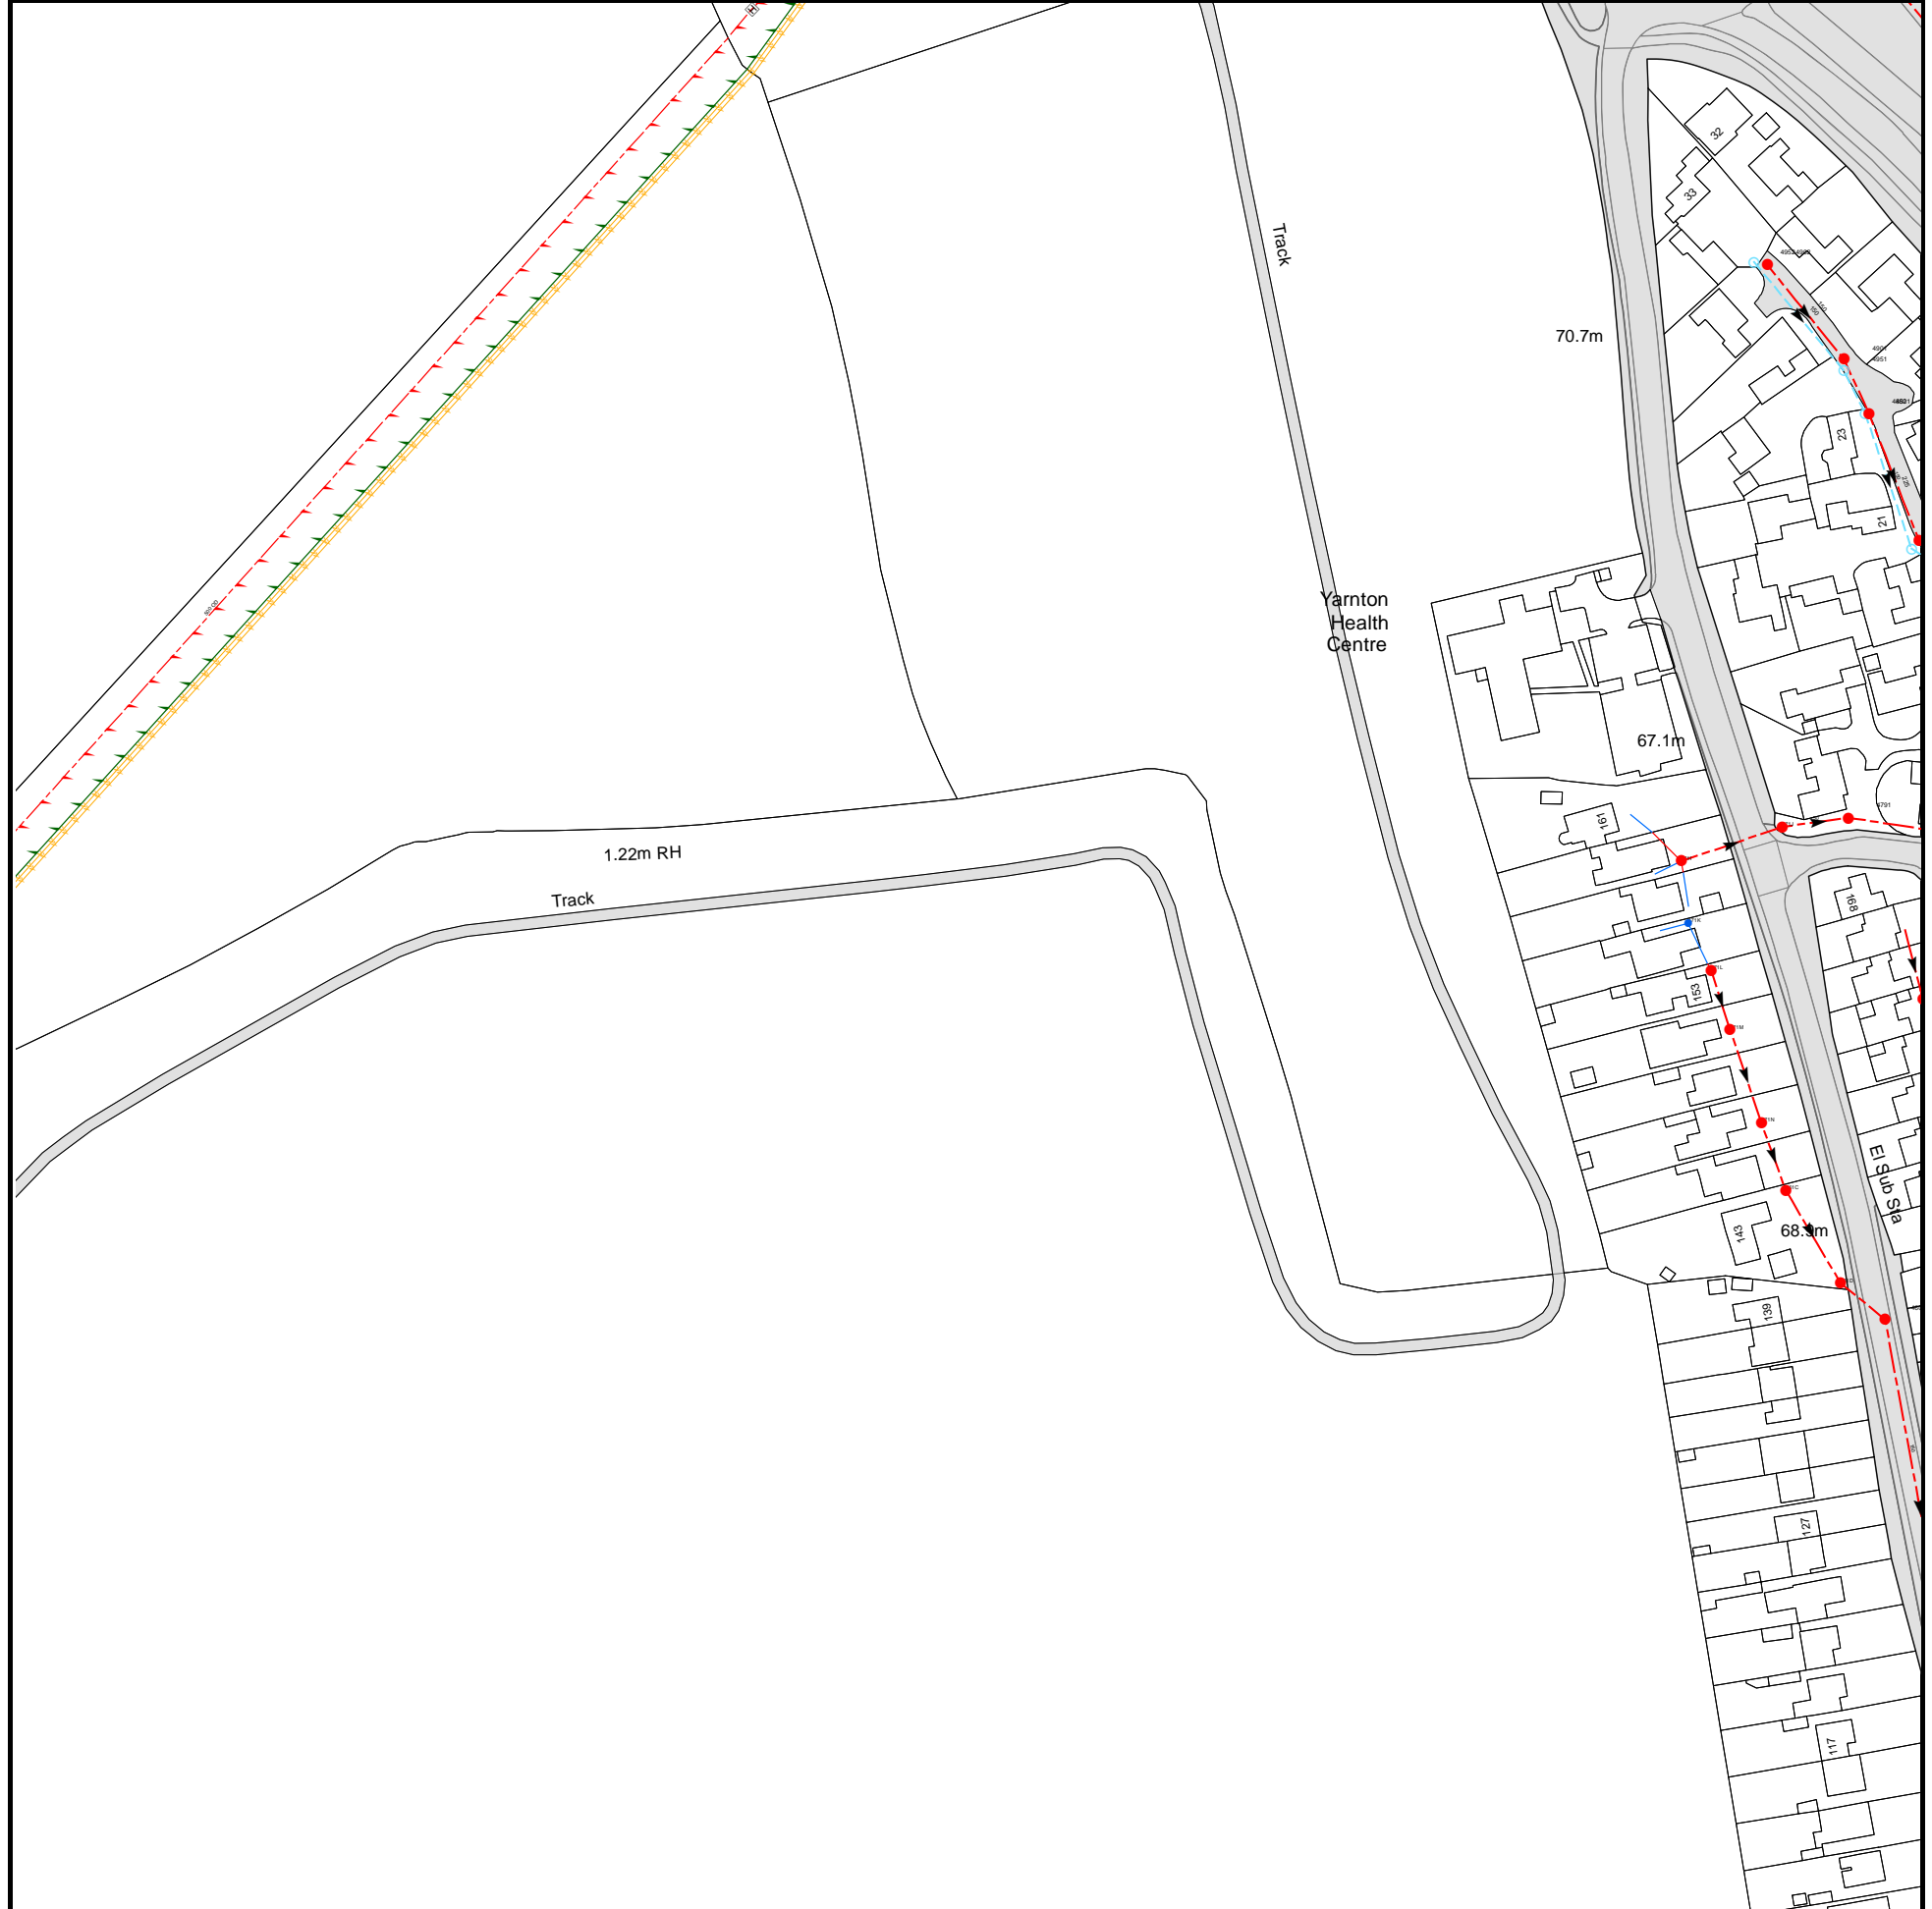

The width of the displayed area is 500m and the centre of the map is located at OS coordinates 447250,212750

The position of the apparatus shown on this plan is given without obligation and warranty, and the accuracy cannot be guaranteed. Service pipes are not shown but their presence should be anticipated. No liability of any kind whatsoever is accepted by Thames Water for any error or omission. The actual position of mains and services must be verified and established on site before any works are undertaken.

Based on the Ordnance Survey Map (2020) with the Sanction of the controller of H.M. Stationery Office, License no. 100019345 Crown Copyright Reserved.

NB. Levels quoted in metres Ordnance Newlyn Datum. The value -9999.00 indicates that no survey information is available

Manhole Reference	Manhole Cover Level	Manhole Invert Level
4951	69.51	67.62
4901	69.48	67.36
4902	69.52	67.73
4952	69.5	68.13
471I	n/a	n/a
471K	n/a	n/a
471L	n/a	n/a
471M	n/a	n/a
471N	n/a	n/a
471J	n/a	n/a
461C	n/a	n/a
461D	n/a	n/a
4791	n/a	n/a
4852	69.26	67.44
4801	69.36	67.16
4851	68.19	66.5
4802	68.25	66.48
471H	n/a	n/a
4601	68.23	66.45

The position of the apparatus shown on this plan is given without obligation and warranty, and the accuracy cannot be guaranteed. Service pipes are not shown but their presence should be anticipated. No liability of any kind whatsoever is accepted by Thames Water for any error or omission. The actual position of mains and services must be verified and established on site before any works are undertaken.



The width of the displayed area is 500m and the centre of the map is located at OS coordinates 448750,213750
The position of the apparatus shown on this plan is given without obligation and warranty, and the accuracy cannot be guaranteed. Service pipes are not shown but their presence should be anticipated. No liability of any kind whatsoever is accepted by Thames Water for any error or omission. The actual position of mains and services must be verified and established on site before any works are undertaken.

Based on the Ordnance Survey Map (2020) with the Sanction of the controller of H.M. Stationery Office, License no. 100019345 Crown Copyright Reserved.

NB. Levels quoted in metres Ordnance Newlyn Datum. The value -9999.00 indicates that no survey information is available


Manhole Reference	Manhole Cover Level	Manhole Invert Level
8950	62.26	60.89
9901	62.07	59.18
8951	62.53	n/a
9950	62.5	61.33
9951	62.28	61.46
9902	62.19	59.4
891A	n/a	n/a
8902	62.76	61.01
9903	62.35	59.6
6701	62.12	59.38
671H	n/a	n/a
781B	n/a	n/a
7802	62.03	60.39
7805	61.8	60.39
7804	61.97	60.56
7855	62.04	60.97
7856	61.81	60.7
6852	61.88	60.25
7803	62.21	60.87
7854	62.35	61.31
781A	n/a	n/a
6905	62.12	60.2
6954	62.12	60.61
6951	62.21	60.96
6904	62.25	60.22
6953	62.44	60.91
7950	62.58	61.16
7901	62.58	61
7951	62.69	61.47
791A	n/a	n/a
691F	n/a	n/a
691A	n/a	n/a
691G	n/a	n/a
5903	62.92	59.9
5954	62.8	60.13
5904	62.78	59.87
5955	62.37	59.67
5953	62.7	59.72
6901	62.62	59.33
691L	n/a	n/a
691K	n/a	n/a
691J	n/a	n/a
691I	n/a	n/a
691H	n/a	n/a
6950	62.27	60.76
6902	62.21	59.97
5906	62.79	60.38
5956	62.77	60.77
5959	n/a	n/a
5901	63.23	61.24
5950	63.26	61.76
5902	63.16	60.01
5951	63.18	60.54
5952	62.9	60.34
6807	61.95	59.02
5855	62	59.58
5802	61.99	59.73
5852	62.02	60.3
5805	62.05	59.44
5854	62.04	60.04
6801	62.04	59.4
6851	62.03	60
6802	61.97	59.59
6853	61.92	60.15
5808	62.34	60.5
5850	62.23	60.79
5851	62.15	60.61
5801	62.16	60.03
681A	n/a	n/a
681B	n/a	n/a
5806	62.17	59.1
681C	n/a	n/a
5856	62.15	59.71
5807	62.37	60.72
691C	n/a	n/a
691D	n/a	n/a
691E	n/a	n/a
6903	62.71	59.78
5905	62.36	59.25
6952	62.71	60.54
7701	61.98	59.82
7853	62.19	61.39
7852	62.15	61.17
8850	62.03	60.63
8801	62	60.35
8851	62.04	60.99
8802	62.05	60.69
8852	62.27	61.24
8803	62.33	61.08
8853	62.18	n/a

Manhole Reference	Manhole Cover Level	Manhole Invert Level
991B	n/a	n/a
991A	n/a	n/a
9802	n/a	n/a
9801	61.88	58.84
771D	n/a	n/a
9702	61.56	58.53
871H	n/a	n/a
9701	61.84	60.33
8704	62.14	61.17
8701	61.96	61.07
971A	n/a	n/a
8702	61.85	60.81
8751	61.69	60.77
8752	61.68	60.62
8754	61.84	60.44
8703	61.66	60.46
7750	61.94	60.24
8753	61.5	60.52
8705	61.64	60.11
8707	62.29	61.59
6854	62.16	60.55
6803	62.2	60.06
6751	62.01	60.02
6855	62.19	60.41
671B	n/a	n/a
6804	62.29	59.71
6856	62.29	60.21
671A	n/a	n/a
6750	62.14	60.97
6805	62.25	60.1
6858	62.26	60.53
6857	62.14	60.84
681D	n/a	n/a
671G	n/a	n/a
671F	n/a	n/a
771G	n/a	n/a
771J	n/a	n/a
771F	n/a	n/a
771E	n/a	n/a
771I	n/a	n/a
7752	61.79	60.75
7751	61.97	60.36
7702	61.95	59.96
7850	61.84	60.43
7801	61.86	60.13
7851	62.04	60.7
7607	62.12	58.49
6601	62.38	60.28
6652	62.36	60.68
761C	n/a	n/a
661C	n/a	n/a
7652	62.18	59.86
661B	n/a	n/a
7603	62.21	58.86
6650	62.27	60.81
6657	62.25	59.17
6606	62.25	58.51
6759	62.22	60.98
6756	62.08	60.24
7754	62.23	59.98
6705	62.06	59.13
6758	62.25	60.42
6706	62.2	60.03
6707	62.3	58.66
7704	62.21	59.32
6760	62.29	59.25
6755	61.98	60.43
7706	61.96	60.81
7753	62.12	60.09
671E	n/a	n/a
771K	n/a	n/a
7703	62.28	59.59
771H	n/a	n/a
7653	62.37	60.46
771A	n/a	n/a
7705	62.52	61.34
771B	n/a	n/a
771C	n/a	n/a
871A	n/a	n/a
861I	n/a	n/a
871B	n/a	n/a
861H	n/a	n/a
861J	n/a	n/a
8607	62.29	59.6
871G	n/a	n/a
8706	62.15	60.21
8755	62.13	60.61
871C	n/a	n/a
861N	n/a	n/a
871F	n/a	n/a
871E	n/a	n/a
871D	n/a	n/a
861K	n/a	n/a

Manhole Reference	Manhole Cover Level	Manhole Invert Level
8651	62.3	60.77
8601	62.1	59.83
8650	62.22	60.37
9650	62.26	60.21
9601	62.35	59.47
9651	62.35	60.38
9602	62.36	59.68
9607	61.83	58.14
7604	62.29	58.24
8606	62.2	58.04
8661	62.07	59.9
8608	62.12	59.02
8660	62.15	60.06
861L	n/a	n/a
861M	n/a	n/a
8658	62.09	58.94
8605	62.07	58.19
861F	n/a	n/a
861E	n/a	n/a
861C	n/a	n/a
861D	n/a	n/a
861B	n/a	n/a
861A	n/a	n/a
861G	n/a	n/a
8652	62.12	60.27
8654	62.17	59.83
8602	62.33	59.11
8653	62.36	60.02
9652	62.29	60.05
9653	62.31	59.98
9603	62.45	59.25
961B	n/a	n/a
9655	61.79	60.15
9605	61.8	58.09
9654	61.58	60.2
9604	61.53	58.19
851B	n/a	n/a
851A	n/a	n/a
8557	62.19	60.51
9553	61.99	60.76
8510	62.06	60.26
8550	62.09	60.56
951B	n/a	n/a
8502	62.32	60.28
8552	62.33	60.79
8551	62.24	60.3
8501	62.2	58.69
8503	62.4	60.09
951A	n/a	n/a
8655	62.36	58.86
961C	n/a	n/a
8603	62.3	57.99
751C	n/a	n/a
7651	62.12	60.17
7602	62.15	59.79
751E	n/a	n/a
7650	62.09	59.71
7654	62.12	61.08
7601	62.1	58.76
751D	n/a	n/a
7659	62.13	59.12
751F	n/a	n/a
7501	62.36	60.28
7551	62.13	60.79
7550	62.28	60.5
7658	62.13	59.76
7502	62.27	59.73
7606	62.18	58.42
7552	62.28	60.21
7657	62.2	59.03
761G	n/a	n/a
761A	n/a	n/a
761B	n/a	n/a
7504	62.13	59.4
7555	62.15	60.05
7656	62.25	59.01
7505	62.29	58.83
7605	62.25	58.31
9550	61.51	59.33
9551	61.64	59.38
9502	61.63	58.2
9501	61.61	57.97
9504	61.65	58.01
9656	61.74	60.06
9606	61.73	58.09
9552	61.62	58.73
9503	61.64	57.71
9555	61.56	59.95
9556	61.57	60
9506	61.65	57.82
9505	61.56	59.81
961A	n/a	n/a
9557	61.47	59.92

Manhole Reference	Manhole Cover Level	Manhole Invert Level
0509	61.44	57.98
9554	62.16	59.5
8561	62.22	59.85
851H	n/a	n/a
851F	n/a	n/a
851G	n/a	n/a
8507	62.21	59.95
851C	n/a	n/a
8558	62.28	60.35
851E	n/a	n/a
7556	62.33	59.9
7554	62.26	60.36
7655	62.34	58.98
751A	n/a	n/a
7503	62.21	59.85
7553	62.25	60.37
751B	n/a	n/a
8504	62.35	59.6
851D	n/a	n/a
8560	62.08	60.66
8659	62.21	59.02
8509	62.13	60.32
8554	62.3	59.84
8508	62.13	60.55
8559	62.09	60.93
8555	62.2	59.81
8505	62.1	59.2
8562	62.11	60.21
8662	62.08	59.43
8506	62.15	58.94
8604	62.21	58.13
8656	62.24	58.95
6757	61.99	60.5
5751	62.36	60.69
5702	62.39	60.22
5750	62.23	60.42
5701	62.2	60.17
571D	n/a	n/a
5752	62.06	60.59
5754	62.27	60.42
5704	62.28	59.68
6704	62.33	59.96
571C	n/a	n/a
6754	62.26	60.33
571A	n/a	n/a
5705	62.3	59.3
6708	61.97	57.93
6703	62.07	59.04
6761	61.97	59.17
6753	62.13	60.14
5753	62.16	60.5
6702	62.22	60.07
6752	62.21	60.35
5703	62.3	60.14
671D	n/a	n/a
671C	n/a	n/a
581A	n/a	n/a
5804	62.2	60.45
5803	61.84	60.18
6806	61.81	58.91
6859	61.83	59.24
5853	61.9	60.43
661D	n/a	n/a
661A	n/a	n/a
6651	62.39	60.88
6602	62.27	59.8
6653	62.27	60.32
6603	62.2	59.47
6654	62.24	60.14
651A	n/a	n/a
6655	62.15	59.95
661E	n/a	n/a
6604	62.14	59.29
661F	n/a	n/a
6656	62.11	59.75
6605	62.08	58.99

The position of the apparatus shown on this plan is given without obligation and warranty, and the accuracy cannot be guaranteed. Service pipes are not shown but their presence should be anticipated. No liability of any kind whatsoever is accepted by Thames Water for any error or omission. The actual position of mains and services must be verified and established on site before any works are undertaken.

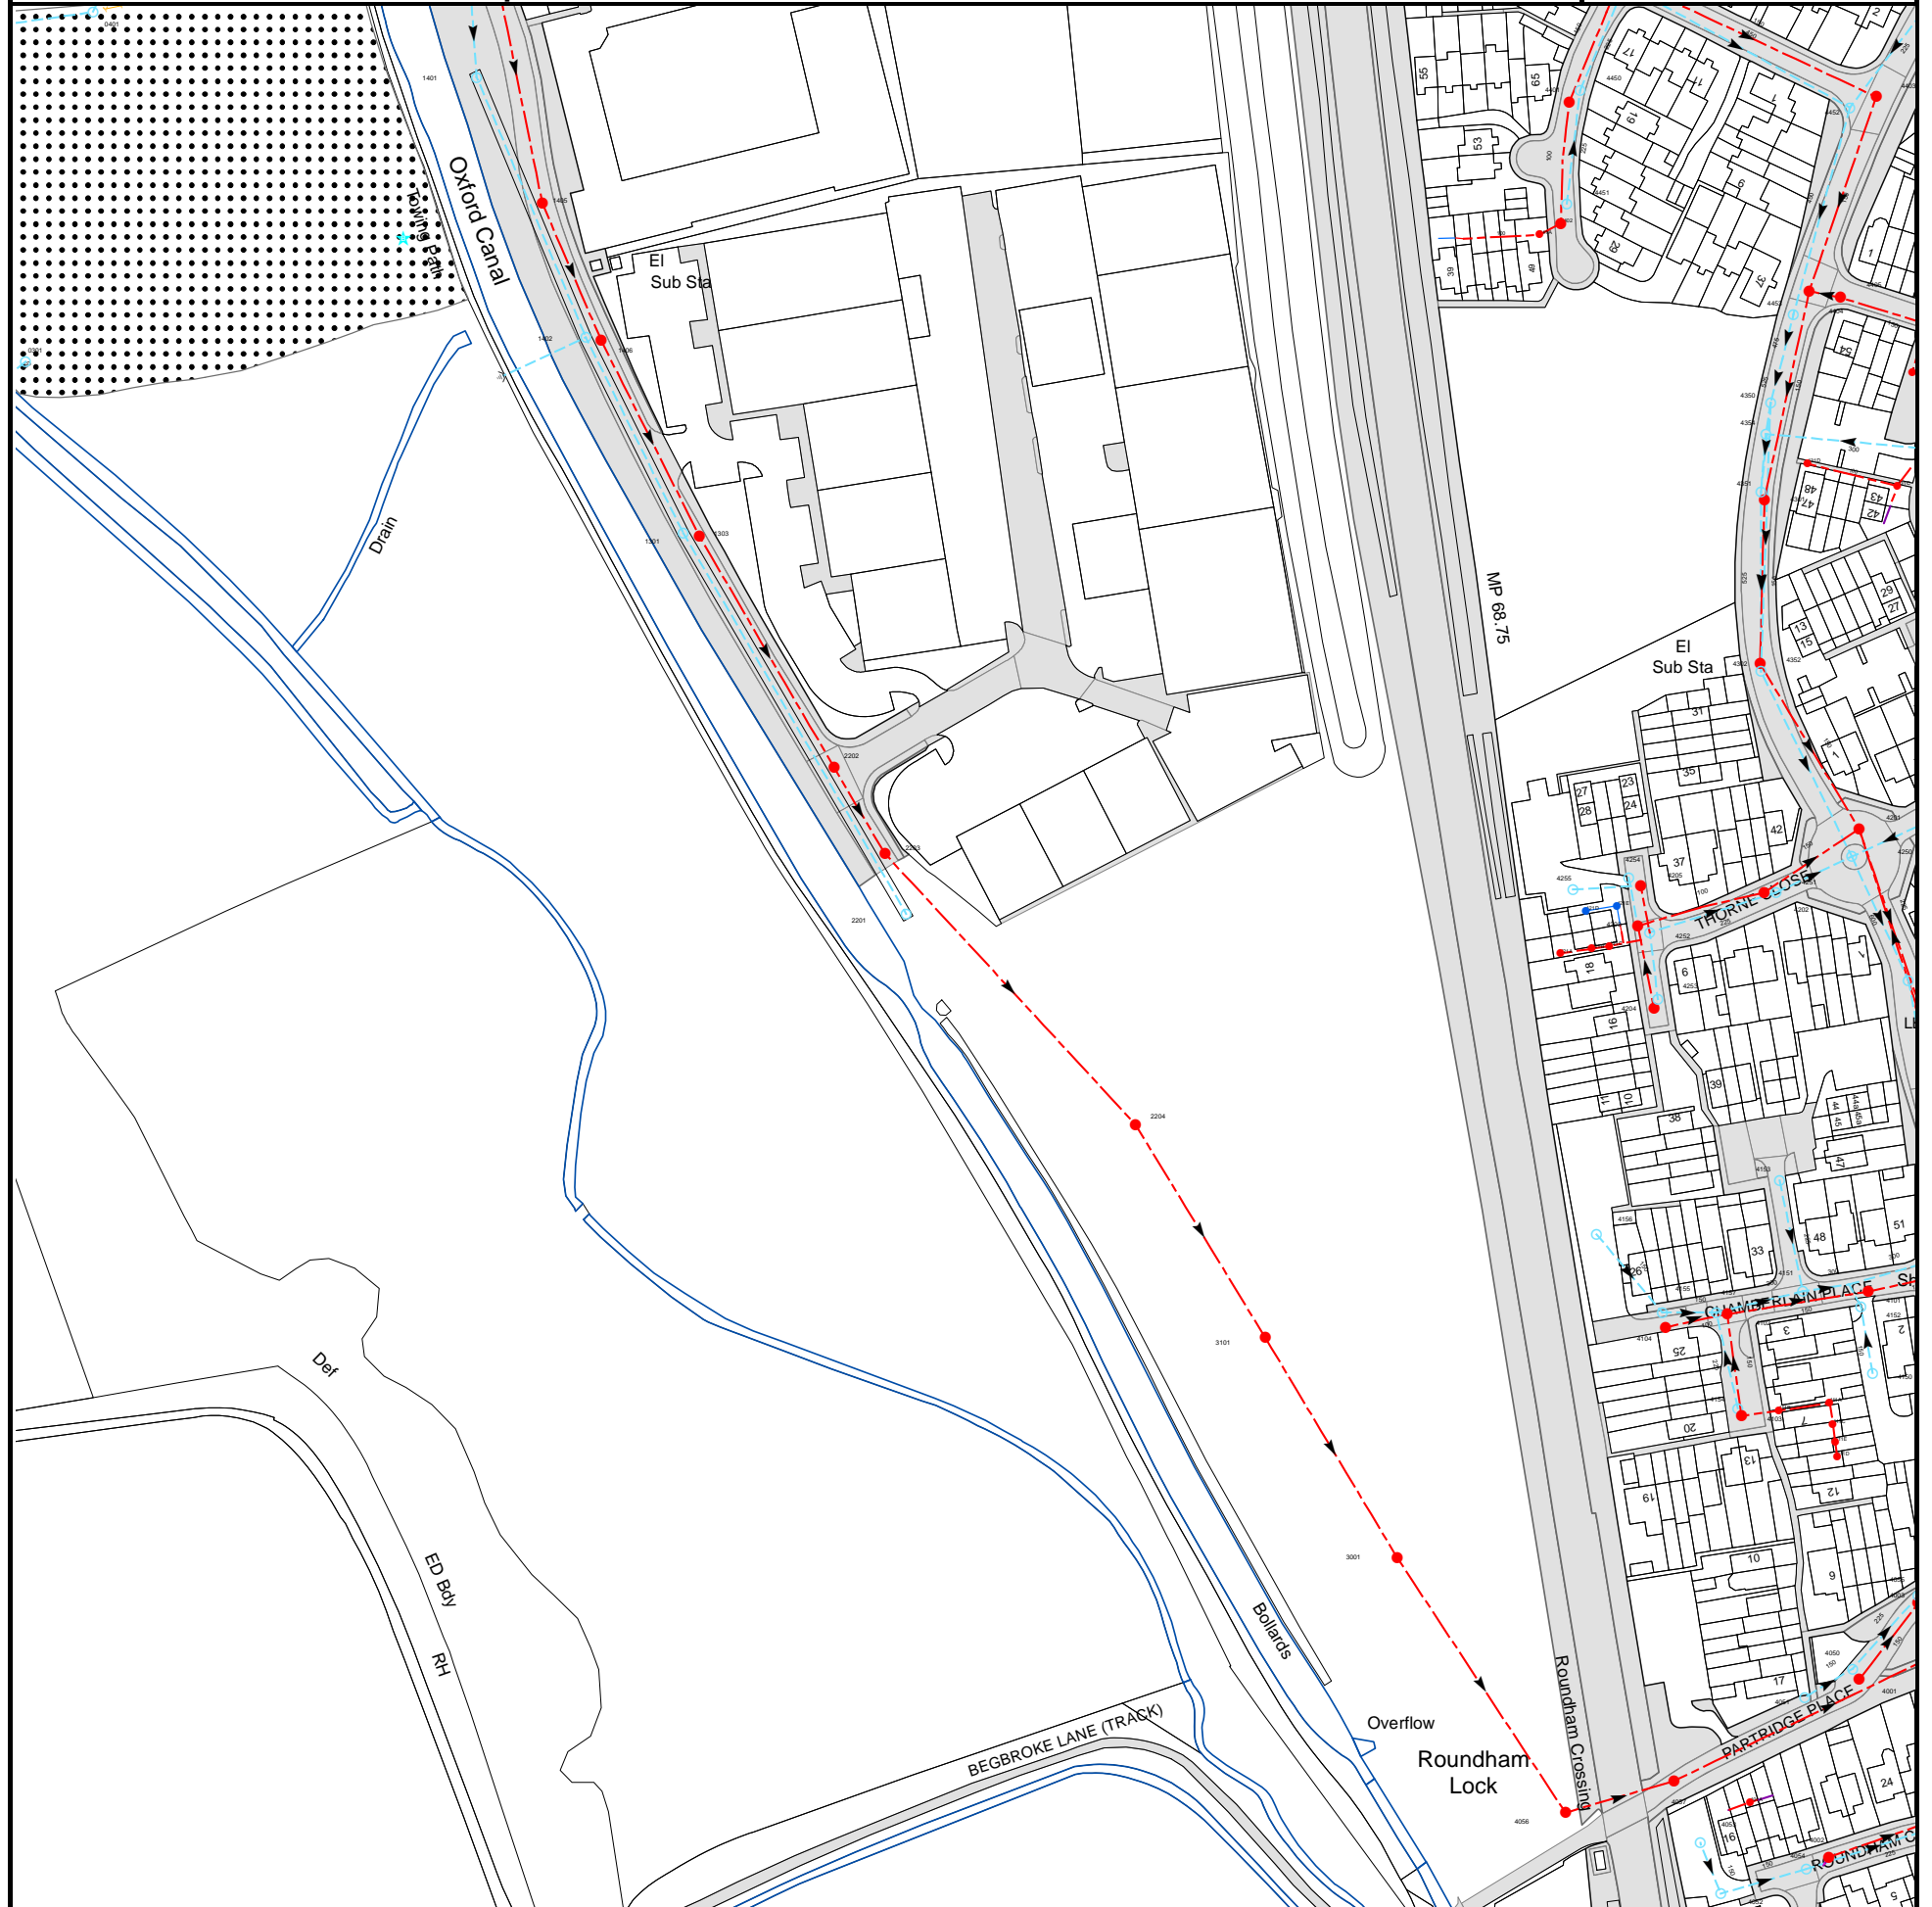

The width of the displayed area is 500m and the centre of the map is located at OS coordinates 448250,214250


The position of the apparatus shown on this plan is given without obligation and warranty, and the accuracy cannot be guaranteed. Service pipes are not shown but their presence should be anticipated. No liability of any kind whatsoever is accepted by Thames Water for any error or omission. The actual position of mains and services must be verified and established on site before any works are undertaken.

Based on the Ordnance Survey Map (2020) with the Sanction of the controller of H.M. Stationery Office, License no. 100019345 Crown Copyright Reserved.

NB. Levels quoted in metres Ordnance Newlyn Datum. The value -9999.00 indicates that no survey information is available

Manhole Reference	Manhole Cover Level	Manhole Invert Level
341A	n/a	n/a
1401	n/a	n/a
1405	n/a	n/a
1402	n/a	n/a
1406	n/a	n/a
0301	n/a	n/a
0401	n/a	n/a
4003	65.43	62.73
4055	65.45	63.11
5204	64.89	62.23
4206	64.62	61.23
4256	64.68	61.74
431C	n/a	n/a
441A	n/a	n/a
4051	65.26	63.6
4001	65.45	62.99
4050	65.37	63.4
411D	n/a	n/a
411E	n/a	n/a
411C	n/a	n/a
4103	64.69	62.96
411B	n/a	n/a
4154	64.73	63.15
411A	n/a	n/a
4150	65.05	63.85
4102	64.98	61.6
4152	65.08	63.21
4101	64.92	62.34
4151	65	62.7
4153	65.13	63.29
4052	64.22	63.35
4054	64.47	63.2
4002	64.57	63.2
401A	n/a	n/a
441B	n/a	n/a
4453	66.95	62.79
4405	66.92	62.91
4404	66.98	62.83
4402	67.37	65.98
4451	67.39	65.56
4452	67.4	62.97
4401	67.42	65.59
4403	67.42	63.28
4450	67.4	65.13
1301	n/a	n/a
1303	n/a	n/a
2202	n/a	n/a
2203	n/a	n/a
2201	n/a	n/a
421A	n/a	n/a
4255	64.63	63.75
421D	n/a	n/a
421B	n/a	n/a
421C	n/a	n/a
421E	n/a	n/a
4254	64.95	63.12
4203	64.66	62.88
4205	64.96	63.47
4252	64.68	63.28
4204	64.73	63.12
4253	64.72	63.41
4302	65.79	62.05
4351	66.45	62.61
4352	65.77	62.28
4202	64.86	62.45
4301	66.39	62.32
4354	66.31	62.9
4350	66.55	62.73
4251	64.86	62.85
431D	n/a	n/a
4250	64.92	61.96
4201	64.92	61.59
2204	n/a	n/a
3101	n/a	n/a
3001	n/a	n/a
4056	n/a	n/a
4156	64.62	63.58
4155	64.8	63.15
4104	64.78	62.84
4057	n/a	n/a
4053	64.36	63.54
4157	64.98	62.87

The position of the apparatus shown on this plan is given without obligation and warranty, and the accuracy cannot be guaranteed. Service pipes are not shown but their presence should be anticipated. No liability of any kind whatsoever is accepted by Thames Water for any error or omission. The actual position of mains and services must be verified and established on site before any works are undertaken.

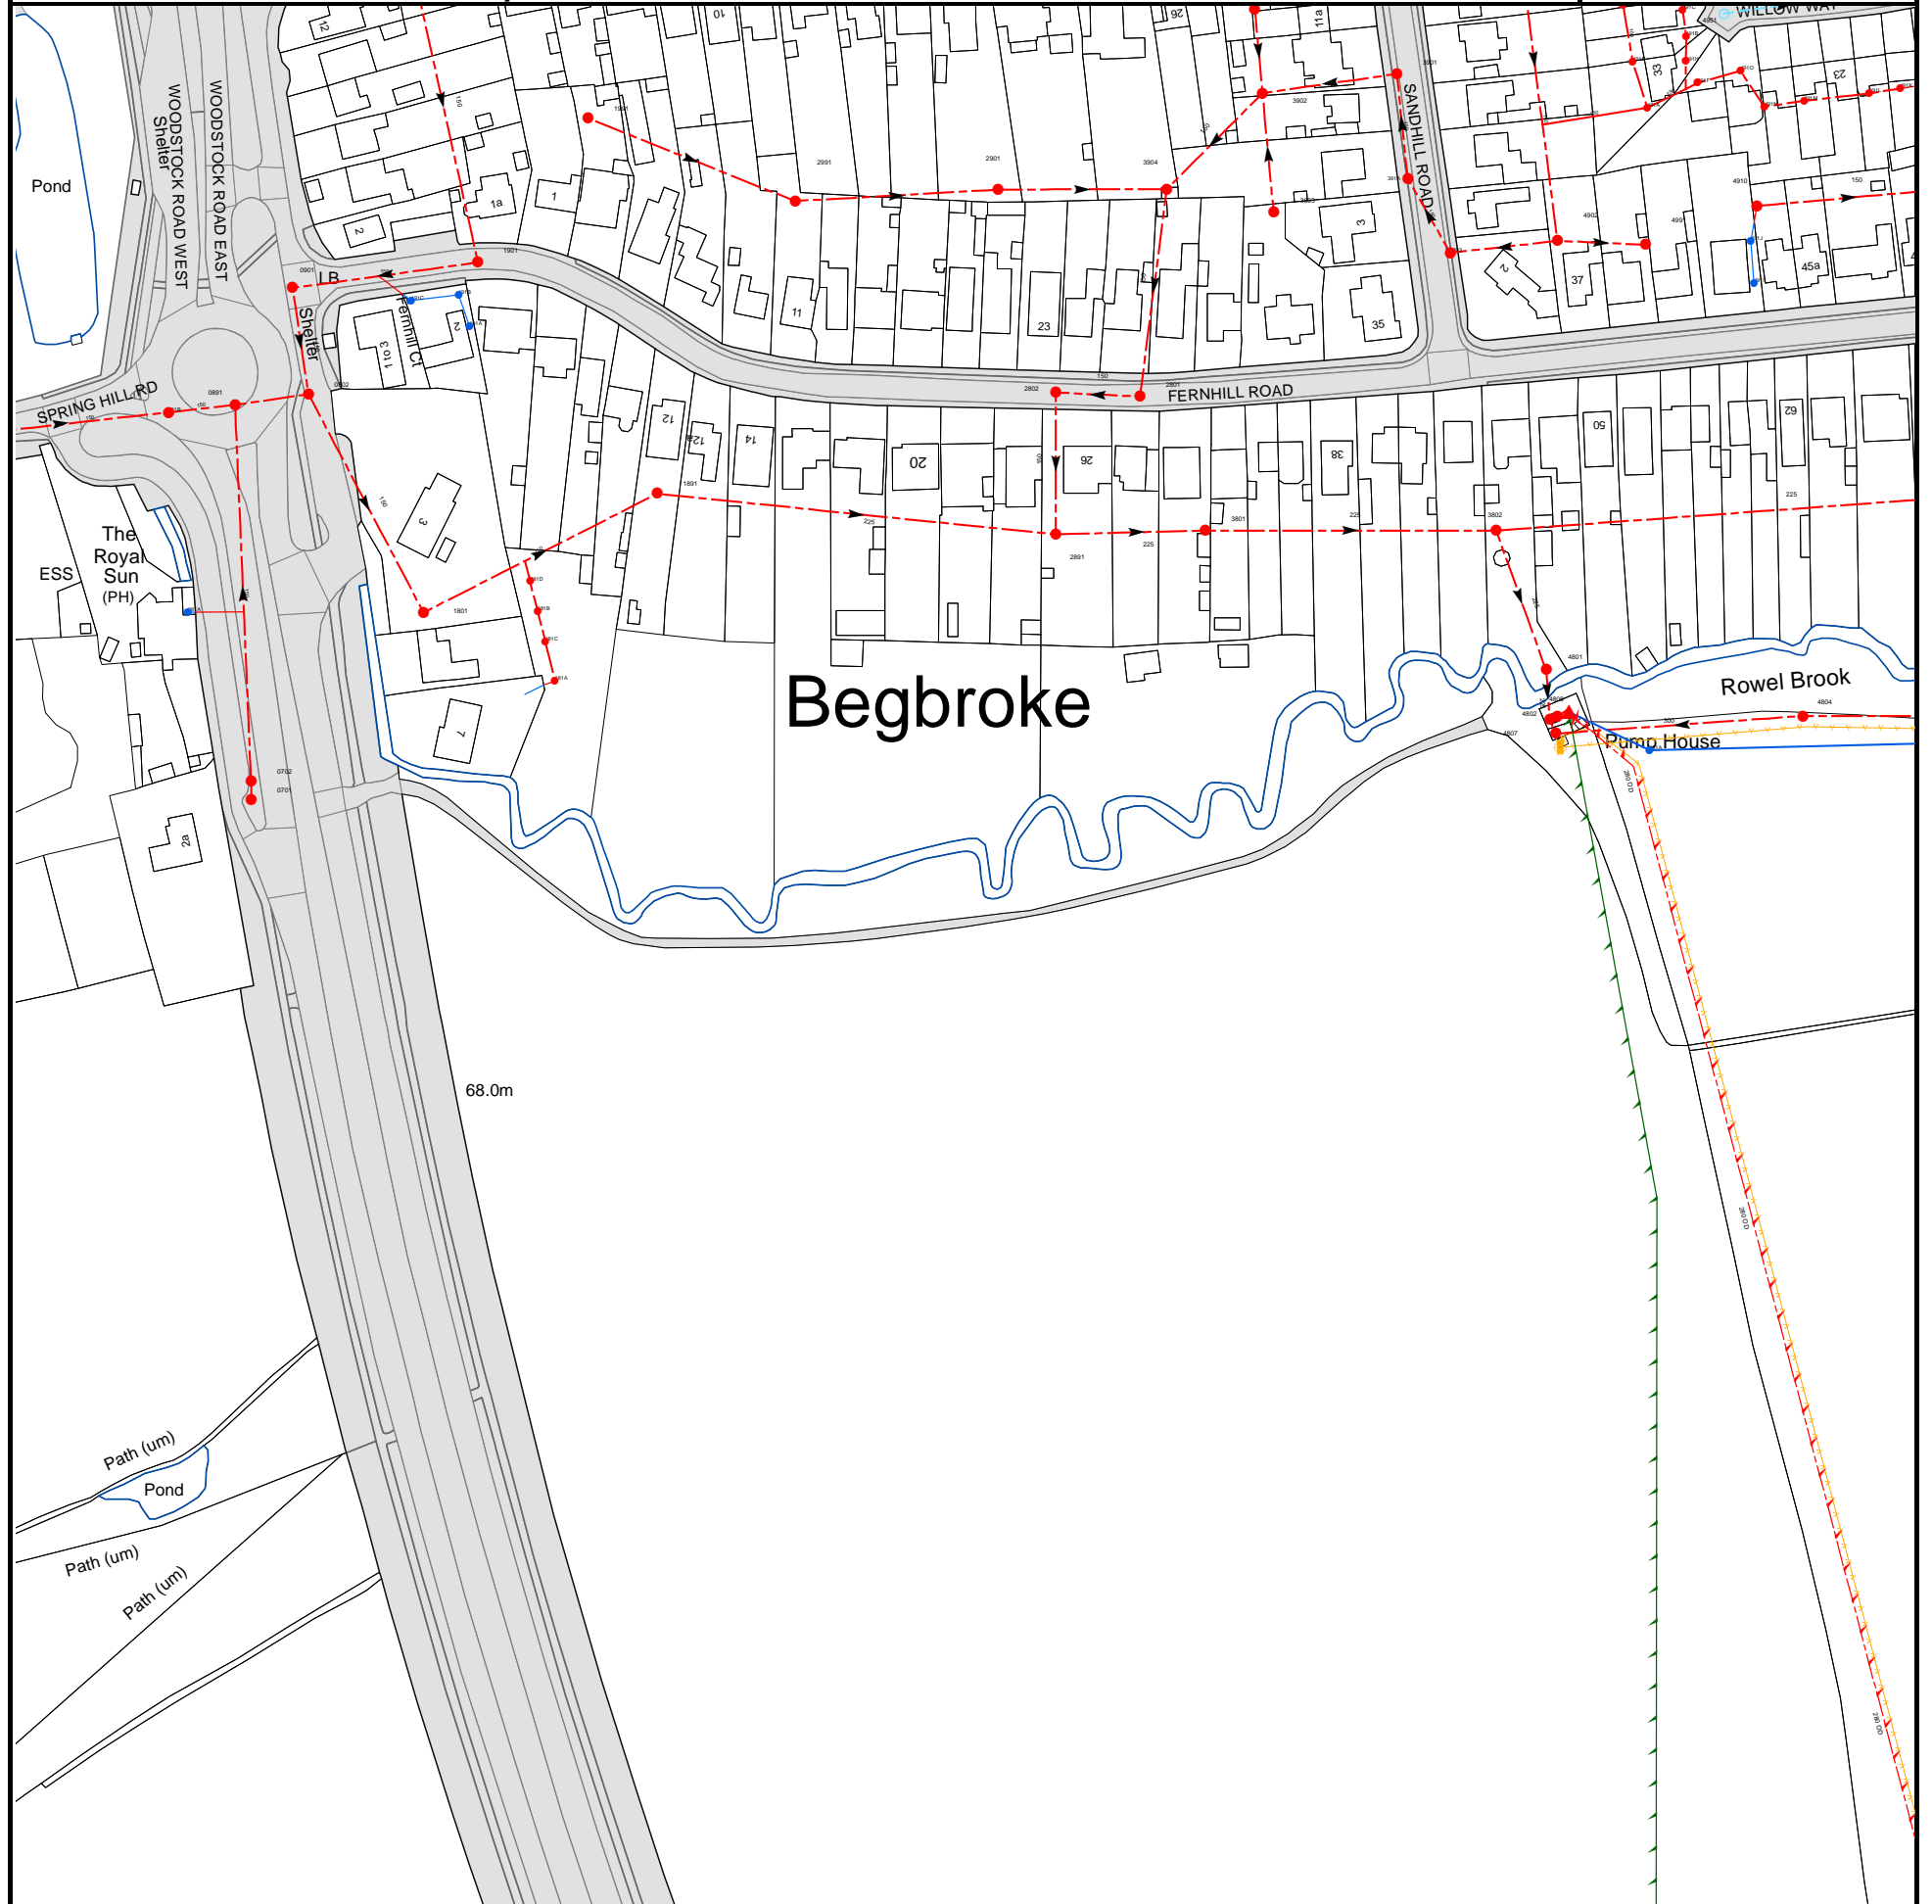

The width of the displayed area is 500m and the centre of the map is located at OS coordinates 447250,213750


The position of the apparatus shown on this plan is given without obligation and warranty, and the accuracy cannot be guaranteed. Service pipes are not shown but their presence should be anticipated. No liability of any kind whatsoever is accepted by Thames Water for any error or omission. The actual position of mains and services must be verified and established on site before any works are undertaken.

Based on the Ordnance Survey Map (2020) with the Sanction of the controller of H.M. Stationery Office, License no. 100019345 Crown Copyright Reserved.

NB. Levels quoted in metres Ordnance Newlyn Datum. The value -9999.00 indicates that no survey information is available

Manhole Reference	Manhole Cover Level	Manhole Invert Level
481A	n/a	n/a
4807	65.32	62.71
4802	65.41	62.2
4808	n/a	n/a
4804	n/a	n/a
4801	66.07	62.89
4991	n/a	n/a
4902	68.21	65.9
4910	67.86	66.54
491A	n/a	n/a
491F	n/a	n/a
491H	n/a	n/a
491B	n/a	n/a
4951	67.1	66.16
491C	n/a	n/a
081B	n/a	n/a
081A	n/a	n/a
0891	n/a	n/a
0701	67.73	65.87
0702	67.64	65.84
0901	67.54	65.25
0802	67.39	65.08
191C	n/a	n/a
1801	67.35	64.68
191B	n/a	n/a
191A	n/a	n/a
1901	68.37	65.51
181D	n/a	n/a
181B	n/a	n/a
3905	n/a	n/a
3902	67.56	65.41
3901	68.27	65.7
491D	n/a	n/a
491E	n/a	n/a
491O	n/a	n/a
491N	n/a	n/a
491M	n/a	n/a
491L	n/a	n/a
491K	n/a	n/a
181A	n/a	n/a
181C	n/a	n/a
2891	n/a	n/a
3801	66.21	63.64
3802	66.1	62.86
1891	n/a	n/a
2801	66.8	64.93
2802	67.08	64.83
491I	n/a	n/a
3903	68.08	65.83
491J	n/a	n/a
3993	n/a	n/a
2991	n/a	n/a
2901	67.53	65.93
3904	n/a	n/a
391A	n/a	n/a
1991	n/a	n/a

The position of the apparatus shown on this plan is given without obligation and warranty, and the accuracy cannot be guaranteed. Service pipes are not shown but their presence should be anticipated. No liability of any kind whatsoever is accepted by Thames Water for any error or omission. The actual position of mains and services must be verified and established on site before any works are undertaken.

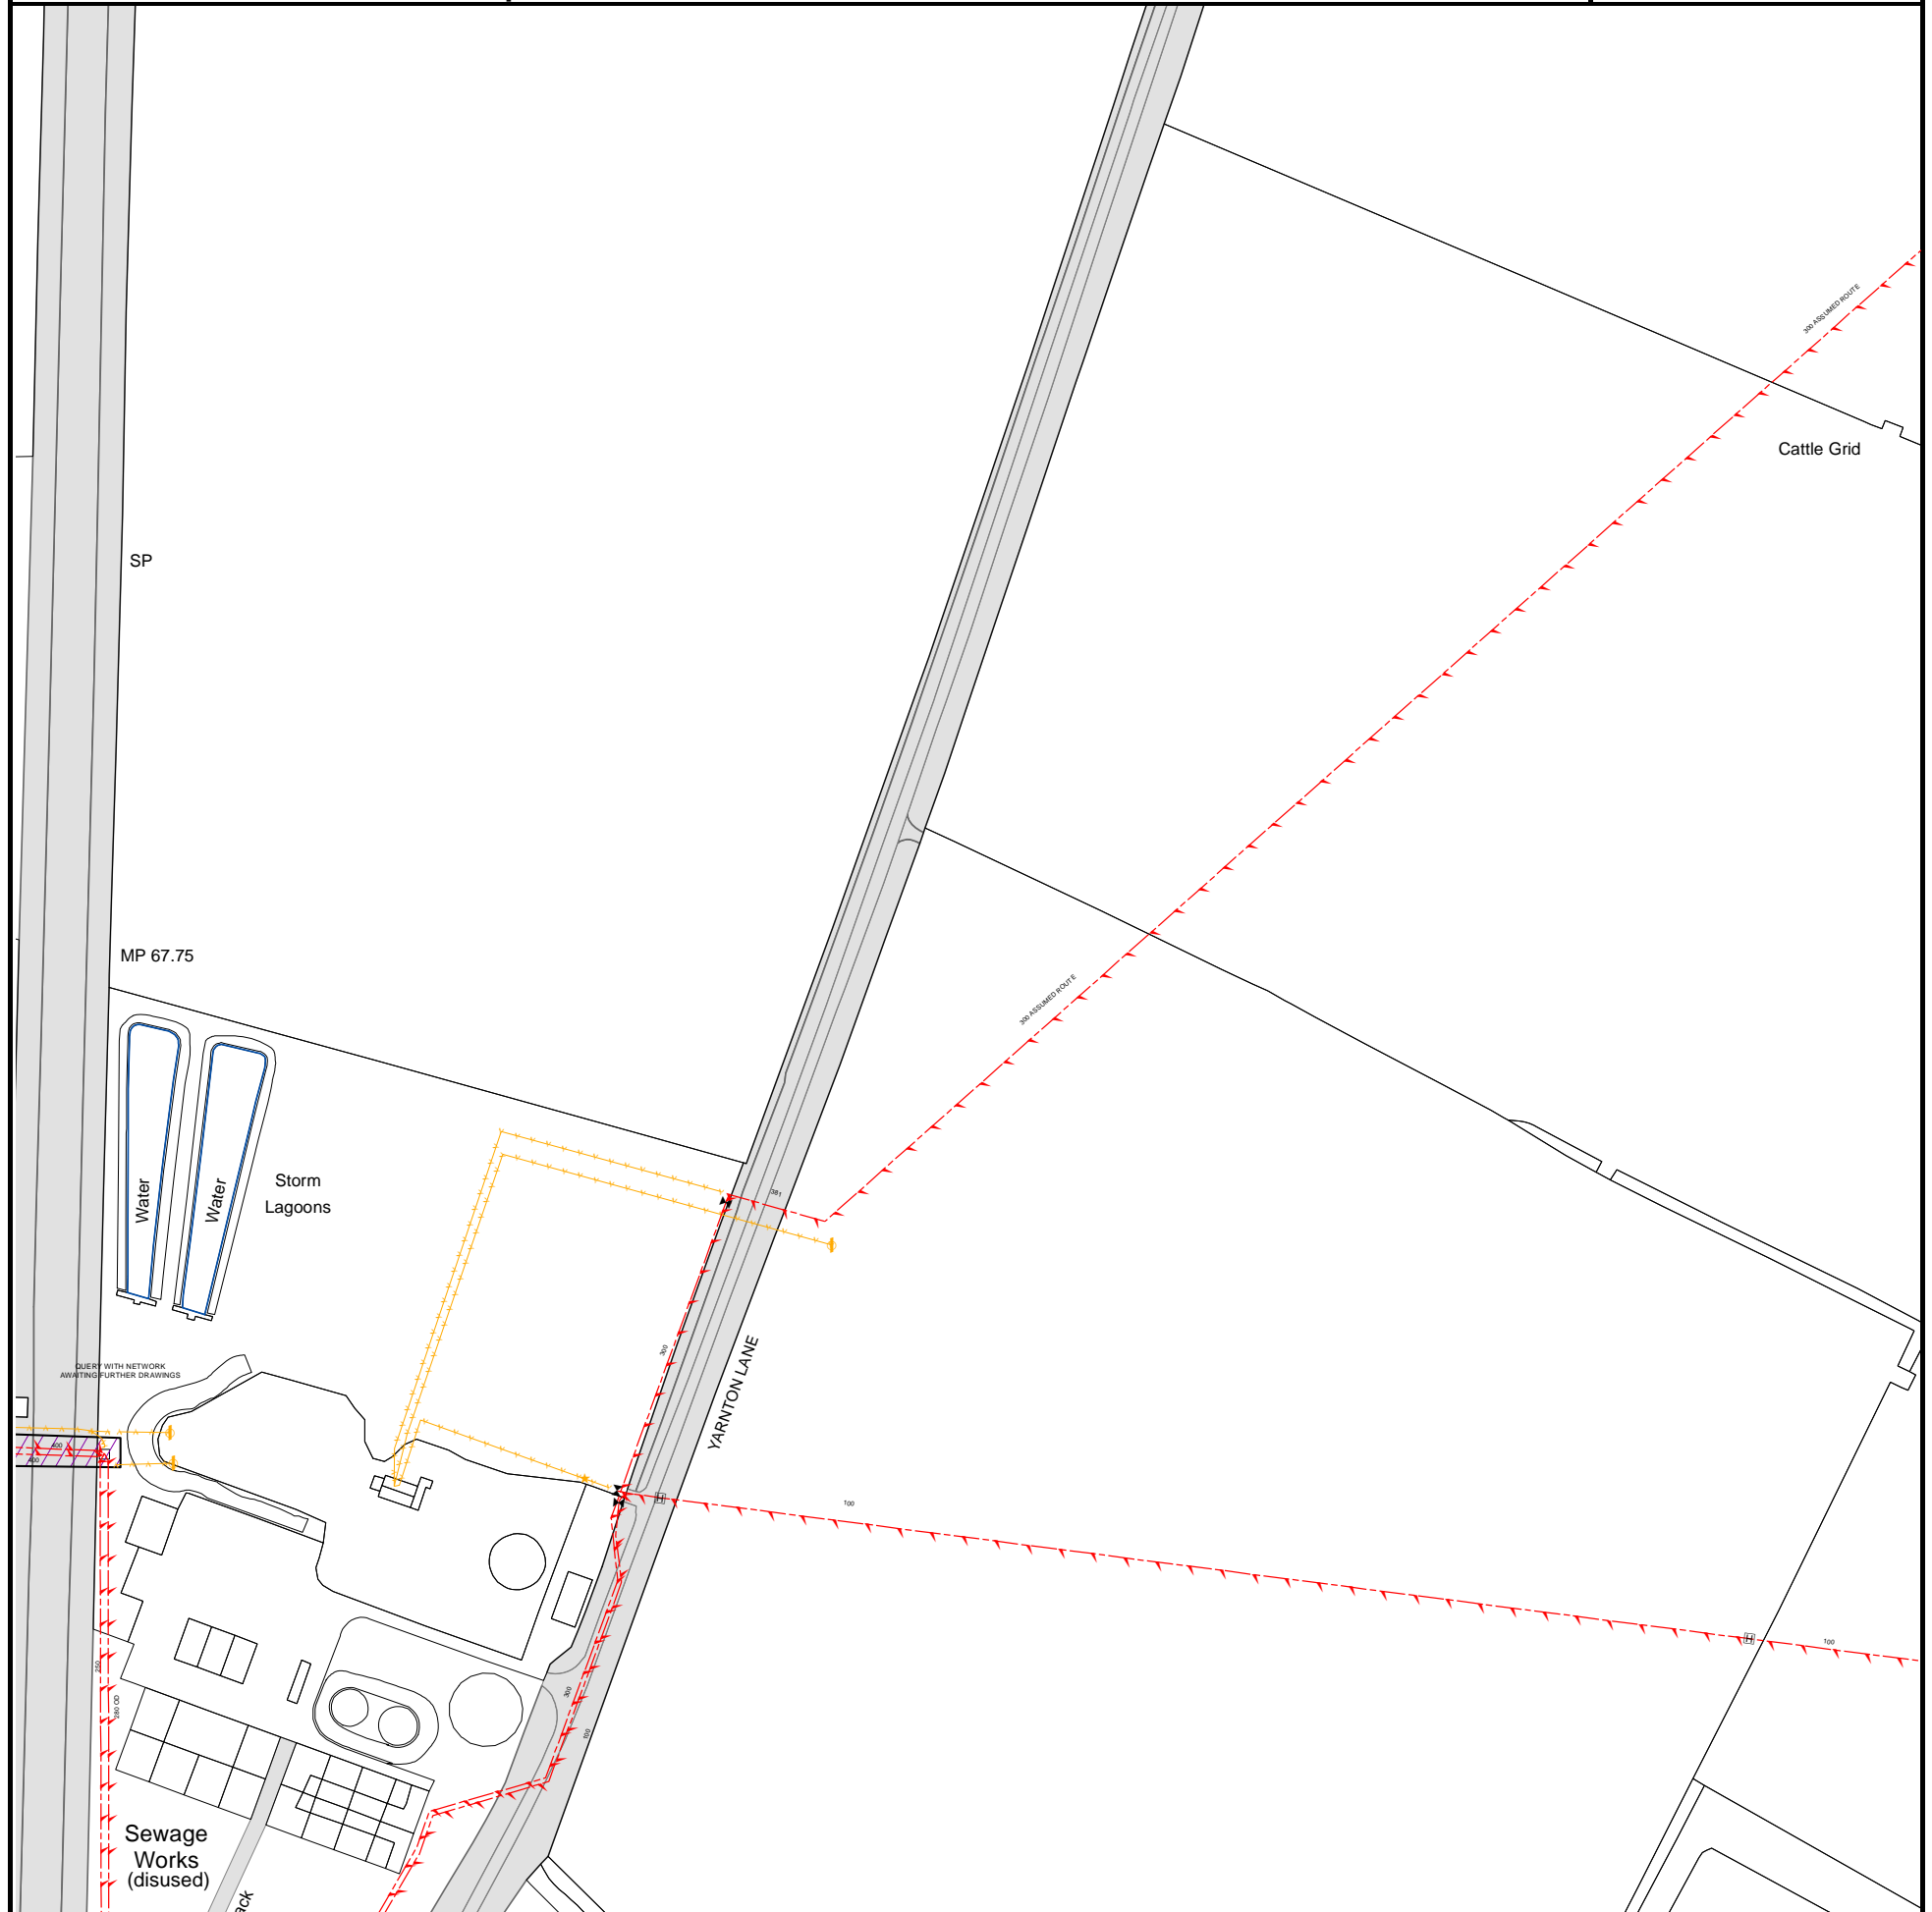

The width of the displayed area is 500m and the centre of the map is located at OS coordinates 448750,212750


The position of the apparatus shown on this plan is given without obligation and warranty, and the accuracy cannot be guaranteed. Service pipes are not shown but their presence should be anticipated. No liability of any kind whatsoever is accepted by Thames Water for any error or omission. The actual position of mains and services must be verified and established on site before any works are undertaken.

Based on the Ordnance Survey Map (2020) with the Sanction of the controller of H.M. Stationery Office, License no. 100019345 Crown Copyright Reserved.

NB. Levels quoted in metres Ordnance Newlyn Datum. The value -9999.00 indicates that no survey information is available

Manhole Reference	Manhole Cover Level	Manhole Invert Level
n/a	n/a	n/a

The position of the apparatus shown on this plan is given without obligation and warranty, and the accuracy cannot be guaranteed. Service pipes are not shown but their presence should be anticipated. No liability of any kind whatsoever is accepted by Thames Water for any error or omission. The actual position of mains and services must be verified and established on site before any works are undertaken.

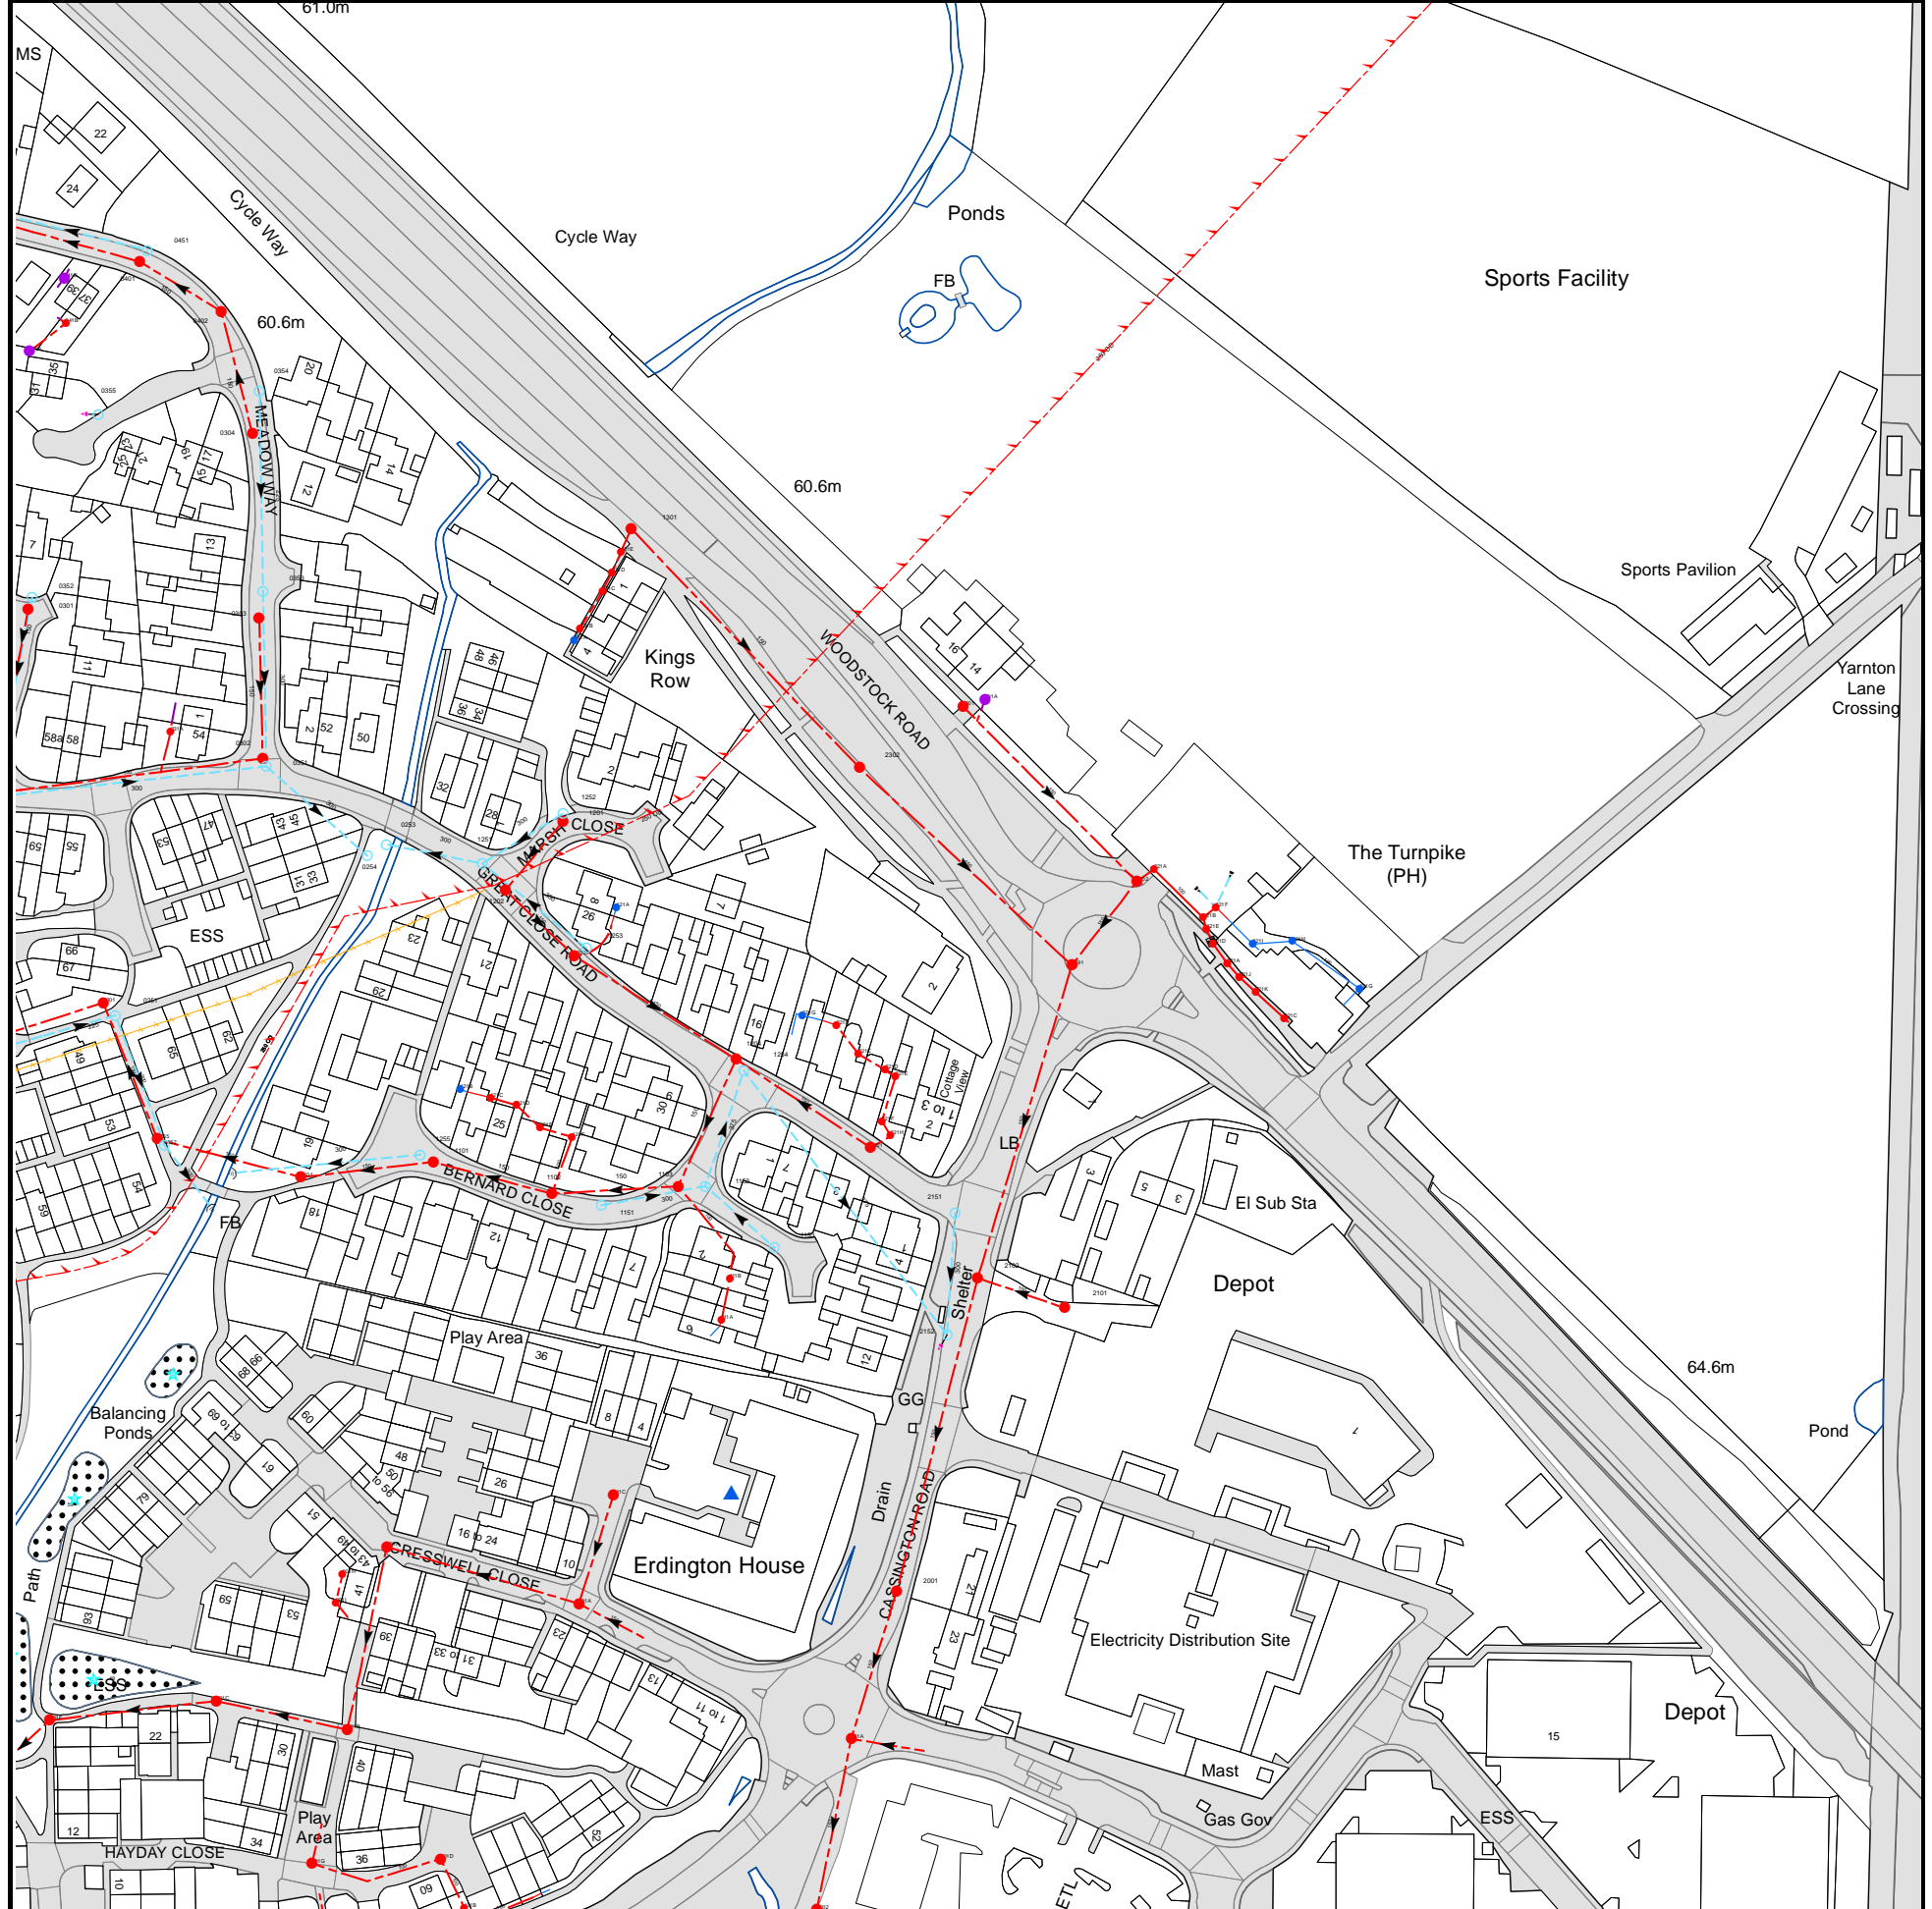

The width of the displayed area is 500m and the centre of the map is located at OS coordinates 448250,212250
The position of the apparatus shown on this plan is given without obligation and warranty, and the accuracy cannot be guaranteed. Service pipes are not shown but their presence should be anticipated. No liability of any kind whatsoever is accepted by Thames Water for any error or omission. The actual position of mains and services must be verified and established on site before any works are undertaken.


Based on the Ordnance Survey Map (2020) with the Sanction of the controller of H.M. Stationery Office, License no. 100019345 Crown Copyright Reserved.

NB. Levels quoted in metres Ordnance Newlyn Datum. The value -9999.00 indicates that no survey information is available

Manhole Reference	Manhole Cover Level	Manhole Invert Level
041C	n/a	n/a
0401	61.24	59.13
0451	61.21	60.34
031A	n/a	n/a
0303	60.82	59.37
0301	60.98	59.49
0352	60.99	60.05
0353	60.86	59.71
0304	60.98	59.51
0355	60.87	60
0354	61.02	59.79
041A	n/a	n/a
041B	n/a	n/a
0402	61.12	59.32
0252	60.43	59.27
0255	n/a	n/a
121F	n/a	n/a
121E	n/a	n/a
0251	60.46	59.15
0201	60.44	57.39
0351	60.82	59.6
0302	60.8	58.57
221B	n/a	n/a
221C	n/a	n/a
2302	60.44	58.47
2201	60.7	58.86
221F	n/a	n/a
221D	n/a	n/a
221H	n/a	n/a
221E	n/a	n/a
2301	60.3	58.68
231A	n/a	n/a
2291	n/a	n/a
2202	60.58	58.21
221A	n/a	n/a
321B	n/a	n/a
321E	n/a	n/a
321D	n/a	n/a
321F	n/a	n/a
321A	n/a	n/a
321J	n/a	n/a
321I	n/a	n/a
321K	n/a	n/a
321C	n/a	n/a
321H	n/a	n/a
321G	n/a	n/a
0254	n/a	n/a
0253	n/a	n/a
1255	60.38	59.18
1101	60.34	57.69
121B	n/a	n/a
1251	60.56	59.56
121C	n/a	n/a
1202	60.56	58.88
121D	n/a	n/a
1102	60.64	57.86
1252	60.55	59.59
1201	60.57	59.14
1203	60.71	58.59
131A	n/a	n/a
131B	n/a	n/a
1253	60.68	59.69
1151	60.59	59.61
131C	n/a	n/a
131D	n/a	n/a
121A	n/a	n/a
131E	n/a	n/a
1301	60.73	58.81
1103	60.56	58.1
1152	60.55	59.48
1204	60.49	58.19
1254	60.51	59.28
221G	n/a	n/a
001F	n/a	n/a
001C	n/a	n/a
0101	60.38	57.47
2002	59.96	56.89
101B	n/a	n/a
001G	n/a	n/a
101D	n/a	n/a
201A	n/a	n/a
001B	n/a	n/a
101A	n/a	n/a
001I	n/a	n/a
2001	60.27	57.3
001H	n/a	n/a
001A	n/a	n/a
111C	n/a	n/a
2152	60.43	58.97
111A	n/a	n/a

Manhole Reference	Manhole Cover Level	Manhole Invert Level
2101	60.2	58.11
111B	n/a	n/a
2102	60.09	57.76
1153	60.62	59.66
2151	60.41	59.09

The position of the apparatus shown on this plan is given without obligation and warranty, and the accuracy cannot be guaranteed. Service pipes are not shown but their presence should be anticipated. No liability of any kind whatsoever is accepted by Thames Water for any error or omission. The actual position of mains and services must be verified and established on site before any works are undertaken.

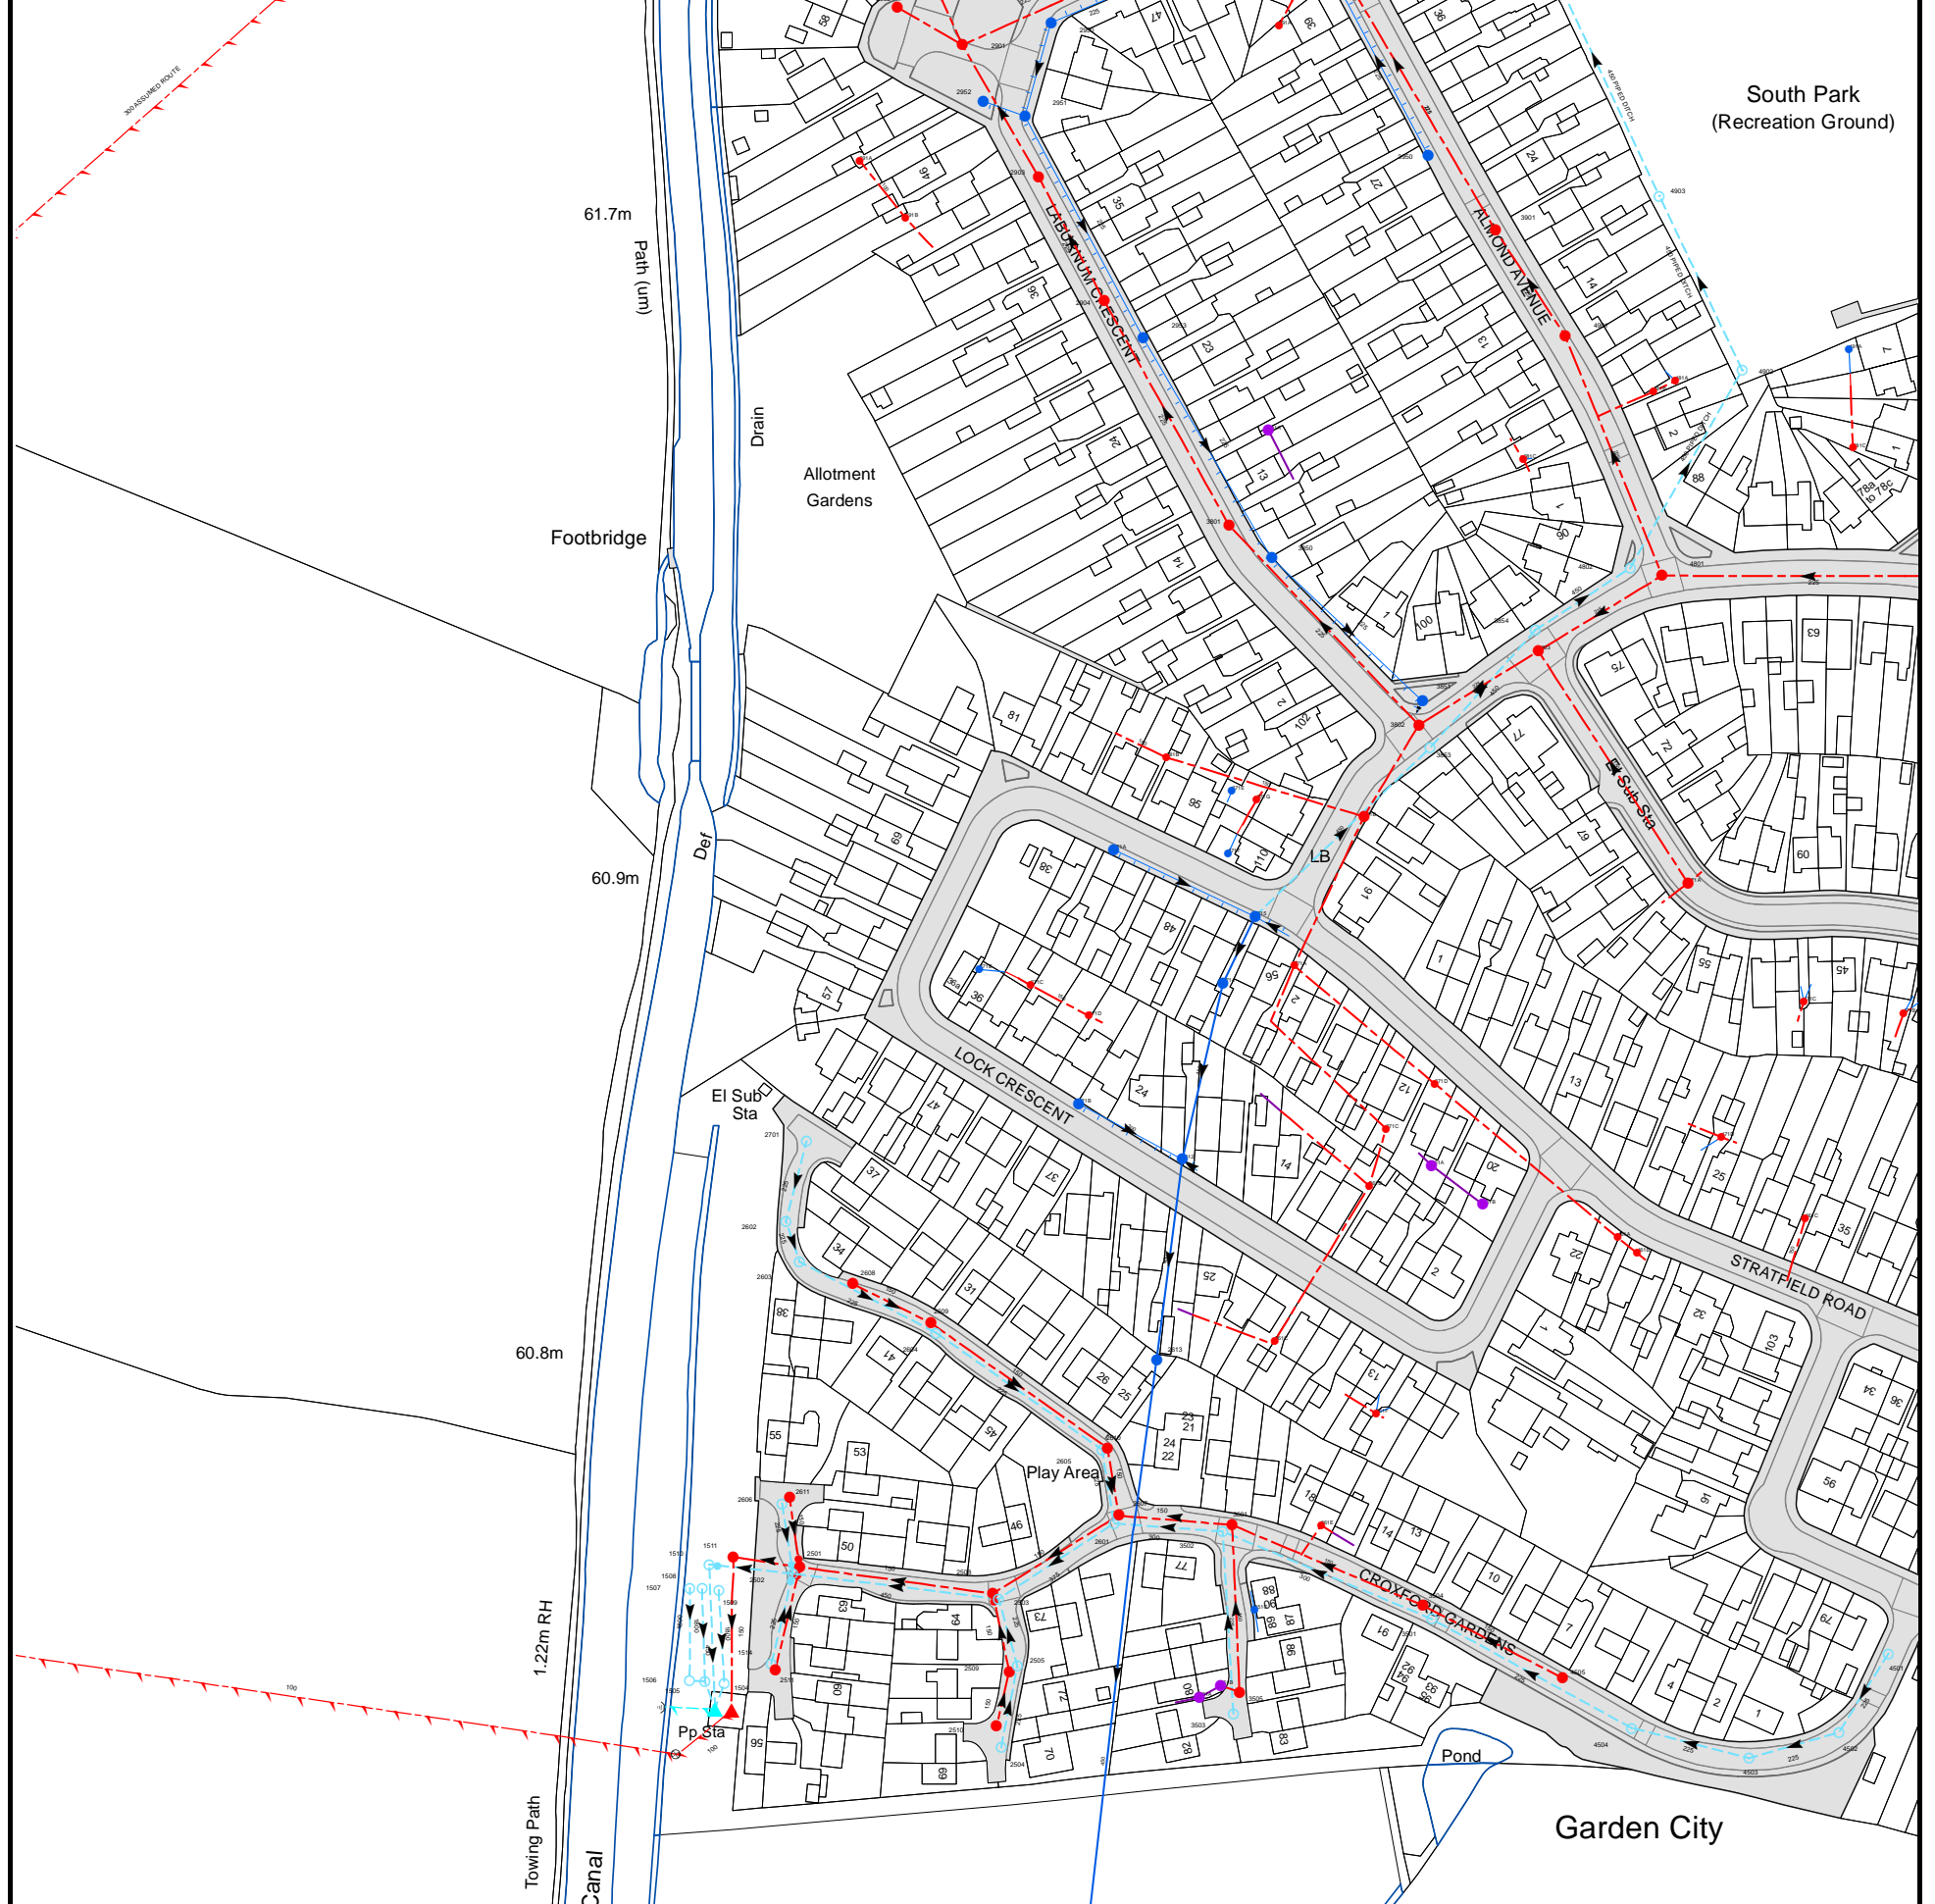

The width of the displayed area is 500m and the centre of the map is located at OS coordinates 449250,212750
The position of the apparatus shown on this plan is given without obligation and warranty, and the accuracy cannot be guaranteed. Service pipes are not shown but their presence should be anticipated. No liability of any kind whatsoever is accepted by Thames Water for any error or omission. The actual position of mains and services must be verified and established on site before any works are undertaken.


Based on the Ordnance Survey Map (2020) with the Sanction of the controller of H.M. Stationery Office, License no. 100019345 Crown Copyright Reserved.

NB. Levels quoted in metres Ordnance Newlyn Datum. The value -9999.00 indicates that no survey information is available

Manhole Reference	Manhole Cover Level	Manhole Invert Level
291A	n/a	n/a
2902	61.14	59.84
291B	n/a	n/a
1506	60.44	54.94
1507	60.39	54.99
1508	60.41	54.96
1505	60.44	54.9
1510	60.51	57.36
1509	60.41	54.96
1504	60.41	54.84
1511	60.49	55.44
1514	60.57	59.12
2511	60.6	58.75
2606	60.58	59.18
2602	60.6	59.13
2611	60.64	58.84
2502	60.42	57.71
2603	60.52	59.04
2501	60.46	57.23
2701	60.74	59.29
2608	60.31	58.62
2609	60.33	58.3
2604	60.47	58.76
2508	60.63	57.56
2510	60.71	59.35
2503	60.58	57.91
2504	60.65	58.94
2509	60.74	59.06
2505	60.74	58.54
2605	60.25	58.38
2610	60.28	57.92
2601	60.23	58.1
2607	60.23	57.8
2613	60.59	n/a
2612	60.67	59.39
351A	n/a	n/a
351B	n/a	n/a
3502	60.51	58.39
3601	60.48	58.08
3503	60.45	59.02
3505	60.49	59.12
351C	n/a	n/a
361C	n/a	n/a
361E	n/a	n/a
361D	n/a	n/a
361F	n/a	n/a
3504	60.4	58.59
361A	n/a	n/a
3501	60.43	58.83
361B	n/a	n/a
4505	60.8	58.99
461A	n/a	n/a
4504	61.13	59.59
461B	n/a	n/a
4503	61.74	60.35
461C	n/a	n/a
4502	62.31	60.81
4501	62.4	60.9
271E	n/a	n/a
271C	n/a	n/a
271B	n/a	n/a
271D	n/a	n/a
271A	n/a	n/a
381B	n/a	n/a
3714	n/a	n/a
371F	n/a	n/a
3801	60.86	57.32
371E	n/a	n/a
3715	n/a	n/a
371G	n/a	n/a
3850	60.9	59.56
371A	n/a	n/a
371B	n/a	n/a
371C	n/a	n/a
3802	61.12	57.47
3851	61.18	59.4
3853	n/a	n/a
371D	n/a	n/a
3854	n/a	n/a
3803	60.96	57.75
4802	n/a	n/a
4801	60.89	57.95
471A	n/a	n/a
471D	n/a	n/a
471C	n/a	n/a
471B	n/a	n/a
381C	n/a	n/a
481C	n/a	n/a
381A	n/a	n/a
481B	n/a	n/a

Manhole Reference	Manhole Cover Level	Manhole Invert Level
481A	n/a	n/a
4902	n/a	n/a
491A	n/a	n/a
2953	60.94	59.65
4901	61.13	57.64
2904	60.92	57.21
3901	61.17	57.48
4903	n/a	n/a
2903	61.06	n/a
3950	61.19	59.83
2951	61.17	59.68
2952	61.25	60.58
2901	61.18	n/a
391A	n/a	n/a
2950	61.16	59.77

The position of the apparatus shown on this plan is given without obligation and warranty, and the accuracy cannot be guaranteed. Service pipes are not shown but their presence should be anticipated. No liability of any kind whatsoever is accepted by Thames Water for any error or omission. The actual position of mains and services must be verified and established on site before any works are undertaken.

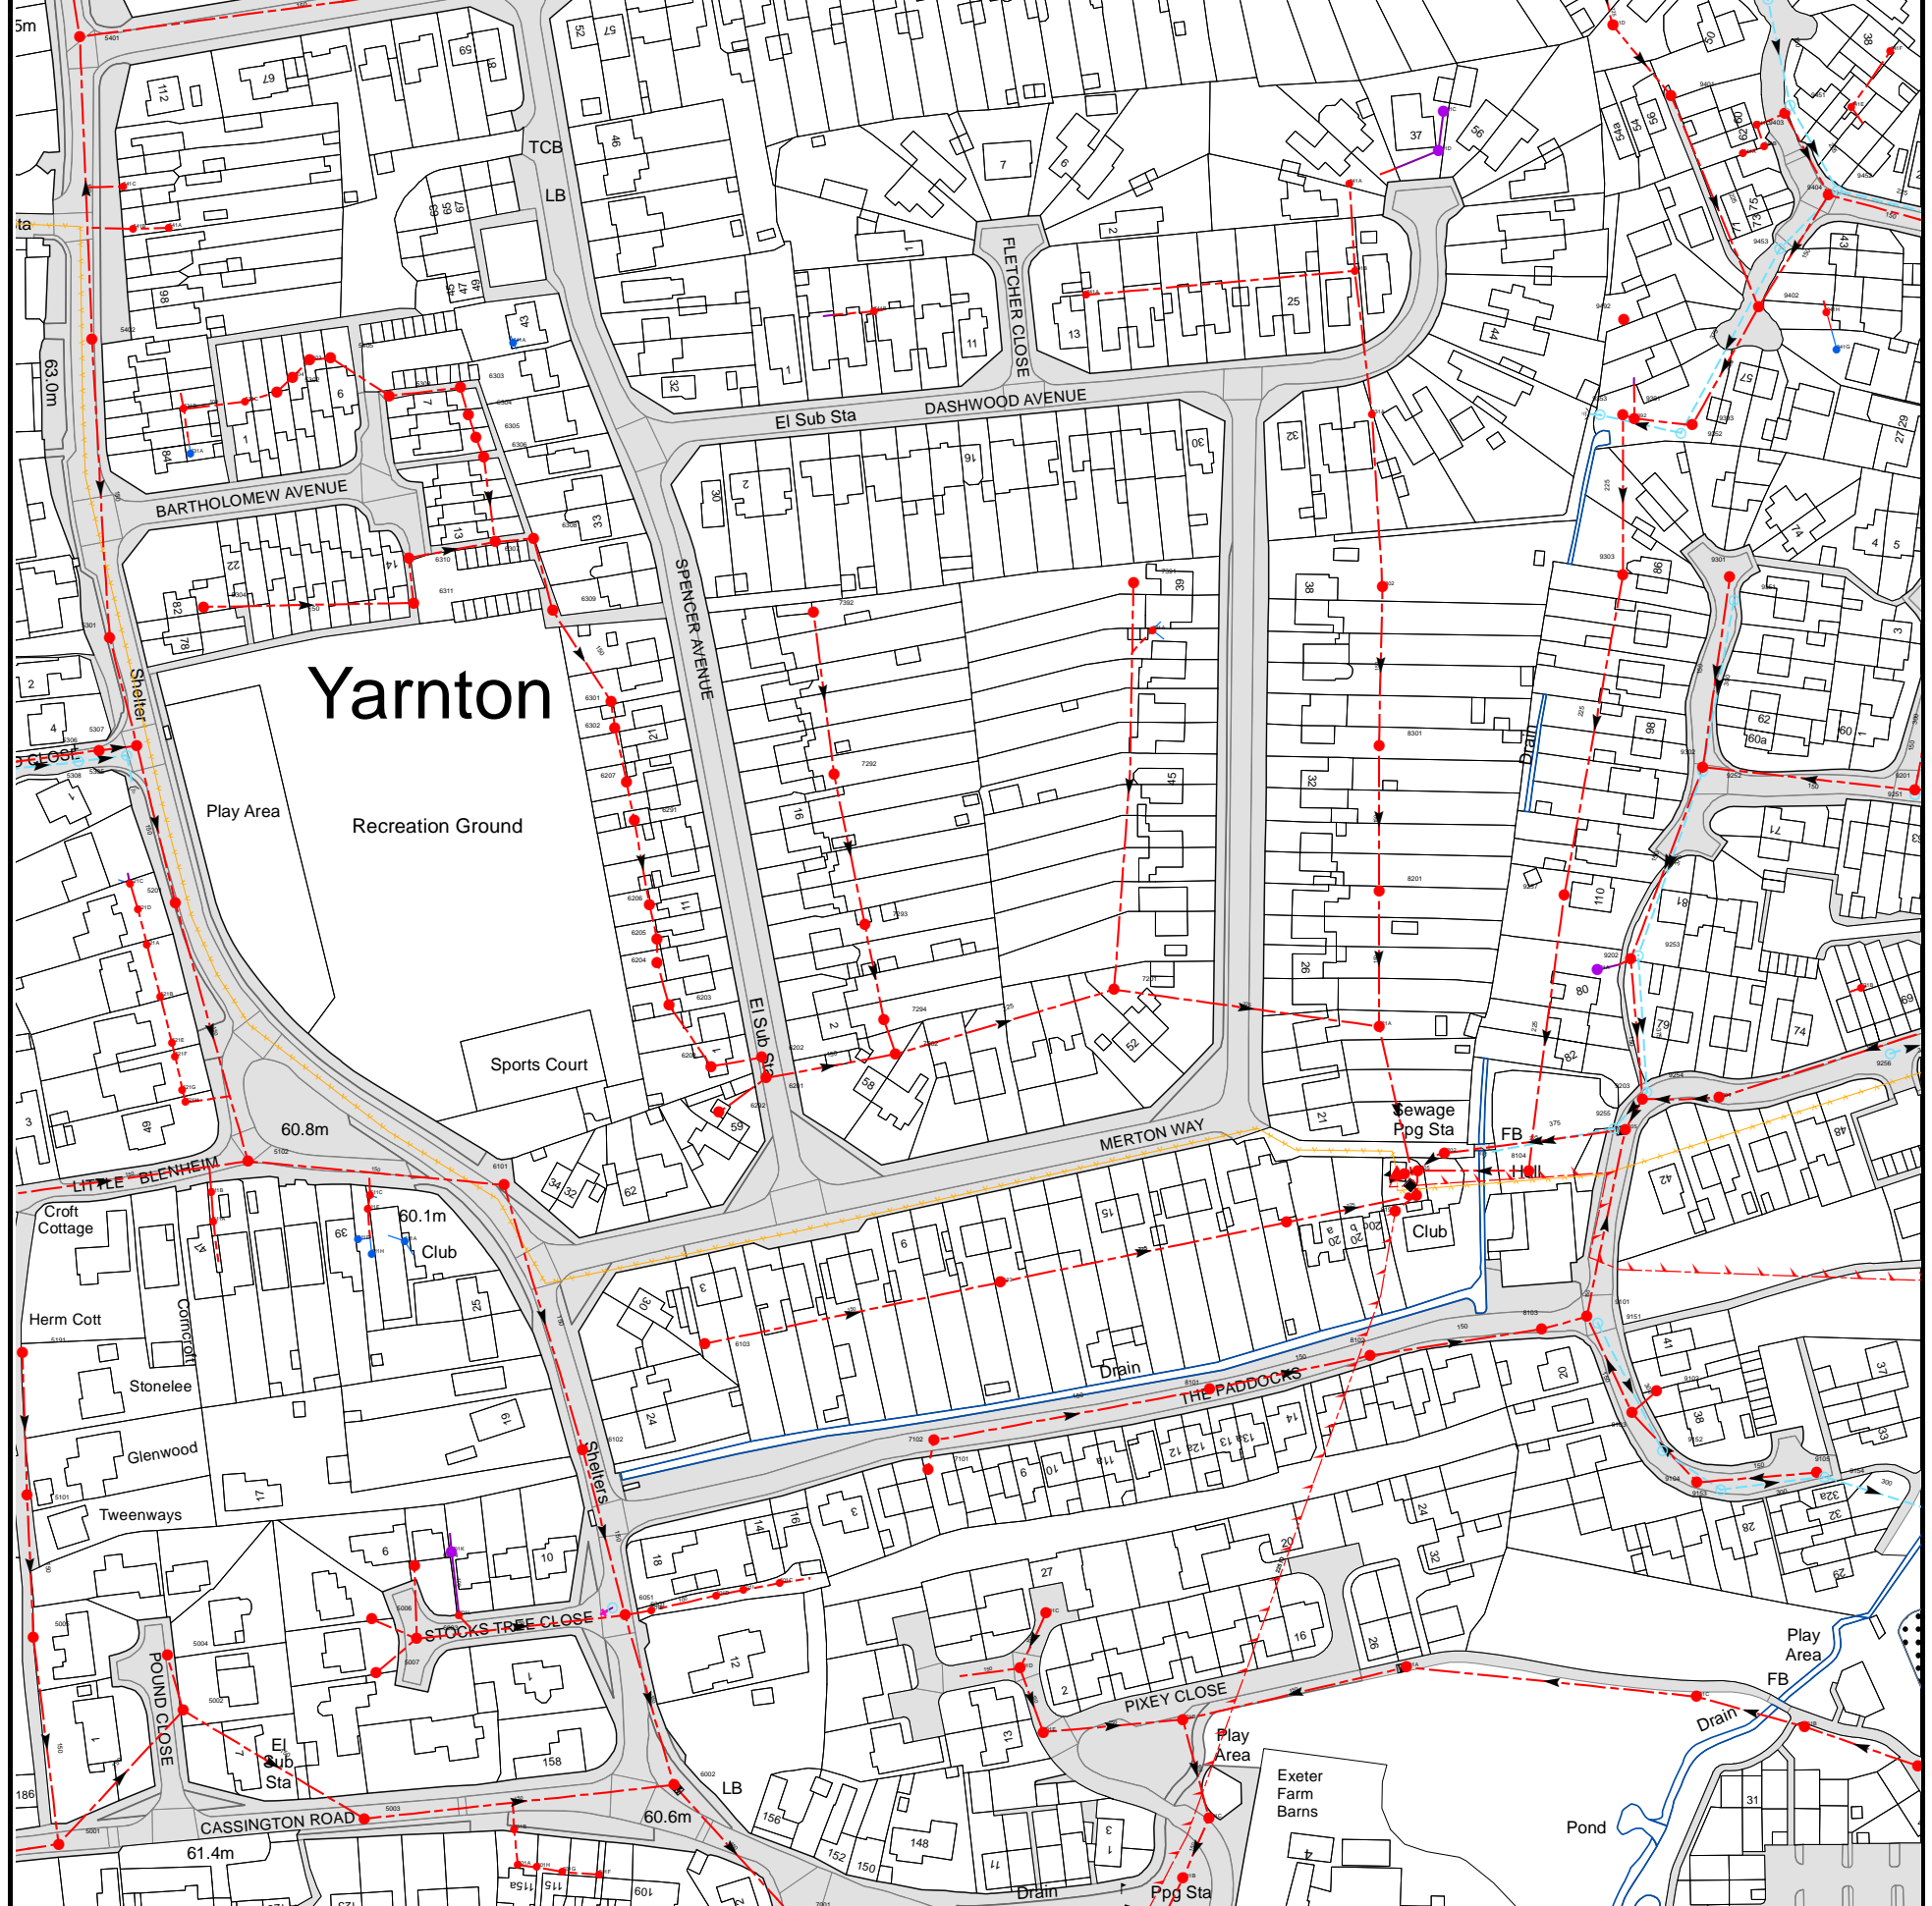

The width of the displayed area is 500m and the centre of the map is located at OS coordinates 447750,212250
The position of the apparatus shown on this plan is given without obligation and warranty, and the accuracy cannot be guaranteed. Service pipes are not shown but their presence should be anticipated. No liability of any kind whatsoever is accepted by Thames Water for any error or omission. The actual position of mains and services must be verified and established on site before any works are undertaken.


Based on the Ordnance Survey Map (2020) with the Sanction of the controller of H.M. Stationery Office, License no. 100019345 Crown Copyright Reserved.

NB. Levels quoted in metres Ordnance Newlyn Datum. The value -9999.00 indicates that no survey information is available

Manhole Reference	Manhole Cover Level	Manhole Invert Level
841A	n/a	n/a
841B	n/a	n/a
841D	n/a	n/a
841C	n/a	n/a
941D	n/a	n/a
9401	61.33	58.37
941A	n/a	n/a
941C	n/a	n/a
941B	n/a	n/a
9551	61.36	60.31
9453	61.19	59.94
9403	61.24	59.44
9451	61.23	60.19
9404	61.09	58.63
9452	61.09	59.99
941E	n/a	n/a
941F	n/a	n/a
5401	63.46	61.03
541C	n/a	n/a
541B	n/a	n/a
541A	n/a	n/a
741B	n/a	n/a
9351	60.69	59.65
9301	60.7	58.93
941G	n/a	n/a
941H	n/a	n/a
9402	61.21	58.22
5308	64.1	62.41
5305	63.15	n/a
5306	63.82	n/a
5307	62.65	60.45
5301	62.88	60.79
5304	62.93	62.1
6311	61.82	61.2
6310	61.81	61.11
6307	61.5	60.73
6306	61.62	60.95
531A	n/a	n/a
6305	61.68	60.94
6304	61.79	61.01
531B	n/a	n/a
531C	n/a	n/a
5303	61.99	61.23
5302	62.34	61.58
6303	61.75	61.08
5404	62.26	61.51
5403	62.08	61.32
5405	62.13	61.37
641A	n/a	n/a
5402	63.14	61.69
9204	60.2	56.68
9256	60.28	59.19
921B	n/a	n/a
9251	60.84	59.85
9201	60.85	58.32
9252	60.61	59.61
9302	60.62	57.95
741A	n/a	n/a
7201	60.52	58.75
7391	n/a	n/a
731A	n/a	n/a
831A	n/a	n/a
821A	n/a	n/a
8301	60.47	58.89
8201	60.38	58.76
8302	60.7	59.15
8105	60.15	55.85
8202	59.99	56.38
8104	60.11	57.83
9257	n/a	n/a
921A	n/a	n/a
9353	n/a	n/a
9255	60.32	59.22
9391	n/a	n/a
9303	60.72	57.92
9492	n/a	n/a
9205	60.36	56.56
9202	60.55	57.71
9392	n/a	n/a
9253	60.53	59.47
9203	60.42	56.6
9254	60.44	59.34
9352	60.73	59.31
9393	n/a	n/a
511C	n/a	n/a
511B	n/a	n/a
6101	60.58	58.83
5102	60.75	59.36
521H	n/a	n/a
521G	n/a	n/a

Manhole Reference	Manhole Cover Level	Manhole Invert Level
521F	n/a	n/a
521E	n/a	n/a
521B	n/a	n/a
521A	n/a	n/a
521D	n/a	n/a
5201	62	59.93
521C	n/a	n/a
6308	61.4	60.74
6309	61.23	60.63
6102	60.1	58.32
6301	60.75	60.21
6051	60.11	59.69
6302	60.72	60.24
6001	60.14	58.14
6207	60.66	60.17
6291	n/a	n/a
6206	60.52	59.93
601E	n/a	n/a
6204	60.49	59.95
6205	60.51	59.83
6203	60.48	59.96
6103	60.73	59.92
6208	60.46	59.73
601D	n/a	n/a
6292	n/a	n/a
601I	n/a	n/a
6202	60.46	59.66
6201	60.46	59.6
601C	n/a	n/a
7392	n/a	n/a
7292	n/a	n/a
7293	n/a	n/a
7294	n/a	n/a
7202	60.19	58.7
5002	61.41	59.87
5007	61.13	59.73
5004	62.01	60.91
6003	60.86	59.44
5005	62.83	61.11
5006	61.22	59.67
601L	n/a	n/a
6004	61.09	60.06
601K	n/a	n/a
5101	63.37	62.05
5191	n/a	n/a
511H	n/a	n/a
611A	n/a	n/a
511D	n/a	n/a
511A	n/a	n/a
511F	n/a	n/a
801B	n/a	n/a
901C	n/a	n/a
701D	n/a	n/a
801A	n/a	n/a
701C	n/a	n/a
9153	60.15	58.9
9104	60.44	58.87
9154	60.37	58.84
9105	60.77	59.36
7101	60.84	58.93
9152	60.09	58.97
7102	60.65	58.87
9103	60.03	58.28
9102	60.18	59.16
8101	60.27	58.11
8102	60.18	57.68
8103	60.24	57.44
9151	60.15	59.12
9101	60.12	57.17
7103	60.4	59.45
811A	n/a	n/a
811B	n/a	n/a
8196	n/a	n/a
8195	n/a	n/a
601A	n/a	n/a
601H	n/a	n/a
601G	n/a	n/a
601F	n/a	n/a
6002	60.5	57.99
701E	n/a	n/a
701B	n/a	n/a
801C	n/a	n/a
901B	n/a	n/a
901A	n/a	n/a
5001	61.64	60.04
5003	60.96	59.7
601B	n/a	n/a

The position of the apparatus shown on this plan is given without obligation and warranty, and the accuracy cannot be guaranteed. Service pipes are not shown but their presence should be anticipated. No liability of any kind whatsoever is accepted by Thames Water for any error or omission. The actual position of mains and services must be verified and established on site before any works are undertaken.

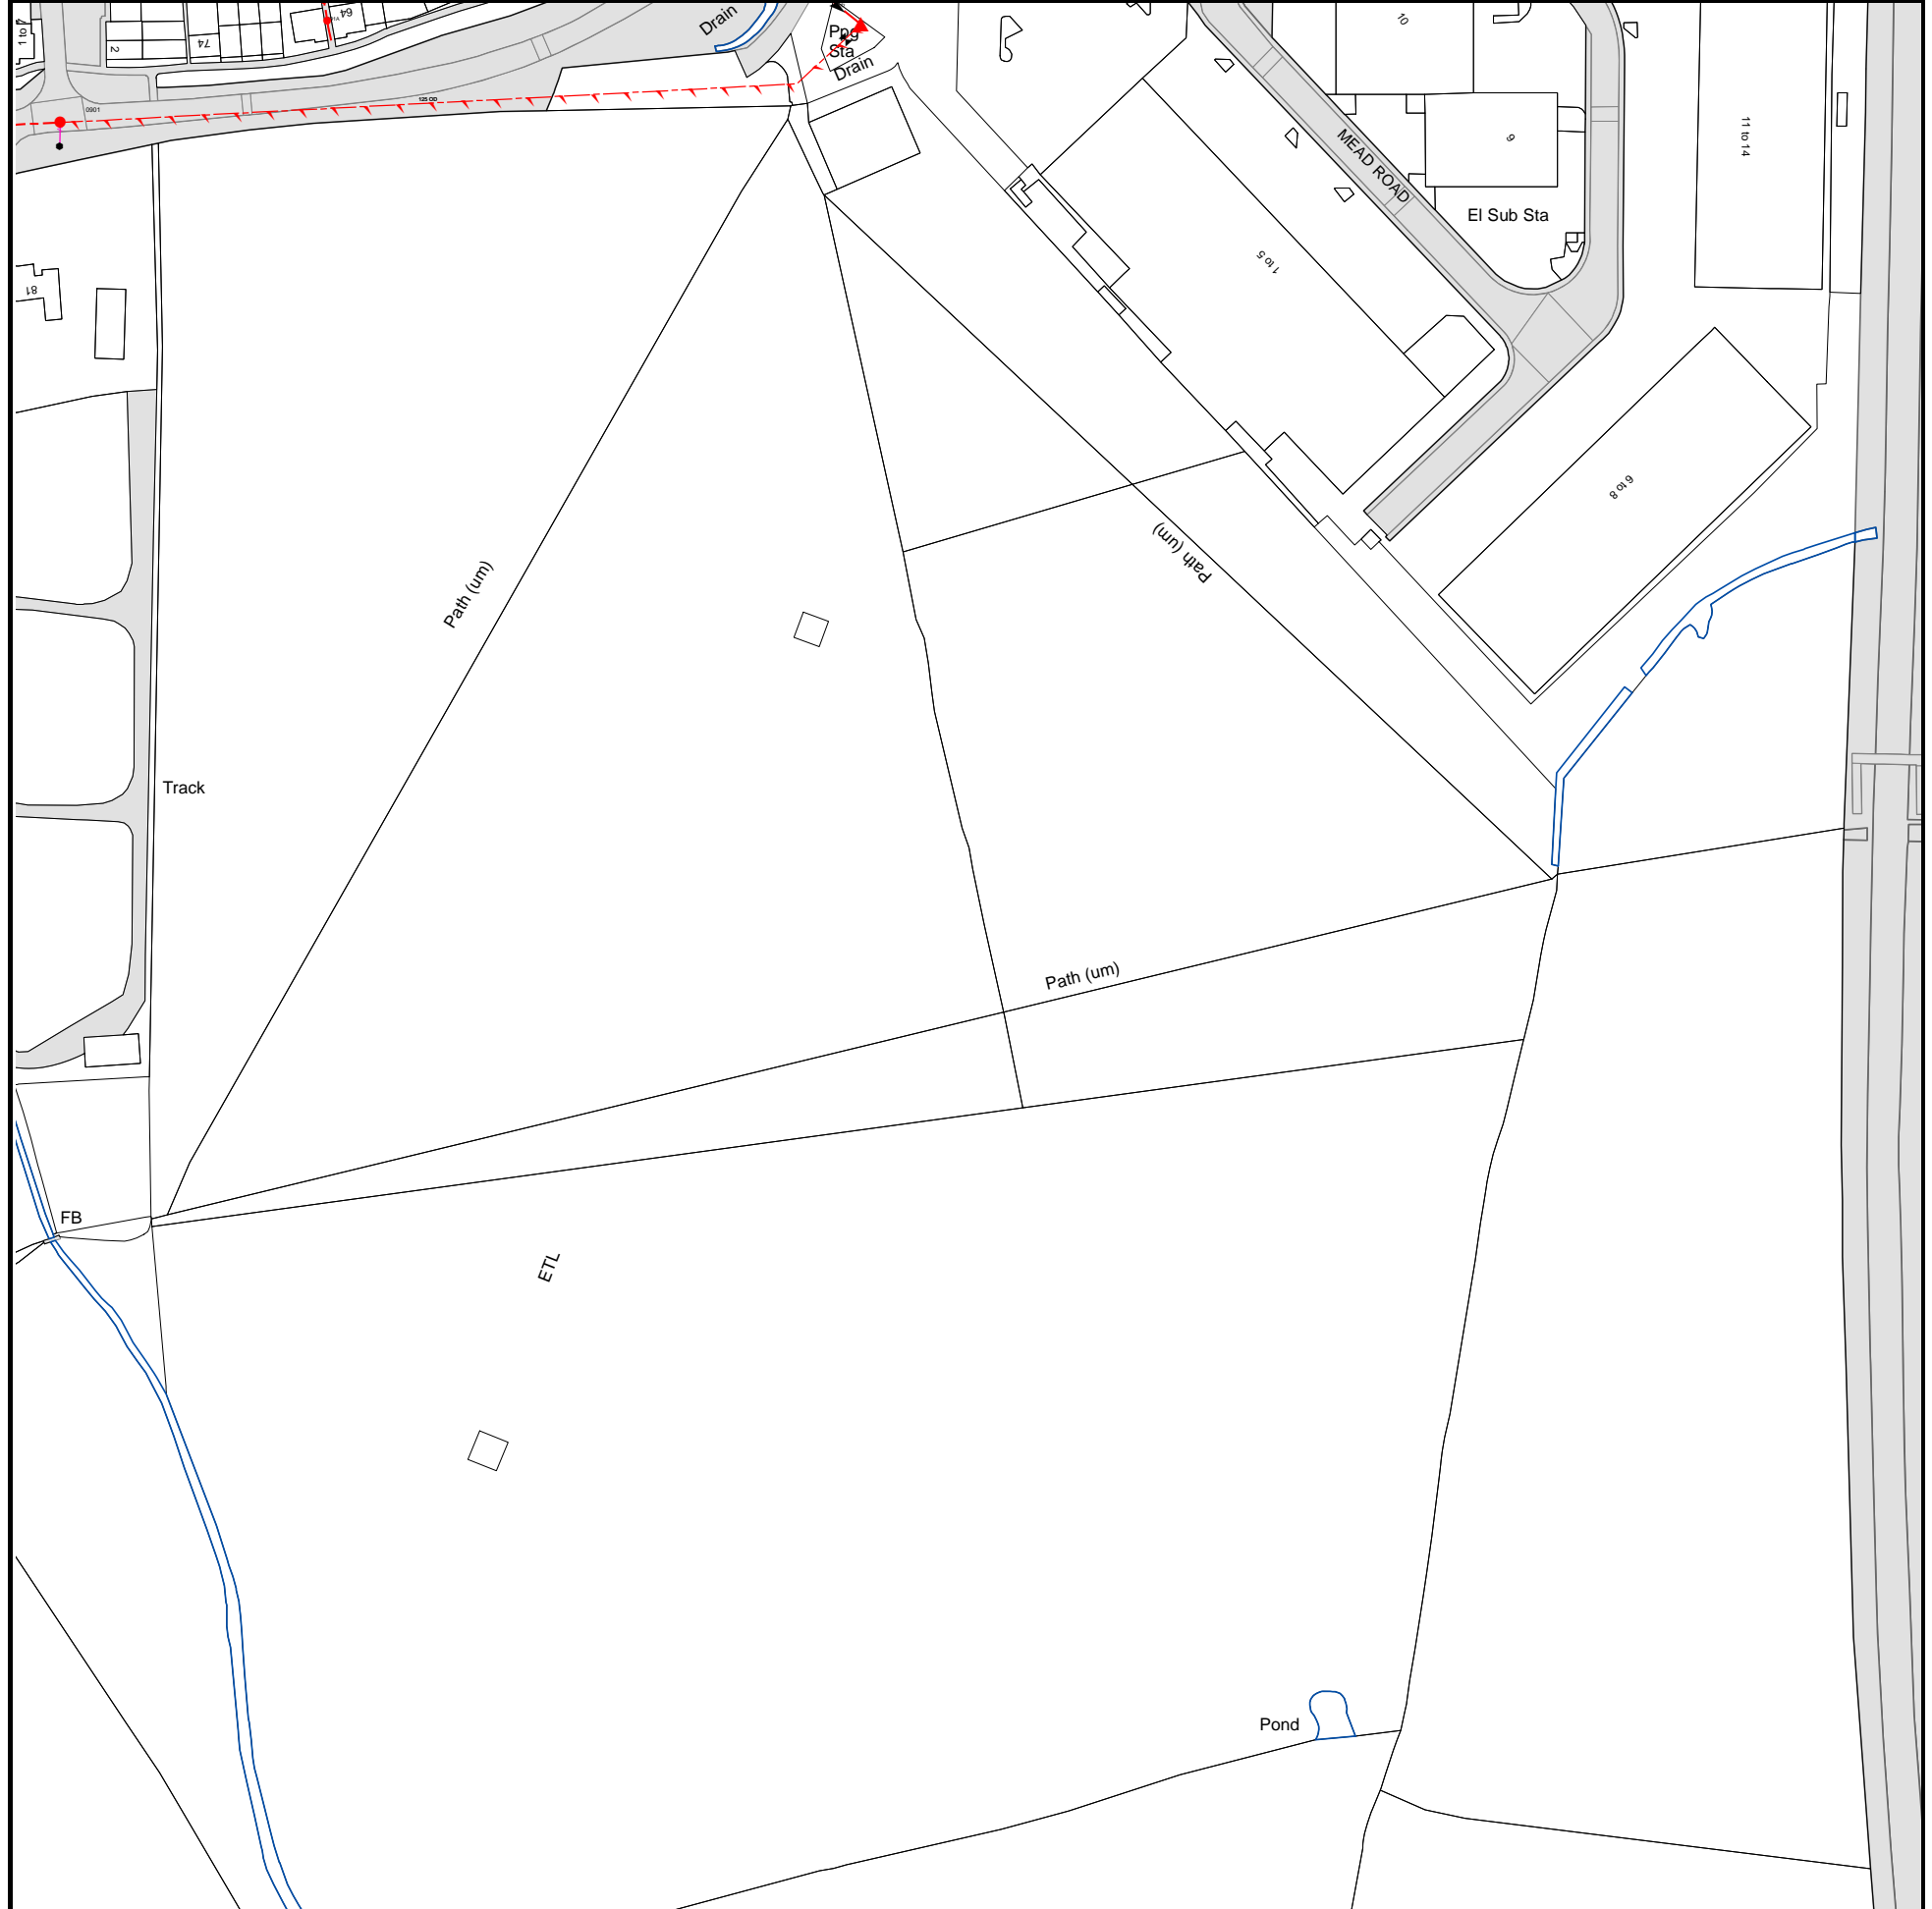

The width of the displayed area is 500m and the centre of the map is located at OS coordinates 448250,211750


The position of the apparatus shown on this plan is given without obligation and warranty, and the accuracy cannot be guaranteed. Service pipes are not shown but their presence should be anticipated. No liability of any kind whatsoever is accepted by Thames Water for any error or omission. The actual position of mains and services must be verified and established on site before any works are undertaken.

Based on the Ordnance Survey Map (2020) with the Sanction of the controller of H.M. Stationery Office, License no. 100019345 Crown Copyright Reserved.

NB. Levels quoted in metres Ordnance Newlyn Datum. The value -9999.00 indicates that no survey information is available

Manhole Reference	Manhole Cover Level	Manhole Invert Level
0901	60.02	58.91
091A	n/a	n/a
091B	n/a	n/a

The position of the apparatus shown on this plan is given without obligation and warranty, and the accuracy cannot be guaranteed. Service pipes are not shown but their presence should be anticipated. No liability of any kind whatsoever is accepted by Thames Water for any error or omission. The actual position of mains and services must be verified and established on site before any works are undertaken.

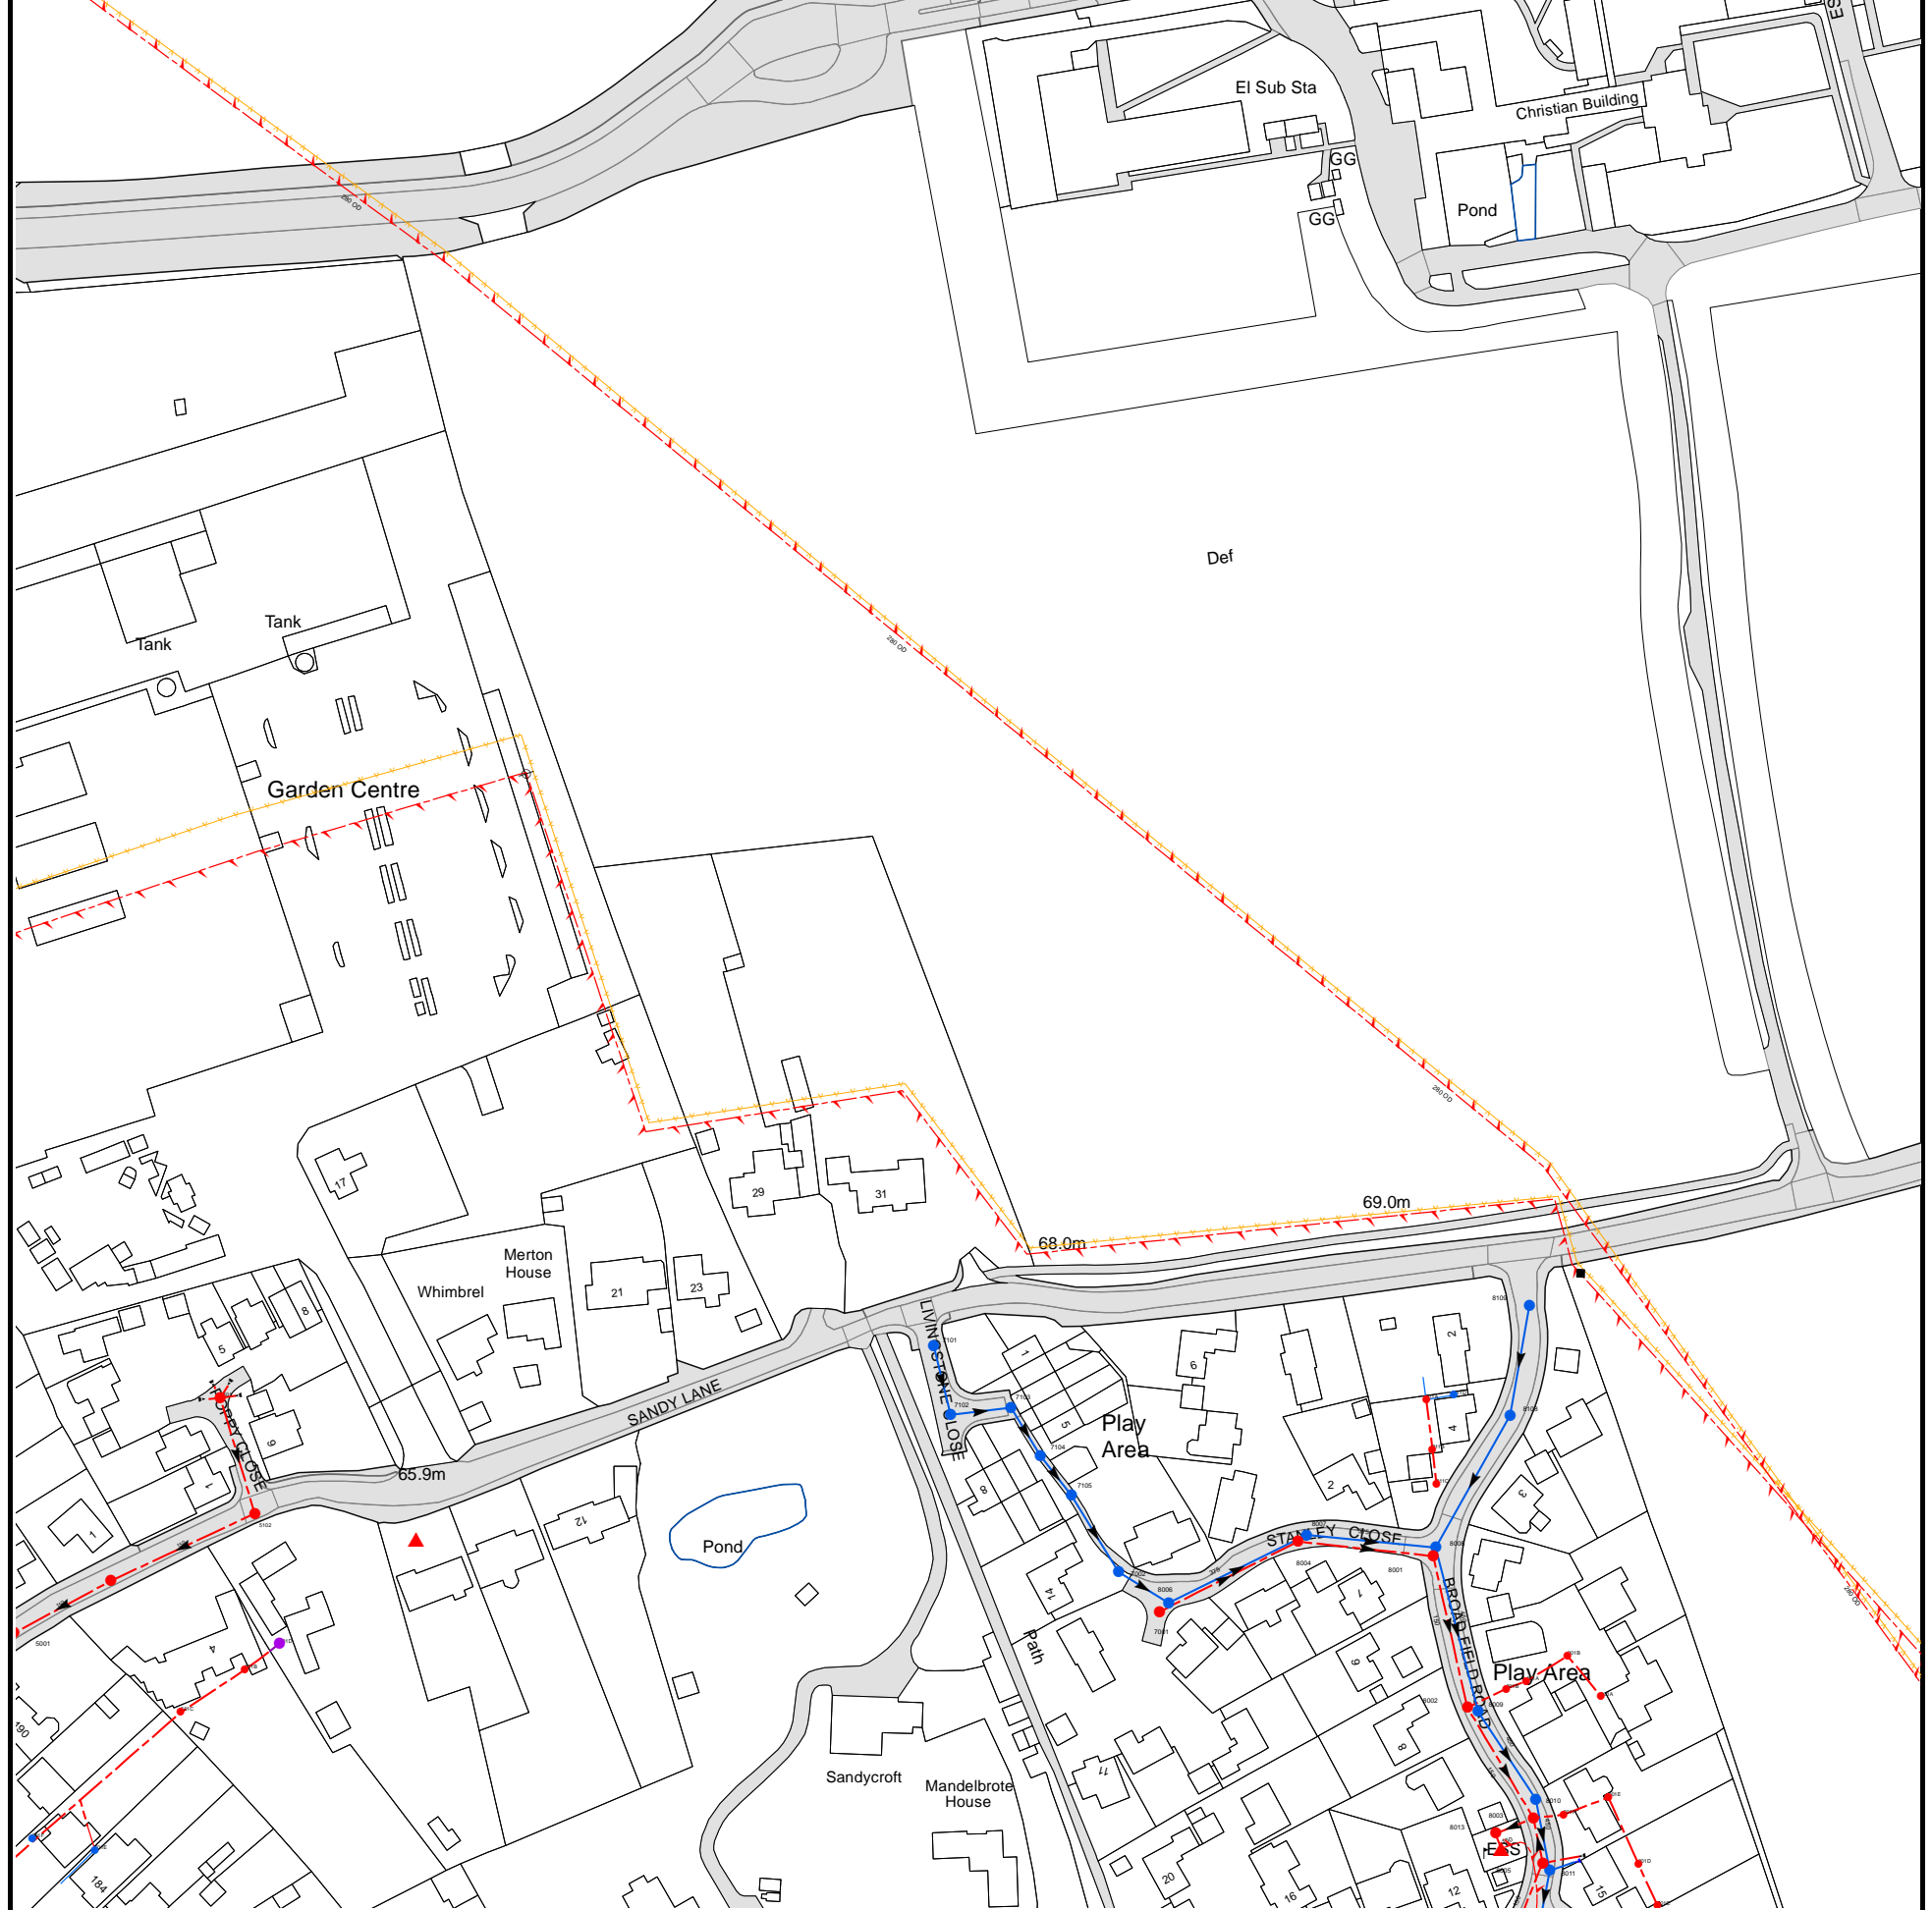


The width of the displayed area is 500m and the centre of the map is located at OS coordinates 447750,213250
The position of the apparatus shown on this plan is given without obligation and warranty, and the accuracy cannot be guaranteed. Service pipes are not shown but their presence should be anticipated. No liability of any kind whatsoever is accepted by Thames Water for any error or omission. The actual position of mains and services must be verified and established on site before any works are undertaken.

Based on the Ordnance Survey Map (2020) with the Sanction of the controller of H.M. Stationery Office, License no. 100019345 Crown Copyright Reserved.

NB. Levels quoted in metres Ordnance Newlyn Datum. The value -9999.00 indicates that no survey information is available

Manhole Reference	Manhole Cover Level	Manhole Invert Level
7101	67.7	66.28
7102	67.4	66
7103	66.62	65.45
7104	66.48	65
7105	65.97	64.92
811A	n/a	n/a
811B	n/a	n/a
811C	n/a	n/a
811D	n/a	n/a
8108	67.33	65.2
8109	68.47	67
901F	n/a	n/a
8010	65.95	64.05
901E	n/a	n/a
8009	65.9	64.13
8002	65.83	63.18
901A	n/a	n/a
801B	n/a	n/a
801A	n/a	n/a
901B	n/a	n/a
7001	65.78	64.15
8006	65.83	64.54
7002	65.88	64.78
8001	65.75	63.52
8008	65.83	64.23
8004	65.79	63.82
8007	65.78	64.42
901C	n/a	n/a
8011	65.82	64.01
901D	n/a	n/a
8005	65.88	61.84
8013	66.5	61.62
8003	66	61.74
501E	n/a	n/a
501F	n/a	n/a
501C	n/a	n/a
501B	n/a	n/a
501D	n/a	n/a
5001	67.43	64.91
501A	67.35	65.1
5102	66.32	65.37
5101	66.28	65.59

The position of the apparatus shown on this plan is given without obligation and warranty, and the accuracy cannot be guaranteed. Service pipes are not shown but their presence should be anticipated. No liability of any kind whatsoever is accepted by Thames Water for any error or omission. The actual position of mains and services must be verified and established on site before any works are undertaken.

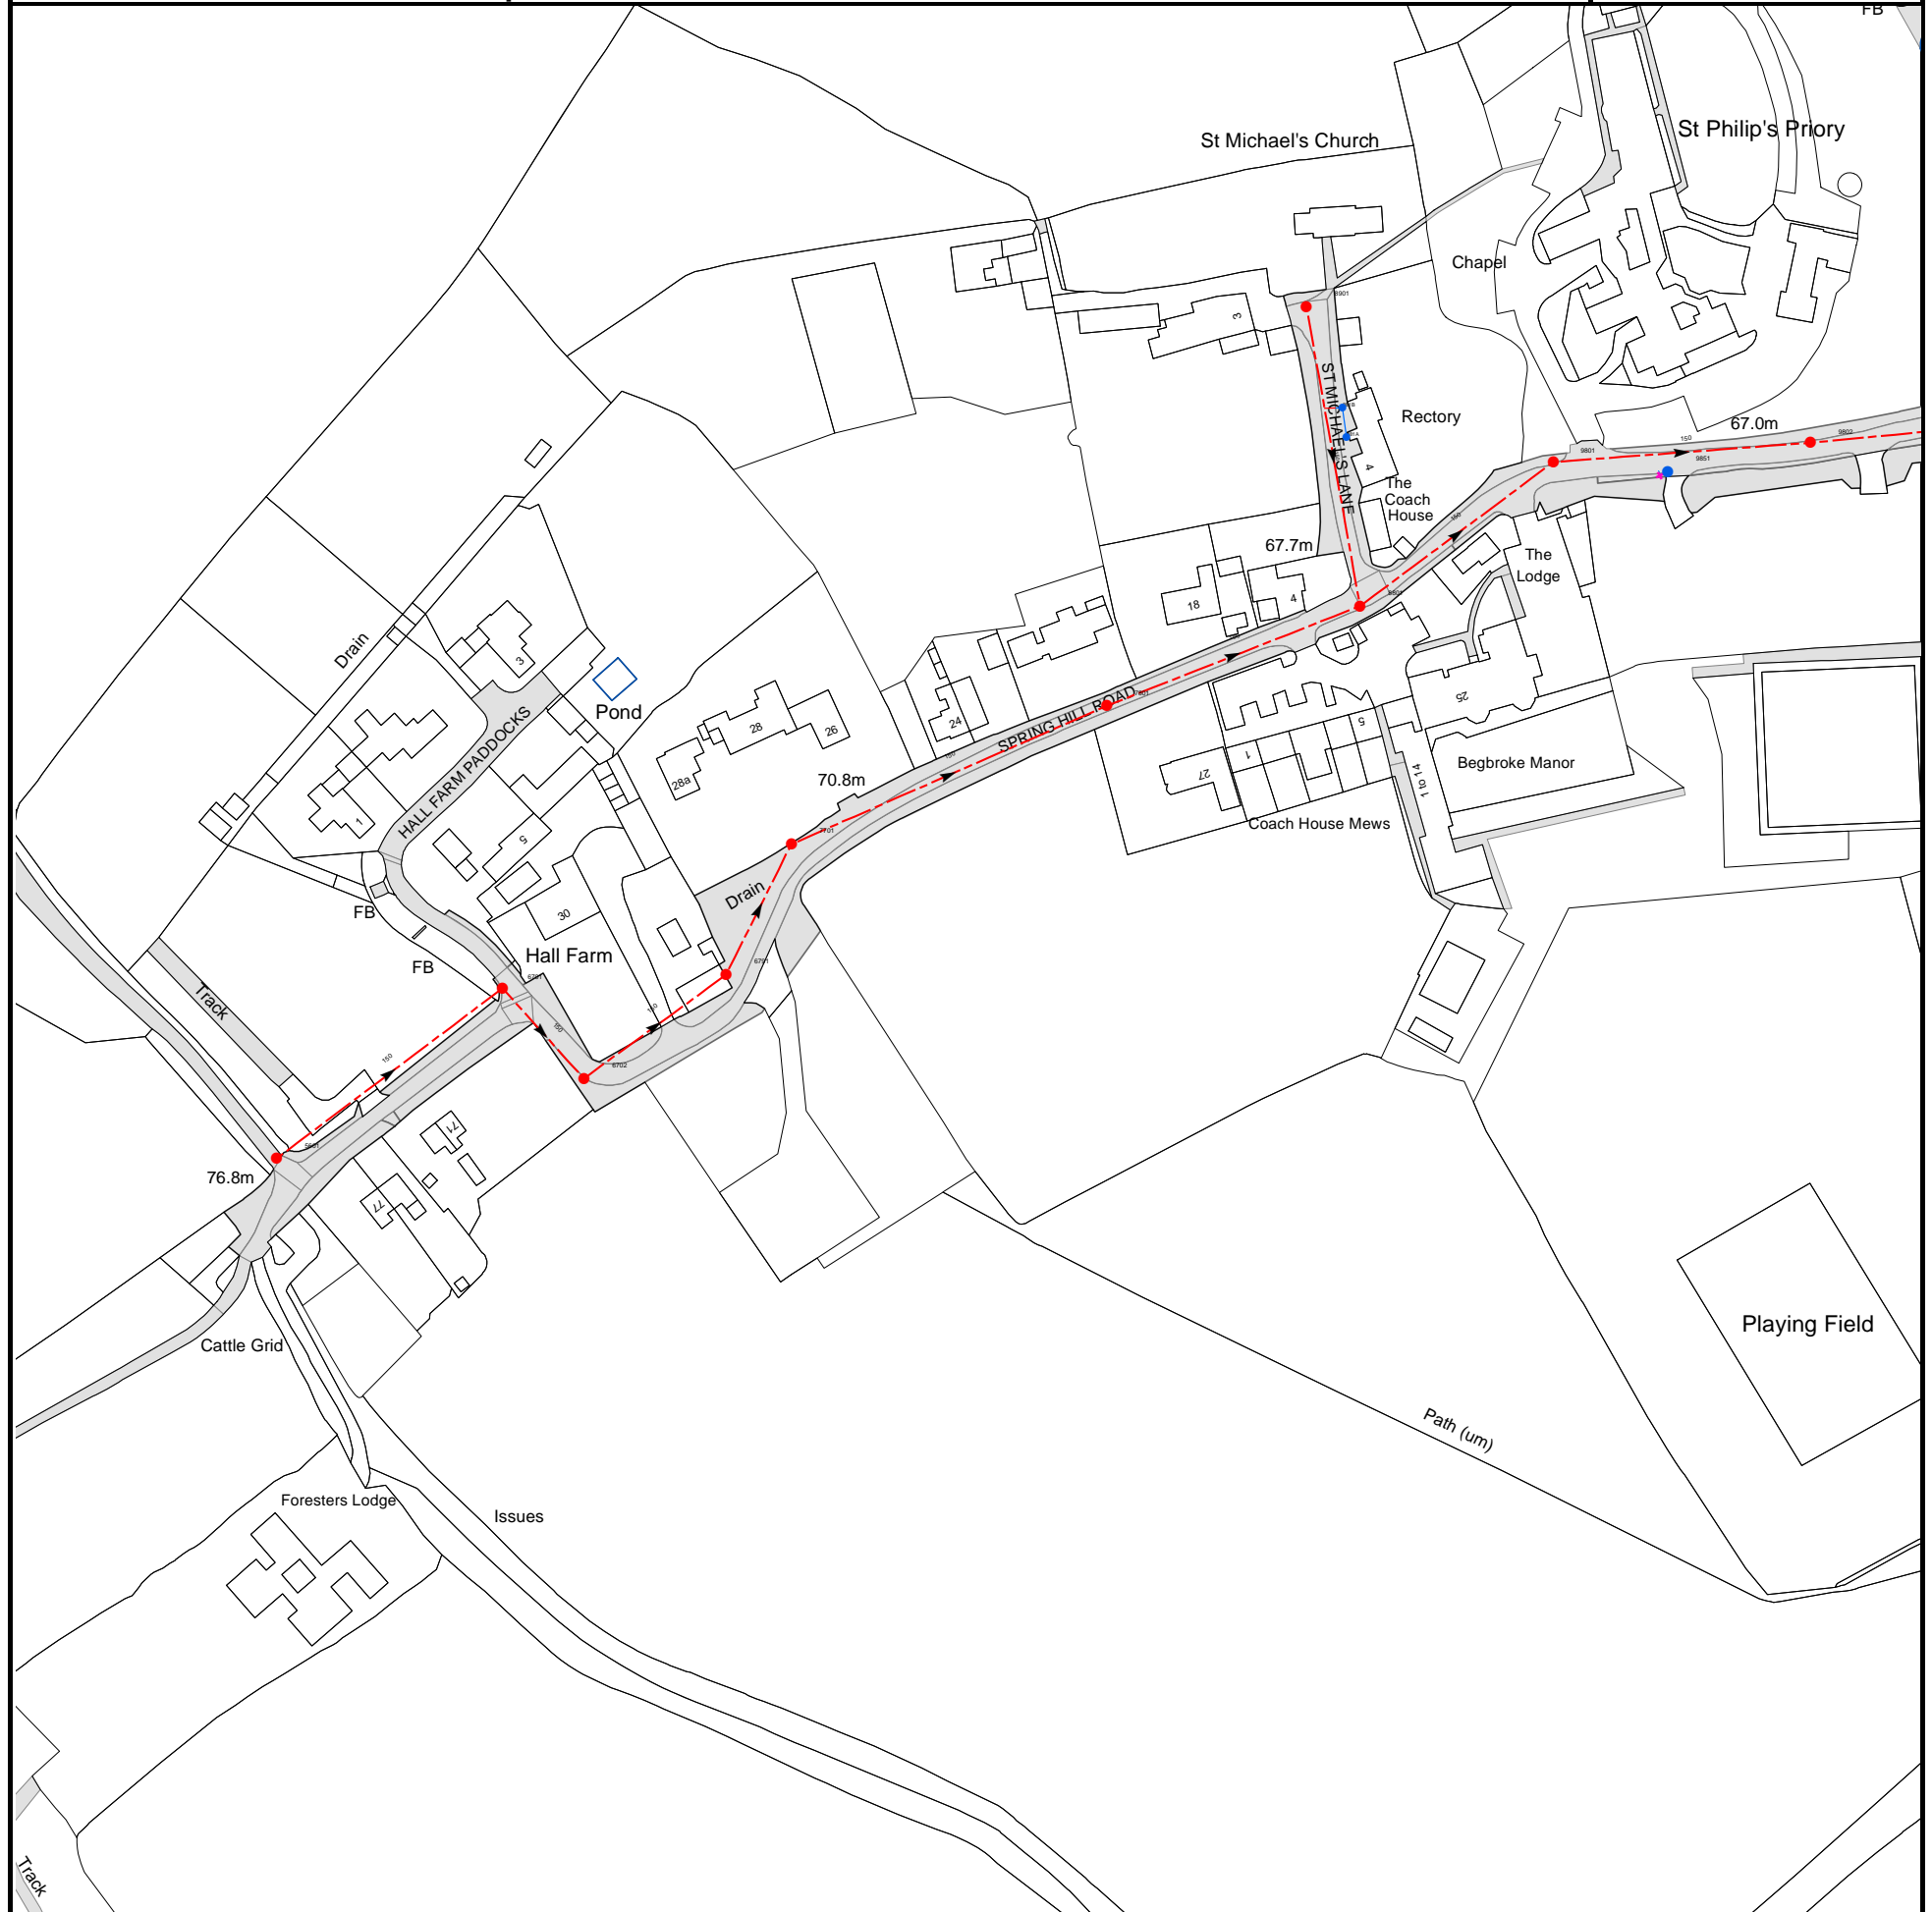

The width of the displayed area is 500m and the centre of the map is located at OS coordinates 446750,213750


The position of the apparatus shown on this plan is given without obligation and warranty, and the accuracy cannot be guaranteed. Service pipes are not shown but their presence should be anticipated. No liability of any kind whatsoever is accepted by Thames Water for any error or omission. The actual position of mains and services must be verified and established on site before any works are undertaken.

Based on the Ordnance Survey Map (2020) with the Sanction of the controller of H.M. Stationery Office, License no. 100019345 Crown Copyright Reserved.

NB. Levels quoted in metres Ordnance Newlyn Datum. The value -9999.00 indicates that no survey information is available

Manhole Reference	Manhole Cover Level	Manhole Invert Level
6791	n/a	n/a
7701	71.83	70.32
7801	69.3	67.65
8901	68.63	67.33
881B	n/a	n/a
881A	n/a	n/a
8801	67.22	65.91
9801	67.23	66.06
9851	67.1	66.37
9802	67.02	65.74
5601	76.58	75.22
6701	75.54	73.85
6702	75.18	73.18

The position of the apparatus shown on this plan is given without obligation and warranty, and the accuracy cannot be guaranteed. Service pipes are not shown but their presence should be anticipated. No liability of any kind whatsoever is accepted by Thames Water for any error or omission. The actual position of mains and services must be verified and established on site before any works are undertaken.

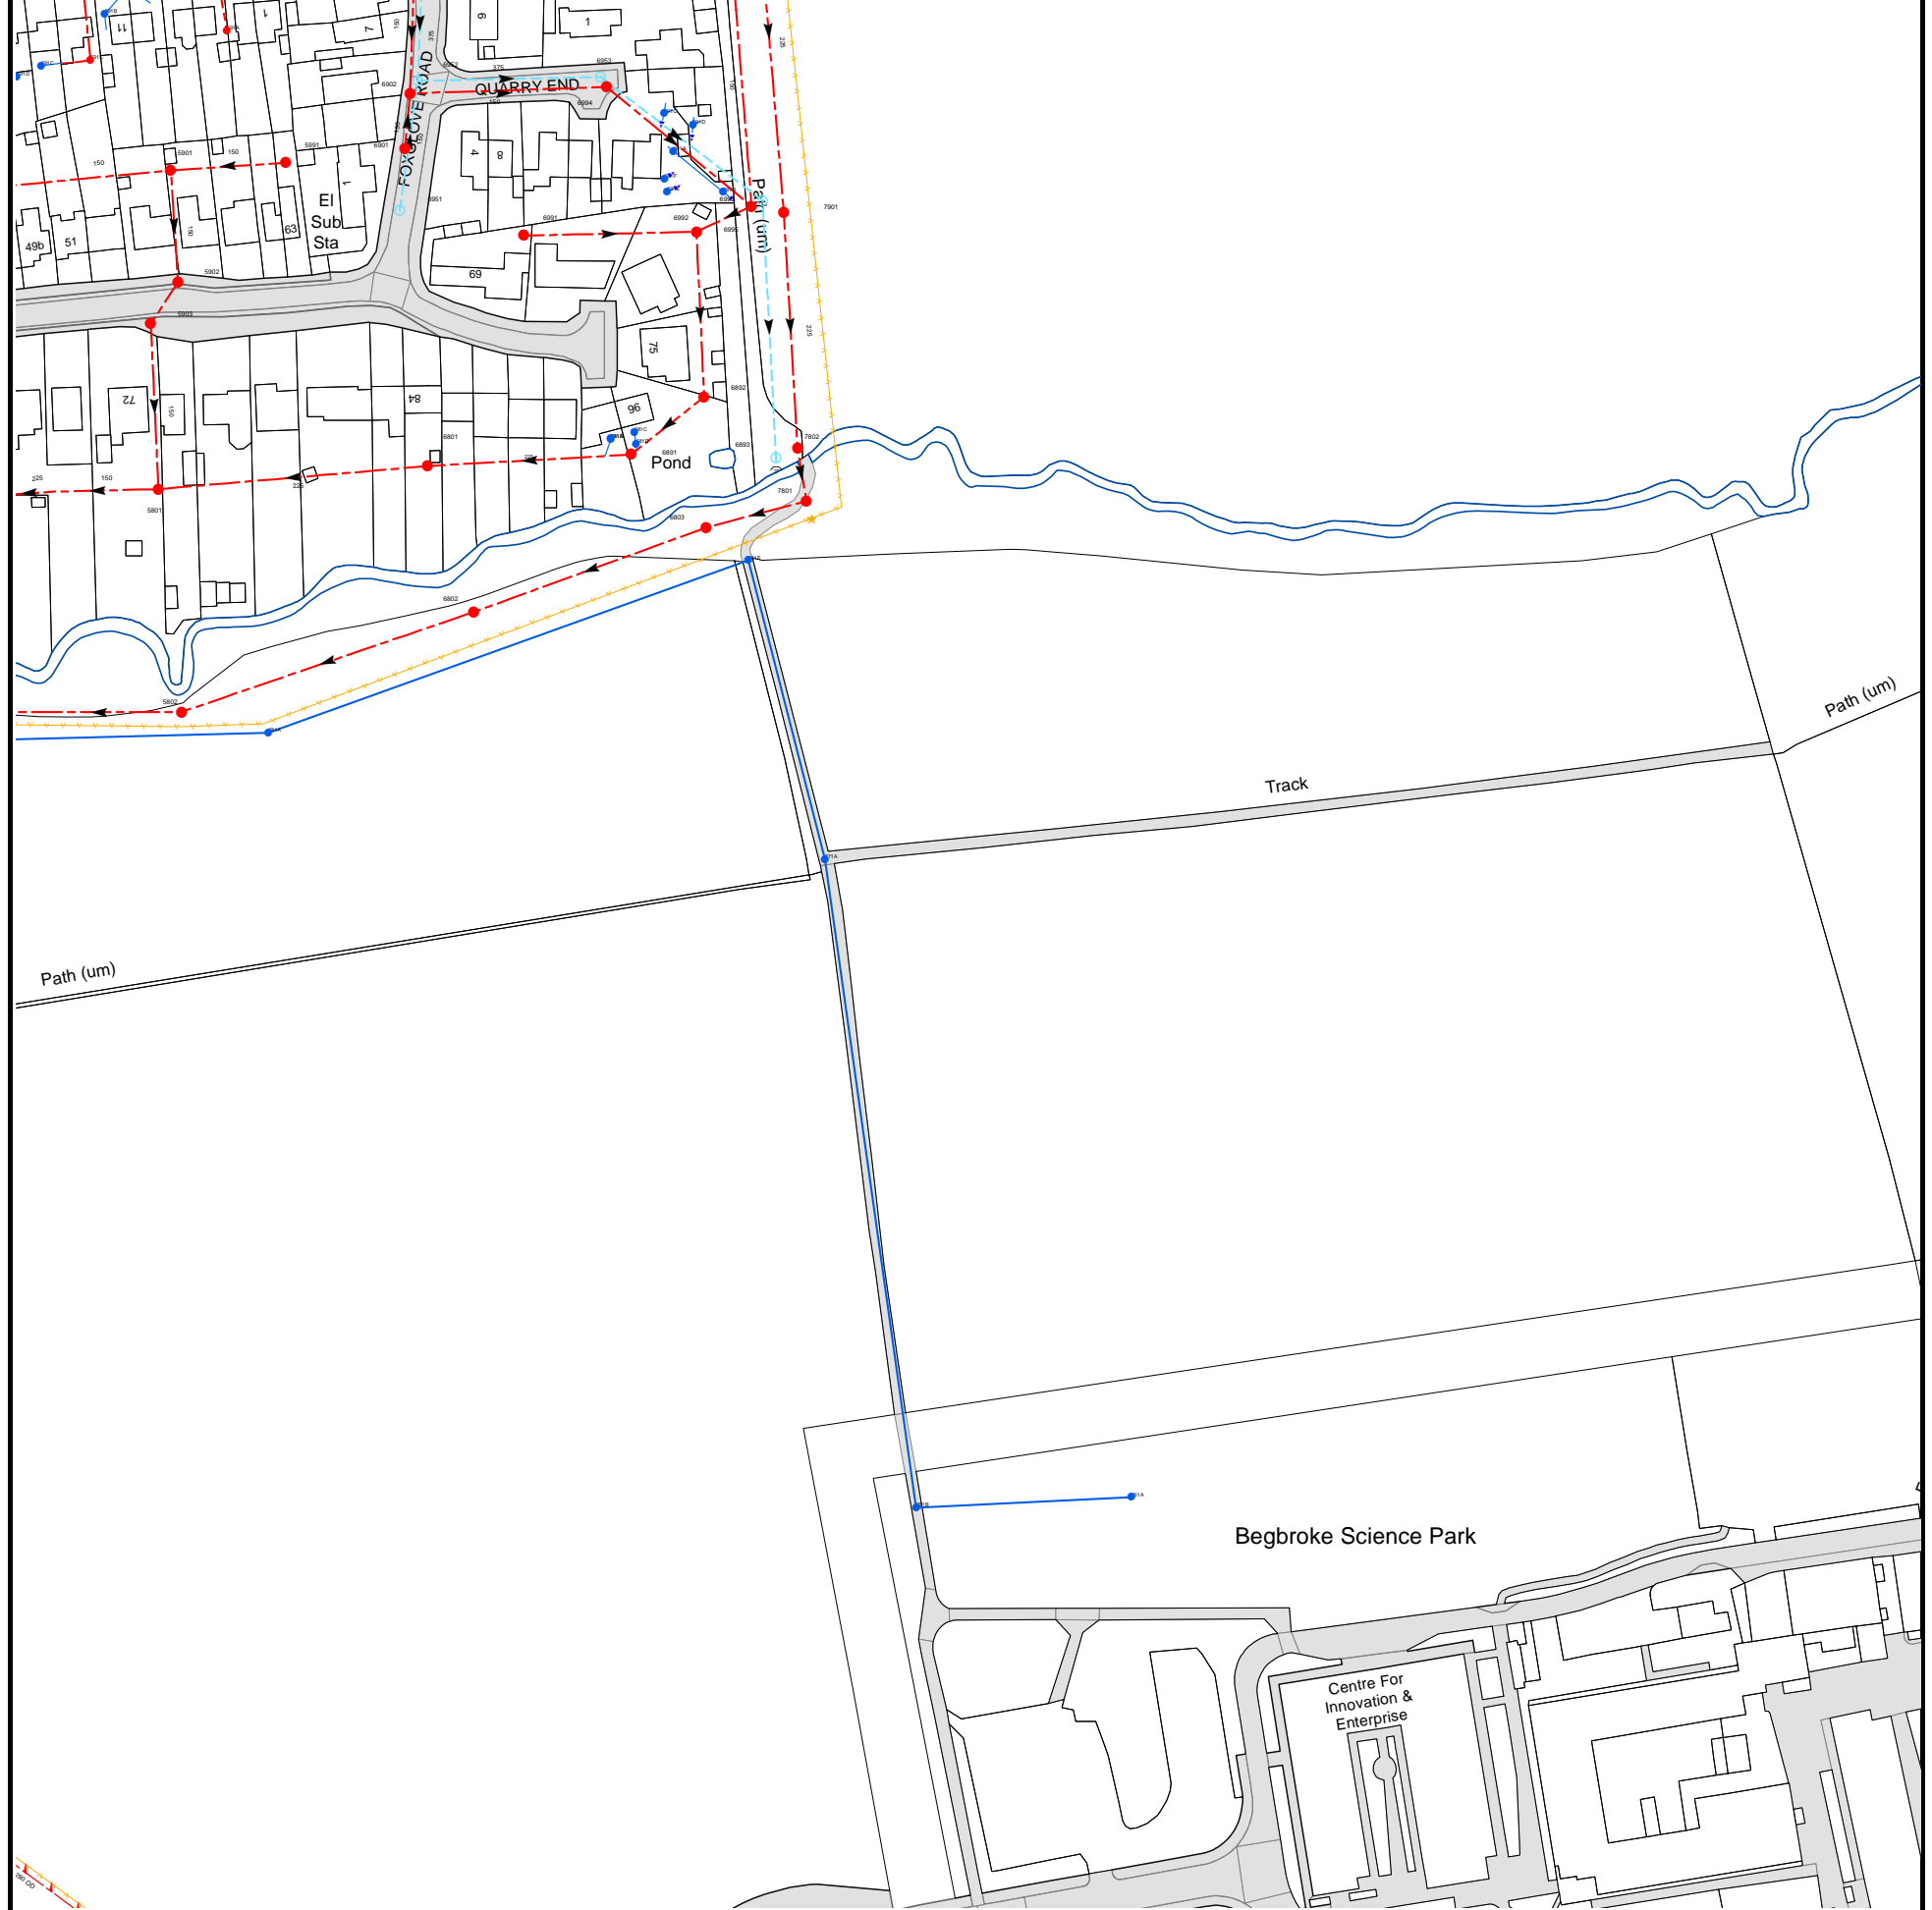

The width of the displayed area is 500m and the centre of the map is located at OS coordinates 447750,213750

The position of the apparatus shown on this plan is given without obligation and warranty, and the accuracy cannot be guaranteed. Service pipes are not shown but their presence should be anticipated. No liability of any kind whatsoever is accepted by Thames Water for any error or omission. The actual position of mains and services must be verified and established on site before any works are undertaken.

Based on the Ordnance Survey Map (2020) with the Sanction of the controller of H.M. Stationery Office, License no. 100019345 Crown Copyright Reserved.

NB. Levels quoted in metres Ordnance Newlyn Datum. The value -9999.00 indicates that no survey information is available

Manhole Reference	Manhole Cover Level	Manhole Invert Level
691D	n/a	n/a
6992	n/a	n/a
6892	n/a	n/a
6803	n/a	n/a
691B	n/a	n/a
681E	n/a	n/a
6993	n/a	n/a
6995	n/a	n/a
6893	n/a	n/a
7901	n/a	n/a
7802	n/a	n/a
7801	n/a	n/a
771A	n/a	n/a
6951	66.57	65.16
6901	66.94	65.85
6902	67.35	65.66
6952	67.44	64.77
6801	64.76	63.83
6802	n/a	n/a
6991	n/a	n/a
6953	n/a	n/a
6994	n/a	n/a
681A	n/a	n/a
681B	n/a	n/a
6891	n/a	n/a
681C	n/a	n/a
681D	n/a	n/a
691C	n/a	n/a
691F	n/a	n/a
691E	n/a	n/a
691A	n/a	n/a
581A	n/a	n/a
5802	n/a	n/a
5801	65.12	63.33
5903	66.2	64.4
5902	65.97	64.58
5901	66.31	64.99
5991	67.35	65.66
591A	n/a	n/a
591B	n/a	n/a
591D	n/a	n/a
591C	n/a	n/a
591E	n/a	n/a
761B	n/a	n/a
761A	n/a	n/a

The position of the apparatus shown on this plan is given without obligation and warranty, and the accuracy cannot be guaranteed. Service pipes are not shown but their presence should be anticipated. No liability of any kind whatsoever is accepted by Thames Water for any error or omission. The actual position of mains and services must be verified and established on site before any works are undertaken.



The width of the displayed area is 500m and the centre of the map is located at OS coordinates 447750,214250


The position of the apparatus shown on this plan is given without obligation and warranty, and the accuracy cannot be guaranteed. Service pipes are not shown but their presence should be anticipated. No liability of any kind whatsoever is accepted by Thames Water for any error or omission. The actual position of mains and services must be verified and established on site before any works are undertaken.

Based on the Ordnance Survey Map (2020) with the Sanction of the controller of H.M. Stationery Office, License no. 100019345 Crown Copyright Reserved.

NB. Levels quoted in metres Ordnance Newlyn Datum. The value -9999.00 indicates that no survey information is available

Manhole Reference	Manhole Cover Level	Manhole Invert Level
6051	67.85	65.46
6056	67.65	66.55
6058	n/a	n/a
501E	n/a	n/a
501D	n/a	n/a
5004	67.68	66.01
6053	67.8	64.99
6001	67.66	65.9
6054	67.63	64.92
6002	67.91	66.3
6052	67.93	65.37
6003	67.89	66.53
501G	n/a	n/a
501A	n/a	n/a
5053	67.52	65.47
5052	67.55	65.44
5001	67.44	66.45
501F	n/a	n/a
5002	67.61	66.44
5051	67.85	65.25
5003	67.84	66.32
501J	n/a	n/a
501L	n/a	n/a
501K	n/a	n/a
501B	n/a	n/a
501C	n/a	n/a
501I	n/a	n/a

The position of the apparatus shown on this plan is given without obligation and warranty, and the accuracy cannot be guaranteed. Service pipes are not shown but their presence should be anticipated. No liability of any kind whatsoever is accepted by Thames Water for any error or omission. The actual position of mains and services must be verified and established on site before any works are undertaken.

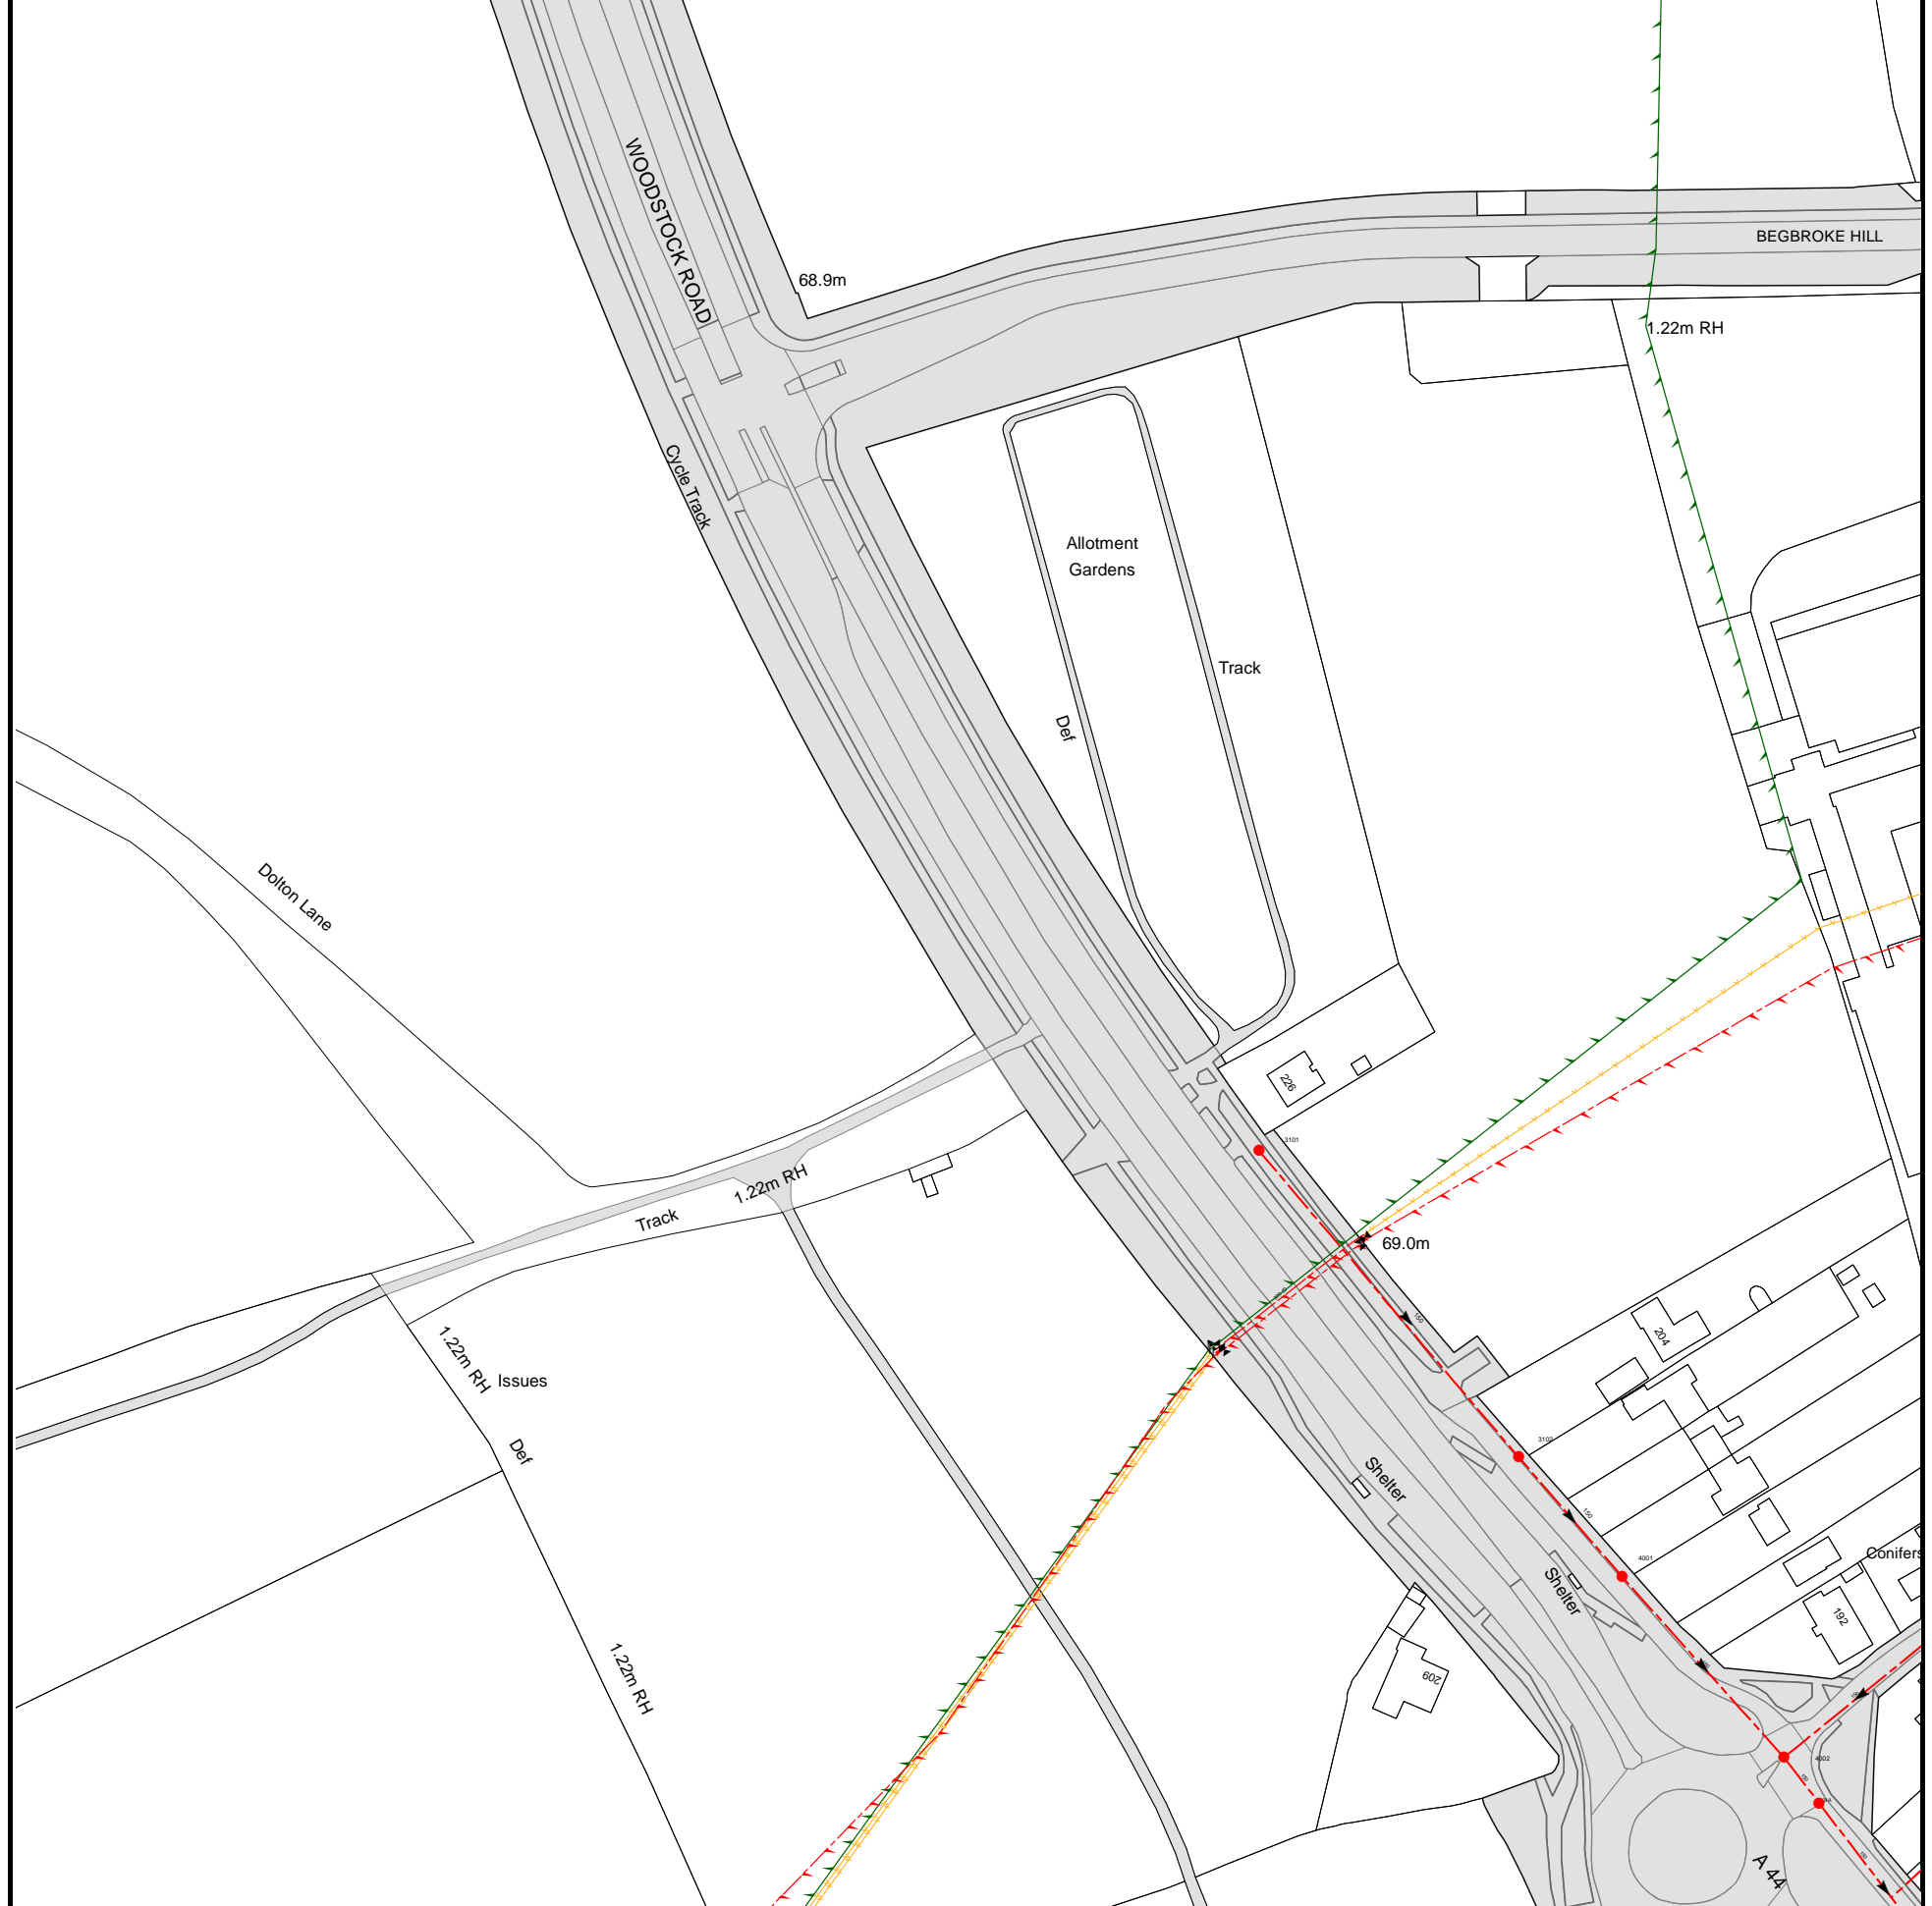


The width of the displayed area is 500m and the centre of the map is located at OS coordinates 447250,213250
The position of the apparatus shown on this plan is given without obligation and warranty, and the accuracy cannot be guaranteed. Service pipes are not shown but their presence should be anticipated. No liability of any kind whatsoever is accepted by Thames Water for any error or omission. The actual position of mains and services must be verified and established on site before any works are undertaken.

Based on the Ordnance Survey Map (2020) with the Sanction of the controller of H.M. Stationery Office, License no. 100019345 Crown Copyright Reserved.

NB. Levels quoted in metres Ordnance Newlyn Datum. The value -9999.00 indicates that no survey information is available

Manhole Reference	Manhole Cover Level	Manhole Invert Level
3101	68.95	67.61
401B	n/a	n/a
401A	n/a	n/a
4002	68.18	64.64
4001	68.08	65.95
3102	68.29	66.37

The position of the apparatus shown on this plan is given without obligation and warranty, and the accuracy cannot be guaranteed. Service pipes are not shown but their presence should be anticipated. No liability of any kind whatsoever is accepted by Thames Water for any error or omission. The actual position of mains and services must be verified and established on site before any works are undertaken.

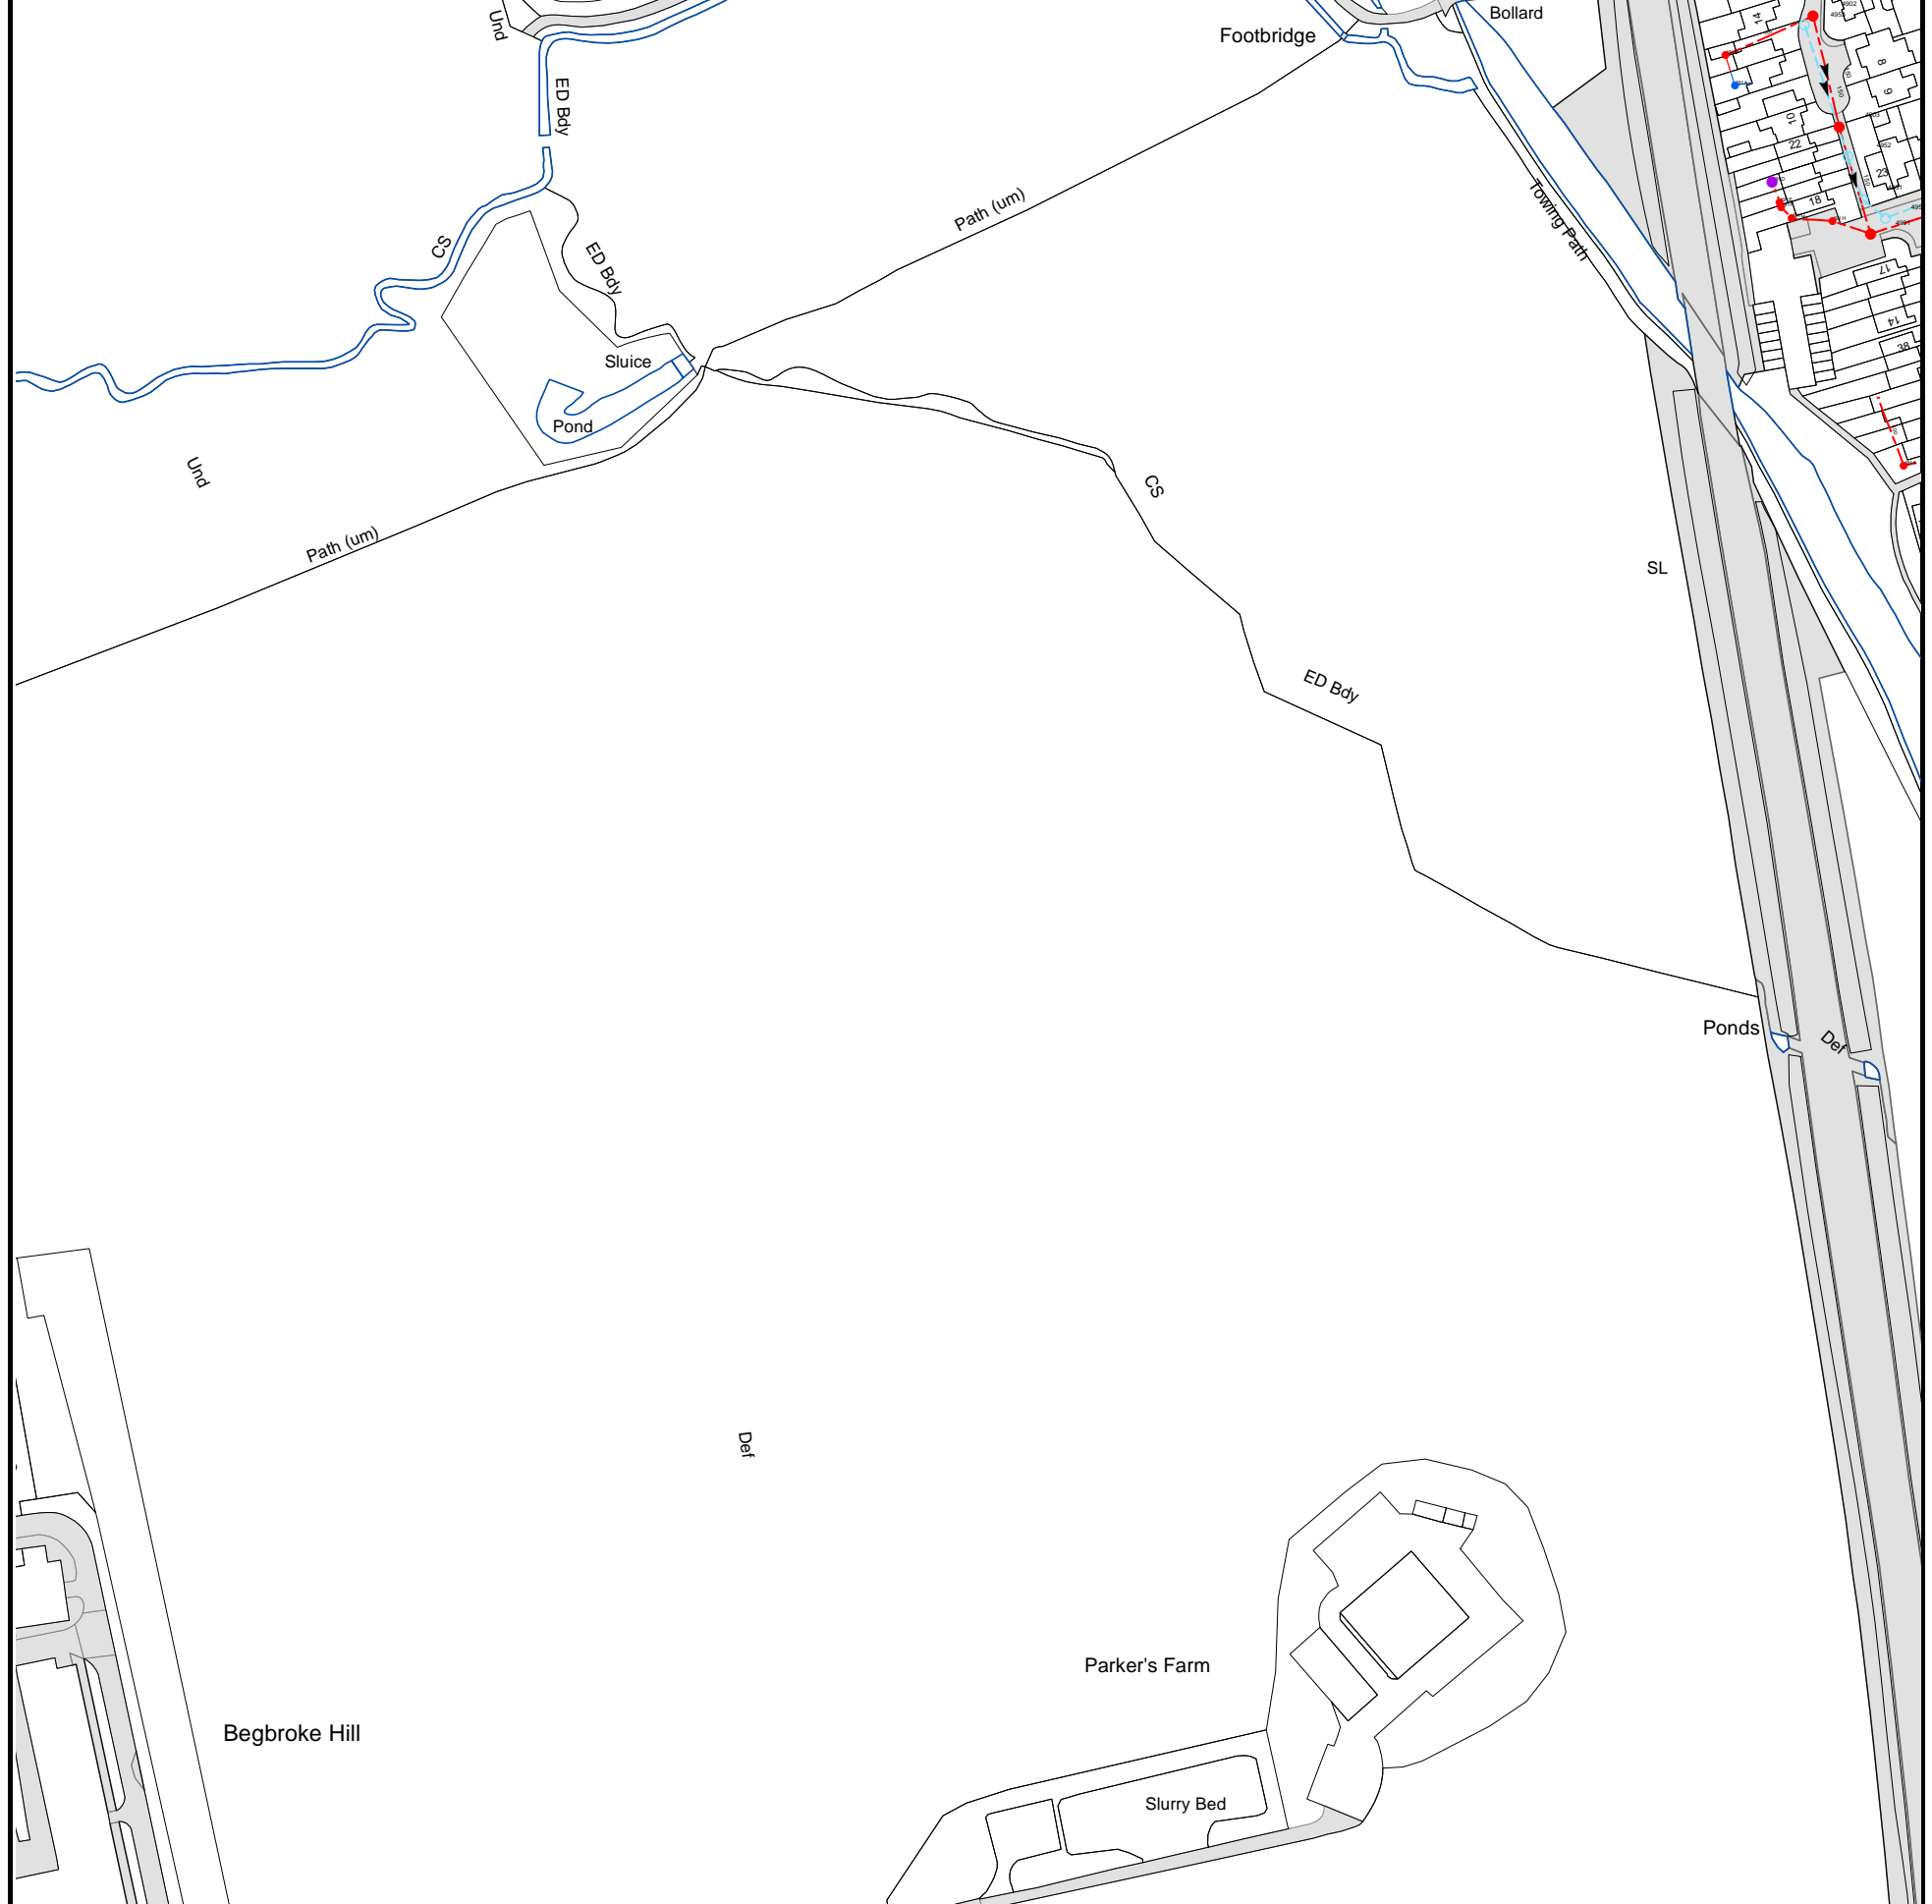


The width of the displayed area is 500m and the centre of the map is located at OS coordinates 448250,213750
The position of the apparatus shown on this plan is given without obligation and warranty, and the accuracy cannot be guaranteed. Service pipes are not shown but their presence should be anticipated. No liability of any kind whatsoever is accepted by Thames Water for any error or omission. The actual position of mains and services must be verified and established on site before any works are undertaken.

Based on the Ordnance Survey Map (2020) with the Sanction of the controller of H.M. Stationery Office, License no. 100019345 Crown Copyright Reserved.

NB. Levels quoted in metres Ordnance Newlyn Datum. The value -9999.00 indicates that no survey information is available

Manhole Reference	Manhole Cover Level	Manhole Invert Level
481A	n/a	n/a
4901	62.8	60.78
491H	n/a	n/a
491G	n/a	n/a
4950	62.8	61.1
491F	n/a	n/a
491E	n/a	n/a
4951	63.03	61.56
491D	n/a	n/a
4952	63.32	61.66
4903	63.36	61.61
491A	n/a	n/a
4953	64.03	62.59
4902	64.06	62.42
491B	n/a	n/a

The position of the apparatus shown on this plan is given without obligation and warranty, and the accuracy cannot be guaranteed. Service pipes are not shown but their presence should be anticipated. No liability of any kind whatsoever is accepted by Thames Water for any error or omission. The actual position of mains and services must be verified and established on site before any works are undertaken.

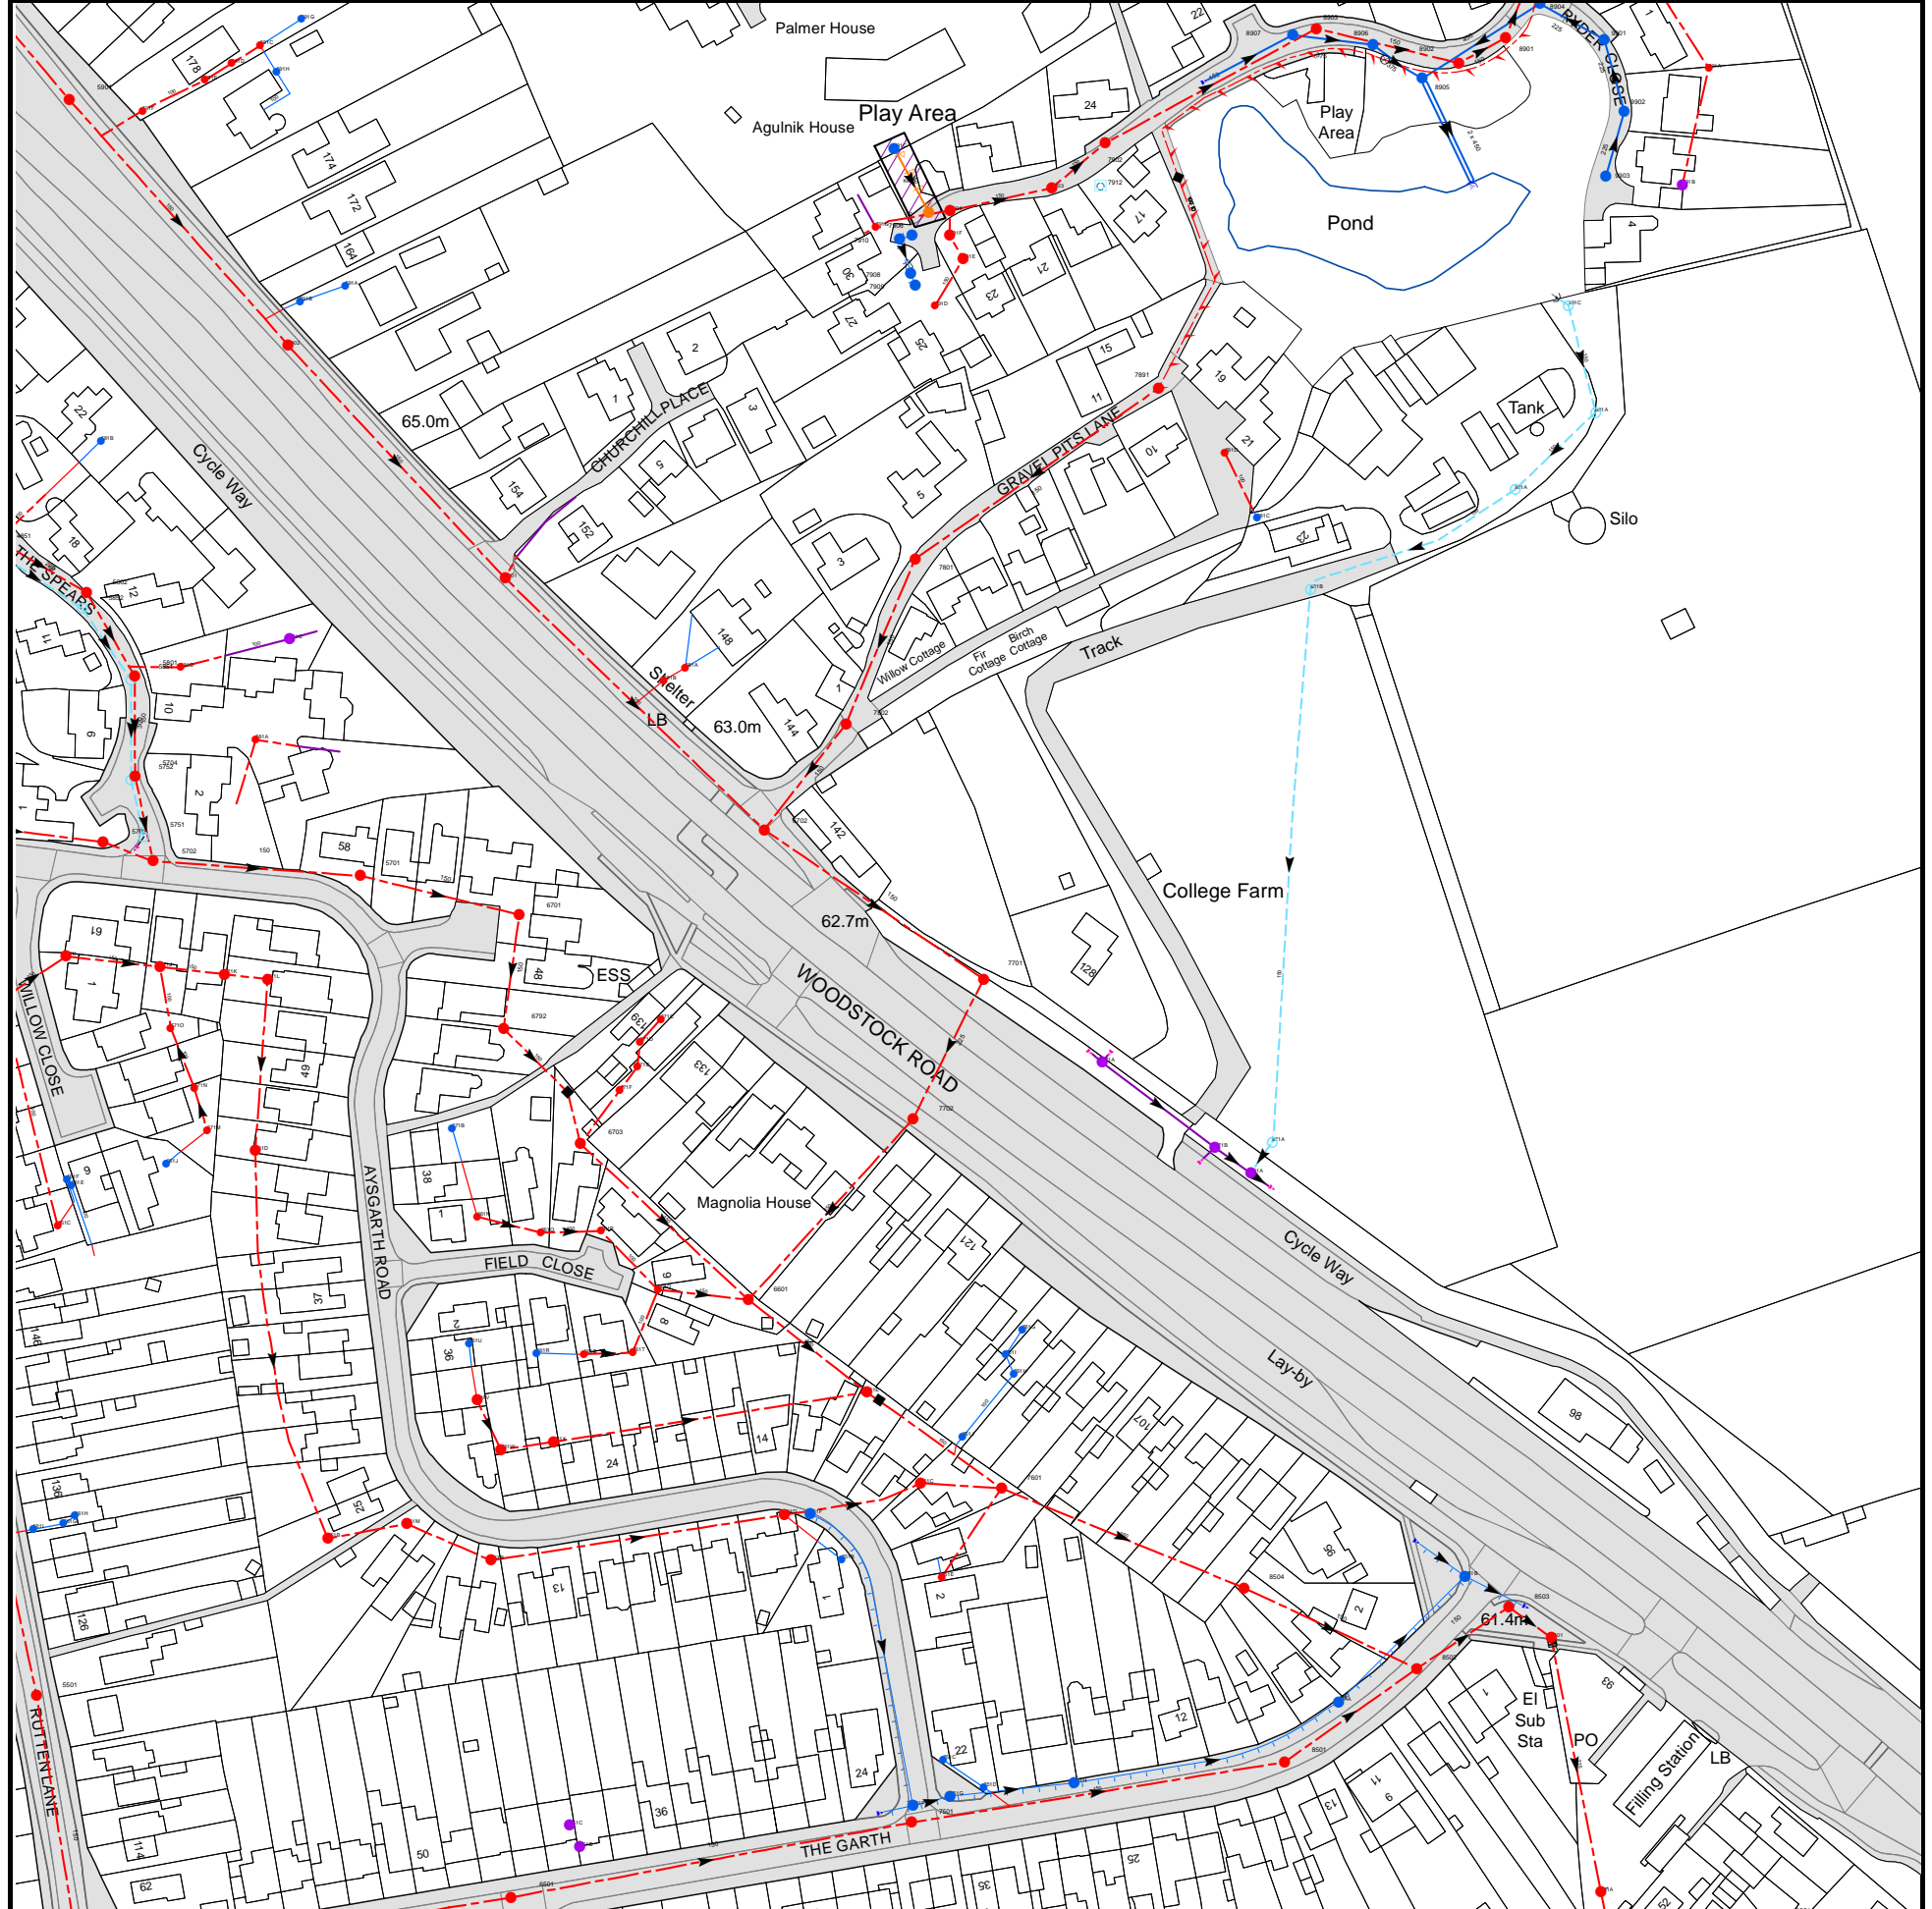

The width of the displayed area is 500m and the centre of the map is located at OS coordinates 447750,212750

The position of the apparatus shown on this plan is given without obligation and warranty, and the accuracy cannot be guaranteed. Service pipes are not shown but their presence should be anticipated. No liability of any kind whatsoever is accepted by Thames Water for any error or omission. The actual position of mains and services must be verified and established on site before any works are undertaken.

Based on the Ordnance Survey Map (2020) with the Sanction of the controller of H.M. Stationery Office, License no. 100019345 Crown Copyright Reserved.

NB. Levels quoted in metres Ordnance Newlyn Datum. The value -9999.00 indicates that no survey information is available

Manhole Reference	Manhole Cover Level	Manhole Invert Level
9902	65.84	64.43
8905	65.6	63.86
991A	n/a	n/a
8902	65.55	62.62
8906	65.35	64.05
9901	65.6	64.12
8901	65.63	62.06
8907	65.55	64.3
8903	n/a	n/a
8904	65.76	63.97
5902	65.75	63.25
591B	n/a	n/a
591A	n/a	n/a
591F	n/a	n/a
5901	67.32	63.89
591E	n/a	n/a
591H	n/a	n/a
591D	n/a	n/a
591C	n/a	n/a
591G	n/a	n/a
7702	62.65	60.76
771A	n/a	n/a
7701	62.48	61.03
881B	62.01	58.93
7801	64.71	63.02
881C	n/a	n/a
881A	n/a	n/a
881D	n/a	n/a
981A	66.77	63.67
7891	n/a	n/a
791D	n/a	n/a
991C	n/a	n/a
7909	n/a	64.34
7908	n/a	64.36
791E	n/a	n/a
7910	n/a	n/a
791F	n/a	n/a
7906	n/a	n/a
791G	n/a	n/a
n/a	n/a	n/a
7904	66.15	63.7
7903	66.8	63.17
7912	n/a	n/a
991B	n/a	n/a
9903	66	64.56
791C	n/a	n/a
7902	67.15	63.02
561C	n/a	n/a
571I	n/a	n/a
561F	n/a	n/a
561E	n/a	n/a
5852	67.12	65.78
5802	67.18	65.61
581B	n/a	n/a
5703	66.03	64.63
5851	66.43	65.31
5752	65.95	65.1
5801	66.39	64.91
5704	65.94	64.57
5751	65.79	64.87
5702	65.69	64.35
571J	n/a	n/a
561J	n/a	n/a
571O	n/a	n/a
581D	n/a	n/a
571N	n/a	n/a
571M	n/a	n/a
571K	n/a	n/a
561D	n/a	n/a
581A	n/a	n/a
571L	n/a	n/a
581C	n/a	n/a
5701	64.93	63.92
671B	n/a	n/a
661N	n/a	n/a
6792	n/a	n/a
6801	64.25	62.58
6701	64.78	63.41
661O	n/a	n/a
6703	62.81	59.52
661P	n/a	n/a
671F	n/a	n/a
671E	n/a	n/a
671D	n/a	n/a
661Q	n/a	n/a
671C	n/a	n/a
681B	n/a	n/a
681A	n/a	n/a
6702	63.09	61.49
7802	63.63	62.12

Manhole Reference	Manhole Cover Level	Manhole Invert Level
8501	61.39	59.29
751C	n/a	n/a
851A	n/a	n/a
8502	61.46	59.01
9501	61.34	58.78
8503	61.4	58.87
8504	61.43	59.38
751E	n/a	n/a
851B	n/a	n/a
7601	61.66	59.45
761C	n/a	n/a
761J	n/a	n/a
761H	n/a	n/a
761I	n/a	n/a
761G	n/a	n/a
861A	61.77	60.96
871B	n/a	n/a
871A	61.9	60.73
7501	61.62	59.94
751F	n/a	n/a
751G	n/a	n/a
751D	n/a	n/a
751H	n/a	n/a
951A	n/a	n/a
561I	n/a	n/a
5501	64.79	63.15
561G	n/a	n/a
561H	n/a	n/a
551B	n/a	n/a
661M	n/a	n/a
661U	n/a	n/a
661V	n/a	n/a
651B	n/a	n/a
661W	n/a	n/a
6501	61.87	60.23
661R	n/a	n/a
661X	n/a	n/a
651C	n/a	n/a
651D	n/a	n/a
661S	n/a	n/a
661T	n/a	n/a
6601	62.31	59.75
761D	n/a	n/a
761F	n/a	n/a
751B	n/a	n/a
761E	n/a	n/a

The position of the apparatus shown on this plan is given without obligation and warranty, and the accuracy cannot be guaranteed. Service pipes are not shown but their presence should be anticipated. No liability of any kind whatsoever is accepted by Thames Water for any error or omission. The actual position of mains and services must be verified and established on site before any works are undertaken.




The width of the displayed area is 500m and the centre of the map is located at OS coordinates 448750,213250
The position of the apparatus shown on this plan is given without obligation and warranty, and the accuracy cannot be guaranteed. Service pipes are not shown but their presence should be anticipated. No liability of any kind whatsoever is accepted by Thames Water for any error or omission. The actual position of mains and services must be verified and established on site before any works are undertaken.

Based on the Ordnance Survey Map (2020) with the Sanction of the controller of H.M. Stationery Office, License no. 100019345 Crown Copyright Reserved.

NB. Levels quoted in metres Ordnance Newlyn Datum. The value -9999.00 indicates that no survey information is available

Manhole Reference	Manhole Cover Level	Manhole Invert Level
7450	62.32	61.37
9406	62.22	58.61
9407	62.15	58.52
9456	62.05	59.51
9457	61.93	60.3
8452	62.27	61.09
9454	62.34	60
8403	62.27	60.5
9405	62.31	58.93
9455	62.35	59.82
8410	62.29	59.07
7401	62.45	60.79
7451	62.46	60.99
8408	62.24	59.94
8457	62.22	60.45
8409	62.17	59.52
841C	n/a	n/a
8456	62.19	60.7
8407	62.25	60.35
841B	n/a	n/a
841A	n/a	n/a
8453	62.39	61.01
8404	62.39	60.75
8454	62.31	60.92
8455	62.23	60.87
8405	62.32	60.43
8406	62.19	60.04
8402	62.38	59.54
8451	62.44	60.77
8450	62.39	60.13
8401	62.47	59.31
931A	n/a	n/a
9301	62	60.43
9350	61.96	60.79
931B	n/a	n/a
9401	61.87	59.83
9450	61.86	60.42
9402	61.9	60
9451	61.91	60.56
9452	62.04	60.65
9403	62.04	60.16
9404	62.11	60.36
9453	62.11	60.81
941A	n/a	n/a
941B	n/a	n/a

The position of the apparatus shown on this plan is given without obligation and warranty, and the accuracy cannot be guaranteed. Service pipes are not shown but their presence should be anticipated. No liability of any kind whatsoever is accepted by Thames Water for any error or omission. The actual position of mains and services must be verified and established on site before any works are undertaken.

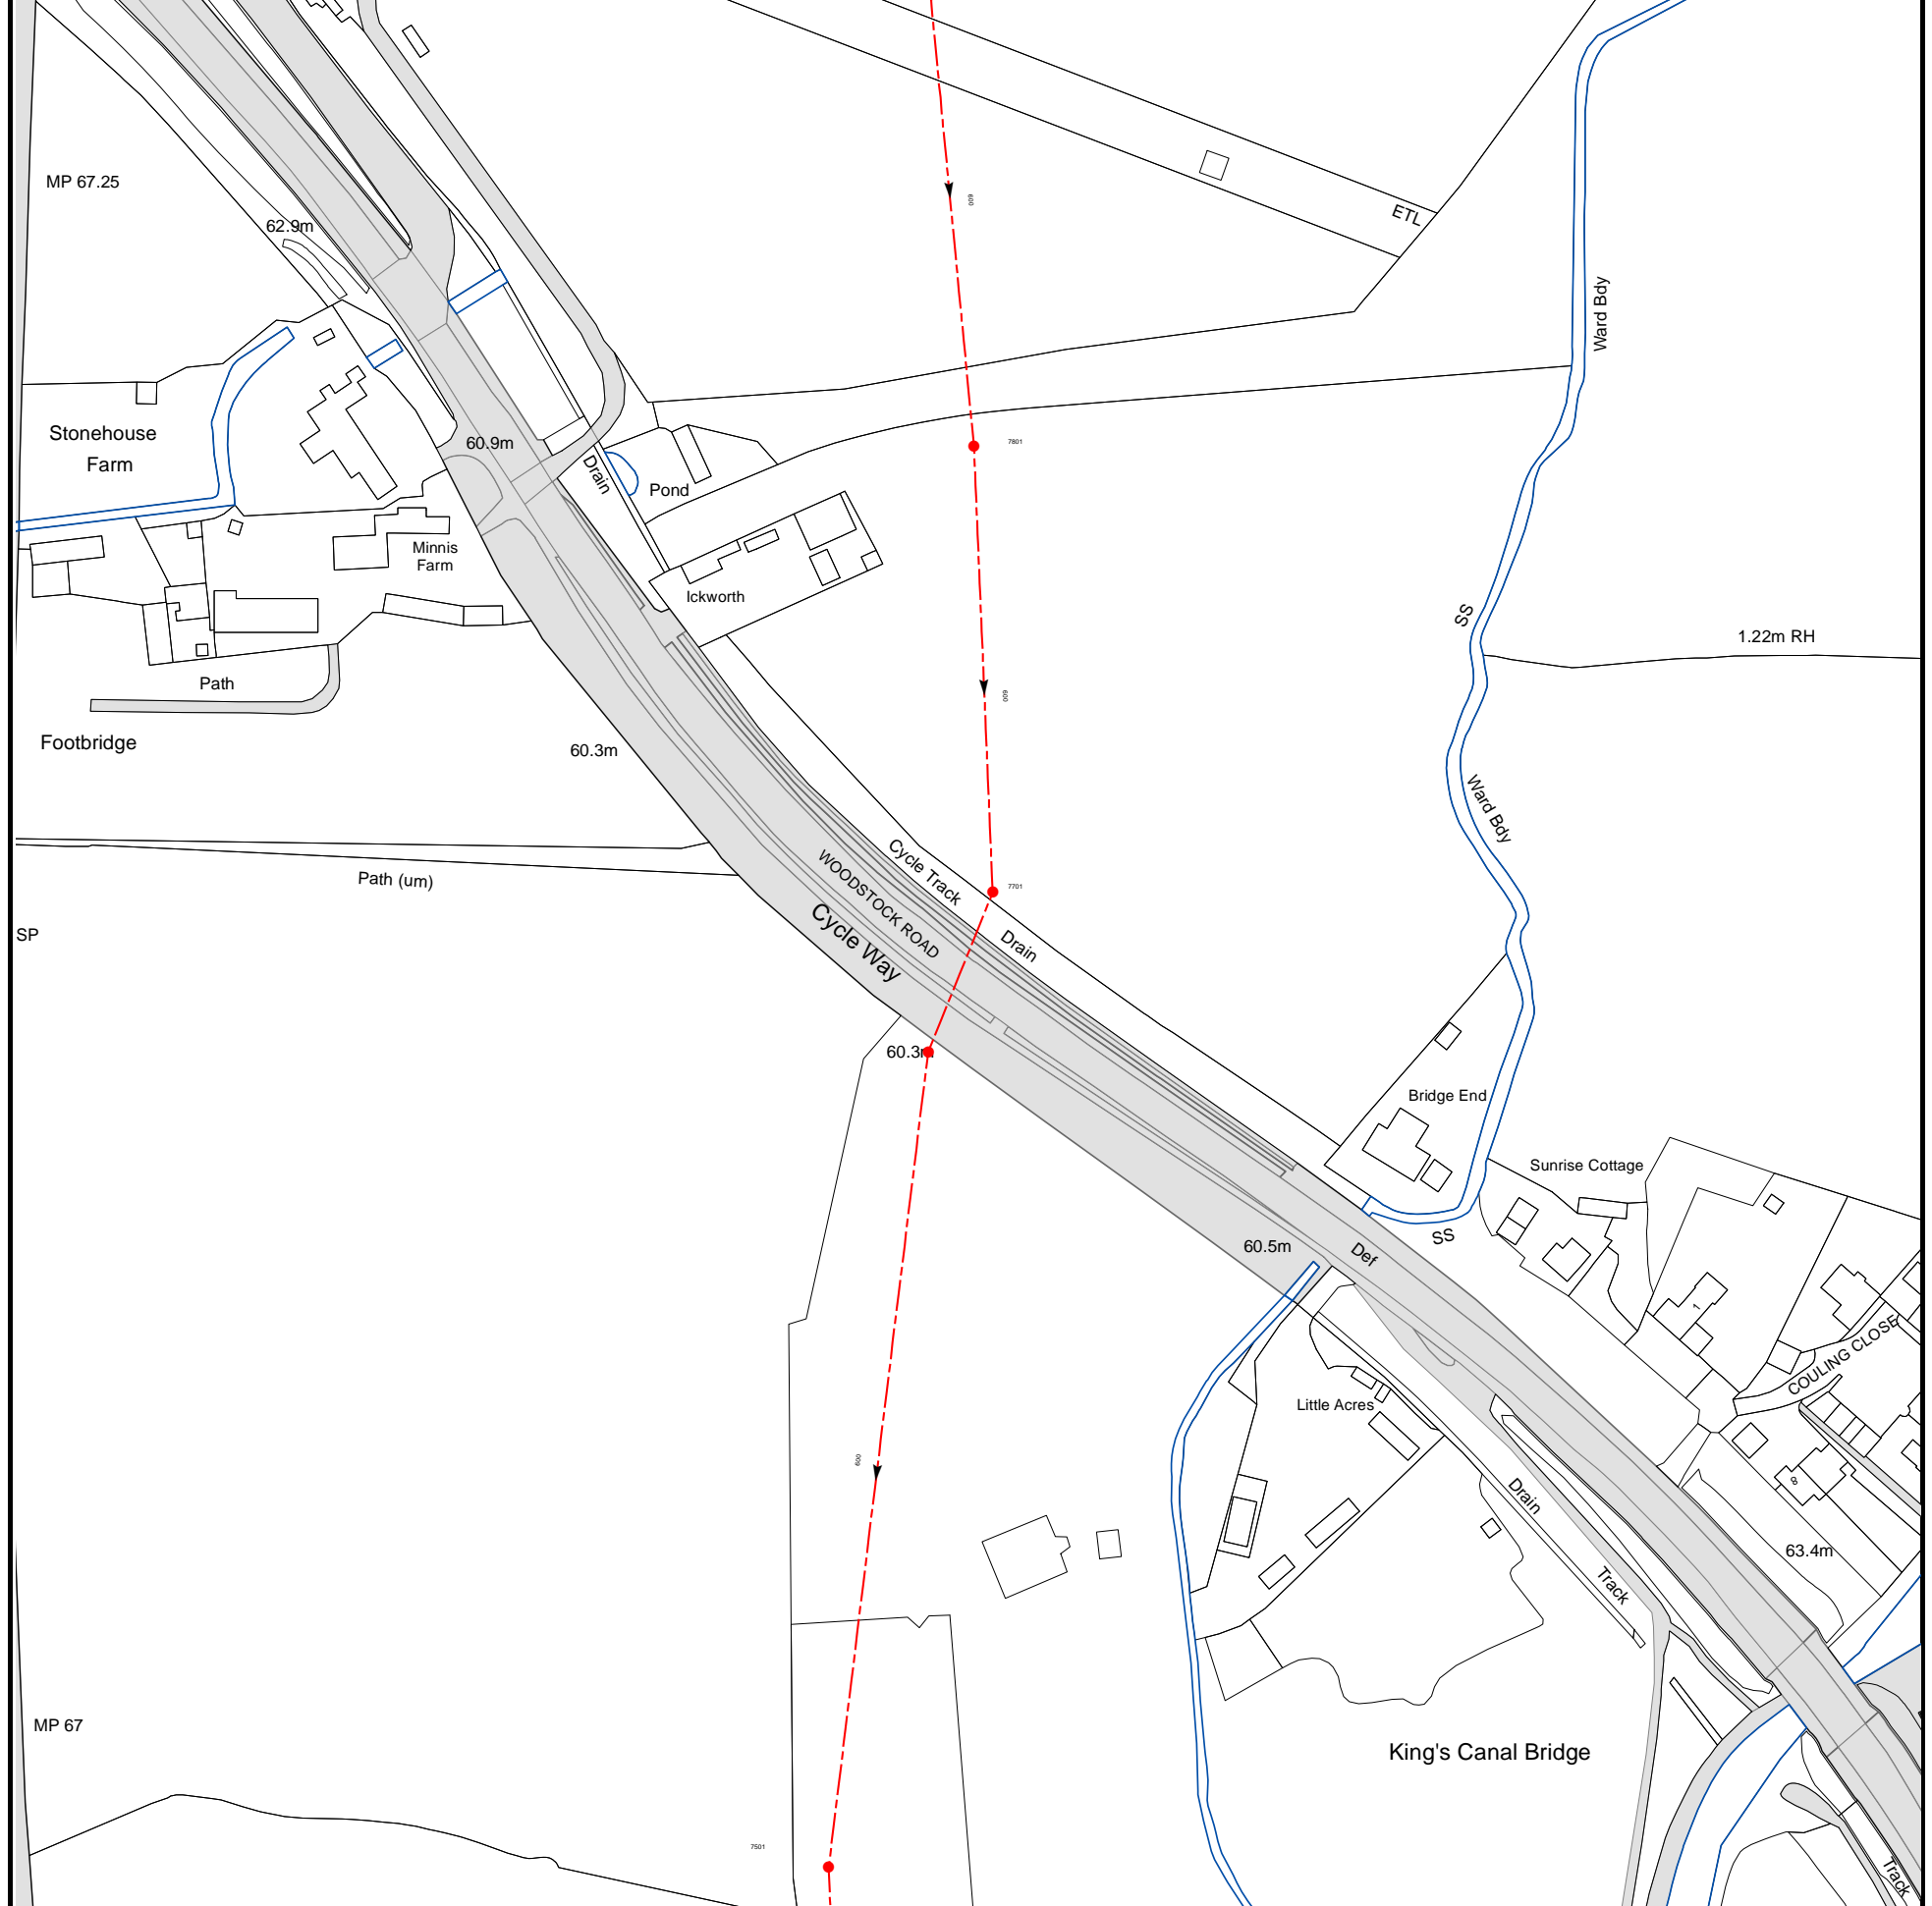

The width of the displayed area is 500m and the centre of the map is located at OS coordinates 448750,211750


The position of the apparatus shown on this plan is given without obligation and warranty, and the accuracy cannot be guaranteed. Service pipes are not shown but their presence should be anticipated. No liability of any kind whatsoever is accepted by Thames Water for any error or omission. The actual position of mains and services must be verified and established on site before any works are undertaken.

Based on the Ordnance Survey Map (2020) with the Sanction of the controller of H.M. Stationery Office, License no. 100019345 Crown Copyright Reserved.

NB. Levels quoted in metres Ordnance Newlyn Datum. The value -9999.00 indicates that no survey information is available

Manhole Reference	Manhole Cover Level	Manhole Invert Level
7501	59.3	56.47
7702	59.29	56.87
7701	59.28	57
7801	59.42	57.21

The position of the apparatus shown on this plan is given without obligation and warranty, and the accuracy cannot be guaranteed. Service pipes are not shown but their presence should be anticipated. No liability of any kind whatsoever is accepted by Thames Water for any error or omission. The actual position of mains and services must be verified and established on site before any works are undertaken.

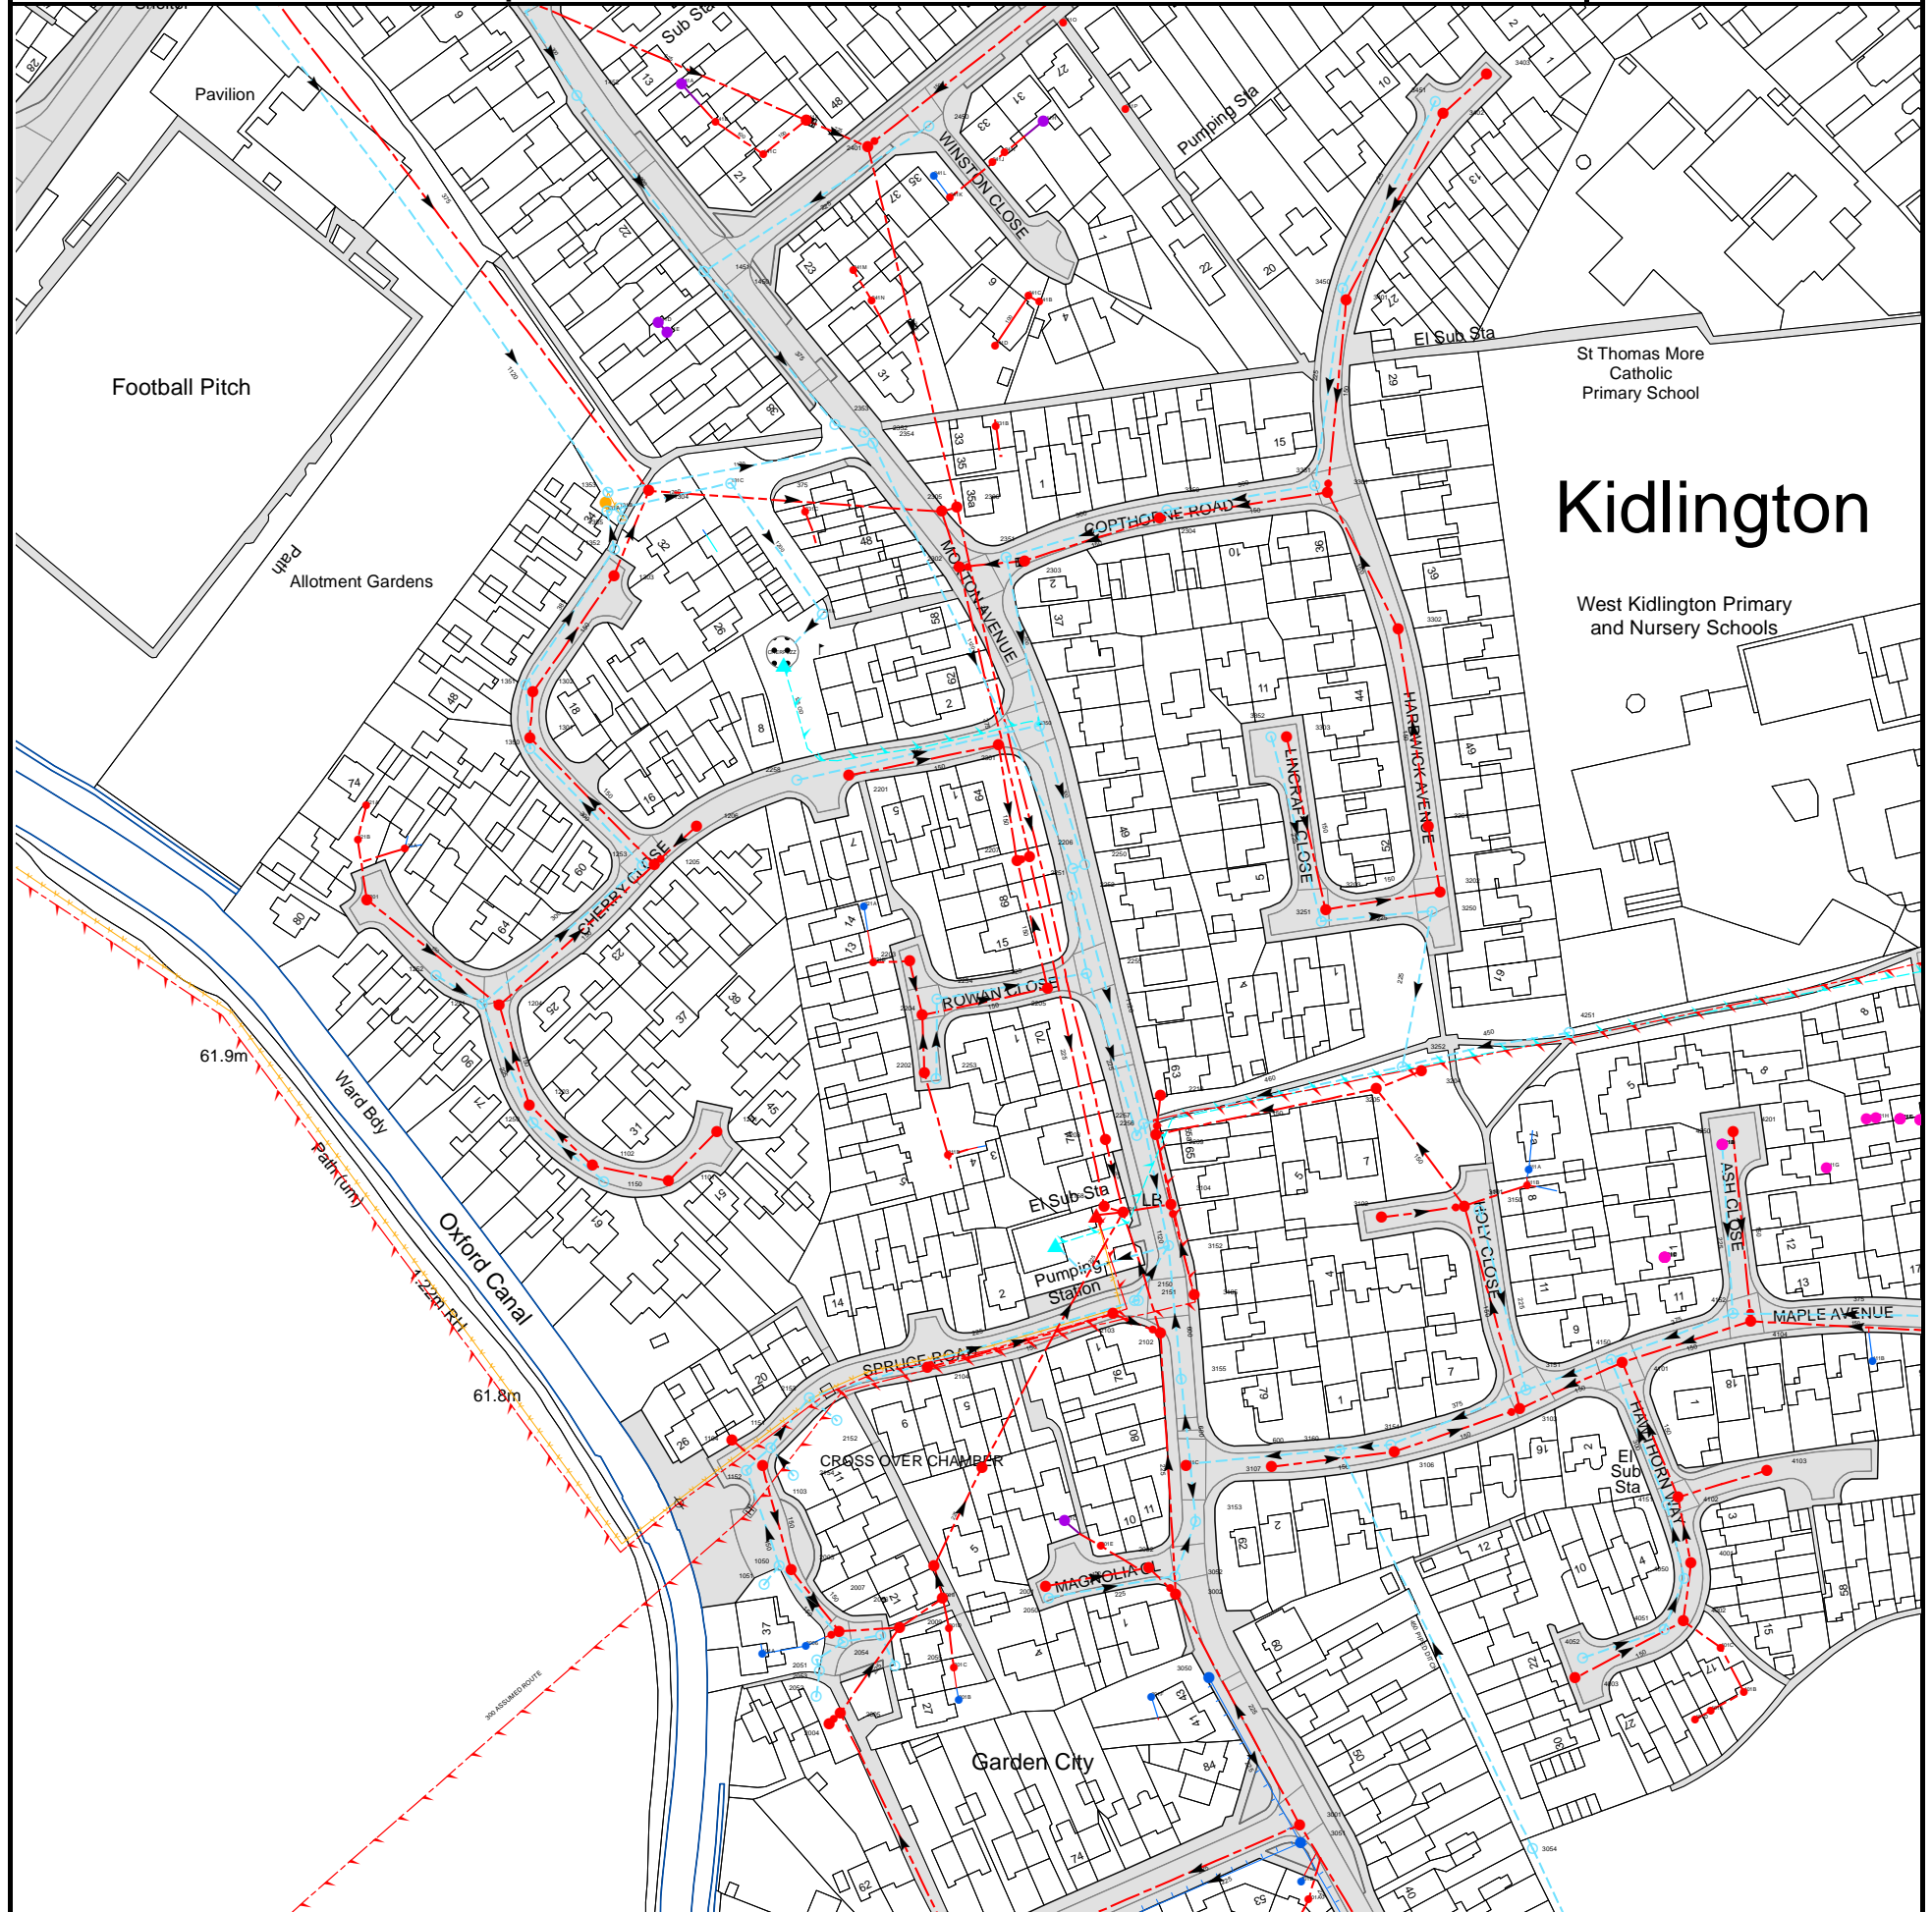

The width of the displayed area is 500m and the centre of the map is located at OS coordinates 449250,213250
The position of the apparatus shown on this plan is given without obligation and warranty, and the accuracy cannot be guaranteed. Service pipes are not shown but their presence should be anticipated. No liability of any kind whatsoever is accepted by Thames Water for any error or omission. The actual position of mains and services must be verified and established on site before any works are undertaken.

Based on the Ordnance Survey Map (2020) with the Sanction of the controller of H.M. Stationery Office, License no. 100019345 Crown Copyright Reserved.

NB. Levels quoted in metres Ordnance Newlyn Datum. The value -9999.00 indicates that no survey information is available

Manhole Reference	Manhole Cover Level	Manhole Invert Level
241A	n/a	n/a
241M	n/a	n/a
2401	61.23	57.14
2450	61.46	60.13
241L	n/a	n/a
241K	n/a	n/a
241J	n/a	n/a
241I	n/a	n/a
241C	n/a	n/a
241H	n/a	n/a
241O	n/a	n/a
241P	n/a	n/a
3450	61.66	60.67
3401	61.67	60.04
3451	62.01	61.08
3402	62.04	60.44
3403	62.1	60.58
1304	61.17	57.07
131C	61.22	58.33
141E	n/a	n/a
141D	n/a	n/a
1450	61.54	59.9
1451	61.32	59.9
141C	n/a	n/a
141B	n/a	n/a
1452	61.62	59.94
141A	n/a	n/a
1503	n/a	n/a
1150	61.35	60.57
1101	61.44	59.9
1102	61.35	59.71
1201	61.55	60.06
1250	61.19	60.41
1203	61.2	59.35
1204	61.21	59.13
1251	61.23	60.23
1252	61.39	60.37
0201	61.25	59.82
1253	61.05	59.93
1205	60.98	58.47
121A	n/a	n/a
021B	n/a	n/a
1206	60.89	59.66
021A	n/a	n/a
2258	61.02	60.12
1350	60.63	59.76
1301	60.68	58
1302	60.77	57.91
1351	60.76	59.7
1303	60.97	57.53
1352	61.9	59.37
1355	61.14	59.33
231C	n/a	n/a
131A	61.19	59.32
131B	61.3	58.5
1353	61.17	58.47
1104	61.9	60.19
1152	61.63	60.61
101A	n/a	n/a
1103	61.65	60.09
1051	61.85	61.03
1151	61.45	60.53
1050	61.79	60.81
2003	61.76	59.67
2154	61.71	60.61
2006	61.85	60.92
2052	61.86	61.06
2051	61.85	61.13
2053	61.94	61.04
2004	61.69	60.45
2007	61.89	59.38
2005	61.73	56.64
2054	61.91	60.93
2056	61.87	60.9
2055	61.85	61.02
2009	61.95	56.57
201A	n/a	n/a
2008	61.74	56.49
201D	n/a	n/a
201C	n/a	n/a
421B	n/a	n/a
4152	61.22	59.48
4201	61.59	59.93
4104	61.25	58.33
411G	n/a	n/a
421C	n/a	n/a
411B	n/a	n/a
421H	n/a	n/a
421E	n/a	n/a
421G	n/a	n/a

Manhole Reference	Manhole Cover Level	Manhole Invert Level
421F	n/a	n/a
421J	n/a	n/a
421I	n/a	n/a
3104	61.99	56.88
3155	61.7	58.56
3105	61.96	60.01
3251	61.25	60.01
3203	61.35	59.97
3205	62.03	57.24
3102	61.66	59.44
3252	62.1	59.6
3204	62.11	58.83
3250	61.61	59.75
3202	61.54	59.78
3101	61.6	57.45
3150	61.57	59.73
3103	61.26	57.71
3151	61.3	59.14
311B	n/a	n/a
311A	n/a	n/a
4251	61.83	59.75
4150	61.24	59.35
4101	61.19	57.86
411D	n/a	n/a
411C	n/a	n/a
411E	n/a	n/a
411F	n/a	n/a
4250	61.56	60.01
421D	n/a	n/a
421A	n/a	n/a
301A	n/a	n/a
301B	n/a	n/a
3054	n/a	n/a
3051	60.98	60
3001	60.96	56.87
401D	n/a	n/a
201B	n/a	n/a
211A	n/a	n/a
2001	60.9	59.56
2050	60.89	59.76
211C	n/a	n/a
201E	n/a	n/a
2002	61.13	59.26
201F	n/a	n/a
3052	61.19	59.59
3002	61.24	56.88
311C	n/a	n/a
3153	61.4	58.53
3050	61.08	60.42
3107	61.3	59.88
3160	n/a	n/a
3154	61.04	58.77
3106	61.05	59.54
4003	60.75	59.32
4052	60.82	59.91
4051	61.01	59.75
4151	61.18	59.53
4102	61.25	58.8
4002	60.99	59.02
4050	61.05	59.64
4001	61.09	58.93
401A	n/a	n/a
401C	n/a	n/a
401B	n/a	n/a
4103	61.3	59.79
2250	61.25	59.41
2207	61.4	58.72
2206	61.41	56.69
3201	61.41	59.68
2201	61.14	59.61
2301	61.34	59.28
3303	61.43	60.38
3352	61.47	60.25
2350	61.53	59.6
3302	61.42	59.19
231A	61.13	58.03
2302	61.29	56.86
2303	61.3	58.18
2351	61.22	59.92
2304	61.58	58.54
2305	61.45	56.97
3350	61.56	60.1
2306	61.47	56.91
3301	61.4	58.86
3351	61.43	60.34
2354	61.51	58.46
2352	61.53	59.61
231B	n/a	n/a
2353	61.54	59.63
241D	n/a	n/a
241B	n/a	n/a
241N	n/a	n/a
2153	61.19	60.45

Manhole Reference	Manhole Cover Level	Manhole Invert Level
2152	61.32	60.46
221A	n/a	n/a
221B	n/a	n/a
2203	61.06	59.69
2204	61	59.55
2202	60.93	59.69
2104	61.28	59.58
2253	60.96	57.19
2254	61.06	59.63
211B	n/a	n/a
2205	61.27	59.22
2252	61.35	59.71
2251	61.32	58.43
2255	61.56	59.45
2158	n/a	n/a
2208	61.99	56.45
2103	61.61	59.17
2101	61.94	56.5
2150	61.75	59.34
2256	61.83	59.15
2151	61.25	60.29
2257	61.87	58.25
2209	61.97	56.99
2102	61.83	56.71
2210	61.98	58.97
3152	61.91	58.29

The position of the apparatus shown on this plan is given without obligation and warranty, and the accuracy cannot be guaranteed. Service pipes are not shown but their presence should be anticipated. No liability of any kind whatsoever is accepted by Thames Water for any error or omission. The actual position of mains and services must be verified and established on site before any works are undertaken.



The width of the displayed area is 500m and the centre of the map is located at OS coordinates 449250,212250

The position of the apparatus shown on this plan is given without obligation and warranty, and the accuracy cannot be guaranteed. Service pipes are not shown but their presence should be anticipated. No liability of any kind whatsoever is accepted by Thames Water for any error or omission. The actual position of mains and services must be verified and established on site before any works are undertaken.

Based on the Ordnance Survey Map (2020) with the Sanction of the controller of H.M. Stationery Office, License no. 100019345 Crown Copyright Reserved.

NB. Levels quoted in metres Ordnance Newlyn Datum. The value -9999.00 indicates that no survey information is available

Manhole Reference	Manhole Cover Level	Manhole Invert Level
2401	n/a	n/a

The position of the apparatus shown on this plan is given without obligation and warranty, and the accuracy cannot be guaranteed. Service pipes are not shown but their presence should be anticipated. No liability of any kind whatsoever is accepted by Thames Water for any error or omission. The actual position of mains and services must be verified and established on site before any works are undertaken.



The width of the displayed area is 500m and the centre of the map is located at OS coordinates 448750,214250
 The position of the apparatus shown on this plan is given without obligation and warranty, and the accuracy cannot be guaranteed. Service pipes are not shown but their presence should be anticipated. No liability of any kind whatsoever is accepted by Thames Water for any error or omission. The actual position of mains and services must be verified and established on site before any works are undertaken.

Based on the Ordnance Survey Map (2020) with the Sanction of the controller of H.M. Stationery Office, License no. 100019345 Crown Copyright Reserved.

NB. Levels quoted in metres Ordnance Newlyn Datum. The value -9999.00 indicates that no survey information is available


Manhole Reference	Manhole Cover Level	Manhole Invert Level
9001	62.82	59.75
9002	62.77	n/a
9051	62.99	n/a
9003	63.05	n/a
911C	n/a	n/a
9150	63.36	62.43
911B	n/a	n/a
911A	n/a	n/a
9250	64.23	63.28
921A	n/a	n/a
9251	65.09	63.53
9202	65.12	63.19
9201	65.21	63.28
9312	65.29	63.61
8405	66.15	64.91
8404	66.18	64.94
8418	66.26	65.17
8417	66.41	65.25
8416	66.41	65.42
8401	66.41	65.5
9402	66.62	65.91
9403	66.63	65.69
9401	66.01	65.5
9404	66.6	65.16
9405	66.54	65.02
8403	66.43	65.69
9050	63.06	62.5
8052	63.1	62.33
8003	63.08	61.69
8004	62.98	61.39
801A	n/a	n/a
8051	62.85	61.96
8053	63.01	62.15
7007	62.49	n/a
801D	n/a	n/a
8002	62.69	60.11
8050	62.48	61.69
8001	62.46	60.41
9311	65.64	63.8
9310	65.63	63.83
9351	65.31	63.99
7305	64.7	62.67
9309	65.68	63.92
9308	65.66	64.08
9301	65.36	63.91
8301	65.63	64.43
7353	64.84	64.01
9307	65.73	64.1
8302	65.65	64.6
9352	65.45	64.05
8303	65.67	64.78
9306	65.75	64.11
8351	65.67	64.42
8304	65.72	64.91
9305	65.94	64.34
9303	65.83	64.45
8307	65.61	64.67
9304	65.73	64.47
8352	65.36	64.31
8308	65.66	64.44
9302	65.91	64.69
8309	65.75	64.38
8310	65.69	64.27
8305	65.87	64.8
8306	66.08	64.83
701C	n/a	n/a
701D	n/a	n/a
7106	63.32	62.11
811A	n/a	n/a
8151	63.58	62.69
8101	63.58	61.7
8150	63.68	62.82
8253	63.85	62.99
8254	63.86	63.06
821D	n/a	n/a
8255	63.85	63.1
8251	63.96	63.01
821E	n/a	n/a
8202	64.18	62.59
721B	n/a	n/a
7202	64.07	63.36
8203	64.07	62.17
8252	64.01	63.46
821A	n/a	n/a
8201	64.09	62.39
821C	n/a	n/a
821B	n/a	n/a
8250	64.32	63.29
7250	64.59	63.43
8350	64.63	63.81

Manhole Reference	Manhole Cover Level	Manhole Invert Level
7302	64.34	62.65
7306	64.63	62.47
7352	64.46	63.47
7355	65.37	64.44
8311	65.82	64.5
7304	65.21	63.13
741C	n/a	n/a
8406	65.94	64.68
7401	65.85	64.03
8407	66.11	64.85
741B	n/a	n/a
741A	n/a	n/a
8408	66.11	65.02
6401	65.31	63
6454	65.52	63.84
7450	65.55	64.69
8409	66.47	65.47
6455	65.61	64.48
8411	66.44	65.71
8410	66.47	65.68
8412	66.5	65.83
6450	65.68	64.88
8413	66.68	66.05
6402	65.67	63.54
8414	66.69	66.17
641B	n/a	n/a
8415	66.76	66.31
641A	n/a	n/a
8402	66.55	65.92
6104	63.29	61.47
7104	63.44	62.22
7002	62.84	61.71
7153	63.48	61.59
7103	63.34	62.37
7152	63.36	61.74
7105	63.53	61.62
7102	63.43	62.46
7154	63.54	61.43
7001	62.94	61.8
7005	62.8	61.91
7151	63.49	61.92
7107	63.35	61.72
701B	n/a	n/a
7156	63.47	61.55
7108	63.28	61.83
711B	n/a	n/a
7003	63.1	62.09
7101	63.74	62.77
7050	63.2	61.74
7051	63.04	61.78
7155	63.18	61.76
7150	63.72	62.15
701G	n/a	n/a
701F	n/a	n/a
711A	n/a	n/a
701E	n/a	n/a
721H	n/a	n/a
621M	n/a	n/a
7203	63.89	62.95
621J	n/a	n/a
621K	n/a	1
7204	63.74	62.79
621T	n/a	n/a
7201	64	63.09
721E	n/a	n/a
621S	n/a	n/a
721F	n/a	n/a
721D	n/a	n/a
721I	n/a	n/a
721G	n/a	n/a
621R	n/a	n/a
621E	n/a	n/a
621F	n/a	n/a
621D	n/a	n/a
6253	63.8	62.9
6205	63.82	62.73
721C	n/a	n/a
731A	n/a	n/a
7301	64.53	62.88
7351	64.84	63.65
7354	65.15	64.24
7307	n/a	n/a
7303	65.49	63.4
7350	65.17	63.75
6054	62.63	61.2
6056	63.05	60.73
7054	62.35	61.27
6055	62.94	61.98
7053	62.22	61.19
7006	62.48	60.66
701A	n/a	n/a
7052	62.66	62.06
6453	65.54	64.56

Manhole Reference	Manhole Cover Level	Manhole Invert Level
6452	65.61	64.68
6451	65.78	65.11
6456	65.74	64.77
5201	64.4	62.46
5251	63.53	62.16
5250	64.41	62.61
6201	64.37	62.03
6250	64.3	62.34
6202	64.29	61.91
621N	n/a	n/a
6252	64.08	62.22
6204	64.04	61.65
621O	n/a	n/a
631F	n/a	n/a
621B	n/a	n/a
631C	n/a	n/a
621A	n/a	n/a
631B	n/a	n/a
6301	64.34	62.9
6351	64.35	63.07
621I	n/a	n/a
631A	n/a	n/a
631E	n/a	n/a
621H	n/a	n/a
6203	64.48	62.96
6251	63.91	62
631D	n/a	n/a
621L	n/a	n/a
621C	n/a	n/a
621G	n/a	n/a
5057	63.8	60.1
6057	63.41	59.84
6005	63.35	59.46
6050	63.85	60.62
6001	63.97	60.17
6051	63.98	60.74
601C	n/a	n/a
601D	n/a	n/a
5003	64.28	63.02
601B	n/a	n/a
601A	n/a	n/a
6003	63.72	60.77
5006	64.23	60.54
5053	64.17	60.77
6053	63.75	61.02
6004	63.23	61.41
6002	64.07	60.56
6052	63.97	60.82
6103	63.26	60.9
6152	63.23	61.22
611A	n/a	n/a
611E	n/a	n/a
611B	n/a	n/a
611C	n/a	n/a
611D	n/a	n/a
5150	64.41	61.18
5101	64.42	61.07
511B	n/a	n/a
6102	64.09	61.2
6151	64.07	61.47
6150	63.67	61.83
6101	63.74	61.36
501A	n/a	n/a
5064	n/a	n/a
5050	64.8	62.89
5052	64.31	62.63
5051	64.05	62.9
5055	64.11	60.25
5008	64.05	59.88
5007	63.78	59.76
5152	64.79	61.25
511J	n/a	n/a
5104	64.81	60.69
511H	n/a	n/a
5153	65.05	60.57
5062	n/a	n/a
5105	65.03	60.49
511E	n/a	n/a
511F	n/a	n/a
5054	65.19	60.45
511K	n/a	n/a
5002	65.2	60.24
5252	64.6	63.3
5103	64.62	62.99
5063	n/a	n/a
511G	n/a	n/a
5056	64.47	60.33
5009	64.43	60.09
511C	n/a	n/a
5151	64.62	60.91
511A	n/a	n/a
5005	64.74	63.65
5102	64.46	60.85

Manhole Reference	Manhole Cover Level	Manhole Invert Level
511L	n/a	n/a
5004	64.58	63.42
521E	n/a	n/a
5254	64.55	61.48
5253	64.58	62.94
5203	64.54	60.93
5202	64.61	62.66
5204	64.89	62.23
521C	n/a	n/a
521D	n/a	n/a
5255	64.88	62.34
521A	n/a	n/a
521B	n/a	n/a
5360	n/a	n/a
5350	64.77	63.33
5351	64.59	62.86
5302	64.56	62.25
5301	64.8	63.05
5352	64.77	63.09
5303	64.73	62.64
5353	65.17	63.34
5304	65.13	62.84
5354	65.22	63.45
5305	65.19	63.11
5355	66.32	63.16
5356	66.53	63.25
5306	66.55	64.8
5401	66.94	63.26
5451	66.77	63.26
5452	66.77	65.33
5453	66.42	63.58
5402	66.7	63.58
5403	66.48	63.87
5454	66.47	64
701H	n/a	n/a
701I	n/a	n/a
801E	n/a	n/a

The position of the apparatus shown on this plan is given without obligation and warranty, and the accuracy cannot be guaranteed. Service pipes are not shown but their presence should be anticipated. No liability of any kind whatsoever is accepted by Thames Water for any error or omission. The actual position of mains and services must be verified and established on site before any works are undertaken.

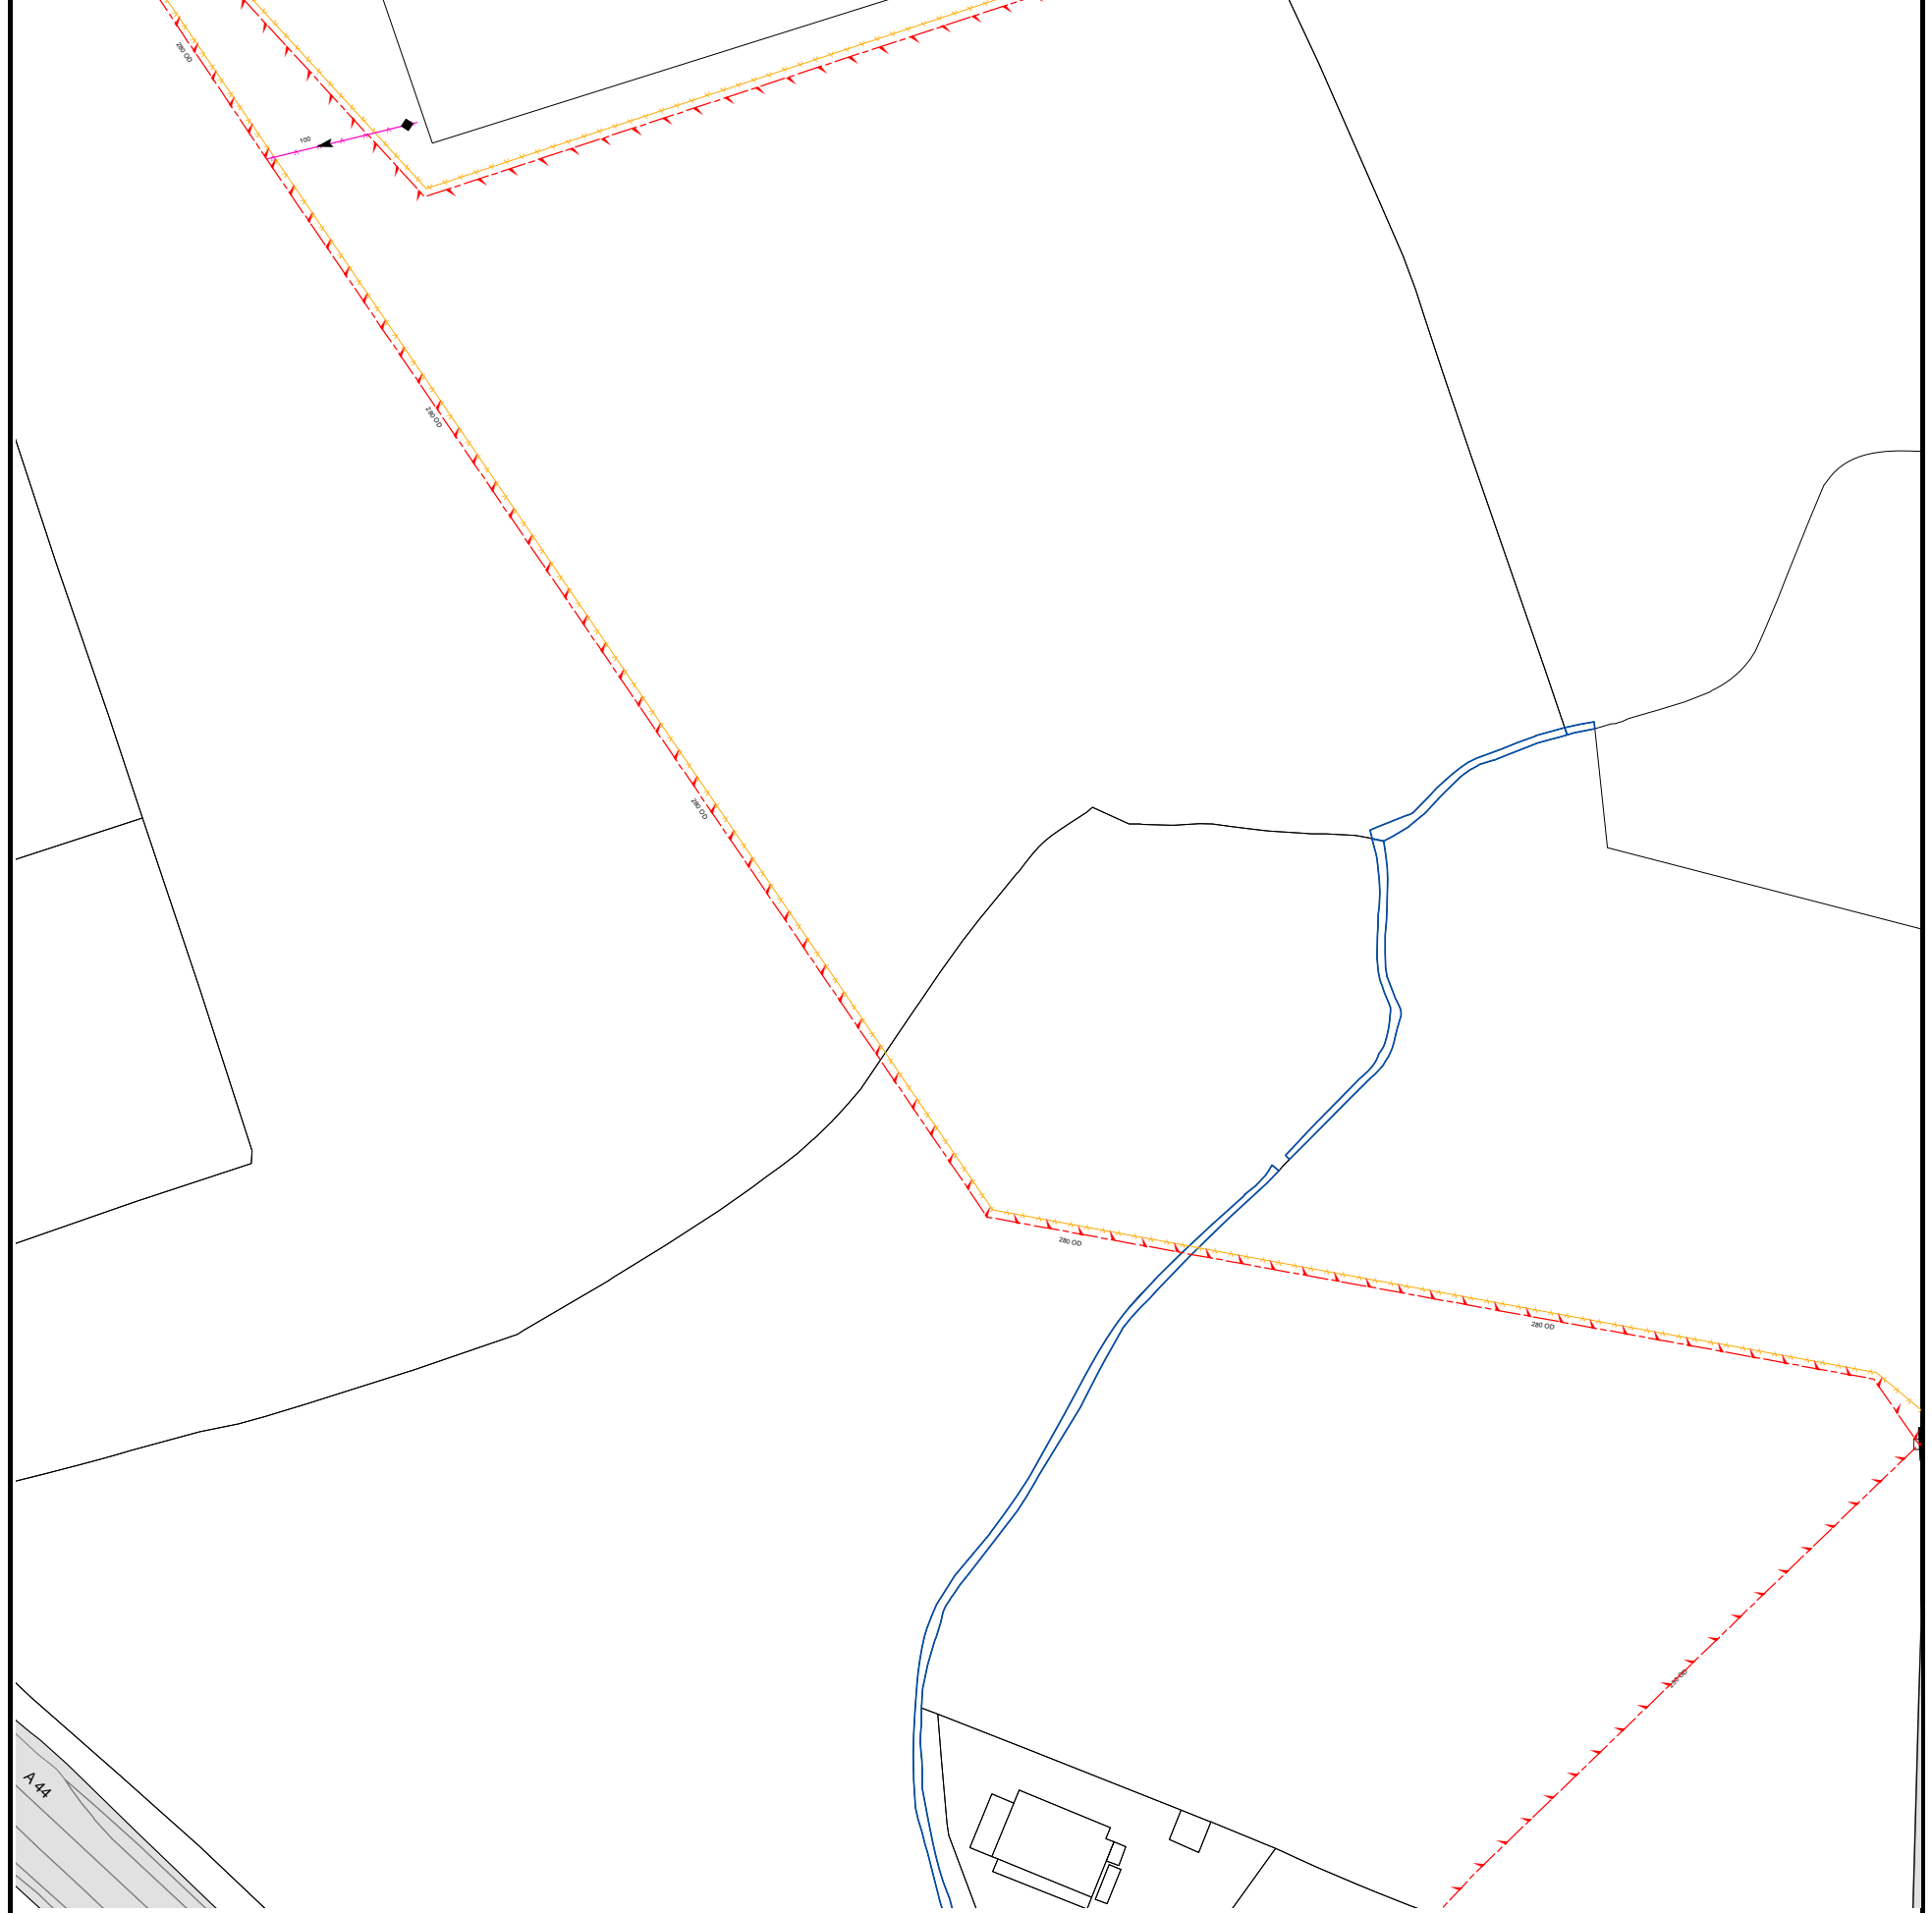

The width of the displayed area is 500m and the centre of the map is located at OS coordinates 448250,212750


The position of the apparatus shown on this plan is given without obligation and warranty, and the accuracy cannot be guaranteed. Service pipes are not shown but their presence should be anticipated. No liability of any kind whatsoever is accepted by Thames Water for any error or omission. The actual position of mains and services must be verified and established on site before any works are undertaken.

Based on the Ordnance Survey Map (2020) with the Sanction of the controller of H.M. Stationery Office, License no. 100019345 Crown Copyright Reserved.

NB. Levels quoted in metres Ordnance Newlyn Datum. The value -9999.00 indicates that no survey information is available

Manhole Reference	Manhole Cover Level	Manhole Invert Level
n/a	n/a	n/a

The position of the apparatus shown on this plan is given without obligation and warranty, and the accuracy cannot be guaranteed. Service pipes are not shown but their presence should be anticipated. No liability of any kind whatsoever is accepted by Thames Water for any error or omission. The actual position of mains and services must be verified and established on site before any works are undertaken.

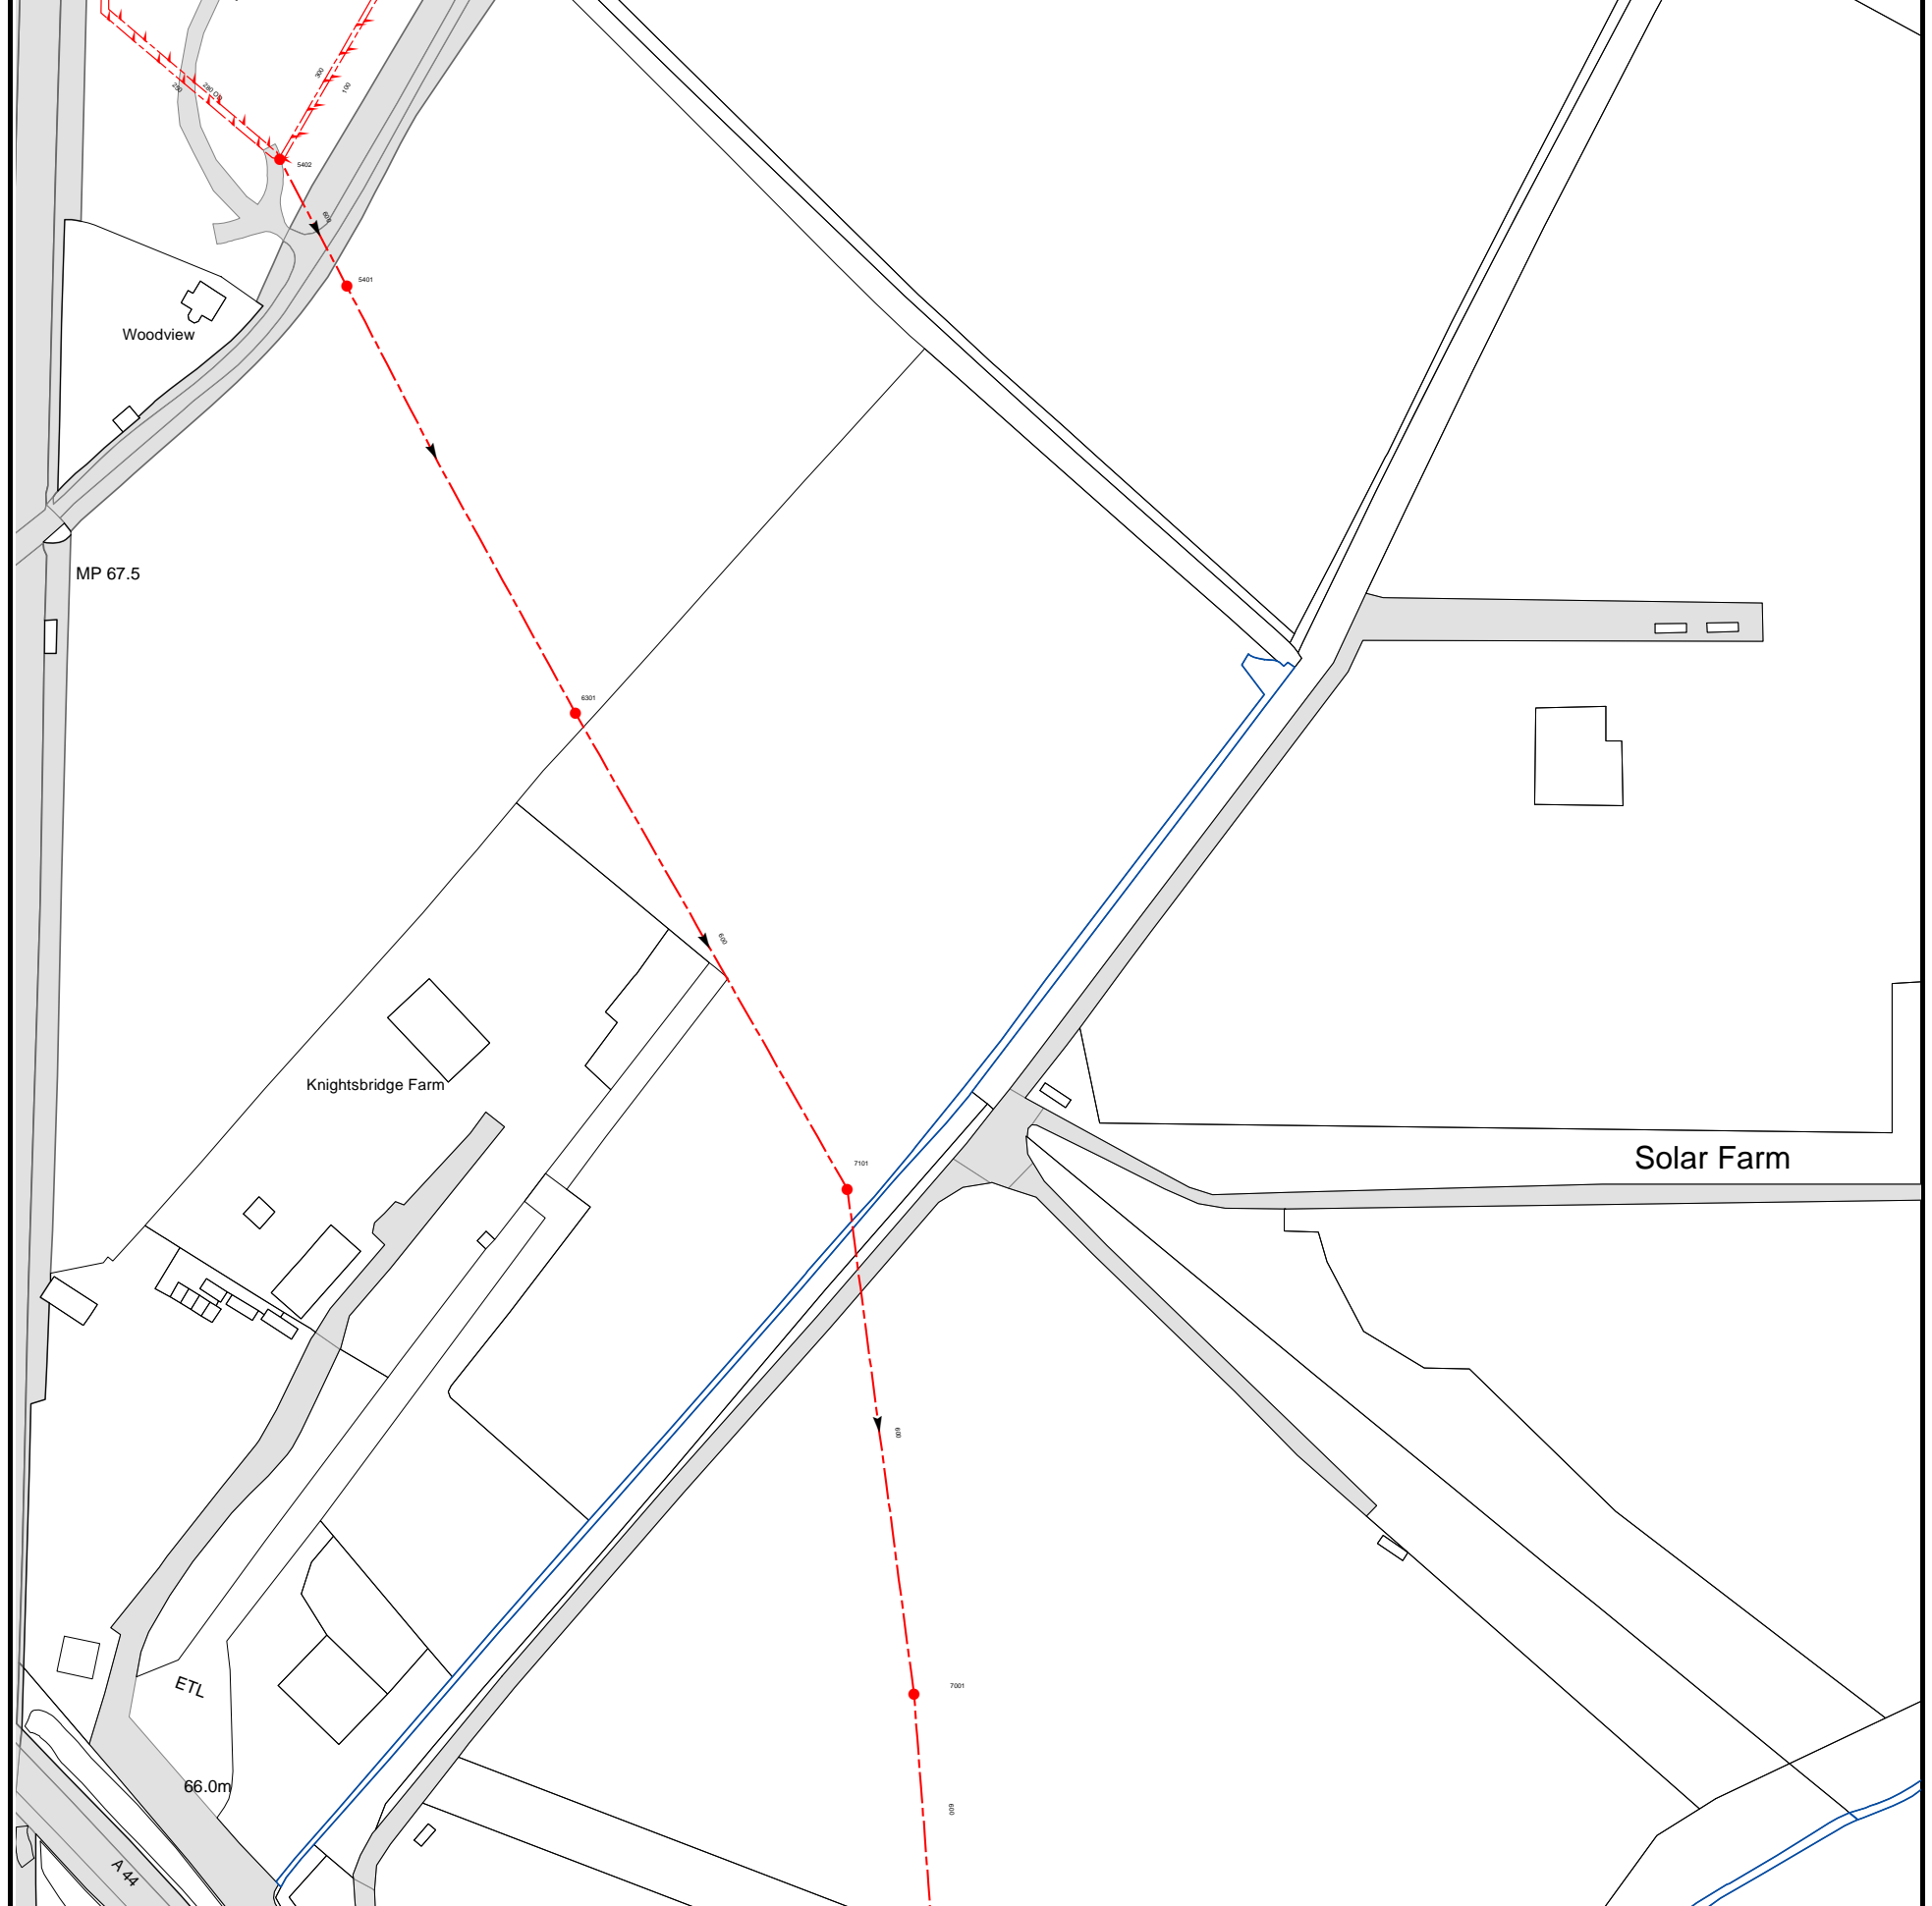

The width of the displayed area is 500m and the centre of the map is located at OS coordinates 448750,212250

The position of the apparatus shown on this plan is given without obligation and warranty, and the accuracy cannot be guaranteed. Service pipes are not shown but their presence should be anticipated. No liability of any kind whatsoever is accepted by Thames Water for any error or omission. The actual position of mains and services must be verified and established on site before any works are undertaken.

Based on the Ordnance Survey Map (2020) with the Sanction of the controller of H.M. Stationery Office, License no. 100019345 Crown Copyright Reserved.

NB. Levels quoted in metres Ordnance Newlyn Datum. The value -9999.00 indicates that no survey information is available

Manhole Reference	Manhole Cover Level	Manhole Invert Level
5402	60.42	58.9
5401	60.49	58.32
6301	60.35	58.08
7101	60.04	57.8
7001	58.7	57.51

The position of the apparatus shown on this plan is given without obligation and warranty, and the accuracy cannot be guaranteed. Service pipes are not shown but their presence should be anticipated. No liability of any kind whatsoever is accepted by Thames Water for any error or omission. The actual position of mains and services must be verified and established on site before any works are undertaken.



Asset Location Search - Sewer Key

Public Sewer Types (Operated and maintained by Thames Water)

- Foul Sewer:** A sewer designed to convey waste water from domestic and industrial sources to a treatment works.
- Surface Water Sewer:** A sewer designed to convey surface water (e.g. rain water from roofs, yards and car parks) to rivers or watercourses.
- Combined Sewer:** A sewer designed to convey both waste water and surface water from domestic and industrial sources to a treatment works.
- Storm Sewer
- Sludge Sewer
- Foul Trunk Sewer
- Surface Trunk Sewer
- Combined Trunk Sewer
- Foul Rising Main
- Surface Water Rising Main
- Combined Rising Main
- Vacuum
- Thames Water Proposed
- Vent Pipe
- Gallery

Other Sewer Types (Not operated and maintained by Thames Water)

- Sewer
- Culverted Watercourse
- Proposed
- Decommissioned Sewer
- Content of this drainage network is currently unknown
- Ownership of this drainage network is currently unknown

Notes:

- 1) All levels associated with the plans are to Ordnance Datum Newlyn.
- 2) All measurements on the plan are metric.
- 3) Arrows (on gravity fed sewers) or flecks (on rising mains) indicate the direction of flow.
- 4) Most private pipes are not shown on our plans, as in the past, this information has not been recorded.

Sewer Fittings

A feature in a sewer that does not affect the flow in the pipe. Example: a vent is a fitting as the function of a vent is to release excess gas.

- Air Valve
- Meter
- Dam Chase
- Vent
- Fitting

Operational Controls

A feature in a sewer that changes or diverts the flow in the sewer. Example: A hydrobrake limits the flow passing downstream.

- Ancillary
- Drop Pipe
- Control Valve
- Well

End Items

End symbols appear at the start or end of a sewer pipe. Examples: an Undefined End at the start of a sewer indicates that Thames Water has no knowledge of the position of the sewer upstream of that symbol. Outfall on a surface water sewer indicates that the pipe discharges into a stream or river.

- Inlet
- Outfall
- Undefined End

Other Symbols

Symbols used on maps which do not fall under other general categories.

- Change of Characteristic Indicator
- Public / Private Pumping Station
- Invert Level
- Summit

Areas

Lines denoting areas of underground surveys, etc.

- Agreement
- Chamber
- Operational Site

Ducts or Crossings

- Casement
 - Conduit Bridge
 - Subway
 - Tunnel
- Ducts may contain high voltage cables. Please check with Thames Water.

5) 'na' or '0' on a manhole indicates that data is unavailable.

6) The text appearing alongside a sewer line indicates the internal diameter of the pipe in millimeters. Text next to a manhole indicates the manhole reference number and should not be taken as a measurement. If you are unsure about any text or symbology, please contact Property Searches on 0800 009 4540.



The width of the displayed area is 500m and the centre of the map is located at OS coordinates 448250,213250

The position of the apparatus shown on this plan is given without obligation and warranty, and the accuracy cannot be guaranteed. Service pipes are not shown but their presence should be anticipated. No liability of any kind whatsoever is accepted by Thames Water for any error or omission. The actual position of mains and services must be verified and established on site before any works are undertaken.

Based on the Ordnance Survey Map (2020) with the Sanction of the controller of H.M. Stationery Office, License no. 100019345 Crown Copyright Reserved.



The width of the displayed area is 500m and the centre of the map is located at OS coordinates 447250,212750

The position of the apparatus shown on this plan is given without obligation and warranty, and the accuracy cannot be guaranteed. Service pipes are not shown but their presence should be anticipated. No liability of any kind whatsoever is accepted by Thames Water for any error or omission. The actual position of mains and services must be verified and established on site before any works are undertaken.

Based on the Ordnance Survey Map (2020) with the Sanction of the controller of H.M. Stationery Office, License no. 100019345 Crown Copyright Reserved.



The width of the displayed area is 500m and the centre of the map is located at OS coordinates 448750,213750

The position of the apparatus shown on this plan is given without obligation and warranty, and the accuracy cannot be guaranteed. Service pipes are not shown but their presence should be anticipated. No liability of any kind whatsoever is accepted by Thames Water for any error or omission. The actual position of mains and services must be verified and established on site before any works are undertaken.


Based on the Ordnance Survey Map (2020) with the Sanction of the controller of H.M. Stationery Office, License no. 100019345 Crown Copyright Reserved.




The width of the displayed area is 500m and the centre of the map is located at OS coordinates 448250,214250

The position of the apparatus shown on this plan is given without obligation and warranty, and the accuracy cannot be guaranteed. Service pipes are not shown but their presence should be anticipated. No liability of any kind whatsoever is accepted by Thames Water for any error or omission. The actual position of mains and services must be verified and established on site before any works are undertaken.

Based on the Ordnance Survey Map (2020) with the Sanction of the controller of H.M. Stationery Office, License no. 100019345 Crown Copyright Reserved.

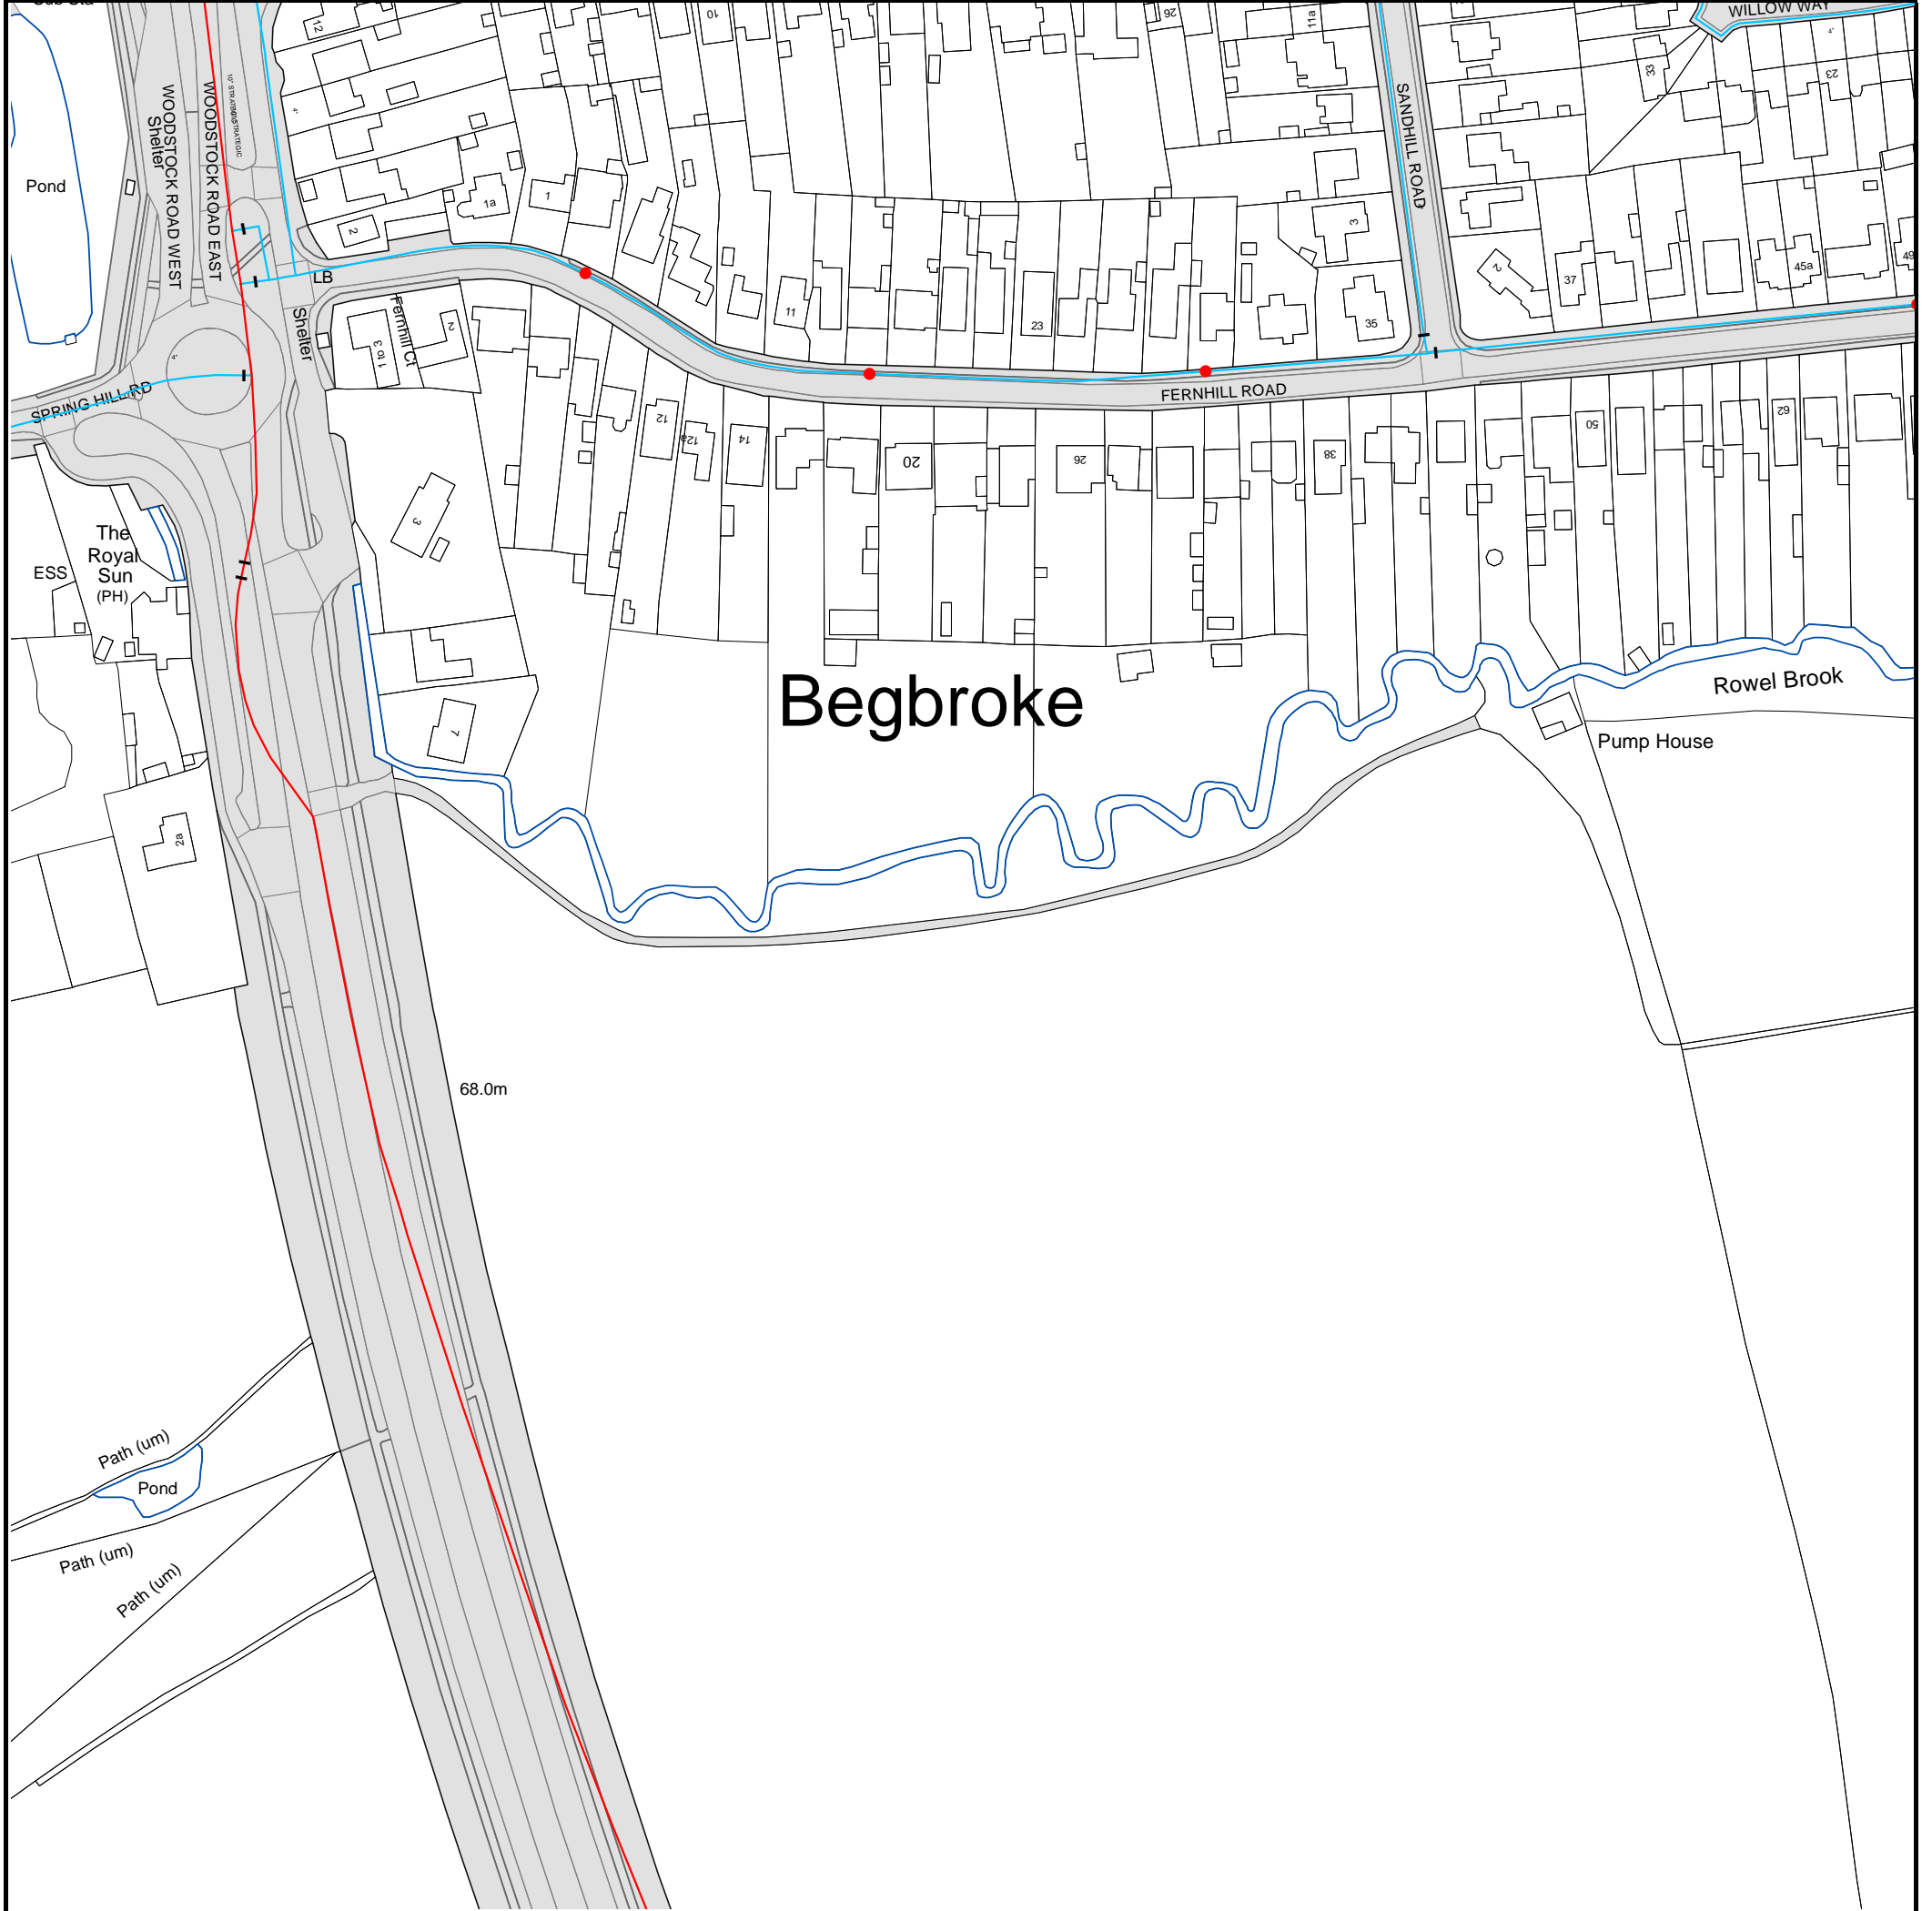

The width of the displayed area is 500m and the centre of the map is located at OS coordinates 447250,213750
The position of the apparatus shown on this plan is given without obligation and warranty, and the accuracy cannot be guaranteed. Service pipes are not shown but their presence should be anticipated. No liability of any kind whatsoever is accepted by Thames Water for any error or omission. The actual position of mains and services must be verified and established on site before any works are undertaken.
Based on the Ordnance Survey Map (2020) with the Sanction of the controller of H.M. Stationery Office, License no. 100019345 Crown Copyright Reserved.

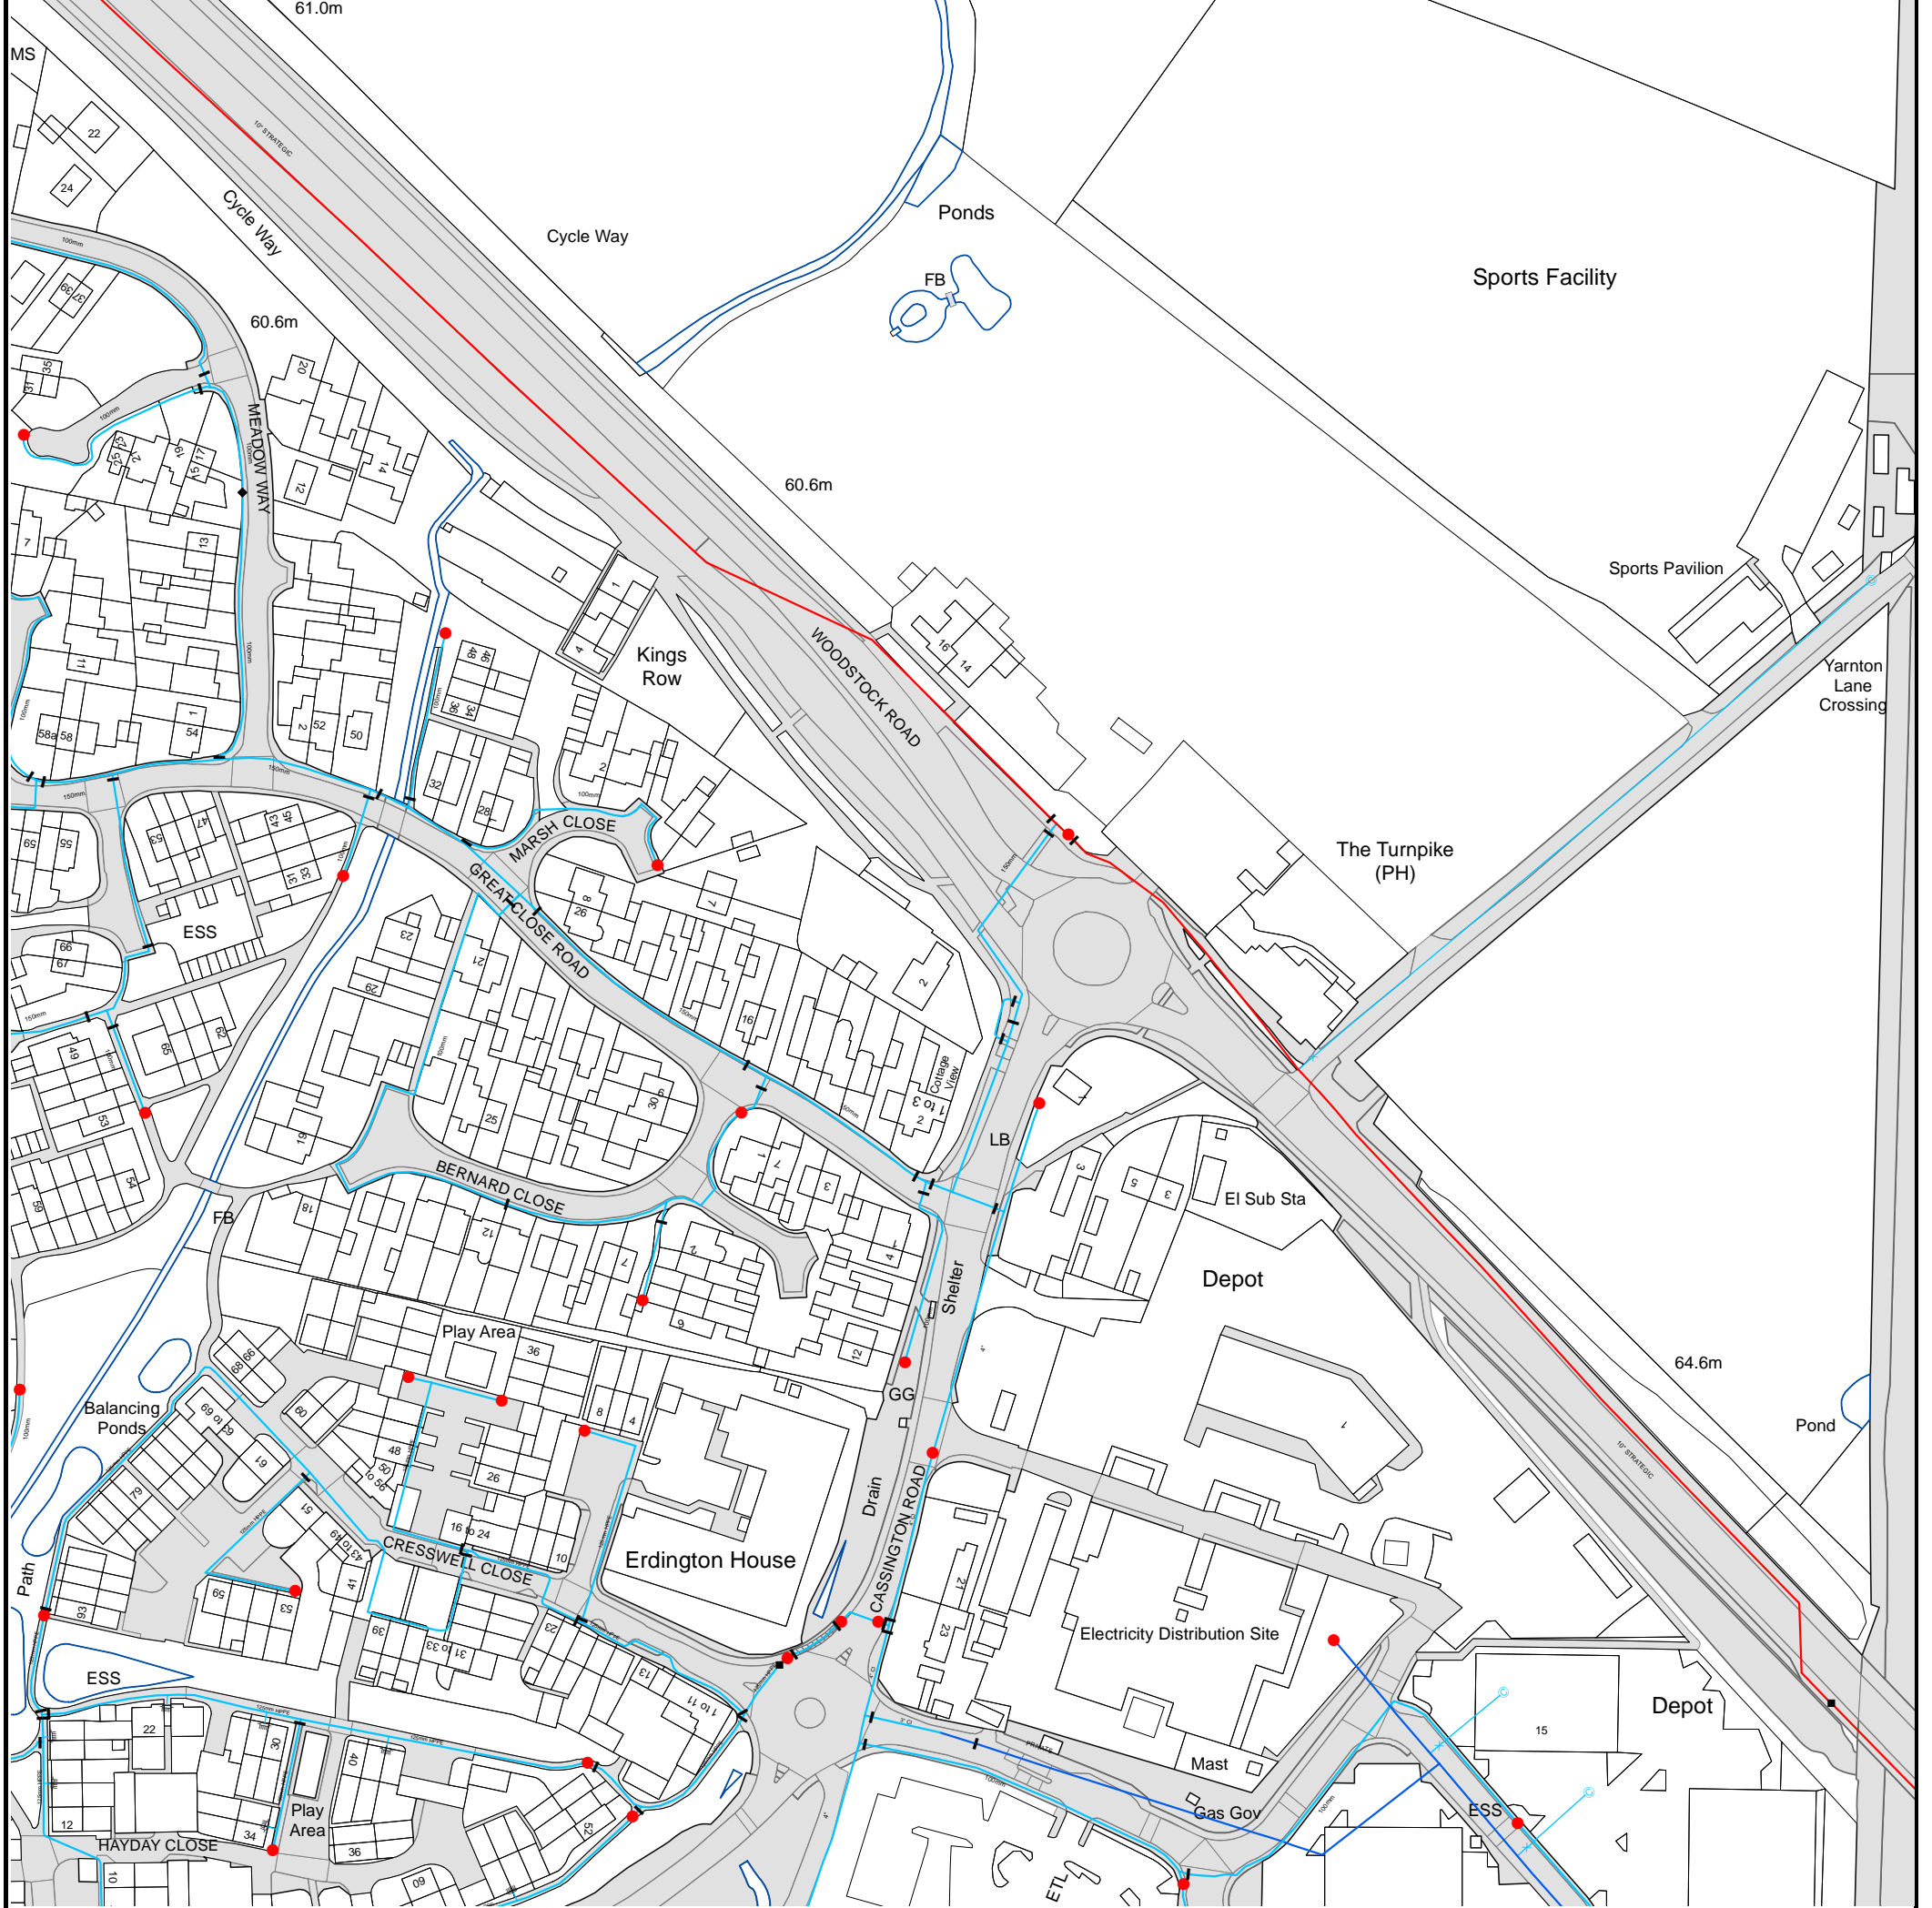

The width of the displayed area is 500m and the centre of the map is located at OS coordinates 448250,212250

The position of the apparatus shown on this plan is given without obligation and warranty, and the accuracy cannot be guaranteed. Service pipes are not shown but their presence should be anticipated. No liability of any kind whatsoever is accepted by Thames Water for any error or omission. The actual position of mains and services must be verified and established on site before any works are undertaken.


Based on the Ordnance Survey Map (2020) with the Sanction of the controller of H.M. Stationery Office, License no. 100019345 Crown Copyright Reserved.



The width of the displayed area is 500m and the centre of the map is located at OS coordinates 449250,212750

The position of the apparatus shown on this plan is given without obligation and warranty, and the accuracy cannot be guaranteed. Service pipes are not shown but their presence should be anticipated. No liability of any kind whatsoever is accepted by Thames Water for any error or omission. The actual position of mains and services must be verified and established on site before any works are undertaken.


Based on the Ordnance Survey Map (2020) with the Sanction of the controller of H.M. Stationery Office, License no. 100019345 Crown Copyright Reserved.

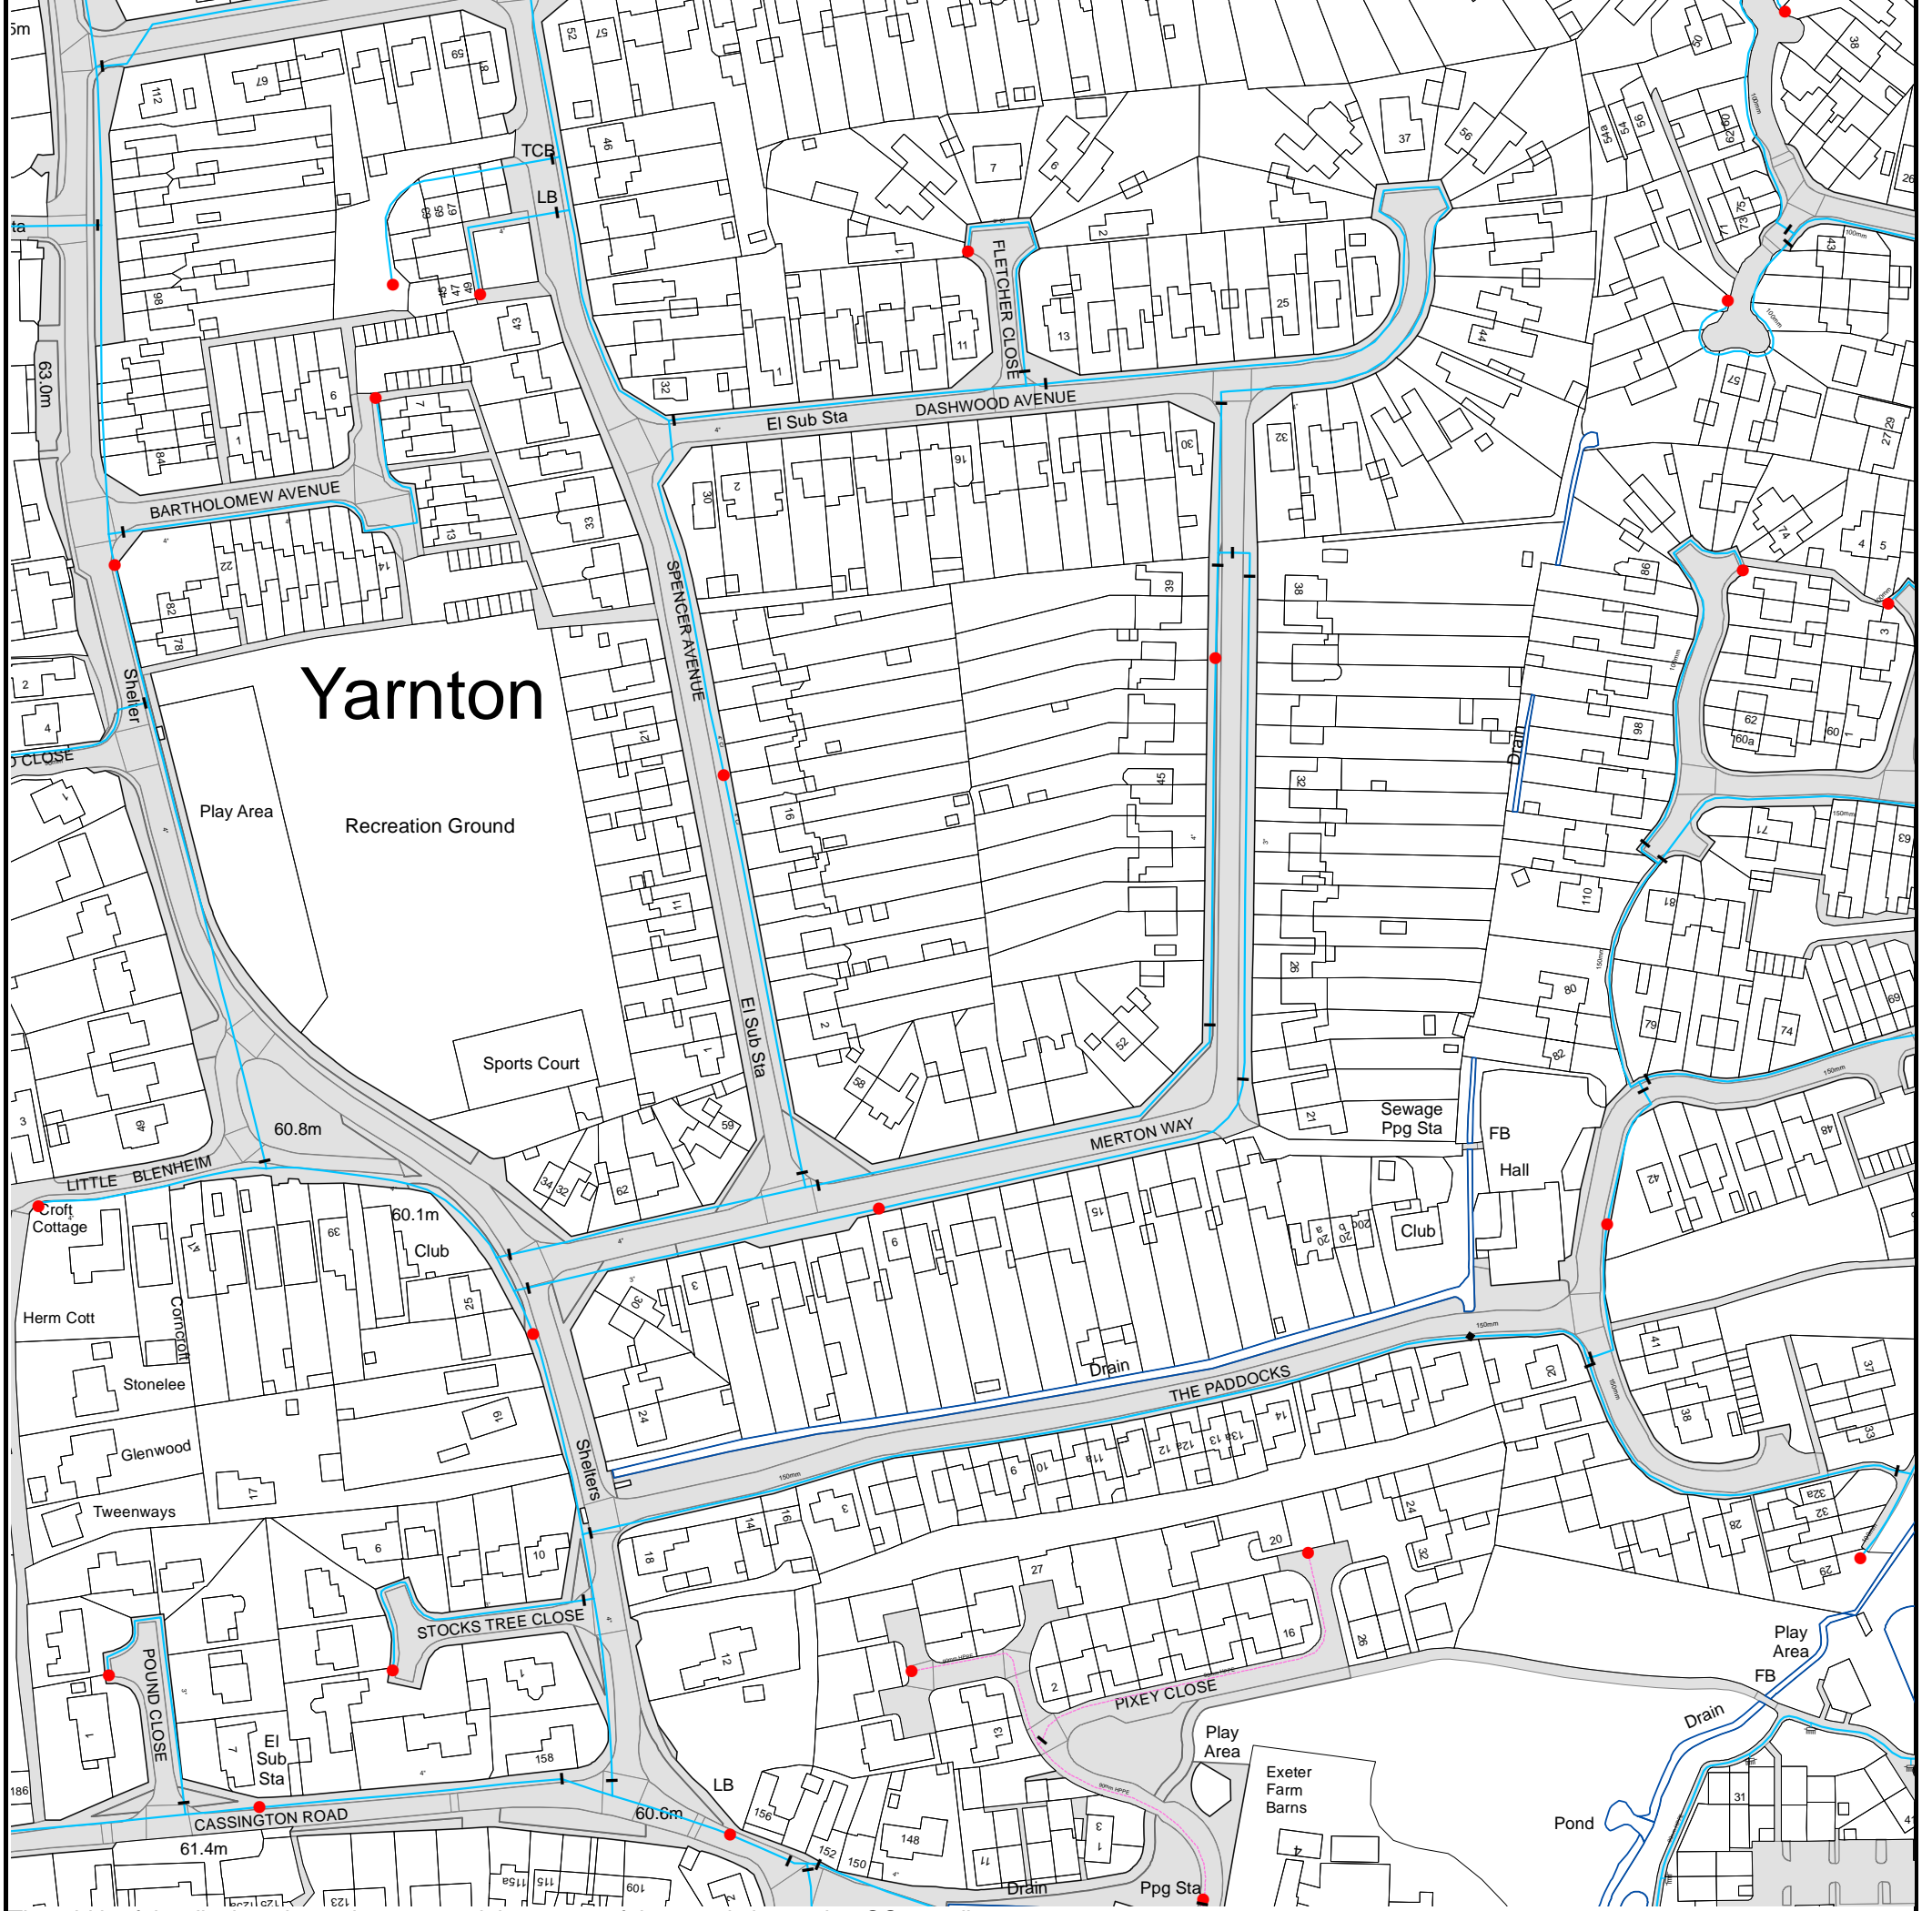


The width of the displayed area is 500m and the centre of the map is located at OS coordinates 447750,212250

The position of the apparatus shown on this plan is given without obligation and warranty, and the accuracy cannot be guaranteed. Service pipes are not shown but their presence should be anticipated. No liability of any kind whatsoever is accepted by Thames Water for any error or omission. The actual position of mains and services must be verified and established on site before any works are undertaken.

Based on the Ordnance Survey Map (2020) with the Sanction of the controller of H.M. Stationery Office, License no. 100019345 Crown Copyright Reserved.

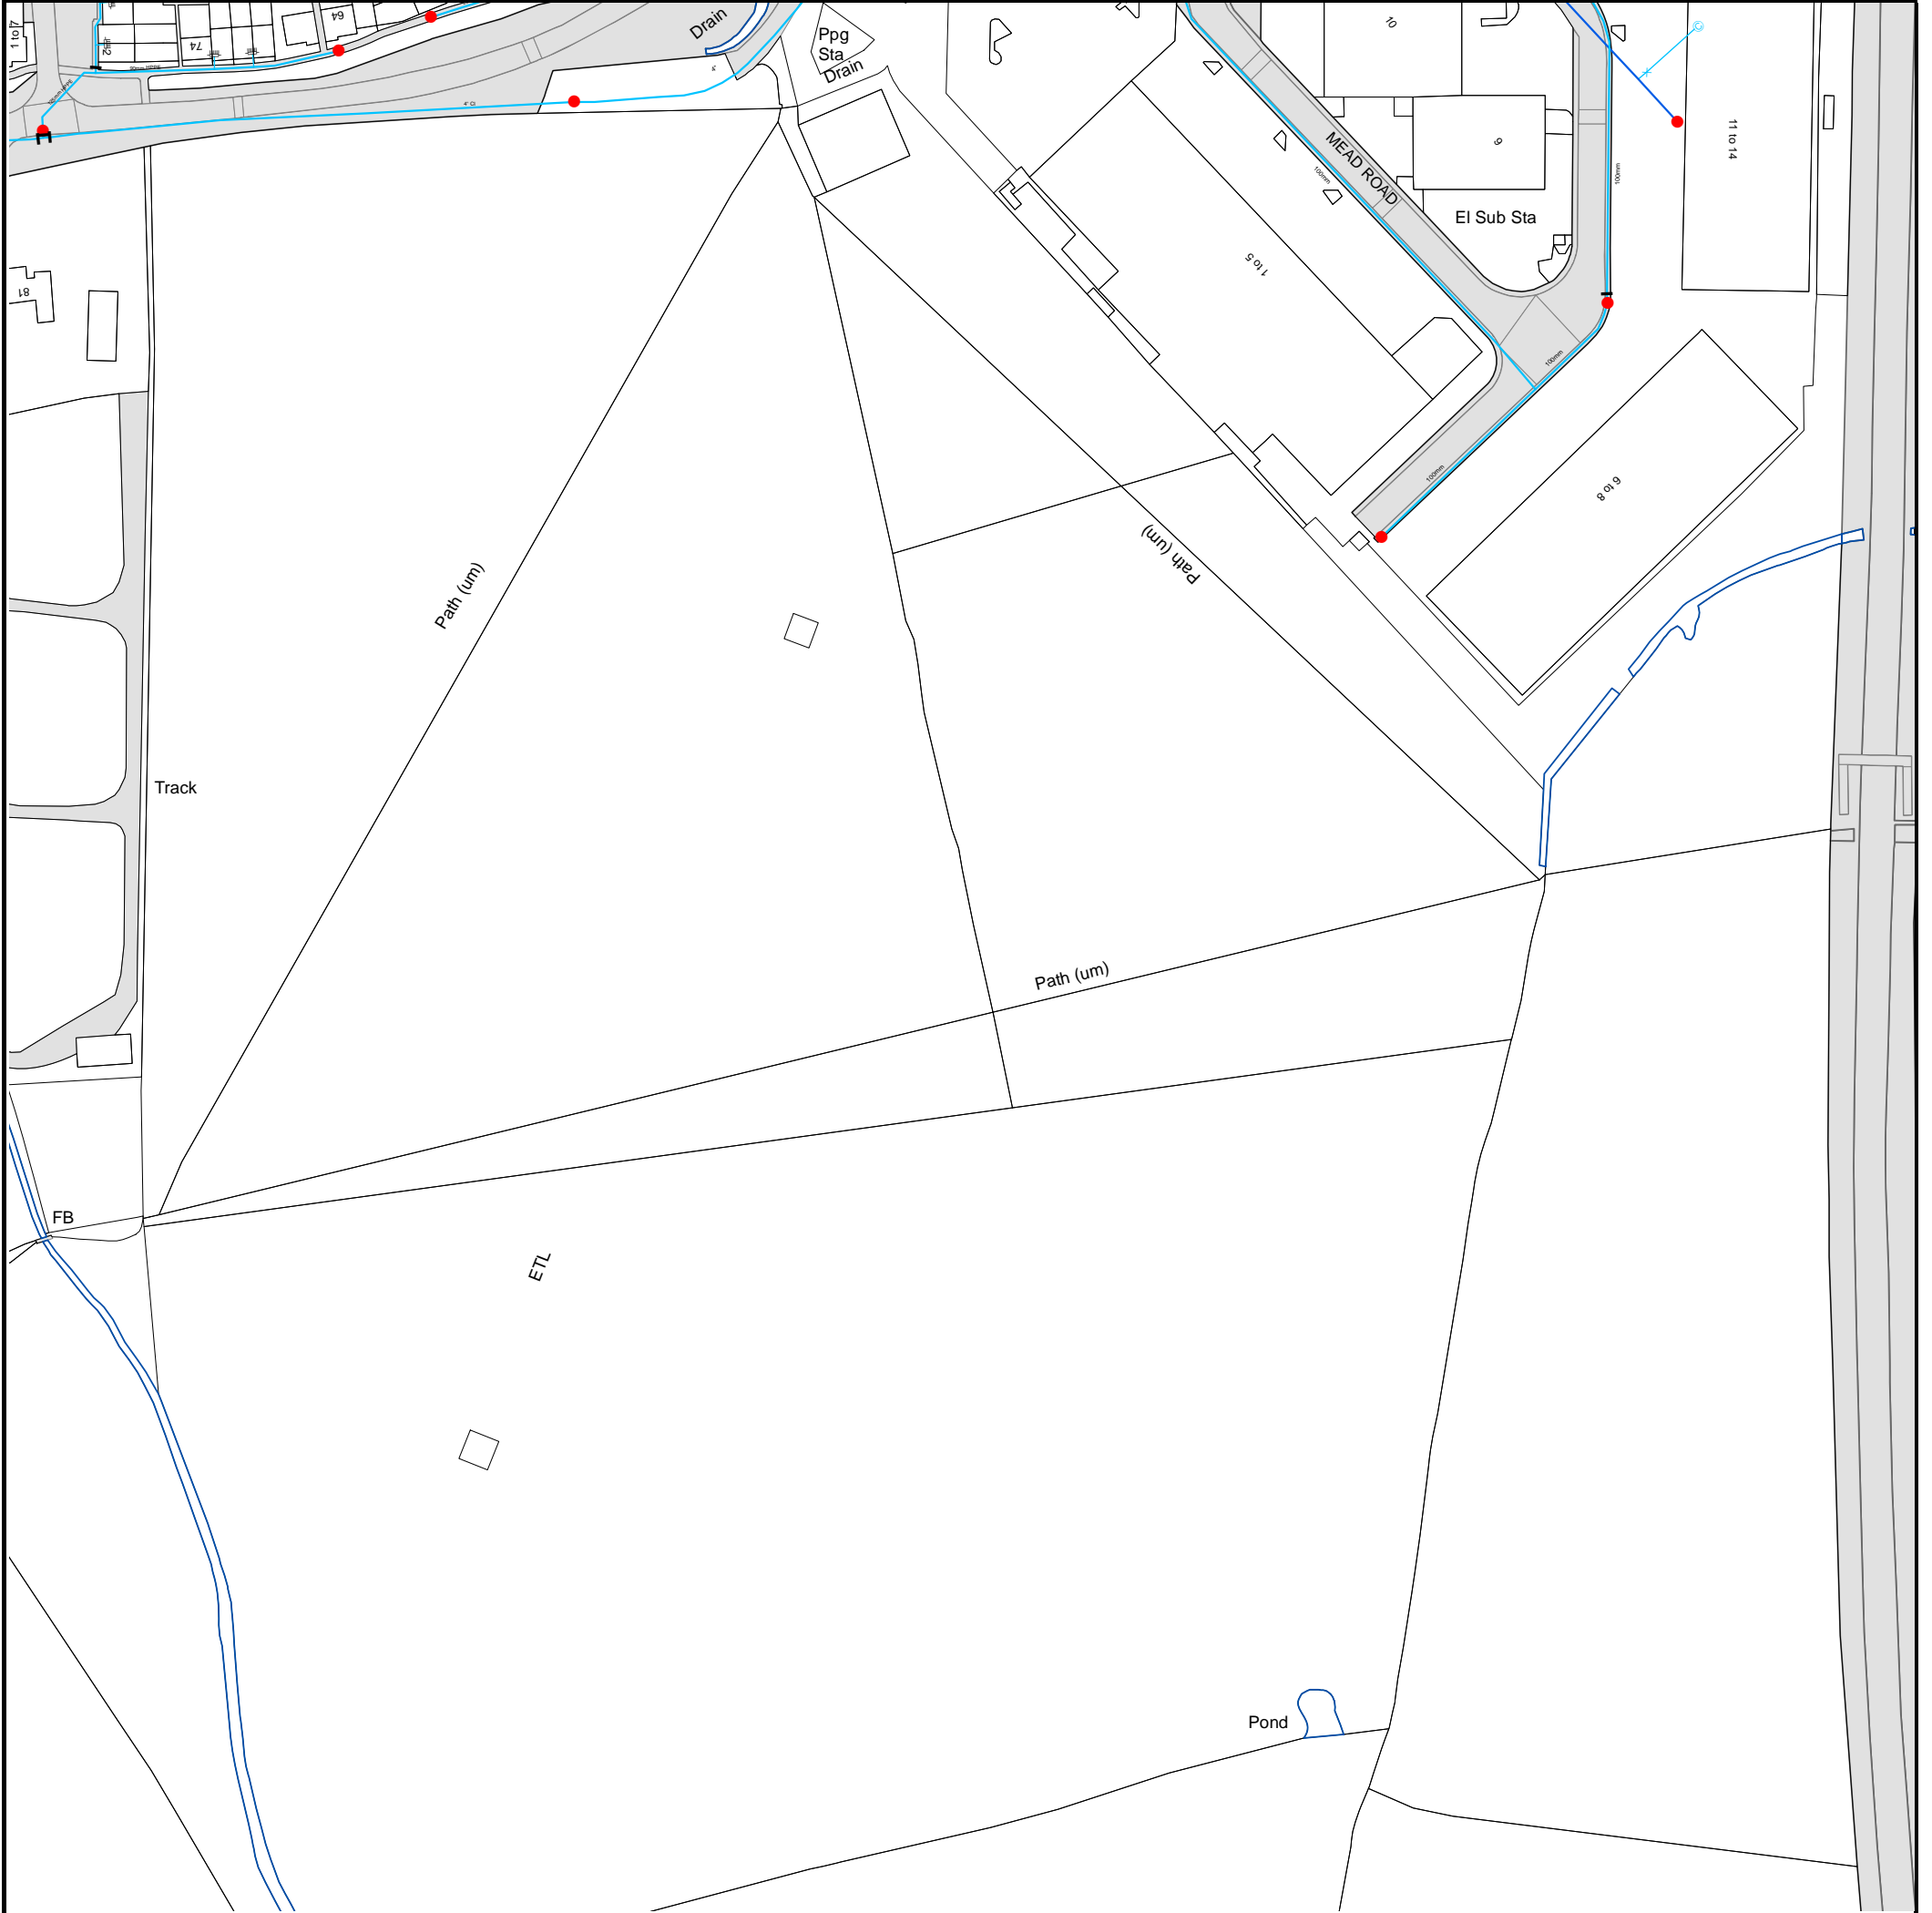

The width of the displayed area is 500m and the centre of the map is located at OS coordinates 448250,211750
The position of the apparatus shown on this plan is given without obligation and warranty, and the accuracy cannot be guaranteed. Service pipes are not shown but their presence should be anticipated. No liability of any kind whatsoever is accepted by Thames Water for any error or omission. The actual position of mains and services must be verified and established on site before any works are undertaken.
Based on the Ordnance Survey Map (2020) with the Sanction of the controller of H.M. Stationery Office, License no. 100019345 Crown Copyright Reserved.

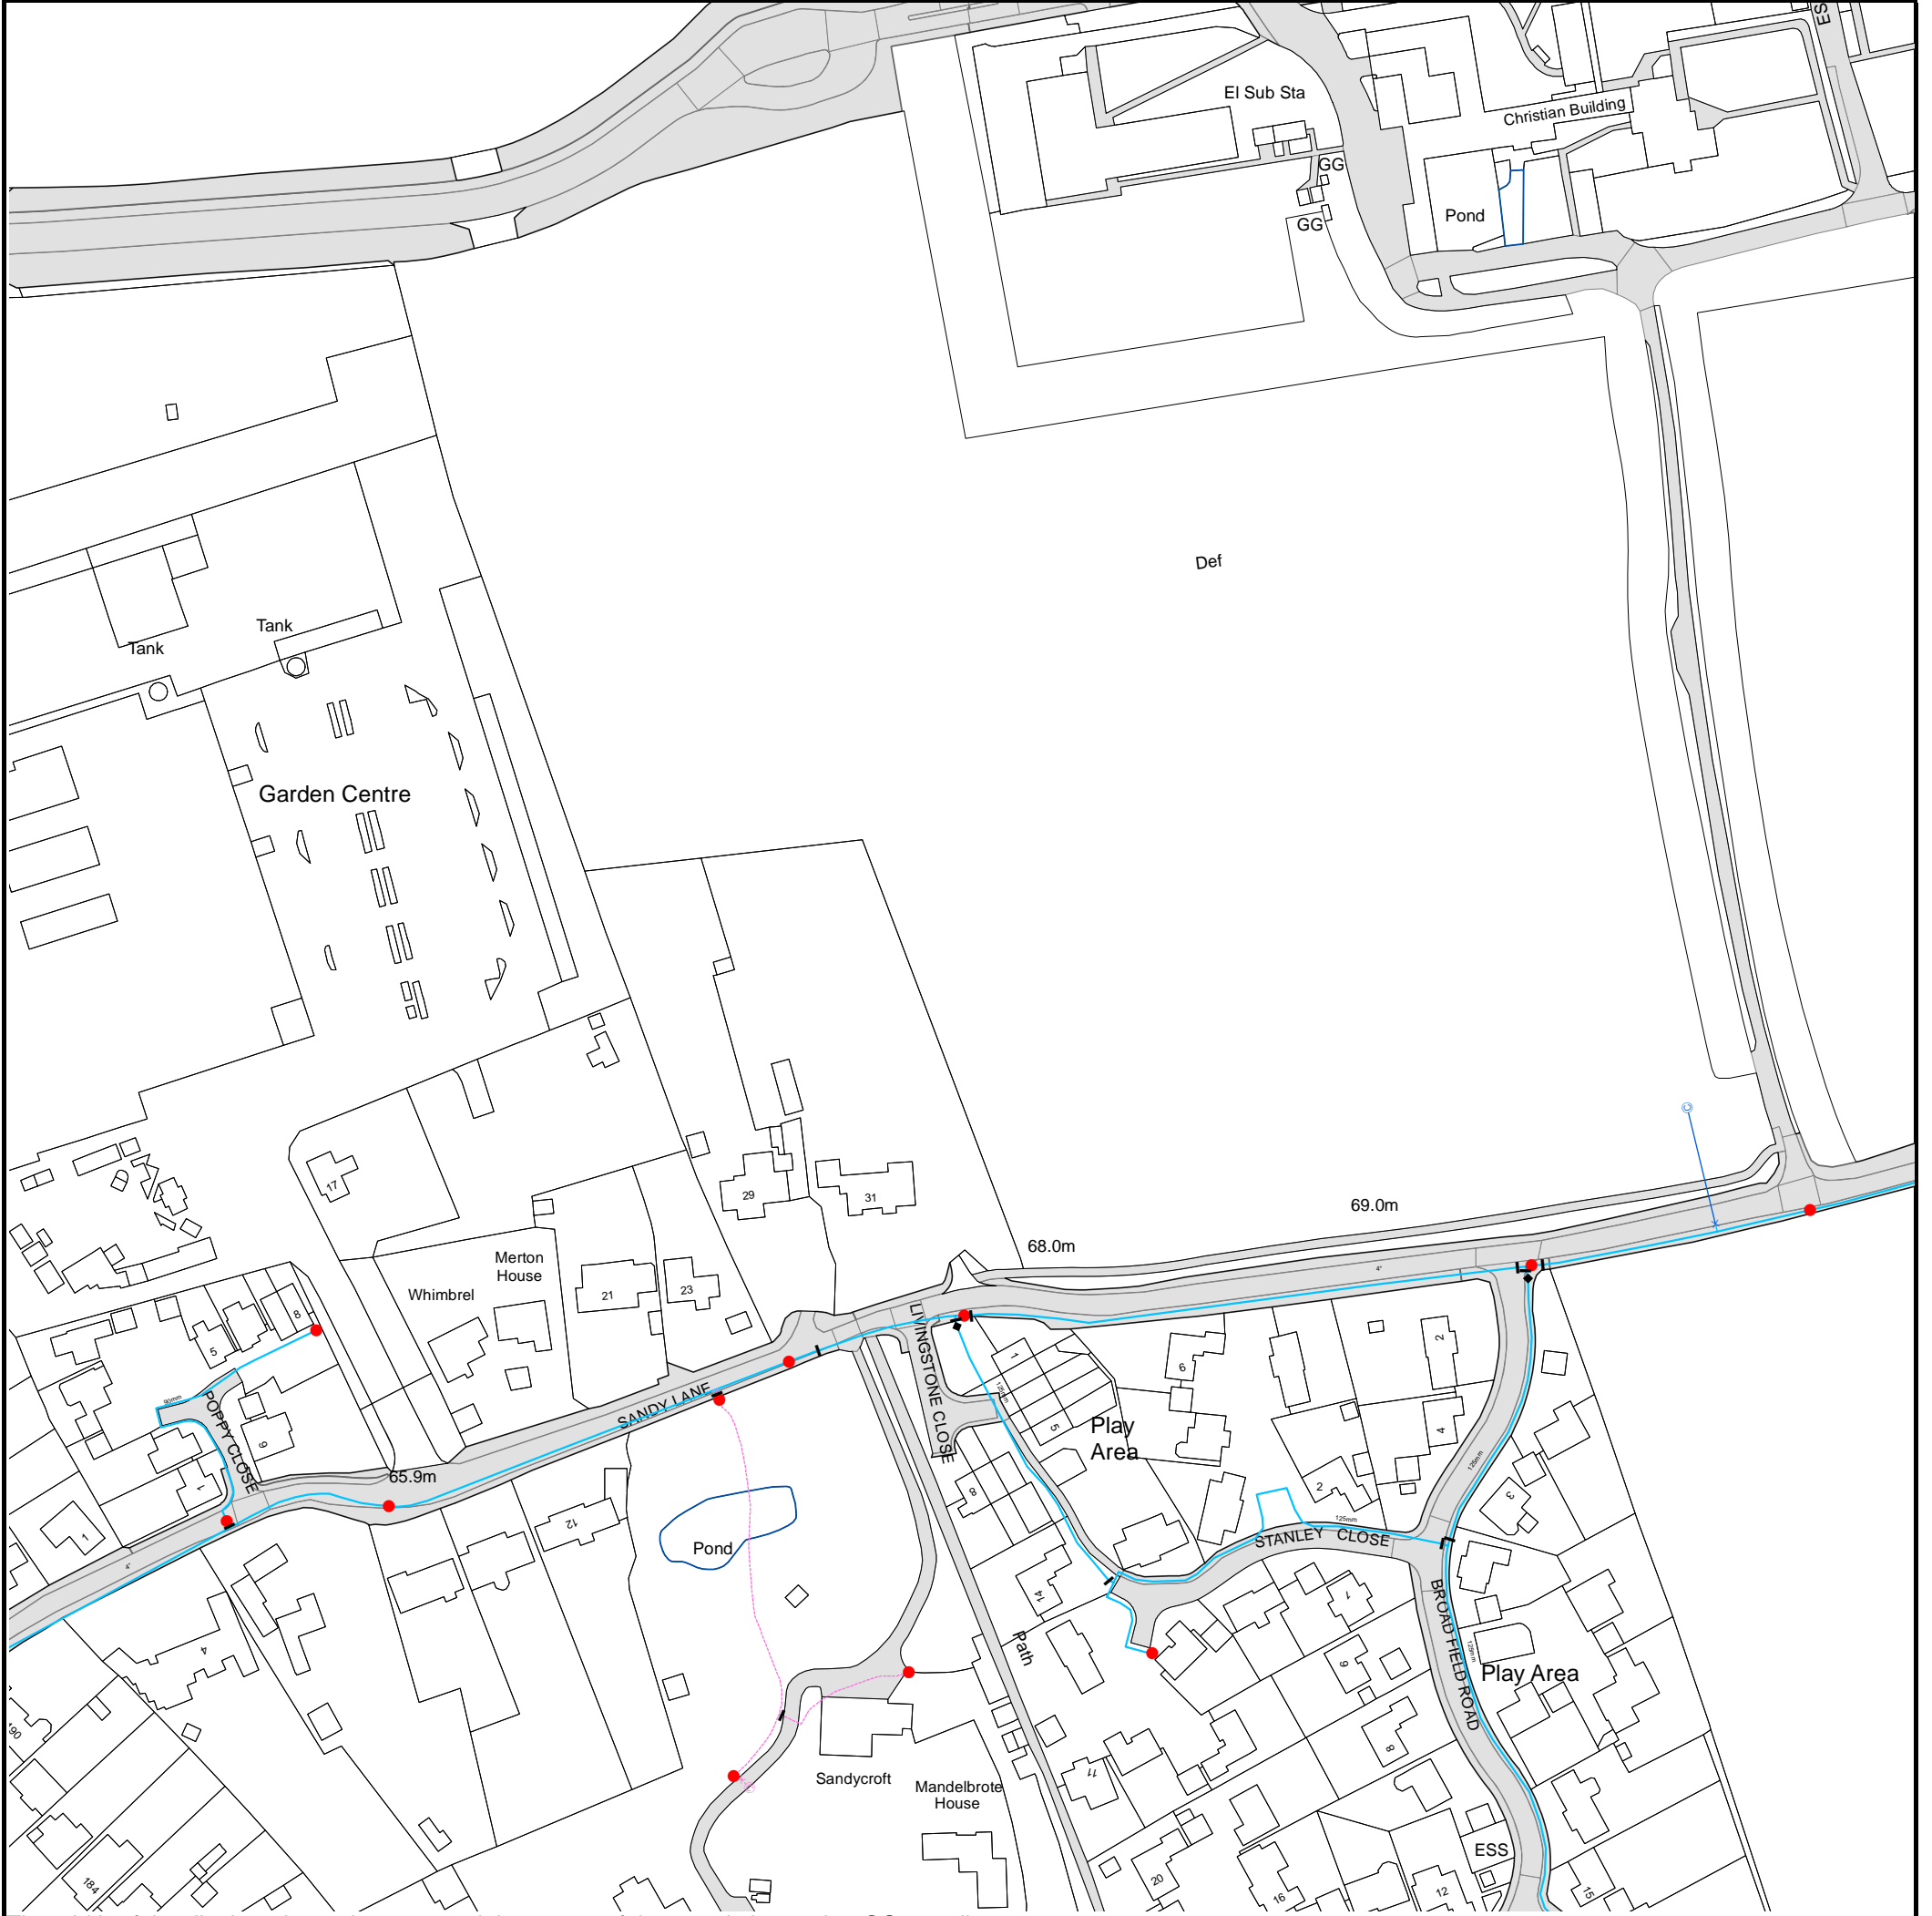

The width of the displayed area is 500m and the centre of the map is located at OS coordinates 447750,213250

The position of the apparatus shown on this plan is given without obligation and warranty, and the accuracy cannot be guaranteed. Service pipes are not shown but their presence should be anticipated. No liability of any kind whatsoever is accepted by Thames Water for any error or omission. The actual position of mains and services must be verified and established on site before any works are undertaken.


Based on the Ordnance Survey Map (2020) with the Sanction of the controller of H.M. Stationery Office, License no. 100019345 Crown Copyright Reserved.



The width of the displayed area is 500m and the centre of the map is located at OS coordinates 446750,213750

The position of the apparatus shown on this plan is given without obligation and warranty, and the accuracy cannot be guaranteed. Service pipes are not shown but their presence should be anticipated. No liability of any kind whatsoever is accepted by Thames Water for any error or omission. The actual position of mains and services must be verified and established on site before any works are undertaken.

Based on the Ordnance Survey Map (2020) with the Sanction of the controller of H.M. Stationery Office, License no. 100019345 Crown Copyright Reserved.

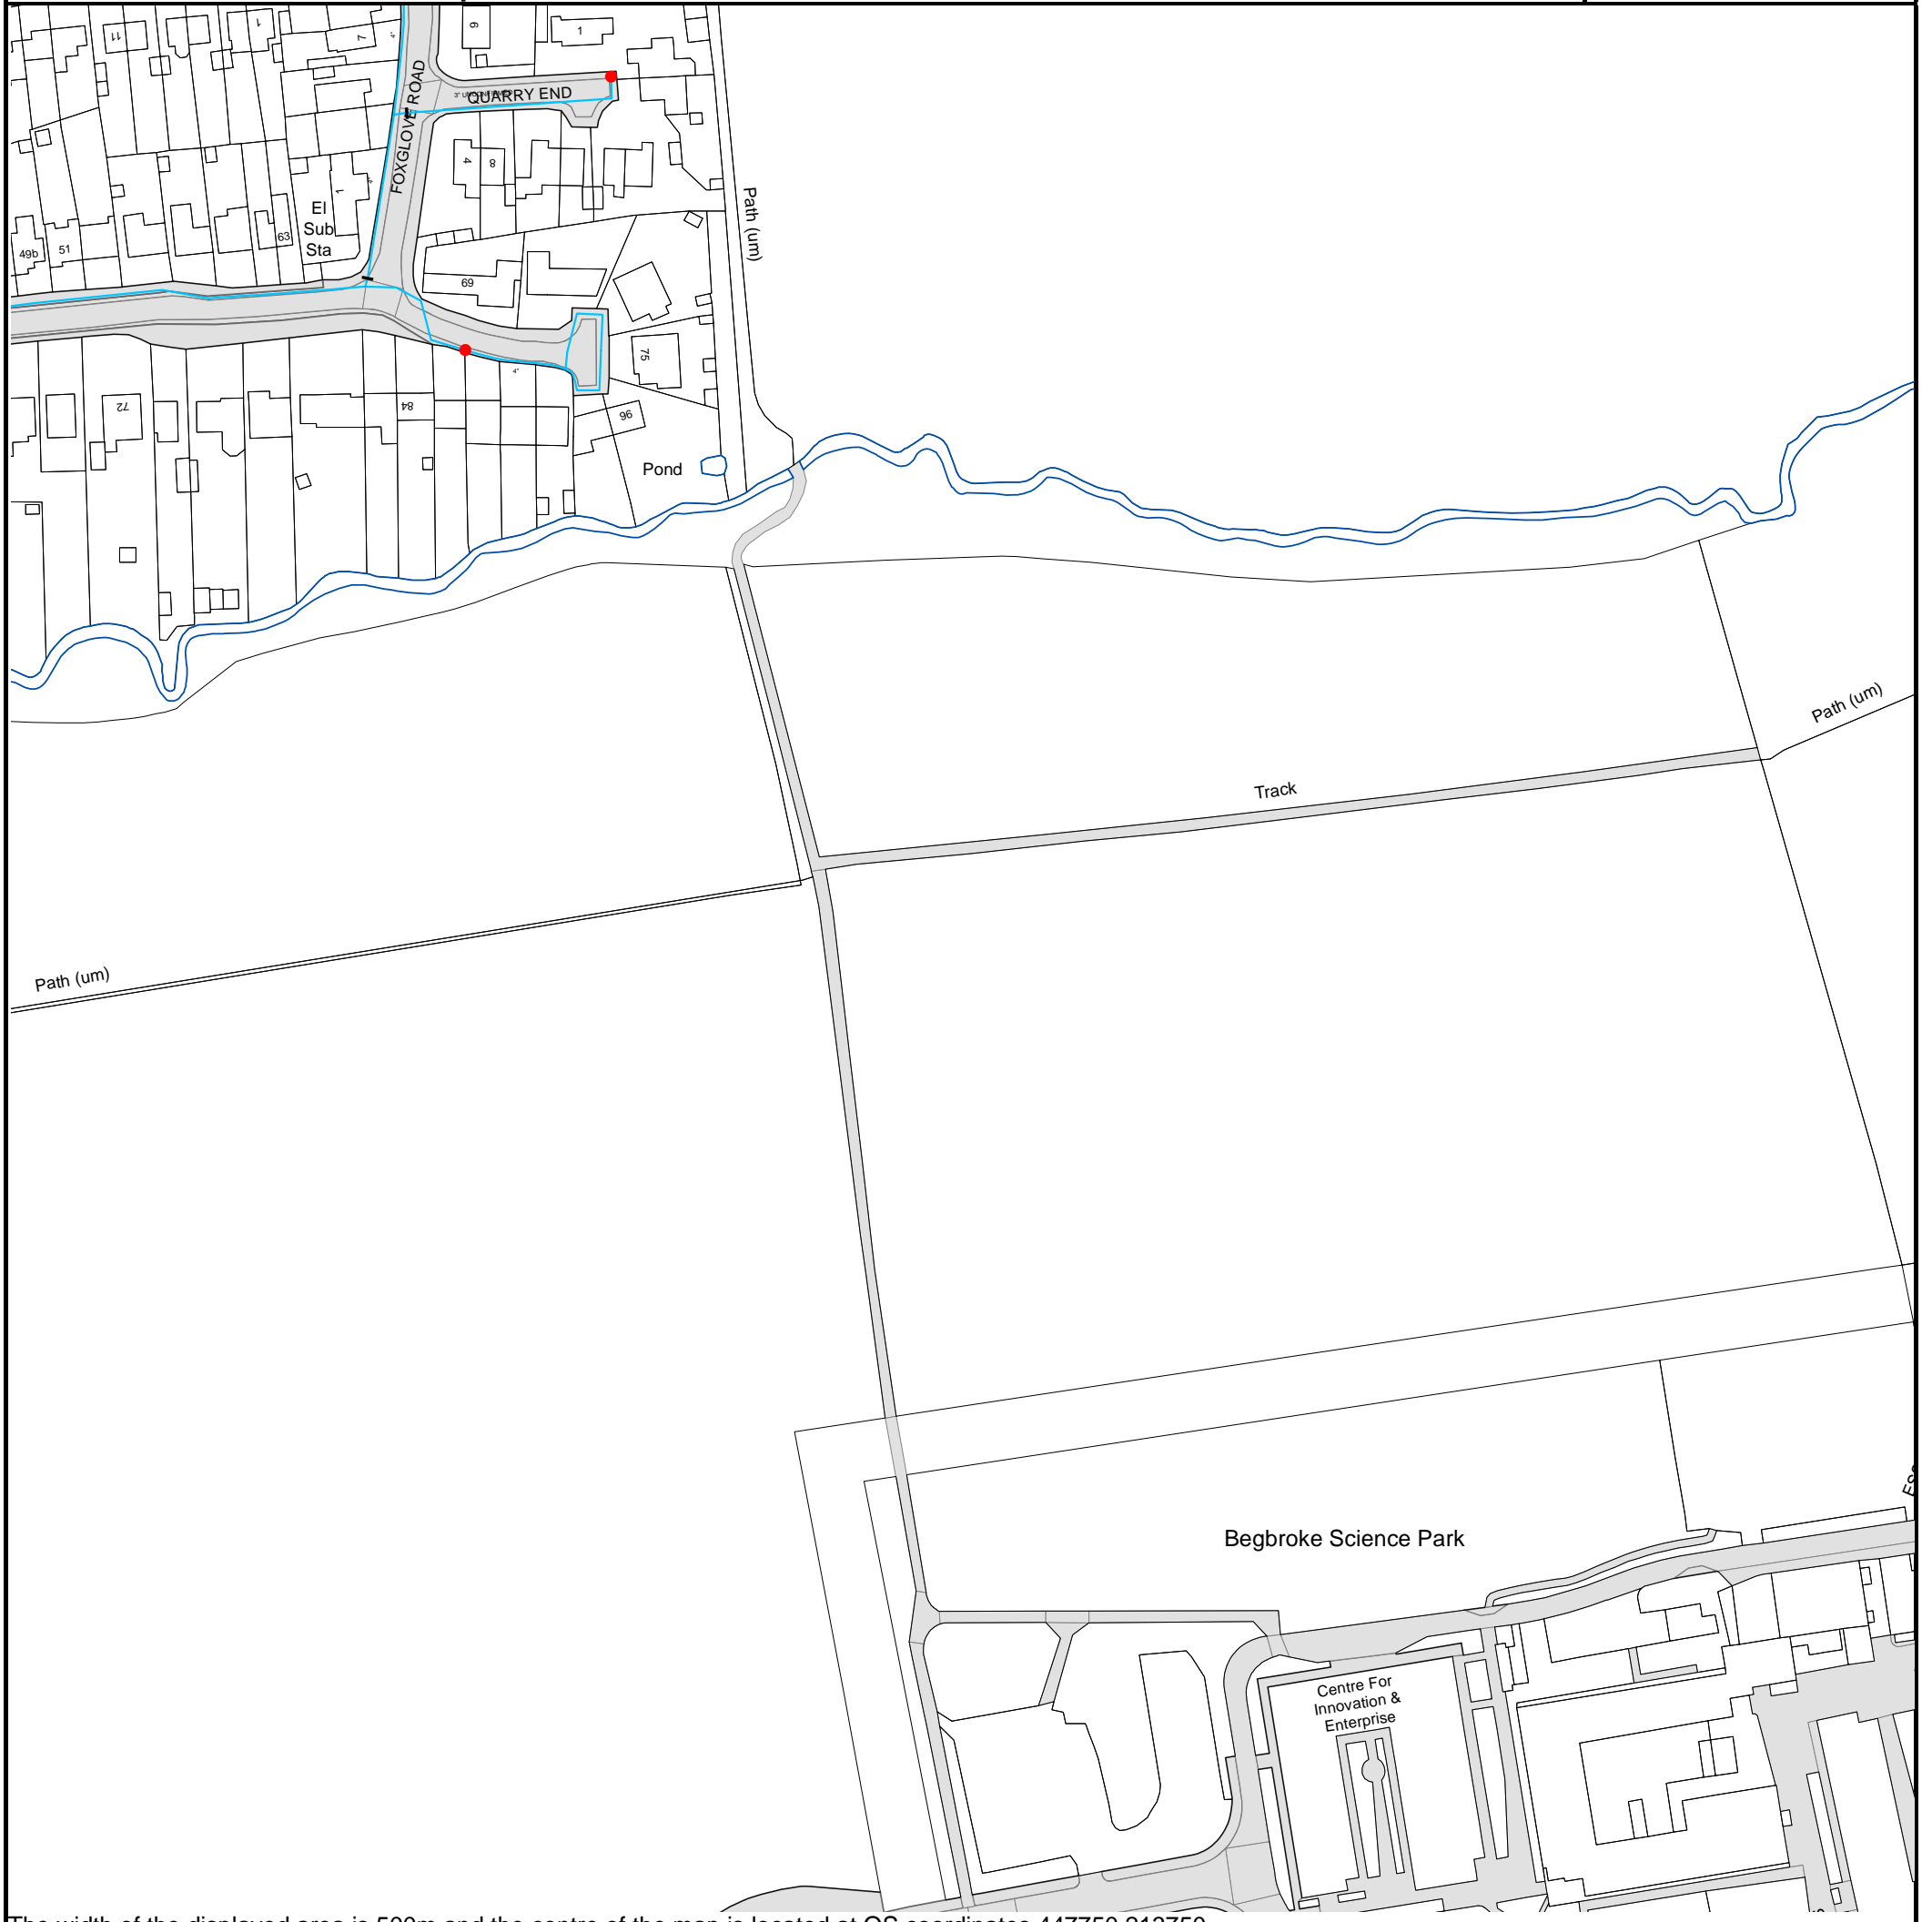


The width of the displayed area is 500m and the centre of the map is located at OS coordinates 447750,213750
The position of the apparatus shown on this plan is given without obligation and warranty, and the accuracy cannot be guaranteed. Service pipes are not shown but their presence should be anticipated. No liability of any kind whatsoever is accepted by Thames Water for any error or omission. The actual position of mains and services must be verified and established on site before any works are undertaken.
Based on the Ordnance Survey Map (2020) with the Sanction of the controller of H.M. Stationery Office, License no. 100019345 Crown Copyright Reserved.



The width of the displayed area is 500m and the centre of the map is located at OS coordinates 447750,214250

The position of the apparatus shown on this plan is given without obligation and warranty, and the accuracy cannot be guaranteed. Service pipes are not shown but their presence should be anticipated. No liability of any kind whatsoever is accepted by Thames Water for any error or omission. The actual position of mains and services must be verified and established on site before any works are undertaken.


Based on the Ordnance Survey Map (2020) with the Sanction of the controller of H.M. Stationery Office, License no. 100019345 Crown Copyright Reserved.

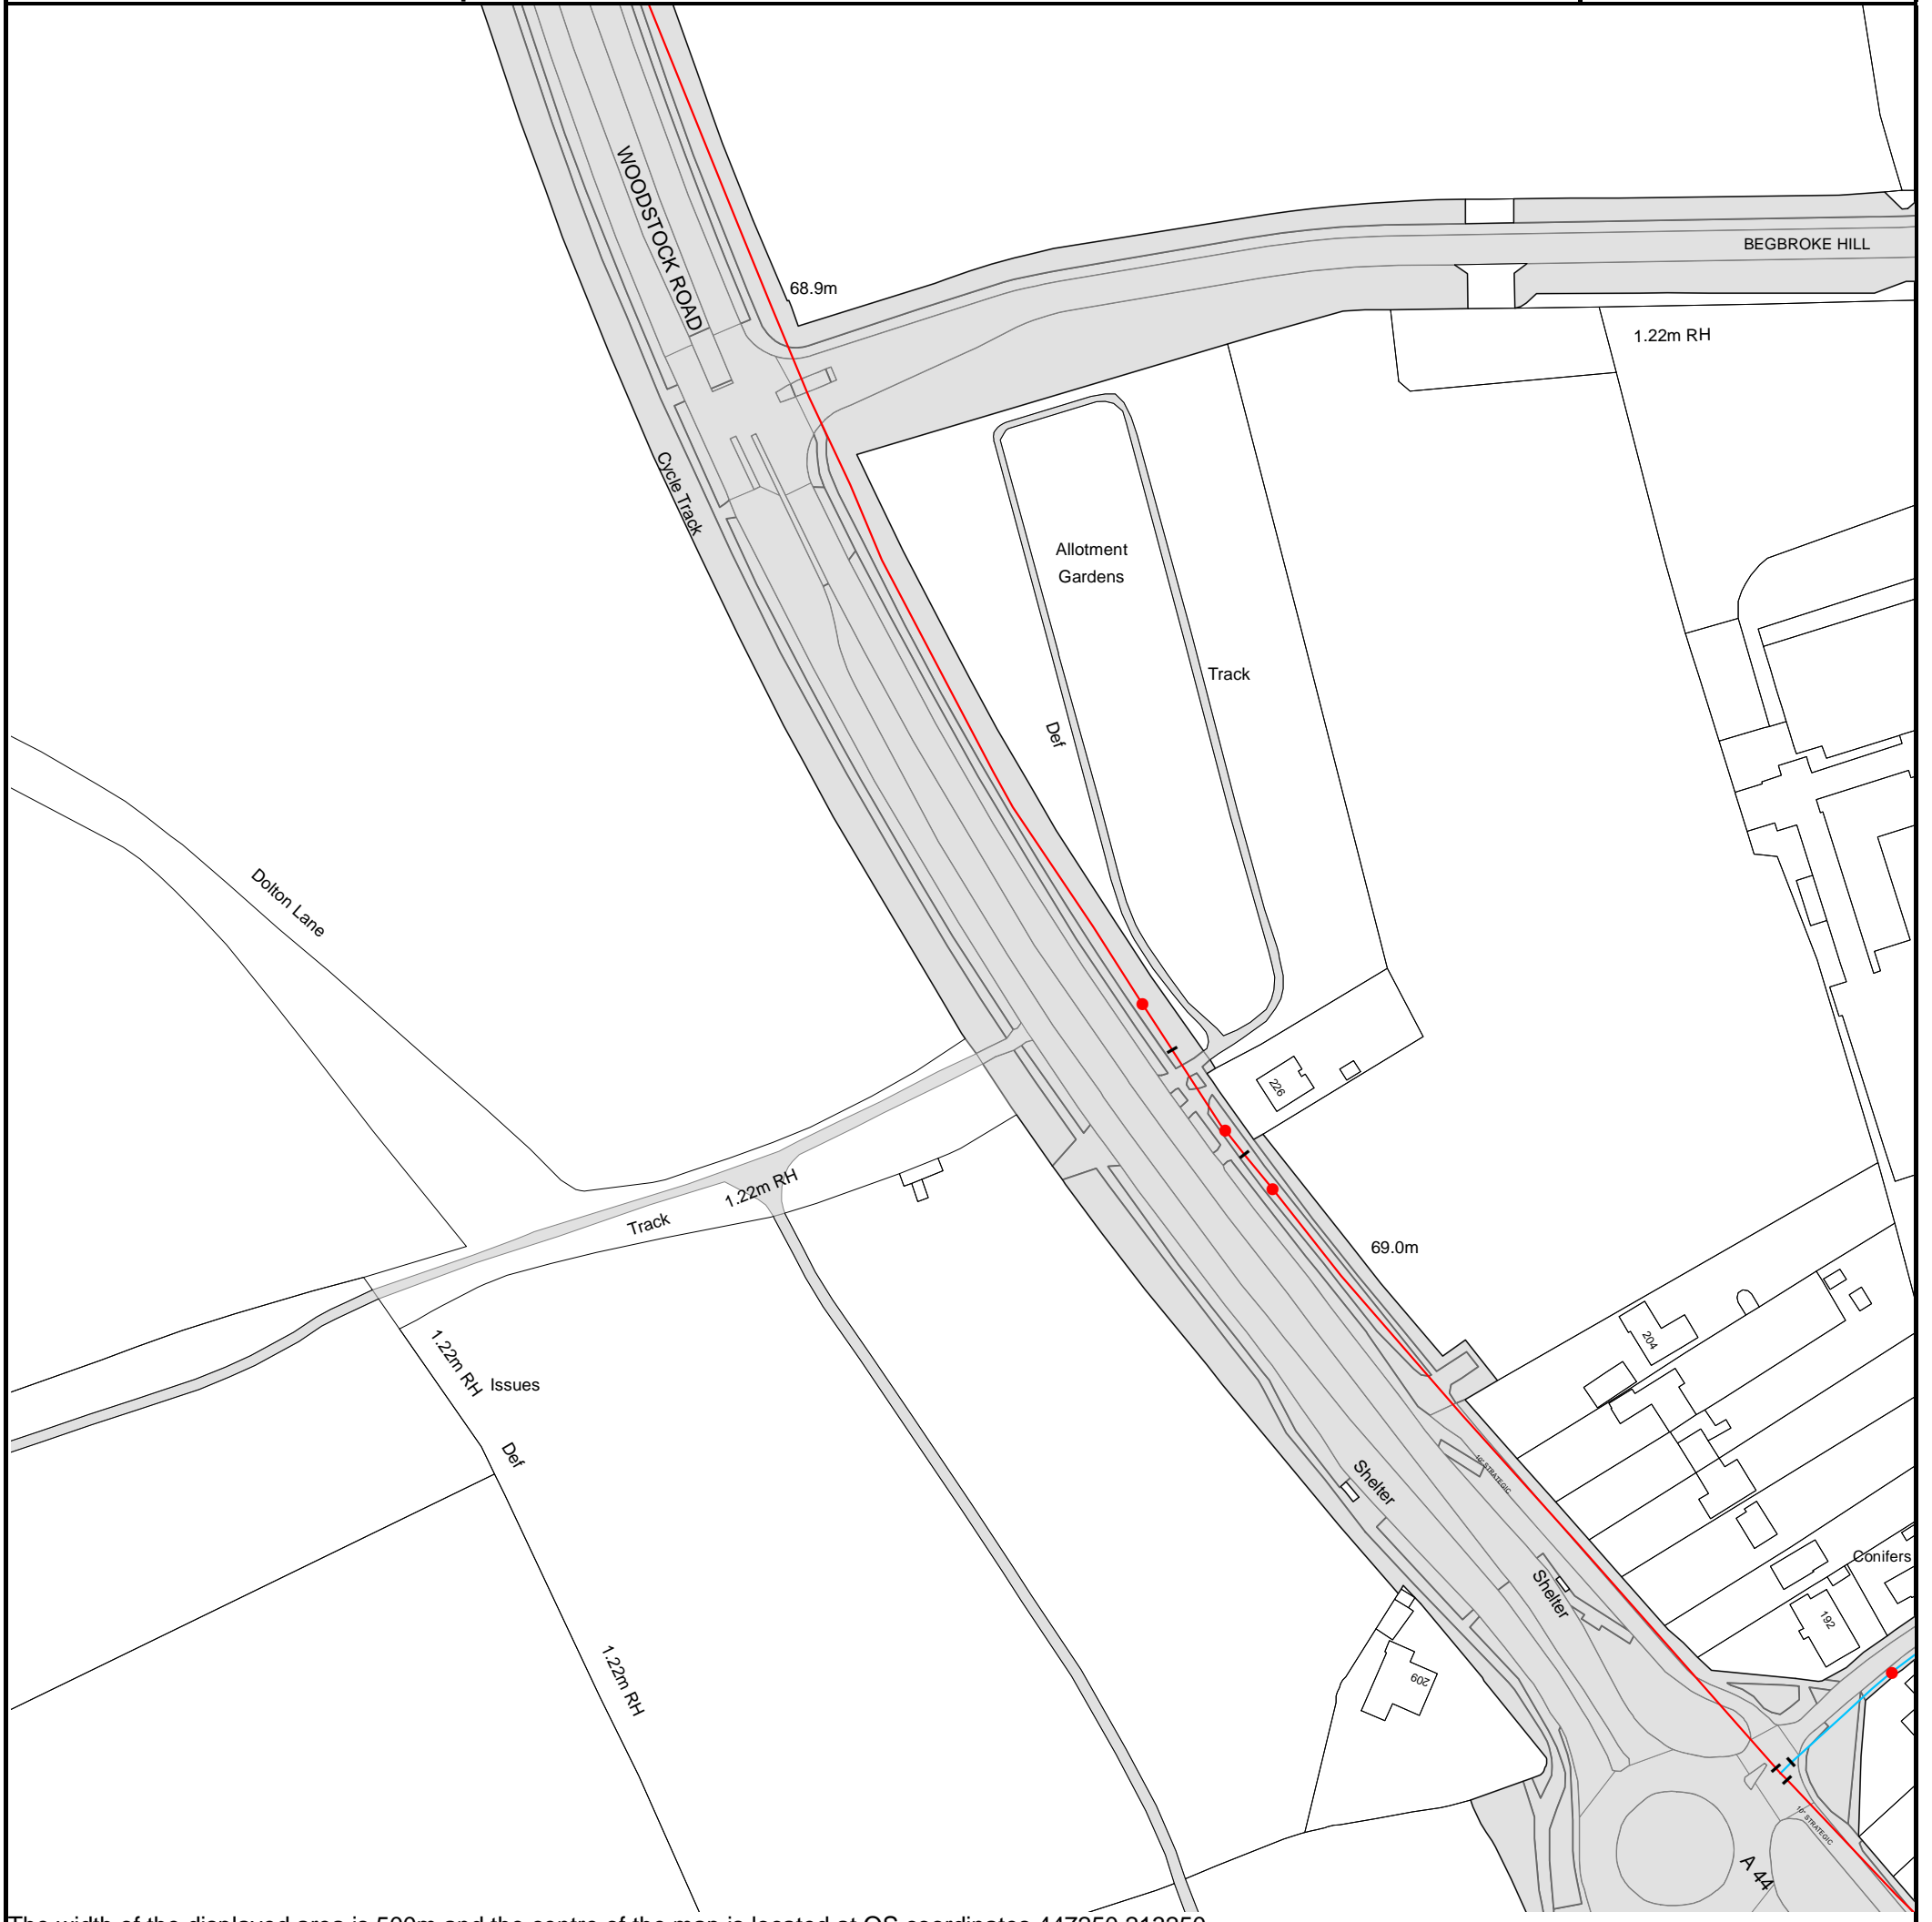

The width of the displayed area is 500m and the centre of the map is located at OS coordinates 447250,213250
The position of the apparatus shown on this plan is given without obligation and warranty, and the accuracy cannot be guaranteed. Service pipes are not shown but their presence should be anticipated. No liability of any kind whatsoever is accepted by Thames Water for any error or omission. The actual position of mains and services must be verified and established on site before any works are undertaken.
Based on the Ordnance Survey Map (2020) with the Sanction of the controller of H.M. Stationery Office, License no. 100019345 Crown Copyright Reserved.



The width of the displayed area is 500m and the centre of the map is located at OS coordinates 448250,213750
The position of the apparatus shown on this plan is given without obligation and warranty, and the accuracy cannot be guaranteed. Service pipes are not shown but their presence should be anticipated. No liability of any kind whatsoever is accepted by Thames Water for any error or omission. The actual position of mains and services must be verified and established on site before any works are undertaken.
Based on the Ordnance Survey Map (2020) with the Sanction of the controller of H.M. Stationery Office, License no. 100019345 Crown Copyright Reserved.

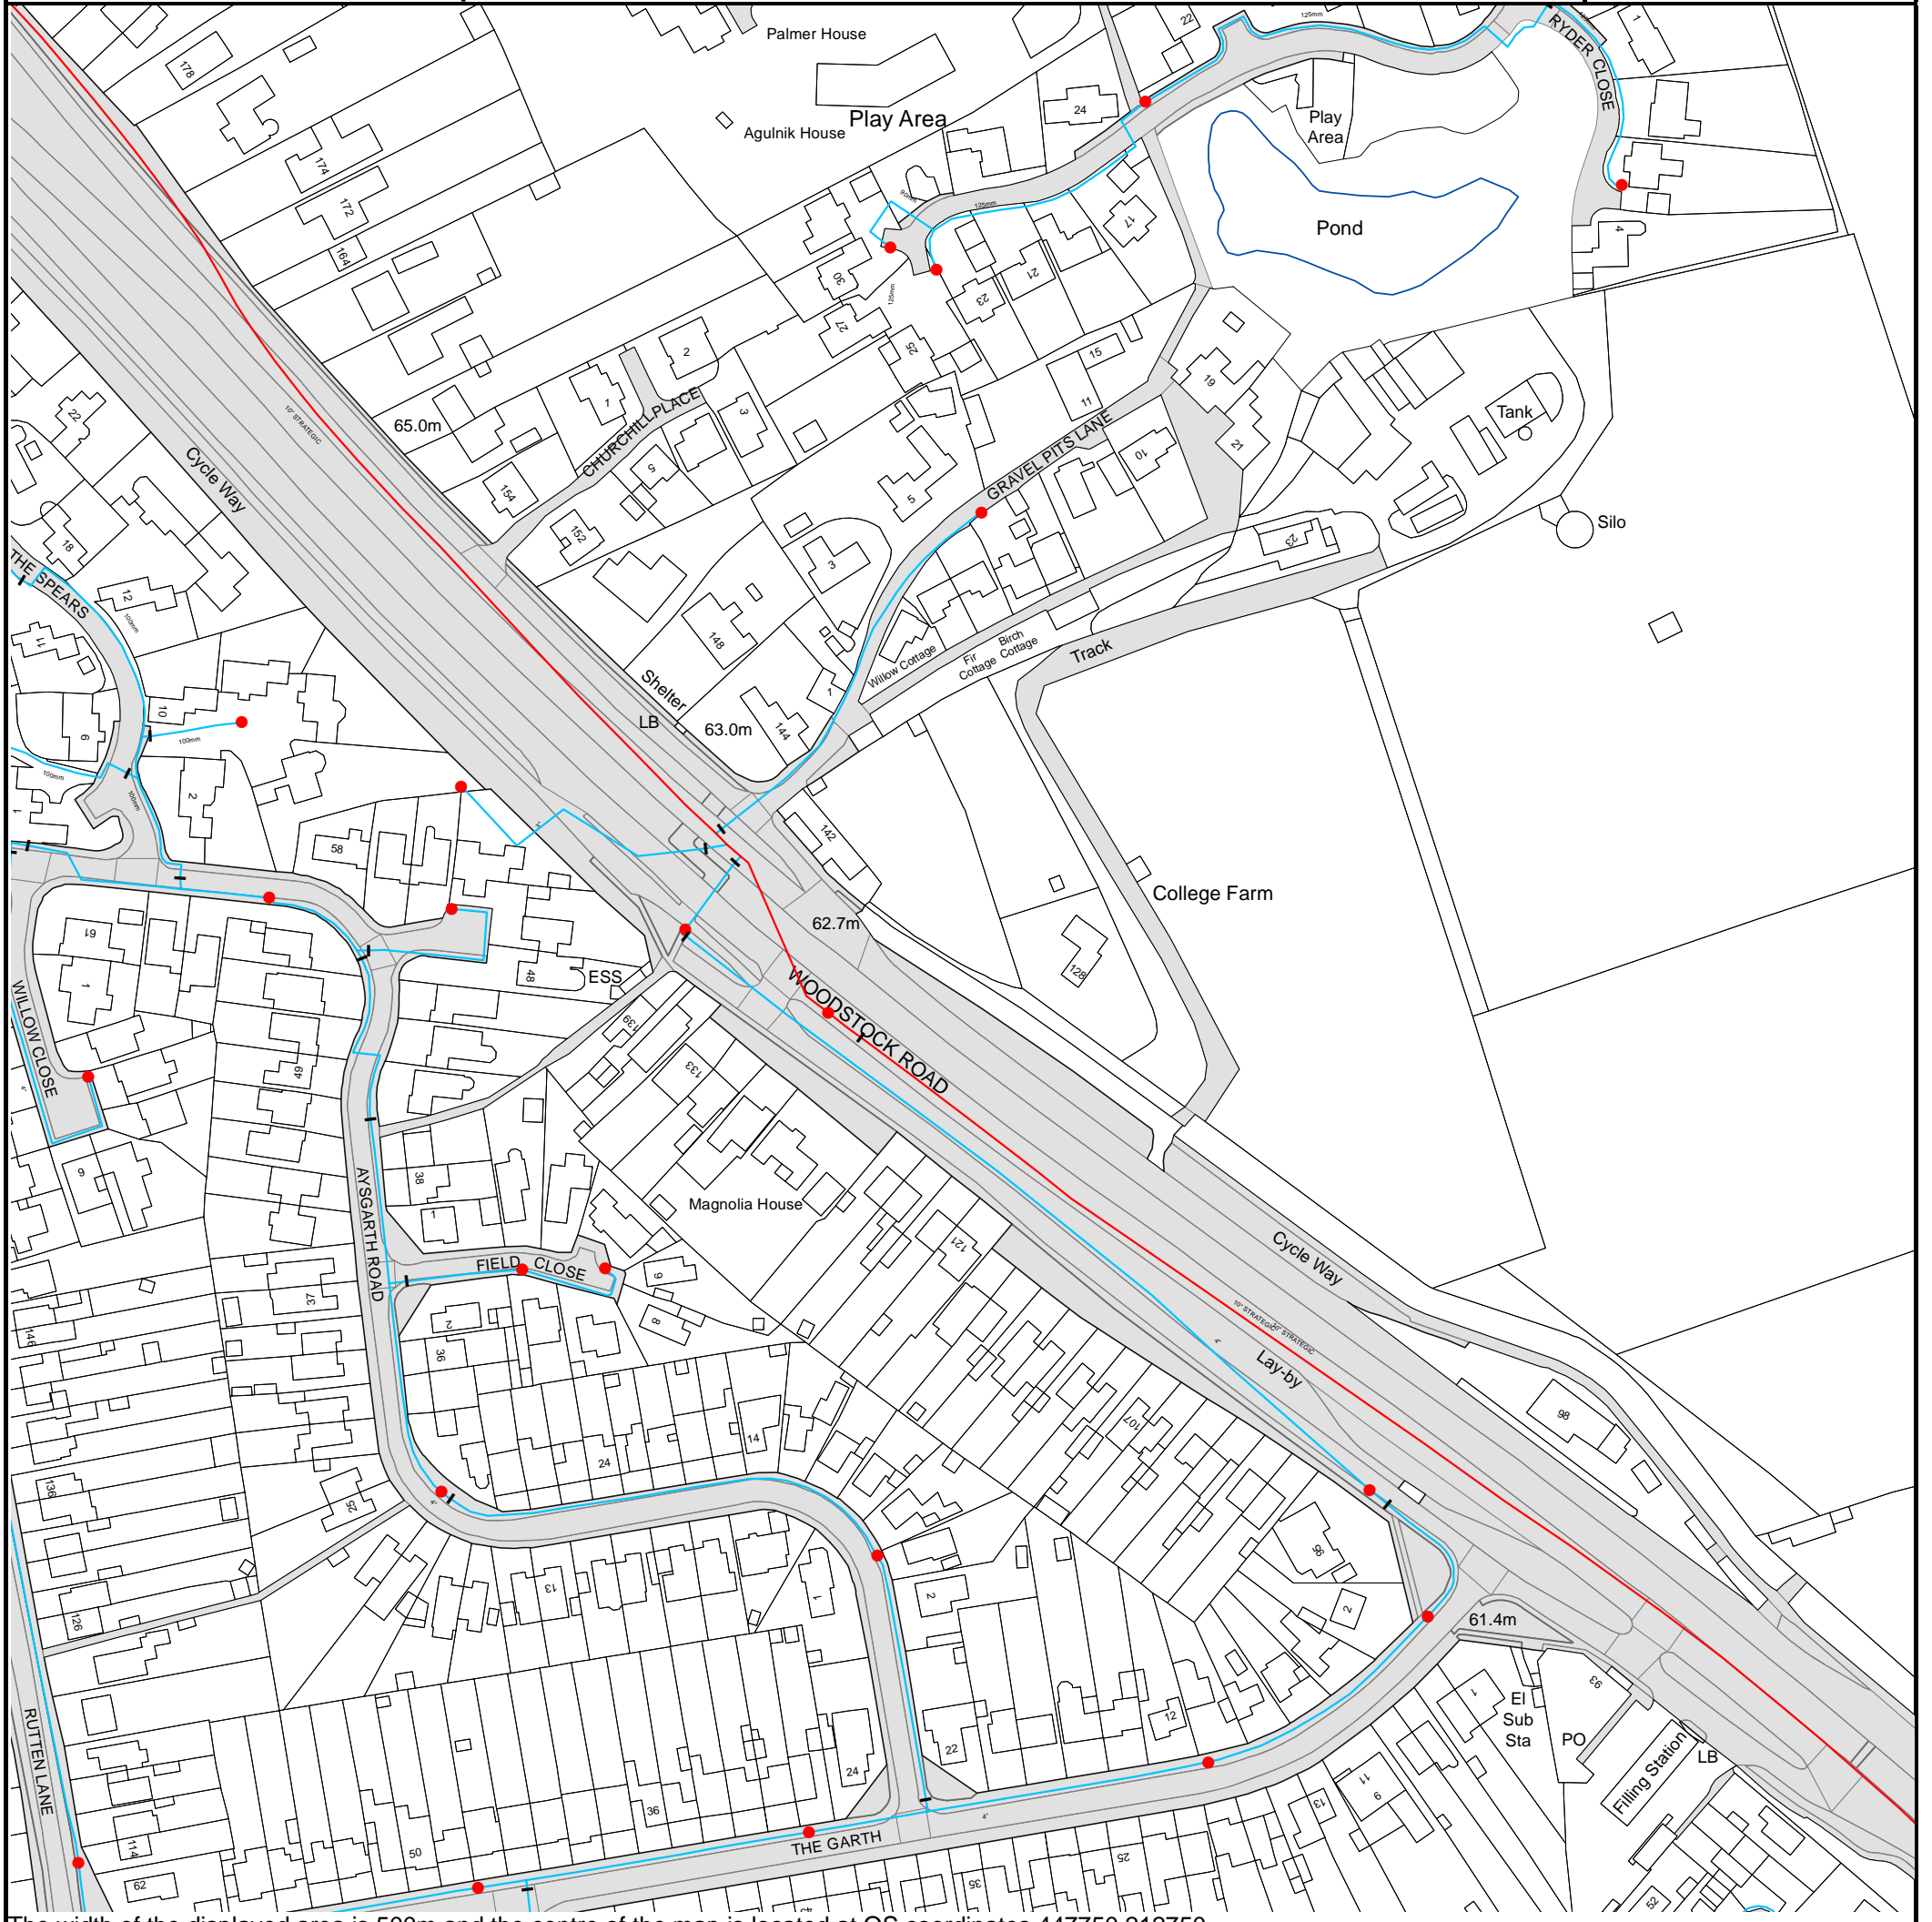

The width of the displayed area is 500m and the centre of the map is located at OS coordinates 447750,212750
The position of the apparatus shown on this plan is given without obligation and warranty, and the accuracy cannot be guaranteed. Service pipes are not shown but their presence should be anticipated. No liability of any kind whatsoever is accepted by Thames Water for any error or omission. The actual position of mains and services must be verified and established on site before any works are undertaken.
Based on the Ordnance Survey Map (2020) with the Sanction of the controller of H.M. Stationery Office, License no. 100019345 Crown Copyright Reserved.