

Warning: PDF designed for A4 colour print only with no page scaling



20m Dig Sites Area: Line:

Date Requested: 24/06/2022
 Job Reference: 25881010
 Site Location: 448066 213346
 Requested by: Mr Joe Shawyer
 Your Scheme/Reference: 31188_002

Voltages (V)			
LV (Low Voltage) and Services	Up to 1,000V		
HV (High Voltage)	Over 1,000V to 11,000V		
EHV (Extra High Voltage)	22,000V to 132,000V		
Transmission	275,000V and 400,000V		
NORMAL DEPTH TO THE TOP OF THE CABLE WHEN LAID			
Services	LV	HV	EHV
Footpath/Unmade	0.45m	0.45m	0.6m
Road Crossing	0.6m	0.6m	0.75m
Agricultural	1m	1m	1.1m

Legend	
	Service Cable
	LV Mains
	6.6kV
	11kV
	22kV
	33kV
	66kV
	132kV
	275kV
	400kV
	Fibre Optic
	Road Cable

Distribution Structures (Electric)	
	Pole, Existing Location
	Pole Structure, Existing Location - Single
	Pole Structure, Existing Location - 4
	Duct Route
	Cross Section Route

WARNING
 There may have been subsequent alteration to the surface levels. Trial holes must be undertaken to determine position and depths of cables. HS (G) 47 Booklet from the Health and Safety Executive - Avoiding Danger from Buried Cables - should be consulted before commencing excavation work.
 WHEN WORKING IN THE VICINITY OF OVERHEAD LINES THE HEALTH AND SAFETY GUIDANCE NOTES G56 SHOULD BE CONSULTED (AVAILABLE FROM THE HSE WEBSITE)




Southern Electric Power Distribution plc
 Registered Office: No.1 Forbury Place
 43 Forbury Road Reading RG1 3JH
 Registered In England & Wales No.04094290

If you're unsure & need to seek advice before commencing excavations, please contact:
 General Enquiries: 0800 048 3516

Subject to revision - Master held by SSEN Asset Data Team:
Asset.Data@sse.com
 01256 337 294

Scale: 1:500 (When plotted at A4)

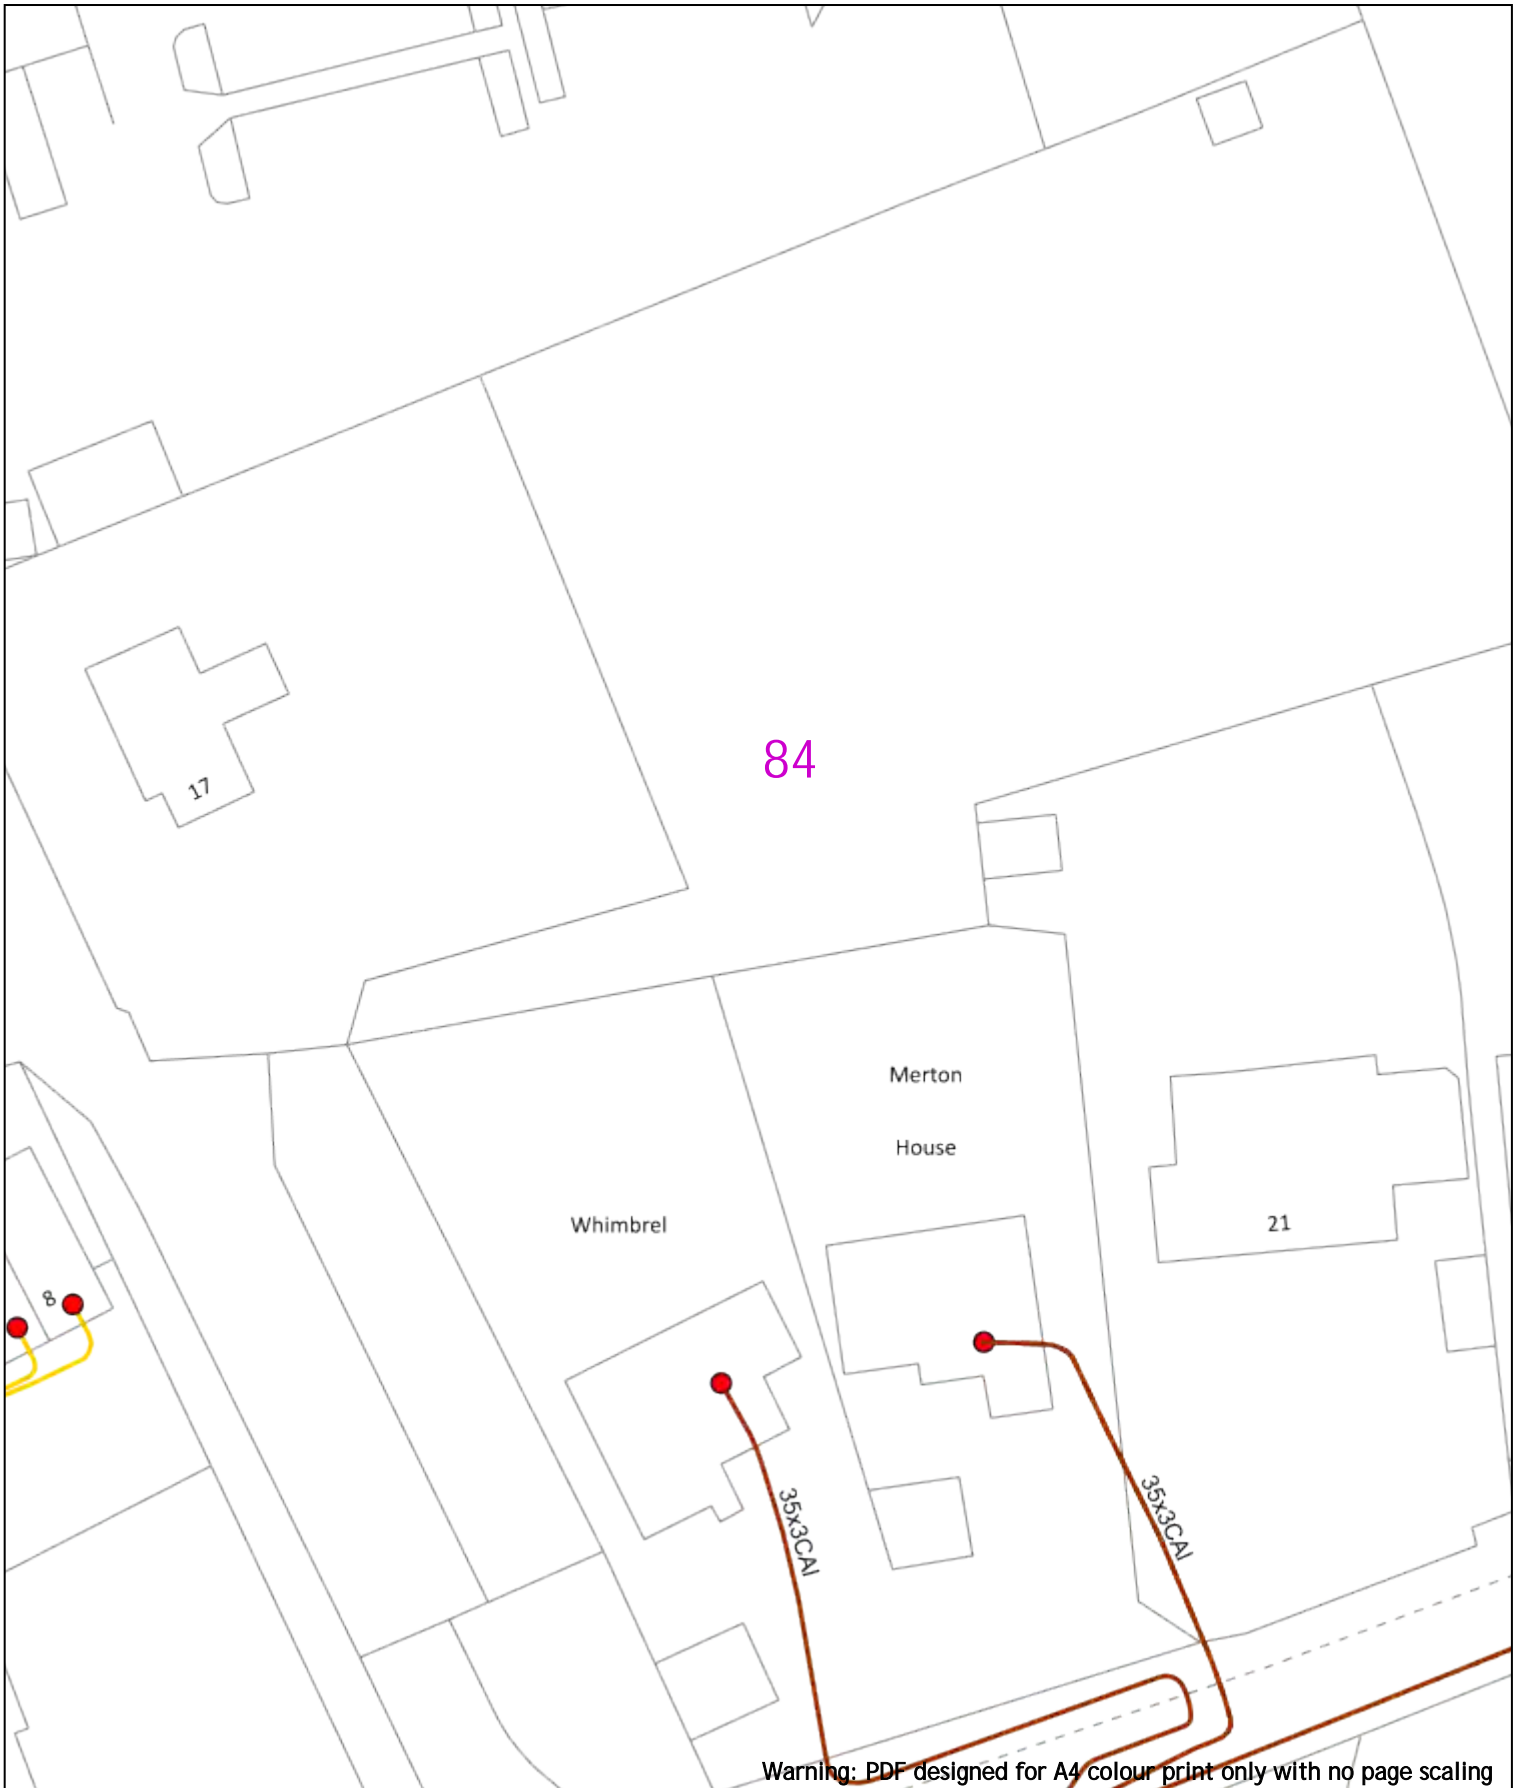

Warning: PDF designed for A4 colour print only with no page scaling

0 20m Dig Sites Area: Line:

Date Requested: 24/06/2022
 Job Reference: 25881010
 Site Location: 448066 213346
 Requested by: Mr Joe Shawyer
 Your Scheme/Reference: 31188_002

Voltages (V)			
LV (Low Voltage) and Services	Up to 1,000V		
HV (High Voltage)	Over 1,000V to 11,000V		
EHV (Extra High Voltage)	22,000V to 132,000V		
Transmission	275,000V and 400,000V		
NORMAL DEPTH TO THE TOP OF THE CABLE WHEN LAID			
Services	LV	HV	EHV
Footpath/Unmade	0.45m	0.45m	0.6m
Road Crossing	0.6m	0.6m	0.75m
Agricultural	1m	1m	1.1m

Legend		Distribution Structures (Electric)	
	Service Cable		Pole, Existing Location
	LV Mains		Pole Structure, Existing Location - Single
	2-13kV		Pole Structure, Existing Location - 1+
	6.6kV		Duct Route
	11kV		Cross Section Route
	22kV		
	33kV		
	66kV		
	132kV		
	275kV		
	400kV		
	Fibre Optic		
	Rigid Cable		


WARNING
 There may have been subsequent alteration to the surface levels. Trial holes must be undertaken to determine position and depths of cables. HS (G) 47 Booklet from the Health and Safety Executive - Avoiding Danger from Buried Cables - should be consulted before commencing excavation work.
 WHEN WORKING IN THE VICINITY OF OVERHEAD LINES THE HEALTH AND SAFETY GUIDANCE NOTES G56 SHOULD BE CONSULTED (AVAILABLE FROM THE HSE WEBSITE)

Scale: 1:500 (When plotted at A4)

Southern Electric Power Distribution plc
 Registered Office: No.1 Forbury Place
 43 Forbury Road Reading RG1 3JH
 Registered In England & Wales No.04094290

If you're unsure & need to seek advice before commencing excavations, please contact:
 General Enquiries: 0800 048 3516

Subject to revision - Master held by SSEN Asset Data Team:
Asset.Data@sse.com
 01256 337 294

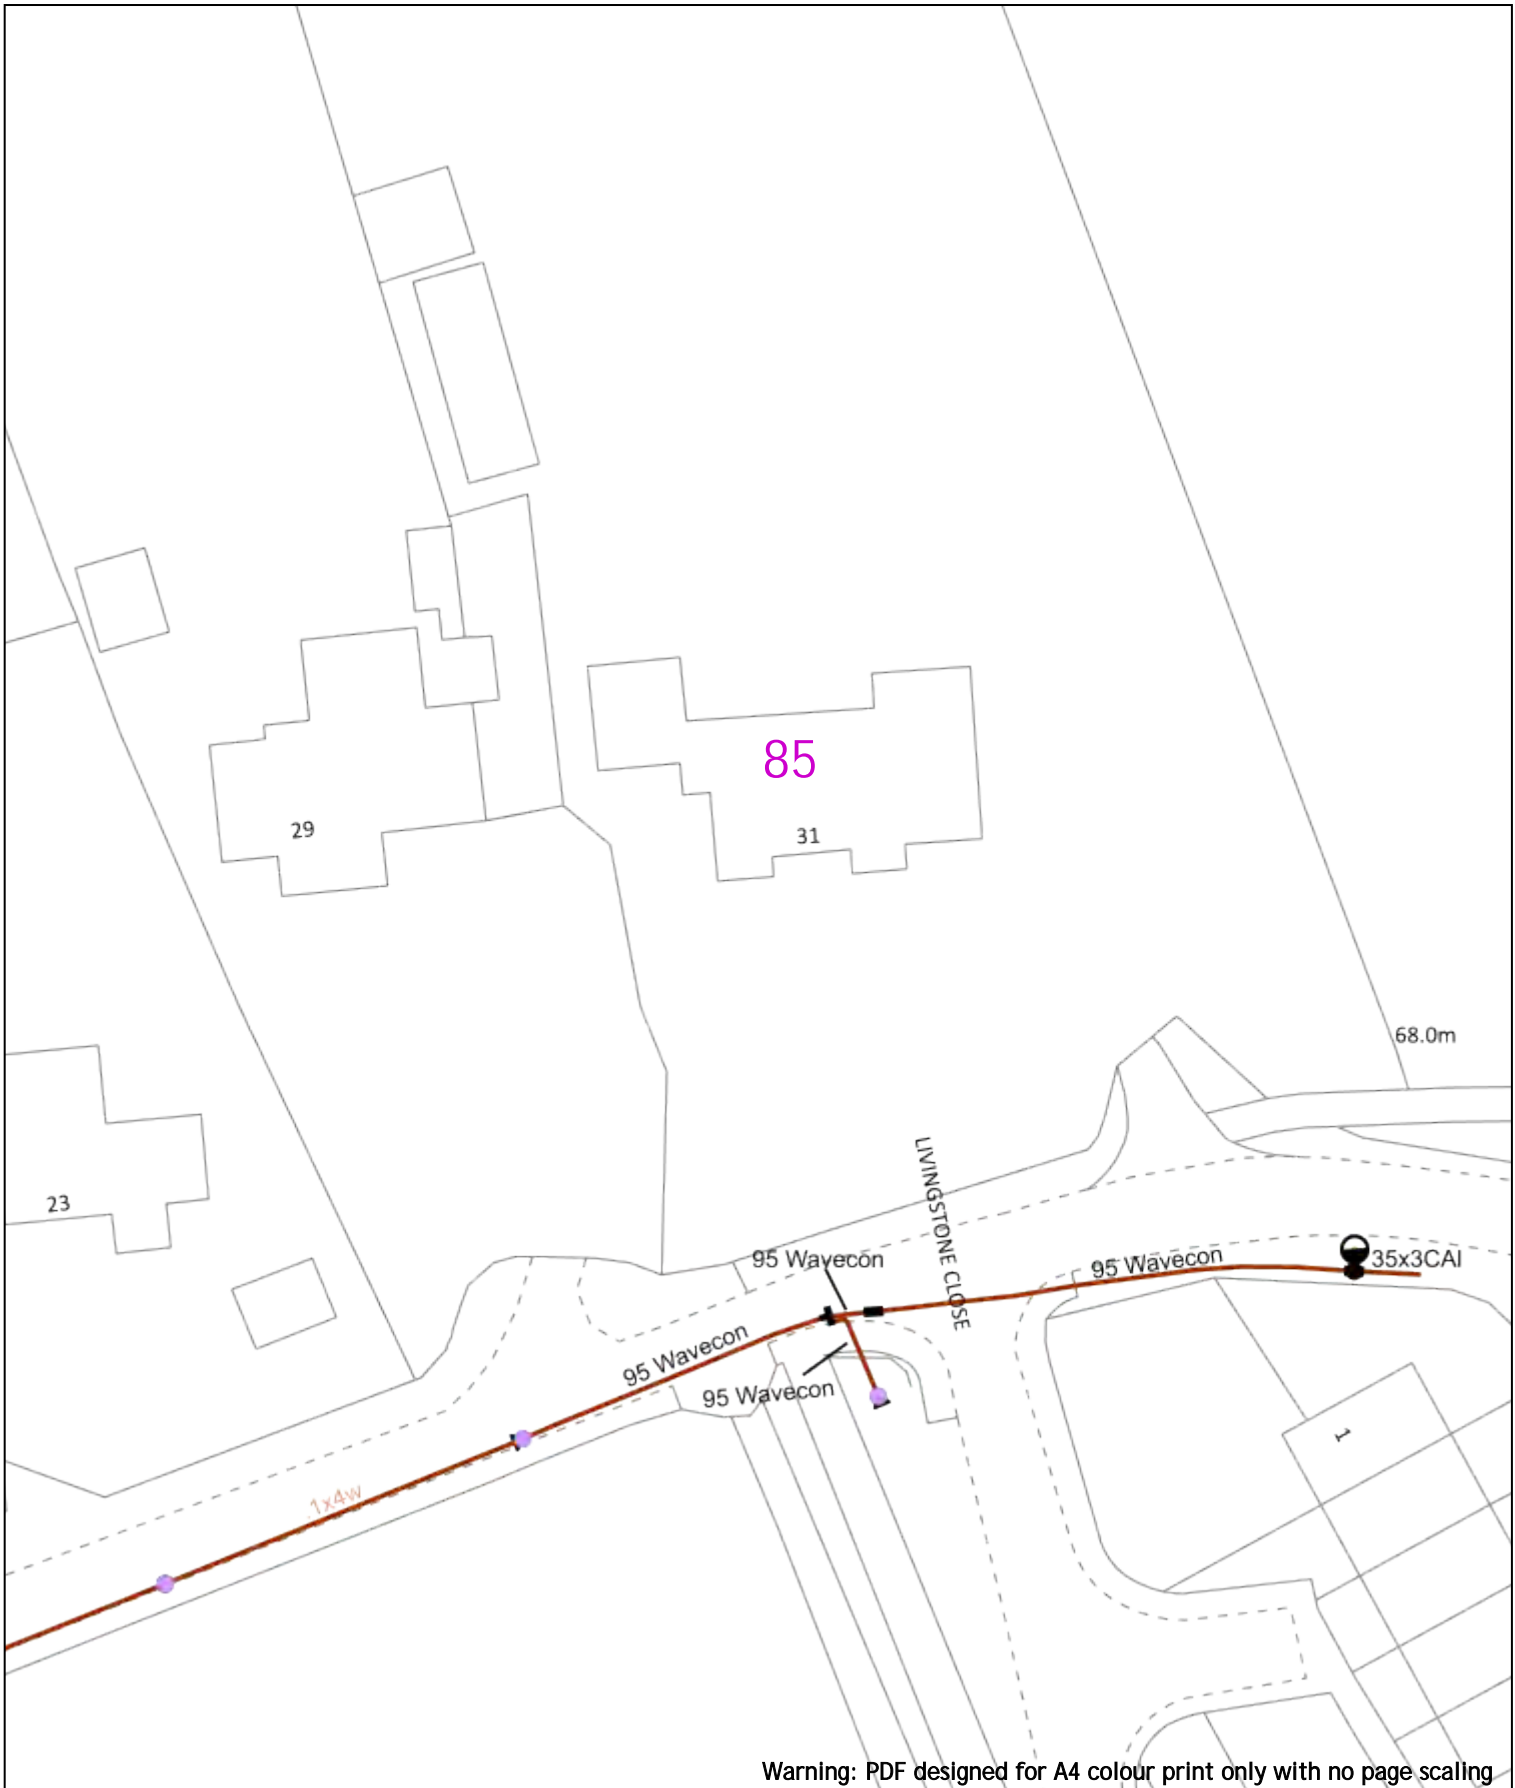

Warning: PDF designed for A4 colour print only with no page scaling



Date Requested: 24/06/2022
 Job Reference: 25881010
 Site Location: 448066 213346
 Requested by: Mr Joe Shawyer
 Your Scheme/Reference: 31188_002

Voltages (V)			
LV (Low Voltage) and Services	Up to 1,000V		
HV (High Voltage)	Over 1,000V to 11,000V		
EHV (Extra High Voltage)	22,000V to 132,000V		
Transmission	275,000V and 400,000V		
NORMAL DEPTH TO THE TOP OF THE CABLE WHEN LAID			
Services	LV	HV	EHV
Footpath/Unmade	0.45m	0.45m	0.6m
Road Crossing	0.6m	0.6m	0.75m
Agricultural	1m	1m	1.1m

Legend

- Service Cable
- LV Main
- 2-33kV
- 6.6kV
- 11kV
- 22kV
- 33kV
- 66kV
- 132kV
- 275kV
- 400kV
- Fibre Optic
- Pilot Cable

Distribution Structures (Electric)

- Pole, Existing Location
- Pole Structure, Existing Location - Single
- Pole Structure, Existing Location - H
- Duct Route
- Cross Section Route

Scale: 1:500 (When plotted at A4)

WARNING
 There may have been subsequent alteration to the surface levels. Trial holes must be undertaken to determine position and depths of cables. HS (G) 47 Booklet from the Health and Safety Executive - Avoiding Danger from Buried Cables - should be consulted before commencing excavation work.
 WHEN WORKING IN THE VICINITY OF OVERHEAD LINES THE HEALTH AND SAFETY GUIDANCE NOTES G56 SHOULD BE CONSULTED (AVAILABLE FROM THE HSE WEBSITE)





Southern Electric Power Distribution plc
 Registered Office: No.1 Forbury Place
 43 Forbury Road Reading RG1 3JH
 Registered In England & Wales No.04094290

If you're unsure & need to seek advice before commencing excavations, please contact:
 General Enquiries: 0800 048 3516

Subject to revision - Master held by SSEN Asset Data Team:
Asset.Data@sse.com
 01256 337 294

69.0m

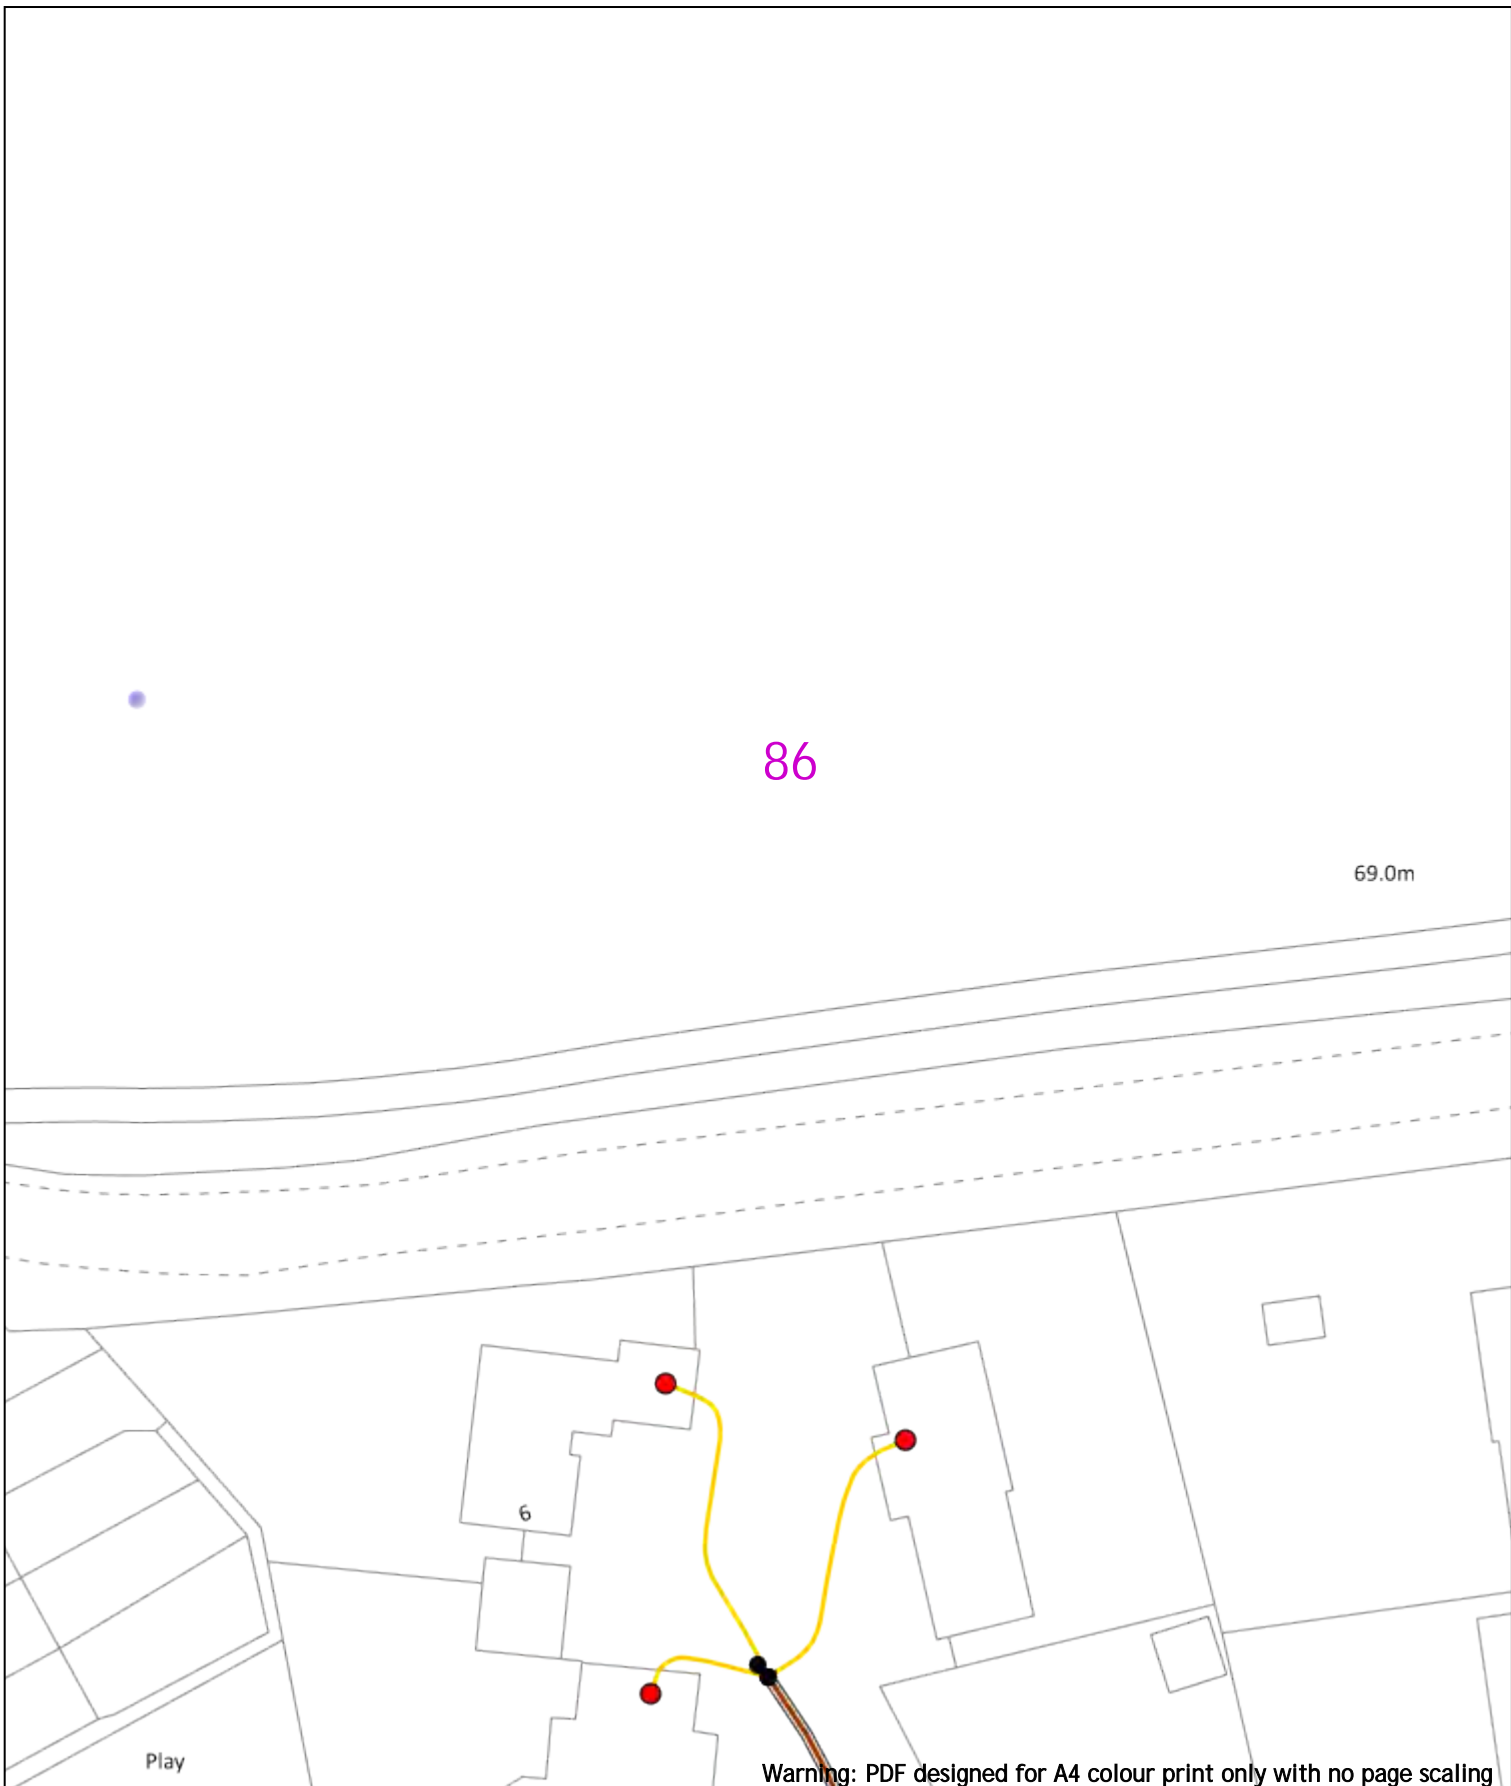

0 20m Dig Sites Area: Line:

Date Requested: 24/06/2022
 Job Reference: 25881010
 Site Location: 448066 213346
 Requested by: Mr Joe Shawyer
 Your Scheme/Reference: 31188_002

Voltages (V)				
LV (Low Voltage) and Services	Up to 1,000V			
HV (High Voltage)	Over 1,000V to 11,000V			
EHV (Extra High Voltage)	22,000V to 132,000V			
Transmission	275,000V and 400,000V			

NORMAL DEPTH TO THE TOP OF THE CABLE WHEN LAID				
Services	LV	HV	EHV	
Footpath/Unmade	0.45m	0.45m	0.6m	0.8m
Road Crossing	0.6m	0.6m	0.75m	0.9m
Agricultural	1m	1m	1m	1.1m

Legend

- Service Cable
- LV Main
- 6.6kV
- 11kV
- 22kV
- 33kV
- 66kV
- 132kV
- 275kV
- 400kV
- Fibre Optic
- Riser Cable

Distribution Structures (Electric)

- Pole, Existing Location
- Pole Structure, Existing Location - Single
- Pole Structure, Existing Location - H
- Duct Route
- Cross Section Route

WARNING

There may have been subsequent alteration to the surface levels. Trial holes must be undertaken to determine position and depths of cables. HS (G) 47 Booklet from the Health and Safety Executive - Avoiding Danger from Buried Cables - should be consulted before commencing excavation work.


WHEN WORKING IN THE VICINITY OF OVERHEAD LINES THE HEALTH AND SAFETY GUIDANCE NOTES G56 SHOULD BE CONSULTED (AVAILABLE FROM THE HSE WEBSITE)

Southern Electric Power Distribution plc

Registered Office: No.1 Forbury Place
 43 Forbury Road Reading RG1 3JH
 Registered In England & Wales No.04094290

If you're unsure & need to seek advice before commencing excavations, please contact:
 General Enquiries: 0800 048 3516

Subject to revision - Master held by SSEN Asset Data Team:
Asset.Data@sse.com
 01256 337 294

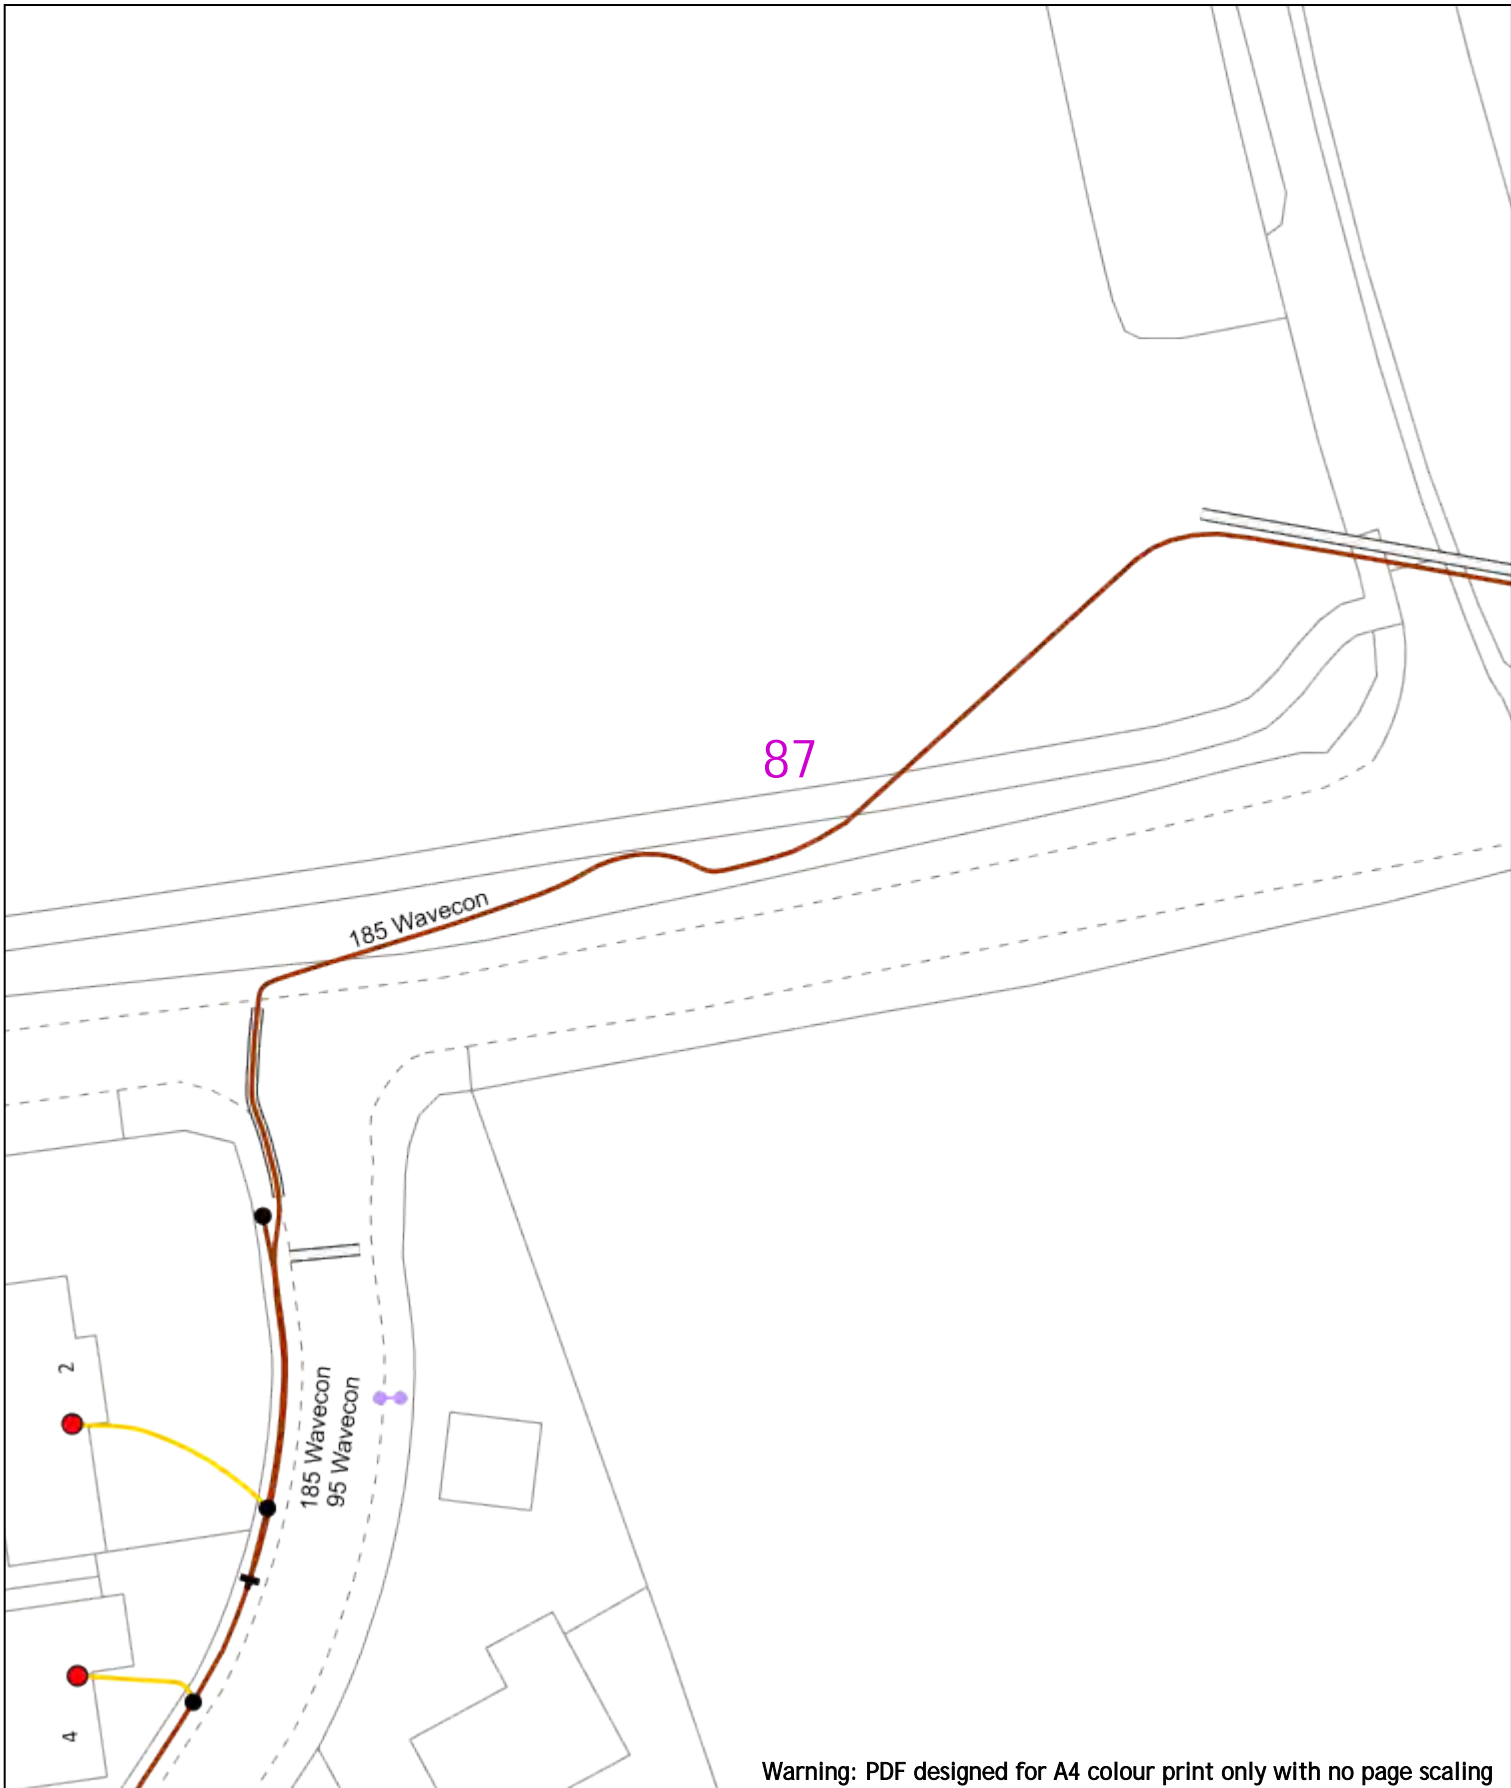

Warning: PDF designed for A4 colour print only with no page scaling

0 20m Dig Sites Area: Line:

Date Requested: 24/06/2022
 Job Reference: 25881010
 Site Location: 448066 213346
 Requested by: Mr Joe Shawyer
 Your Scheme/Reference: 31188_002

Voltages (V)	
LV (Low Voltage) and Services	Up to 1,000V
HV (High Voltage)	Over 1,000V to 11,000V
EHV (Extra High Voltage)	22,000V to 132,000V
Transmission	275,000V and 400,000V

NORMAL DEPTH TO THE TOP OF THE CABLE WHEN LAID	Services			
	LV	HV	HV	EHV
Footpath/Unmade	0.45m	0.45m	0.6m	0.8m
Road Crossing	0.6m	0.6m	0.75m	0.9m
Agricultural	1m	1m	1m	1.1m

Legend

- Service Cable
- LV Main
- 2-138kV
- 6.6kV
- 11kV
- 22kV
- 33kV
- 66kV
- 132kV
- 275kV
- 400kV
- Fibre Optic
- Road Cable

Distribution Structures (Electric)

- Pole, Existing Location
- Pole Structure, Existing Location - Single
- Pole Structure, Existing Location - H
- Duct Route
- Cross Section Route

WARNING
 There may have been subsequent alteration to the surface levels. Trial holes must be undertaken to determine position and depths of cables. HS (G) 47 Booklet from the Health and Safety Executive - Avoiding Danger from Buried Cables - should be consulted before commencing excavation work.
 WHEN WORKING IN THE VICINITY OF OVERHEAD LINES THE HEALTH AND SAFETY GUIDANCE NOTES G56 SHOULD BE CONSULTED (AVAILABLE FROM THE HSE WEBSITE)


Scale: 1:500 (When plotted at A4)

Southern Electric Power Distribution plc
 Registered Office: No.1 Forbury Place
 43 Forbury Road Reading RG1 3JH
 Registered In England & Wales No.04094290

If you're unsure & need to seek advice before commencing excavations, please contact:
 General Enquiries: 0800 048 3516

Subject to revision - Master held by SSEN Asset Data Team:
Asset.Data@sse.com
 01256 337 294

BASED UPON THE ORDNANCE SURVEY MAP WITH THE SANCTION OF THE CONTROLLER OF H.M. STATIONERY OFFICE CROWN COPYRIGHT RESERVED.
 This copy has been made by or with the authority of Scottish and Southern Energy Power Distribution Ltd. Pursuant to section 47 of the Copyright, Designs and Patents Act 1988 ("The Act"). Unless the Act provides a relevant exception to copyright the copy must not be copied without prior permission of the copyright owner.
 Plans generated by DigSAFE Pro™ software provided by Lineasearchbeforedig.

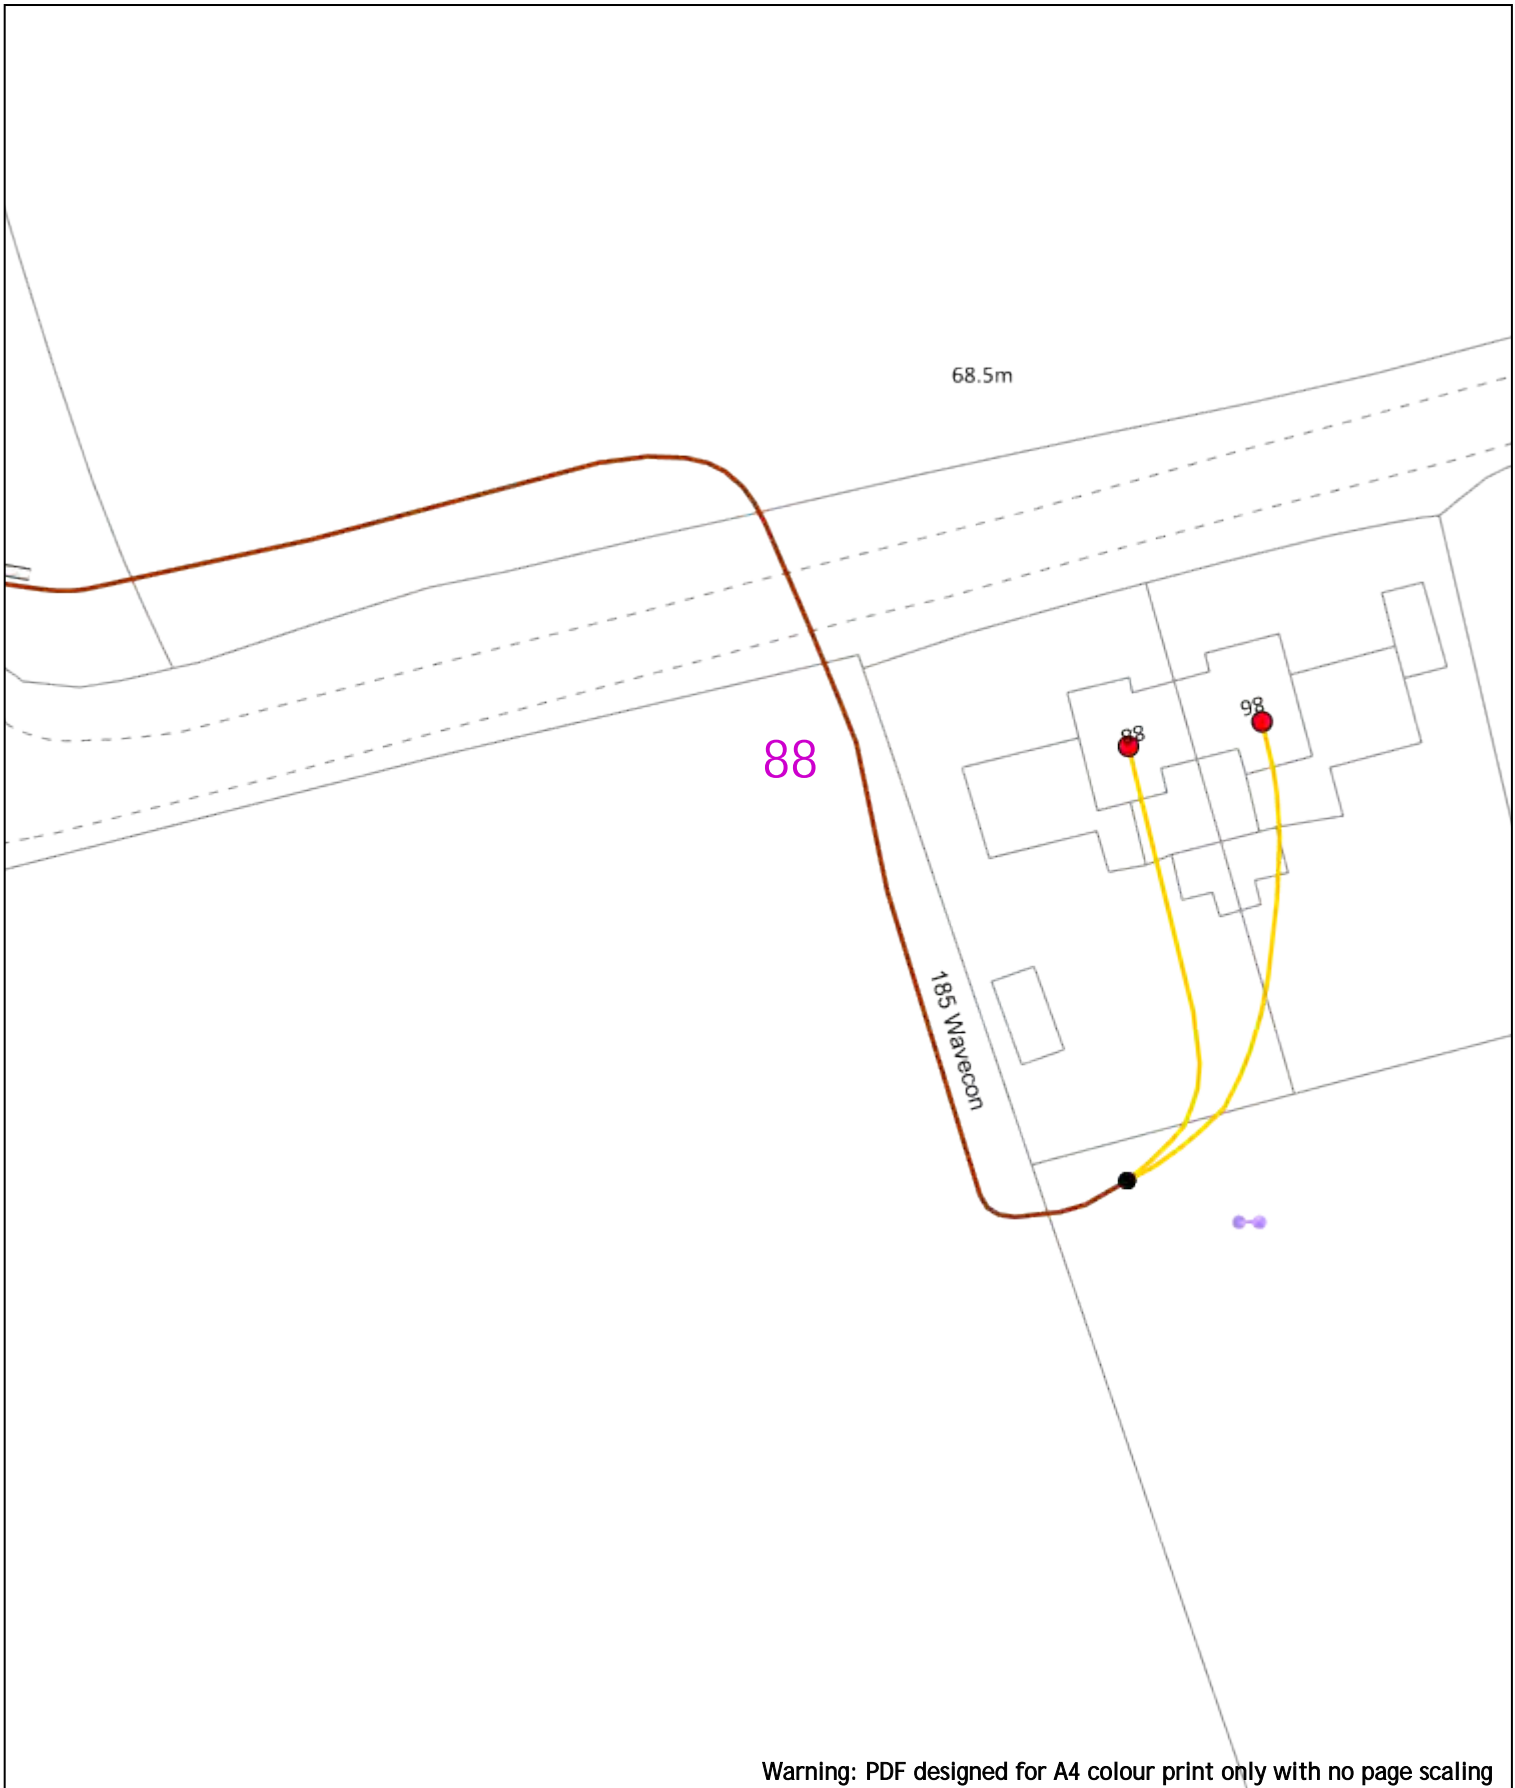




Warning: PDF designed for A4 colour print only with no page scaling

<p>0 20m Dig Sites Area: Line: </p>	<p>Date Requested: 24/06/2022 Job Reference: 25881010 Site Location: 448066 213346 Requested by: Mr Joe Shawyer Your Scheme/Reference: 31188_002</p>	<table border="1" style="width: 100%; border-collapse: collapse;"> <thead> <tr> <th colspan="4">Voltages (V)</th> </tr> </thead> <tbody> <tr> <td>LV (Low Voltage) and Services</td> <td colspan="3">Up to 1,000V</td> </tr> <tr> <td>HV (High Voltage)</td> <td colspan="3">Over 1,000V to 11,000V</td> </tr> <tr> <td>EHV (Extra High Voltage)</td> <td colspan="3">22,000V to 132,000V</td> </tr> <tr> <td>Transmission</td> <td colspan="3">275,000V and 400,000V</td> </tr> <tr> <th colspan="4">NORMAL DEPTH TO THE TOP OF THE CABLE WHEN LAID</th> </tr> <tr> <td>Services</td> <td>LV</td> <td>HV</td> <td>EHV</td> </tr> <tr> <td>Footpath/Unmade</td> <td>0.45m</td> <td>0.45m</td> <td>0.6m</td> </tr> <tr> <td>Road Crossing</td> <td>0.6m</td> <td>0.6m</td> <td>0.75m</td> </tr> <tr> <td>Agricultural</td> <td>1m</td> <td>1m</td> <td>1.1m</td> </tr> </tbody> </table>	Voltages (V)				LV (Low Voltage) and Services	Up to 1,000V			HV (High Voltage)	Over 1,000V to 11,000V			EHV (Extra High Voltage)	22,000V to 132,000V			Transmission	275,000V and 400,000V			NORMAL DEPTH TO THE TOP OF THE CABLE WHEN LAID				Services	LV	HV	EHV	Footpath/Unmade	0.45m	0.45m	0.6m	Road Crossing	0.6m	0.6m	0.75m	Agricultural	1m	1m	1.1m	<table border="1" style="width: 100%; border-collapse: collapse;"> <thead> <tr> <th colspan="2">Legend</th> </tr> </thead> <tbody> <tr> <td></td> <td>Service Cable</td> </tr> <tr> <td></td> <td>LV Mains</td> </tr> <tr> <td></td> <td>2-33kV</td> </tr> <tr> <td></td> <td>6.6kV</td> </tr> <tr> <td></td> <td>11kV</td> </tr> <tr> <td></td> <td>22kV</td> </tr> <tr> <td></td> <td>33kV</td> </tr> <tr> <td></td> <td>66kV</td> </tr> <tr> <td></td> <td>132kV</td> </tr> <tr> <td></td> <td>275kV</td> </tr> <tr> <td></td> <td>400kV</td> </tr> <tr> <td></td> <td>Fibre Optic</td> </tr> <tr> <td></td> <td>Road Cable</td> </tr> </tbody> </table> <table border="1" style="width: 100%; border-collapse: collapse;"> <thead> <tr> <th colspan="2">Distribution Structures (Electric)</th> </tr> </thead> <tbody> <tr> <td></td> <td>Pole, Existing Location</td> </tr> <tr> <td></td> <td>Pole Structure, Existing Location - Single</td> </tr> <tr> <td></td> <td>Pole Structure, Existing Location - H</td> </tr> <tr> <td></td> <td>Duct Route</td> </tr> <tr> <td></td> <td>Cross Section Route</td> </tr> </tbody> </table>	Legend			Service Cable		LV Mains		2-33kV		6.6kV		11kV		22kV		33kV		66kV		132kV		275kV		400kV		Fibre Optic		Road Cable	Distribution Structures (Electric)			Pole, Existing Location		Pole Structure, Existing Location - Single		Pole Structure, Existing Location - H		Duct Route		Cross Section Route
Voltages (V)	
LV (Low Voltage) and Services	Up to 1,000V	
HV (High Voltage)	Over 1,000V to 11,000V	
EHV (Extra High Voltage)	22,000V to 132,000V	
Transmission	275,000V and 400,000V	
NORMAL DEPTH TO THE TOP OF THE CABLE WHEN LAID	
Services	LV	HV	EHV	
Footpath/Unmade	0.45m	0.45m	0.6m	
Road Crossing	0.6m	0.6m	0.75m	
Agricultural	1m	1m	1.1m	
Legend	
	Service Cable	
	LV Mains	
	2-33kV	
	6.6kV	
	11kV	
	22kV	
	33kV	
	66kV	
	132kV	
	275kV	
	400kV	
	Fibre Optic	
	Road Cable	
Distribution Structures (Electric)	
	Pole, Existing Location	
	Pole Structure, Existing Location - Single	
	Pole Structure, Existing Location - H	
	Duct Route	
	Cross Section Route	
<p>Scale: 1:500 (When plotted at A4)</p>		<p>WARNING</p> <p>There may have been subsequent alteration to the surface levels. Trial holes must be undertaken to determine position and depths of cables. HS (G) 47 Booklet from the Health and Safety Executive - Avoiding Danger from Buried Cables - should be consulted before commencing excavation work.</p> <p>WHEN WORKING IN THE VICINITY OF OVERHEAD LINES THE HEALTH AND SAFETY GUIDANCE NOTES G56 SHOULD BE CONSULTED (AVAILABLE FROM THE HSE WEBSITE)</p>	
<p>0 20m Dig Sites Area: Line: </p>	
<p>Southern Electric Power Distribution plc Registered Office: No.1 Forbury Place 43 Forbury Road Reading RG1 3JH Registered In England & Wales No.04094290</p>		<p>If you're unsure & need to seek advice before commencing excavations, please contact: General Enquiries: 0800 048 3516</p>	
<p>Subject to revision - Master held by SSEN Asset Data Team: Asset.Data@sse.com 01256 337 294</p>		<p>Based upon the Ordnance Survey map with the sanction of the Controller of Her Majesty's Stationery Office Crown Copyright Reserved. This copy has been made by or with the authority of Scottish and Southern Energy Power Distribution Ltd. Pursuant to section 47 of the Copyright, Designs and Patents Act 1988 ("The Act"). Unless the Act provides a relevant exception to copyright the copy must not be copied without prior permission of the copyright owner. Plans generated by DigSAFE Pro™ software provided by Linearcableforeldg.</p>	

68.5m

89

Warning: PDF designed for A4 colour print only with no page scaling

0  20m Dig Sites Area:  Line: 



Date Requested: 24/06/2022
 Job Reference: 25881010
 Site Location: 448066 213346
 Requested by: Mr Joe Shawyer

Your Scheme/Reference: 31188_002

Voltages (V)			
LV (Low Voltage) and Services	Up to 1,000V		
HV (High Voltage)	Over 1,000V to 11,000V		
EHV (Extra High Voltage)	22,000V to 132,000V		
Transmission	275,000V and 400,000V		
NORMAL DEPTH TO THE TOP OF THE CABLE WHEN LAID			
Services	LV	HV	EHV
Footpath/Unmade	0.45m	0.45m	0.6m 0.8m
Road Crossing	0.6m	0.6m	0.75m 0.9m
Agricultural	1m	1m	1m 1.1m

<p>Legend</p> <ul style="list-style-type: none">  Service Cable  LV Mains  2-33kV  6.6kV  11kV  22kV  33kV  66kV  132kV  275kV  400kV  Fibre Optic  Pilot Cable 	<p>Distribution Structures (Electric)</p> <ul style="list-style-type: none">  Pole, Existing Location  Pole Structure, Existing Location - Single  Pole Structure, Existing Location - H  Duct Route  Cross Section Route
--	--

WARNING
 There may have been subsequent alteration to the surface levels. Trial holes must be undertaken to determine position and depths of cables. HS (G) 47 Booklet from the Health and Safety Executive - Avoiding Danger from Buried Cables - should be consulted before commencing excavation work.
WHEN WORKING IN THE VICINITY OF OVERHEAD LINES THE HEALTH AND SAFETY GUIDANCE NOTES G56 SHOULD BE CONSULTED (AVAILABLE FROM THE HSE WEBSITE)

Southern Electric Power Distribution plc
 Registered Office: No.1 Forbury Place
 43 Forbury Road Reading RG1 3JH
 Registered In England & Wales No.04094290

If you're unsure & need to seek advice before commencing excavations, please contact:
 General Enquiries: 0800 048 3516

Subject to revision - Master held by SSEN Asset Data Team:
Asset.Data@sse.com
 01256 337 294

Scale: 1:500 (When plotted at A4)

90














Warning: PDF designed for A4 colour print only with no page scaling

0  20m Dig Sites Area:  Line: 






Date Requested: 24/06/2022
 Job Reference: 25881010
 Site Location: 448066 213346
 Requested by: Mr Joe Shawyer
 Your Scheme/Reference: 31188_002

Voltages (V)			
LV (Low Voltage) and Services	Up to 1,000V		
HV (High Voltage)	Over 1,000V to 11,000V		
EHV (Extra High Voltage)	22,000V to 132,000V		
Transmission	275,000V and 400,000V		
NORMAL DEPTH TO THE TOP OF THE CABLE WHEN LAID			
Services	LV	HV	EHV
Footpath/Unmade	0.45m	0.45m	0.6m
Road Crossing	0.6m	0.6m	0.75m
Agricultural	1m	1m	1.1m

Legend

-  Service Cable
-  LV Mains
-  2-33kV
-  6.6kV
-  11kV
-  22kV
-  33kV
-  66kV
-  132kV
-  275kV
-  400kV
-  Fibre Optic
-  Pilot Cable

Distribution Structures (Electric)

-  Pole, Existing Location
-  Pole Structure, Existing Location - Single
-  Pole Structure, Existing Location - H
-  Duct Route
-  Cross Section Route

WARNING

There may have been subsequent alteration to the surface levels. Trial holes must be undertaken to determine position and depths of cables. HS (G) 47 Booklet from the Health and Safety Executive - Avoiding Danger from Buried Cables - should be consulted before commencing excavation work.


WHEN WORKING IN THE VICINITY OF OVERHEAD LINES THE HEALTH AND SAFETY GUIDANCE NOTES G56 SHOULD BE CONSULTED (AVAILABLE FROM THE HSE WEBSITE)




Southern Electric Power Distribution plc
 Registered Office: No.1 Forbury Place
 43 Forbury Road Reading RG1 3JH
 Registered In England & Wales No.04094290


If you're unsure & need to seek advice before commencing excavations, please contact:
 General Enquiries: 0800 048 3516

Subject to revision – Master held by SSEN Asset Data Team:
Asset.Data@sse.com
 01256 337 294

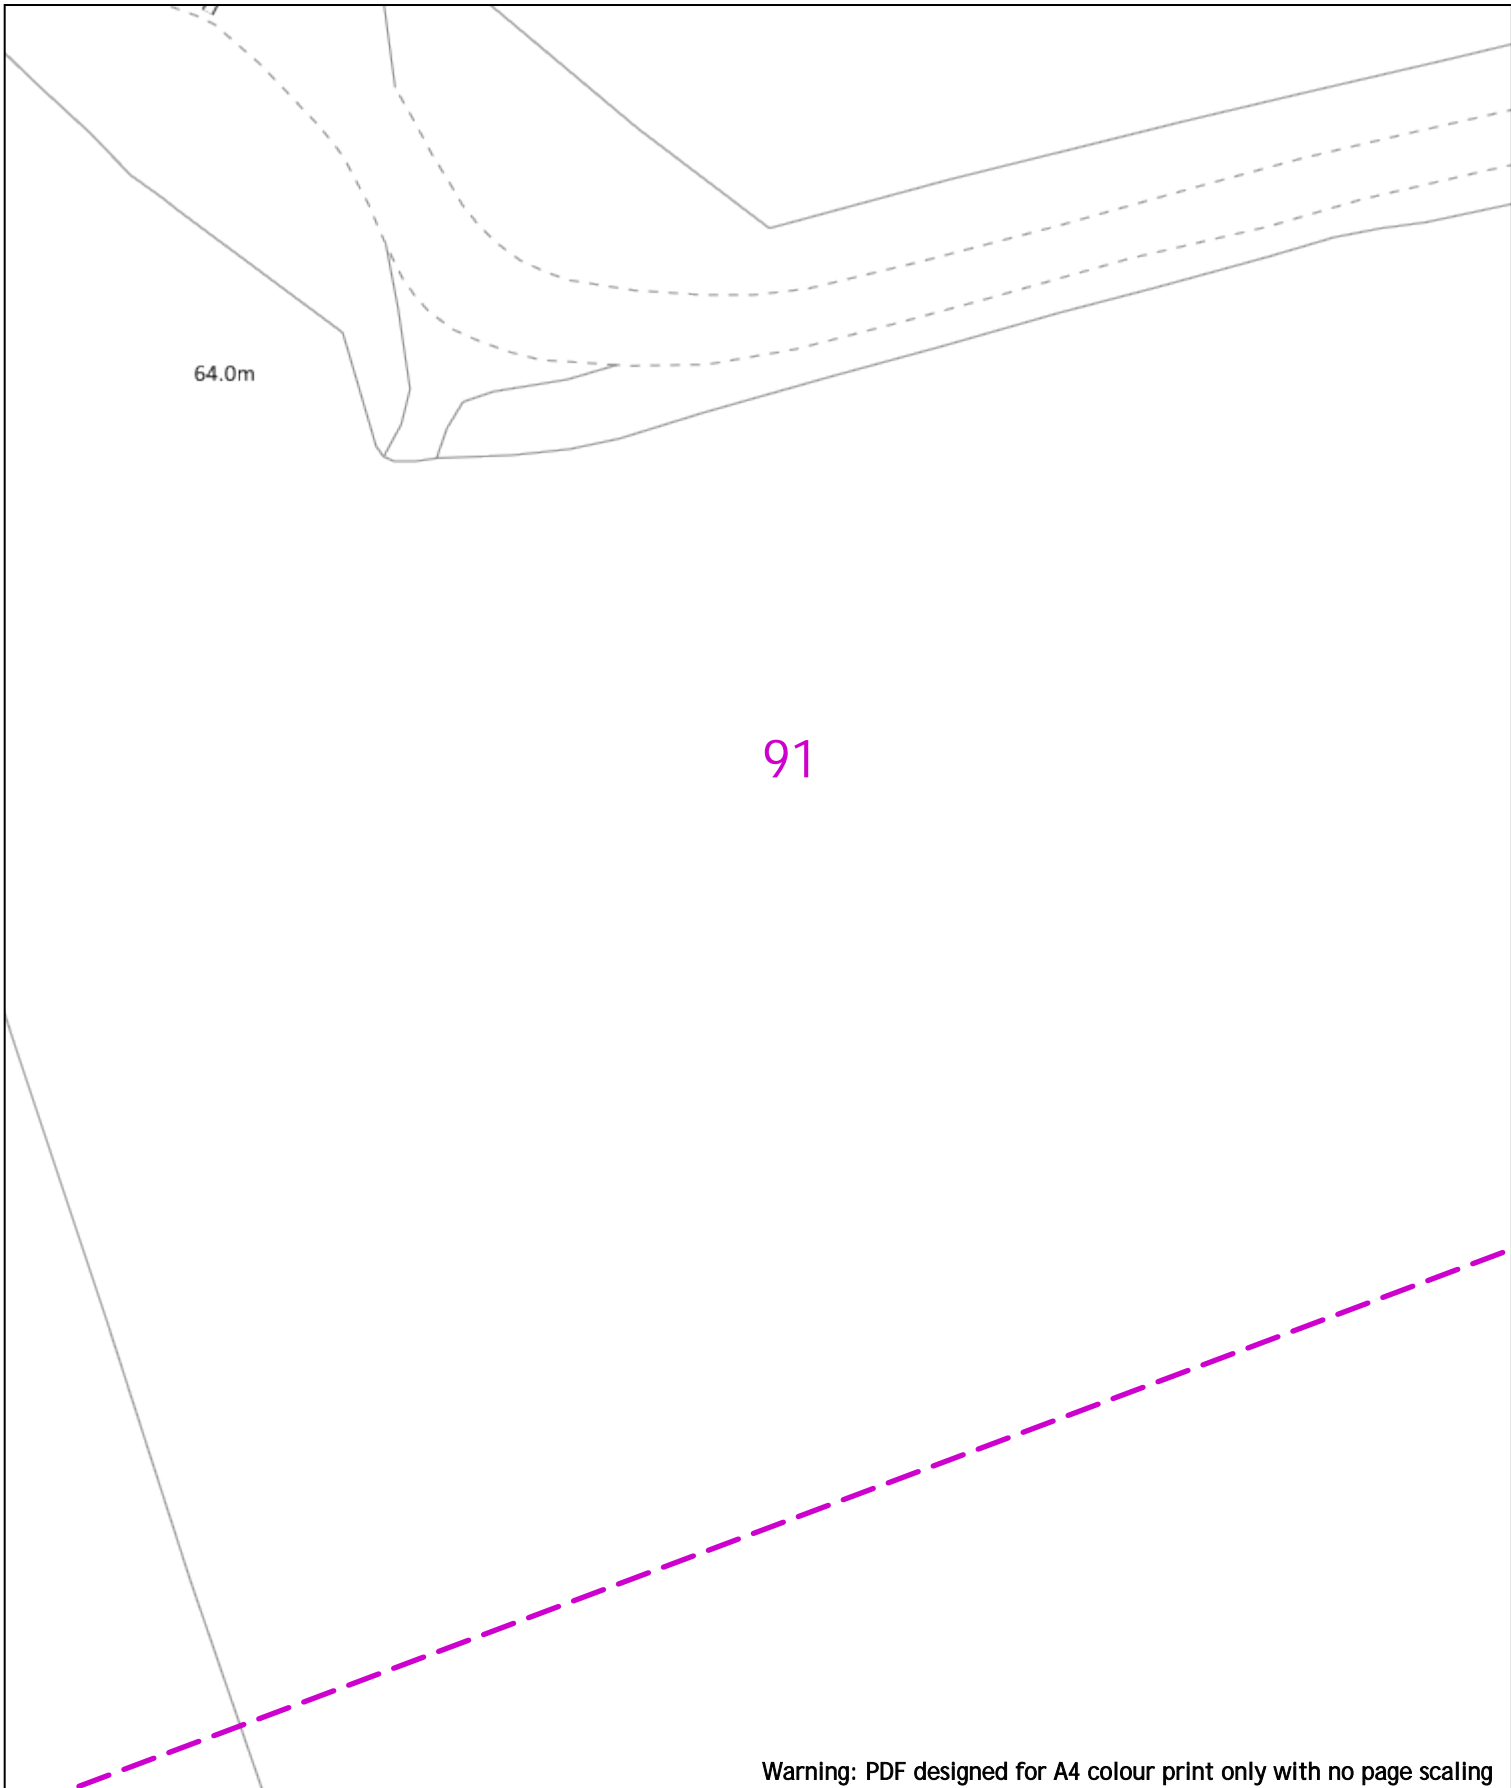

Warning: PDF designed for A4 colour print only with no page scaling

<p>0 20m Dig Sites Area: Line: </p>	<p>Voltages (V)</p> <table border="1" style="width: 100%; border-collapse: collapse;"> <tr> <td>LV (Low Voltage) and Services</td> <td colspan="3">Up to 1,000V</td> </tr> <tr> <td>HV (High Voltage)</td> <td colspan="3">Over 1,000V to 11,000V</td> </tr> <tr> <td>EHV (Extra High Voltage)</td> <td colspan="3">22,000V to 132,000V</td> </tr> <tr> <td>Transmission</td> <td colspan="3">275,000V and 400,000V</td> </tr> </table> <p>NORMAL DEPTH TO THE TOP OF THE CABLE WHEN LAID</p> <table border="1" style="width: 100%; border-collapse: collapse;"> <thead> <tr> <th>Services</th> <th>LV</th> <th>HV</th> <th>EHV</th> </tr> </thead> <tbody> <tr> <td>Footpath/Unmade</td> <td>0.45m</td> <td>0.45m</td> <td>0.6m 0.8m</td> </tr> <tr> <td>Road Crossing</td> <td>0.6m</td> <td>0.6m</td> <td>0.75m 0.9m</td> </tr> <tr> <td>Agricultural</td> <td>1m</td> <td>1m</td> <td>1m 1.1m</td> </tr> </tbody> </table>	LV (Low Voltage) and Services	Up to 1,000V			HV (High Voltage)	Over 1,000V to 11,000V			EHV (Extra High Voltage)	22,000V to 132,000V			Transmission	275,000V and 400,000V			Services	LV	HV	EHV	Footpath/Unmade	0.45m	0.45m	0.6m 0.8m	Road Crossing	0.6m	0.6m	0.75m 0.9m	Agricultural	1m	1m	1m 1.1m	<p>Legend</p> <table border="1" style="width: 100%; border-collapse: collapse;"> <tr> <td></td> <td>Service Cable</td> </tr> <tr> <td></td> <td>LV Mains</td> </tr> <tr> <td></td> <td>2-33kV</td> </tr> <tr> <td></td> <td>6.6kV</td> </tr> <tr> <td></td> <td>11kV</td> </tr> <tr> <td></td> <td>22kV</td> </tr> <tr> <td></td> <td>33kV</td> </tr> <tr> <td></td> <td>66kV</td> </tr> <tr> <td></td> <td>132kV</td> </tr> <tr> <td></td> <td>275kV</td> </tr> <tr> <td></td> <td>400kV</td> </tr> <tr> <td></td> <td>Fibre Optic</td> </tr> <tr> <td></td> <td>Rigid Cable</td> </tr> </table> <p>Distribution Structures (Electric)</p> <table border="1" style="width: 100%; border-collapse: collapse;"> <tr> <td></td> <td>Pole, Existing Location</td> </tr> <tr> <td></td> <td>Pole Structure, Existing Location - Single</td> </tr> <tr> <td></td> <td>Pole Structure, Existing Location - H</td> </tr> <tr> <td></td> <td>Duct Route</td> </tr> <tr> <td></td> <td>Cross Section Route</td> </tr> </table>		Service Cable		LV Mains		2-33kV		6.6kV		11kV		22kV		33kV		66kV		132kV		275kV		400kV		Fibre Optic		Rigid Cable		Pole, Existing Location		Pole Structure, Existing Location - Single		Pole Structure, Existing Location - H		Duct Route		Cross Section Route	<p></p> <p></p> <p>Southern Electric Power Distribution plc Registered Office: No.1 Forbury Place 43 Forbury Road Reading RG1 3JH Registered In England & Wales No.04094290</p> <p>If you're unsure & need to seek advice before commencing excavations, please contact: General Enquiries: 0800 048 3516</p> <p>Subject to revision – Master held by SSEN Asset Data Team: Asset.Data@sse.com 01256 337 294</p>
<p>Date Requested: 24/06/2022 Job Reference: 25881010 Site Location: 448066 213346 Requested by: Mr Joe Shawyer Your Scheme/Reference: 31188_002</p>		<p>WARNING</p> <p>There may have been subsequent alteration to the surface levels. Trial holes must be undertaken to determine position and depths of cables. HS (G) 47 Booklet from the Health and Safety Executive – Avoiding Danger from Buried Cables – should be consulted before commencing excavation work.</p> <p>WHEN WORKING IN THE VICINITY OF OVERHEAD LINES THE HEALTH AND SAFETY GUIDANCE NOTES G56 SHOULD BE CONSULTED (AVAILABLE FROM THE HSE WEBSITE)</p>	
<p>Scale: 1:500 (When plotted at A4)</p>		<p><small>BASED UPON THE ORDNANCE SURVEY MAP WITH THE SANCTION OF THE CONTROLLER OF H.M. STATIONERY OFFICE CROWN COPYRIGHT RESERVED. This copy has been made by or with the authority of Scottish and Southern Energy Power Distribution Ltd. Pursuant to section 47 of the Copyright, Designs and Patents Act 1988 ("The Act"). Unless the Act provides a relevant exception to copyright the copy must not be copied without permission of the copyright owner. Plans generated by DigSAFE Pro™ software provided by Linearcabbeforeldg.</small></p>	

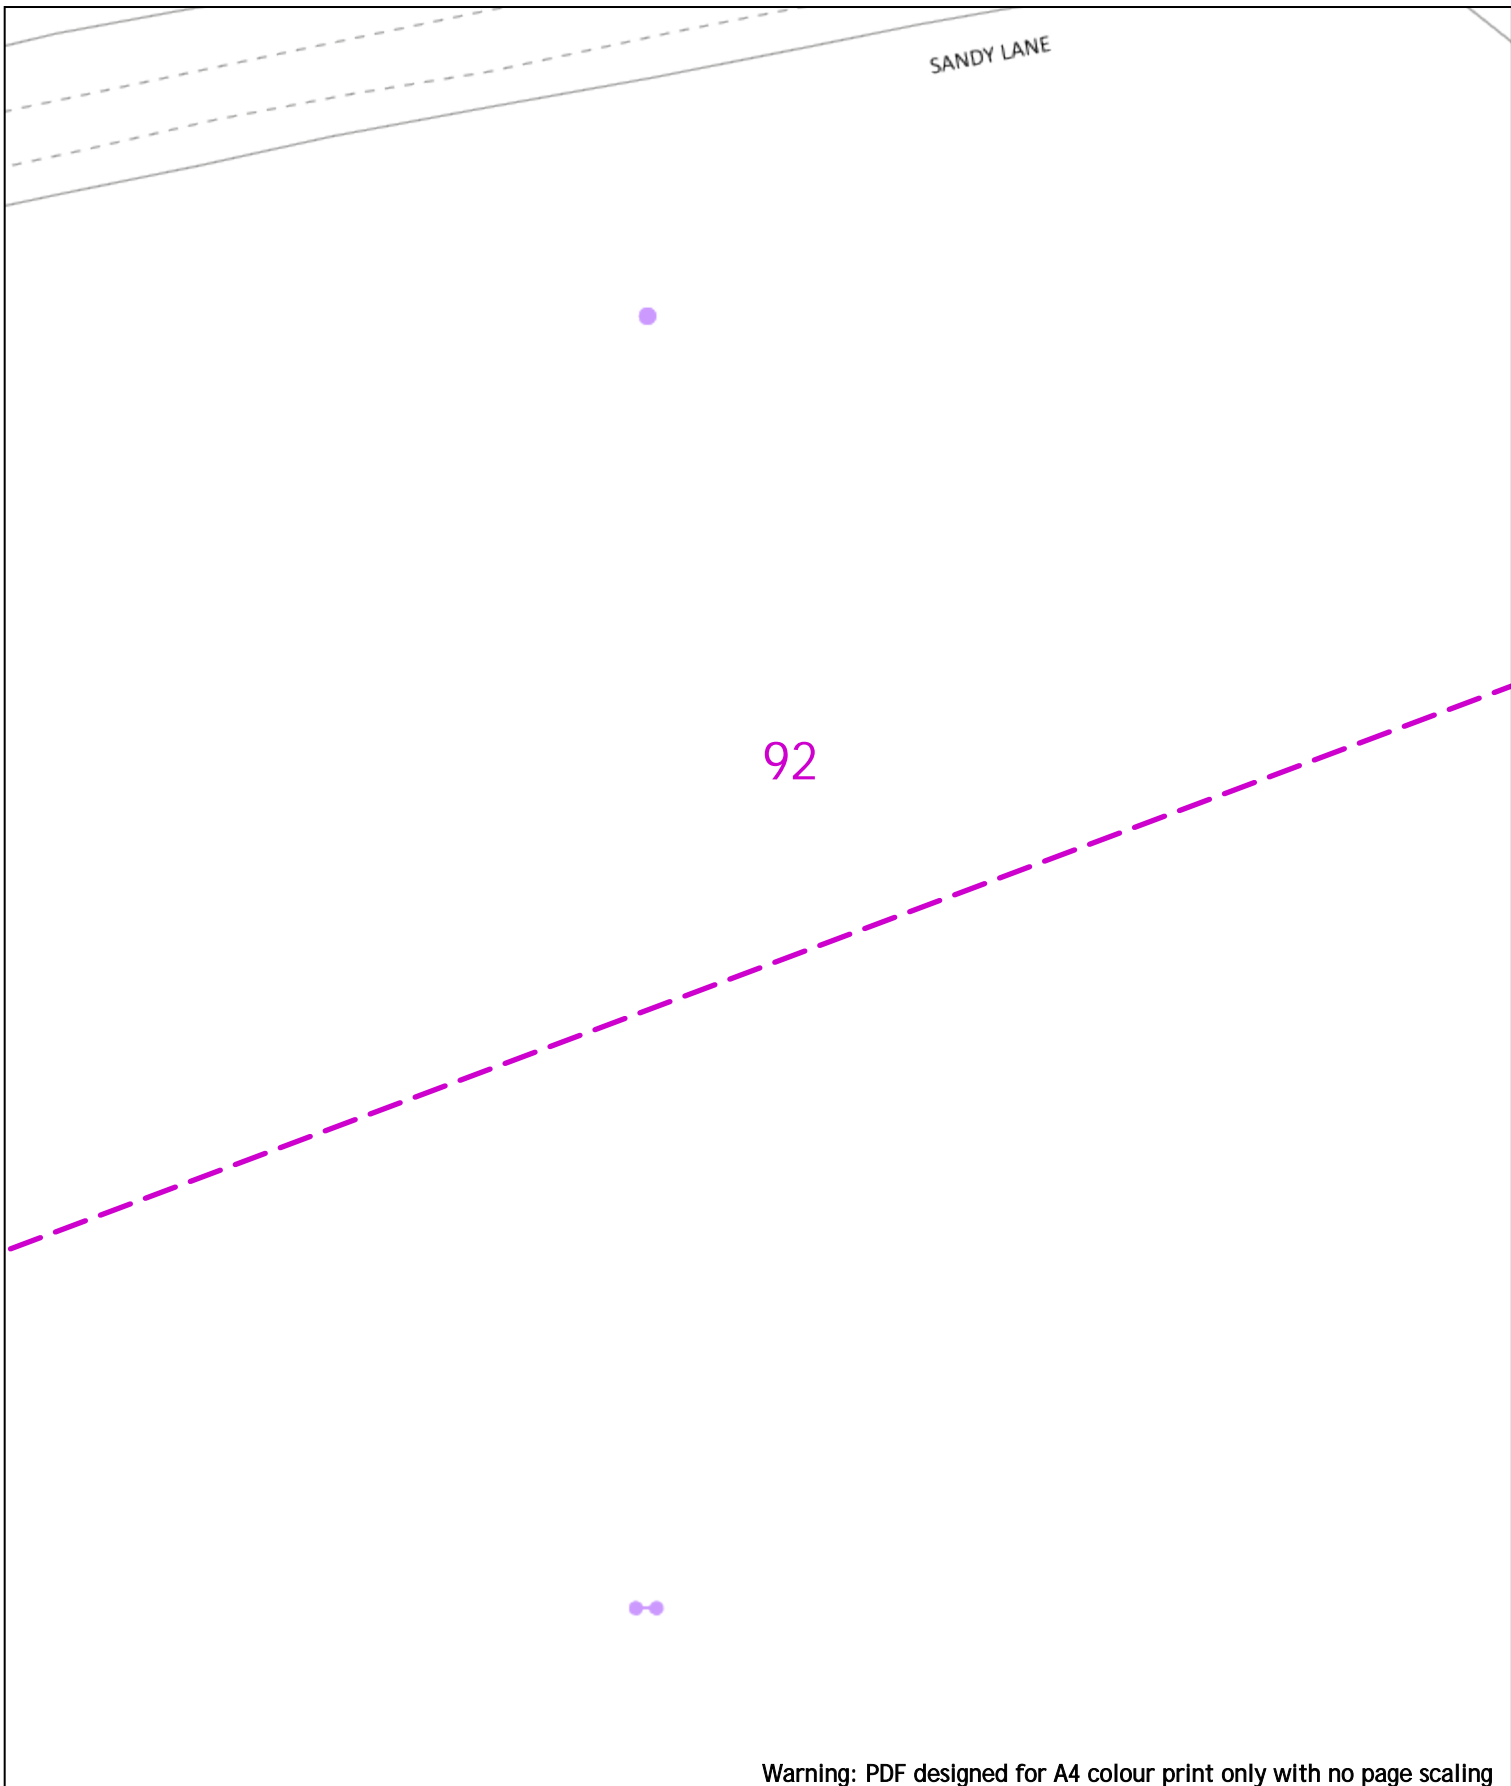

Warning: PDF designed for A4 colour print only with no page scaling

0 20m Dig Sites Area: Line:

Date Requested: 24/06/2022
 Job Reference: 25881010
 Site Location: 448066 213346
 Requested by: Mr Joe Shawyer
 Your Scheme/Reference: 31188_002

Voltages (V)			
LV (Low Voltage) and Services	Up to 1,000V		
HV (High Voltage)	Over 1,000V to 11,000V		
EHV (Extra High Voltage)	22,000V to 132,000V		
Transmission	275,000V and 400,000V		

NORMAL DEPTH TO THE TOP OF THE CABLE WHEN LAID			
Services	LV	HV	EHV
Footpath/Unmade	0.45m	0.45m	0.6m
Road Crossing	0.6m	0.6m	0.75m
Agricultural	1m	1m	1.1m

Legend

- Service Cable
- LV Main
- 2-33kV
- 6.6kV
- 11kV
- 22kV
- 33kV
- 66kV
- 132kV
- 275kV
- 400kV
- Fibre Optic
- Riser Cable

Distribution Structures (Electric)

- Pole, Existing Location
- Pole Structure, Existing Location - Single
- Pole Structure, Existing Location - H
- Duct Route
- Cross Section Route

WARNING
 There may have been subsequent alteration to the surface levels. Trial holes must be undertaken to determine position and depths of cables. HS (G) 47 Booklet from the Health and Safety Executive - Avoiding Danger from Buried Cables - should be consulted before commencing excavation work.
WHEN WORKING IN THE VICINITY OF OVERHEAD LINES THE HEALTH AND SAFETY GUIDANCE NOTES G56 SHOULD BE CONSULTED (AVAILABLE FROM THE HSE WEBSITE)


Scale: 1:500 (When plotted at A4)

Southern Electric Power Distribution plc
 Registered Office: No.1 Forbury Place
 43 Forbury Road Reading RG1 3JH
 Registered In England & Wales No.04094290

If you're unsure & need to seek advice before commencing excavations, please contact:
 General Enquiries: 0800 048 3516

Subject to revision - Master held by SSEN Asset Data Team:
Asset.Data@sse.com
 01256 337 294

BASED UPON THE ORDNANCE SURVEY MAP WITH THE SANCTION OF THE CONTROLLER OF H.M. STATIONERY OFFICE CROWN COPYRIGHT RESERVED.
 This copy has been made by or with the authority of Scottish and Southern Energy Power Distribution Ltd. Pursuant to section 47 of the Copyright, Designs and Patents Act 1988 ("The Act"). Unless the Act provides a relevant exception to copyright the copy must not be copied without prior permission of the copyright owner.
 Plans generated by DigSAFE Pro™ software provided by Linearcableforeldg.

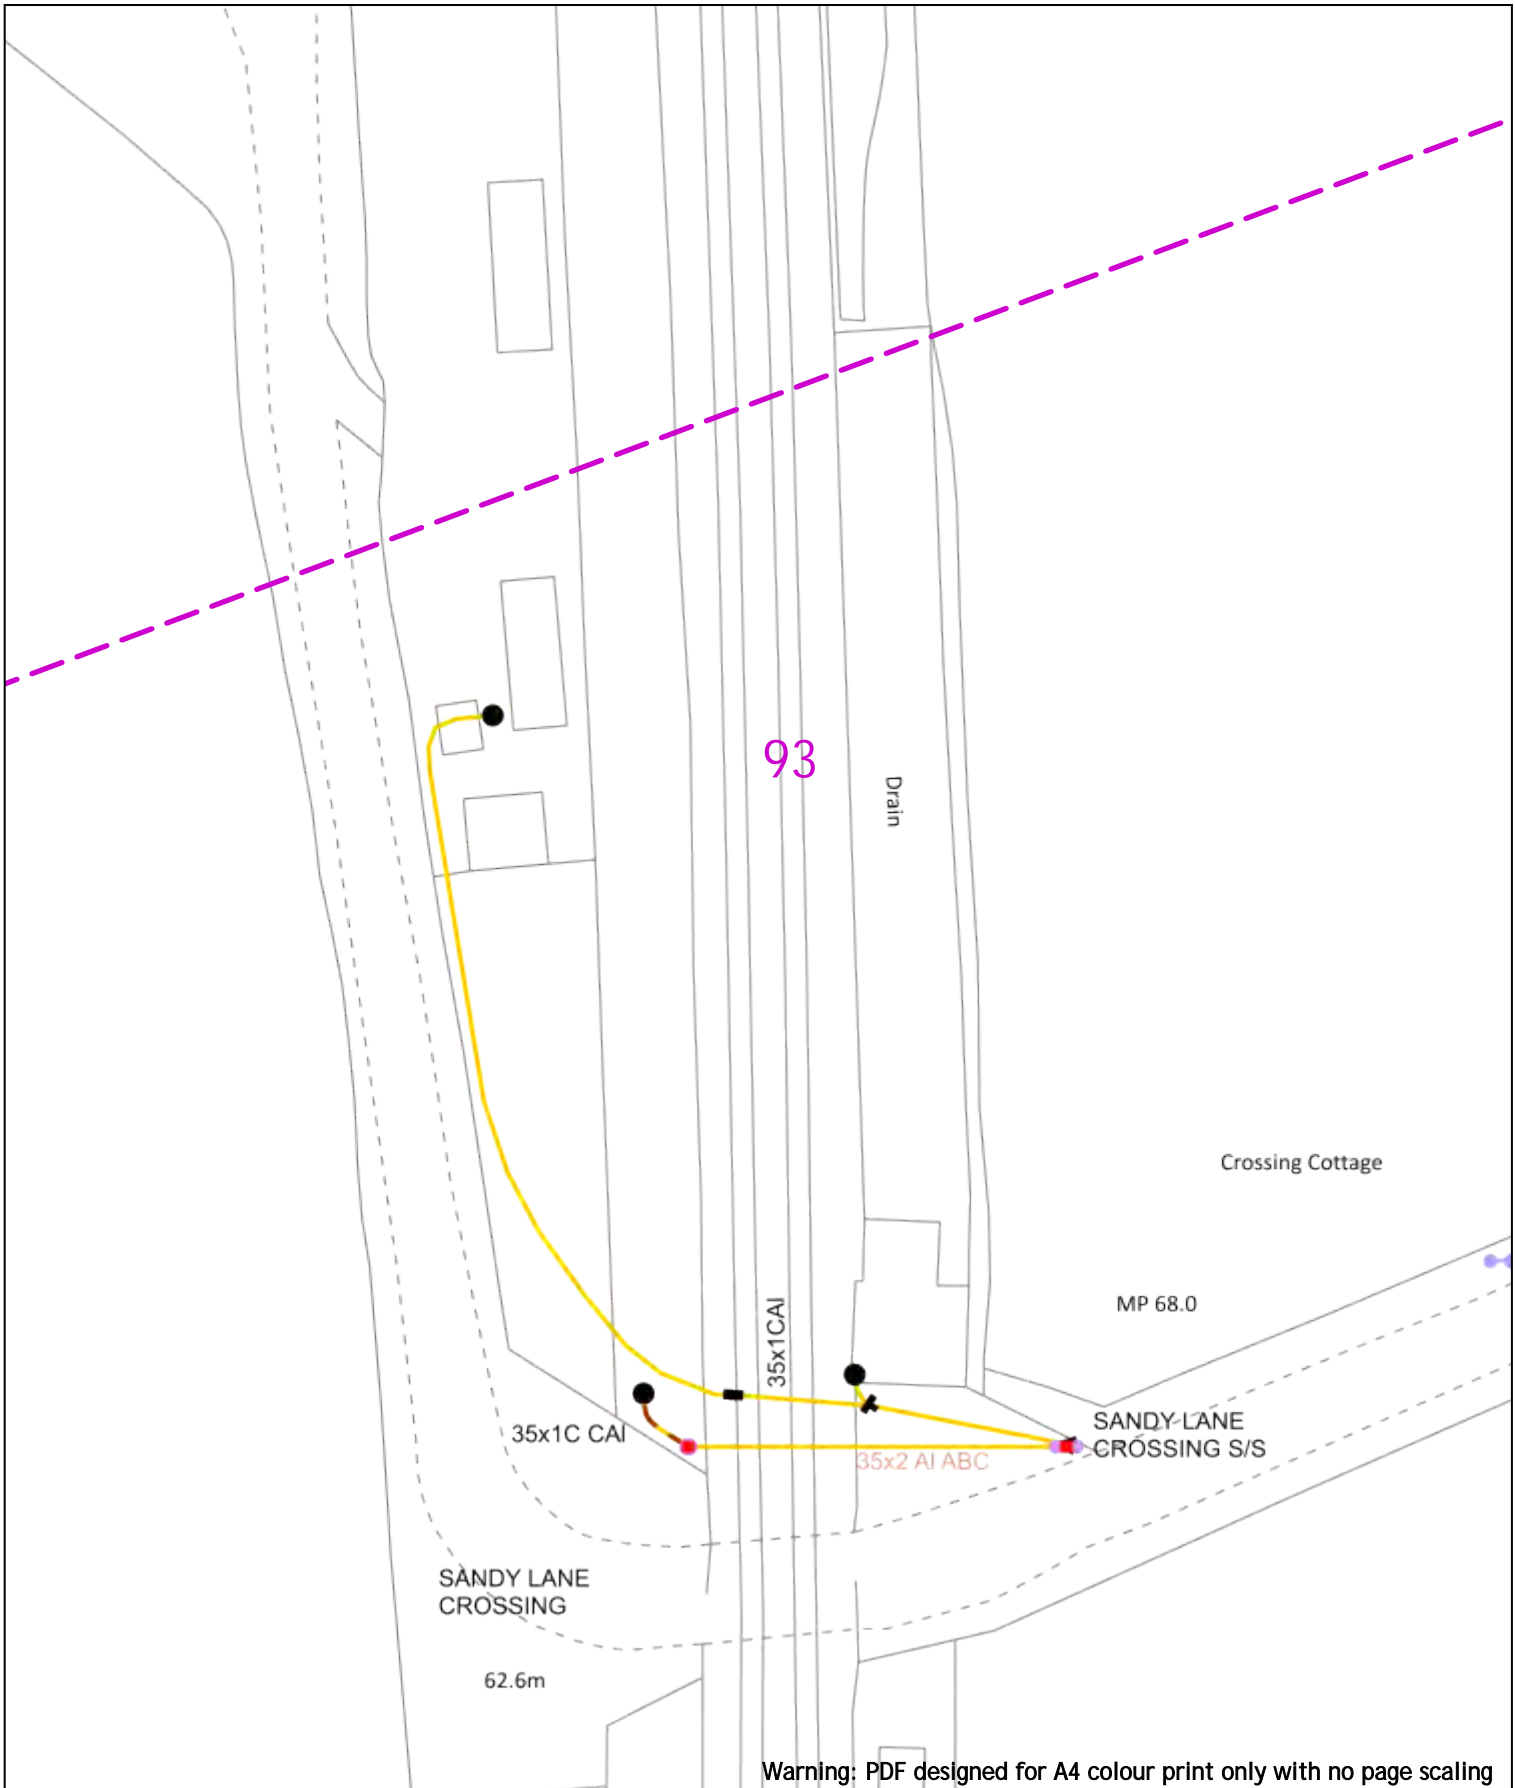

Warning: PDF designed for A4 colour print only with no page scaling

0 20m Dig Sites Area: Line:

Date Requested: 24/06/2022
 Job Reference: 25881010
 Site Location: 448066 213346
 Requested by: Mr Joe Shawyer
 Your Scheme/Reference: 31188_002

Voltages (V)	
LV (Low Voltage) and Services	Up to 1,000V
HV (High Voltage)	Over 1,000V to 11,000V
EHV (Extra High Voltage)	22,000V to 132,000V
Transmission	275,000V and 400,000V

NORMAL DEPTH TO THE TOP OF THE CABLE WHEN LAID			
Services	LV	HV	EHV
Footpath/Unmade	0.45m	0.45m	0.6m
Road Crossing	0.6m	0.6m	0.75m
Agricultural	1m	1m	1.1m

Legend

- Service Cable
- LV Main
- 6.6kV
- 11kV
- 22kV
- 33kV
- 66kV
- 132kV
- 275kV
- 400kV
- Fibre Optic
- Riser Cable

Distribution Structures (Electric)

- Pole, Existing Location
- Pole Structure, Existing Location - Single
- Pole Structure, Existing Location - H
- Duct Route
- Cross Section Route


WARNING
 There may have been subsequent alteration to the surface levels. Trial holes must be undertaken to determine position and depths of cables. HS (G) 47 Booklet from the Health and Safety Executive - Avoiding Danger from Buried Cables - should be consulted before commencing excavation work.
 WHEN WORKING IN THE VICINITY OF OVERHEAD LINES THE HEALTH AND SAFETY GUIDANCE NOTES G56 SHOULD BE CONSULTED (AVAILABLE FROM THE HSE WEBSITE)

Scale: 1:500 (When plotted at A4)

Southern Electric Power Distribution plc
 Registered Office: No.1 Forbury Place
 43 Forbury Road Reading RG1 3JH
 Registered In England & Wales No.04094290

If you're unsure & need to seek advice before commencing excavations, please contact:
 General Enquiries: 0800 048 3516

Subject to revision - Master held by SSEN Asset Data Team:
Asset.Data@sse.com
 01256 337 294

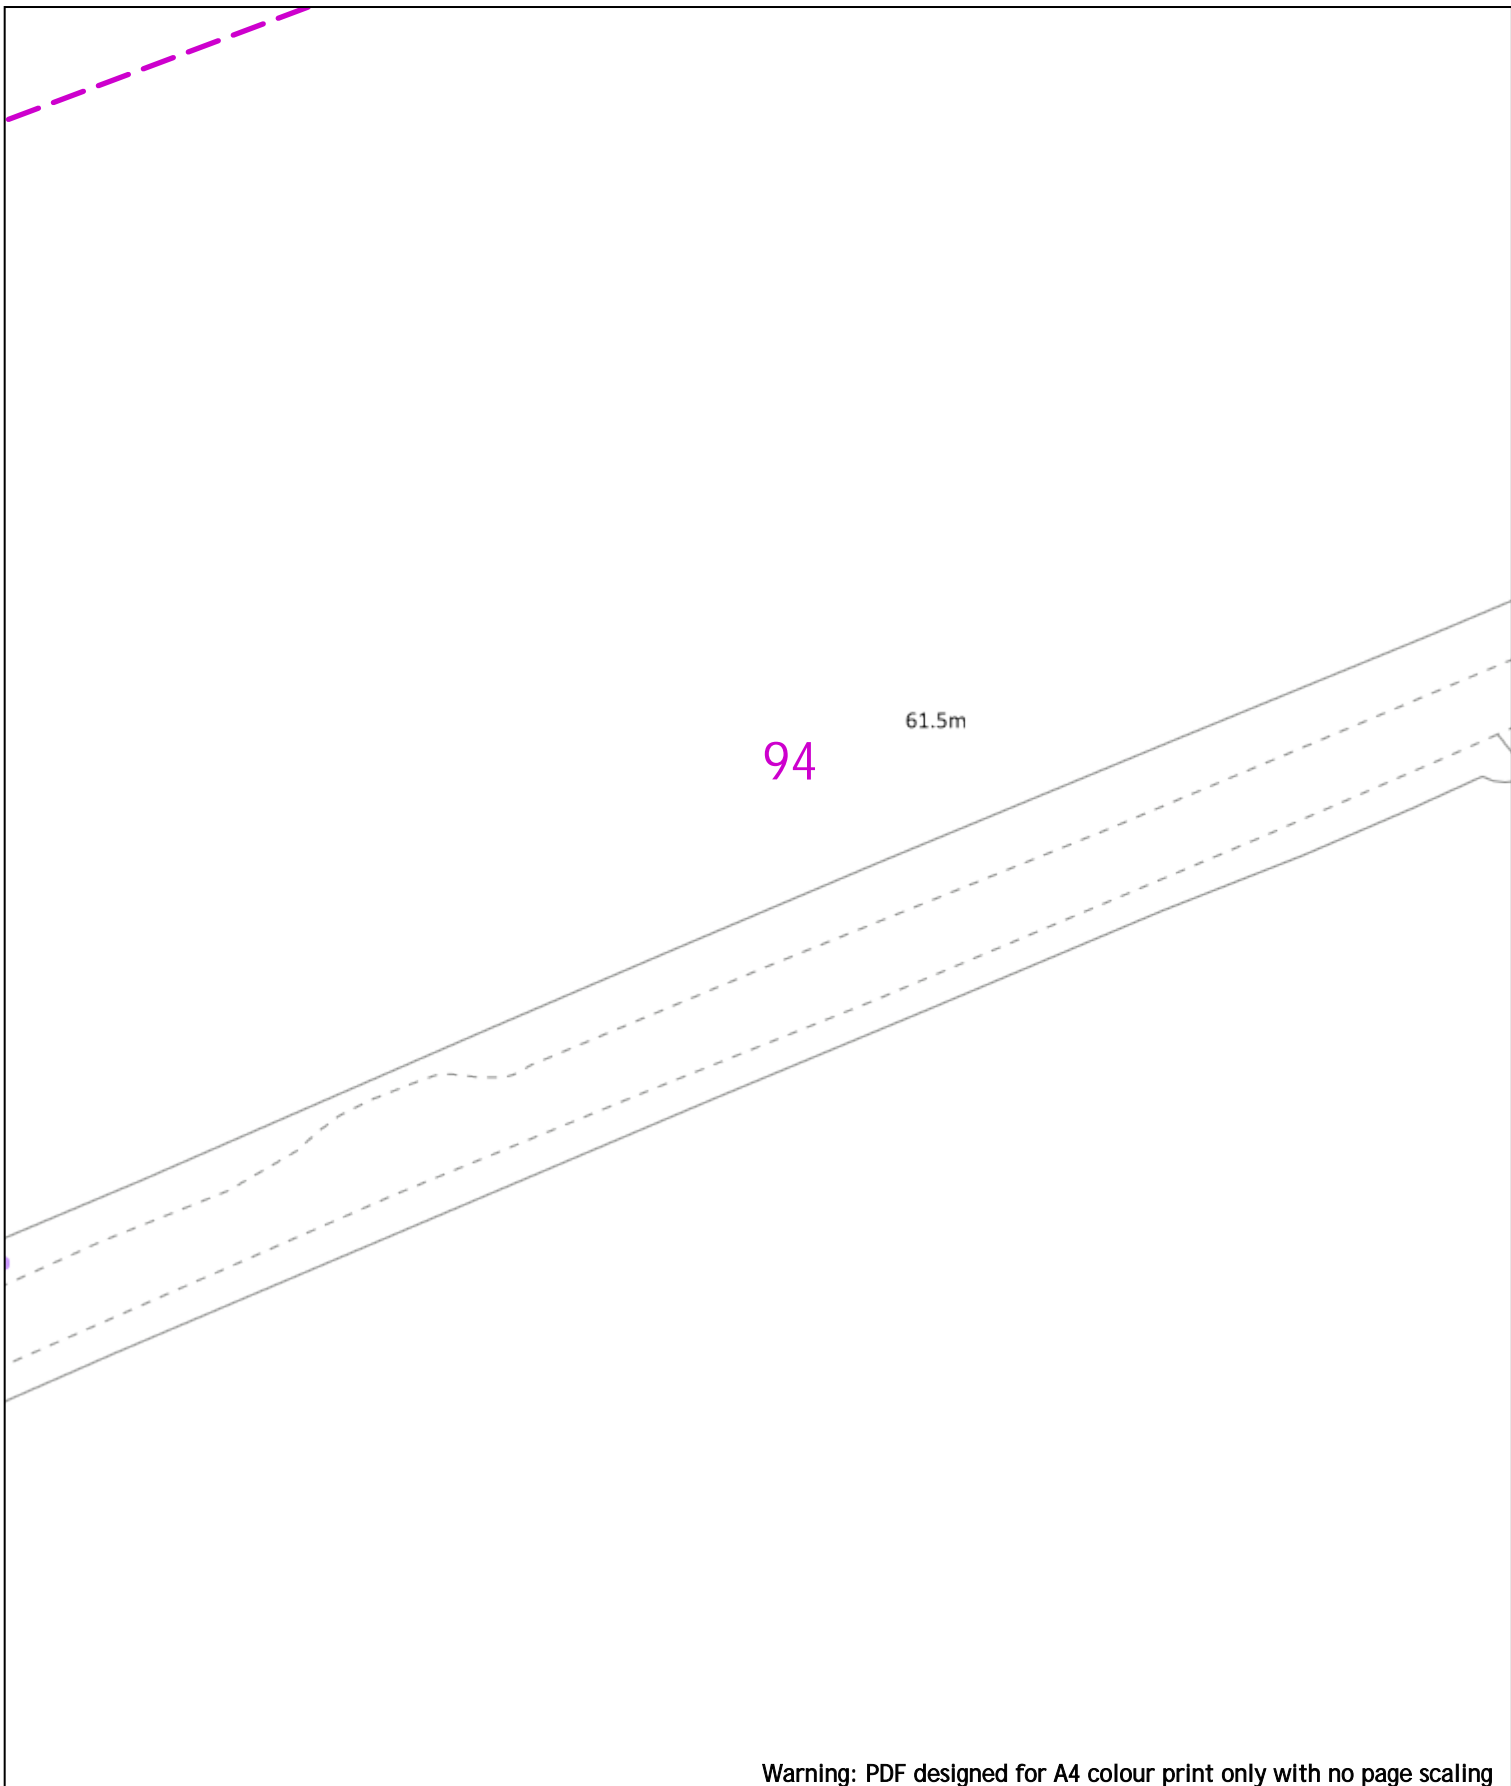

Warning: PDF designed for A4 colour print only with no page scaling

0 20m Dig Sites Area: Line:

Date Requested: 24/06/2022
 Job Reference: 25881010
 Site Location: 448066 213346
 Requested by: Mr Joe Shawyer
 Your Scheme/Reference: 31188_002

Voltages (V)			
LV (Low Voltage) and Services	Up to 1,000V		
HV (High Voltage)	Over 1,000V to 11,000V		
EHV (Extra High Voltage)	22,000V to 132,000V		
Transmission	275,000V and 400,000V		

NORMAL DEPTH TO THE TOP OF THE CABLE WHEN LAID			
Services	LV	HV	EHV
Footpath/Unmade	0.45m	0.45m	0.8m
Road Crossing	0.6m	0.6m	0.9m
Agricultural	1m	1m	1.1m

Legend		Distribution Structures (Electric)	
	Service Cable		Pole, Existing Location
	LV Mains		Pole Structure, Existing Location - Single
	2-33kV		Pole Structure, Existing Location - H
	6.6kV		Duct Route
	11kV		Cross Section Route
	22kV		
	33kV		
	66kV		
	132kV		
	275kV		
	400kV		
	Fibre Optic		
	Rigid Cable		

WARNING
 There may have been subsequent alteration to the surface levels. Trial holes must be undertaken to determine position and depths of cables. HS (G) 47 Booklet from the Health and Safety Executive - Avoiding Danger from Buried Cables - should be consulted before commencing excavation work.
 WHEN WORKING IN THE VICINITY OF OVERHEAD LINES THE HEALTH AND SAFETY GUIDANCE NOTES G56 SHOULD BE CONSULTED (AVAILABLE FROM THE HSE WEBSITE)

Scale: 1:500 (When plotted at A4)

Southern Electric Power Distribution plc
 Registered Office: No.1 Forbury Place
 43 Forbury Road Reading RG1 3JH
 Registered In England & Wales No.04094290

If you're unsure & need to seek advice before commencing excavations, please contact:
 General Enquiries: 0800 048 3516

Subject to revision - Master held by SSEN Asset Data Team:
Asset.Data@sse.com
 01256 337 294

95

Warning: PDF designed for A4 colour print only with no page scaling

0  20m Dig Sites Area:  Line: 

Date Requested: 24/06/2022
 Job Reference: 25881010
 Site Location: 448066 213346
 Requested by: Mr Joe Shawyer

Your Scheme/Reference: 31188_002

Voltages (V)			
LV (Low Voltage) and Services	Up to 1,000V		
HV (High Voltage)	Over 1,000V to 11,000V		
EHV (Extra High Voltage)	22,000V to 132,000V		
Transmission	275,000V and 400,000V		

NORMAL DEPTH TO THE TOP OF THE CABLE WHEN LAID			
Services	LV	HV	EHV
Footpath/Unmade	0.45m	0.45m	0.6m
Road Crossing	0.6m	0.6m	0.75m
Agricultural	1m	1m	1.1m

<p>Legend</p> <ul style="list-style-type: none"> Service Cable LV Mains 2-33kV 6.6kV 11kV 22kV 33kV 66kV 132kV 275kV 400kV Fibre Optic Pilot Cable 	<p>Distribution Structures (Electric)</p> <ul style="list-style-type: none"> Pole, Existing Location Pole Structure, Existing Location - Single Pole Structure, Existing Location - H Duct Route Cross Section Route
---	---

WARNING
 There may have been subsequent alteration to the surface levels. Trial holes must be undertaken to determine position and depths of cables. HS (G) 47 Booklet from the Health and Safety Executive - Avoiding Danger from Buried Cables - should be consulted before commencing excavation work.
WHEN WORKING IN THE VICINITY OF OVERHEAD LINES THE HEALTH AND SAFETY GUIDANCE NOTES G56 SHOULD BE CONSULTED (AVAILABLE FROM THE HSE WEBSITE)




Southern Electric Power Distribution plc
 Registered Office: No.1 Forbury Place
 43 Forbury Road Reading RG1 3JH
 Registered In England & Wales No.04094290

If you're unsure & need to seek advice before commencing excavations, please contact:
 General Enquiries: 0800 048 3516

Subject to revision - Master held by SSEN Asset Data Team:
Asset.Data@sse.com
 01256 337 294

Scale: 1:500 (When plotted at A4)

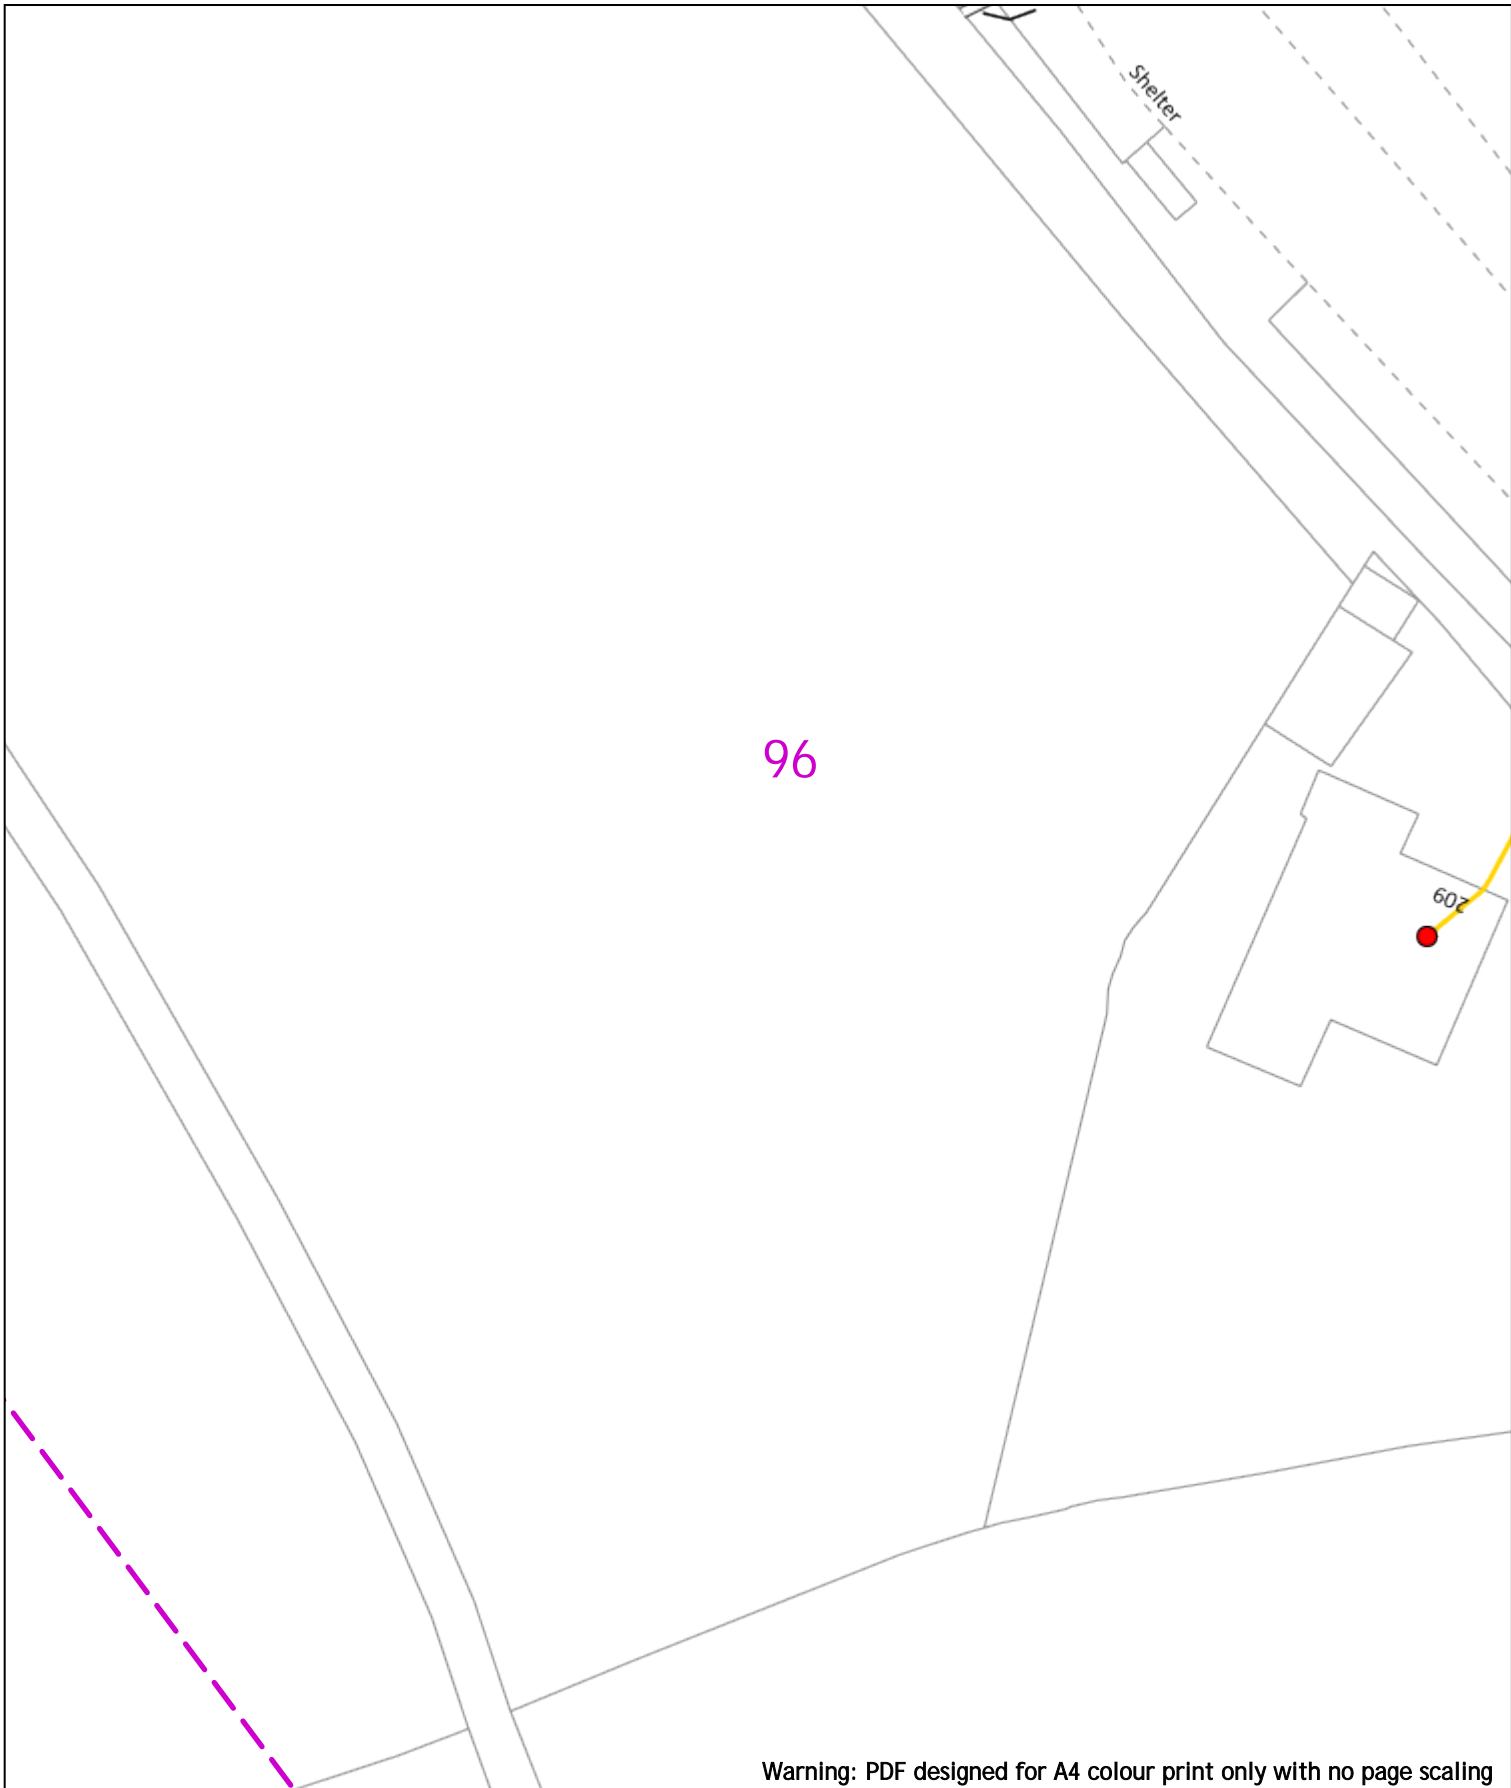

Warning: PDF designed for A4 colour print only with no page scaling

0 20m Dig Sites Area: Line:

Date Requested: 24/06/2022
 Job Reference: 25881010
 Site Location: 448066 213346
 Requested by: Mr Joe Shawyer
 Your Scheme/Reference: 31188_002

Voltages (V)	
LV (Low Voltage) and Services	Up to 1,000V
HV (High Voltage)	Over 1,000V to 11,000V
EHV (Extra High Voltage)	22,000V to 132,000V
Transmission	275,000V and 400,000V

NORMAL DEPTH TO THE TOP OF THE CABLE WHEN LAID				
Services	LV	HV	EHV	
Footpath/Unmade	0.45m	0.45m	0.6m	0.8m
Road Crossing	0.6m	0.6m	0.75m	0.9m
Agricultural	1m	1m	1m	1.1m

Legend

- Service Cable
- LV Mains
- 2-33kV
- 6.6kV
- 11kV
- 22kV
- 33kV
- 66kV
- 132kV
- 275kV
- 400kV
- Fibre Optic
- Rigid Cable

Distribution Structures (Electric)

- Pole, Existing Location
- Pole Structure, Existing Location - Single
- Pole Structure, Existing Location - H
- Duct Route
- Cross Section Route

WARNING
 There may have been subsequent alteration to the surface levels. Trial holes must be undertaken to determine position and depths of cables. HS (G) 47 Booklet from the Health and Safety Executive - Avoiding Danger from Buried Cables - should be consulted before commencing excavation work.
 WHEN WORKING IN THE VICINITY OF OVERHEAD LINES THE HEALTH AND SAFETY GUIDANCE NOTES G56 SHOULD BE CONSULTED (AVAILABLE FROM THE HSE WEBSITE)


Scale: 1:500 (When plotted at A4)

Southern Electric Power Distribution plc
 Registered Office: No.1 Forbury Place
 43 Forbury Road Reading RG1 3JH
 Registered In England & Wales No.04094290

If you're unsure & need to seek advice before commencing excavations, please contact:
 General Enquiries: 0800 048 3516

Subject to revision - Master held by SSEN Asset Data Team:
Asset.Data@sse.com
 01256 337 294

BASED UPON THE ORDNANCE SURVEY MAP WITH THE SANCTION OF THE CONTROLLER OF H.M. STATIONERY OFFICE CROWN COPYRIGHT RESERVED.
 This copy has been made by or with the authority of Scottish and Southern Energy Power Distribution Ltd. Pursuant to section 47 of the Copyright, Designs and Patents Act 1988 ("The Act"). Unless the Act provides a relevant exception to copyright the copy must not be copied without prior permission of the copyright owner.

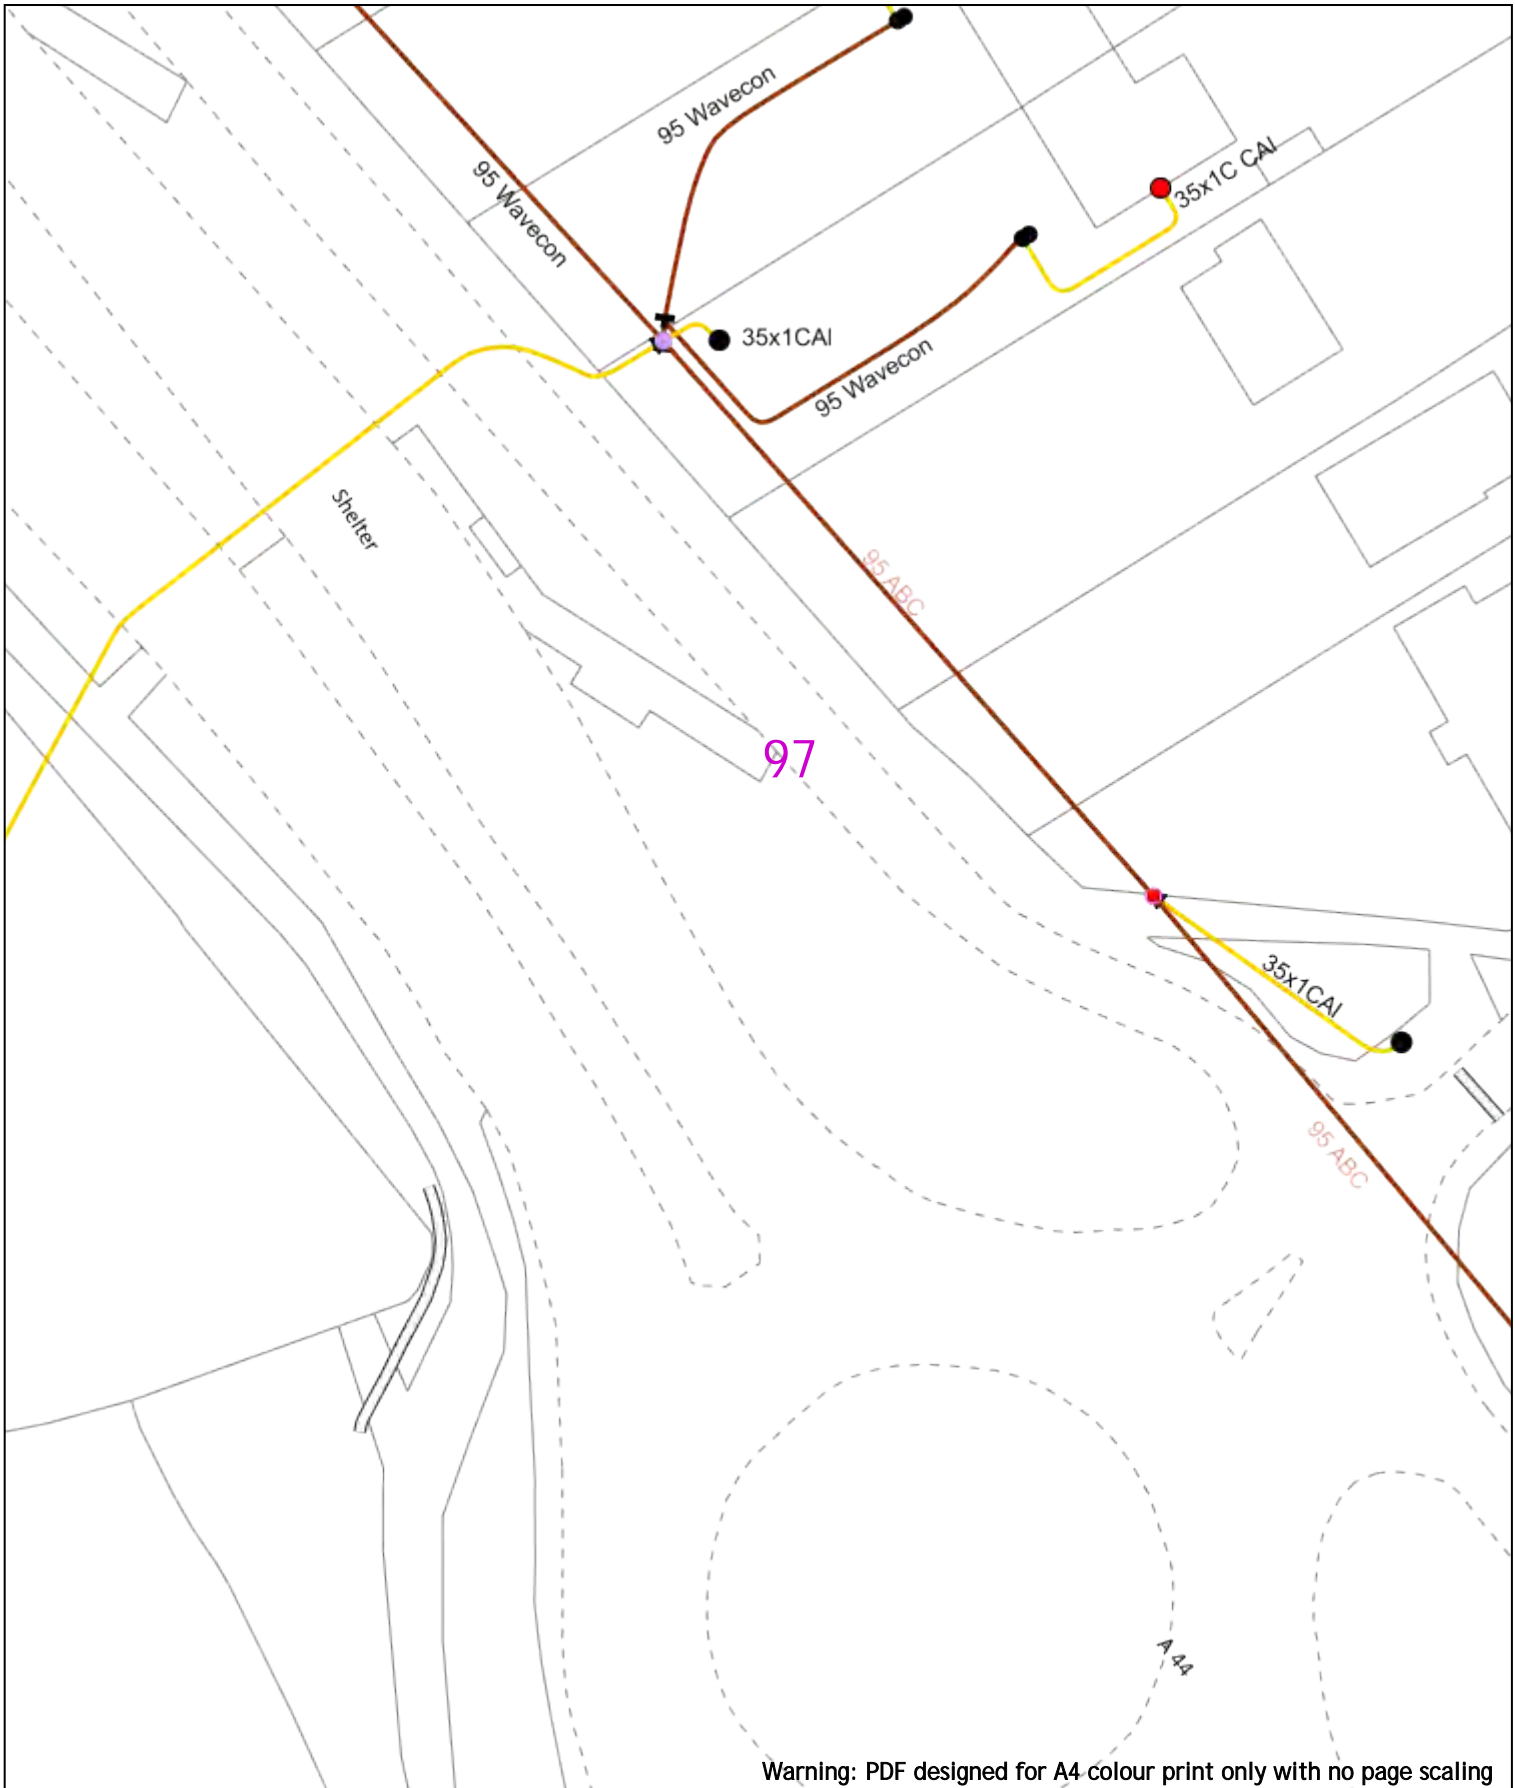

Warning: PDF designed for A4 colour print only with no page scaling



Date Requested: 24/06/2022
 Job Reference: 25881010
 Site Location: 448066 213346
 Requested by: Mr Joe Shawyer
 Your Scheme/Reference: 31188_002

Voltages (V)				
LV (Low Voltage) and Services	Up to 1,000V			
HV (High Voltage)	Over 1,000V to 11,000V			
EHV (Extra High Voltage)	22,000V to 132,000V			
Transmission	275,000V and 400,000V			
NORMAL DEPTH TO THE TOP OF THE CABLE WHEN LAID				
Services	LV	HV	EHV	
Footpath/Unmade	0.45m	0.45m	0.6m	0.8m
Road Crossing	0.6m	0.6m	0.75m	0.9m
Agricultural	1m	1m	1m	1.1m

Legend		Distribution Structures (Electric)	
	Service Cable		Pole, Existing Location
	LV Main		Pole Structure, Existing Location - Single
	6.6kV		Pole Structure, Existing Location - H
	11kV		Duct Route
	22kV		Cross Section Route
	33kV		
	66kV		
	132kV		
	275kV		
	400kV		
	Fibre Optic		
	Rigid Cable		


Scale: 1:500 (When plotted at A4)

WARNING
 There may have been subsequent alteration to the surface levels. Trial holes must be undertaken to determine position and depths of cables. HS (G) 47 Booklet from the Health and Safety Executive - Avoiding Danger from Buried Cables - should be consulted before commencing excavation work.
 WHEN WORKING IN THE VICINITY OF OVERHEAD LINES THE HEALTH AND SAFETY GUIDANCE NOTES G56 SHOULD BE CONSULTED (AVAILABLE FROM THE HSE WEBSITE)

Southern Electric Power Distribution plc
 Registered Office: No.1 Forbury Place
 43 Forbury Road Reading RG1 3JH
 Registered In England & Wales No.04094290

If you're unsure & need to seek advice before commencing excavations, please contact:
 General Enquiries: 0800 048 3516

Subject to revision - Master held by SSEN Asset Data Team:
Asset.Data@sse.com
 01256 337 294

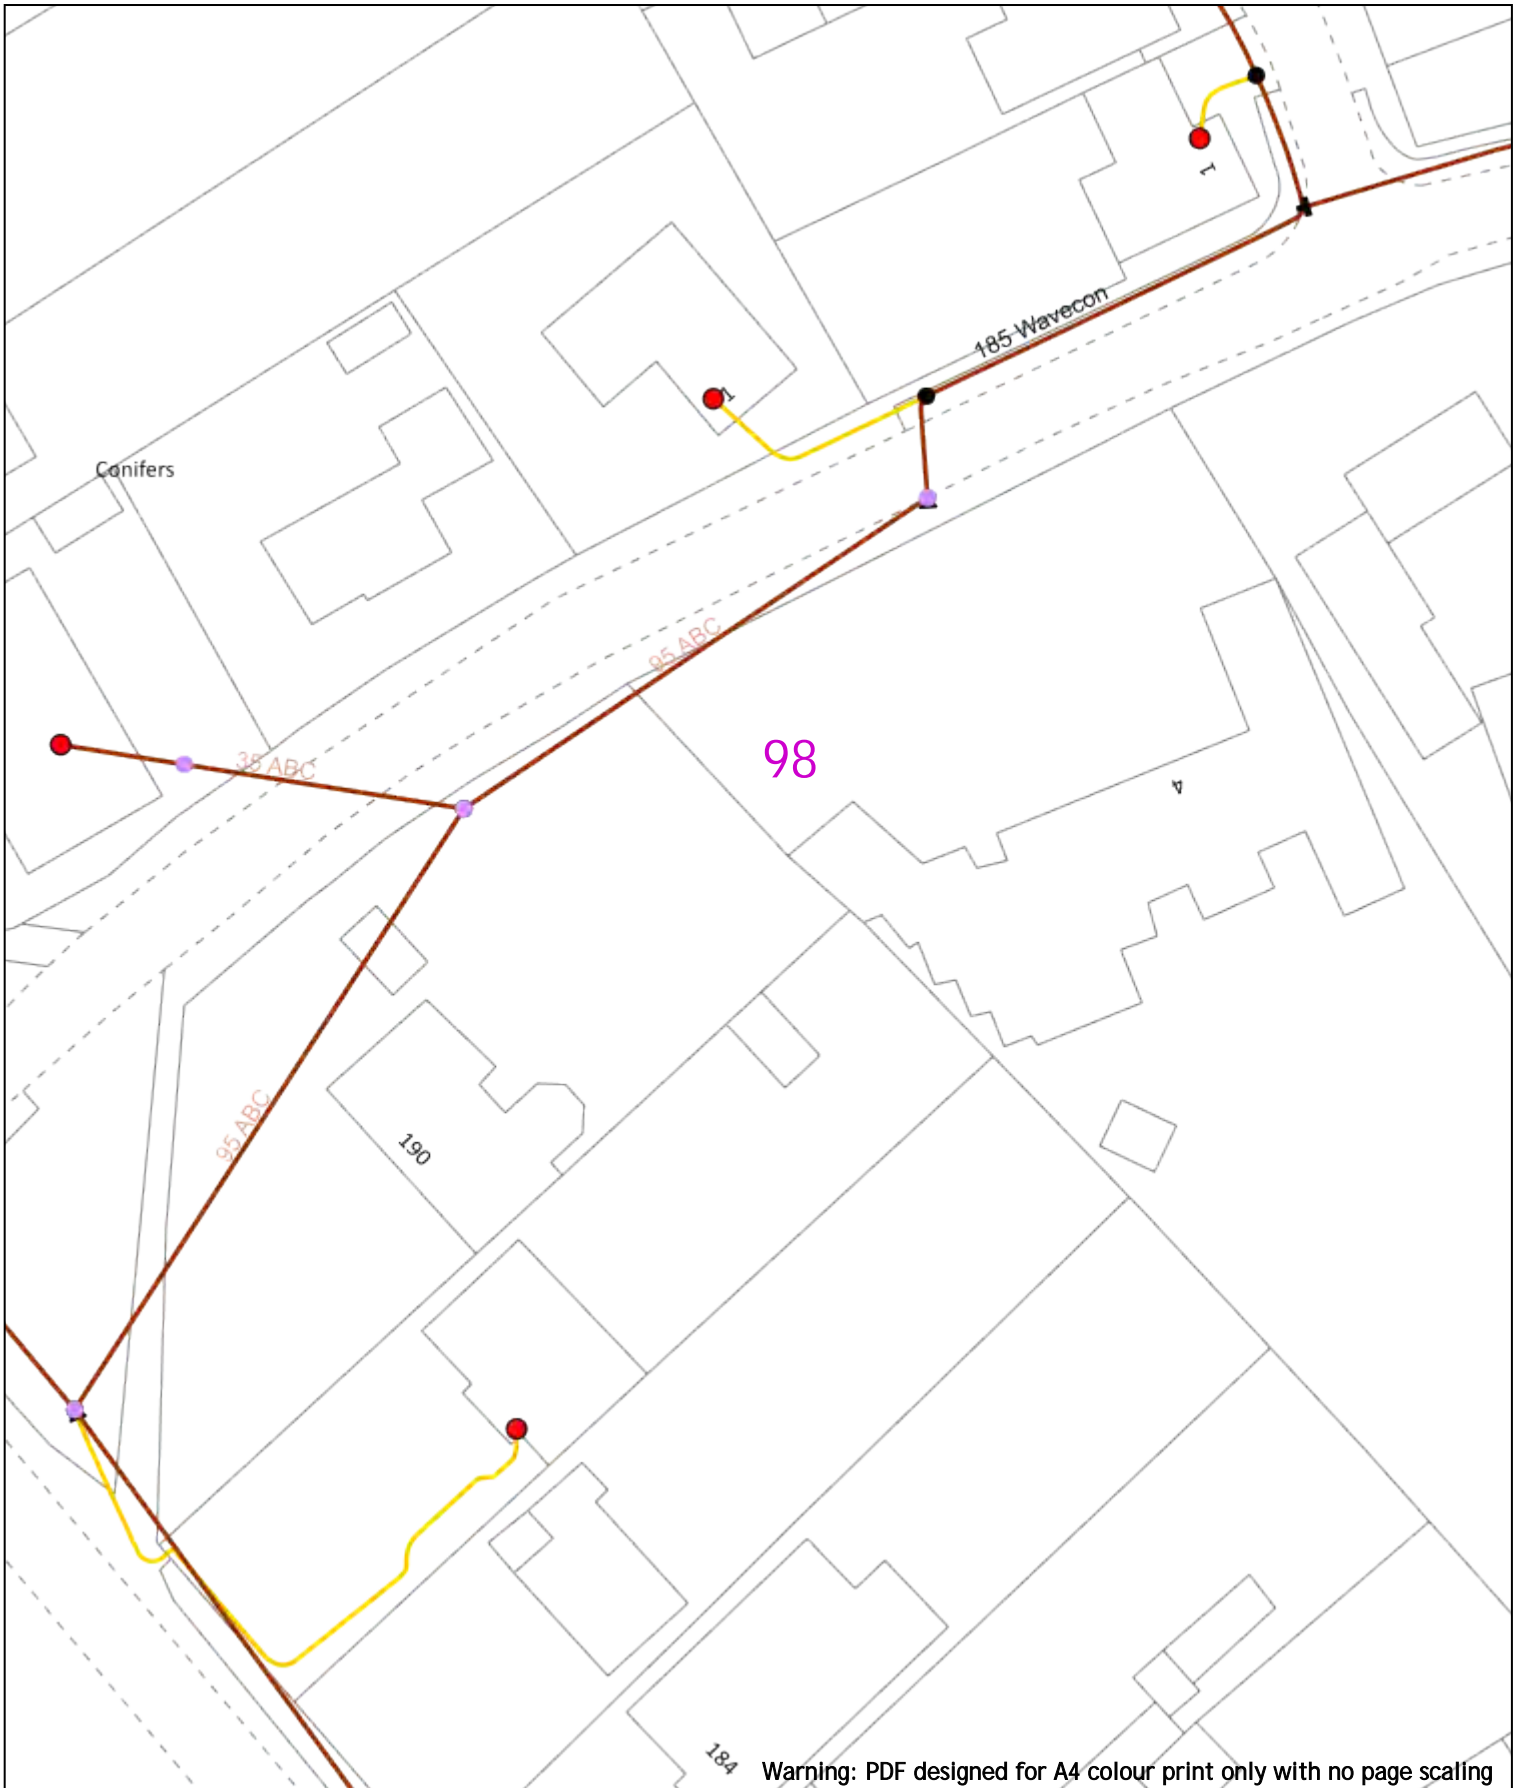

0 20m Dig Sites Area: Line:

Date Requested: 24/06/2022
 Job Reference: 25881010
 Site Location: 448066 213346
 Requested by: Mr Joe Shawyer
 Your Scheme/Reference: 31188_002

Voltages (V)	
LV (Low Voltage) and Services	Up to 1,000V
HV (High Voltage)	Over 1,000V to 11,000V
EHV (Extra High Voltage)	22,000V to 132,000V
Transmission	275,000V and 400,000V

NORMAL DEPTH TO THE TOP OF THE CABLE WHEN LAID	Services			
	LV	HV	EHV	
Footpath/Unmade	0.45m	0.45m	0.6m	0.8m
Road Crossing	0.6m	0.6m	0.75m	0.9m
Agricultural	1m	1m	1m	1.1m

Legend

- Service Cable
- LV Main
- 6.6kV
- 11kV
- 22kV
- 33kV
- 66kV
- 132kV
- 275kV
- 400kV
- Fibre Optic
- Rfid Cable

Distribution Structures (Electric)

- Pole, Existing Location
- Pole Structure, Existing Location - Single
- Pole Structure, Existing Location - H
- Duct Route
- Cross Section Route


WARNING
 There may have been subsequent alteration to the surface levels. Trial holes must be undertaken to determine position and depths of cables. HS (G) 47 Booklet from the Health and Safety Executive - Avoiding Danger from Buried Cables - should be consulted before commencing excavation work.
 WHEN WORKING IN THE VICINITY OF OVERHEAD LINES THE HEALTH AND SAFETY GUIDANCE NOTES G56 SHOULD BE CONSULTED (AVAILABLE FROM THE HSE WEBSITE)

Scale: 1:500 (When plotted at A4)

Southern Electric Power Distribution plc
 Registered Office: No.1 Forbury Place
 43 Forbury Road Reading RG1 3JH
 Registered In England & Wales No.04094290

If you're unsure & need to seek advice before commencing excavations, please contact:
 General Enquiries: 0800 048 3516

Subject to revision - Master held by SSEN Asset Data Team:
Asset.Data@sse.com
 01256 337 294

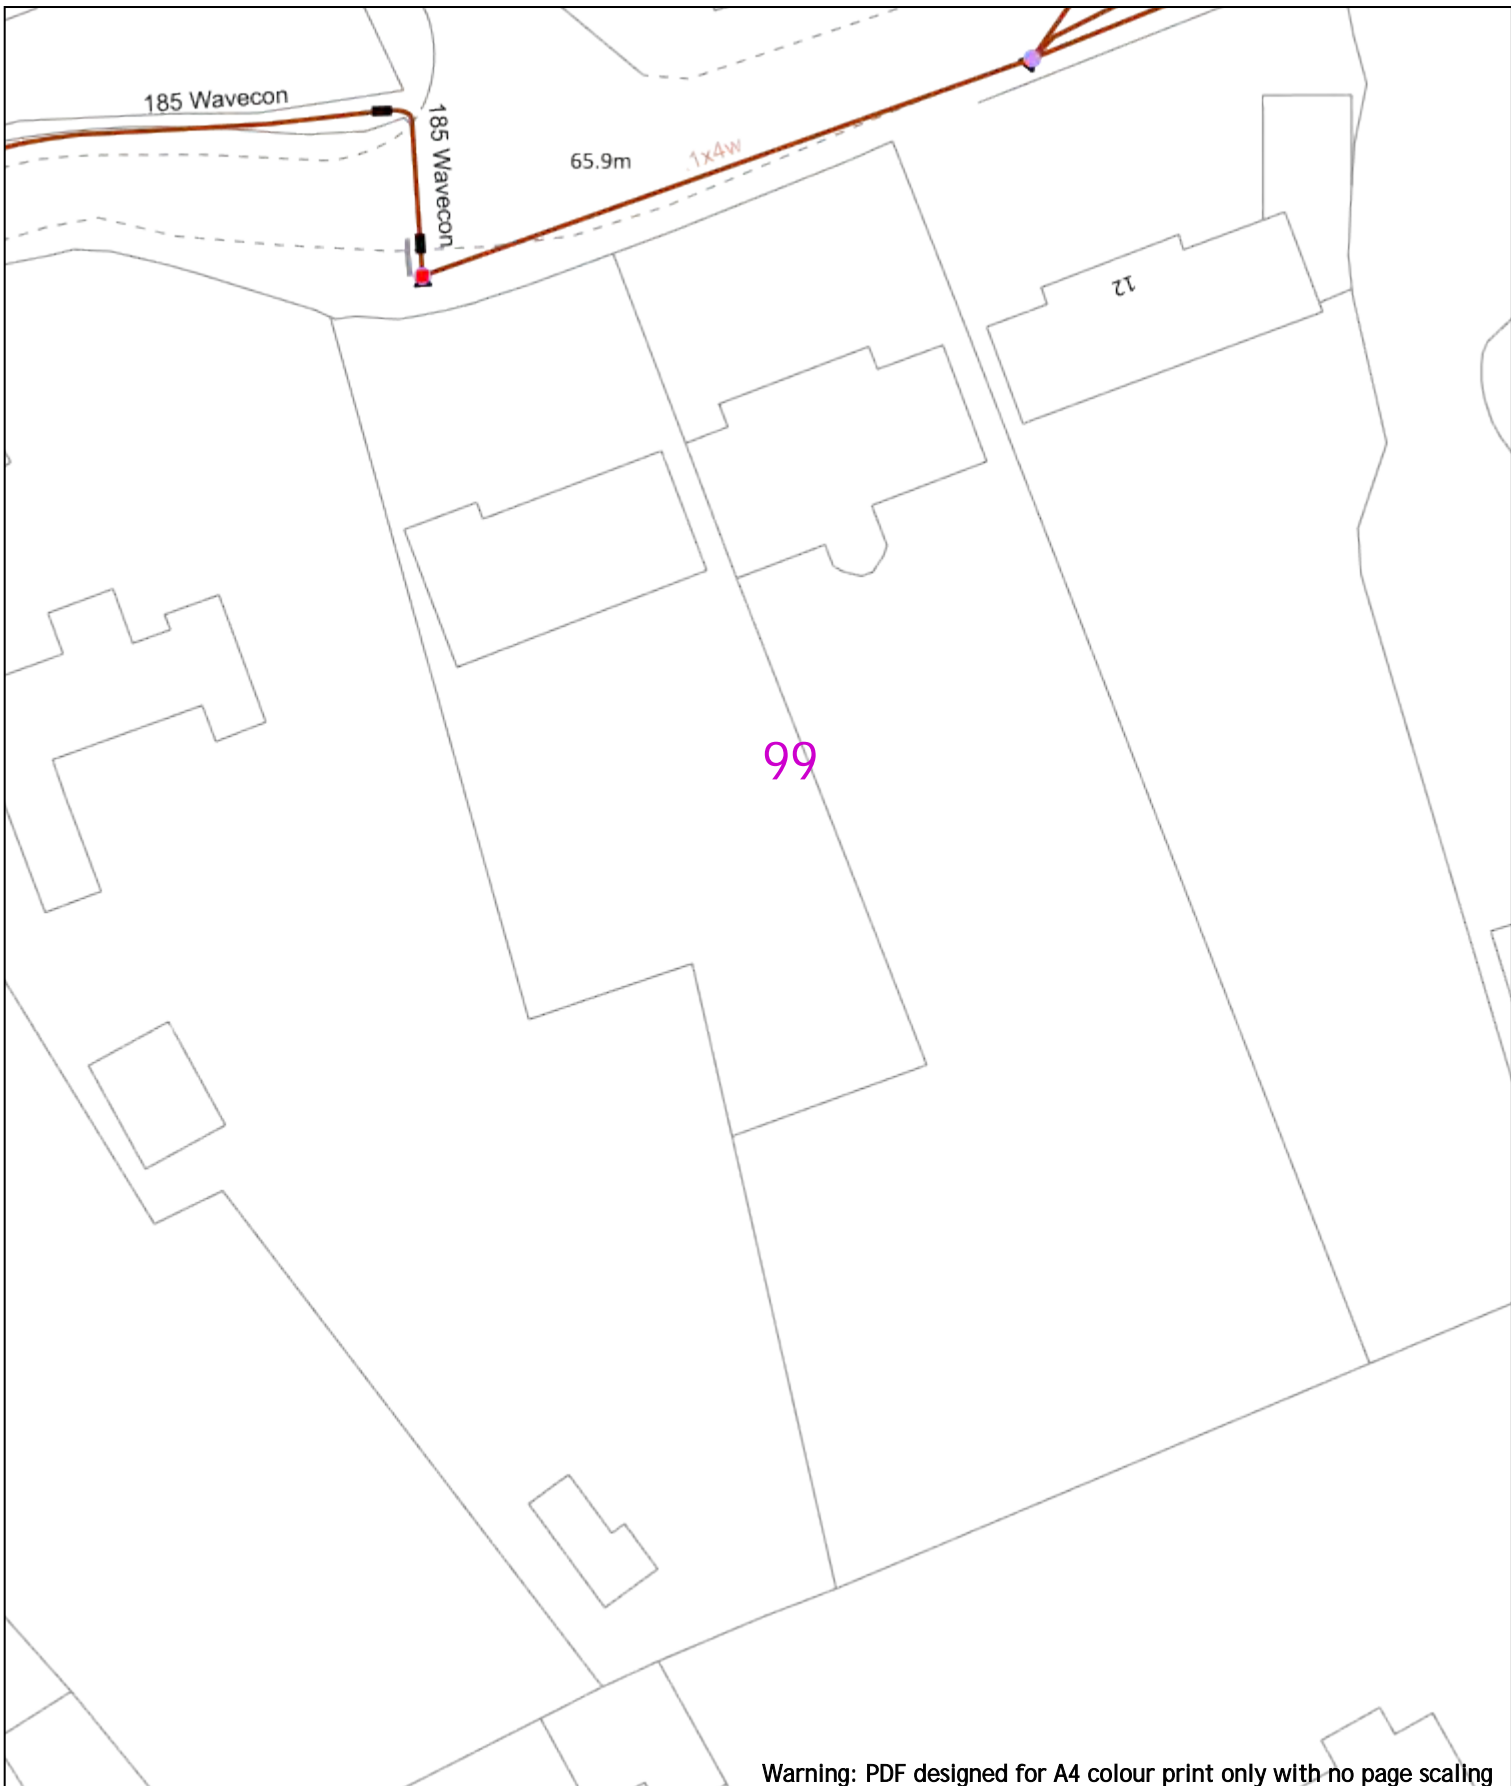

Warning: PDF designed for A4 colour print only with no page scaling

0 20m Dig Sites Area: Line:

Date Requested: 24/06/2022
 Job Reference: 25881010
 Site Location: 448066 213346
 Requested by: Mr Joe Shawyer
 Your Scheme/Reference: 31188_002

Voltages (V)			
LV (Low Voltage) and Services	Up to 1,000V		
HV (High Voltage)	Over 1,000V to 11,000V		
EHV (Extra High Voltage)	22,000V to 132,000V		
Transmission	275,000V and 400,000V		

	NORMAL DEPTH TO THE TOP OF THE CABLE WHEN LAID			
	Services	LV	HV	EHV
Footpath/Unmade	0.45m	0.45m	0.6m	0.8m
Road Crossing	0.6m	0.6m	0.75m	0.9m
Agricultural	1m	1m	1m	1.1m

Legend		Distribution Structures (Electric)	
	Service Cable		Pole, Existing Location
	LV Main		Pole Structure, Existing Location - Single
	2-33kV		Pole Structure, Existing Location - H
	6.6kV		Duct Route
	11kV		Cross Section Route
	22kV		
	33kV		
	66kV		
	132kV		
	275kV		
	400kV		
	Fibre Optic		
	Rigid Cable		


WARNING
 There may have been subsequent alteration to the surface levels. Trial holes must be undertaken to determine position and depths of cables. HS (G) 47 Booklet from the Health and Safety Executive - Avoiding Danger from Buried Cables - should be consulted before commencing excavation work.
 WHEN WORKING IN THE VICINITY OF OVERHEAD LINES THE HEALTH AND SAFETY GUIDANCE NOTES G56 SHOULD BE CONSULTED (AVAILABLE FROM THE HSE WEBSITE)

Scale: 1:500 (When plotted at A4)

Southern Electric Power Distribution plc
 Registered Office: No.1 Forbury Place
 43 Forbury Road Reading RG1 3JH
 Registered In England & Wales No.04094290


If you're unsure & need to seek advice before commencing excavations, please contact:
 General Enquiries: 0800 048 3516

Subject to revision - Master held by SSEN Asset Data Team:
Asset.Data@sse.com
 01256 337 294

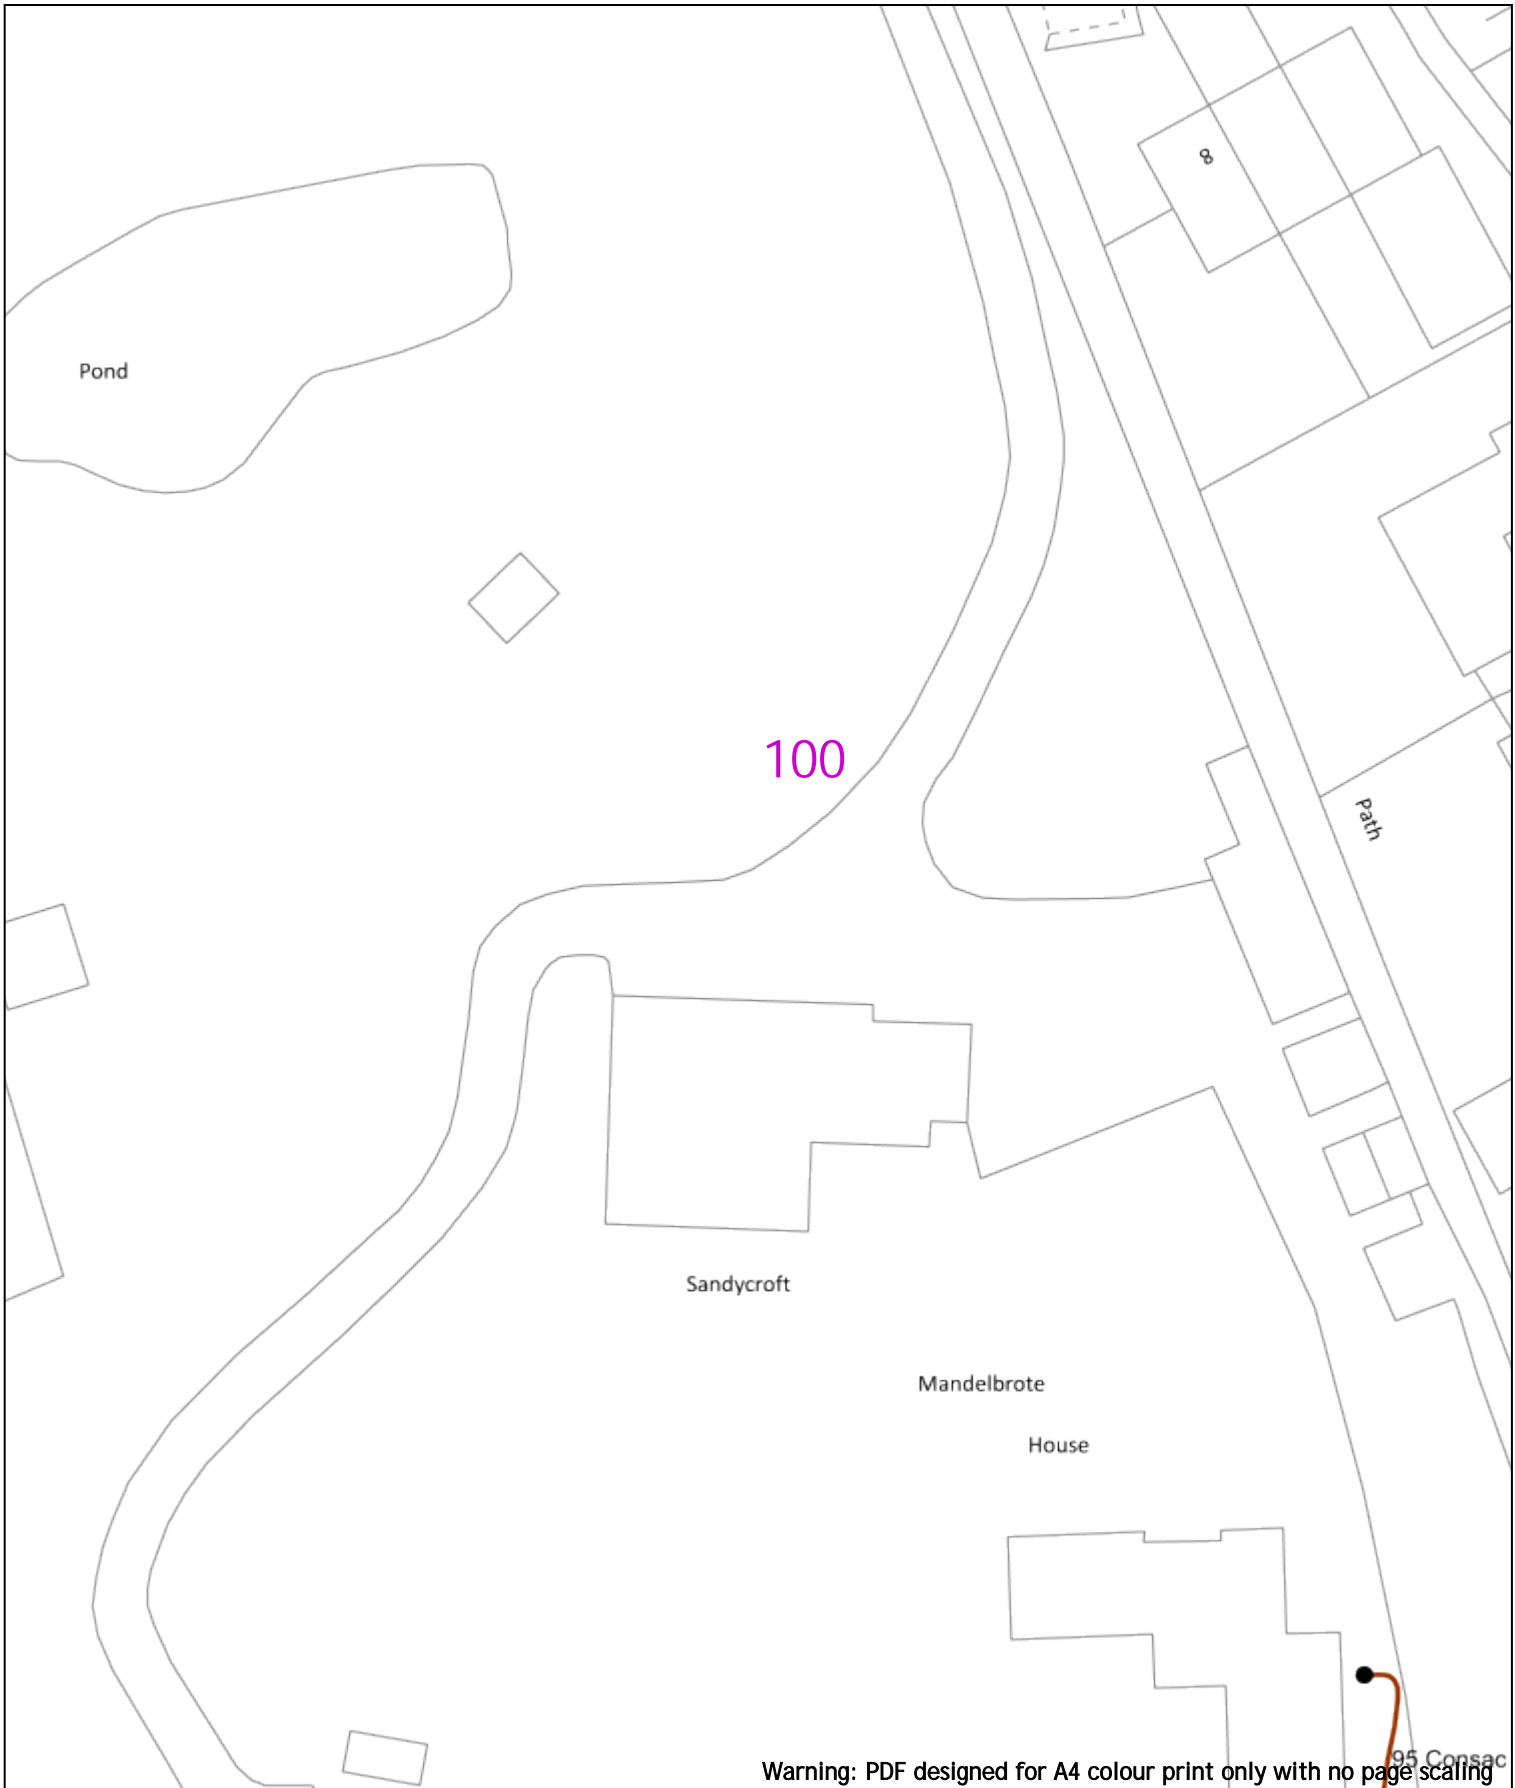

Warning: PDF designed for A4 colour print only with no page scaling

<p>0 20m Dig Sites Area: Line: </p>	<p>Voltages (V)</p> <table border="1" style="width: 100%; border-collapse: collapse;"> <tr> <td>LV (Low Voltage) and Services</td> <td colspan="3">Up to 1,000V</td> </tr> <tr> <td>HV (High Voltage)</td> <td colspan="3">Over 1,000V to 11,000V</td> </tr> <tr> <td>EHV (Extra High Voltage)</td> <td colspan="3">22,000V to 132,000V</td> </tr> <tr> <td>Transmission</td> <td colspan="3">275,000V and 400,000V</td> </tr> </table> <p>NORMAL DEPTH TO THE TOP OF THE CABLE WHEN LAID</p> <table border="1" style="width: 100%; border-collapse: collapse;"> <thead> <tr> <th>Services</th> <th>LV</th> <th>HV</th> <th>EHV</th> </tr> </thead> <tbody> <tr> <td>Footpath/Unmade</td> <td>0.45m</td> <td>0.45m</td> <td>0.6m</td> </tr> <tr> <td>Road Crossing</td> <td>0.6m</td> <td>0.6m</td> <td>0.75m</td> </tr> <tr> <td>Agricultural</td> <td>1m</td> <td>1m</td> <td>1.1m</td> </tr> </tbody> </table>	LV (Low Voltage) and Services	Up to 1,000V			HV (High Voltage)	Over 1,000V to 11,000V			EHV (Extra High Voltage)	22,000V to 132,000V			Transmission	275,000V and 400,000V			Services	LV	HV	EHV	Footpath/Unmade	0.45m	0.45m	0.6m	Road Crossing	0.6m	0.6m	0.75m	Agricultural	1m	1m	1.1m	<p>Legend</p> <ul style="list-style-type: none"> Service Cable LV Mains 6.6kV 11kV 22kV 33kV 66kV 132kV 275kV 400kV Fibre Optic Pilot Cable <p>Distribution Structures (Electric)</p> <ul style="list-style-type: none"> Pole, Existing Location Pole Structure, Existing Location - Single Pole Structure, Existing Location - H Duct Route Cross Section Route 	<p> Scottish & Southern Electricity Networks</p> <p>Southern Electric Power Distribution plc Registered Office: No.1 Forbury Place 43 Forbury Road Reading RG1 3JH Registered In England & Wales No.04094290</p> <p>If you're unsure & need to seek advice before commencing excavations, please contact: General Enquiries: 0800 048 3516</p> <p>Subject to revision – Master held by SSEN Asset Data Team: Asset.Data@sse.com 01256 337 294</p>
LV (Low Voltage) and Services	Up to 1,000V																																		
HV (High Voltage)	Over 1,000V to 11,000V																																		
EHV (Extra High Voltage)	22,000V to 132,000V																																		
Transmission	275,000V and 400,000V																																		
Services	LV	HV	EHV																																
Footpath/Unmade	0.45m	0.45m	0.6m																																
Road Crossing	0.6m	0.6m	0.75m																																
Agricultural	1m	1m	1.1m																																
<p>Scale: 1:500 (When plotted at A4)</p> <p>WARNING There may have been subsequent alteration to the surface levels. Trial holes must be undertaken to determine position and depths of cables. HS (G) 47 Booklet from the Health and Safety Executive – Avoiding Danger from Buried Cables – should be consulted before commencing excavation work. WHEN WORKING IN THE VICINITY OF OVERHEAD LINES THE HEALTH AND SAFETY GUIDANCE NOTES G56 SHOULD BE CONSULTED (AVAILABLE FROM THE HSE WEBSITE)</p>			<p>BASED UPON THE ORDNANCE SURVEY MAP WITH THE SANCTION OF THE CONTROLLER OF H.M STATIONERY OFFICE CROWN COPYRIGHT RESERVED. This copy has been made by or with the authority of Scottish and Southern Energy Power Distribution Ltd. Pursuant to section 47 of the Copyright, Designs and Patents Act 1988 ("The Act"). Unless the Act provides a relevant exception to copyright the copy must not be copied without prior permission of the copyright owner. Plans generated by DigSAFE Pro™ software provided by Lineasearchbeforeldg.</p>																																

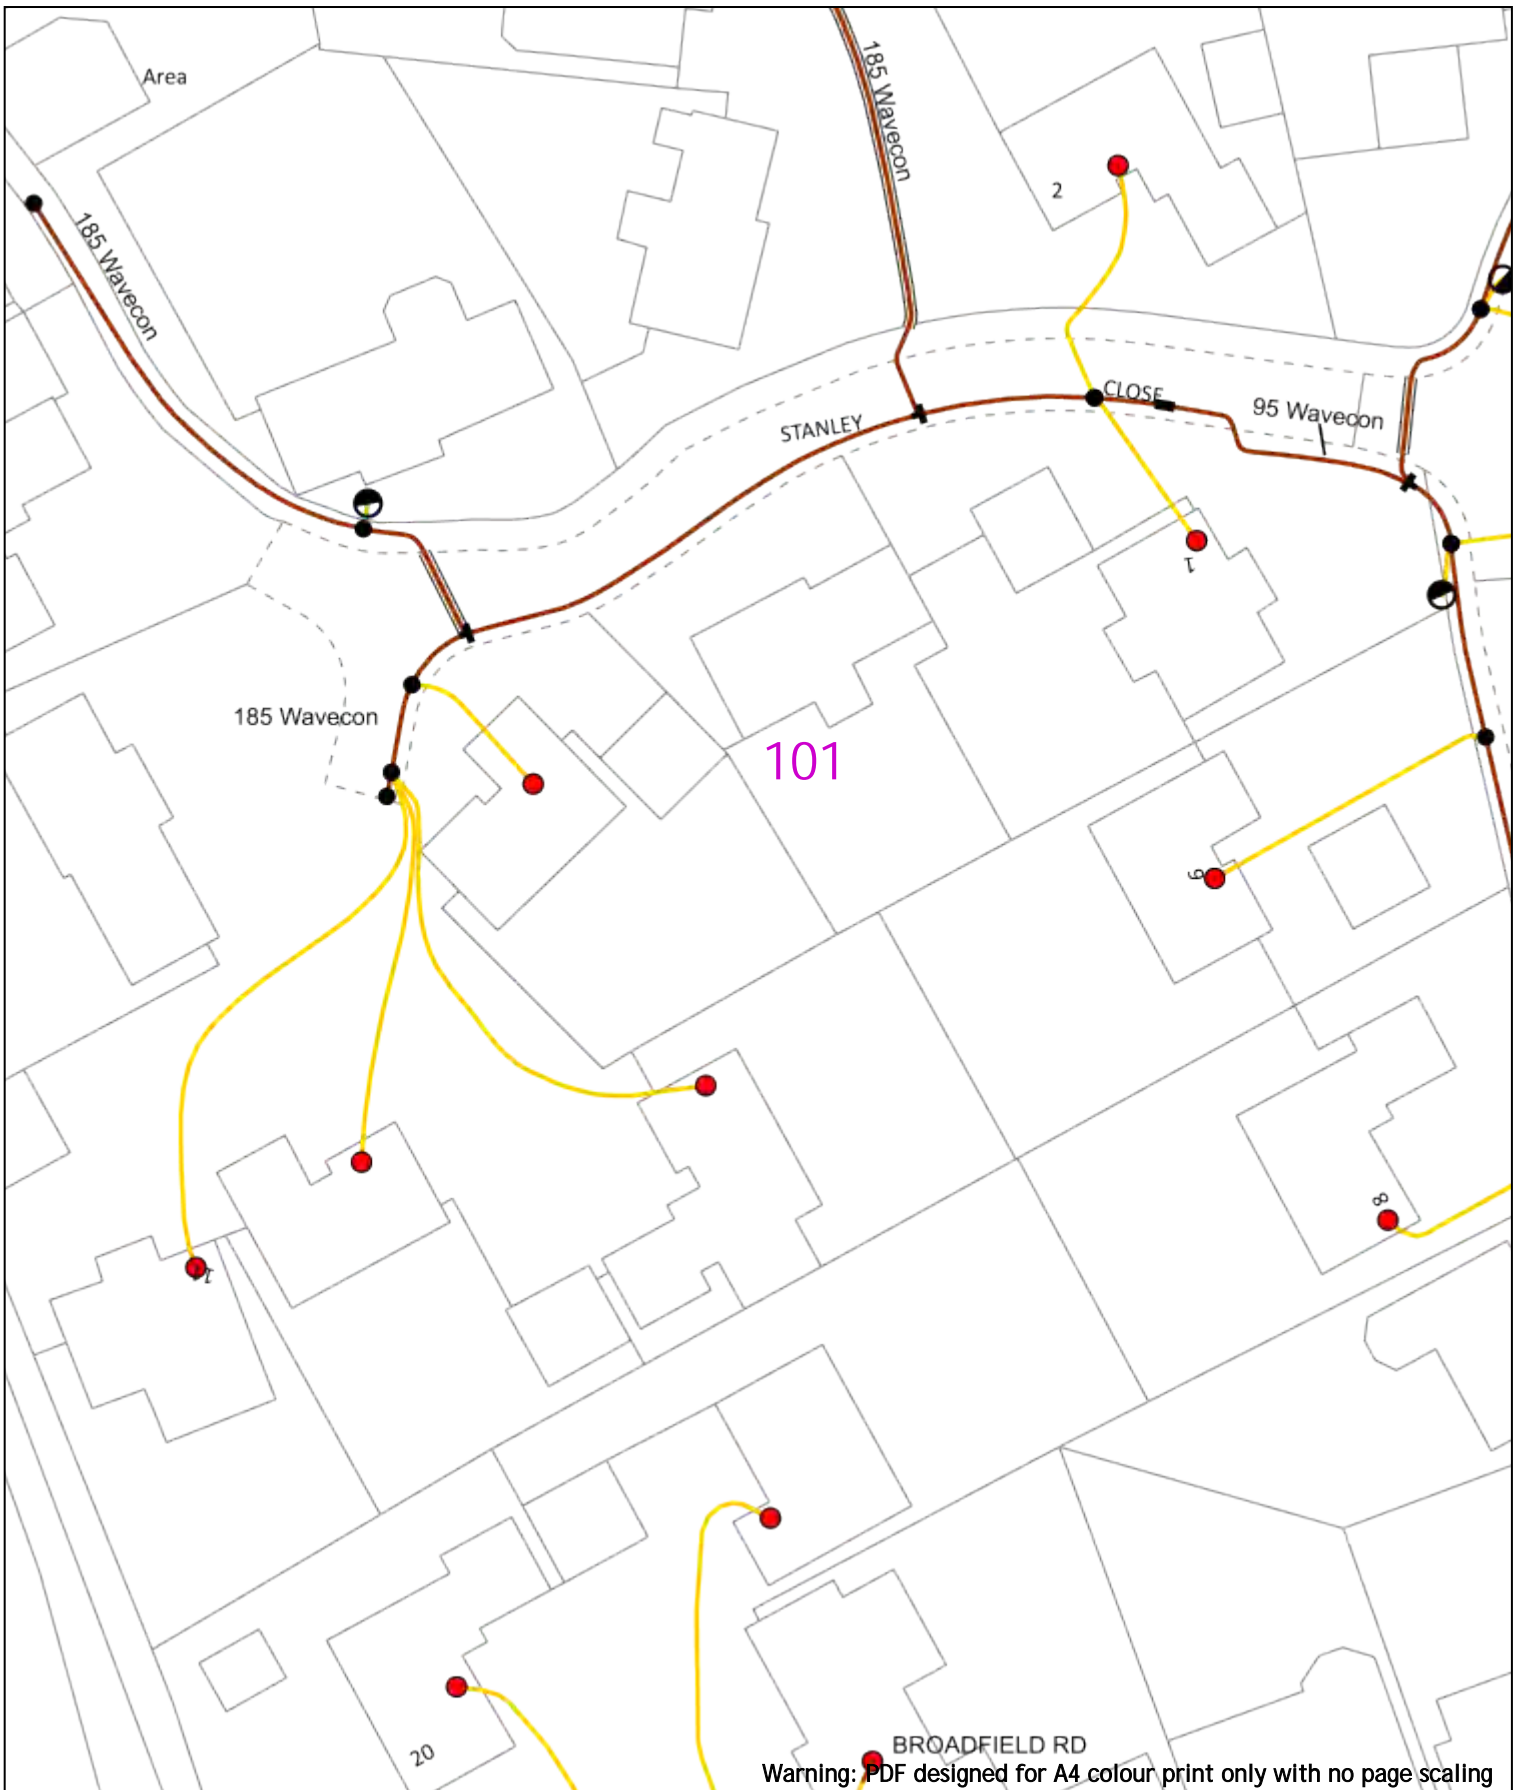

0 20m Dig Sites Area: Line:

Date Requested: 24/06/2022
 Job Reference: 25881010
 Site Location: 448066 213346
 Requested by: Mr Joe Shawyer
 Your Scheme/Reference: 31188_002

Voltages (V)			
LV (Low Voltage) and Services	Up to 1,000V		
HV (High Voltage)	Over 1,000V to 11,000V		
EHV (Extra High Voltage)	22,000V to 132,000V		
Transmission	275,000V and 400,000V		
NORMAL DEPTH TO THE TOP OF THE CABLE WHEN LAID			
Services	LV	HV	EHV
Footpath/Unmade	0.45m	0.45m	0.6m
Road Crossing	0.6m	0.6m	0.75m
Agricultural	1m	1m	1.1m

Legend	
	Service Cable
	LV Main
	6.6kV
	11kV
	22kV
	33kV
	66kV
	132kV
	275kV
	400kV
	Fiber Optic
	Rigid Cable

Distribution Structures (Electric)	
	Pole, Existing Location
	Pole Structure, Existing Location - Single
	Pole Structure, Existing Location - H
	Duct Route
	Cross Section Route

WARNING
 There may have been subsequent alteration to the surface levels. Trial holes must be undertaken to determine position and depths of cables. HS (G) 47 Booklet from the Health and Safety Executive - Avoiding Danger from Buried Cables - should be consulted before commencing excavation work.
 WHEN WORKING IN THE VICINITY OF OVERHEAD LINES THE HEALTH AND SAFETY GUIDANCE NOTES G56 SHOULD BE CONSULTED (AVAILABLE FROM THE HSE WEBSITE)


Scale: 1:500 (When plotted at A4)

Southern Electric Power Distribution plc
 Registered Office: No.1 Forbury Place
 43 Forbury Road Reading RG1 3JH
 Registered In England & Wales No.04094290

If you're unsure & need to seek advice before commencing excavations, please contact:
 General Enquiries: 0800 048 3516

Subject to revision - Master held by SSEN Asset Data Team:
Asset.Data@sse.com
 01256 337 294

BASED UPON THE ORDNANCE SURVEY MAP WITH THE SANCTION OF THE CONTROLLER OF H.M. STATIONERY OFFICE CROWN COPYRIGHT RESERVED.
 This copy has been made by or with the authority of Scottish and Southern Energy Power Distribution Ltd. Pursuant to section 47 of the Copyright, Designs and Patents Act 1988 ("The Act"). Unless the Act provides a relevant exception to copyright the copy must not be copied without permission of the copyright owner.

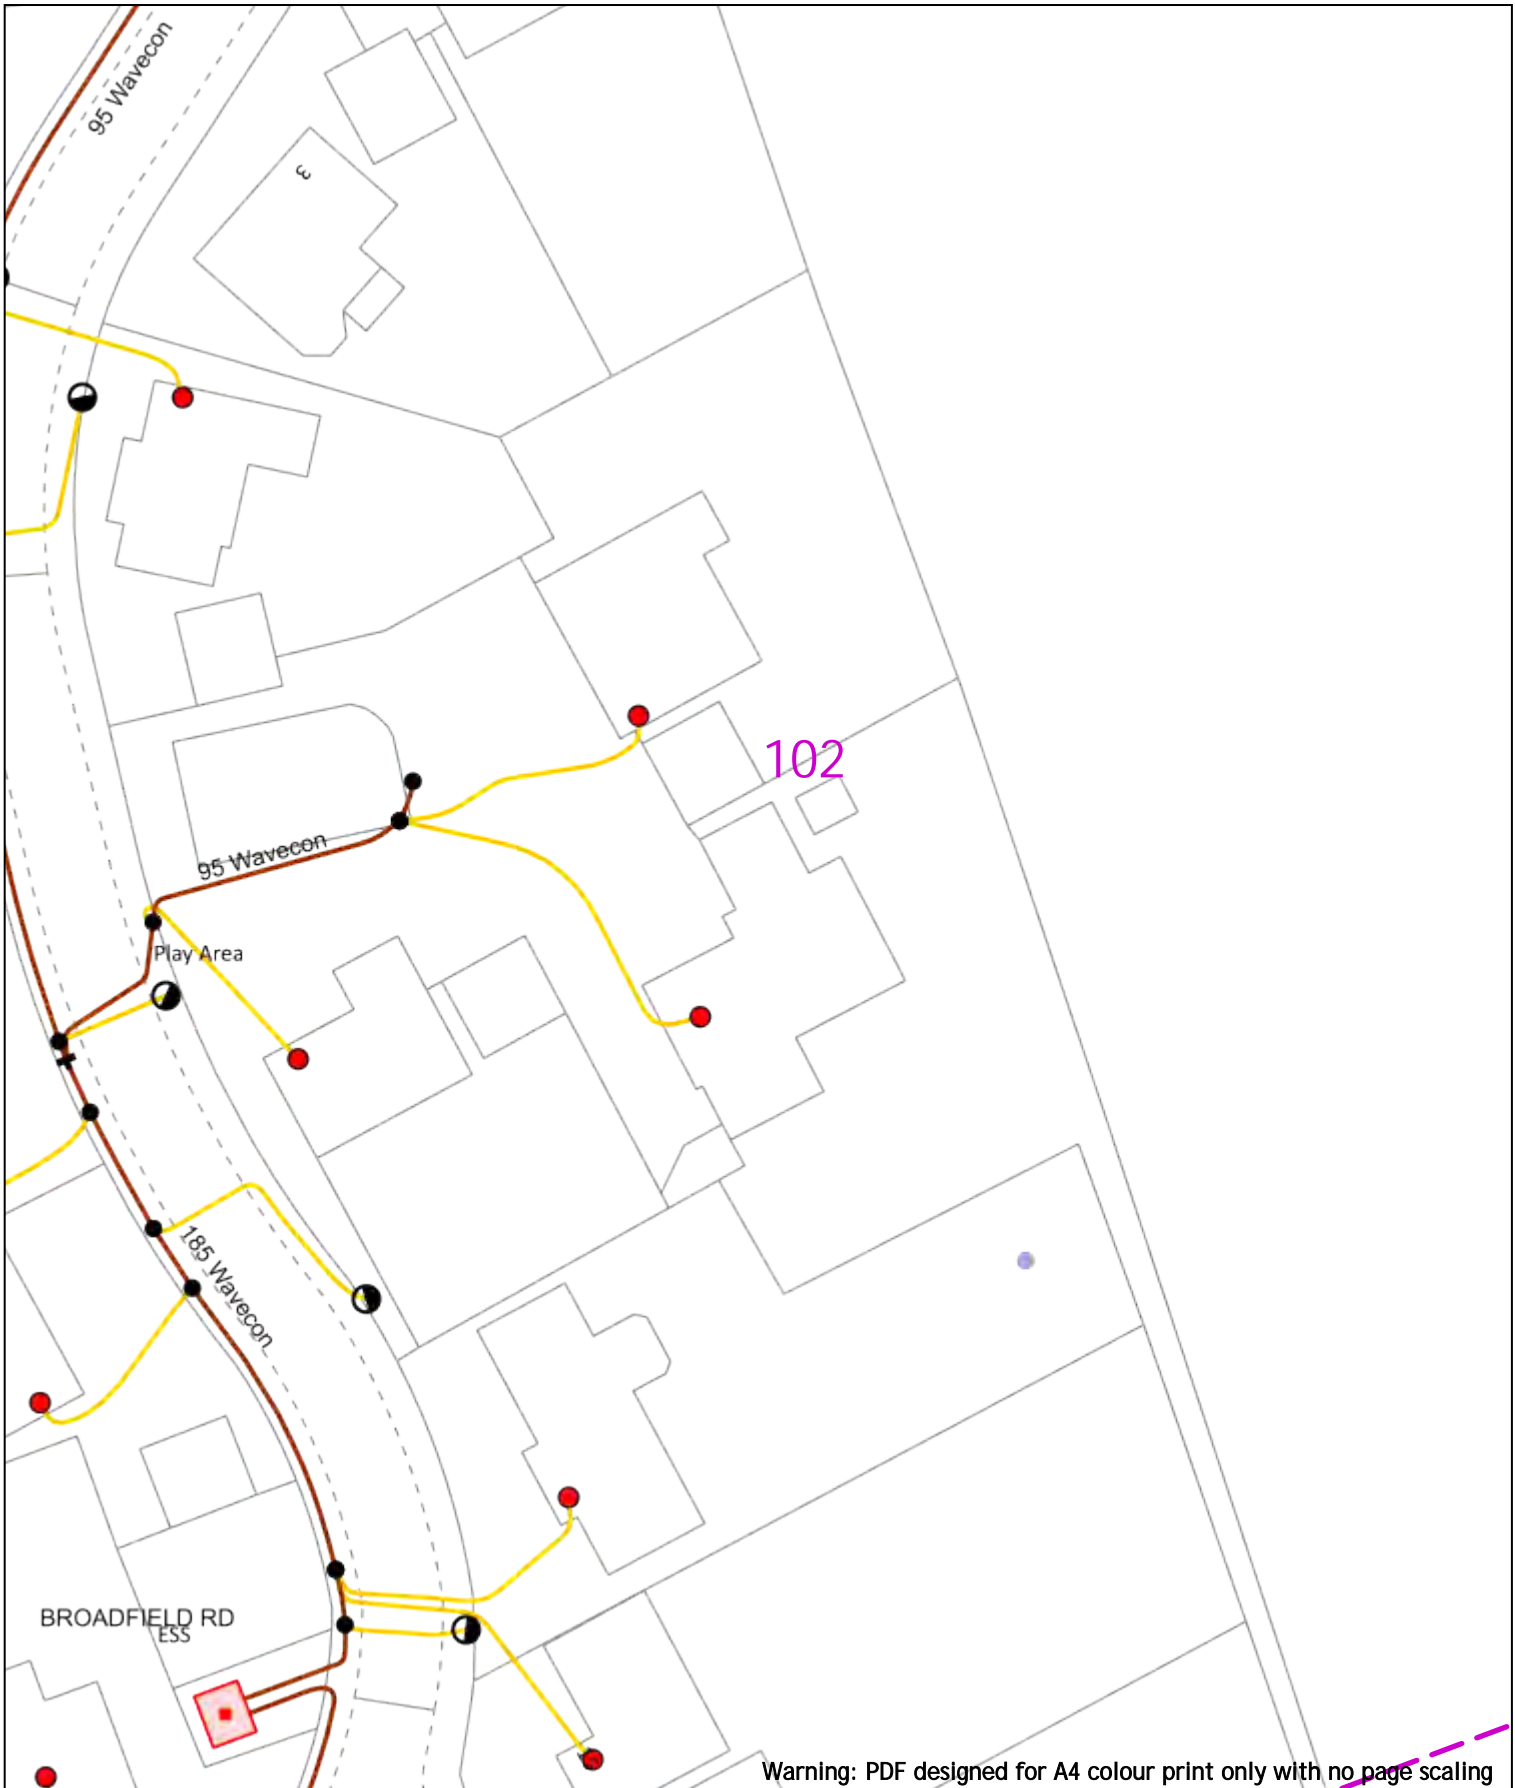

0 20m Dig Sites Area: Line:

Date Requested: 24/06/2022
 Job Reference: 25881010
 Site Location: 448066 213346
 Requested by: Mr Joe Shawyer
 Your Scheme/Reference: 31188_002

Voltages (V)			
LV (Low Voltage) and Services	Up to 1,000V		
HV (High Voltage)	Over 1,000V to 11,000V		
EHV (Extra High Voltage)	22,000V to 132,000V		
Transmission	275,000V and 400,000V		

NORMAL DEPTH TO THE TOP OF THE CABLE WHEN LAID	Services			
	LV	HV	EHV	
Footpath/Unmade	0.45m	0.45m	0.6m	0.8m
Road Crossing	0.6m	0.6m	0.75m	0.9m
Agricultural	1m	1m	1m	1.1m

Legend		Distribution Structures (Electric)	
	Service Cable		Pole, Existing Location
	LV Mains		Pole Structure, Existing Location - Single
	6.6kV		Pole Structure, Existing Location - H
	11kV		Duct Route
	22kV		Cross Section Route
	33kV		
	66kV		
	132kV		
	275kV		
	400kV		
	Fibre Optic		
	Rigid Cable		

WARNING
 There may have been subsequent alteration to the surface levels. Trial holes must be undertaken to determine position and depths of cables. HS (G) 47 Booklet from the Health and Safety Executive - Avoiding Danger from Buried Cables - should be consulted before commencing excavation work.
 WHEN WORKING IN THE VICINITY OF OVERHEAD LINES THE HEALTH AND SAFETY GUIDANCE NOTES G56 SHOULD BE CONSULTED (AVAILABLE FROM THE HSE WEBSITE)

Scale: 1:500 (When plotted at A4)

Southern Electric Power Distribution plc
 Registered Office: No.1 Forbury Place
 43 Forbury Road Reading RG1 3JH
 Registered In England & Wales No.04094290

If you're unsure & need to seek advice before commencing excavations, please contact:
 General Enquiries: 0800 048 3516

Subject to revision - Master held by SSEN Asset Data Team:
Asset.Data@sse.com
 01256 337 294

103

Warning: PDF designed for A4 colour print only with no page scaling

0  20m Dig Sites Area:  Line: 

Date Requested: 24/06/2022
 Job Reference: 25881010
 Site Location: 448066 213346
 Requested by: Mr Joe Shawyer
 Your Scheme/Reference: 31188_002

Voltages (V)			
LV (Low Voltage) and Services	Up to 1,000V		
HV (High Voltage)	Over 1,000V to 11,000V		
EHV (Extra High Voltage)	22,000V to 132,000V		
Transmission	275,000V and 400,000V		
NORMAL DEPTH TO THE TOP OF THE CABLE WHEN LAID			
Services	LV	HV	EHV
Footpath/Unmade	0.45m	0.45m	0.6m 0.8m
Road Crossing	0.6m	0.6m	0.75m 0.9m
Agricultural	1m	1m	1m 1.1m

Legend

- Service Cable
- LV Mains
- 2-33kV
- 66kV
- 132kV
- 275kV
- 400kV
- Fibre Optic
- Pilot Cable

Distribution Structures (Electric)

- Pole, Existing Location
- Pole Structure, Existing Location - Single
- Pole Structure, Existing Location - H
- Duct Route
- Cross Section Route

WARNING
 There may have been subsequent alteration to the surface levels. Trial holes must be undertaken to determine position and depths of cables. HS (G) 47 Booklet from the Health and Safety Executive - Avoiding Danger from Buried Cables - should be consulted before commencing excavation work.
WHEN WORKING IN THE VICINITY OF OVERHEAD LINES THE HEALTH AND SAFETY GUIDANCE NOTES G56 SHOULD BE CONSULTED (AVAILABLE FROM THE HSE WEBSITE)




Southern Electric Power Distribution plc
 Registered Office: No.1 Forbury Place
 43 Forbury Road Reading RG1 3JH
 Registered In England & Wales No.04094290

If you're unsure & need to seek advice before commencing excavations, please contact:
 General Enquiries: 0800 048 3516

Subject to revision - Master held by SSEN Asset Data Team:
Asset.Data@sse.com
 01256 337 294

Scale: 1:500 (When plotted at A4)

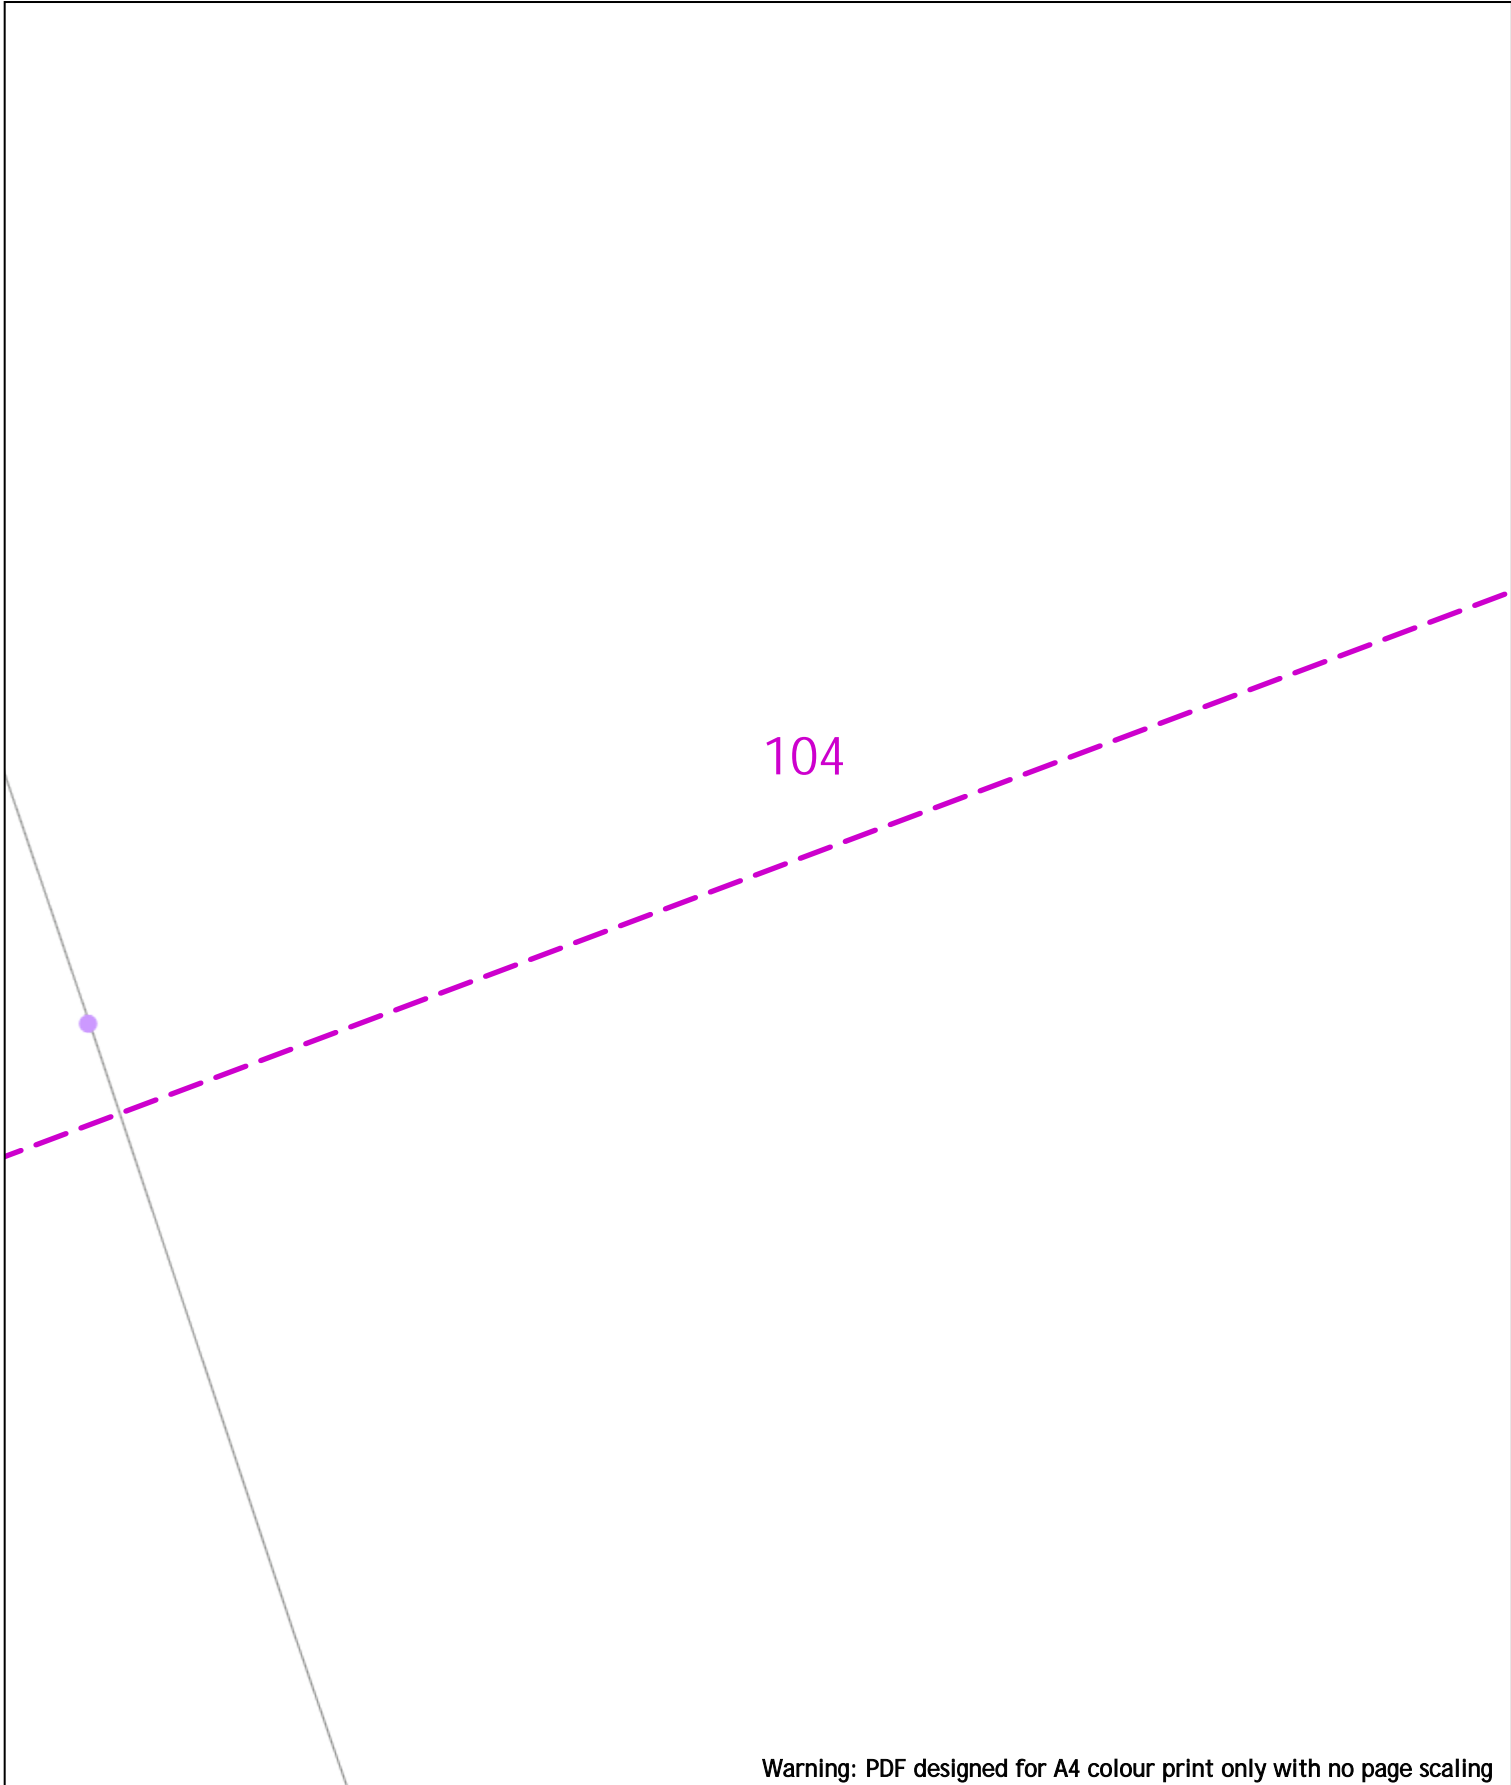

Warning: PDF designed for A4 colour print only with no page scaling

0 20m Dig Sites Area: Line:

Date Requested: 24/06/2022
 Job Reference: 25881010
 Site Location: 448066 213346
 Requested by: Mr Joe Shawyer
 Your Scheme/Reference: 31188_002

Voltages (V)				
LV (Low Voltage) and Services	Up to 1,000V			
HV (High Voltage)	Over 1,000V to 11,000V			
EHV (Extra High Voltage)	22,000V to 132,000V			
Transmission	275,000V and 400,000V			

NORMAL DEPTH TO THE TOP OF THE CABLE WHEN LAID				
Services	LV	HV	EHV	
Footpath/Unmade	0.45m	0.45m	0.6m	0.8m
Road Crossing	0.6m	0.6m	0.75m	0.9m
Agricultural	1m	1m	1m	1.1m

Legend		Distribution Structures (Electric)	
	Service Cable		Pole, Existing Location
	LV Mains		Pole Structure, Existing Location - Single
	2-33kV		Pole Structure, Existing Location - H
	6.6kV		Duct Route
	11kV		Cross Section Route
	22kV		
	33kV		
	66kV		
	132kV		
	275kV		
	400kV		
	Fibre Optic		
	Rigid Cable		


WARNING
 There may have been subsequent alteration to the surface levels. Trial holes must be undertaken to determine position and depths of cables. HS (G) 47 Booklet from the Health and Safety Executive - Avoiding Danger from Buried Cables - should be consulted before commencing excavation work.
 WHEN WORKING IN THE VICINITY OF OVERHEAD LINES THE HEALTH AND SAFETY GUIDANCE NOTES G56 SHOULD BE CONSULTED (AVAILABLE FROM THE HSE WEBSITE)

Scale: 1:500 (When plotted at A4)

Southern Electric Power Distribution plc
 Registered Office: No.1 Forbury Place
 43 Forbury Road Reading RG1 3JH
 Registered In England & Wales No.04094290

If you're unsure & need to seek advice before commencing excavations, please contact:
 General Enquiries: 0800 048 3516

Subject to revision - Master held by SSEN Asset Data Team:
Asset.Data@sse.com
 01256 337 294

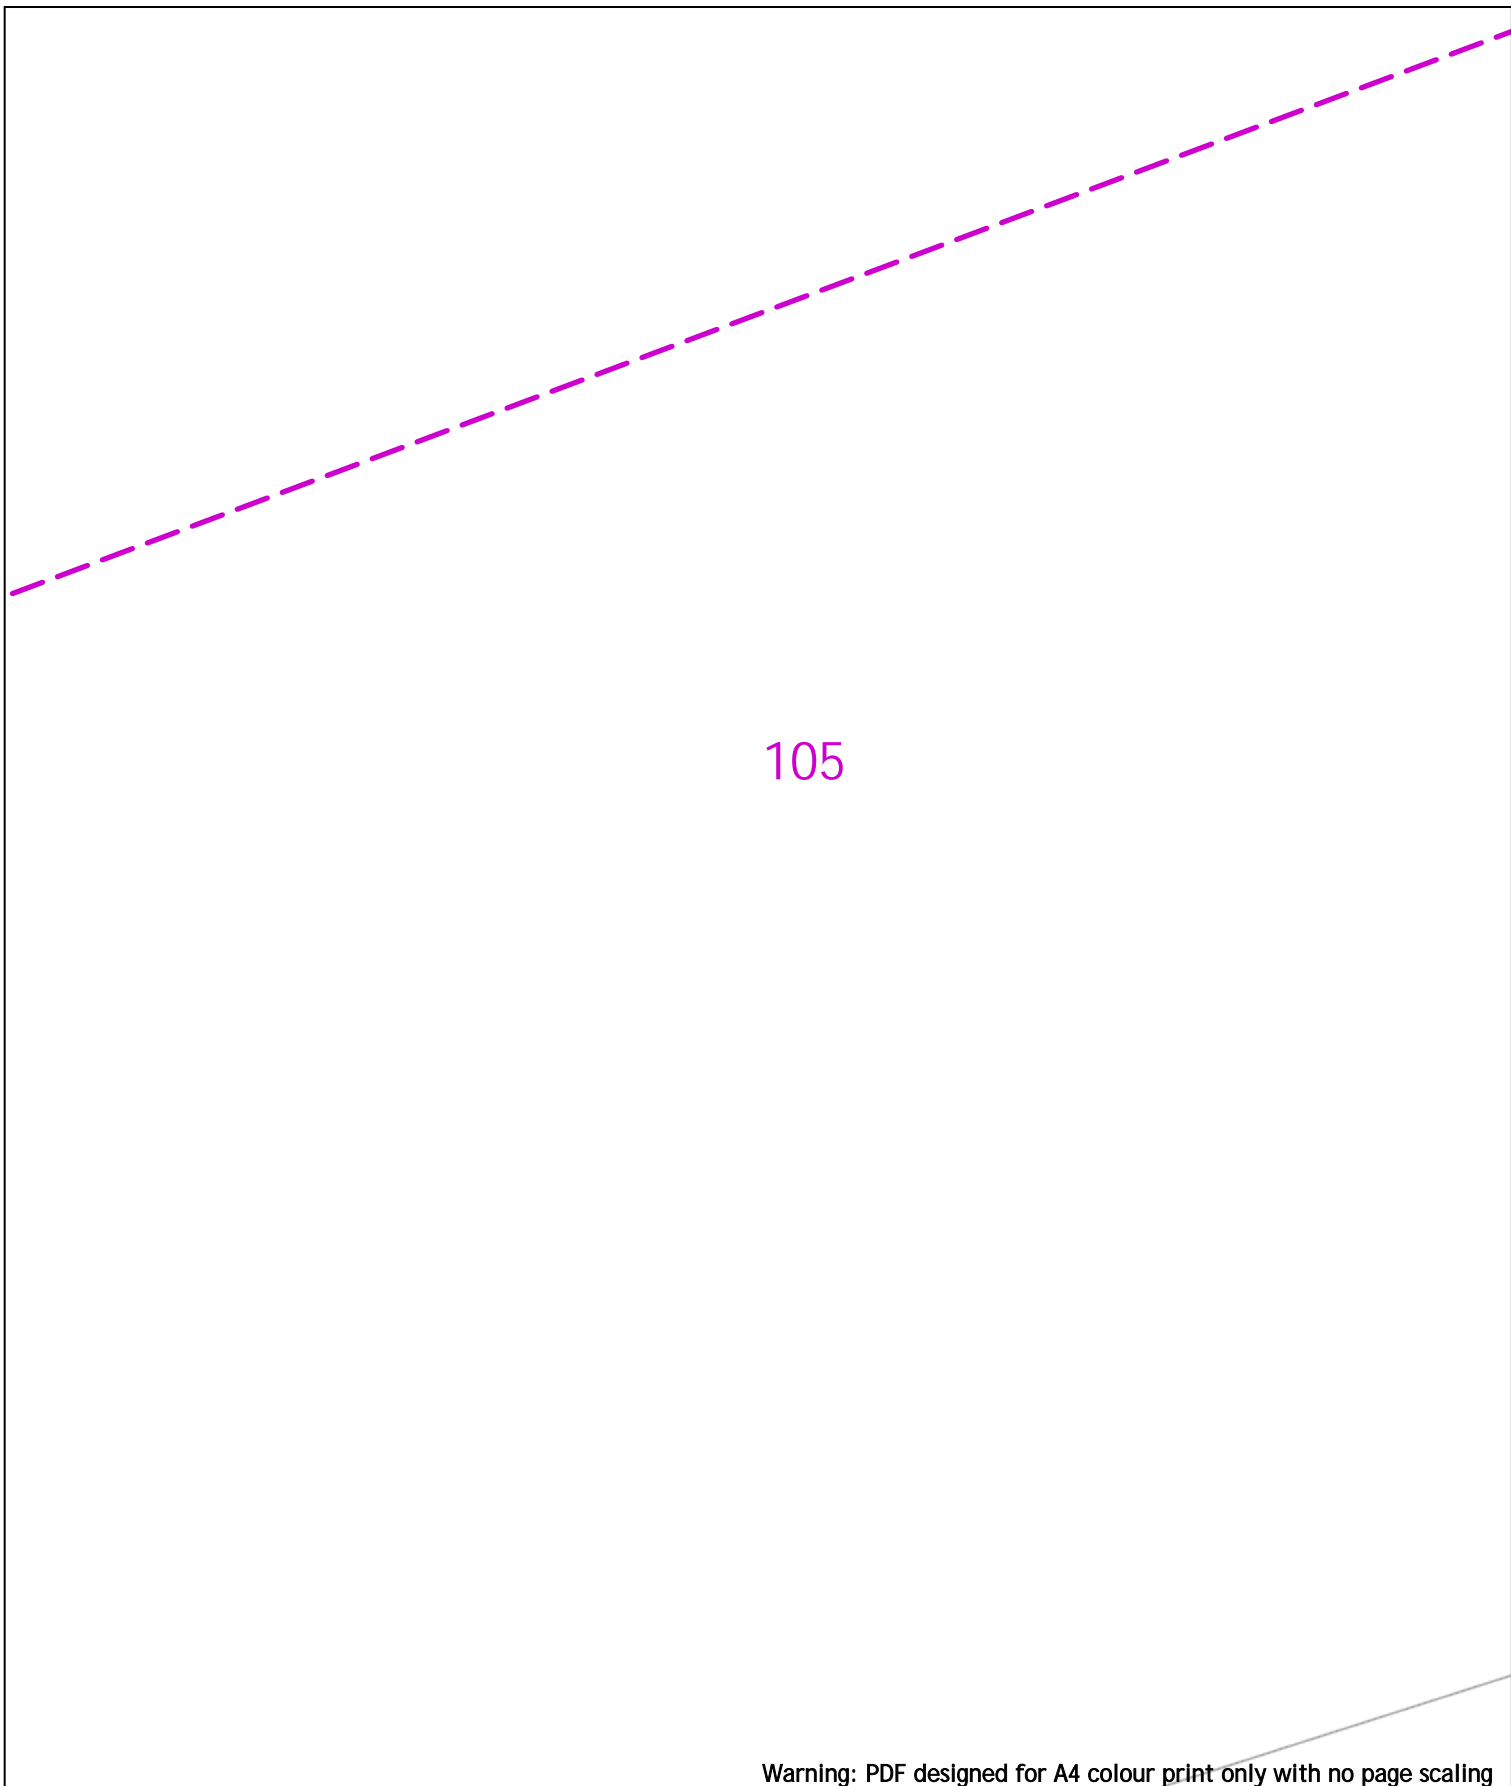

105

Warning: PDF designed for A4 colour print only with no page scaling

0 20m Dig Sites Area: Line:

Date Requested: 24/06/2022
 Job Reference: 25881010
 Site Location: 448066 213346
 Requested by: Mr Joe Shawyer
 Your Scheme/Reference: 31188_002

Voltages (V)			
LV (Low Voltage) and Services	Up to 1,000V		
HV (High Voltage)	Over 1,000V to 11,000V		
EHV (Extra High Voltage)	22,000V to 132,000V		
Transmission	275,000V and 400,000V		

NORMAL DEPTH TO THE TOP OF THE CABLE WHEN LAID			
Services	LV	HV	EHV
Footpath/Unmade	0.45m	0.45m	0.6m
Road Crossing	0.6m	0.6m	0.75m
Agricultural	1m	1m	1.1m

WARNING
 There may have been subsequent alteration to the surface levels. Trial holes must be undertaken to determine position and depths of cables. HS (G) 47 Booklet from the Health and Safety Executive – Avoiding Danger from Buried Cables – should be consulted before commencing excavation work.
WHEN WORKING IN THE VICINITY OF OVERHEAD LINES THE HEALTH AND SAFETY GUIDANCE NOTES G56 SHOULD BE CONSULTED (AVAILABLE FROM THE HSE WEBSITE)

Southern Electric Power Distribution plc
 Registered Office: No.1 Forbury Place
 43 Forbury Road Reading RG1 3JH
 Registered In England & Wales No.04094290

If you're unsure & need to seek advice before commencing excavations, please contact:
 General Enquiries: 0800 048 3516

Subject to revision – Master held by SSEN Asset Data Team:
Asset.Data@sse.com
 01256 337 294

106

Warning: PDF designed for A4 colour print only with no page scaling

0  20m Dig Sites Area:  Line: 

Date Requested: 24/06/2022
 Job Reference: 25881010
 Site Location: 448066 213346
 Requested by: Mr Joe Shawyer

Your Scheme/Reference: 31188_002

Voltages (V)			
LV (Low Voltage) and Services	Up to 1,000V		
HV (High Voltage)	Over 1,000V to 11,000V		
EHV (Extra High Voltage)	22,000V to 132,000V		
Transmission	275,000V and 400,000V		
NORMAL DEPTH TO THE TOP OF THE CABLE WHEN LAID			
Services	LV	HV	EHV
Footpath/Unmade	0.45m	0.45m	0.6m
Road Crossing	0.6m	0.6m	0.75m
Agricultural	1m	1m	1.1m

<p>Legend</p> <ul style="list-style-type: none"> Service Cable LV Mains 2-33kV 6.6kV 11kV 22kV 33kV 66kV 132kV 275kV 400kV Fibre Optic Pilot Cable 	<p>Distribution Structures (Electric)</p> <ul style="list-style-type: none"> Pole, Existing Location Pole Structure, Existing Location - Single Pole Structure, Existing Location - H Duct Route Cross Section Route
---	---


WARNING
 There may have been subsequent alteration to the surface levels. Trial holes must be undertaken to determine position and depths of cables. HS (G) 47 Booklet from the Health and Safety Executive - Avoiding Danger from Buried Cables - should be consulted before commencing excavation work.
WHEN WORKING IN THE VICINITY OF OVERHEAD LINES THE HEALTH AND SAFETY GUIDANCE NOTES G56 SHOULD BE CONSULTED (AVAILABLE FROM THE HSE WEBSITE)



Southern Electric Power Distribution plc
 Registered Office: No.1 Forbury Place
 43 Forbury Road Reading RG1 3JH
 Registered In England & Wales No.04094290

If you're unsure & need to seek advice before commencing excavations, please contact:
 General Enquiries: 0800 048 3516

Subject to revision - Master held by SSEN Asset Data Team:
Asset.Data@sse.com
 01256 337 294

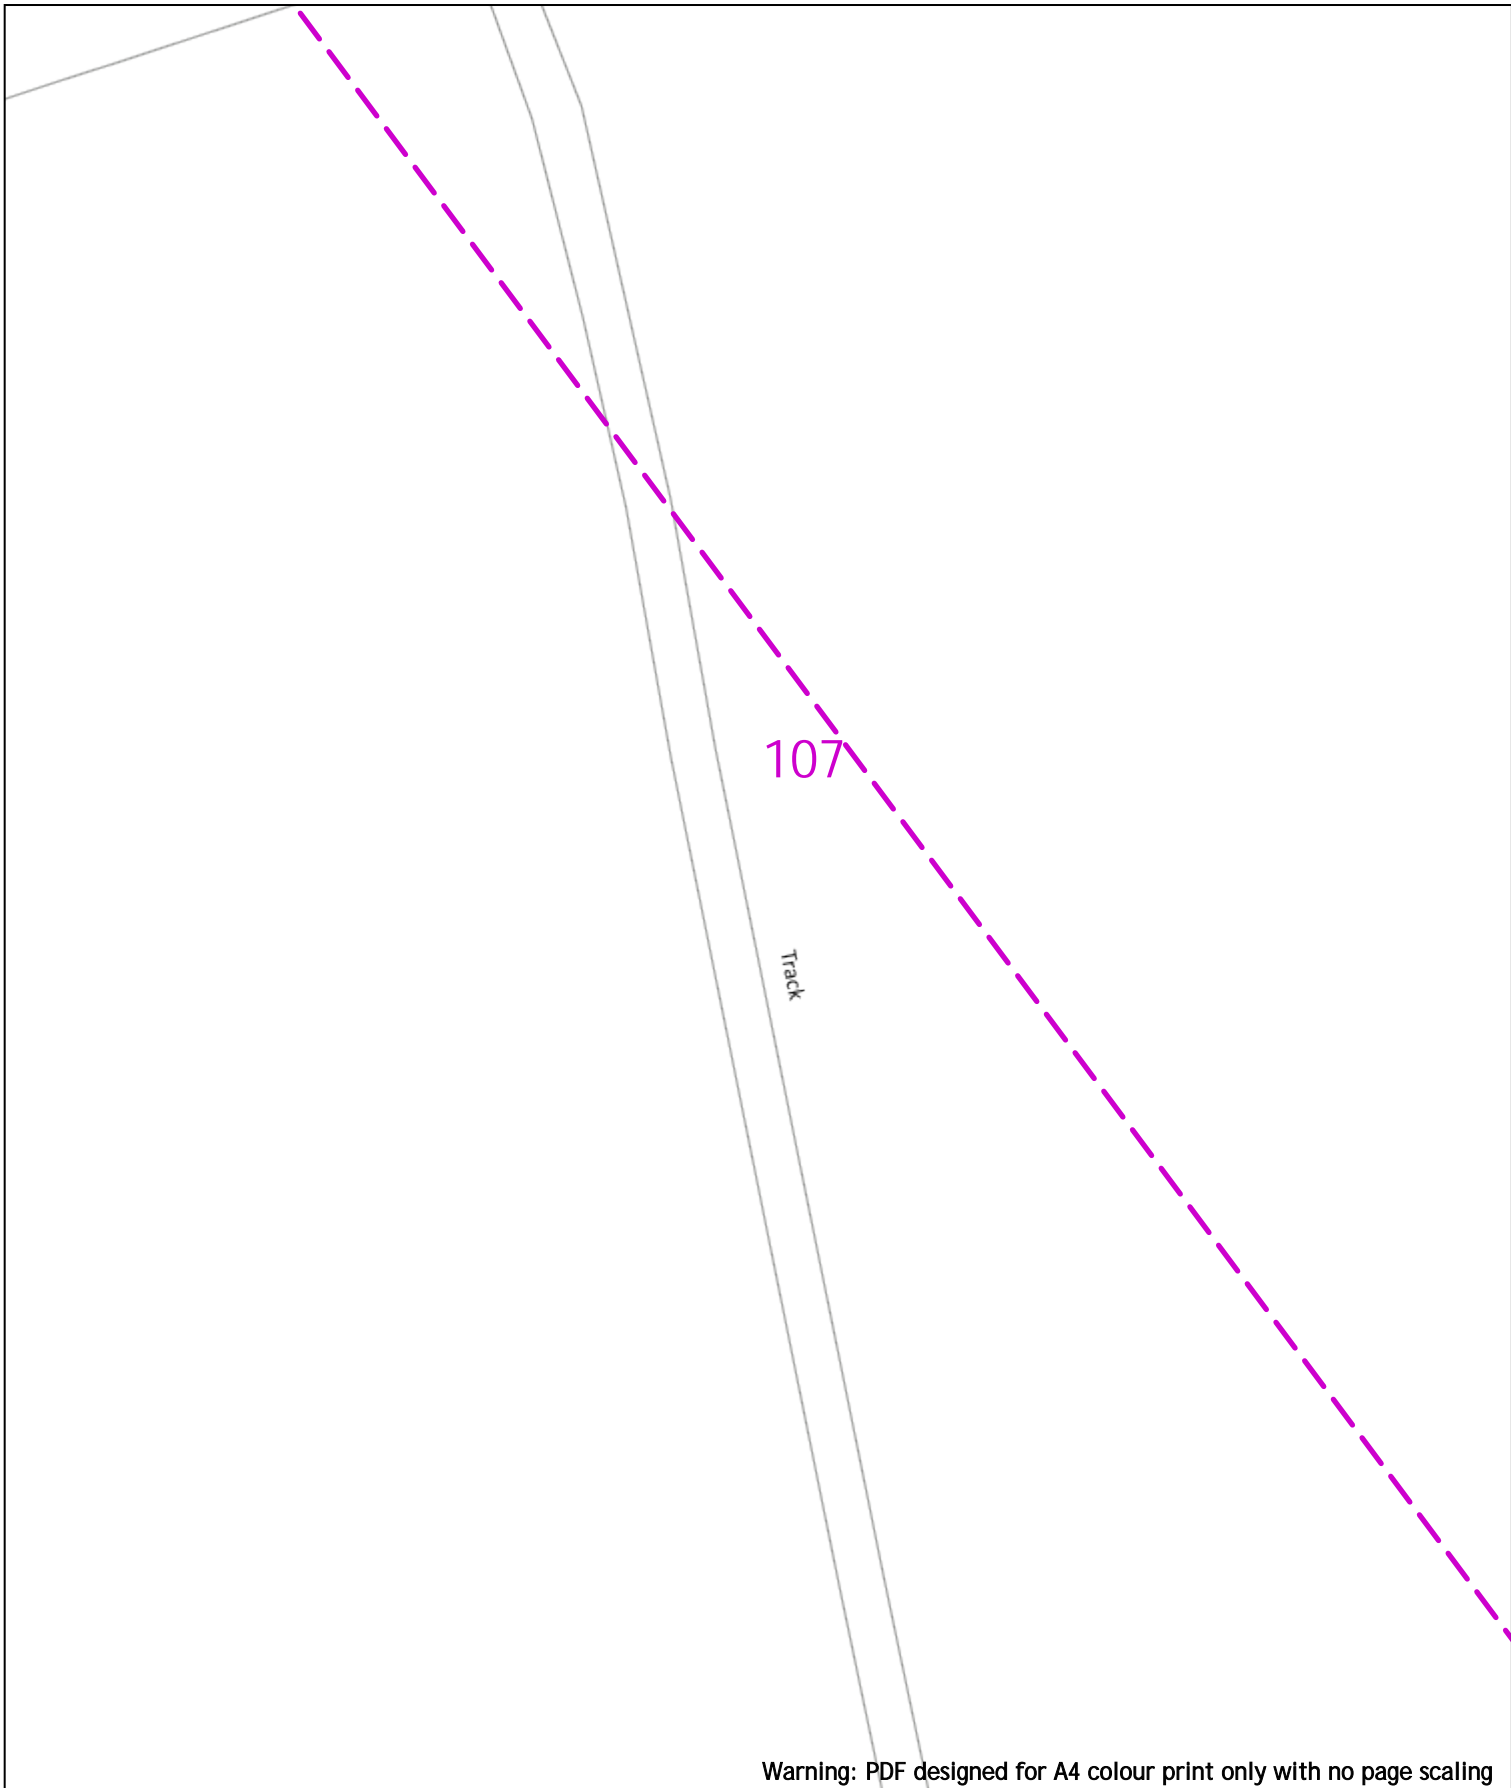

Warning: PDF designed for A4 colour print only with no page scaling

0 20m Dig Sites Area: Line:

Date Requested: 24/06/2022
 Job Reference: 25881010
 Site Location: 448066 213346
 Requested by: Mr Joe Shawyer
 Your Scheme/Reference: 31188_002

Voltages (V)				
LV (Low Voltage) and Services	Up to 1,000V			
HV (High Voltage)	Over 1,000V to 11,000V			
EHV (Extra High Voltage)	22,000V to 132,000V			
Transmission	275,000V and 400,000V			


NORMAL DEPTH TO THE TOP OF THE CABLE WHEN LAID				
Services	LV	HV	EHV	
Footpath/Unmade	0.45m	0.45m	0.6m	0.8m
Road Crossing	0.6m	0.6m	0.75m	0.9m
Agricultural	1m	1m	1m	1.1m

WARNING
 There may have been subsequent alteration to the surface levels. Trial holes must be undertaken to determine position and depths of cables. HS (G) 47 Booklet from the Health and Safety Executive - Avoiding Danger from Buried Cables - should be consulted before commencing excavation work.
WHEN WORKING IN THE VICINITY OF OVERHEAD LINES THE HEALTH AND SAFETY GUIDANCE NOTES G56 SHOULD BE CONSULTED (AVAILABLE FROM THE HSE WEBSITE)

Southern Electric Power Distribution plc
 Registered Office: No.1 Forbury Place
 43 Forbury Road Reading RG1 3JH
 Registered In England & Wales No.04094290

If you're unsure & need to seek advice before commencing excavations, please contact:
 General Enquiries: 0800 048 3516

Subject to revision - Master held by SSEN Asset Data Team:
Asset.Data@sse.com
 01256 337 294

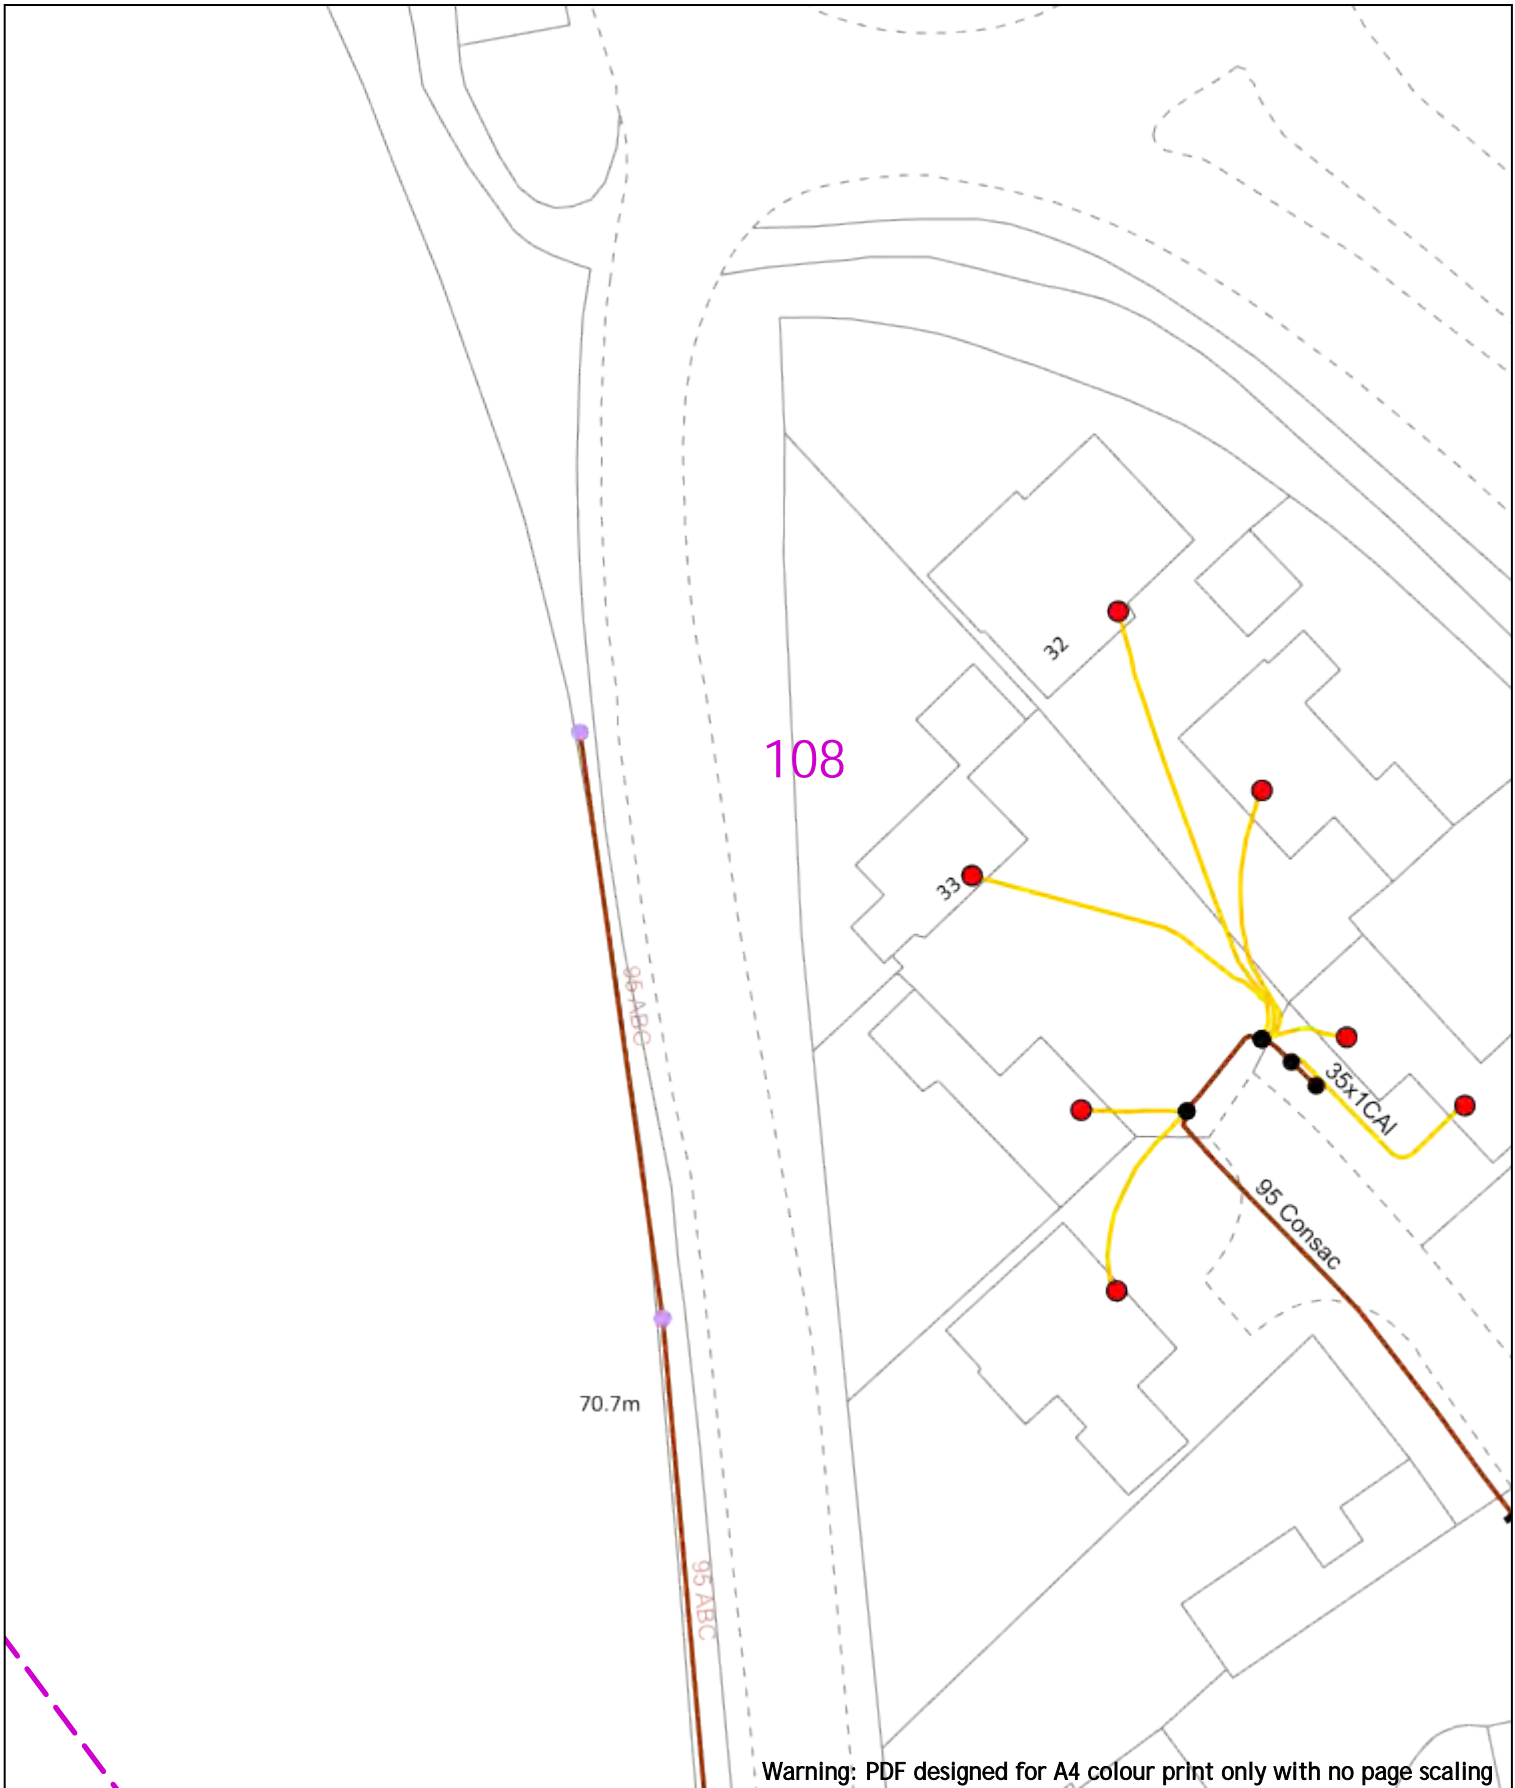

Warning: PDF designed for A4 colour print only with no page scaling

0 20m Dig Sites Area: Line:

Date Requested: 24/06/2022
 Job Reference: 25881010
 Site Location: 448066 213346
 Requested by: Mr Joe Shawyer
 Your Scheme/Reference: 31188_002

Voltages (V)			
LV (Low Voltage) and Services	Up to 1,000V		
HV (High Voltage)	Over 1,000V to 11,000V		
EHV (Extra High Voltage)	22,000V to 132,000V		
Transmission	275,000V and 400,000V		


NORMAL DEPTH TO THE TOP OF THE CABLE WHEN LAID			
Services	LV	HV	EHV
Footpath/Unmade	0.45m	0.45m	0.6m
Road Crossing	0.6m	0.6m	0.75m
Agricultural	1m	1m	1.1m

WARNING
 There may have been subsequent alteration to the surface levels. Trial holes must be undertaken to determine position and depths of cables. HS (G) 47 Booklet from the Health and Safety Executive – Avoiding Danger from Buried Cables – should be consulted before commencing excavation work.
 WHEN WORKING IN THE VICINITY OF OVERHEAD LINES THE HEALTH AND SAFETY GUIDANCE NOTES G56 SHOULD BE CONSULTED (AVAILABLE FROM THE HSE WEBSITE)

Southern Electric Power Distribution plc
 Registered Office: No.1 Forbury Place
 43 Forbury Road Reading RG1 3JH
 Registered In England & Wales No.04094290

If you're unsure & need to seek advice before commencing excavations, please contact:
 General Enquiries: 0800 048 3516

Subject to revision – Master held by SSEN Asset Data Team:
Asset.Data@sse.com
 01256 337 294

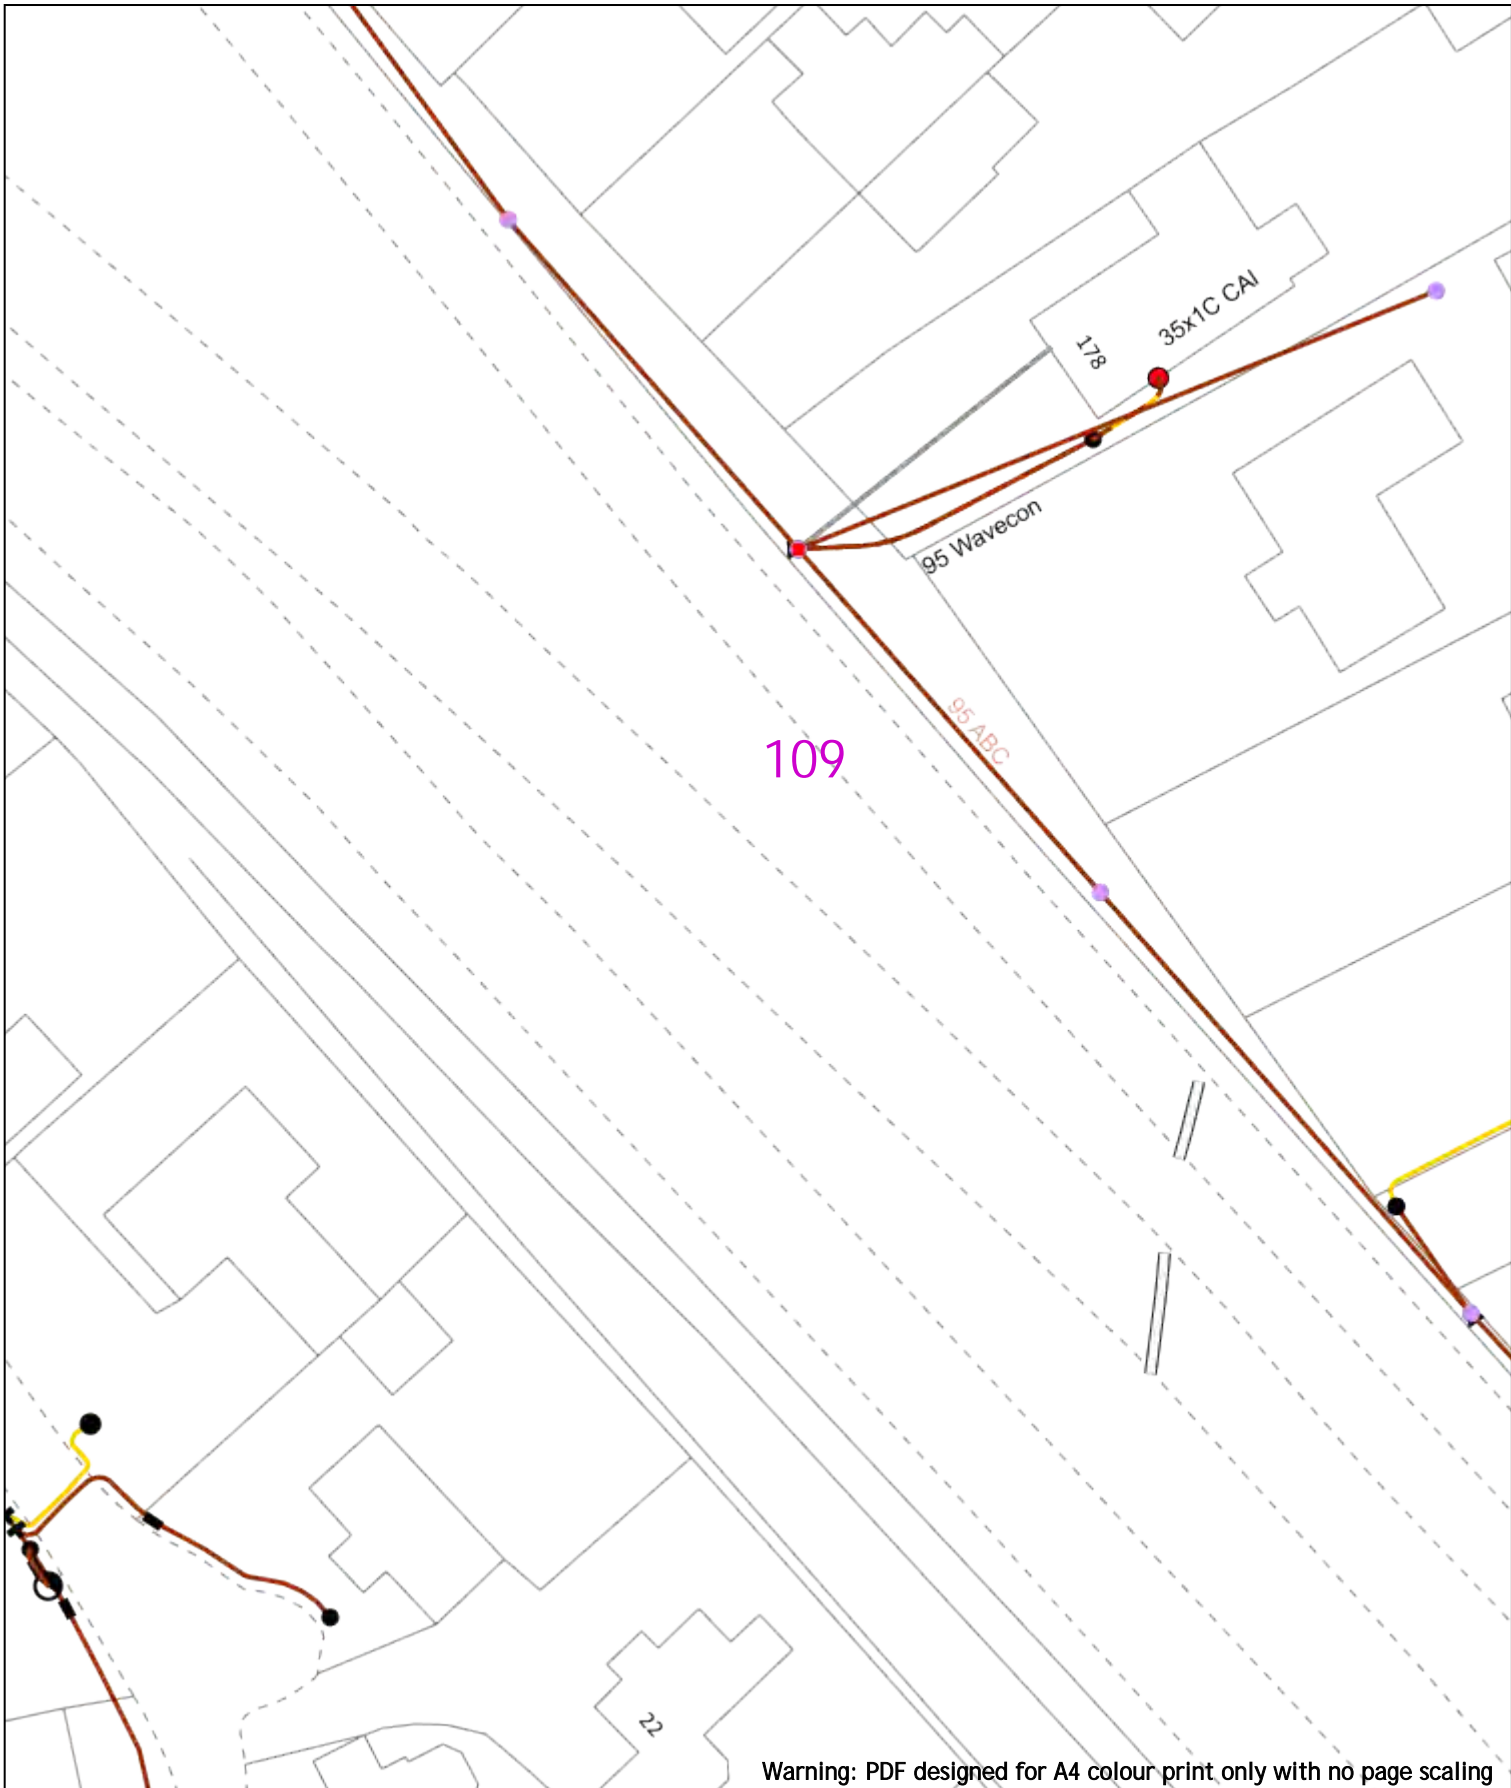

Warning: PDF designed for A4 colour print only with no page scaling

0 20m Dig Sites Area: Line:

Date Requested: 24/06/2022
 Job Reference: 25881010
 Site Location: 448066 213346
 Requested by: Mr Joe Shawyer
 Your Scheme/Reference: 31188_002

Voltages (V)	
LV (Low Voltage) and Services	Up to 1,000V
HV (High Voltage)	Over 1,000V to 11,000V
EHV (Extra High Voltage)	22,000V to 132,000V
Transmission	275,000V and 400,000V

NORMAL DEPTH TO THE TOP OF THE CABLE WHEN LAID			
Services	LV	HV	EHV
Footpath/Unmade	0.45m	0.45m	0.6m
Road Crossing	0.6m	0.6m	0.75m
Agricultural	1m	1m	1.1m

Legend	
	Service Cable
	LV Main
	2-13kV
	6.6kV
	11kV
	22kV
	33kV
	66kV
	132kV
	275kV
	400kV
	Fibre Optic
	Rigid Cable


Distribution Structures (Electric)	
	Pole, Existing Location
	Pole Structure, Existing Location - Single
	Pole Structure, Existing Location - H
	Duct Route
	Cross Section Route

WARNING
 There may have been subsequent alteration to the surface levels. Trial holes must be undertaken to determine position and depths of cables. HS (G) 47 Booklet from the Health and Safety Executive - Avoiding Danger from Buried Cables - should be consulted before commencing excavation work.
 WHEN WORKING IN THE VICINITY OF OVERHEAD LINES THE HEALTH AND SAFETY GUIDANCE NOTES G56 SHOULD BE CONSULTED (AVAILABLE FROM THE HSE WEBSITE)

Southern Electric Power Distribution plc
 Registered Office: No.1 Forbury Place
 43 Forbury Road Reading RG1 3JH
 Registered In England & Wales No.04094290

If you're unsure & need to seek advice before commencing excavations, please contact:
 General Enquiries: 0800 048 3516

Subject to revision - Master held by SSEN Asset Data Team:
Asset.Data@sse.com
 01256 337 294

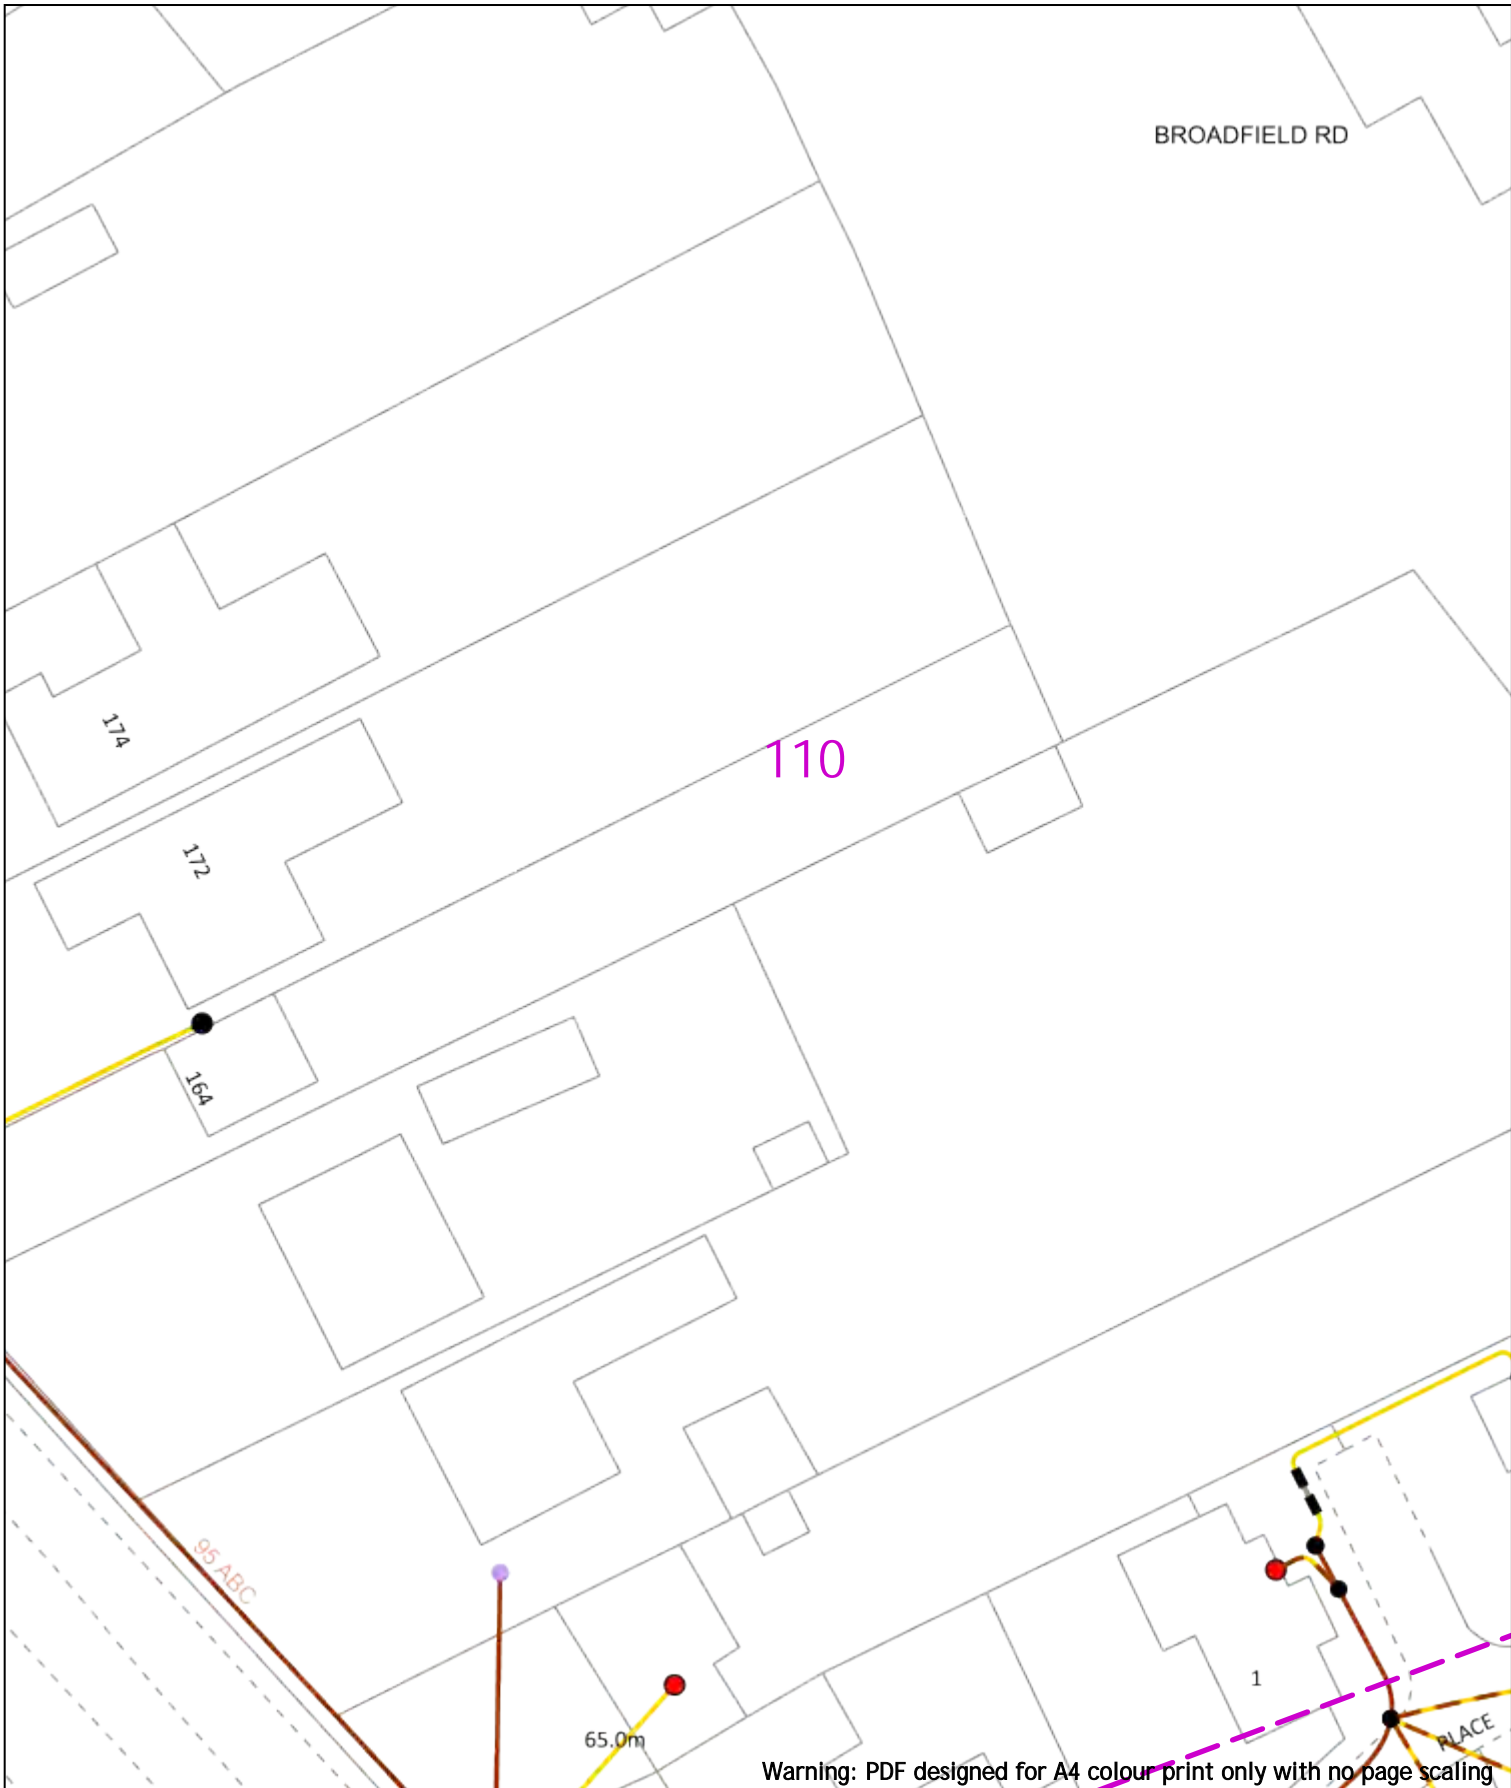

0 20m Dig Sites Area: Line:

Date Requested: 24/06/2022
 Job Reference: 25881010
 Site Location: 448066 213346
 Requested by: Mr Joe Shawyer
 Your Scheme/Reference: 31188_002

Voltages (V)	
LV (Low Voltage) and Services	Up to 1,000V
HV (High Voltage)	Over 1,000V to 11,000V
EHV (Extra High Voltage)	22,000V to 132,000V
Transmission	275,000V and 400,000V

NORMAL DEPTH TO THE TOP OF THE CABLE WHEN LAID	Services			
	LV	HV	EHV	
Footpath/Unmade	0.45m	0.45m	0.6m	0.8m
Road Crossing	0.6m	0.6m	0.75m	0.9m
Agricultural	1m	1m	1m	1.1m

Legend	
	Service Cable
	LV Main
	2-33kV
	6.6kV
	11kV
	22kV
	33kV
	66kV
	132kV
	275kV
	400kV
	Fibre Optic
	Road Cable

Distribution Structures (Electric)	
	Pole, Existing Location
	Pole Structure, Existing Location - Single
	Pole Structure, Existing Location - H
	Duct Route
	Cross Section Route


WARNING
 There may have been subsequent alteration to the surface levels. Trial holes must be undertaken to determine position and depths of cables. HS (G) 47 Booklet from the Health and Safety Executive - Avoiding Danger from Buried Cables - should be consulted before commencing excavation work.
 WHEN WORKING IN THE VICINITY OF OVERHEAD LINES THE HEALTH AND SAFETY GUIDANCE NOTES G56 SHOULD BE CONSULTED (AVAILABLE FROM THE HSE WEBSITE)

Scale: 1:500 (When plotted at A4)

Southern Electric Power Distribution plc
 Registered Office: No.1 Forbury Place
 43 Forbury Road Reading RG1 3JH
 Registered In England & Wales No.04094290


If you're unsure & need to seek advice before commencing excavations, please contact:
 General Enquiries: 0800 048 3516

Subject to revision - Master held by SSEN Asset Data Team:
Asset.Data@sse.com
 01256 337 294

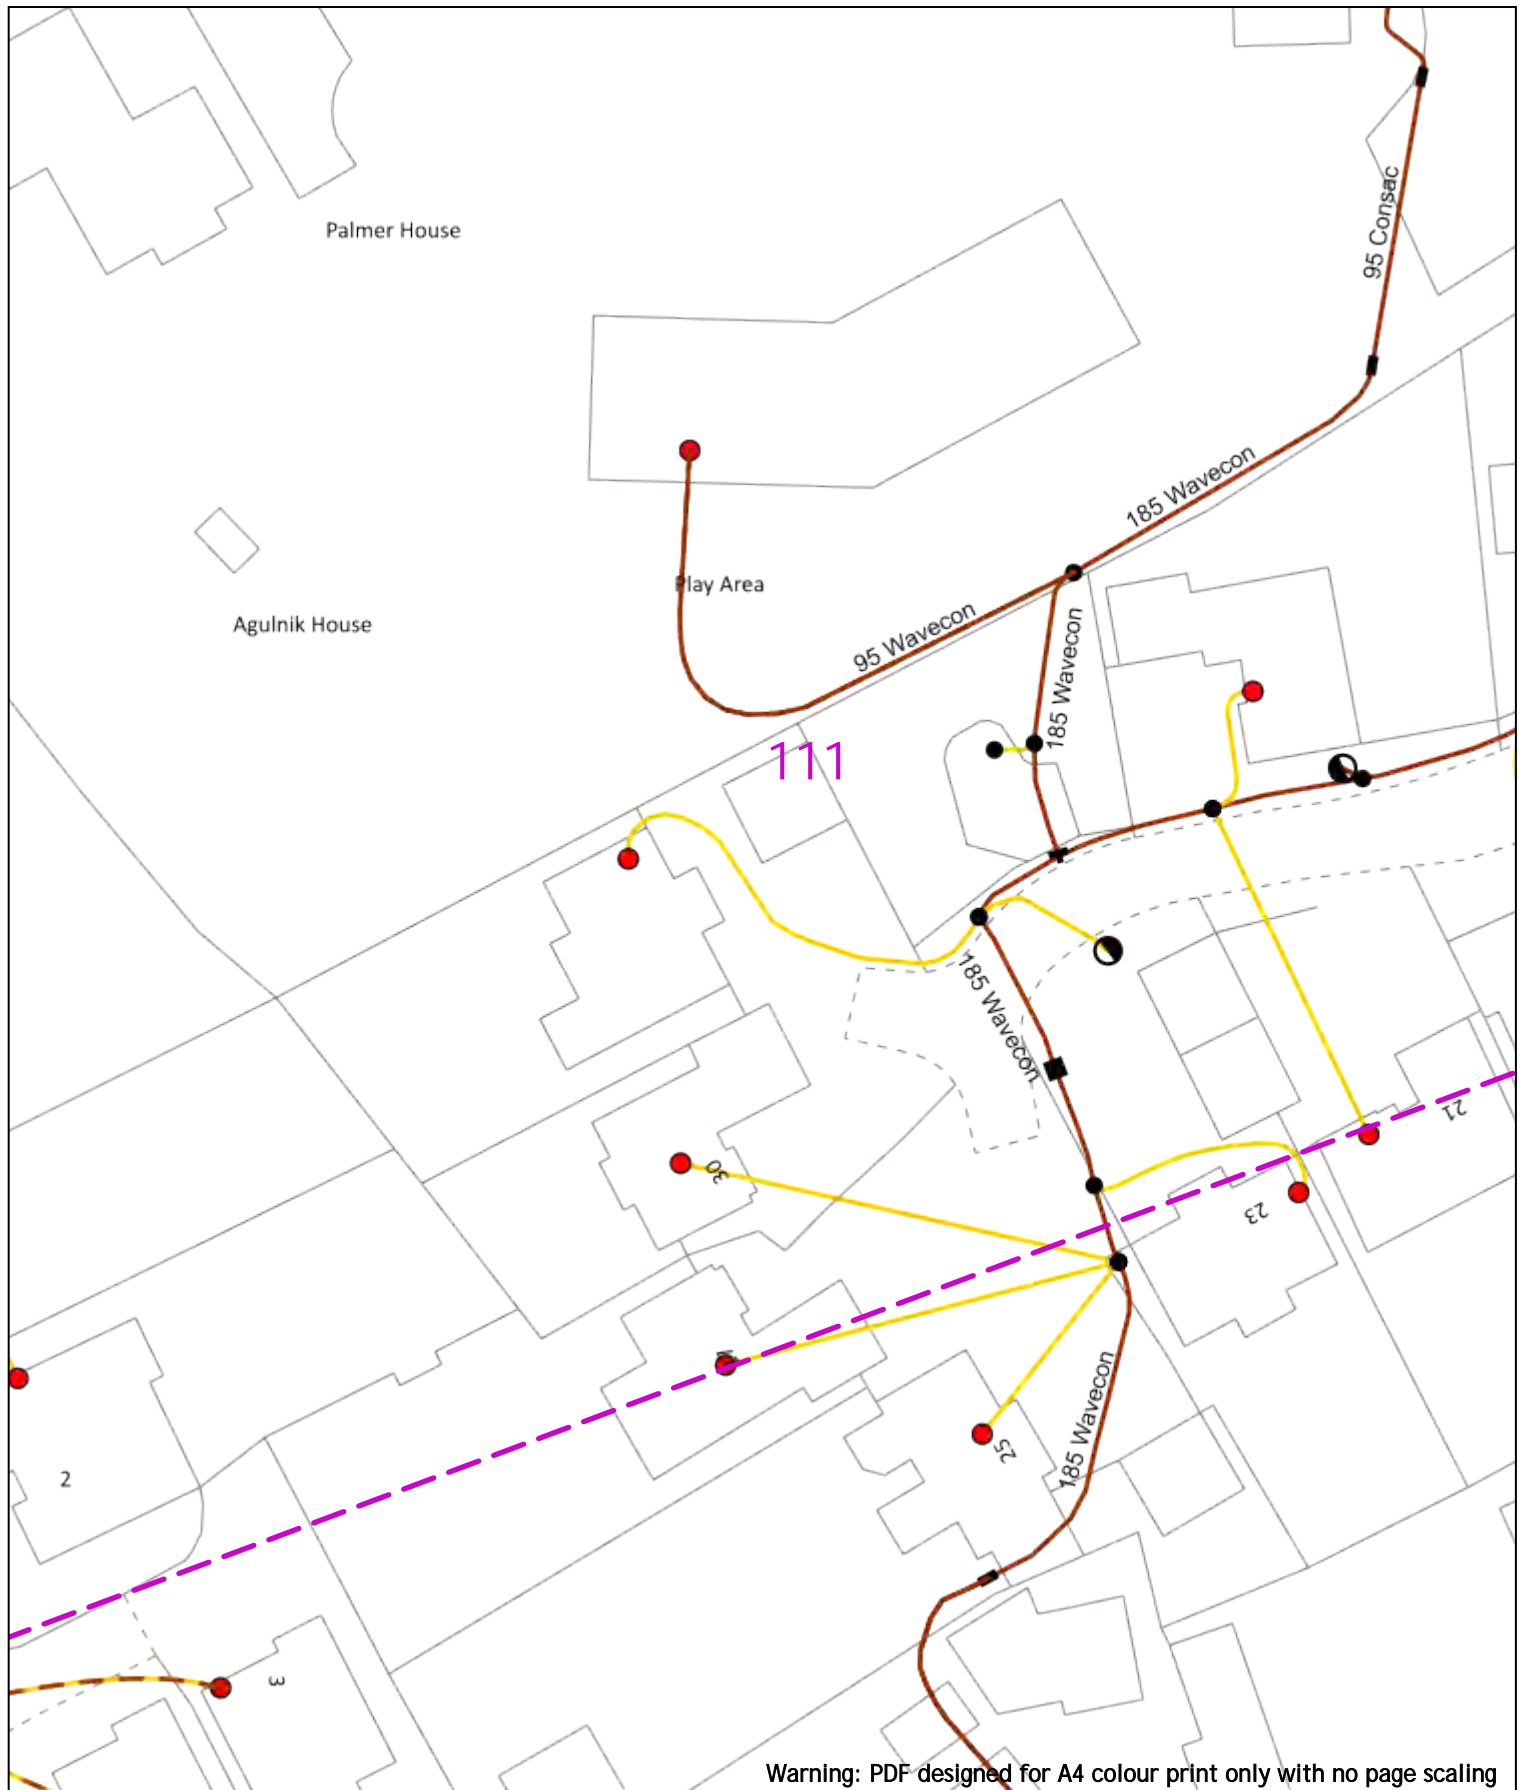

Warning: PDF designed for A4 colour print only with no page scaling

<p>0 20m</p> <p>Date Requested: 24/06/2022 Job Reference: 25881010 Site Location: 448066 213346 Requested by: Mr Joe Shawyer Your Scheme/Reference: 31188_002</p>	<p>Dig Sites: Area: Line: </p>	<table border="1" style="width: 100%; border-collapse: collapse;"> <tr> <th colspan="4">Voltages (V)</th> </tr> <tr> <td>LV (Low Voltage) and Services</td> <td colspan="3">Up to 1,000V</td> </tr> <tr> <td>HV (High Voltage)</td> <td colspan="3">Over 1,000V to 11,000V</td> </tr> <tr> <td>EHV (Extra High Voltage)</td> <td colspan="3">22,000V to 132,000V</td> </tr> <tr> <td>Transmission</td> <td colspan="3">275,000V and 400,000V</td> </tr> <tr> <th colspan="4">NORMAL DEPTH TO THE TOP OF THE CABLE WHEN LAID</th> </tr> <tr> <td>Services</td> <td>LV</td> <td>HV</td> <td>EHV</td> </tr> <tr> <td>Footpath/Unmade</td> <td>0.45m</td> <td>0.45m</td> <td>0.6m</td> </tr> <tr> <td>Road Crossing</td> <td>0.6m</td> <td>0.6m</td> <td>0.75m</td> </tr> <tr> <td>Agricultural</td> <td>1m</td> <td>1m</td> <td>1.1m</td> </tr> </table> <table border="1" style="width: 100%; border-collapse: collapse;"> <tr> <th colspan="2">Legend</th> <th colspan="2">Distribution Structures (Electric)</th> </tr> <tr> <td></td> <td>Service Cable</td> <td></td> <td>Pole, Existing Location</td> </tr> <tr> <td></td> <td>LV Main</td> <td></td> <td>Pole Structure, Existing Location - Single</td> </tr> <tr> <td></td> <td>6.6kV</td> <td></td> <td>Pole Structure, Existing Location - H</td> </tr> <tr> <td></td> <td>11kV</td> <td></td> <td>Davit Route</td> </tr> <tr> <td></td> <td>22kV</td> <td></td> <td>Cross Section Route</td> </tr> <tr> <td></td> <td>33kV</td> <td></td> <td></td> </tr> <tr> <td></td> <td>66kV</td> <td></td> <td></td> </tr> <tr> <td></td> <td>132kV</td> <td></td> <td></td> </tr> <tr> <td></td> <td>275kV</td> <td></td> <td></td> </tr> <tr> <td></td> <td>400kV</td> <td></td> <td></td> </tr> <tr> <td></td> <td>Fibre Optic</td> <td></td> <td></td> </tr> <tr> <td></td> <td>Pilot Cable</td> <td></td> <td></td> </tr> </table>	Voltages (V)				LV (Low Voltage) and Services	Up to 1,000V			HV (High Voltage)	Over 1,000V to 11,000V			EHV (Extra High Voltage)	22,000V to 132,000V			Transmission	275,000V and 400,000V			NORMAL DEPTH TO THE TOP OF THE CABLE WHEN LAID				Services	LV	HV	EHV	Footpath/Unmade	0.45m	0.45m	0.6m	Road Crossing	0.6m	0.6m	0.75m	Agricultural	1m	1m	1.1m	Legend		Distribution Structures (Electric)			Service Cable		Pole, Existing Location		LV Main		Pole Structure, Existing Location - Single		6.6kV		Pole Structure, Existing Location - H		11kV		Davit Route		22kV		Cross Section Route		33kV				66kV				132kV				275kV				400kV				Fibre Optic				Pilot Cable			 <p>Southern Electric Power Distribution plc Registered Office: No.1 Forbury Place 43 Forbury Road Reading RG1 3JH Registered In England & Wales No.04094290</p> <p>If you're unsure & need to seek advice before commencing excavations, please contact: General Enquiries: 0800 048 3516</p> <p>Subject to revision – Master held by SSEN Asset Data Team: Asset.Data@sse.com 01256 337 294</p>
<p>Scale: 1:500 (When plotted at A4)</p>		<p>WARNING There may have been subsequent alteration to the surface levels. Trial holes must be undertaken to determine position and depths of cables. HS (G) 47 Booklet from the Health and Safety Executive – Avoiding Danger from Buried Cables – should be consulted before commencing excavation work. WHEN WORKING IN THE VICINITY OF OVERHEAD LINES THE HEALTH AND SAFETY GUIDANCE NOTES G56 SHOULD BE CONSULTED (AVAILABLE FROM THE HSE WEBSITE)</p>	
<p>BASED UPON THE ORDNANCE SURVEY MAP WITH THE SANCTION OF THE CONTROLLER OF HM STATIONERY OFFICE CROWN COPYRIGHT RESERVED. This copy has been made by or with the authority of Scottish and Southern Energy Power Distribution Ltd. Pursuant to section 47 of the Copyright, Designs and Patents Act 1988 ("The Act"). Unless the Act provides a relevant exception to copyright the copy must not be copied without the permission of the copyright owner. Plans generated by DigSAFE Pro™ software provided by Linearcableforeldg.</p>	

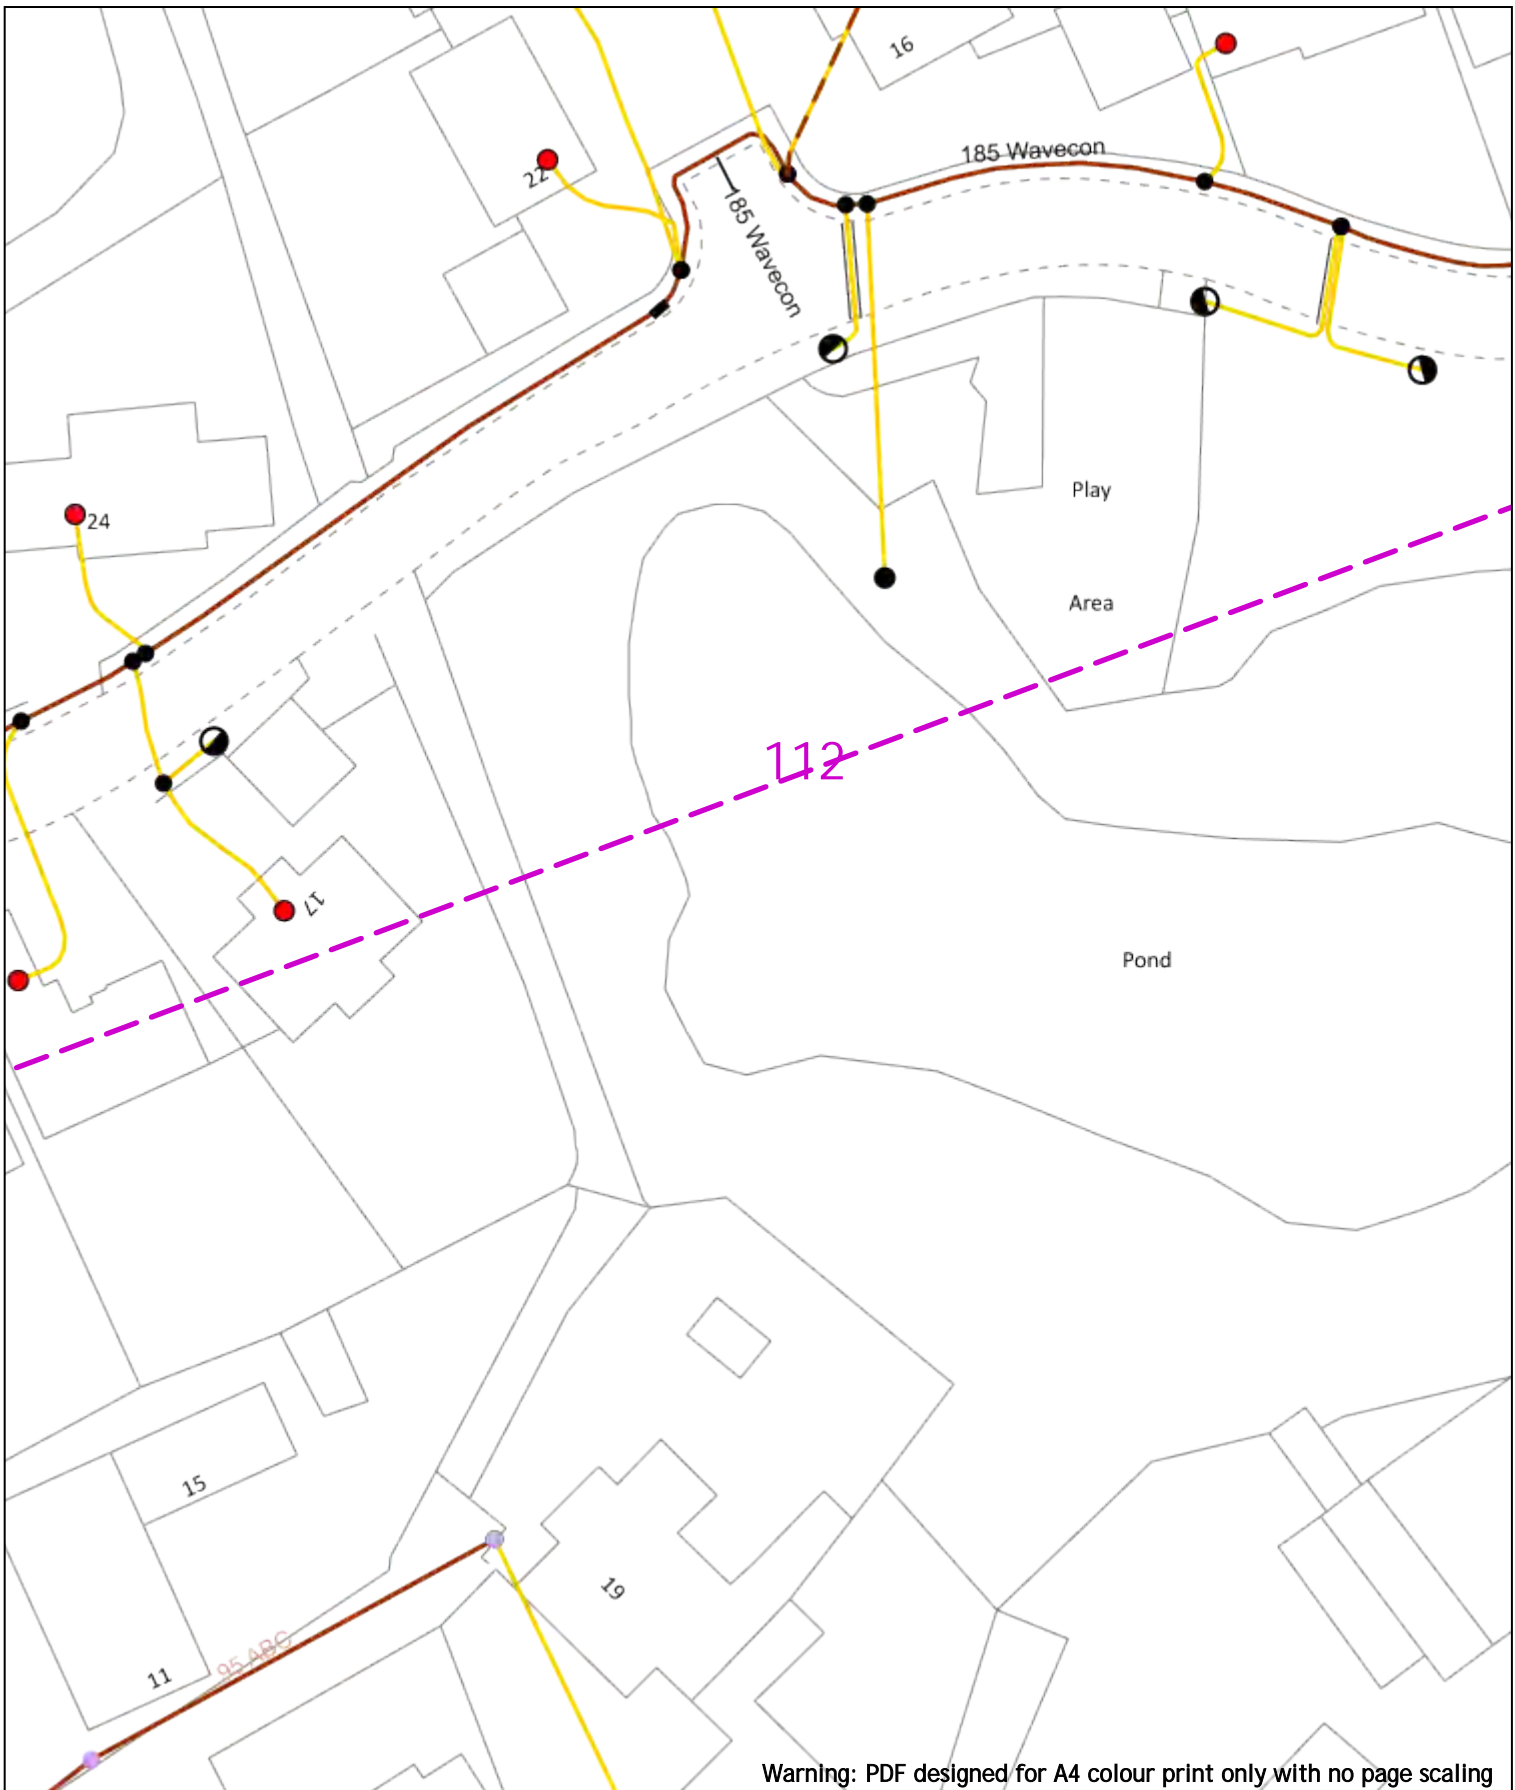

Warning: PDF designed for A4 colour print only with no page scaling



20m Dig Sites Area: Line:

Date Requested: 24/06/2022
 Job Reference: 25881010
 Site Location: 448066 213346
 Requested by: Mr Joe Shawyer
 Your Scheme/Reference: 31188_002

Voltages (V)			
LV (Low Voltage) and Services	Up to 1,000V		
HV (High Voltage)	Over 1,000V to 11,000V		
EHV (Extra High Voltage)	22,000V to 132,000V		
Transmission	275,000V and 400,000V		
NORMAL DEPTH TO THE TOP OF THE CABLE WHEN LAID			
Services	LV	HV	EHV
Footpath/Unmade	0.45m	0.45m	0.6m
Road Crossing	0.6m	0.6m	0.75m
Agricultural	1m	1m	1.1m

<p>Legend</p> <ul style="list-style-type: none"> Service Cable LV Main 6.6kV 11kV 22kV 33kV 66kV 132kV 275kV 400kV Fibre Optic Pilot Cable 	<p>Distribution Structures (Electric)</p> <ul style="list-style-type: none"> Pole, Existing Location Pole Structure, Existing Location - Single Pole Structure, Existing Location - H Duct Route Cross Section Route
---	---


WARNING
 There may have been subsequent alteration to the surface levels. Trial holes must be undertaken to determine position and depths of cables. HS (G) 47 Booklet from the Health and Safety Executive - Avoiding Danger from Buried Cables - should be consulted before commencing excavation work.
 WHEN WORKING IN THE VICINITY OF OVERHEAD LINES THE HEALTH AND SAFETY GUIDANCE NOTES G56 SHOULD BE CONSULTED (AVAILABLE FROM THE HSE WEBSITE)

Scale: 1:500 (When plotted at A4)

Southern Electric Power Distribution plc
 Registered Office: No.1 Forbury Place
 43 Forbury Road Reading RG1 3JH
 Registered In England & Wales No.04094290

If you're unsure & need to seek advice before commencing excavations, please contact:
 General Enquiries: 0800 048 3516

Subject to revision - Master held by SSEN Asset Data Team:
Asset.Data@sse.com
 01256 337 294

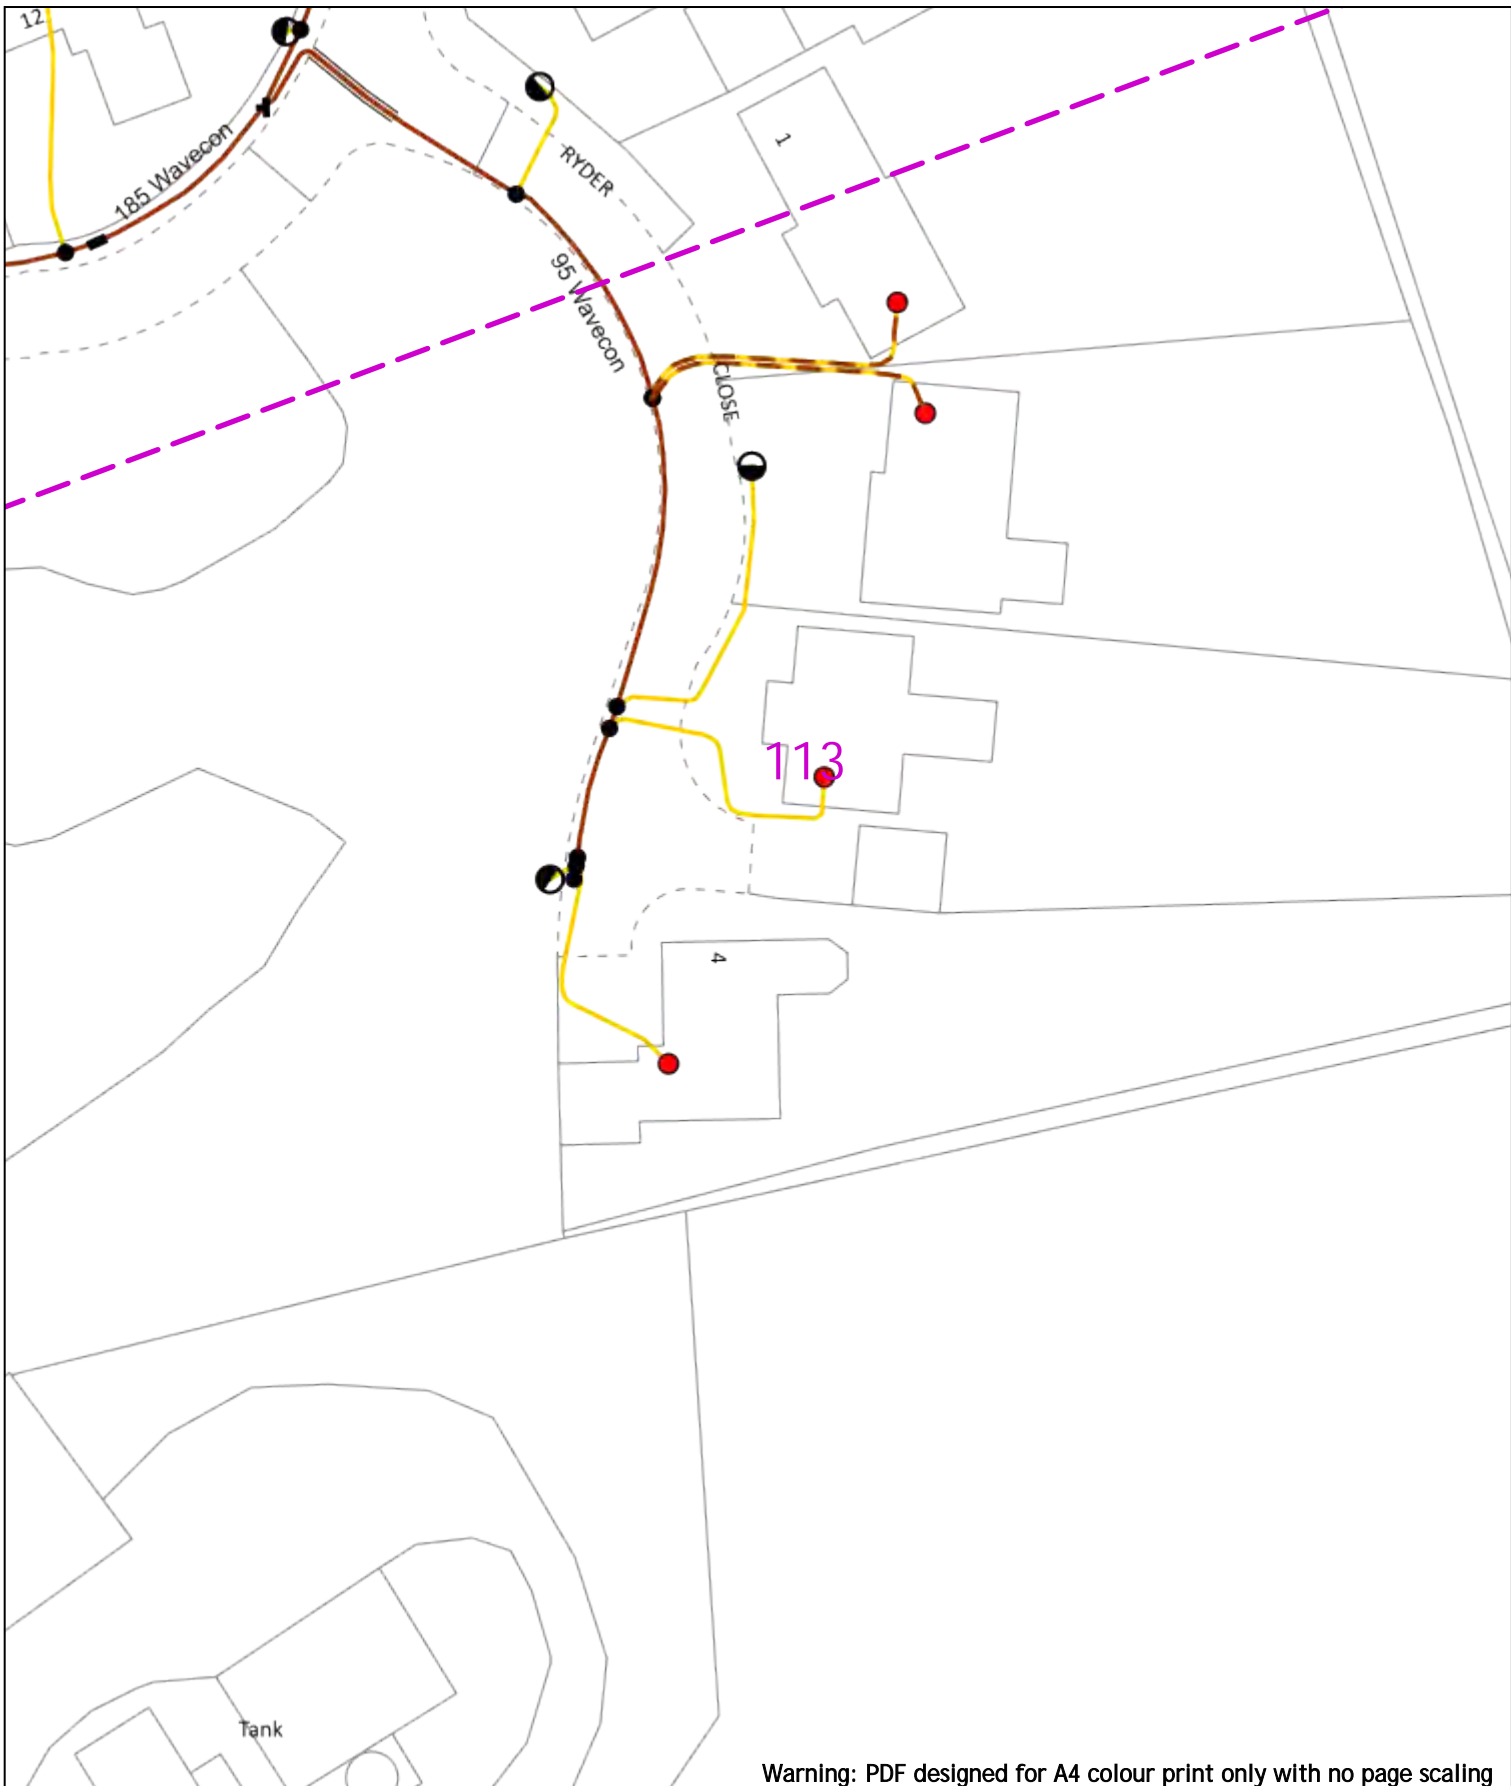

Warning: PDF designed for A4 colour print only with no page scaling



Date Requested: 24/06/2022
 Job Reference: 25881010
 Site Location: 448066 213346
 Requested by: Mr Joe Shawyer
 Your Scheme/Reference: 31188_002

Voltages (V)			
LV (Low Voltage) and Services	Up to 1,000V		
HV (High Voltage)	Over 1,000V to 11,000V		
EHV (Extra High Voltage)	22,000V to 132,000V		
Transmission	275,000V and 400,000V		
NORMAL DEPTH TO THE TOP OF THE CABLE WHEN LAID			
Services	LV	HV	EHV
Footpath/Unmade	0.45m	0.45m	0.6m
Road Crossing	0.6m	0.6m	0.75m
Agricultural	1m	1m	1.1m

Legend		Distribution Structures (Electric)	
	Service Cable		Pole, Existing Location
	LV Main		Pole Structure, Existing Location - Single
	6.6kV		Pole Structure, Existing Location - H
	11kV		Dig Site
	22kV		Crack Section Route
	33kV		
	66kV		
	132kV		
	275kV		
	400kV		
	Fibre Optic		
	Rigid Cable		

Scale: 1:500 (When plotted at A4)

WARNING
 There may have been subsequent alteration to the surface levels. Trial holes must be undertaken to determine position and depths of cables. HS (G) 47 Booklet from the Health and Safety Executive - Avoiding Danger from Buried Cables - should be consulted before commencing excavation work.
 WHEN WORKING IN THE VICINITY OF OVERHEAD LINES THE HEALTH AND SAFETY GUIDANCE NOTES G56 SHOULD BE CONSULTED (AVAILABLE FROM THE HSE WEBSITE)

Southern Electric Power Distribution plc
 Registered Office: No.1 Forbury Place
 43 Forbury Road Reading RG1 3JH
 Registered In England & Wales No.04094290

If you're unsure & need to seek advice before commencing excavations, please contact:
 General Enquiries: 0800 048 3516

Subject to revision – Master held by SSEN Asset Data Team:
Asset.Data@sse.com
 01256 337 294

114

Warning: PDF designed for A4 colour print only with no page scaling

0  20m Dig Sites Area:  Line: 

Date Requested: 24/06/2022
 Job Reference: 25881010
 Site Location: 448066 213346
 Requested by: Mr Joe Shawyer
 Your Scheme/Reference: 31188_002

Voltages (V)			
LV (Low Voltage) and Services	Up to 1,000V		
HV (High Voltage)	Over 1,000V to 11,000V		
EHV (Extra High Voltage)	22,000V to 132,000V		
Transmission	275,000V and 400,000V		
NORMAL DEPTH TO THE TOP OF THE CABLE WHEN LAID			
Services	LV	HV	EHV

Legend

- Service Cable
- LV Mains
- 2-33kV
- 66kV
- 132kV
- 275kV
- 400kV
- Fibre Optic
- Pilot Cable

Distribution Structures (Electric)

- Pole, Existing Location
- Pole Structure, Existing Location - Single
- Pole Structure, Existing Location - H
- Duct Route
- Cross Section Route

WARNING


There may have been subsequent alteration to the surface levels. Trial holes must be undertaken to determine position and depths of cables. HS (G) 47 Booklet from the Health and Safety Executive - Avoiding Danger from Buried Cables - should be consulted before commencing excavation work.

WHEN WORKING IN THE VICINITY OF OVERHEAD LINES THE HEALTH AND SAFETY GUIDANCE NOTES G56 SHOULD BE CONSULTED (AVAILABLE FROM THE HSE WEBSITE)

Southern Electric Power Distribution plc
 Registered Office: No.1 Forbury Place
 43 Forbury Road Reading RG1 3JH
 Registered In England & Wales No.04094290


If you're unsure & need to seek advice before commencing excavations, please contact:
 General Enquiries: 0800 048 3516

Subject to revision – Master held by SSEN Asset Data Team:
Asset.Data@sse.com
 01256 337 294

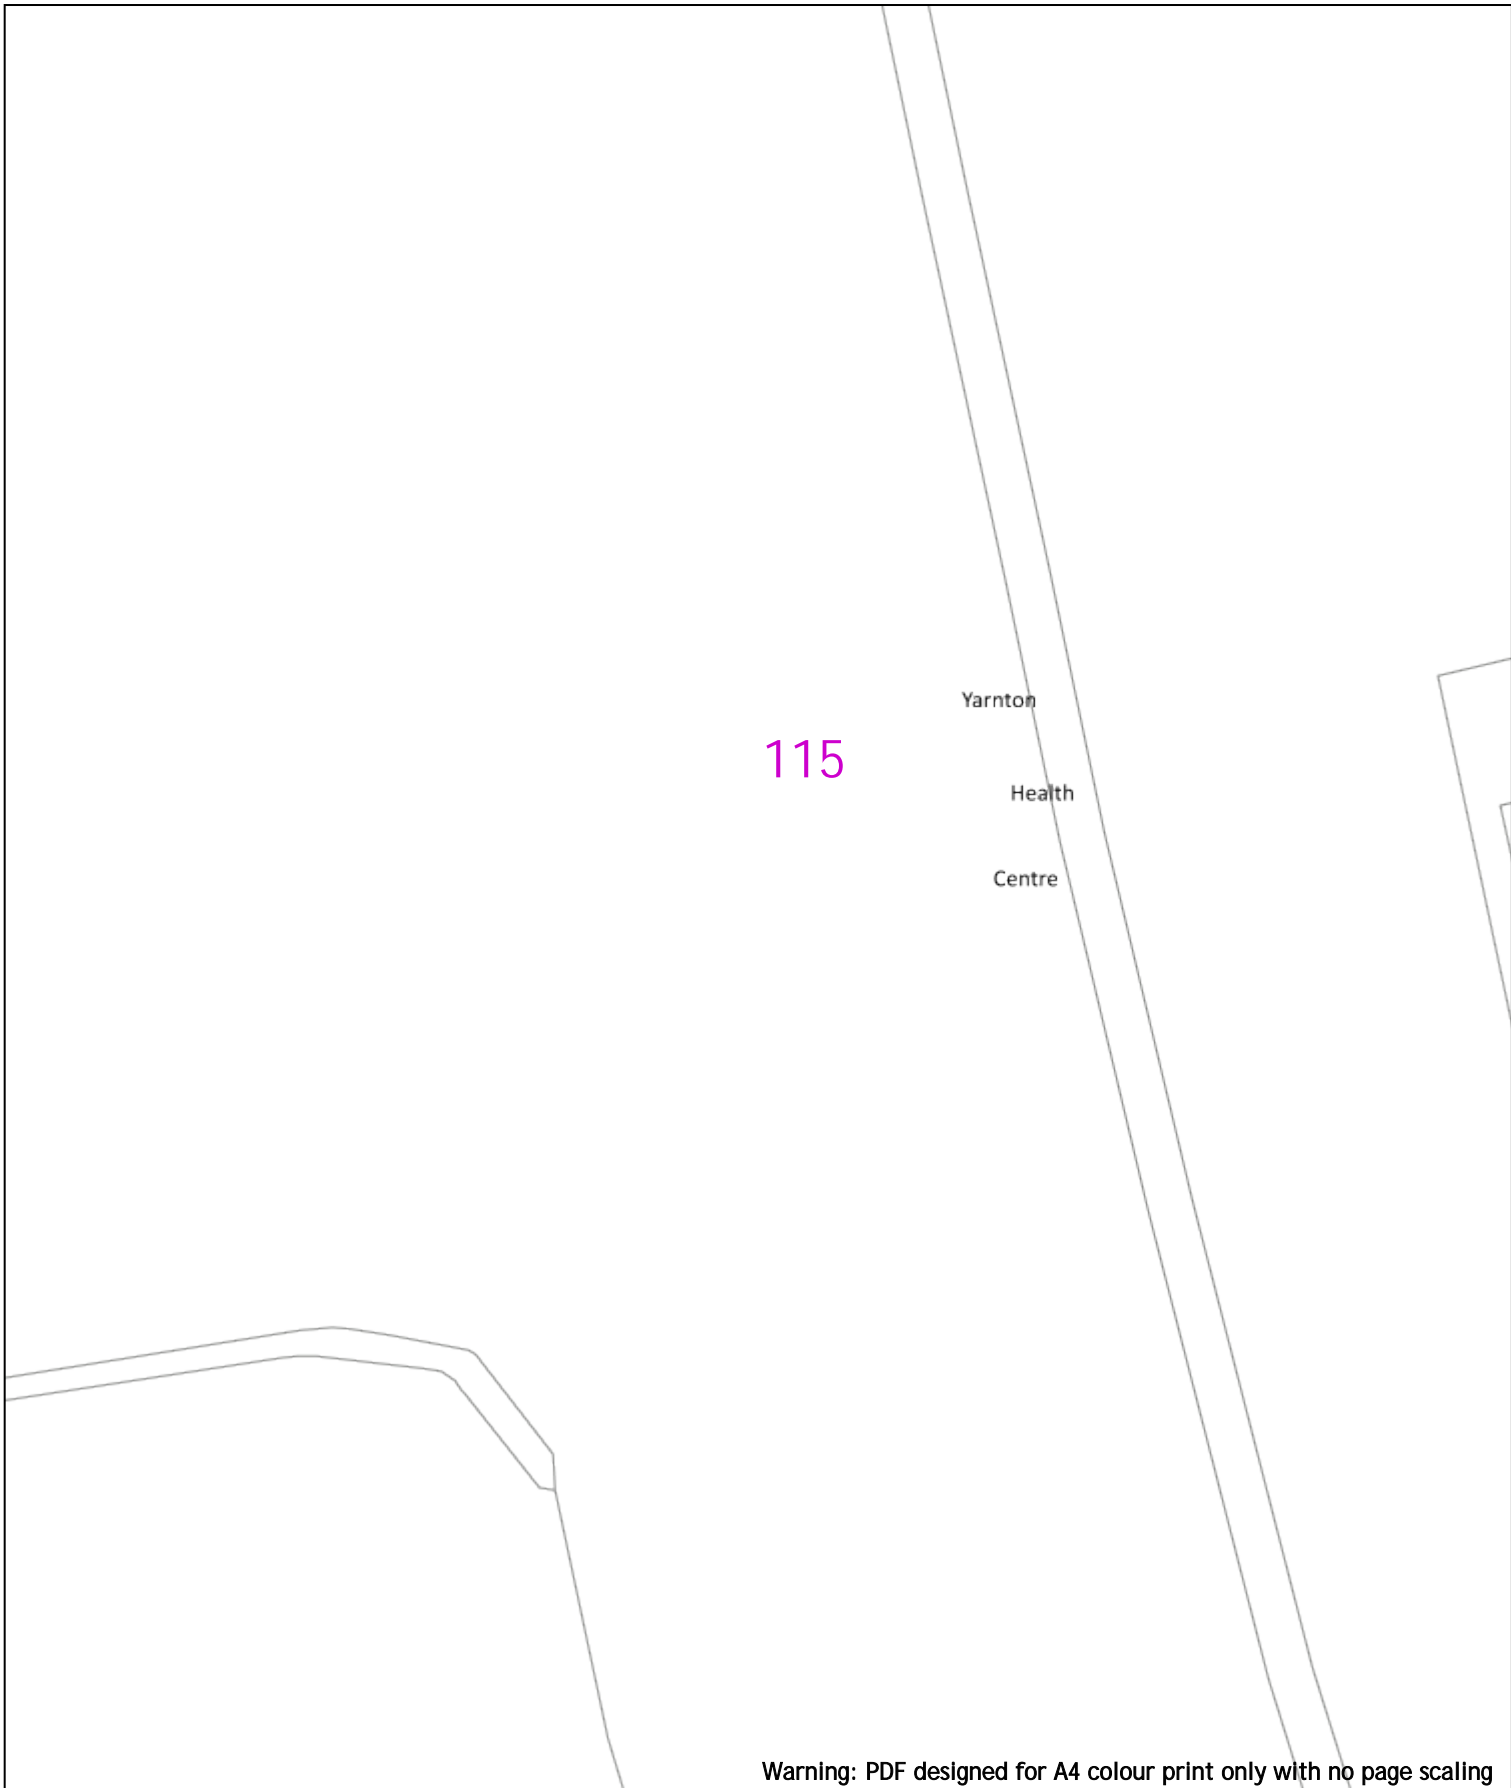

Warning: PDF designed for A4 colour print only with no page scaling

<p>0 20m Dig Sites Area: Line: </p>	<p>Date Requested: 24/06/2022 Job Reference: 25881010 Site Location: 448066 213346 Requested by: Mr Joe Shawyer Your Scheme/Reference: 31188_002</p>	<table border="1" style="width: 100%; border-collapse: collapse;"> <tr> <th colspan="4">Voltages (V)</th> </tr> <tr> <td>LV (Low Voltage) and Services</td> <td colspan="3">Up to 1,000V</td> </tr> <tr> <td>HV (High Voltage)</td> <td colspan="3">Over 1,000V to 11,000V</td> </tr> <tr> <td>EHV (Extra High Voltage)</td> <td colspan="3">22,000V to 132,000V</td> </tr> <tr> <td>Transmission</td> <td colspan="3">275,000V and 400,000V</td> </tr> <tr> <th colspan="4">NORMAL DEPTH TO THE TOP OF THE CABLE WHEN LAID</th> </tr> <tr> <td>Services</td> <td>LV</td> <td>HV</td> <td>EHV</td> </tr> <tr> <td>Footpath/Unmade</td> <td>0.45m</td> <td>0.45m</td> <td>0.6m</td> </tr> <tr> <td>Road Crossing</td> <td>0.6m</td> <td>0.6m</td> <td>0.75m</td> </tr> <tr> <td>Agricultural</td> <td>1m</td> <td>1m</td> <td>1.1m</td> </tr> </table>	Voltages (V)				LV (Low Voltage) and Services	Up to 1,000V			HV (High Voltage)	Over 1,000V to 11,000V			EHV (Extra High Voltage)	22,000V to 132,000V			Transmission	275,000V and 400,000V			NORMAL DEPTH TO THE TOP OF THE CABLE WHEN LAID				Services	LV	HV	EHV	Footpath/Unmade	0.45m	0.45m	0.6m	Road Crossing	0.6m	0.6m	0.75m	Agricultural	1m	1m	1.1m	<div style="display: flex; justify-content: space-between;"> <div style="width: 45%;"> <p>Legend</p> <ul style="list-style-type: none"> Service Cable LV Main 2-33kV 6.6kV 11kV 22kV 33kV 66kV 132kV 275kV 400kV Fibre Optic Pilot Cable </div> <div style="width: 45%;"> <p>Distribution Structures (Electric)</p> <ul style="list-style-type: none"> Pole, Existing Location Pole Structure, Existing Location - Single Pole Structure, Existing Location - H Duct Route Cross Section Route </div> </div>	<div style="display: flex; justify-content: space-around;"> </div> <p style="text-align: center;">Southern Electric Power Distribution plc Registered Office: No.1 Forbury Place 43 Forbury Road Reading RG1 3JH Registered In England & Wales No.04094290</p> <p style="text-align: center;">If you're unsure & need to seek advice before commencing excavations, please contact: General Enquiries: 0800 048 3516</p> <p style="text-align: center;">Subject to revision – Master held by SSEN Asset Data Team: Asset.Data@sse.com 01256 337 294</p>
<p>Scale: 1:500 (When plotted at A4)</p>		<p>WARNING</p> <p>There may have been subsequent alteration to the surface levels. Trial holes must be undertaken to determine position and depths of cables. HS (G) 47 Booklet from the Health and Safety Executive – Avoiding Danger from Buried Cables – should be consulted before commencing excavation work.</p> <p>WHEN WORKING IN THE VICINITY OF OVERHEAD LINES THE HEALTH AND SAFETY GUIDANCE NOTES G56 SHOULD BE CONSULTED (AVAILABLE FROM THE HSE WEBSITE)</p>	
<p>BASED UPON THE ORDNANCE SURVEY MAP WITH THE SANCTION OF THE CONTROLLER OF H.M. STATIONERY OFFICE CROWN COPYRIGHT RESERVED. This copy has been made by or with the authority of Scottish and Southern Energy Power Distribution Ltd. Pursuant to section 47 of the Copyright, Designs and Patents Act 1988 ("The Act"). Unless the Act provides a relevant exception to copyright the copy must not be copied without prior permission of the copyright owner. Plans generated by DigSAFE Pro™ software provided by Lineasearchbeforeldg.</p>	

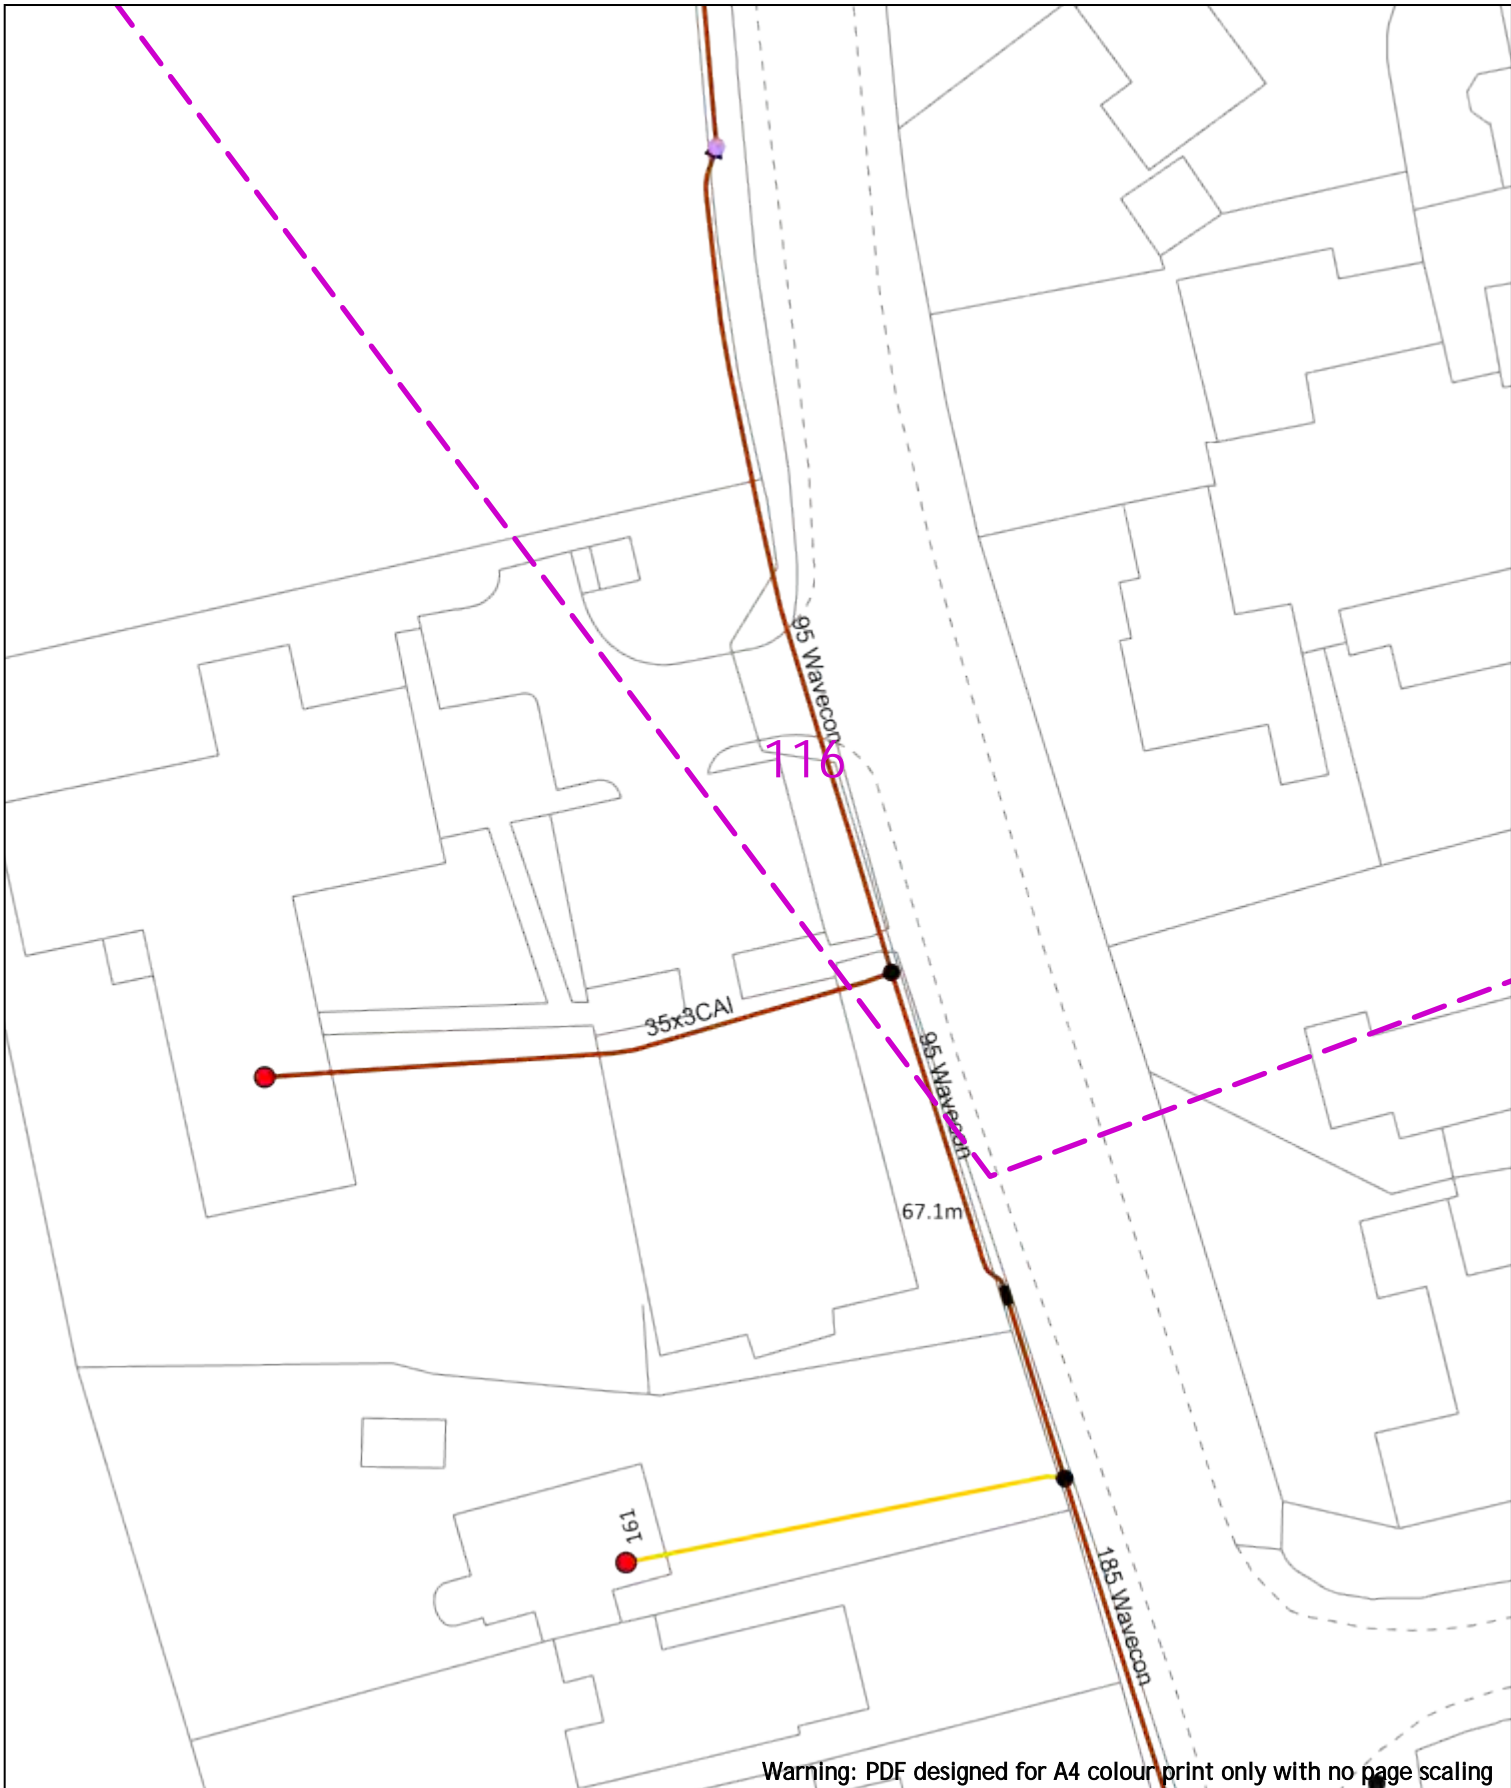

Warning: PDF designed for A4 colour print only with no page scaling

0 20m Dig Sites Area: Line:

Date Requested: 24/06/2022
 Job Reference: 25881010
 Site Location: 448066 213346
 Requested by: Mr Joe Shawyer
 Your Scheme/Reference: 31188_002

Voltages (V)	
LV (Low Voltage) and Services	Up to 1,000V
HV (High Voltage)	Over 1,000V to 11,000V
EHV (Extra High Voltage)	22,000V to 132,000V
Transmission	275,000V and 400,000V

NORMAL DEPTH TO THE TOP OF THE CABLE WHEN LAID			
Services	LV	HV	EHV
Footpath/Unmade	0.45m	0.45m	0.6m
Road Crossing	0.6m	0.6m	0.75m
Agricultural	1m	1m	1.1m

Legend	
	Service Cable
	LV Main
	6.6kV
	11kV
	22kV
	33kV
	66kV
	132kV
	275kV
	400kV
	Fibre Optic
	Road Cable

Distribution Structures (Electric)	
	Pole, Existing Location
	Pole Structure, Existing Location - Single
	Pole Structure, Existing Location - H
	Duct Route
	Cross Section Route

WARNING
 There may have been subsequent alteration to the surface levels. Trial holes must be undertaken to determine position and depths of cables. HS (G) 47 Booklet from the Health and Safety Executive - Avoiding Danger from Buried Cables - should be consulted before commencing excavation work.
 WHEN WORKING IN THE VICINITY OF OVERHEAD LINES THE HEALTH AND SAFETY GUIDANCE NOTES G56 SHOULD BE CONSULTED (AVAILABLE FROM THE HSE WEBSITE)


Scale: 1:500 (When plotted at A4)

Southern Electric Power Distribution plc
 Registered Office: No.1 Forbury Place
 43 Forbury Road Reading RG1 3JH
 Registered In England & Wales No.04094290

If you're unsure & need to seek advice before commencing excavations, please contact:
 General Enquiries: 0800 048 3516

Subject to revision - Master held by SSEN Asset Data Team:
Asset.Data@sse.com
 01256 337 294

BASED UPON THE ORDNANCE SURVEY MAP WITH THE SANCTION OF THE CONTROLLER OF H.M. STATIONERY OFFICE CROWN COPYRIGHT RESERVED.
 This copy has been made by or with the authority of Scottish and Southern Energy Power Distribution Ltd. Pursuant to section 47 of the Copyright, Designs and Patents Act 1988 ("The Act"). Unless the Act provides a relevant exception to copyright the copy must not be copied without prior permission of the copyright owner.
 Plans generated by DigSAFE Pro™ software provided by Linesearchbeforedig.

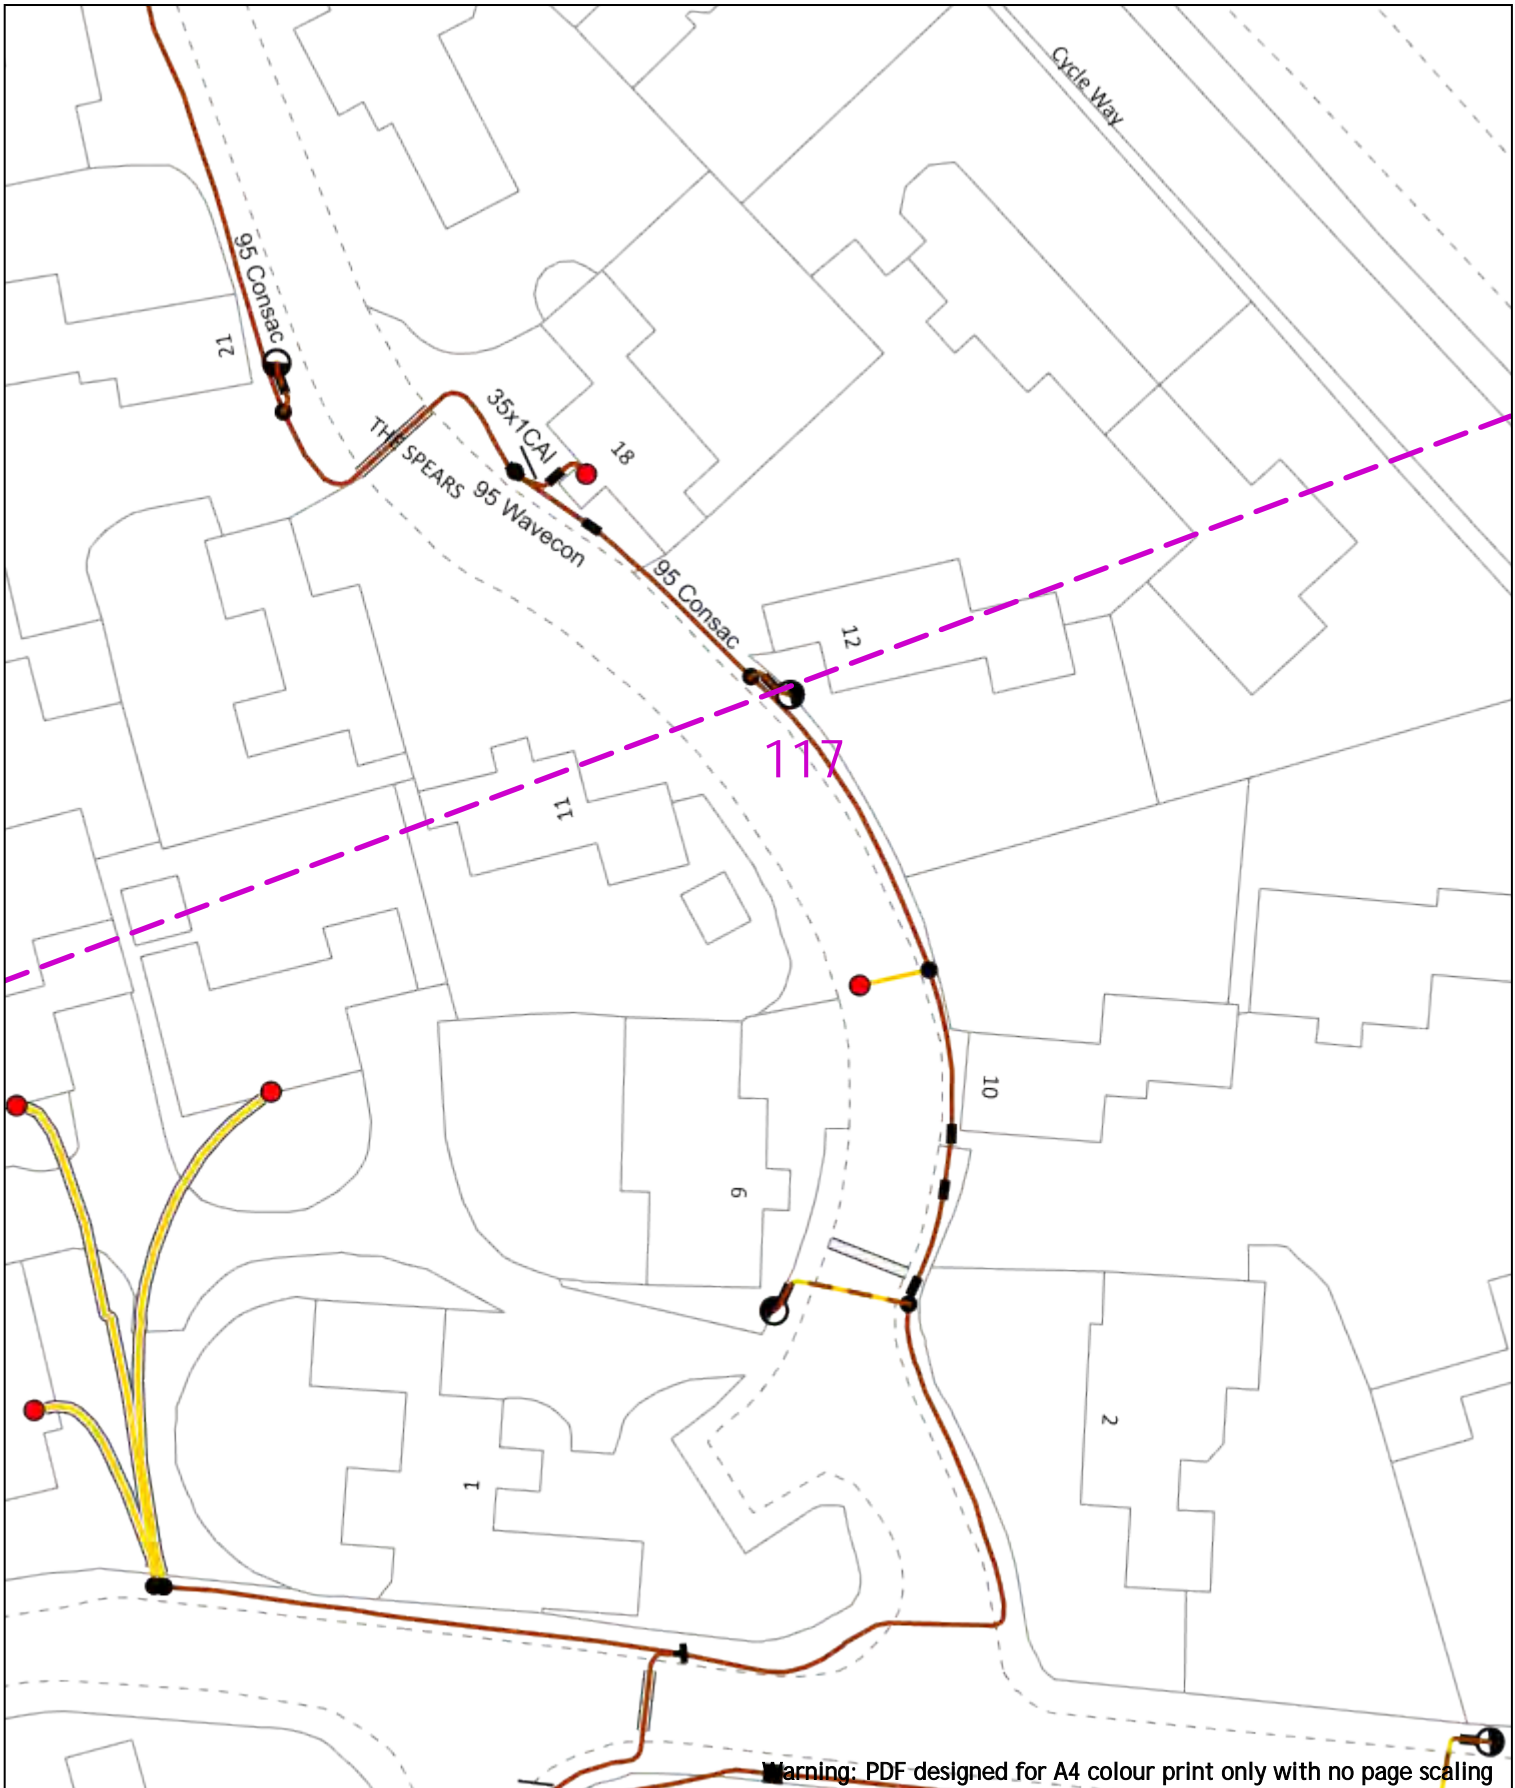

Warning: PDF designed for A4 colour print only with no page scaling



20m Dig Sites Area: [Dashed Pink Box] Line: [Dashed Pink Line]

Date Requested: 24/06/2022
 Job Reference: 25881010
 Site Location: 448066 213346
 Requested by: Mr Joe Shawyer
 Your Scheme/Reference: 31188_002

Voltages (V)			
LV (Low Voltage) and Services	Up to 1,000V		
HV (High Voltage)	Over 1,000V to 11,000V		
EHV (Extra High Voltage)	22,000V to 132,000V		
Transmission	275,000V and 400,000V		
NORMAL DEPTH TO THE TOP OF THE CABLE WHEN LAID			
Services	LV	HV	EHV
Footpath/Unmade	0.45m	0.45m	0.6m
Road Crossing	0.6m	0.6m	0.75m
Agricultural	1m	1m	1.1m

Legend

- Service Cable
- LV Mains
- 6.6kV
- 11kV
- 22kV
- 33kV
- 66kV
- 132kV
- 275kV
- 400kV
- Fibre Optic
- Road Cable

Distribution Structures (Electric)

- Pole, Existing Location
- Pole Structure, Existing Location - Single
- Pole Structure, Existing Location - H
- Duct Route
- Cross Section Route




Southern Electric Power Distribution plc
 Registered Office: No.1 Forbury Place
 43 Forbury Road Reading RG1 3JH
 Registered In England & Wales No.04094290

If you're unsure & need to seek advice before commencing excavations, please contact:
 General Enquiries: 0800 048 3516

Subject to revision – Master held by SSEN Asset Data Team:
Asset.Data@sse.com
 01256 337 294


Scale: 1:500 (When plotted at A4)

WARNING
 There may have been subsequent alteration to the surface levels. Trial holes must be undertaken to determine position and depths of cables. HS (G) 47 Booklet from the Health and Safety Executive – Avoiding Danger from Buried Cables – should be consulted before commencing excavation work.
 WHEN WORKING IN THE VICINITY OF OVERHEAD LINES THE HEALTH AND SAFETY GUIDANCE NOTES G56 SHOULD BE CONSULTED (AVAILABLE FROM THE HSE WEBSITE)

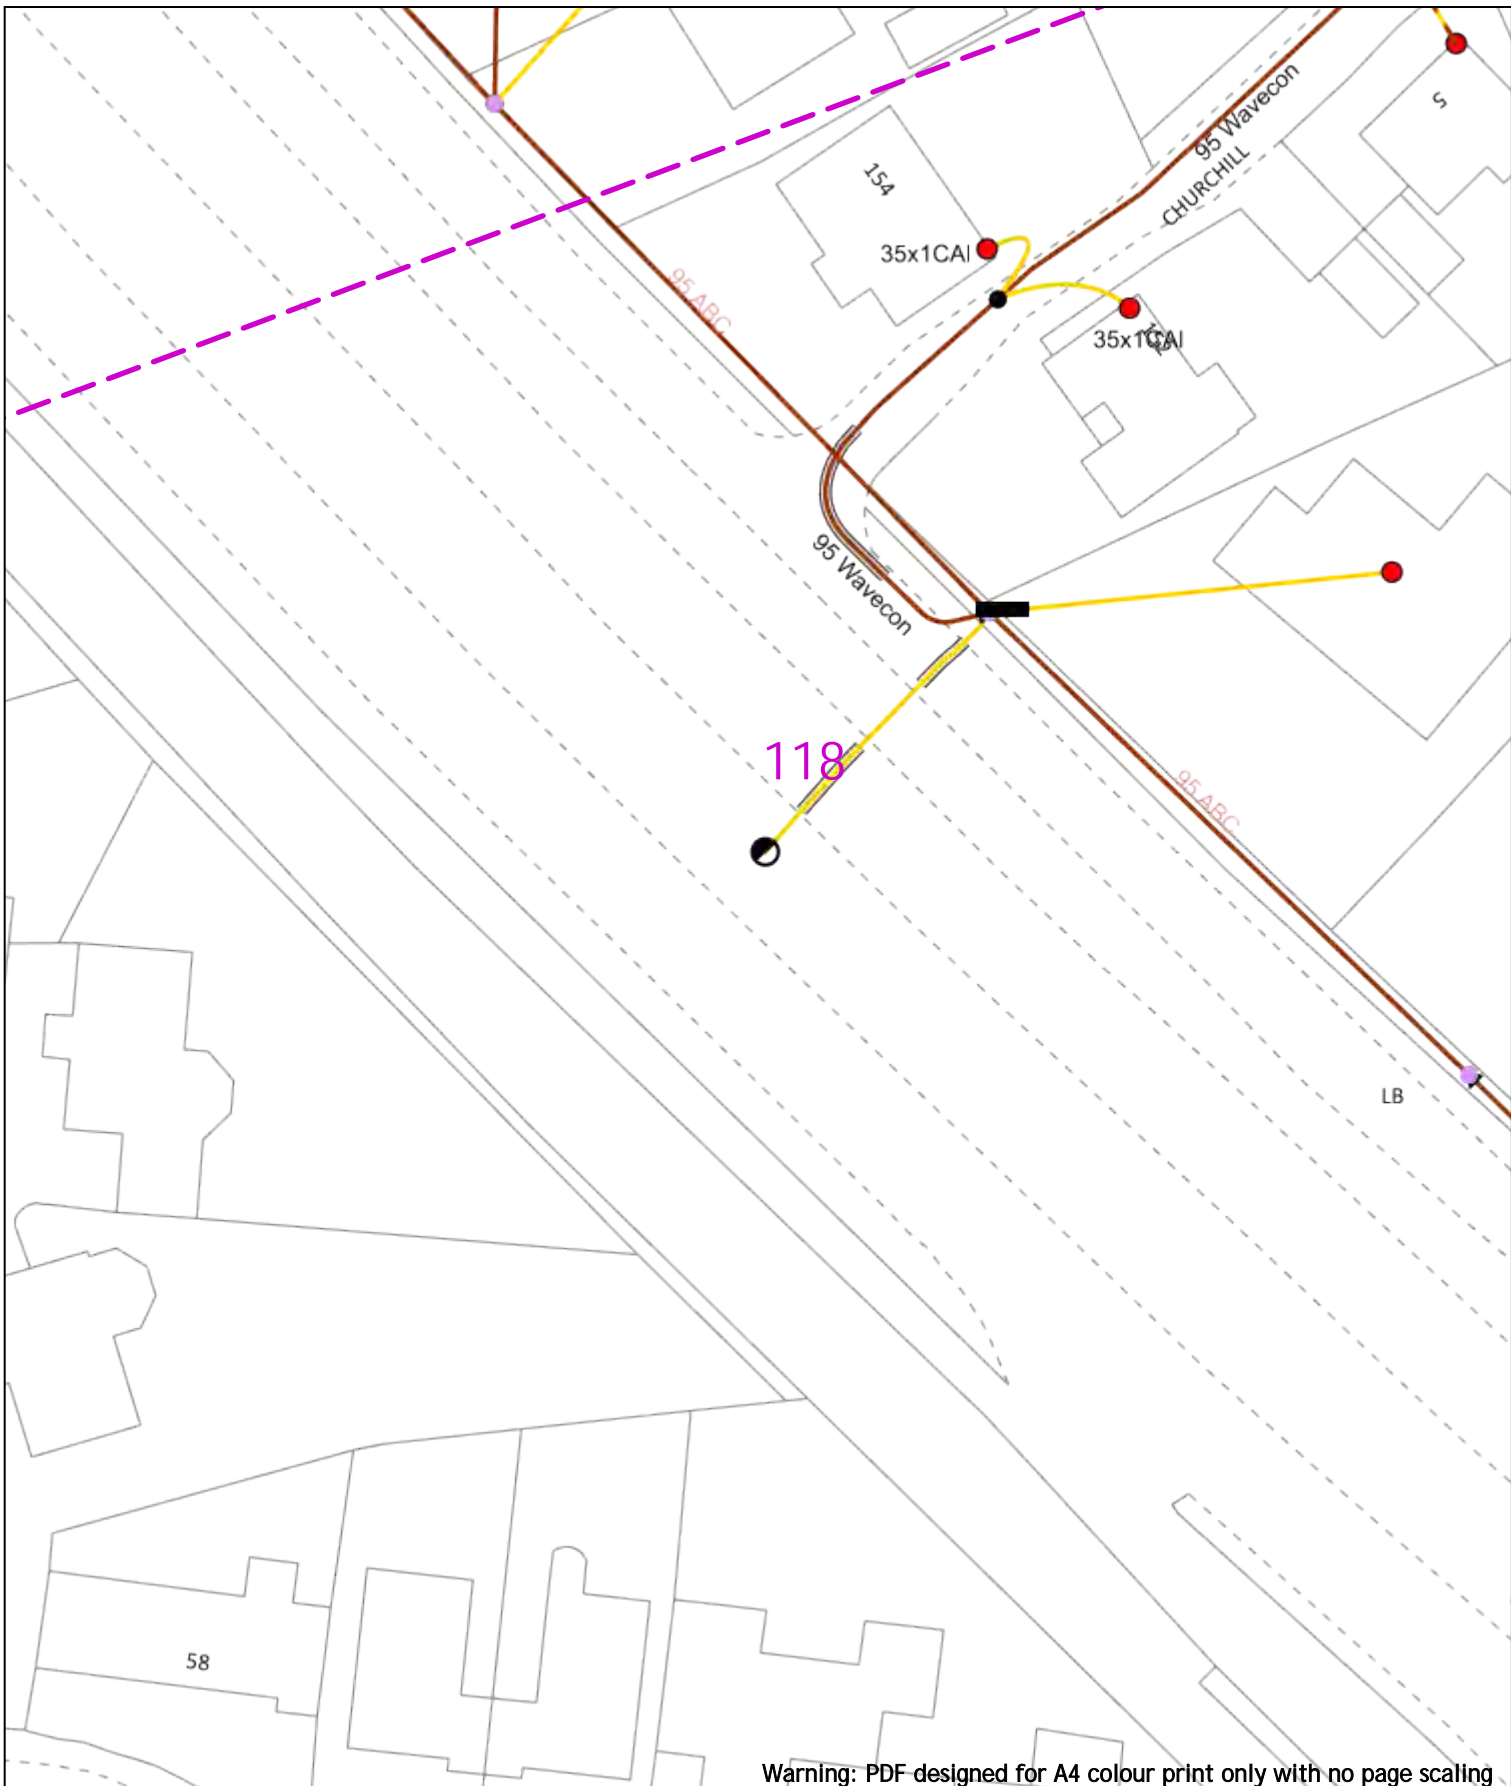

Warning: PDF designed for A4 colour print only with no page scaling

<p>0 20m Dig Sites Area: Line: </p>	<p>Legend</p> <ul style="list-style-type: none"> Service Cable LV Main 6.6kV 11kV 22kV 33kV 66kV 132kV 275kV 400kV Fibre Optic Pilot Cable <p>Distribution Structures (Electric)</p> <ul style="list-style-type: none"> Pole, Existing Location Pole Structure, Existing Location - Single Pole Structure, Existing Location - H Duct Route Cross Section Route 		<p>Southern Electric Power Distribution plc Registered Office: No.1 Forbury Place 43 Forbury Road Reading RG1 3JH Registered In England & Wales No.04094290</p> <p>If you're unsure & need to seek advice before commencing excavations, please contact: General Enquiries: 0800 048 3516</p> <p>Subject to revision – Master held by SSEN Asset Data Team: Asset.Data@sse.com 01256 337 294</p>	
<p>Date Requested: 24/06/2022 Job Reference: 25881010 Site Location: 448066 213346 Requested by: Mr Joe Shawyer Your Scheme/Reference: 31188_002</p>	<table border="1" style="width: 100%; border-collapse: collapse;"> <thead> <tr> <th colspan="4">Voltages (V)</th> </tr> </thead> <tbody> <tr> <td>LV (Low Voltage) and Services</td> <td colspan="3">Up to 1,000V</td> </tr> <tr> <td>HV (High Voltage)</td> <td colspan="3">Over 1,000V to 11,000V</td> </tr> <tr> <td>EHV (Extra High Voltage)</td> <td colspan="3">22,000V to 132,000V</td> </tr> <tr> <td>Transmission</td> <td colspan="3">275,000V and 400,000V</td> </tr> <tr> <th colspan="4">NORMAL DEPTH TO THE TOP OF THE CABLE WHEN LAID</th> </tr> <tr> <td>Services</td> <td>LV</td> <td>HV</td> <td>EHV</td> </tr> <tr> <td>Footpath/Unmade</td> <td>0.45m</td> <td>0.45m</td> <td>0.6m</td> </tr> <tr> <td>Road Crossing</td> <td>0.6m</td> <td>0.6m</td> <td>0.9m</td> </tr> <tr> <td>Agricultural</td> <td>1m</td> <td>1m</td> <td>1.1m</td> </tr> </tbody> </table> <p>WARNING There may have been subsequent alteration to the surface levels. Trial holes must be undertaken to determine position and depths of cables. HS (G) 47 Booklet from the Health and Safety Executive – Avoiding Danger from Buried Cables – should be consulted before commencing excavation work. WHEN WORKING IN THE VICINITY OF OVERHEAD LINES THE HEALTH AND SAFETY GUIDANCE NOTES G56 SHOULD BE CONSULTED (AVAILABLE FROM THE HSE WEBSITE)</p>	Voltages (V)				LV (Low Voltage) and Services	Up to 1,000V			HV (High Voltage)	Over 1,000V to 11,000V			EHV (Extra High Voltage)	22,000V to 132,000V			Transmission	275,000V and 400,000V			NORMAL DEPTH TO THE TOP OF THE CABLE WHEN LAID				Services	LV	HV	EHV	Footpath/Unmade	0.45m	0.45m	0.6m	Road Crossing	0.6m	0.6m	0.9m	Agricultural	1m	1m	1.1m	<p>Scale: 1:500 (When plotted at A4)</p>	<p>BASED UPON THE ORDNANCE SURVEY MAP WITH THE SANCTION OF THE CONTROLLER OF H.M. STATIONERY OFFICE CROWN COPYRIGHT RESERVED. This copy has been made by or with the authority of Scottish and Southern Energy Power Distribution Ltd. Pursuant to section 47 of the Copyright, Designs and Patents Act 1988 ("The Act"). Unless the Act provides a relevant exception to copyright the copy must not be copied without prior permission of the copyright owner. Plans generated by DigSAFE Pro™ software provided by Linearcableforedging.</p>

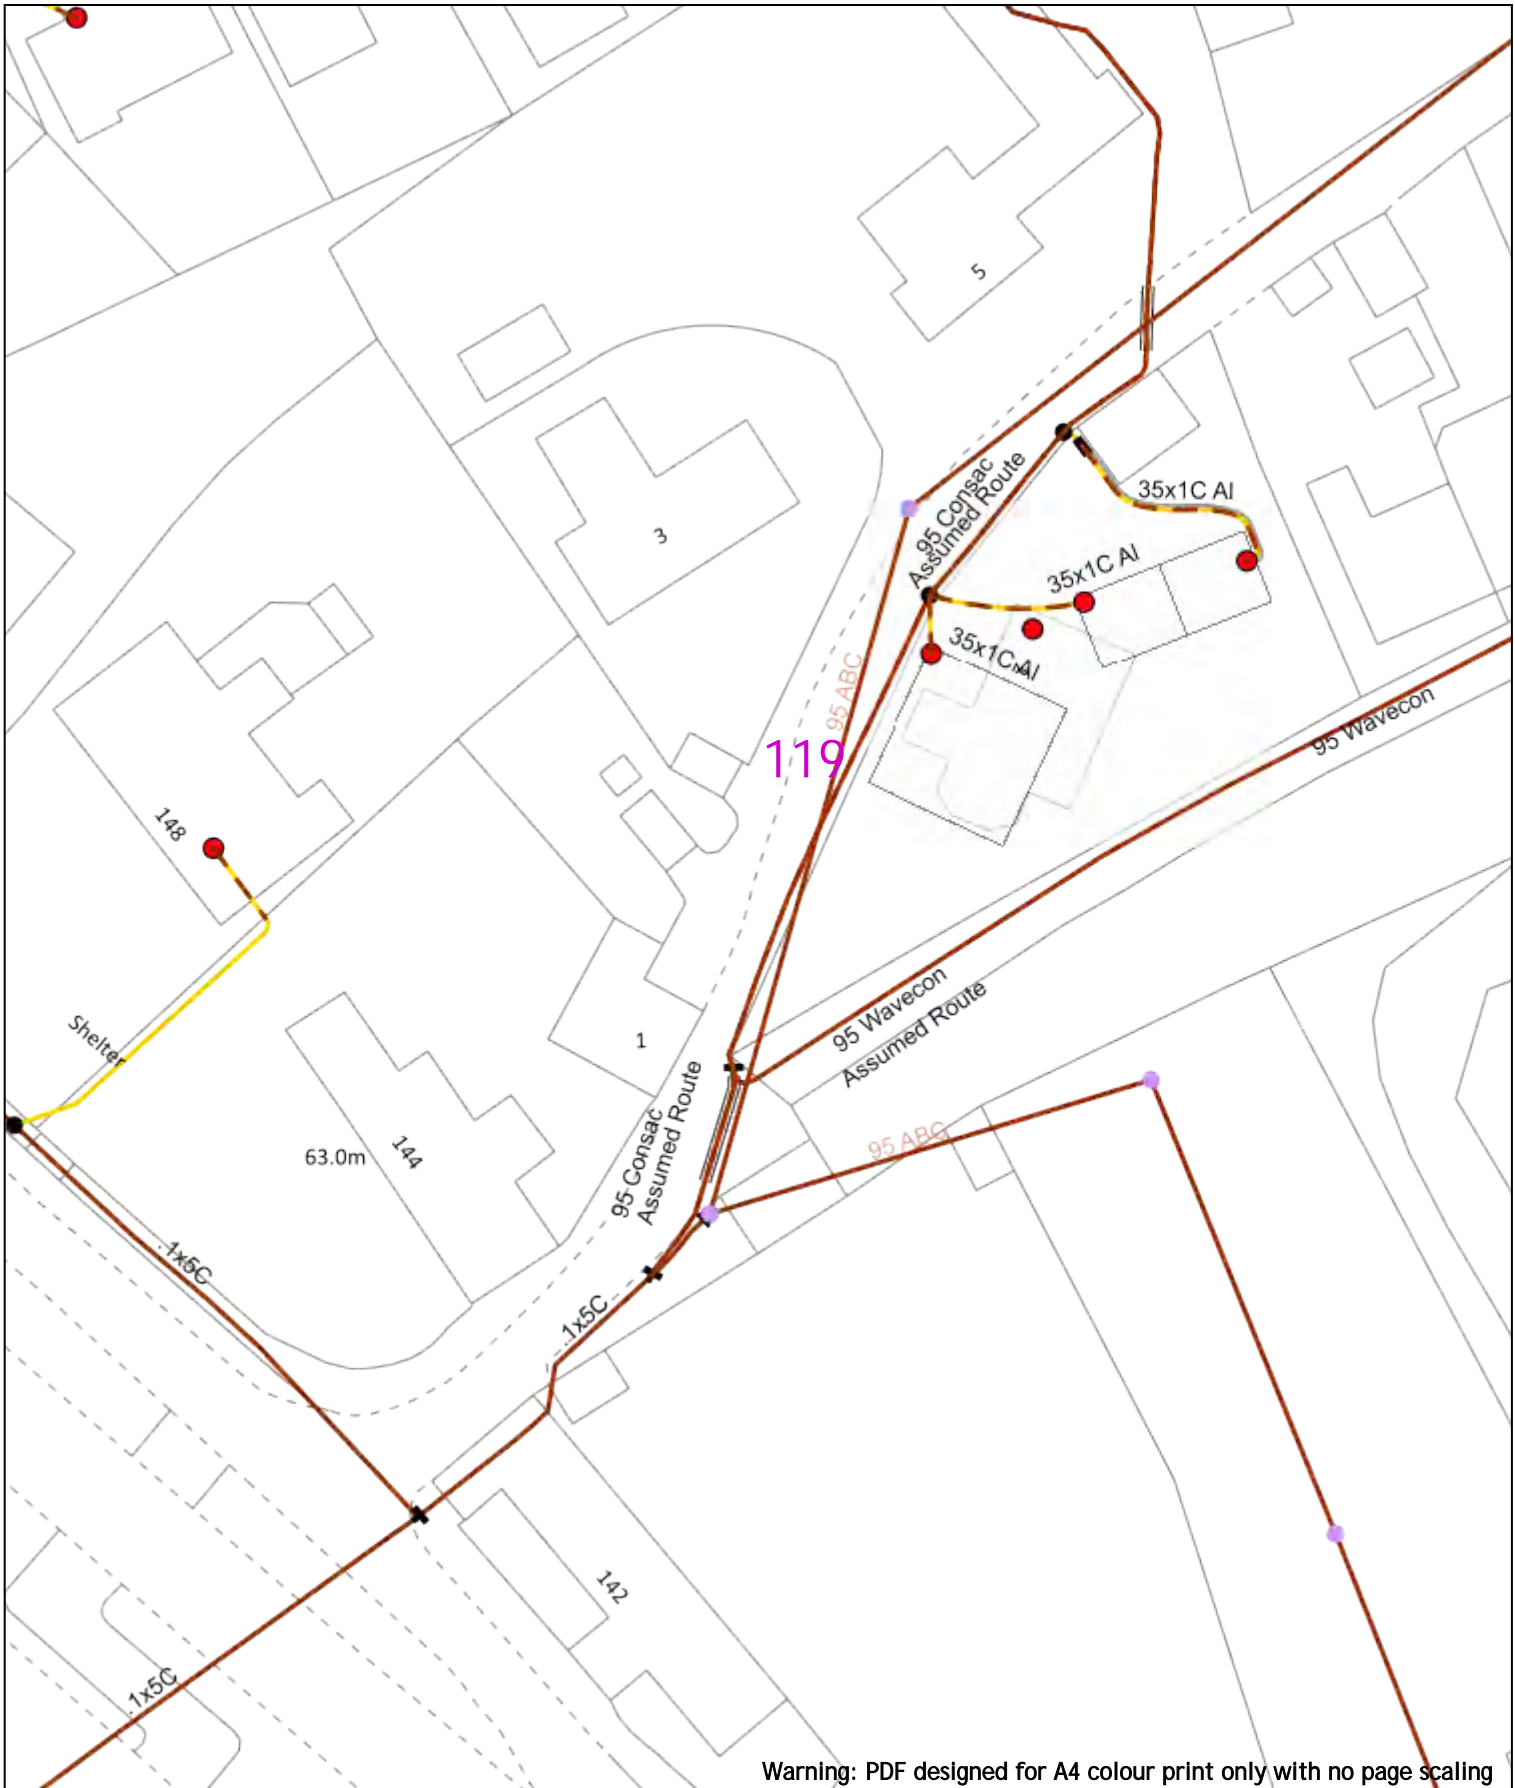

0 20m Dig Sites Area: Line:

Date Requested: 24/06/2022
 Job Reference: 25881010
 Site Location: 448066 213346
 Requested by: Mr Joe Shawyer
 Your Scheme/Reference: 31188_002

Voltages (V)	
LV (Low Voltage) and Services	Up to 1,000V
HV (High Voltage)	Over 1,000V to 11,000V
EHV (Extra High Voltage)	22,000V to 132,000V
Transmission	275,000V and 400,000V

NORMAL DEPTH TO THE TOP OF THE CABLE WHEN LAID			
Services	LV	HV	EHV
Footpath/Unmade	0.45m	0.45m	0.6m
Road Crossing	0.6m	0.6m	0.75m
Agricultural	1m	1m	1.1m

Legend	
	Service Cable
	LV Mains
	6.6kV
	11kV
	22kV
	33kV
	66kV
	132kV
	275kV
	400kV
	Fibre Optic
	Road Cable

Distribution Structures (Electric)	
	Pole, Existing Location
	Pole Structure, Existing Location - Single
	Pole Structure, Existing Location - e
	Duct Route
	Cross Section Route

WARNING
 There may have been subsequent alteration to the surface levels. Trial holes must be undertaken to determine position and depths of cables. HS (G) 47 Booklet from the Health and Safety Executive - Avoiding Danger from Buried Cables - should be consulted before commencing excavation work.
 WHEN WORKING IN THE VICINITY OF OVERHEAD LINES THE HEALTH AND SAFETY GUIDANCE NOTES G56 SHOULD BE CONSULTED (AVAILABLE FROM THE HSE WEBSITE)


Scale: 1:500 (When plotted at A4)

Southern Electric Power Distribution plc
 Registered Office: No.1 Forbury Place
 43 Forbury Road Reading RG1 3JH
 Registered In England & Wales No.04094290

If you're unsure & need to seek advice before commencing excavations, please contact:
 General Enquiries: 0800 048 3516


Subject to revision - Master held by SSEN Asset Data Team:
Asset.Data@sse.com
 01256 337 294

BASED UPON THE ORDNANCE SURVEY MAP WITH THE SANCTION OF THE CONTROLLER OF H.M. STATIONERY OFFICE CROWN COPYRIGHT RESERVED.
 This copy has been made by or with the authority of Scottish and Southern Energy Power Distribution Ltd. Pursuant to section 47 of the Copyright, Designs and Patents Act 1988 ("The Act"). Unless the Act provides a relevant exception to copyright the copy must not be copied without permission of the copyright owner.
 Plans generated by DigSAFE Pro™ software provided by Lineaschibboleddig.

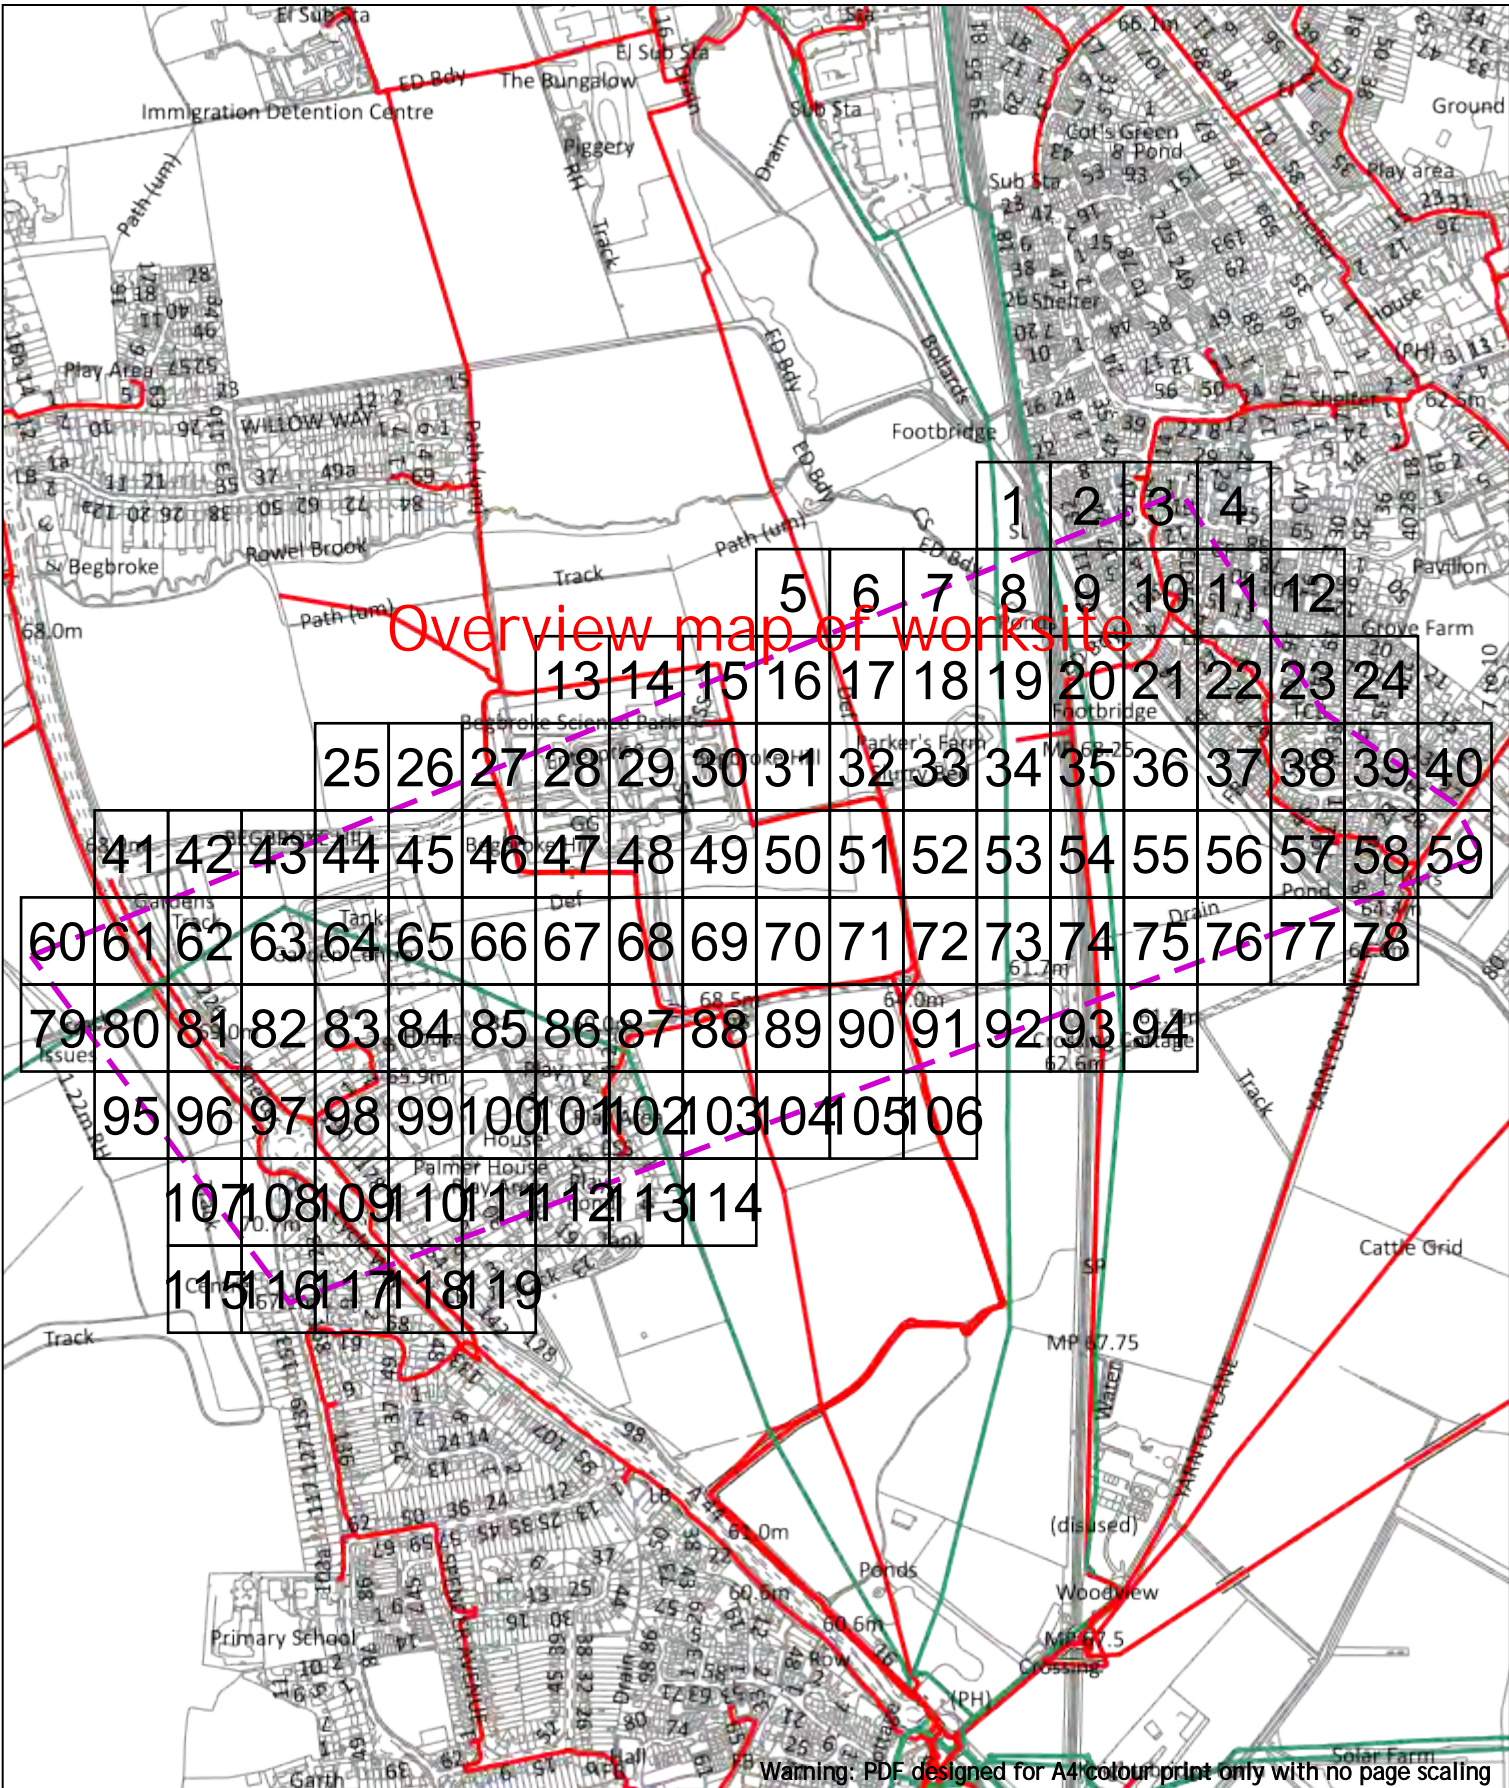

Overview map of worksite

<p>Dig Sites Area: Line: </p> <p>Extra High Voltage cables in vicinity</p>																										
<p>Date Requested: 24/06/2022 Job Reference: 25881010 Site Location: 448066 213346 Requested by: Mr Joe Shawyer</p>	<p>Your Scheme/Reference: 31188_002</p>			<p>Southern Electric Power Distribution plc Registered Office: No.1 Forbury Place 43 Forbury Road Reading RG1 3JH Registered In England & Wales No.04094290</p> <p>If you're unsure & need to seek advice before commencing excavations, please contact: General Enquiries: 0800 048 3516</p> <p>Subject to revision – Master held by SSEN Asset Data Team: Asset.Data@sse.com 01256 337 294</p>																						
<p>Voltagues (V)</p> <table border="1"> <tr> <td>LV (Low Voltage) and Services</td> <td>Up to 1,000V</td> </tr> <tr> <td>HV (High Voltage)</td> <td>Over 1,000V to 11,000V</td> </tr> <tr> <td>EHV (Extra High Voltage)</td> <td>22,000V to 132,000V</td> </tr> <tr> <td>Transmission</td> <td>275,000V and 400,000V</td> </tr> </table> <p>NORMAL DEPTH TO THE TOP OF THE CABLE WHEN LAID</p> <table border="1"> <tr> <td>Services</td> <td>LV</td> <td>HV</td> <td>EHV</td> </tr> <tr> <td>Footpath/Unmade</td> <td>0.45m</td> <td>0.45m</td> <td>0.6m</td> </tr> <tr> <td>Road Crossing</td> <td>0.6m</td> <td>0.6m</td> <td>0.75m</td> </tr> <tr> <td>Agricultural</td> <td>1m</td> <td>1m</td> <td>1.1m</td> </tr> </table>		LV (Low Voltage) and Services	Up to 1,000V	HV (High Voltage)	Over 1,000V to 11,000V	EHV (Extra High Voltage)	22,000V to 132,000V	Transmission	275,000V and 400,000V	Services	LV	HV	EHV	Footpath/Unmade	0.45m	0.45m	0.6m	Road Crossing	0.6m	0.6m	0.75m	Agricultural	1m	1m	1.1m	<p>Legend</p> <ul style="list-style-type: none"> Service Cable LV Mains 11kV 22kV 33kV 66kV 132kV 275kV 400kV Fibre Optic Pipe Cable <p>Distribution Structures (Electric)</p> <ul style="list-style-type: none"> Pole, Existing Location Pole Structure, Existing Location - Single Pole Structure, Existing Location - H Duct Route Cross Section Route
LV (Low Voltage) and Services	Up to 1,000V																									
HV (High Voltage)	Over 1,000V to 11,000V																									
EHV (Extra High Voltage)	22,000V to 132,000V																									
Transmission	275,000V and 400,000V																									
Services	LV	HV	EHV																							
Footpath/Unmade	0.45m	0.45m	0.6m																							
Road Crossing	0.6m	0.6m	0.75m																							
Agricultural	1m	1m	1.1m																							
<p>Scale: 1:10250 (When plotted at A4)</p> <p>WARNING</p> <p>There may have been subsequent alteration to the surface levels. Trial holes must be undertaken to determine position and depths of cables. HS (G) 47 Booklet from the Health and Safety Executive – Avoiding Danger from Buried Cables – should be consulted before commencing excavation work.</p> <p>WHEN WORKING IN THE VICINITY OF OVERHEAD LINES THE HEALTH AND SAFETY GUIDANCE NOTES G56 SHOULD BE CONSULTED (AVAILABLE FROM THE HSE WEBSITE)</p> <p><small>BASED UPON THE ORDNANCE SURVEY MAP WITH THE SANCTION OF THE CONTROLLER OF HM STATIONERY OFFICE CROWN COPYRIGHT RESERVED. This copy has been made by or with the authority of Scottish and Southern Energy Power Distribution Ltd. Pursuant to section 47 of the Copyright, Designs and Patents Act 1988 ('The Act'). Unless the Act provides a relevant exception to copyright the copy must not be copied without prior permission of the copyright owner. Plans generated by DigSAFE Pro™ software provided by Linexarchitects.co.uk.</small></p>																										

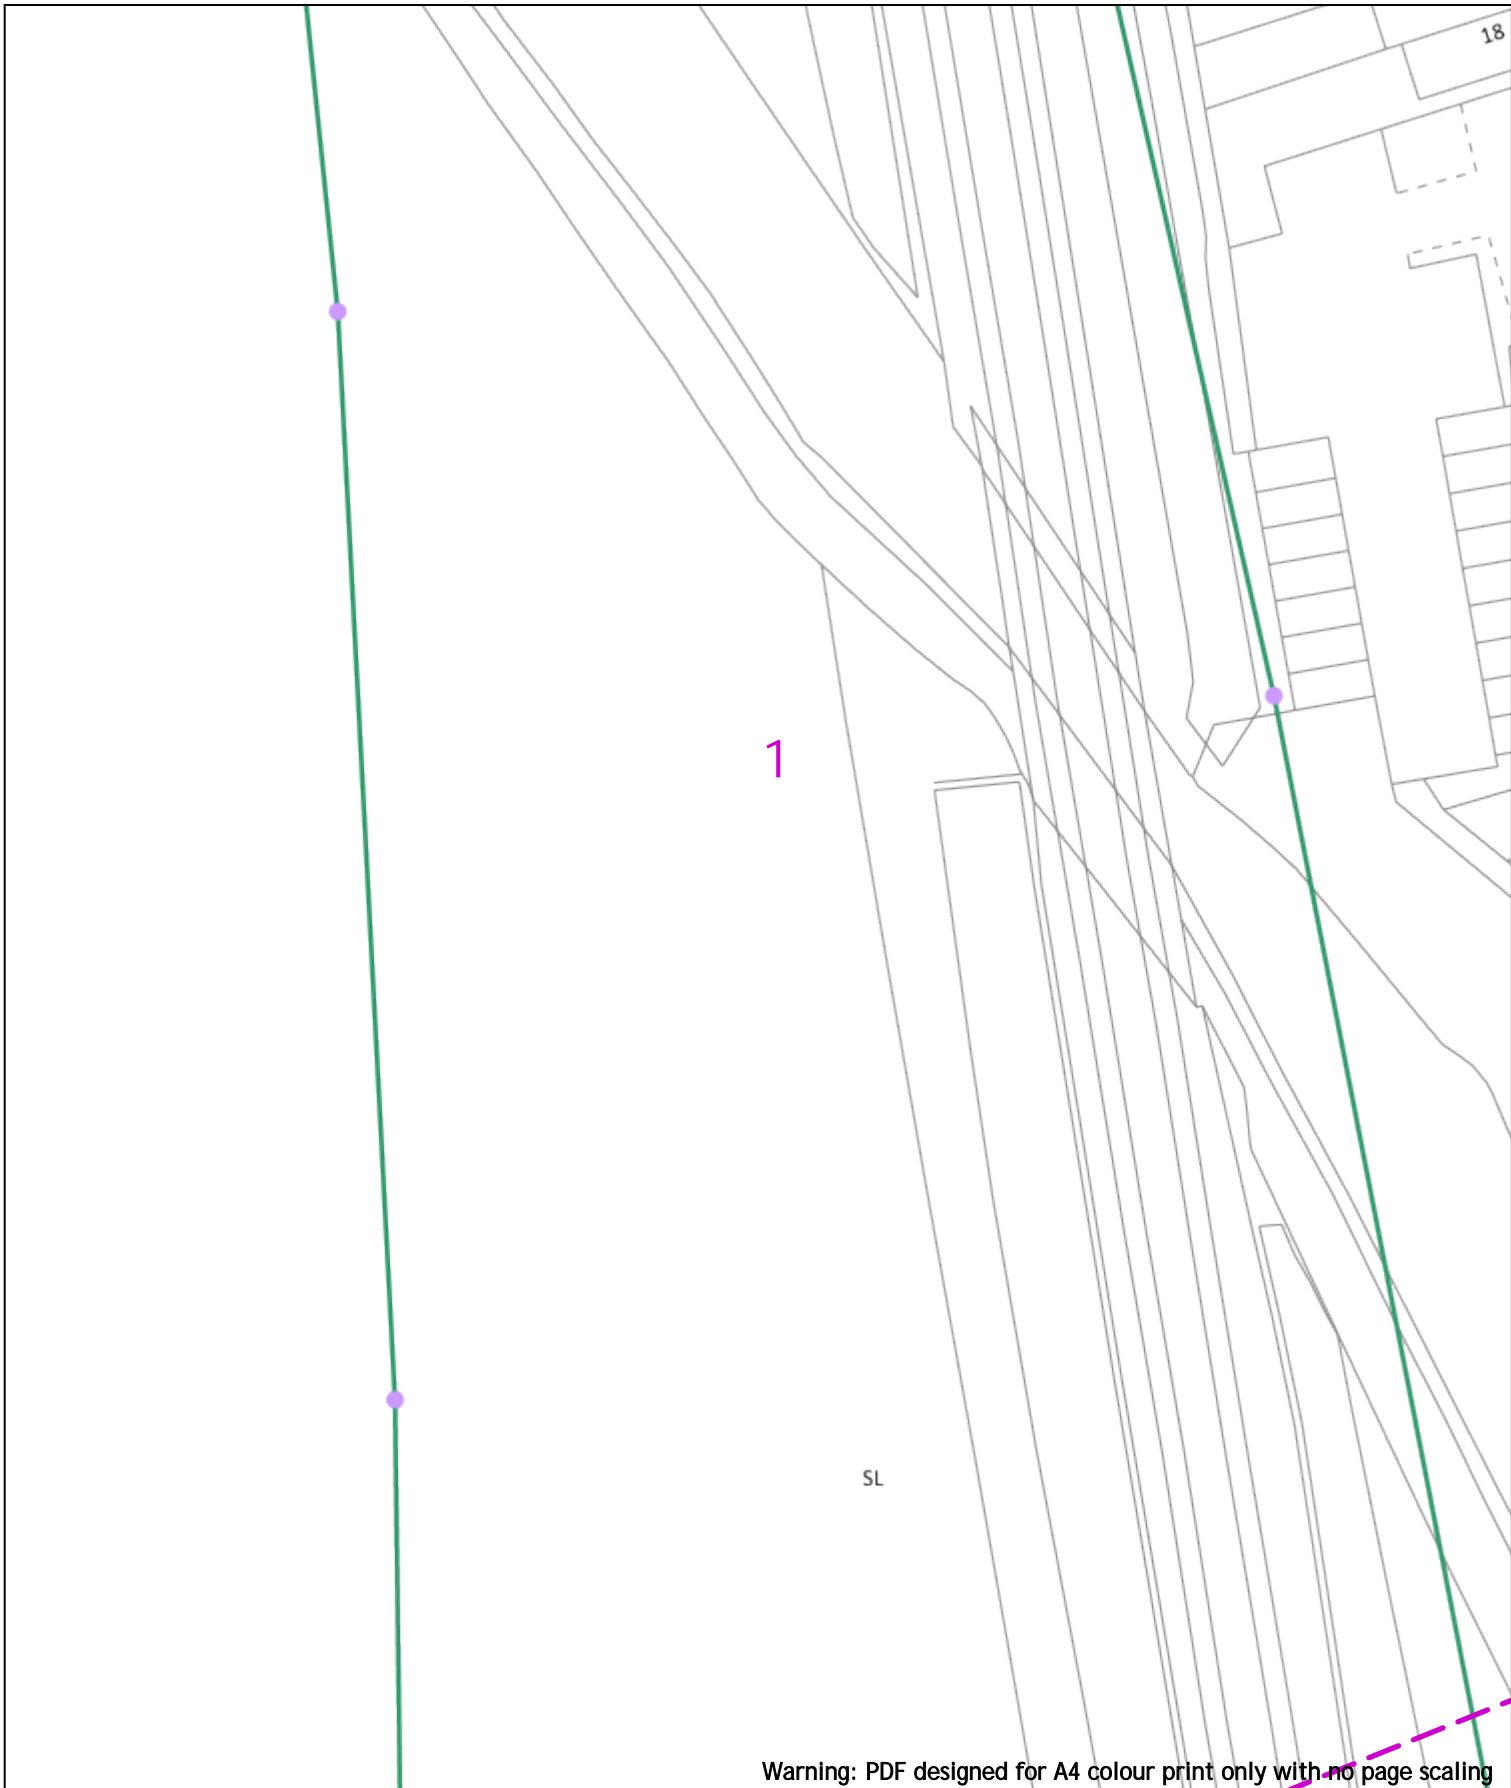

Warning: PDF designed for A4 colour print only with no page scaling

<p>0 20m</p> <p>Date Requested: 24/06/2022 Job Reference: 25881010 Site Location: 448066 213346 Requested by: Mr Joe Shawyer Your Scheme/Reference: 31188_002</p>	<p>Dig Sites Area: Line: </p> <p style="text-align: center; background-color: red; color: white; padding: 5px;">Extra High Voltage cables in vicinity</p>	<p> </p> <p style="text-align: center;">Southern Electric Power Distribution plc Registered Office: No.1 Forbury Place 43 Forbury Road Reading RG1 3JH Registered In England & Wales No.04094290</p> <p style="font-size: small;">If you're unsure & need to seek advice before commencing excavations, please contact: General Enquiries: 0800 048 3516</p> <p style="font-size: x-small;">Subject to revision – Master held by SSE Asset Data Team: Asset.Data@sse.com 01256 337 294</p>	
<p>Scale: 1:500 (When plotted at A4)</p>	<table border="1" style="width: 100%; border-collapse: collapse; font-size: x-small;"> <thead> <tr> <th colspan="4">Voltages (V)</th> </tr> </thead> <tbody> <tr> <td>LV (Low Voltage) and Services</td> <td colspan="3">Up to 1,000V</td> </tr> <tr> <td>HV (High Voltage)</td> <td colspan="3">Over 1,000V to 11,000V</td> </tr> <tr> <td>EHV (Extra High Voltage)</td> <td colspan="3">22,000V to 132,000V</td> </tr> <tr> <td>Transmission</td> <td colspan="3">275,000V and 400,000V</td> </tr> <tr> <th colspan="4">NORMAL DEPTH TO THE TOP OF THE CABLE WHEN LAID</th> </tr> <tr> <td>Services</td> <td>LV</td> <td>HV</td> <td>EHV</td> </tr> <tr> <td>Footpath/Unmade</td> <td>0.45m</td> <td>0.45m</td> <td>0.6m</td> </tr> <tr> <td>Road Crossing</td> <td>0.6m</td> <td>0.6m</td> <td>0.75m</td> </tr> <tr> <td>Agricultural</td> <td>1m</td> <td>1m</td> <td>1.1m</td> </tr> </tbody> </table> <p style="font-size: x-small; text-align: center;">WARNING There may have been subsequent alteration to the surface levels. Trial holes must be undertaken to determine position and depths of cables. HS (G) 47 Booklet from the Health and Safety Executive – Avoiding Danger from Buried Cables – should be consulted before commencing excavation work. WHEN WORKING IN THE VICINITY OF OVERHEAD LINES THE HEALTH AND SAFETY GUIDANCE NOTES G56 SHOULD BE CONSULTED (AVAILABLE FROM THE HSE WEBSITE)</p>	Voltages (V)				LV (Low Voltage) and Services	Up to 1,000V			HV (High Voltage)	Over 1,000V to 11,000V			EHV (Extra High Voltage)	22,000V to 132,000V			Transmission	275,000V and 400,000V			NORMAL DEPTH TO THE TOP OF THE CABLE WHEN LAID				Services	LV	HV	EHV	Footpath/Unmade	0.45m	0.45m	0.6m	Road Crossing	0.6m	0.6m	0.75m	Agricultural	1m	1m	1.1m	<table border="1" style="width: 100%; border-collapse: collapse; font-size: x-small;"> <thead> <tr> <th colspan="2">Legend</th> <th colspan="2">Distribution Structures (Electric)</th> </tr> </thead> <tbody> <tr> <td></td> <td>Service Cable</td> <td></td> <td>Pole, Existing Location</td> </tr> <tr> <td></td> <td>LV Mains</td> <td></td> <td>Pole Structure, Existing Location - Single</td> </tr> <tr> <td></td> <td>2 - 11kV</td> <td></td> <td>Pole Structure, Existing Location - H</td> </tr> <tr> <td></td> <td>66kV</td> <td></td> <td>Duct Route</td> </tr> <tr> <td></td> <td>11kV</td> <td></td> <td>Cross Section Route</td> </tr> <tr> <td></td> <td>22kV</td> <td></td> <td></td> </tr> <tr> <td></td> <td>33kV</td> <td></td> <td></td> </tr> <tr> <td></td> <td>66kV</td> <td></td> <td></td> </tr> <tr> <td></td> <td>132kV</td> <td></td> <td></td> </tr> <tr> <td></td> <td>275kV</td> <td></td> <td></td> </tr> <tr> <td></td> <td>400kV</td> <td></td> <td></td> </tr> <tr> <td></td> <td>Fibre Optic</td> <td></td> <td></td> </tr> <tr> <td></td> <td>Pipe Cable</td> <td></td> <td></td> </tr> </tbody> </table>	Legend		Distribution Structures (Electric)			Service Cable		Pole, Existing Location		LV Mains		Pole Structure, Existing Location - Single		2 - 11kV		Pole Structure, Existing Location - H		66kV		Duct Route		11kV		Cross Section Route		22kV				33kV				66kV				132kV				275kV				400kV				Fibre Optic				Pipe Cable		
Voltages (V)	
LV (Low Voltage) and Services	Up to 1,000V	
HV (High Voltage)	Over 1,000V to 11,000V	
EHV (Extra High Voltage)	22,000V to 132,000V	
Transmission	275,000V and 400,000V	
NORMAL DEPTH TO THE TOP OF THE CABLE WHEN LAID	
Services	LV	HV	EHV	
Footpath/Unmade	0.45m	0.45m	0.6m	
Road Crossing	0.6m	0.6m	0.75m	
Agricultural	1m	1m	1.1m	
Legend		Distribution Structures (Electric)	
	Service Cable		Pole, Existing Location	
	LV Mains		Pole Structure, Existing Location - Single	
	2 - 11kV		Pole Structure, Existing Location - H	
	66kV		Duct Route	
	11kV		Cross Section Route	
	22kV	
	33kV	
	66kV	
	132kV	
	275kV	
	400kV	
	Fibre Optic	
	Pipe Cable	

BASED UPON THE ORDNANCE SURVEY MAP WITH THE SANCTION OF THE CONTROLLER OF HM STATIONERY OFFICE CROWN COPYRIGHT RESERVED.
 This copy has been made by or with the authority of Scottish and Southern Energy Power Distribution Ltd. Pursuant to section 47 of the Copyright, Designs and Patents Act 1988 ("The Act"). Unless the Act provides a relevant exception to copyright the copy must not be copied without prior permission of the copyright owner.
 Plans generated by DigSAFE Pro™ software provided by LinesearchbeforeUdig.



Warning: PDF designed for A4 colour print only with no page scaling

0 20m

Dig Sites Area: Line:

Extra High Voltage cables in vicinity

Date Requested: 24/06/2022
 Job Reference: 25881010
 Site Location: 448066 213346
 Requested by: Mr Joe Shawyer
 Your Scheme/Reference: 31188_002

Voltages (V)			
LV (Low Voltage) and Services	Up to 1,000V		
HV (High Voltage)	Over 1,000V to 11,000V		
EHV (Extra High Voltage)	22,000V to 132,000V		
Transmission	275,000V and 400,000V		
NORMAL DEPTH TO THE TOP OF THE CABLE WHEN LAID			
Services	LV	HV	EHV
Footpath/Unmade	0.45m	0.45m	0.6m
Road Crossing	0.6m	0.6m	0.75m
Agricultural	1m	1m	1.1m

Legend	
	Service Cable
	LV Mains
	2 - 3.3kV
	6.6kV
	11kV
	22kV
	33kV
	66kV
	132kV
	275kV
	400kV
	Fibre Optic
	Pipe Cable

Distribution Structures (Electric)	
	Pole, Existing Location
	Pole Structure, Existing Location - Single
	Pole Structure, Existing Location - H
	Duct Route
	Cross Section Route

Southern Electric Power Distribution plc
 Registered Office: No.1 Forbury Place
 43 Forbury Road Reading RG1 3JH
 Registered In England & Wales No.04094290


If you're unsure & need to seek advice before commencing excavations, please contact:
 General Enquiries: 0800 048 3516

Subject to revision – Master held by SSEN Asset Data Team:
Asset.Data@sse.com
 01256 337 294

Scale: 1:500 (When plotted at A4)

WARNING
 There may have been subsequent alteration to the surface levels. Trial holes must be undertaken to determine position and depths of cables. HS (G) 47 Booklet from the Health and Safety Executive – Avoiding Danger from Buried Cables – should be consulted before commencing excavation work.
WHEN WORKING IN THE VICINITY OF OVERHEAD LINES THE HEALTH AND SAFETY GUIDANCE NOTES G56 SHOULD BE CONSULTED (AVAILABLE FROM THE HSE WEBSITE)

BASED UPON THE ORDNANCE SURVEY MAP WITH THE SANCTION OF THE CONTROLLER OF HM STATIONERY OFFICE CROWN COPYRIGHT RESERVED.
 This copy has been made by or with the authority of Scottish and Southern Energy Power Distribution Ltd. Pursuant to section 47 of the Copyright, Designs and Patents Act 1988 ("The Act"). Unless the Act provides a relevant exception to copyright the copy must not be copied without prior permission of the copyright owner.
 Plans generated by DigSAFE Pro™ software provided by LinesearchbeforeyouDig.

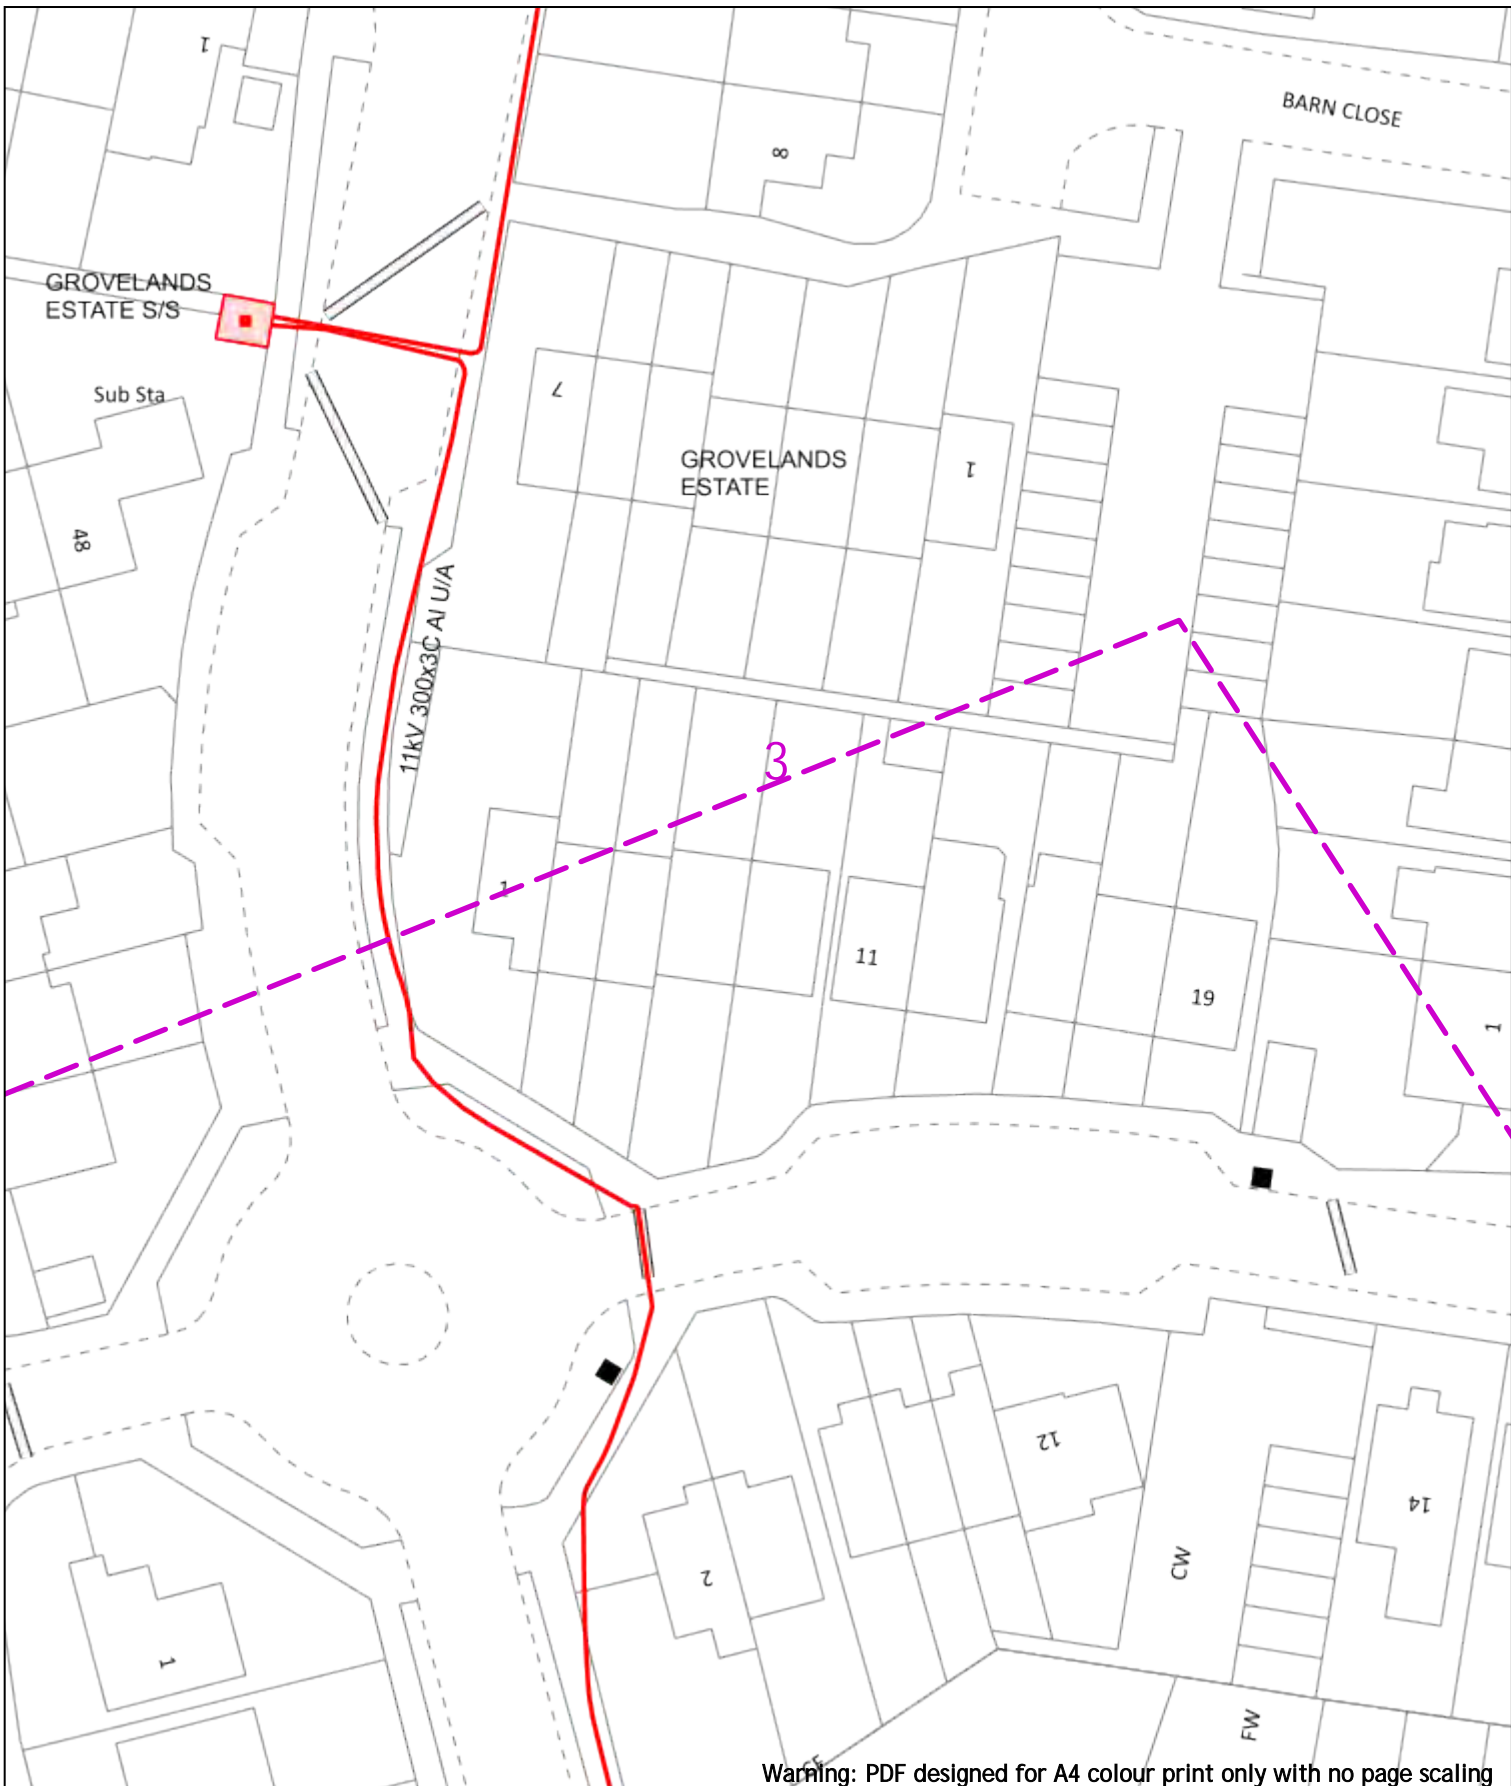

Warning: PDF designed for A4 colour print only with no page scaling



Dig Sites Area: Line:

Extra High Voltage cables in vicinity

Date Requested: 24/06/2022
 Job Reference: 25881010
 Site Location: 448066 213346
 Requested by: Mr Joe Shawyer
 Your Scheme/Reference: 31188_002

Voltages (V)			
LV (Low Voltage) and Services	Up to 1,000V		
HV (High Voltage)	Over 1,000V to 11,000V		
EHV (Extra High Voltage)	22,000V to 132,000V		
Transmission	275,000V and 400,000V		
NORMAL DEPTH TO THE TOP OF THE CABLE WHEN LAID			
Services	LV	HV	EHV
Footpath/Unmade	0.45m	0.45m	0.6m
Road Crossing	0.6m	0.6m	0.75m
Agricultural	1m	1m	1.1m

Legend	
	Service Cable
	LV Mains
	2 - 11kV
	6kV
	11kV
	22kV
	33kV
	66kV
	132kV
	275kV
	400kV
	Fibre Optic
	Pipe Cable

Distribution Structures (Electric)	
	Pole, Existing Location
	Pole Structure, Existing Location - Single
	Pole Structure, Existing Location - H
	Duct Route
	Cross Section Route



Southern Electric Power Distribution plc
 Registered Office: No.1 Forbury Place
 43 Forbury Road Reading RG1 3JH
 Registered In England & Wales No.04094290

If you're unsure & need to seek advice before commencing excavations, please contact:
 General Enquiries: 0800 048 3516

Subject to revision – Master held by SSEN Asset Data Team:
Asset.Data@sse.com
 01256 337 294

Scale: 1:500 (When plotted at A4)

WARNING
 There may have been subsequent alteration to the surface levels. Trial holes must be undertaken to determine position and depths of cables. HS (G) 47 Booklet from the Health and Safety Executive – Avoiding Danger from Buried Cables – should be consulted before commencing excavation work.
WHEN WORKING IN THE VICINITY OF OVERHEAD LINES THE HEALTH AND SAFETY GUIDANCE NOTES G56 SHOULD BE CONSULTED (AVAILABLE FROM THE HSE WEBSITE)



0 20m Dig Sites Area: Line: **Extra High Voltage cables in vicinity**

Date Requested: 24/06/2022
 Job Reference: 25881010
 Site Location: 448066 213346
 Requested by: Mr Joe Shawyer
 Your Scheme/Reference: 31188_002

Voltages (V)	
LV (Low Voltage) and Services	Up to 1,000V
HV (High Voltage)	Over 1,000V to 11,000V
EHV (Extra High Voltage)	22,000V to 132,000V
Transmission	275,000V and 400,000V

NORMAL DEPTH TO THE TOP OF THE CABLE WHEN LAID			
Services	LV	HV	EHV
Footpath/Unmade	0.45m	0.45m	0.6m
Road Crossing	0.6m	0.6m	0.75m
Agricultural	1m	1m	1.1m

Legend	
	Service Cable
	LV Mains
	2 - 11kV
	66kV
	11kV
	22kV
	33kV
	66kV
	132kV
	275kV
	400kV
	Fibre Optic
	Pipe Cable

Distribution Structures (Electric)	
	Pole, Existing Location
	Pole Structure, Existing Location - Single
	Pole Structure, Existing Location - H
	Duct Route
	Cross Section Route

WARNING
 There may have been subsequent alteration to the surface levels. Trial holes must be undertaken to determine position and depths of cables. HS (G) 47 Booklet from the Health and Safety Executive - Avoiding Danger from Buried Cables - should be consulted before commencing excavation work.
 WHEN WORKING IN THE VICINITY OF OVERHEAD LINES THE HEALTH AND SAFETY GUIDANCE NOTES G56 SHOULD BE CONSULTED (AVAILABLE FROM THE HSE WEBSITE)

Scale: 1:500 (When plotted at A4)

Southern Electric Power Distribution plc
 Registered Office: No.1 Forbury Place
 43 Forbury Road Reading RG1 3JH
 Registered In England & Wales No.04094290

If you're unsure & need to seek advice before commencing excavations, please contact:
 General Enquiries: 0800 048 3516

Subject to revision - Master held by SSEN Asset Data Team:
Asset.Data@sse.com
 01256 337 294

BASED UPON THE ORDNANCE SURVEY MAP WITH THE SANCTION OF THE CONTROLLER OF HM STATIONERY OFFICE CROWN COPYRIGHT RESERVED.
 This copy has been made by or with the authority of Scottish and Southern Energy Power Distribution Ltd. Pursuant to section 47 of the Copyright, Designs and Patents Act 1988 ('The Act'). Unless the Act provides a relevant exception to copyright the copy must not be copied without prior permission of the copyright owner.
 Plans generated by DigSAFE Pro™ software provided by LinesearchbeforeDigs.

5

11kV 300x3C Al CAS UJA

11kV 300x3C Al CAS UJA

Warning: PDF designed for A4 colour print only with no page scaling

0 20m

Dig Sites Area: Line:

Extra High Voltage cables in vicinity



Date Requested: 24/06/2022
 Job Reference: 25881010
 Site Location: 448066 213346
 Requested by: Mr Joe Shawyer
 Your Scheme/Reference: 31188_002

Voltages (V)			
LV (Low Voltage) and Services	Up to 1,000V		
HV (High Voltage)	Over 1,000V to 11,000V		
EHV (Extra High Voltage)	22,000V to 132,000V		
Transmission	275,000V and 400,000V		
NORMAL DEPTH TO THE TOP OF THE CABLE WHEN LAID			
Services	LV	HV	EHV
Footpath/Unmade	0.45m	0.45m	0.6m 0.8m
Road Crossing	0.6m	0.6m	0.75m 0.9m
Agricultural	1m	1m	1m 1.1m

Legend		Distribution Structures (Electric)	
	Service Cable		Pole, Existing Location
	LV Mains		Pole Structure, Existing Location - Single
	2 - 11kV		Pole Structure, Existing Location - H
	66kV		Duct Route
	11kV		Cross Section Route
	22kV		
	33kV		
	66kV		
	132kV		
	275kV		
	400kV		
	Fibre Optic		
	Pipe Cable		


WARNING
 There may have been subsequent alteration to the surface levels. Trial holes must be undertaken to determine position and depths of cables. HS (G) 47 Booklet from the Health and Safety Executive - Avoiding Danger from Buried Cables - should be consulted before commencing excavation work.
 WHEN WORKING IN THE VICINITY OF OVERHEAD LINES THE HEALTH AND SAFETY GUIDANCE NOTES G56 SHOULD BE CONSULTED (AVAILABLE FROM THE HSE WEBSITE)

Southern Electric Power Distribution plc
 Registered Office: No.1 Forbury Place
 43 Forbury Road Reading RG1 3JH
 Registered In England & Wales No.04094290

If you're unsure & need to seek advice before commencing excavations, please contact:
 General Enquiries: 0800 048 3516

Subject to revision - Master held by SSEN Asset Data Team:
Asset.Data@sse.com
 01256 337 294

Scale: 1:500 (When plotted at A4)

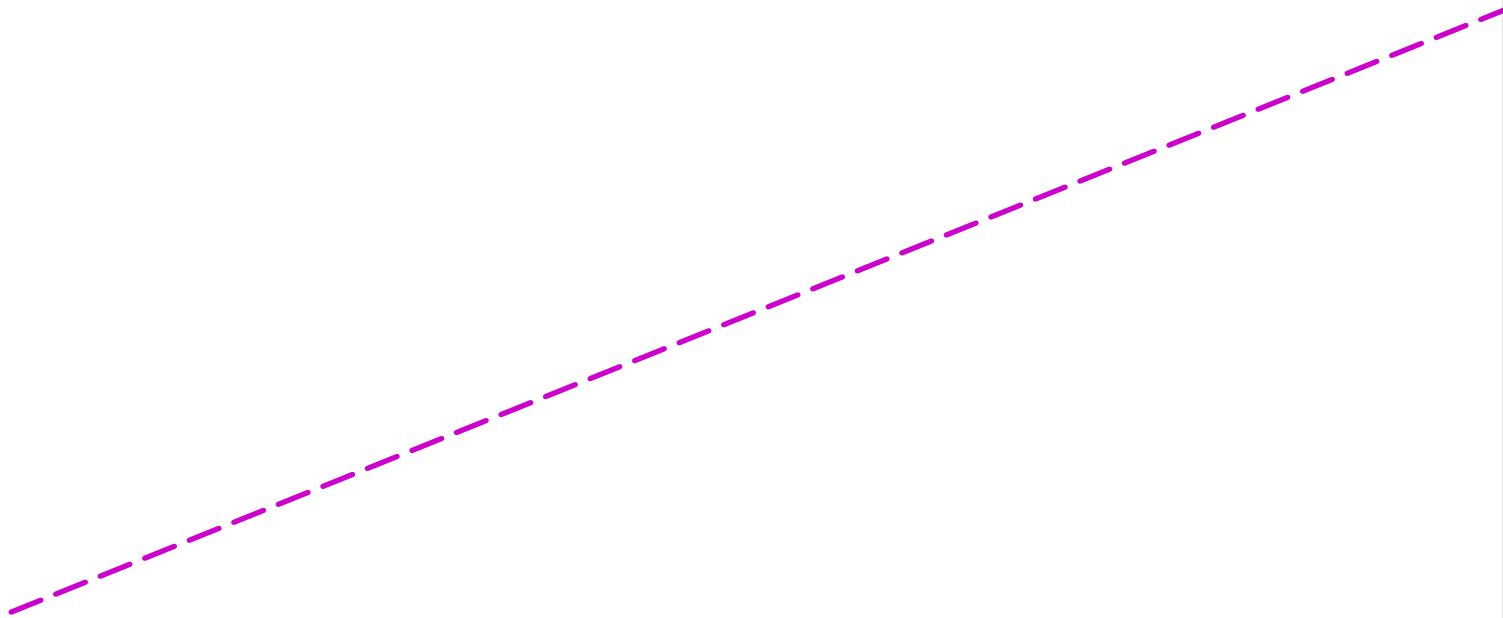

Warning: PDF designed for A4 colour print only with no page scaling

0 20m Dig Sites Area: Line:

**Extra High Voltage
cables in vicinity**



Date Requested: 24/06/2022
 Job Reference: 25881010
 Site Location: 448066 213346
 Requested by: Mr Joe Shawyer
 Your Scheme/Reference: 31188_002

Voltages (V)			
LV (Low Voltage) and Services	Up to 1,000V		
HV (High Voltage)	Over 1,000V to 11,000V		
EHV (Extra High Voltage)	22,000V to 132,000V		
Transmission	275,000V and 400,000V		
NORMAL DEPTH TO THE TOP OF THE CABLE WHEN LAID			
Services	LV	HV	EHV
Footpath/Unmade	0.45m	0.45m	0.6m 0.8m
Road Crossing	0.6m	0.6m	0.75m 0.9m
Agricultural	1m	1m	1m 1.1m

Legend	
	Service Cable
	LV Mains
	2 - 11kV
	66kV
	11kV
	22kV
	33kV
	66kV
	132kV
	275kV
	400kV
	Fibre Optic
	Pipe Cable

Distribution Structures (Electric)	
	Pole, Existing Location
	Pole Structure, Existing Location - Single
	Pole Structure, Existing Location - H
	Duct Route
	Cross Section Route


Southern Electric Power Distribution plc
 Registered Office: No.1 Forbury Place
 43 Forbury Road Reading RG1 3JH
 Registered In England & Wales No.04094290

If you're unsure & need to seek advice before commencing excavations, please contact:
 General Enquiries: 0800 048 3516

Subject to revision – Master held by SSEN Asset Data Team:
Asset.Data@sse.com
 01256 337 294

Scale: 1:500 (When plotted at A4)

WARNING
 There may have been subsequent alteration to the surface levels. Trial holes must be undertaken to determine position and depths of cables. HS (G) 47 Booklet from the Health and Safety Executive – Avoiding Danger from Buried Cables – should be consulted before commencing excavation work.
WHEN WORKING IN THE VICINITY OF OVERHEAD LINES THE HEALTH AND SAFETY GUIDANCE NOTES G56 SHOULD BE CONSULTED (AVAILABLE FROM THE HSE WEBSITE)

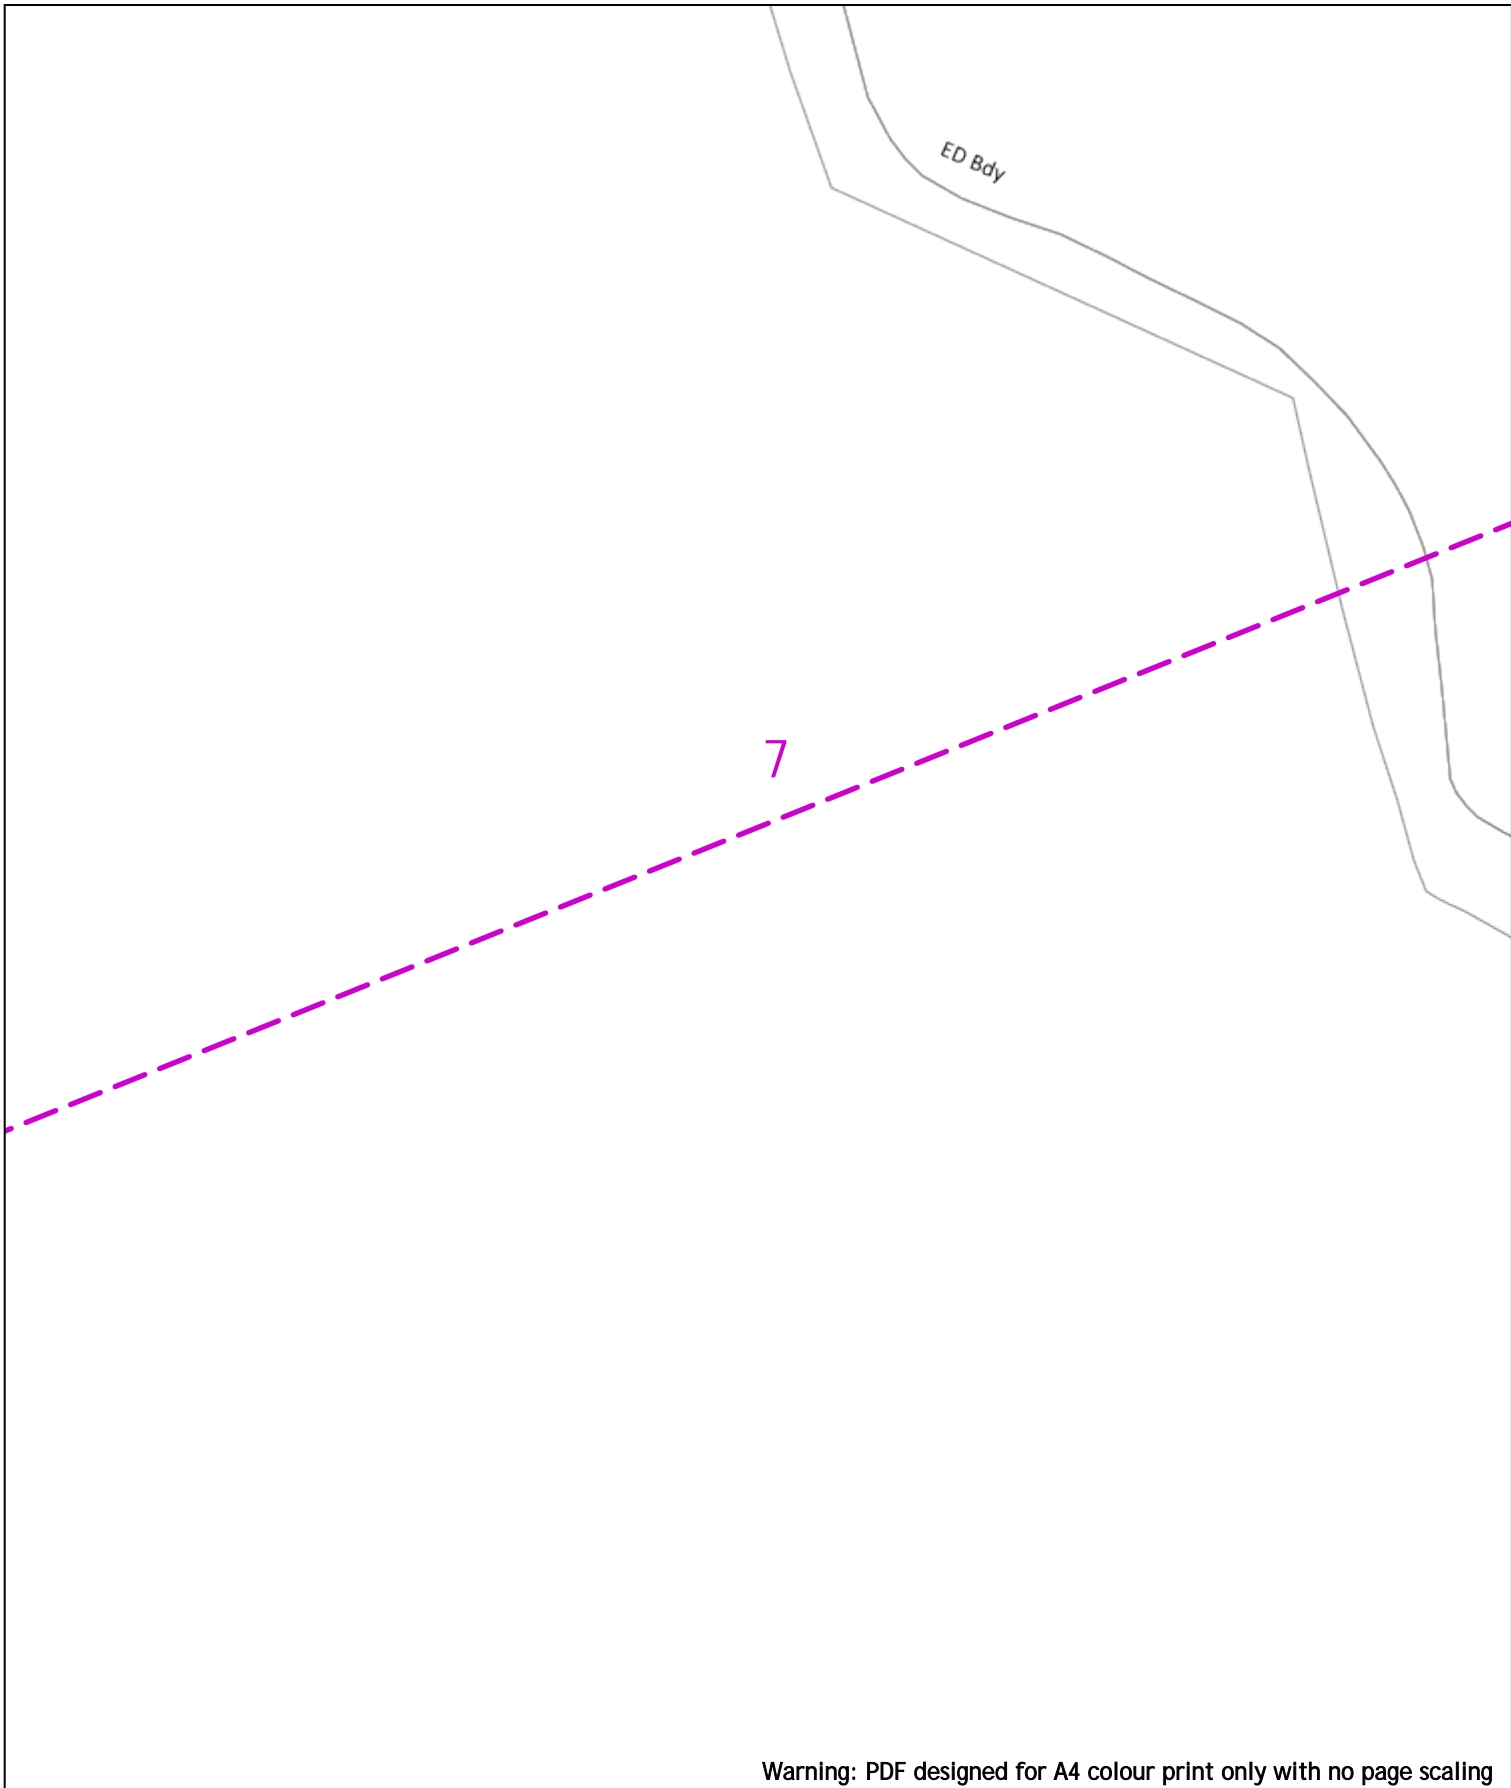

Warning: PDF designed for A4 colour print only with no page scaling

<p>0 20m</p> <p>Date Requested: 24/06/2022 Job Reference: 25881010 Site Location: 448066 213346 Requested by: Mr Joe Shawyer Your Scheme/Reference: 31188_002</p>	<p>Dig Sites Area: Line: </p>	<p>Extra High Voltage cables in vicinity</p>			<p style="text-align: center;">Southern Electric Power Distribution plc Registered Office: No.1 Forbury Place 43 Forbury Road Reading RG1 3JH Registered In England & Wales No.04094290</p> <p style="font-size: small;">If you're unsure & need to seek advice before commencing excavations, please contact: General Enquiries: 0800 048 3516</p> <p style="font-size: x-small;">Subject to revision – Master held by SSEN Asset Data Team: Asset.Data@sse.com 01256 337 294</p>																														
<p>Voltages (V)</p> <table border="1" style="width: 100%; border-collapse: collapse;"> <tr> <td>LV (Low Voltage) and Services</td> <td colspan="3">Up to 1,000V</td> </tr> <tr> <td>HV (High Voltage)</td> <td colspan="3">Over 1,000V to 11,000V</td> </tr> <tr> <td>EHV (Extra High Voltage)</td> <td colspan="3">22,000V to 132,000V</td> </tr> <tr> <td>Transmission</td> <td colspan="3">275,000V and 400,000V</td> </tr> </table> <p>NORMAL DEPTH TO THE TOP OF THE CABLE WHEN LAID</p> <table border="1" style="width: 100%; border-collapse: collapse;"> <thead> <tr> <th>Services</th> <th>LV</th> <th>HV</th> <th>EHV</th> </tr> </thead> <tbody> <tr> <td>Footpath/Unmade</td> <td>0.45m</td> <td>0.45m</td> <td>0.6m</td> </tr> <tr> <td>Road Crossing</td> <td>0.6m</td> <td>0.6m</td> <td>0.75m</td> </tr> <tr> <td>Agricultural</td> <td>1m</td> <td>1m</td> <td>1.1m</td> </tr> </tbody> </table>		LV (Low Voltage) and Services	Up to 1,000V			HV (High Voltage)	Over 1,000V to 11,000V			EHV (Extra High Voltage)	22,000V to 132,000V			Transmission	275,000V and 400,000V			Services	LV	HV	EHV	Footpath/Unmade	0.45m	0.45m	0.6m	Road Crossing	0.6m	0.6m	0.75m	Agricultural	1m	1m	1.1m	<p>Legend</p> <ul style="list-style-type: none"> Service Cable LV Mains 2 – 11kV 66kV 11kV 22kV 33kV 66kV 132kV 275kV 400kV Fibre Optic Pipit Cable <p>Distribution Structures (Electric)</p> <ul style="list-style-type: none"> Pole, Existing Location Pole Structure, Existing Location – Single Pole Structure, Existing Location – H Duct Route Cross Section Route 	<p style="text-align: center;">WARNING</p> <p style="text-align: center; color: red;">There may have been subsequent alteration to the surface levels. Trial holes must be undertaken to determine position and depths of cables. HS (G) 47 Booklet from the Health and Safety Executive – Avoiding Danger from Buried Cables – should be consulted before commencing excavation work.</p> <p style="text-align: center; color: red;">WHEN WORKING IN THE VICINITY OF OVERHEAD LINES THE HEALTH AND SAFETY GUIDANCE NOTES G56 SHOULD BE CONSULTED (AVAILABLE FROM THE HSE WEBSITE)</p>
LV (Low Voltage) and Services	Up to 1,000V																																		
HV (High Voltage)	Over 1,000V to 11,000V																																		
EHV (Extra High Voltage)	22,000V to 132,000V																																		
Transmission	275,000V and 400,000V																																		
Services	LV	HV	EHV																																
Footpath/Unmade	0.45m	0.45m	0.6m																																
Road Crossing	0.6m	0.6m	0.75m																																
Agricultural	1m	1m	1.1m																																
<p>BASED UPON THE ORDNANCE SURVEY MAP WITH THE SANCTION OF THE CONTROLLER OF HM STATIONERY OFFICE CROWN COPYRIGHT RESERVED. This copy has been made by or with the authority of Scottish and Southern Energy Power Distribution Ltd. Pursuant to section 47 of the Copyright, Designs and Patents Act 1988 ("The Act"). Unless the Act provides a relevant exception to copyright the copy must not be copied without prior permission of the copyright owner. Plans generated by DigSAFE Pro™ software provided by LinesearchbeforeDigs.</p>																																			



Warning: PDF designed for A4 colour print only with no page scaling

20m Dig Sites Area: Line: Extra High Voltage cables in vicinity

Date Requested: 24/06/2022
 Job Reference: 25881010
 Site Location: 448066 213346
 Requested by: Mr Joe Shawyer
 Your Scheme/Reference: 31188_002

Voltages (V)				
LV (Low Voltage) and Services	Up to 1,000V			
HV (High Voltage)	Over 1,000V to 11,000V			
EHV (Extra High Voltage)	22,000V to 132,000V			
Transmission	275,000V and 400,000V			
NORMAL DEPTH TO THE TOP OF THE CABLE WHEN LAID				
Services	LV	HV	EHV	
Footpath/Unmade	0.45m	0.45m	0.6m	0.8m
Road Crossing	0.6m	0.6m	0.75m	0.9m
Agricultural	1m	1m	1m	1.1m

Legend		Distribution Structures (Electric)	
	Service Cable	●	Pole, Existing Location
	2 - 11kV	○	Pole Structure, Existing Location - Single
	11kV	○	Pole Structure, Existing Location - H
	22kV		Duct Route
	33kV		Cross Section Route
	66kV		
	132kV		
	275kV		
	400kV		
	Fibre Optic		
	Pipe Cable		


WARNING
 There may have been subsequent alteration to the surface levels. Trial holes must be undertaken to determine position and depths of cables. HS (G) 47 Booklet from the Health and Safety Executive - Avoiding Danger from Buried Cables - should be consulted before commencing excavation work.
WHEN WORKING IN THE VICINITY OF OVERHEAD LINES THE HEALTH AND SAFETY GUIDANCE NOTES G56 SHOULD BE CONSULTED (AVAILABLE FROM THE HSE WEBSITE)

Southern Electric Power Distribution plc
 Registered Office: No.1 Forbury Place
 43 Forbury Road Reading RG1 3JH
 Registered In England & Wales No.04094290

If you're unsure & need to seek advice before commencing excavations, please contact:
 General Enquiries: 0800 048 3516


Subject to revision - Master held by SSEN Asset Data Team:
Asset.Data@sse.com
 01256 337 294

BASED UPON THE ORDNANCE SURVEY MAP WITH THE SANCTION OF THE CONTROLLER OF HM STATIONERY OFFICE CROWN COPYRIGHT RESERVED.
 This copy has been made by or with the authority of Scottish and Southern Energy Power Distribution Ltd. Pursuant to section 47 of the Copyright, Designs and Patents Act 1988 ("The Act"). Unless the Act provides a relevant exception to copyright the copy must not be copied without prior permission of the copyright owner.
 Plans generated by DigSAFE Pro™ software provided by LinesearchbeforeUdig.

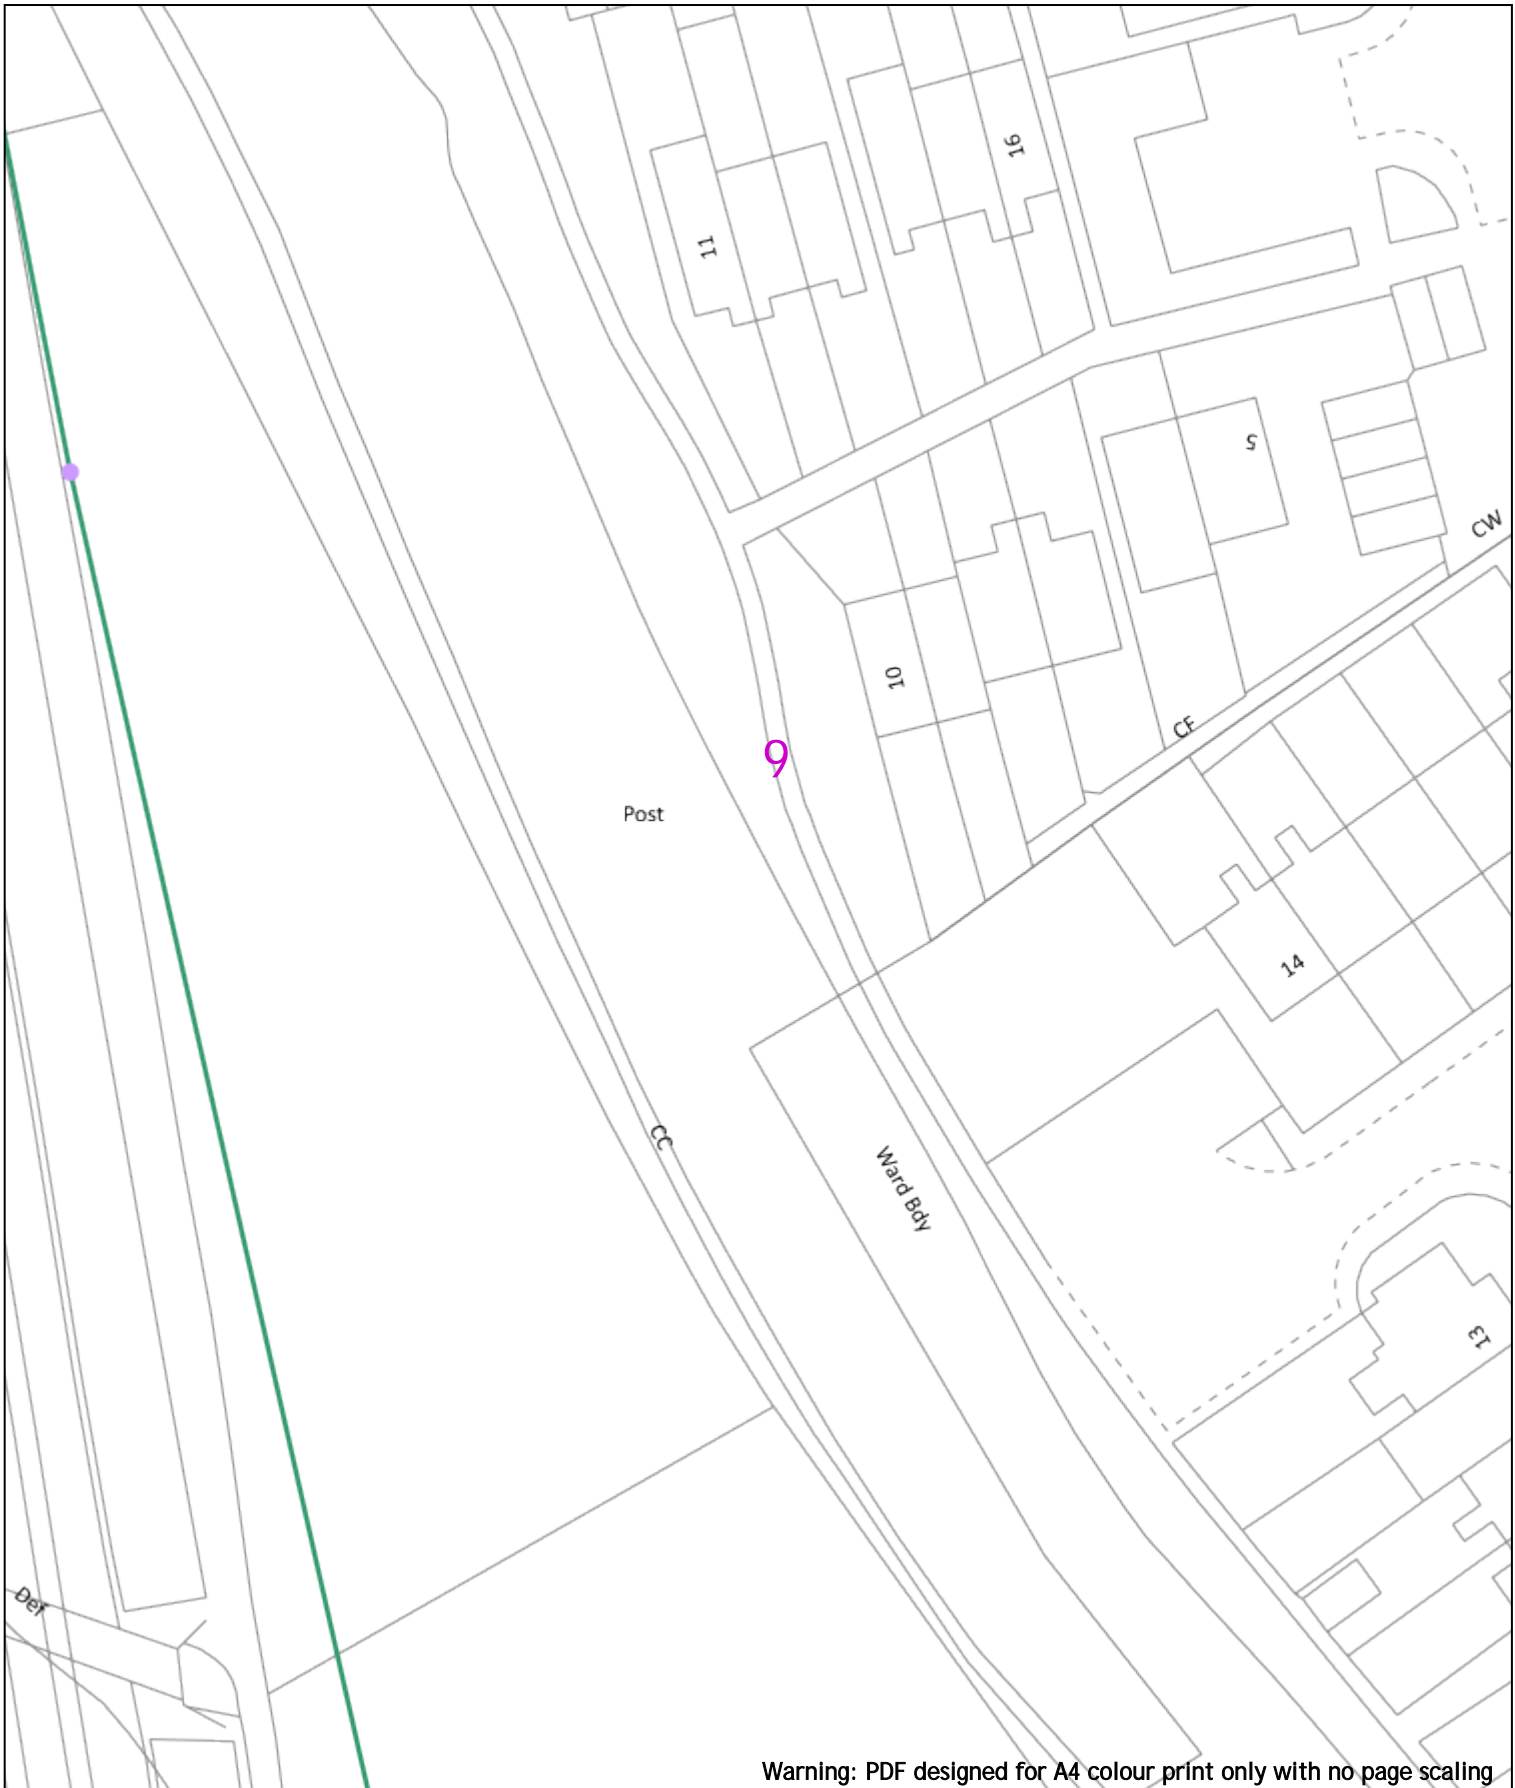

Warning: PDF designed for A4 colour print only with no page scaling


<p>0 20m</p> <p>Date Requested: 24/06/2022 Job Reference: 25881010 Site Location: 448066 213346 Requested by: Mr Joe Shawyer Your Scheme/Reference: 31188_002</p>	<p>Dig Sites Area: Line: </p> <p style="background-color: red; color: white; text-align: center; padding: 2px;">Extra High Voltage cables in vicinity</p>	<p></p> <p></p> <p style="text-align: center;">Southern Electric Power Distribution plc Registered Office: No.1 Forbury Place 43 Forbury Road Reading RG1 3JH Registered In England & Wales No.04094290</p> <p style="font-size: small;">If you're unsure & need to seek advice before commencing excavations, please contact: General Enquiries: 0800 048 3516</p> <p style="font-size: small;">Subject to revision – Master held by SSEN Asset Data Team: Asset.Data@sse.com 01256 337 294</p>	
<p>Voltagess (V)</p> <table border="1" style="width: 100%; border-collapse: collapse; font-size: x-small;"> <tr> <td>LV (Low Voltage) and Services</td> <td>Up to 1,000V</td> </tr> <tr> <td>HV (High Voltage)</td> <td>Over 1,000V to 11,000V</td> </tr> <tr> <td>EHV (Extra High Voltage)</td> <td>22,000V to 132,000V</td> </tr> <tr> <td>Transmission</td> <td>275,000V and 400,000V</td> </tr> </table> <p>NORMAL DEPTH TO THE TOP OF THE CABLE WHEN LAID</p> <table border="1" style="width: 100%; border-collapse: collapse; font-size: x-small;"> <tr> <td>Services</td> <td>LV</td> <td>HV</td> <td>EHV</td> </tr> <tr> <td>Footpath/Unmade</td> <td>0.45m</td> <td>0.45m</td> <td>0.6m</td> </tr> <tr> <td>Road Crossing</td> <td>0.6m</td> <td>0.6m</td> <td>0.75m</td> </tr> <tr> <td>Agricultural</td> <td>1m</td> <td>1m</td> <td>1.1m</td> </tr> </table>	LV (Low Voltage) and Services	Up to 1,000V	HV (High Voltage)	Over 1,000V to 11,000V	EHV (Extra High Voltage)	22,000V to 132,000V	Transmission	275,000V and 400,000V	Services	LV	HV	EHV	Footpath/Unmade	0.45m	0.45m	0.6m	Road Crossing	0.6m	0.6m	0.75m	Agricultural	1m	1m	1.1m	<p>Legend</p> <table border="0" style="width: 100%; font-size: x-small;"> <tr> <td> Service Cable</td> <td> Pole, Existing Location</td> </tr> <tr> <td> LV Mains</td> <td> Pole Structure, Existing Location - Single</td> </tr> <tr> <td> 6.6kV</td> <td> Pole Structure, Existing Location - H</td> </tr> <tr> <td> 11kV</td> <td> Duct Route</td> </tr> <tr> <td> 22kV</td> <td> Cross Section Route</td> </tr> <tr> <td> 33kV</td> <td></td> </tr> <tr> <td> 66kV</td> <td></td> </tr> <tr> <td> 132kV</td> <td></td> </tr> <tr> <td> 275kV</td> <td></td> </tr> <tr> <td> 400kV</td> <td></td> </tr> <tr> <td> Fibre Optic</td> <td></td> </tr> <tr> <td> Pilot Cable</td> <td></td> </tr> </table> <p style="font-size: x-small; text-align: center;">WARNING There may have been subsequent alteration to the surface levels. Trial holes must be undertaken to determine position and depths of cables. HS (G) 47 Booklet from the Health and Safety Executive – Avoiding Danger from Buried Cables – should be consulted before commencing excavation work. WHEN WORKING IN THE VICINITY OF OVERHEAD LINES THE HEALTH AND SAFETY GUIDANCE NOTES G56 SHOULD BE CONSULTED (AVAILABLE FROM THE HSE WEBSITE)</p>	Service Cable	Pole, Existing Location	LV Mains	Pole Structure, Existing Location - Single	6.6kV	Pole Structure, Existing Location - H	11kV	Duct Route	22kV	Cross Section Route	33kV		66kV		132kV		275kV		400kV		Fibre Optic		Pilot Cable	
LV (Low Voltage) and Services	Up to 1,000V	
HV (High Voltage)	Over 1,000V to 11,000V	
EHV (Extra High Voltage)	22,000V to 132,000V	
Transmission	275,000V and 400,000V	
Services	LV	HV	EHV	
Footpath/Unmade	0.45m	0.45m	0.6m	
Road Crossing	0.6m	0.6m	0.75m	
Agricultural	1m	1m	1.1m	
Service Cable	Pole, Existing Location	
LV Mains	Pole Structure, Existing Location - Single	
6.6kV	Pole Structure, Existing Location - H	
11kV	Duct Route	
22kV	Cross Section Route	
33kV	
66kV	
132kV	
275kV	
400kV	
Fibre Optic	
Pilot Cable	

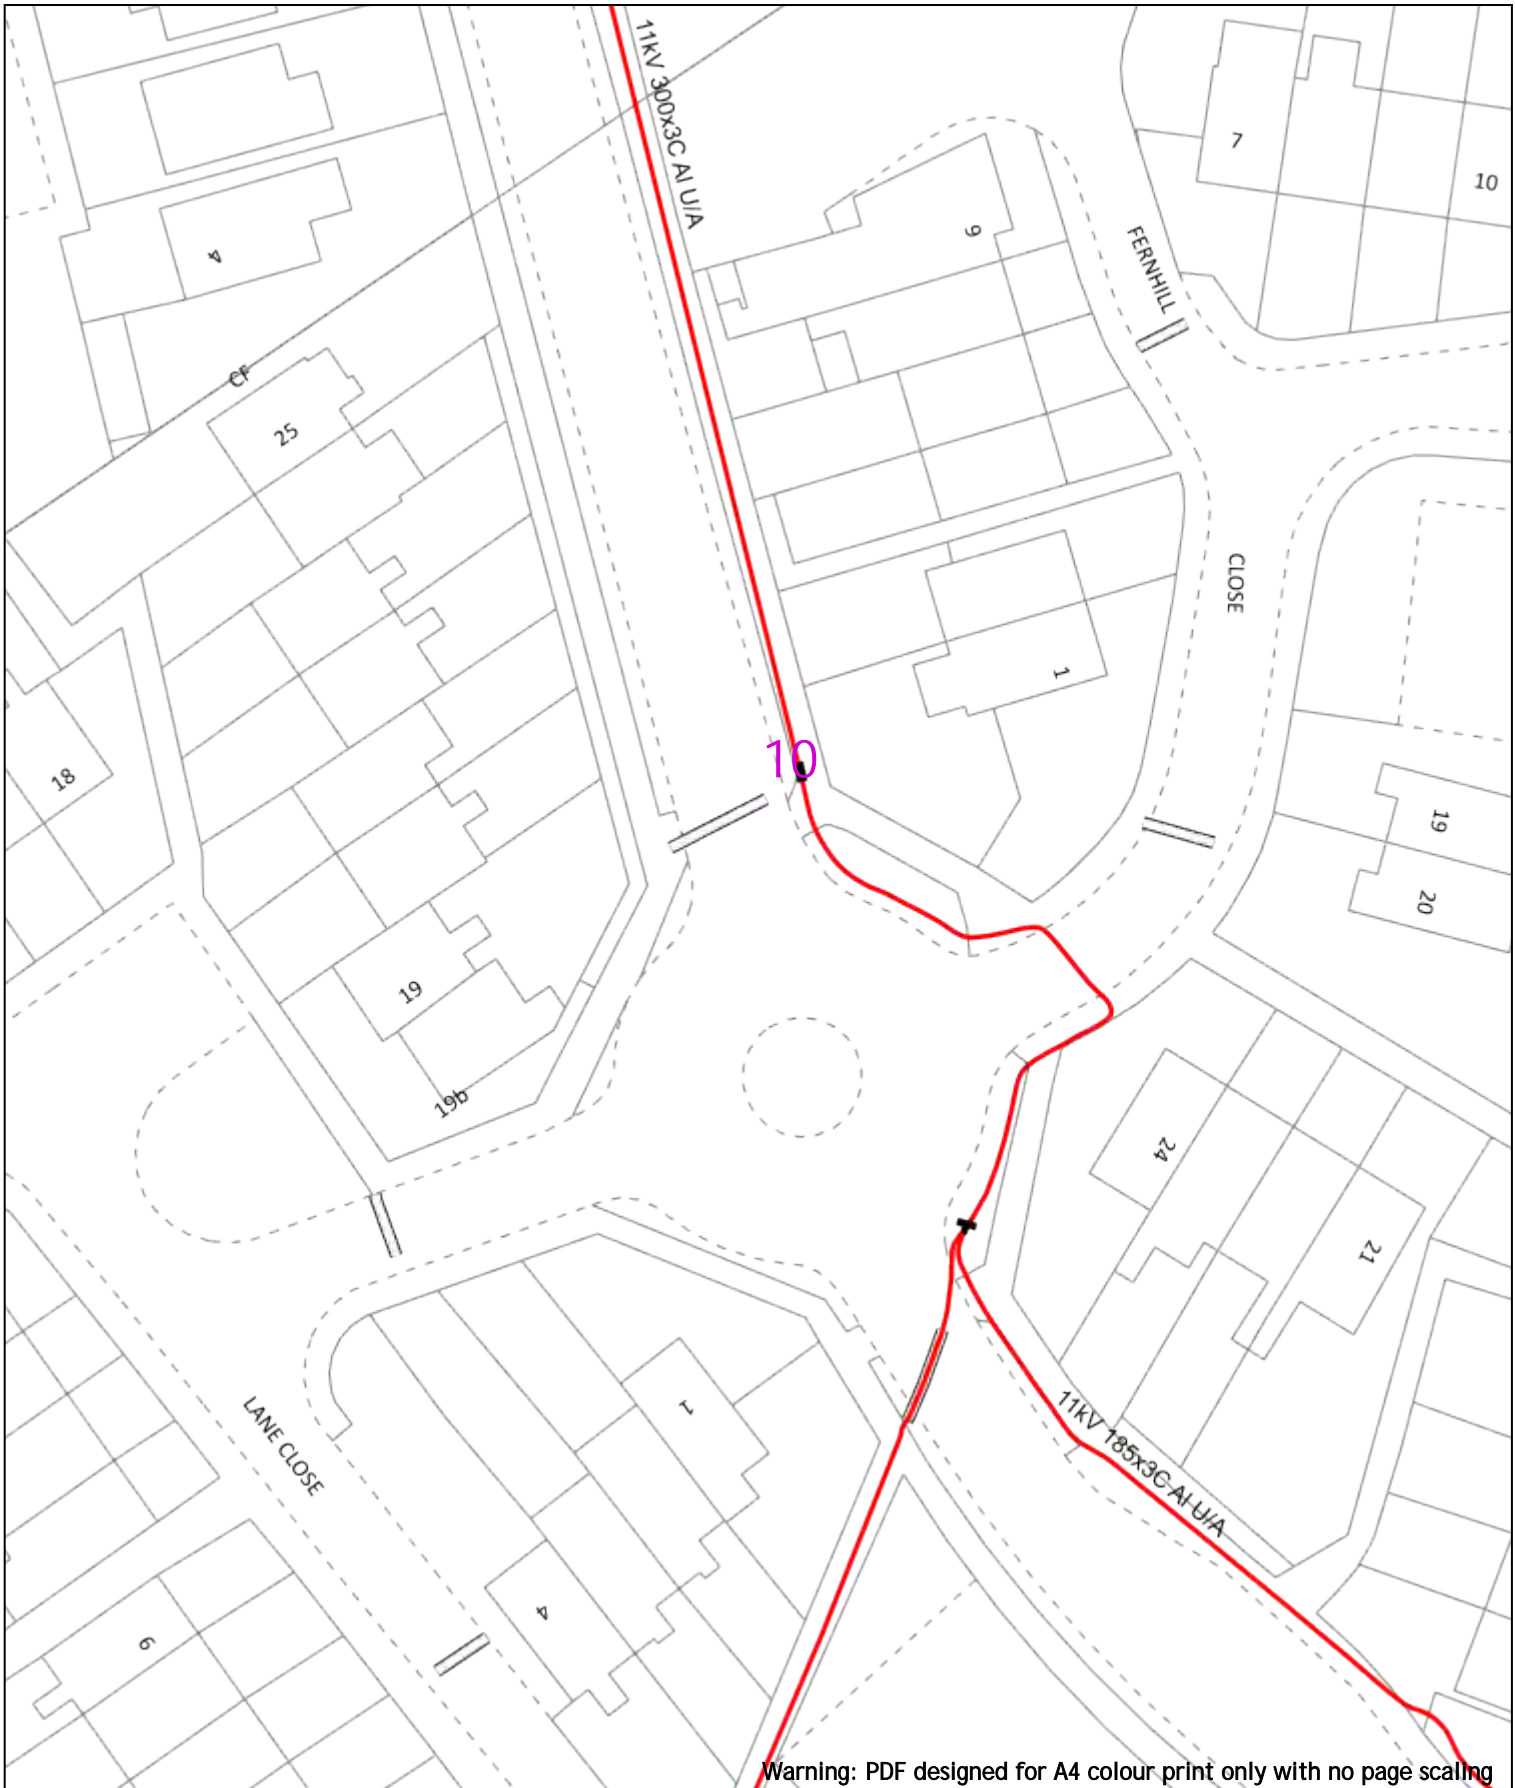

Warning: PDF designed for A4 colour print only with no page scaling

<p>0 20m Dig Sites Area: Line: Extra High Voltage cables in vicinity</p>																										
<p>Date Requested: 24/06/2022 Job Reference: 25881010 Site Location: 448066 213346 Requested by: Mr Joe Shawyer Your Scheme/Reference: 31188_002</p>	<p>Voltages (V)</p> <table border="1"> <tr> <td>LV (Low Voltage) and Services</td> <td>Up to 1,000V</td> </tr> <tr> <td>HV (High Voltage)</td> <td>Over 1,000V to 11,000V</td> </tr> <tr> <td>EHV (Extra High Voltage)</td> <td>22,000V to 132,000V</td> </tr> <tr> <td>Transmission</td> <td>275,000V and 400,000V</td> </tr> </table> <p>NORMAL DEPTH TO THE TOP OF THE CABLE WHEN LAID</p> <table border="1"> <thead> <tr> <th>Services</th> <th>LV</th> <th>HV</th> <th>EHV</th> </tr> </thead> <tbody> <tr> <td>Footpath/Unmade</td> <td>0.45m</td> <td>0.45m</td> <td>0.6m</td> </tr> <tr> <td>Road Crossing</td> <td>0.6m</td> <td>0.6m</td> <td>0.75m</td> </tr> <tr> <td>Agricultural</td> <td>1m</td> <td>1m</td> <td>1.1m</td> </tr> </tbody> </table>			LV (Low Voltage) and Services	Up to 1,000V	HV (High Voltage)	Over 1,000V to 11,000V	EHV (Extra High Voltage)	22,000V to 132,000V	Transmission	275,000V and 400,000V	Services	LV	HV	EHV	Footpath/Unmade	0.45m	0.45m	0.6m	Road Crossing	0.6m	0.6m	0.75m	Agricultural	1m	1m
LV (Low Voltage) and Services	Up to 1,000V																									
HV (High Voltage)	Over 1,000V to 11,000V																									
EHV (Extra High Voltage)	22,000V to 132,000V																									
Transmission	275,000V and 400,000V																									
Services	LV	HV	EHV																							
Footpath/Unmade	0.45m	0.45m	0.6m																							
Road Crossing	0.6m	0.6m	0.75m																							
Agricultural	1m	1m	1.1m																							
<p>Scale: 1:500 (When plotted at A4)</p>		<p>Southern Electric Power Distribution plc Registered Office: No.1 Forbury Place 43 Forbury Road Reading RG1 3JH Registered In England & Wales No.04094290</p> <p>If you're unsure & need to seek advice before commencing excavations, please contact: General Enquiries: 0800 048 3516</p> <p>Subject to revision – Master held by SSEN Asset Data Team: Asset.Data@sse.com 01256 337 294</p>																								

There may have been subsequent alteration to the surface levels. Trial holes must be undertaken to determine position and depths of cables. HS (G) 47 Booklet from the Health and Safety Executive – Avoiding Danger from Buried Cables – should be consulted before commencing excavation work.
WHEN WORKING IN THE VICINITY OF OVERHEAD LINES THE HEALTH AND SAFETY GUIDANCE NOTES G56 SHOULD BE CONSULTED (AVAILABLE FROM THE HSE WEBSITE)

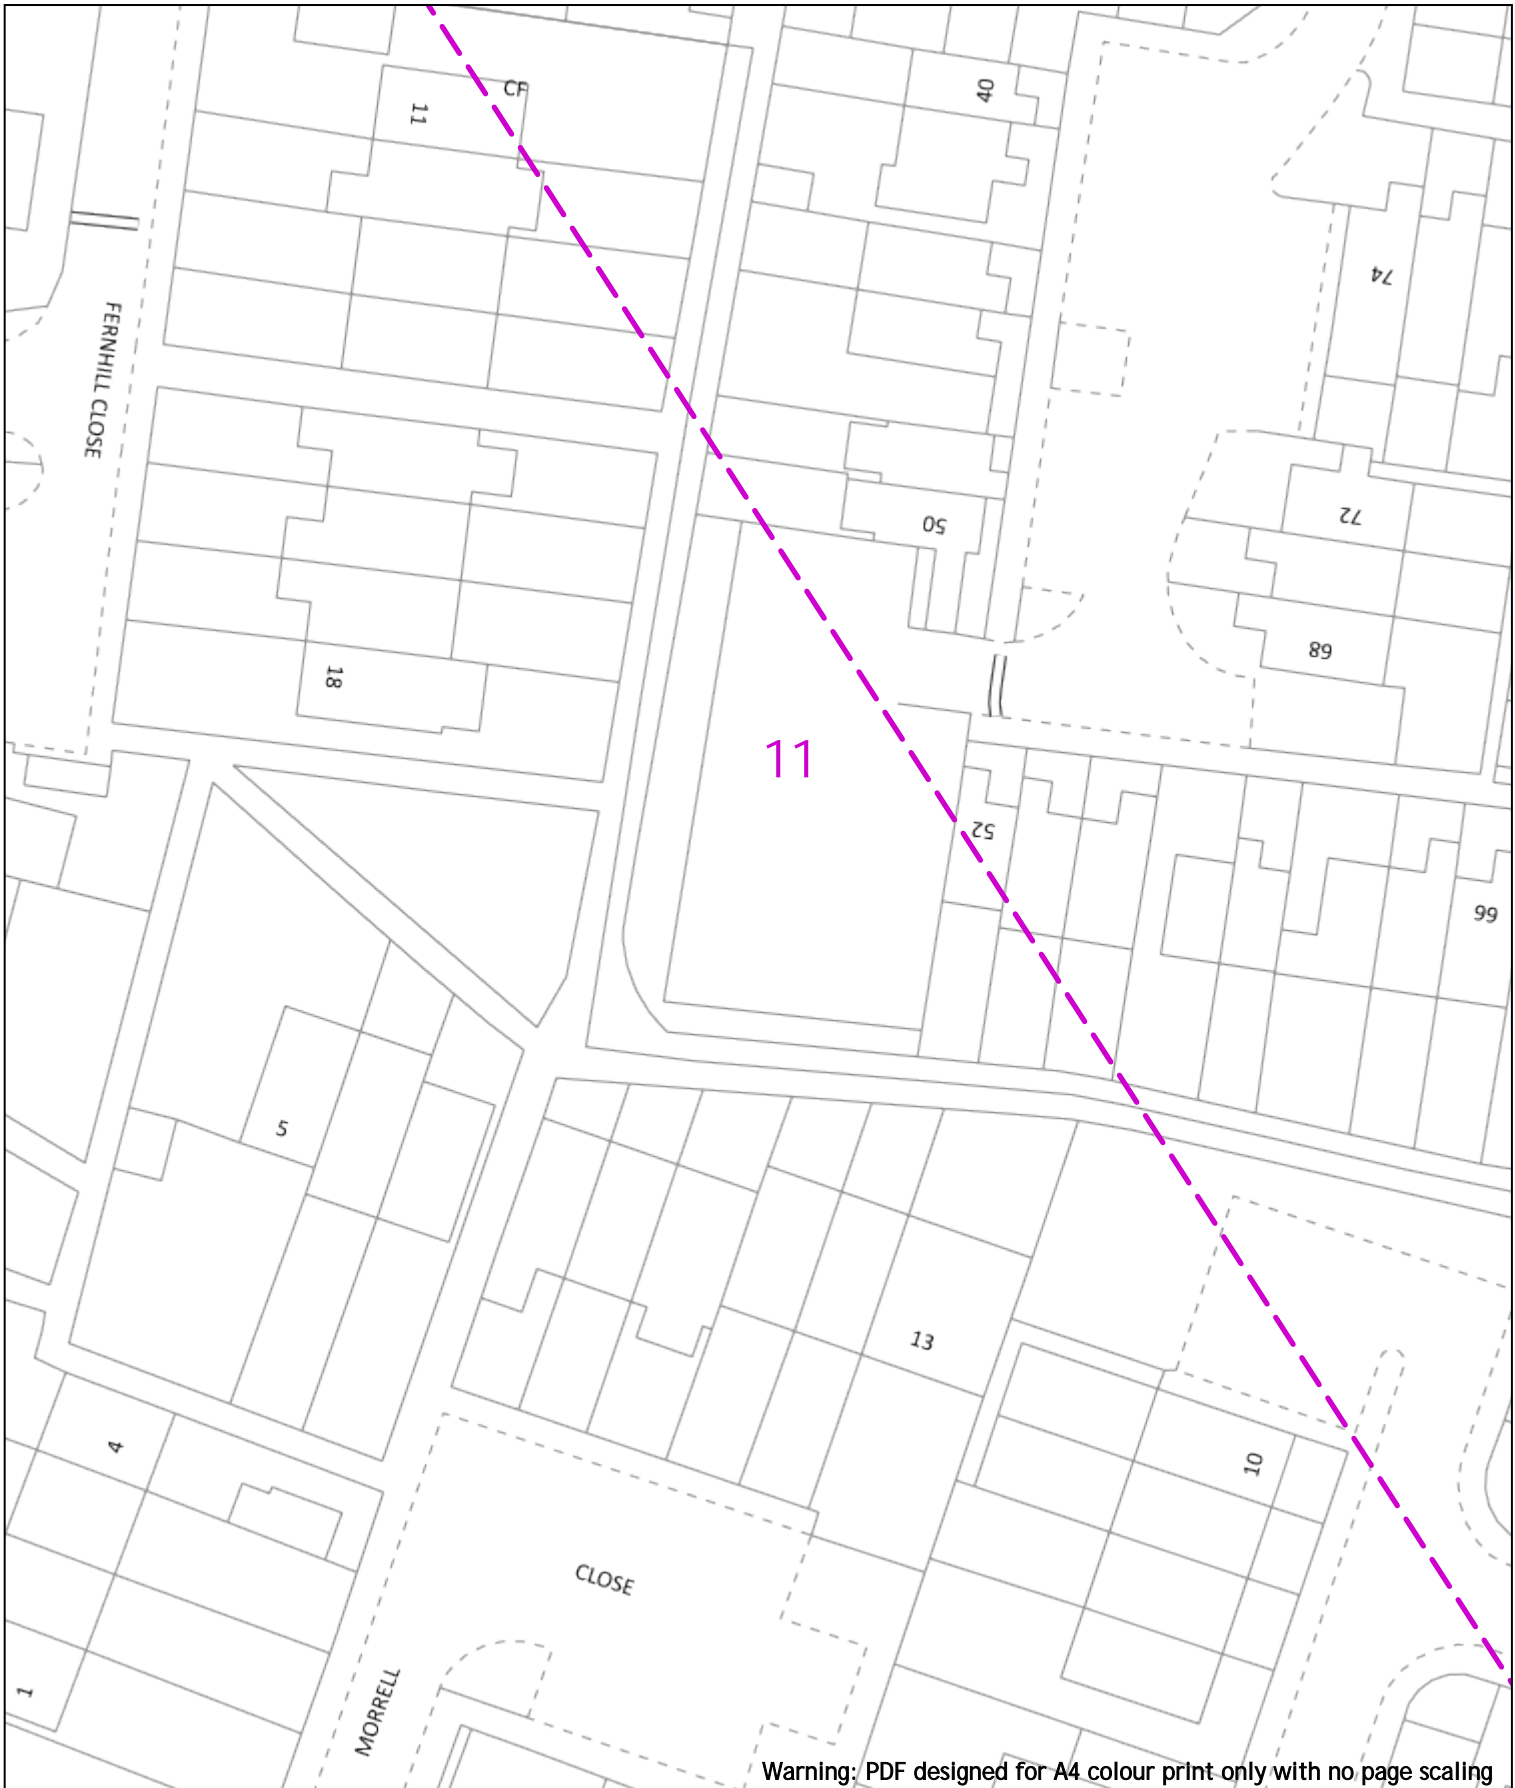

Warning: PDF designed for A4 colour print only with no page scaling

0 20m Dig Sites Area: Line: **Extra High Voltage cables in vicinity**

Date Requested: 24/06/2022
 Job Reference: 25881010
 Site Location: 448066 213346
 Requested by: Mr Joe Shawyer
 Your Scheme/Reference: 31188_002

Voltages (V)			
LV (Low Voltage) and Services	Up to 1,000V		
HV (High Voltage)	Over 1,000V to 11,000V		
EHV (Extra High Voltage)	22,000V to 132,000V		
Transmission	275,000V and 400,000V		

NORMAL DEPTH TO THE TOP OF THE CABLE WHEN LAID			
Services	LV	HV	EHV
Footpath/Unmade	0.45m	0.45m	0.6m
Road Crossing	0.6m	0.6m	0.9m
Agricultural	1m	1m	1.1m


Legend	
	Service Cable
	LV Mains
	6.6kV
	11kV
	22kV
	33kV
	66kV
	132kV
	275kV
	400kV
	Fibre Optic
	Pipe Cable

Distribution Structures (Electric)	
	Pole, Existing Location
	Pole Structure, Existing Location - Single
	Pole Structure, Existing Location - H
	Duct Route
	Cross Section Route

Southern Electric Power Distribution plc
 Registered Office: No.1 Forbury Place
 43 Forbury Road Reading RG1 3JH
 Registered In England & Wales No.04094290

If you're unsure & need to seek advice before commencing excavations, please contact:
 General Enquiries: 0800 048 3516

Subject to revision – Master held by SSEN Asset Data Team:
Asset.Data@sse.com
 01256 337 294

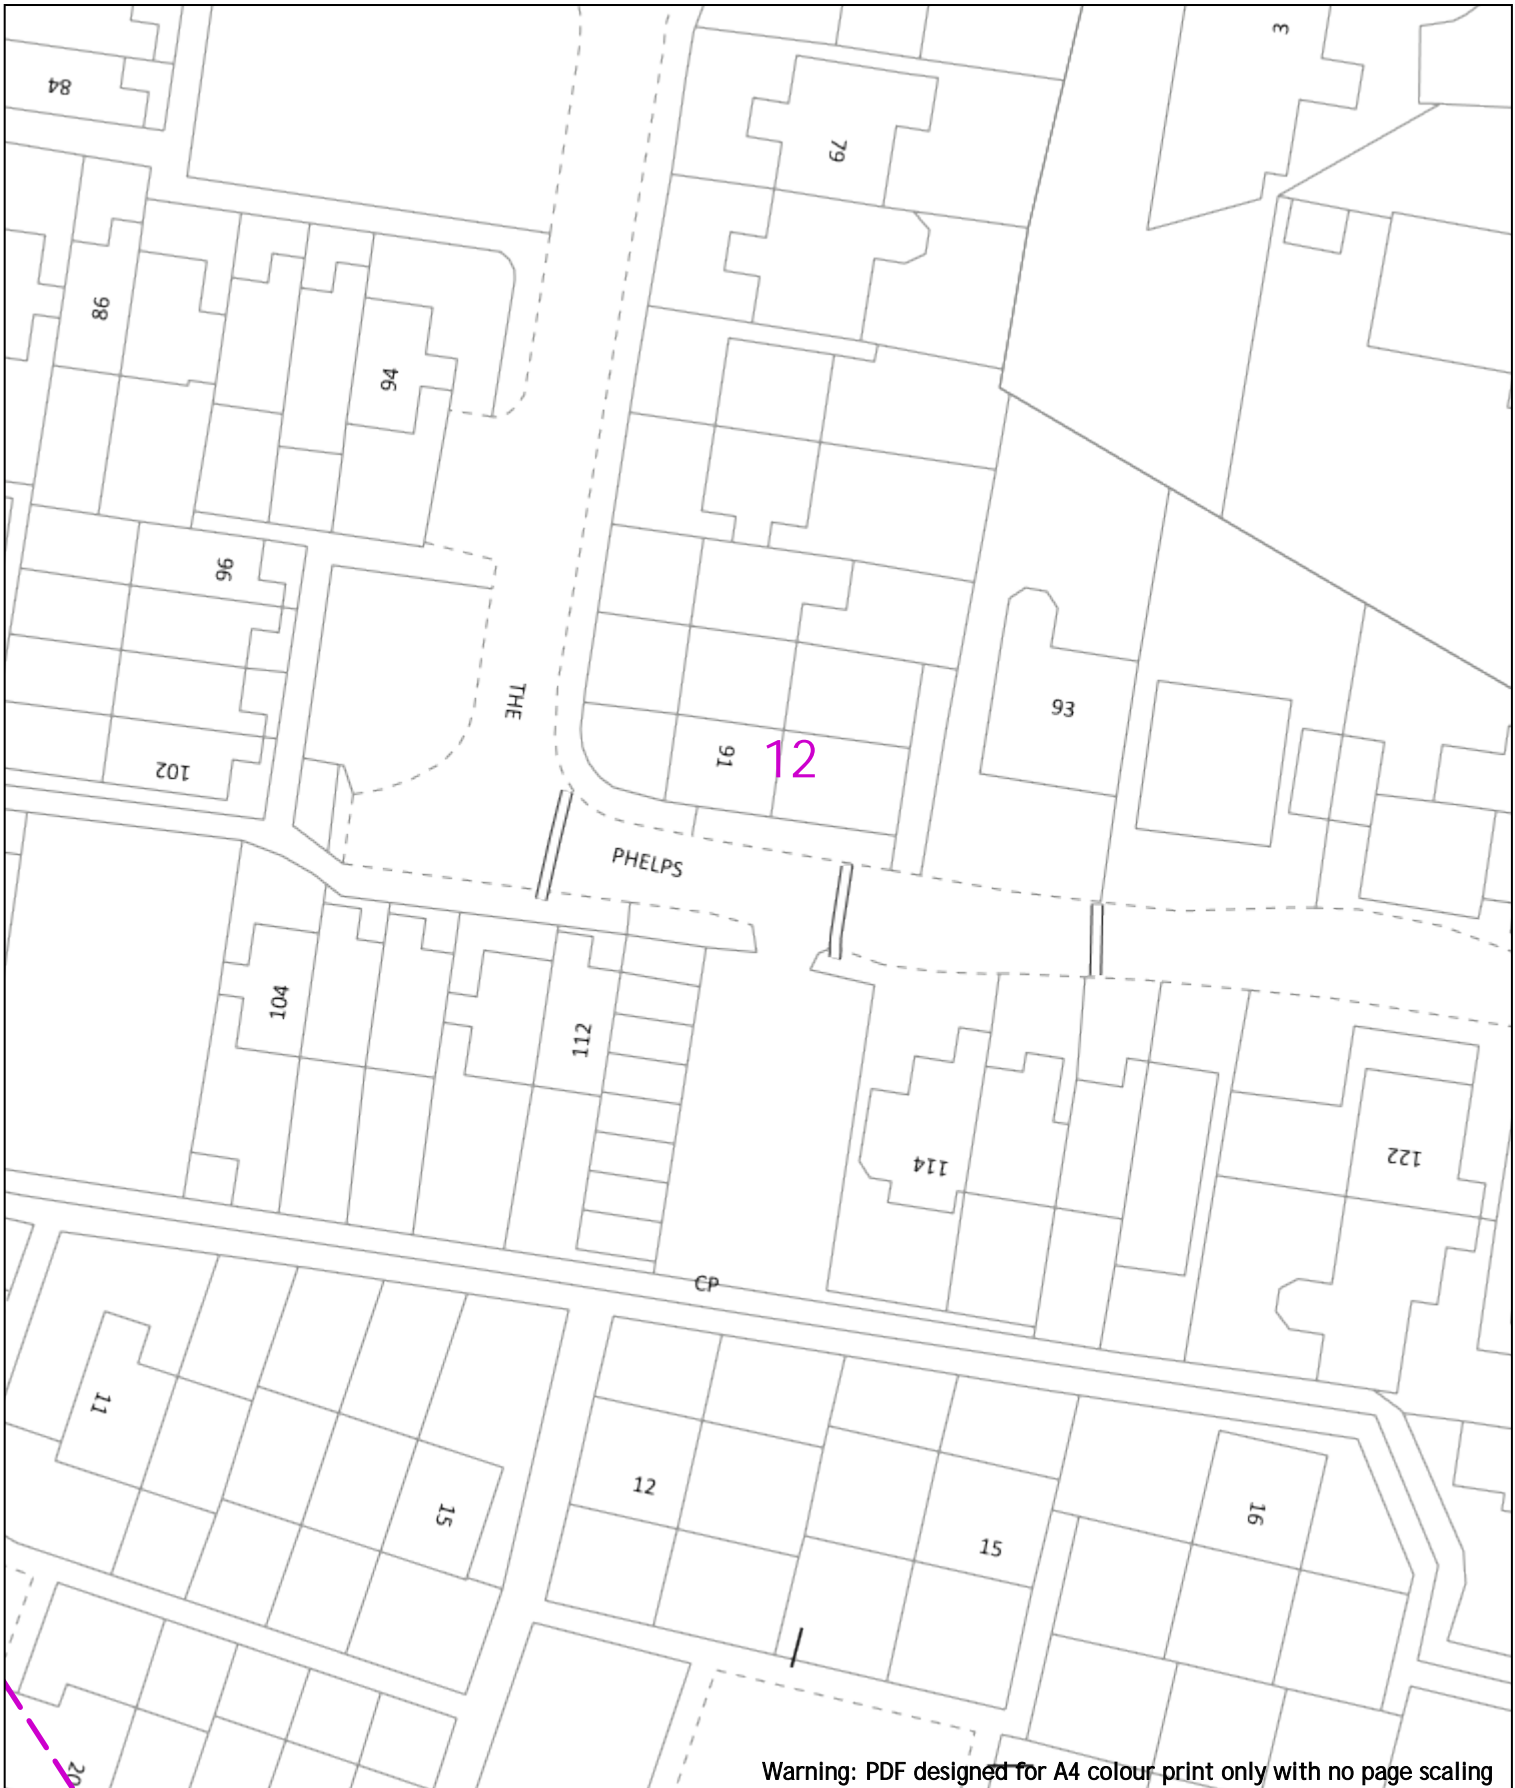

0 20m Dig Sites Area: Line: **Extra High Voltage cables in vicinity**

Date Requested: 24/06/2022
 Job Reference: 25881010
 Site Location: 448066 213346
 Requested by: Mr Joe Shawyer
 Your Scheme/Reference: 31188_002

Voltages (V)			
LV (Low Voltage) and Services	Up to 1,000V		
HV (High Voltage)	Over 1,000V to 11,000V		
EHV (Extra High Voltage)	22,000V to 132,000V		
Transmission	275,000V and 400,000V		

NORMAL DEPTH TO THE TOP OF THE CABLE WHEN LAID			
Services	LV	HV	EHV
Footpath/Unmade	0.45m	0.45m	0.6m
Road Crossing	0.6m	0.6m	0.75m
Agricultural	1m	1m	1.1m

Legend		Distribution Structures (Electric)	
	Service Cable		Pole, Existing Location
	LV Mains		Pole Structure, Existing Location - Single
	6kV		Pole Structure, Existing Location - H
	11kV		Duct Route
	22kV		Cross Section Route
	33kV		
	66kV		
	132kV		
	275kV		
	400kV		
	Fibre Optic		
	Pipe Cable		

WARNING
 There may have been subsequent alteration to the surface levels. Trial holes must be undertaken to determine position and depths of cables. HS (G) 47 Booklet from the Health and Safety Executive - Avoiding Danger from Buried Cables - should be consulted before commencing excavation work.
WHEN WORKING IN THE VICINITY OF OVERHEAD LINES THE HEALTH AND SAFETY GUIDANCE NOTES G56 SHOULD BE CONSULTED (AVAILABLE FROM THE HSE WEBSITE)


Scale: 1:500 (When plotted at A4)

Southern Electric Power Distribution plc
 Registered Office: No.1 Forbury Place
 43 Forbury Road Reading RG1 3JH
 Registered In England & Wales No.04094290

If you're unsure & need to seek advice before commencing excavations, please contact:
 General Enquiries: 0800 048 3516

Subject to revision - Master held by SSEN Asset Data Team:
Asset.Data@sse.com
 01256 337 294

BASED UPON THE ORDNANCE SURVEY MAP WITH THE SANCTION OF THE CONTROLLER OF HM STATIONERY OFFICE CROWN COPYRIGHT RESERVED.
 This copy has been made by or with the authority of Scottish and Southern Energy Power Distribution Ltd. Pursuant to section 47 of the Copyright, Designs and Patents Act 1988 ('The Act'). Unless the Act provides a relevant exception to copyright the copy must not be copied without prior permission of the copyright owner.
 Plans generated by DigSAFE Pro™ software provided by LinesearchbeforeyouDig.

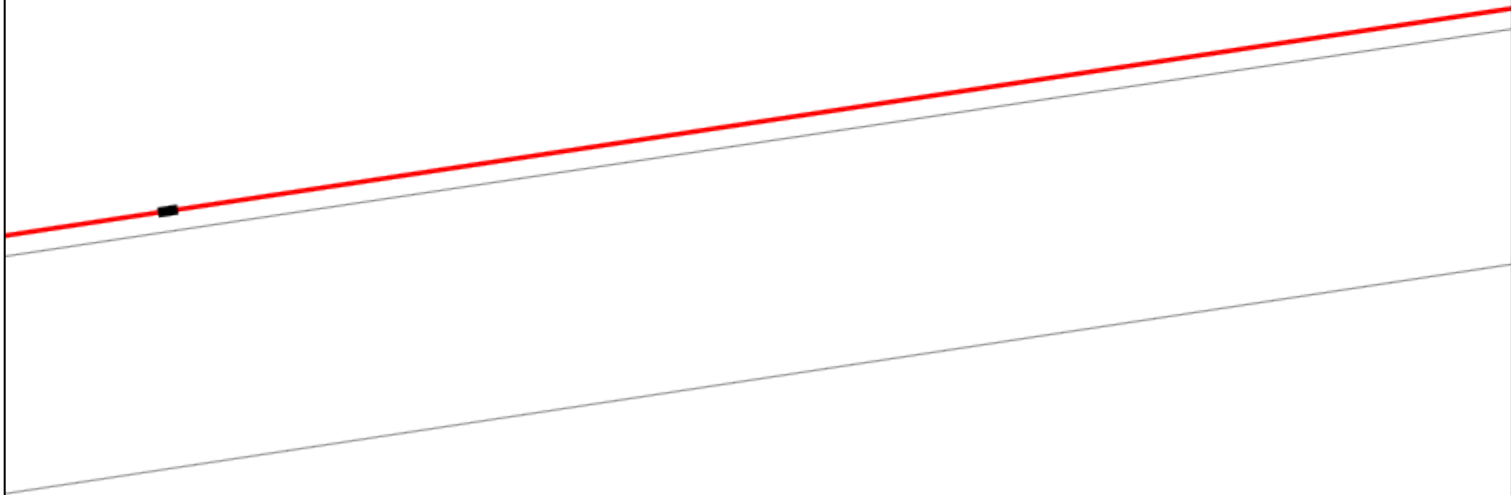

Warning: PDF designed for A4 colour print only with no page scaling



20m Dig Sites Area: Line:

Extra High Voltage cables in vicinity



Date Requested: 24/06/2022
 Job Reference: 25881010
 Site Location: 448066 213346
 Requested by: Mr Joe Shawyer
 Your Scheme/Reference: 31188_002

Voltages (V)			
LV (Low Voltage) and Services	Up to 1,000V		
HV (High Voltage)	Over 1,000V to 11,000V		
EHV (Extra High Voltage)	22,000V to 132,000V		
Transmission	275,000V and 400,000V		
NORMAL DEPTH TO THE TOP OF THE CABLE WHEN LAID			
Services	LV	HV	EHV
Footpath/Unmade	0.45m	0.45m	0.6m 0.8m
Road Crossing	0.6m	0.6m	0.75m 0.9m
Agricultural	1m	1m	1m 1.1m

Legend	
	Service Cable
	LV Mains
	2 - 11kV
	66kV
	11kV
	22kV
	33kV
	66kV
	132kV
	275kV
	400kV
	Fibre Optic
	Pipe Cable

Distribution Structures (Electric)	
	Pole, Existing Location
	Pole Structure, Existing Location - Single
	Pole Structure, Existing Location - H
	Duct Route
	Cross Section Route


Southern Electric Power Distribution plc
 Registered Office: No.1 Forbury Place
 43 Forbury Road Reading RG1 3JH
 Registered In England & Wales No.04094290

If you're unsure & need to seek advice before commencing excavations, please contact:
 General Enquiries: 0800 048 3516

Subject to revision – Master held by SSEN Asset Data Team:
Asset.Data@sse.com
 01256 337 294

Scale: 1:500 (When plotted at A4)

WARNING
 There may have been subsequent alteration to the surface levels. Trial holes must be undertaken to determine position and depths of cables. HS (G) 47 Booklet from the Health and Safety Executive – Avoiding Danger from Buried Cables – should be consulted before commencing excavation work.
WHEN WORKING IN THE VICINITY OF OVERHEAD LINES THE HEALTH AND SAFETY GUIDANCE NOTES G56 SHOULD BE CONSULTED (AVAILABLE FROM THE HSE WEBSITE)

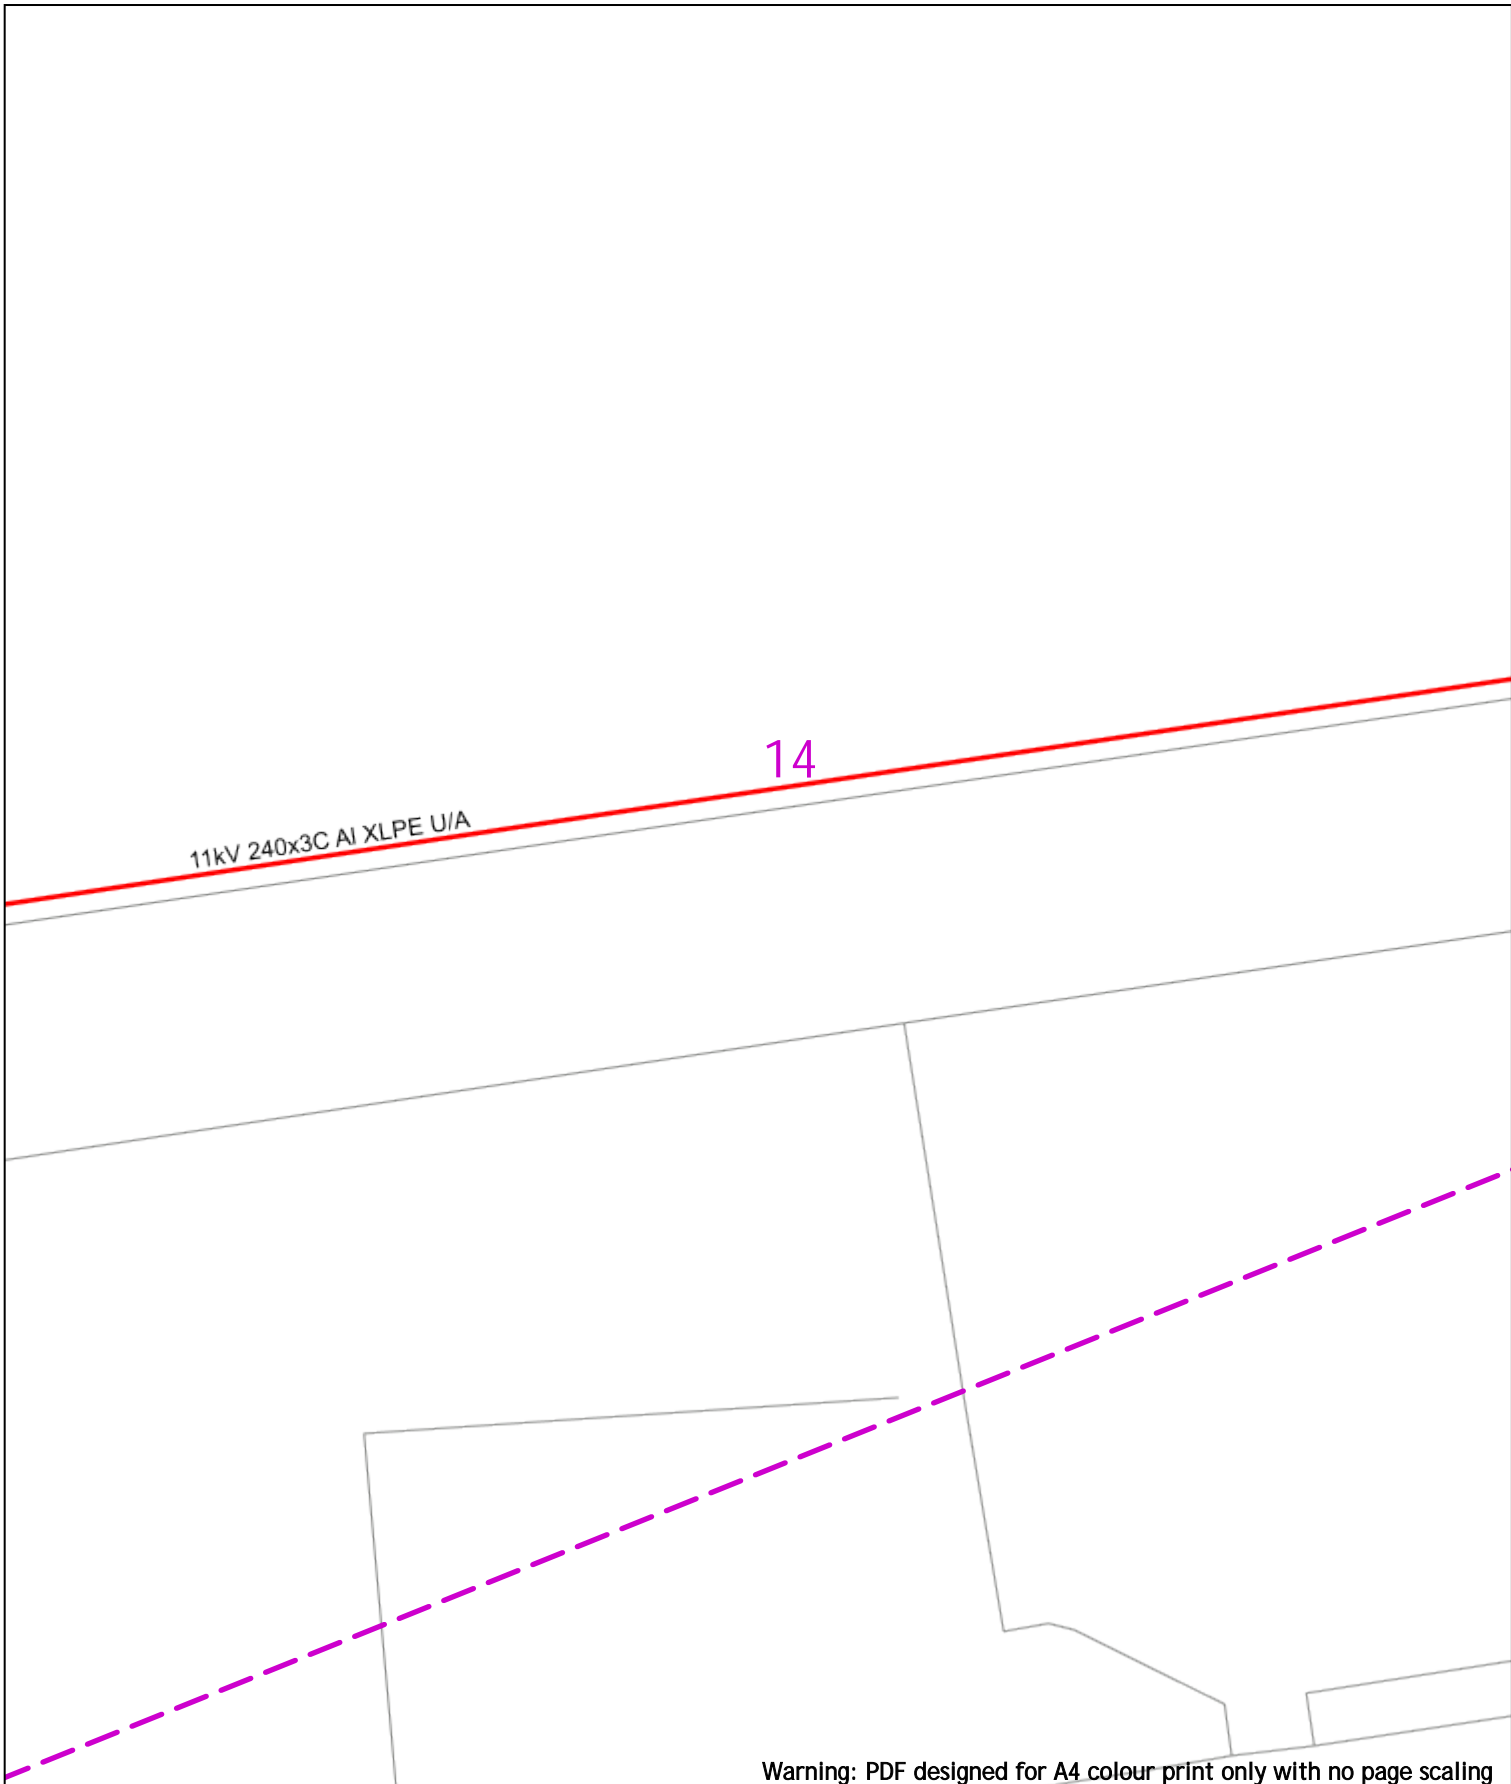

Warning: PDF designed for A4 colour print only with no page scaling



20m Dig Sites Area: [Dashed Purple Box] Line: [Dashed Purple Line]

Extra High Voltage cables in vicinity



Date Requested: 24/06/2022
 Job Reference: 25881010
 Site Location: 448066 213346
 Requested by: Mr Joe Shawyer
 Your Scheme/Reference: 31188_002

Voltages (V)			
LV (Low Voltage) and Services	Up to 1,000V		
HV (High Voltage)	Over 1,000V to 11,000V		
EHV (Extra High Voltage)	22,000V to 132,000V		
Transmission	275,000V and 400,000V		
NORMAL DEPTH TO THE TOP OF THE CABLE WHEN LAID			
Services	LV	HV	EHV
Footpath/Unmade	0.45m	0.45m	0.6m 0.8m
Road Crossing	0.6m	0.6m	0.75m 0.9m
Agricultural	1m	1m	1m 1.1m

Legend	



Southern Electric Power Distribution plc
 Registered Office: No.1 Forbury Place
 43 Forbury Road Reading RG1 3JH
 Registered In England & Wales No.04094290

If you're unsure & need to seek advice before commencing excavations, please contact:
 General Enquiries: 0800 048 3516

Subject to revision – Master held by SSEN Asset Data Team:
Asset.Data@sse.com
 01256 337 294

Scale: 1:500 (When plotted at A4)

WARNING
 There may have been subsequent alteration to the surface levels. Trial holes must be undertaken to determine position and depths of cables. HS (G) 47 Booklet from the Health and Safety Executive – Avoiding Danger from Buried Cables – should be consulted before commencing excavation work.
WHEN WORKING IN THE VICINITY OF OVERHEAD LINES THE HEALTH AND SAFETY GUIDANCE NOTES G56 SHOULD BE CONSULTED (AVAILABLE FROM THE HSE WEBSITE)

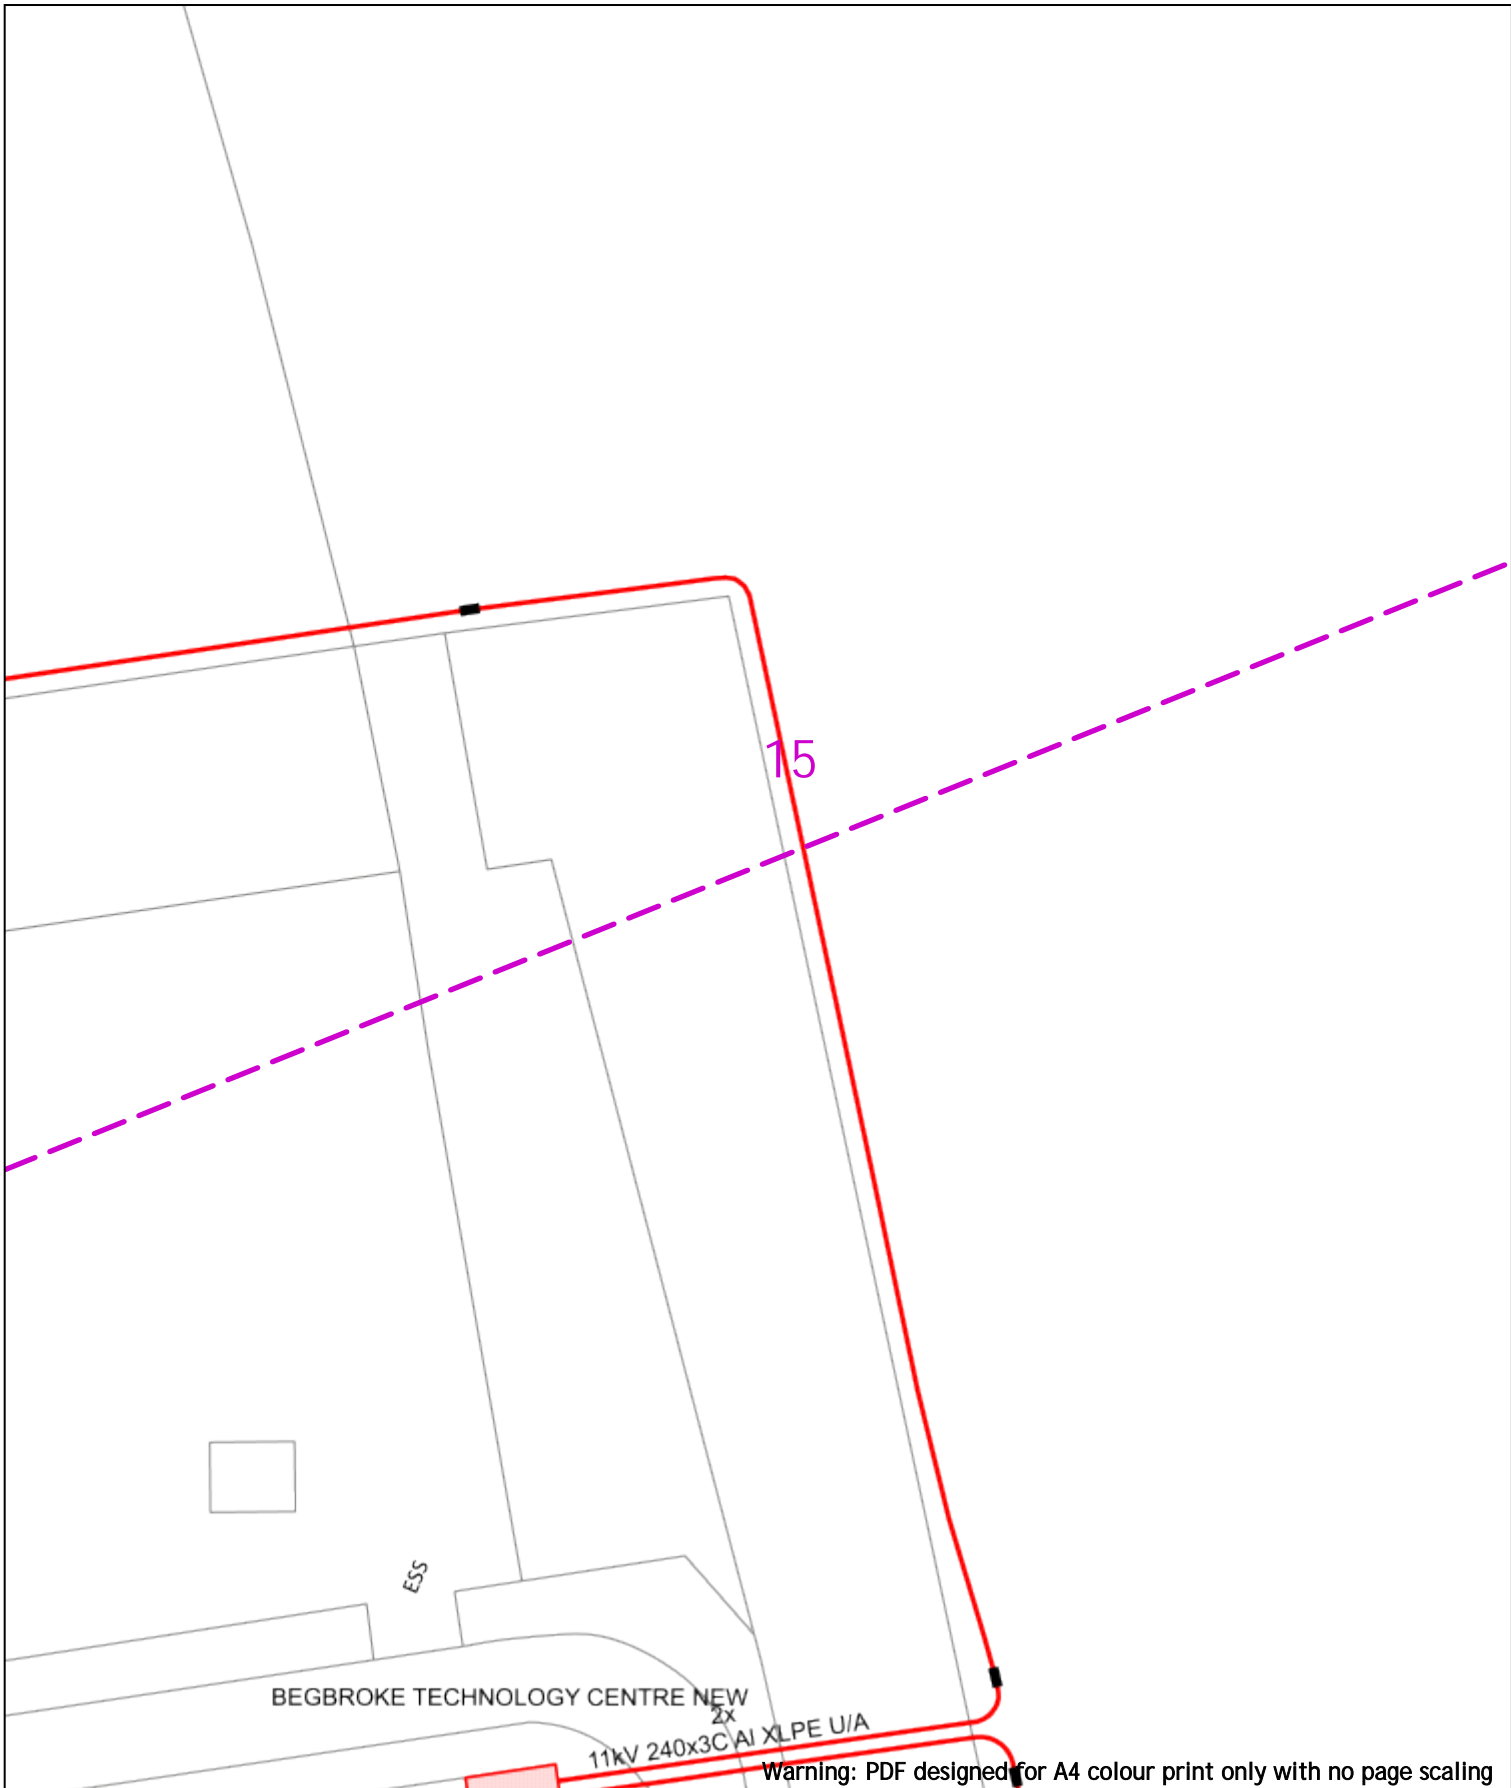

Warning: PDF designed for A4 colour print only with no page scaling

0 20m Dig Sites Area: Line: **Extra High Voltage cables in vicinity**

Date Requested: 24/06/2022
 Job Reference: 25881010
 Site Location: 448066 213346
 Requested by: Mr Joe Shawyer
 Your Scheme/Reference: 31188_002

Voltages (V)			
LV (Low Voltage) and Services	Up to 1,000V		
HV (High Voltage)	Over 1,000V to 11,000V		
EHV (Extra High Voltage)	22,000V to 132,000V		
Transmission	275,000V and 400,000V		
NORMAL DEPTH TO THE TOP OF THE CABLE WHEN LAID			
Services	LV	HV	EHV
Footpath/Unmade	0.45m	0.45m	0.6m
Road Crossing	0.6m	0.6m	0.75m
Agricultural	1m	1m	1.1m

Legend	
	Service Cable
	LV Mains
	2 - 8.3kV
	6.6kV
	11kV
	22kV
	33kV
	66kV
	132kV
	275kV
	400kV
	Fibre Optic
	Pilot Cable

Distribution Structures (Electric)	
	Pole, Existing Location
	Pole Structure, Existing Location - Single
	Pole Structure, Existing Location - H
	Duct Route
	Cross Section Route


Scale: 1:500 (When plotted at A4)

WARNING
 There may have been subsequent alteration to the surface levels. Trial holes must be undertaken to determine position and depths of cables. HS (G) 47 Booklet from the Health and Safety Executive - Avoiding Danger from Buried Cables - should be consulted before commencing excavation work.
 WHEN WORKING IN THE VICINITY OF OVERHEAD LINES THE HEALTH AND SAFETY GUIDANCE NOTES G56 SHOULD BE CONSULTED (AVAILABLE FROM THE HSE WEBSITE)

Southern Electric Power Distribution plc
 Registered Office: No.1 Forbury Place
 43 Forbury Road Reading RG1 3JH
 Registered In England & Wales No.04094290

If you're unsure & need to seek advice before commencing excavations, please contact:
 General Enquiries: 0800 048 3516

Subject to revision - Master held by SSEN Asset Data Team:
Asset.Data@sse.com
 01256 337 294

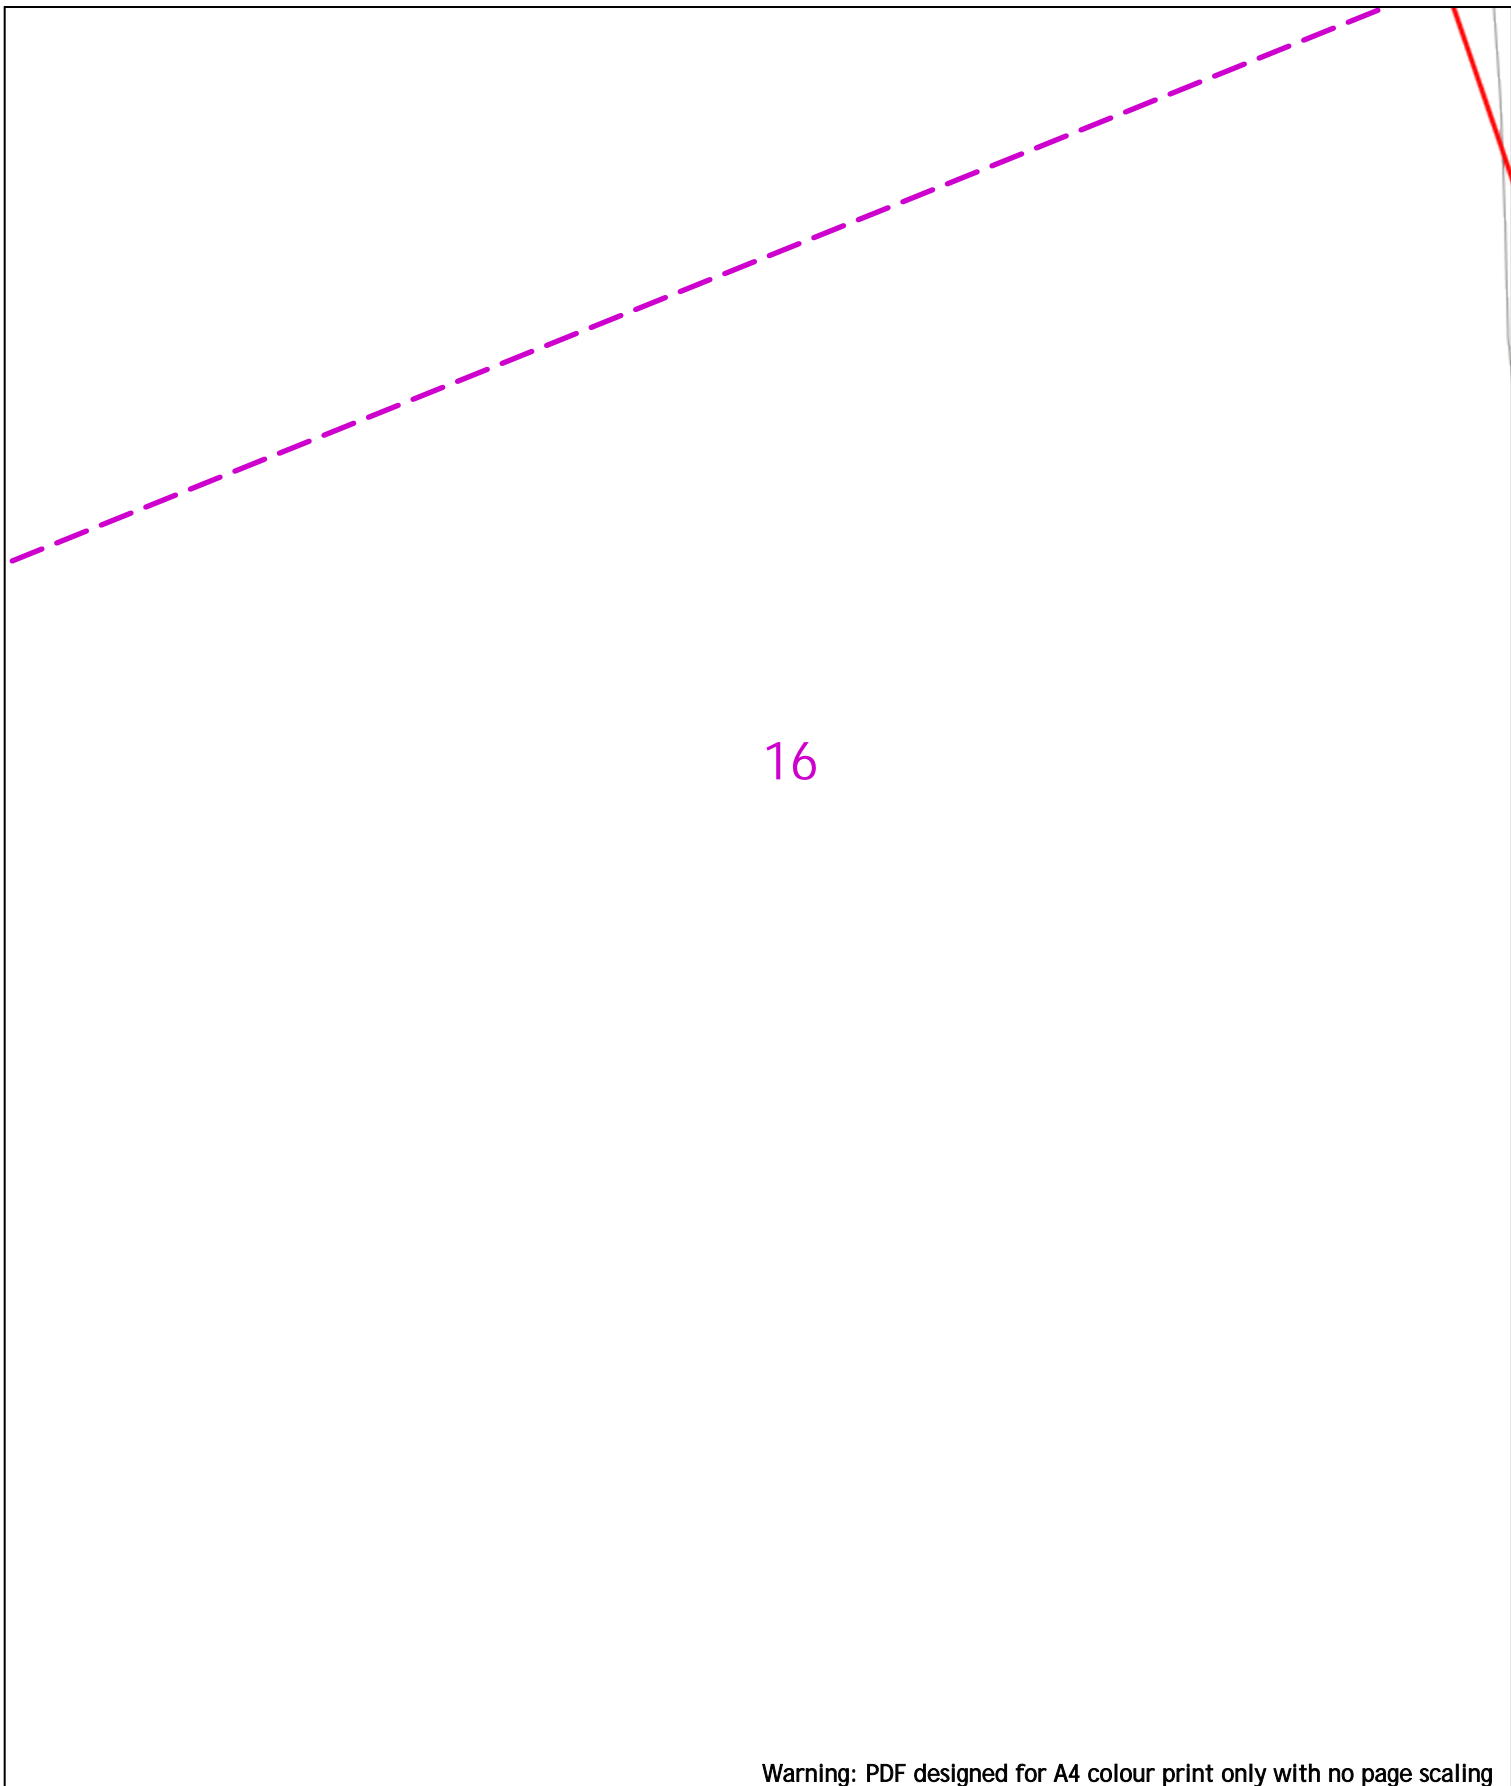

16

Warning: PDF designed for A4 colour print only with no page scaling

	<p>20m Dig Sites Area: Line: </p>	<p>Extra High Voltage cables in vicinity</p>																																	
<p>Date Requested: 24/06/2022 Job Reference: 25881010 Site Location: 448066 213346 Requested by: Mr Joe Shawyer Your Scheme/Reference: 31188_002</p>	<p>Voltages (V)</p> <table border="1"> <tr> <td>LV (Low Voltage) and Services</td> <td colspan="3">Up to 1,000V</td> </tr> <tr> <td>HV (High Voltage)</td> <td colspan="3">Over 1,000V to 11,000V</td> </tr> <tr> <td>EHV (Extra High Voltage)</td> <td colspan="3">22,000V to 132,000V</td> </tr> <tr> <td>Transmission</td> <td colspan="3">275,000V and 400,000V</td> </tr> </table> <p>NORMAL DEPTH TO THE TOP OF THE CABLE WHEN LAID</p> <table border="1"> <thead> <tr> <th>Services</th> <th>LV</th> <th>HV</th> <th>EHV</th> </tr> </thead> <tbody> <tr> <td>Footpath/Unmade</td> <td>0.45m</td> <td>0.45m</td> <td>0.6m</td> </tr> <tr> <td>Road Crossing</td> <td>0.6m</td> <td>0.6m</td> <td>0.75m</td> </tr> <tr> <td>Agricultural</td> <td>1m</td> <td>1m</td> <td>1.1m</td> </tr> </tbody> </table>	LV (Low Voltage) and Services	Up to 1,000V			HV (High Voltage)	Over 1,000V to 11,000V			EHV (Extra High Voltage)	22,000V to 132,000V			Transmission	275,000V and 400,000V			Services	LV	HV	EHV	Footpath/Unmade	0.45m	0.45m	0.6m	Road Crossing	0.6m	0.6m	0.75m	Agricultural	1m	1m	1.1m	<p>Legend</p> <ul style="list-style-type: none"> Service Cable LV Mains 2 - 11kV 66kV 11kV 22kV 33kV 66kV 132kV 275kV 400kV Fibre Optic Pipe Cable <p>Distribution Structures (Electric)</p> <ul style="list-style-type: none"> Pole, Existing Location Pole Structure, Existing Location - Single Pole Structure, Existing Location - H Duct Route Cross Section Route 	<p>Southern Electric Power Distribution plc Registered Office: No.1 Forbury Place 43 Forbury Road Reading RG1 3JH Registered In England & Wales No.04094290</p> <p>If you're unsure & need to seek advice before commencing excavations, please contact: General Enquiries: 0800 048 3516</p> <p>Subject to revision – Master held by SSEN Asset Data Team: Asset.Data@sse.com 01256 337 294</p>
LV (Low Voltage) and Services	Up to 1,000V																																		
HV (High Voltage)	Over 1,000V to 11,000V																																		
EHV (Extra High Voltage)	22,000V to 132,000V																																		
Transmission	275,000V and 400,000V																																		
Services	LV	HV	EHV																																
Footpath/Unmade	0.45m	0.45m	0.6m																																
Road Crossing	0.6m	0.6m	0.75m																																
Agricultural	1m	1m	1.1m																																
<p>Scale: 1:500 (When plotted at A4)</p> <p>WARNING There may have been subsequent alteration to the surface levels. Trial holes must be undertaken to determine position and depths of cables. HS (G) 47 Booklet from the Health and Safety Executive – Avoiding Danger from Buried Cables – should be consulted before commencing excavation work. WHEN WORKING IN THE VICINITY OF OVERHEAD LINES THE HEALTH AND SAFETY GUIDANCE NOTES G56 SHOULD BE CONSULTED (AVAILABLE FROM THE HSE WEBSITE)</p> <p><small>BASED UPON THE ORDNANCE SURVEY MAP WITH THE SANCTION OF THE CONTROLLER OF HM STATIONERY OFFICE CROWN COPYRIGHT RESERVED. This copy has been made by or with the authority of Scottish and Southern Energy Power Distribution Ltd. Pursuant to section 47 of the Copyright, Designs and Patents Act 1988 ("The Act"). Unless the Act provides a relevant exception to copyright the copy must not be copied without prior permission of the copyright owner. Plans generated by DigSAFE Pro™ software provided by LinesearchbeforeUdig.</small></p>																																			

Def

Warning: PDF designed for A4 colour print only with no page scaling

0 20m

Dig Sites Area: Line:

Extra High Voltage cables in vicinity



Date Requested: 24/06/2022
 Job Reference: 25881010
 Site Location: 448066 213346
 Requested by: Mr Joe Shawyer
 Your Scheme/Reference: 31188_002

Voltages (V)			
LV (Low Voltage) and Services	Up to 1,000V		
HV (High Voltage)	Over 1,000V to 11,000V		
EHV (Extra High Voltage)	22,000V to 132,000V		
Transmission	275,000V and 400,000V		
NORMAL DEPTH TO THE TOP OF THE CABLE WHEN LAID			
Services	LV	HV	EHV
Footpath/Unmade	0.45m	0.45m	0.6m 0.8m
Road Crossing	0.6m	0.6m	0.75m 0.9m
Agricultural	1m	1m	1m 1.1m

Legend	
	Service Cable
	LV Mains
	2 - 11kV
	66kV
	275kV
	400kV
	Fibre Optic
	Pipe Cable

Distribution Structures (Electric)	
	Pole, Existing Location
	Pole Structure, Existing Location - Single
	Pole Structure, Existing Location - H
	Duct Route
	Cross Section Route

WARNING
 There may have been subsequent alteration to the surface levels. Trial holes must be undertaken to determine position and depths of cables. HS (G) 47 Booklet from the Health and Safety Executive - Avoiding Danger from Buried Cables - should be consulted before commencing excavation work.
WHEN WORKING IN THE VICINITY OF OVERHEAD LINES THE HEALTH AND SAFETY GUIDANCE NOTES G56 SHOULD BE CONSULTED (AVAILABLE FROM THE HSE WEBSITE)

Southern Electric Power Distribution plc
 Registered Office: No.1 Forbury Place
 43 Forbury Road Reading RG1 3JH
 Registered In England & Wales No.04094290

If you're unsure & need to seek advice before commencing excavations, please contact:
 General Enquiries: 0800 048 3516

Subject to revision - Master held by SSEN Asset Data Team:
Asset.Data@sse.com
 01256 337 294

Scale: 1:500 (When plotted at A4)

Warning: PDF designed for A4 colour print only with no page scaling

	<p>20m Dig Sites Area: Line: </p>	<p>Extra High Voltage cables in vicinity</p>	
<p>Date Requested: 24/06/2022 Job Reference: 25881010 Site Location: 448066 213346 Requested by: Mr Joe Shawyer Your Scheme/Reference: 31188_002</p>	<p style="text-align: center;">Voltages (V)</p> <table border="1"> <tr> <td>LV (Low Voltage) and Services</td> <td colspan="3">Up to 1,000V</td> </tr> <tr> <td>HV (High Voltage)</td> <td colspan="3">Over 1,000V to 11,000V</td> </tr> <tr> <td>EHV (Extra High Voltage)</td> <td colspan="3">22,000V to 132,000V</td> </tr> <tr> <td>Transmission</td> <td colspan="3">275,000V and 400,000V</td> </tr> </table> <p style="text-align: center;">NORMAL DEPTH TO THE TOP OF THE CABLE WHEN LAID</p> <table border="1"> <thead> <tr> <th>Services</th> <th>LV</th> <th>HV</th> <th>EHV</th> </tr> </thead> <tbody> <tr> <td>Footpath/Unmade</td> <td>0.45m</td> <td>0.45m</td> <td>0.6m 0.8m</td> </tr> <tr> <td>Road Crossing</td> <td>0.6m</td> <td>0.6m</td> <td>0.75m 0.9m</td> </tr> <tr> <td>Agricultural</td> <td>1m</td> <td>1m</td> <td>1m 1.1m</td> </tr> </tbody> </table>	LV (Low Voltage) and Services	Up to 1,000V			HV (High Voltage)	Over 1,000V to 11,000V			EHV (Extra High Voltage)	22,000V to 132,000V			Transmission	275,000V and 400,000V			Services	LV	HV	EHV	Footpath/Unmade	0.45m	0.45m	0.6m 0.8m	Road Crossing	0.6m	0.6m	0.75m 0.9m	Agricultural	1m	1m	1m 1.1m	<table border="1"> <tr> <th colspan="2">Legend</th> <th colspan="2">Distribution Structures (Electric)</th> </tr> <tr> <td></td> <td>Service Cable</td> <td></td> <td>Pole, Existing Location</td> </tr> <tr> <td></td> <td>LV Mains</td> <td></td> <td>Pole Structure, Existing Location - Single</td> </tr> <tr> <td></td> <td>2 - 11kV</td> <td></td> <td>Pole Structure, Existing Location - H</td> </tr> <tr> <td></td> <td>66kV</td> <td></td> <td>Duct Route</td> </tr> <tr> <td></td> <td>11kV</td> <td></td> <td>Cross Section Route</td> </tr> <tr> <td></td> <td>22kV</td> <td></td> <td></td> </tr> <tr> <td></td> <td>33kV</td> <td></td> <td></td> </tr> <tr> <td></td> <td>66kV</td> <td></td> <td></td> </tr> <tr> <td></td> <td>132kV</td> <td></td> <td></td> </tr> <tr> <td></td> <td>275kV</td> <td></td> <td></td> </tr> <tr> <td></td> <td>400kV</td> <td></td> <td></td> </tr> <tr> <td></td> <td>Fibre Optic</td> <td></td> <td></td> </tr> <tr> <td></td> <td>Pipe Cable</td> <td></td> <td></td> </tr> </table> <p style="text-align: center;">WARNING</p> <p style="text-align: center; font-size: small;">There may have been subsequent alteration to the surface levels. Trial holes must be undertaken to determine position and depths of cables. HS (G) 47 Booklet from the Health and Safety Executive - Avoiding Danger from Buried Cables - should be consulted before commencing excavation work.</p> <p style="text-align: center; font-size: x-small;">WHEN WORKING IN THE VICINITY OF OVERHEAD LINES THE HEALTH AND SAFETY GUIDANCE NOTES G56 SHOULD BE CONSULTED (AVAILABLE FROM THE HSE WEBSITE)</p>	Legend		Distribution Structures (Electric)			Service Cable		Pole, Existing Location		LV Mains		Pole Structure, Existing Location - Single		2 - 11kV		Pole Structure, Existing Location - H		66kV		Duct Route		11kV		Cross Section Route		22kV				33kV				66kV				132kV				275kV				400kV				Fibre Optic				Pipe Cable			<p style="text-align: center;">Southern Electric Power Distribution plc Registered Office: No.1 Forbury Place 43 Forbury Road Reading RG1 3JH Registered In England & Wales No.04094290</p> <p>If you're unsure & need to seek advice before commencing excavations, please contact: General Enquiries: 0800 048 3516</p> <p>Subject to revision - Master held by SSEN Asset Data Team: Asset.Data@sse.com 01256 337 294</p>
LV (Low Voltage) and Services	Up to 1,000V	
HV (High Voltage)	Over 1,000V to 11,000V	
EHV (Extra High Voltage)	22,000V to 132,000V	
Transmission	275,000V and 400,000V	
Services	LV	HV	EHV	
Footpath/Unmade	0.45m	0.45m	0.6m 0.8m	
Road Crossing	0.6m	0.6m	0.75m 0.9m	
Agricultural	1m	1m	1m 1.1m	
Legend		Distribution Structures (Electric)	
	Service Cable		Pole, Existing Location	
	LV Mains		Pole Structure, Existing Location - Single	
	2 - 11kV		Pole Structure, Existing Location - H	
	66kV		Duct Route	
	11kV		Cross Section Route	
	22kV	
	33kV	
	66kV	
	132kV	
	275kV	
	400kV	
	Fibre Optic	
	Pipe Cable	
<p style="font-size: x-small;">BASED UPON THE ORDNANCE SURVEY MAP WITH THE SANCTION OF THE CONTROLLER OF HM STATIONERY OFFICE CROWN COPYRIGHT RESERVED. This copy has been made by or with the authority of Scottish and Southern Energy Power Distribution Ltd. Pursuant to section 47 of the Copyright, Designs and Patents Act 1988 ("The Act"). Unless the Act provides a relevant exception to copyright the copy must not be copied without prior permission of the copyright owner. Plans generated by DigSAFE Pro™ software provided by LinesearchbeforeDig.</p>	

Warning: PDF designed for A4 colour print only with no page scaling

0 20m Dig Sites Area: Line:

**Extra High Voltage
cables in vicinity**



Date Requested: 24/06/2022
 Job Reference: 25881010
 Site Location: 448066 213346
 Requested by: Mr Joe Shawyer
 Your Scheme/Reference: 31188_002

Voltages (V)			
LV (Low Voltage) and Services	Up to 1,000V		
HV (High Voltage)	Over 1,000V to 11,000V		
EHV (Extra High Voltage)	22,000V to 132,000V		
Transmission	275,000V and 400,000V		
NORMAL DEPTH TO THE TOP OF THE CABLE WHEN LAID			
Services	LV	HV	EHV
Footpath/Unmade	0.45m	0.45m	0.6m
Road Crossing	0.6m	0.6m	0.75m
Agricultural	1m	1m	1.1m

Legend	
	Service Cable
	LV Mains
	2 - 11kV
	66kV
	11kV
	22kV
	33kV
	66kV
	132kV
	275kV
	400kV
	Fibre Optic
	Pipe Cable

Distribution Structures (Electric)	
	Pole, Existing Location
	Pole Structure, Existing Location - Single
	Pole Structure, Existing Location - H
	Duct Route
	Cross Section Route


Southern Electric Power Distribution plc
 Registered Office: No.1 Forbury Place
 43 Forbury Road Reading RG1 3JH
 Registered In England & Wales No.04094290

If you're unsure & need to seek advice before commencing excavations, please contact:
 General Enquiries: 0800 048 3516

Subject to revision – Master held by SSEN Asset Data Team:
Asset.Data@sse.com
 01256 337 294

Scale: 1:500 (When plotted at A4)

WARNING
 There may have been subsequent alteration to the surface levels. Trial holes must be undertaken to determine position and depths of cables. HS (G) 47 Booklet from the Health and Safety Executive – Avoiding Danger from Buried Cables – should be consulted before commencing excavation work.
WHEN WORKING IN THE VICINITY OF OVERHEAD LINES THE HEALTH AND SAFETY GUIDANCE NOTES G56 SHOULD BE CONSULTED (AVAILABLE FROM THE HSE WEBSITE)

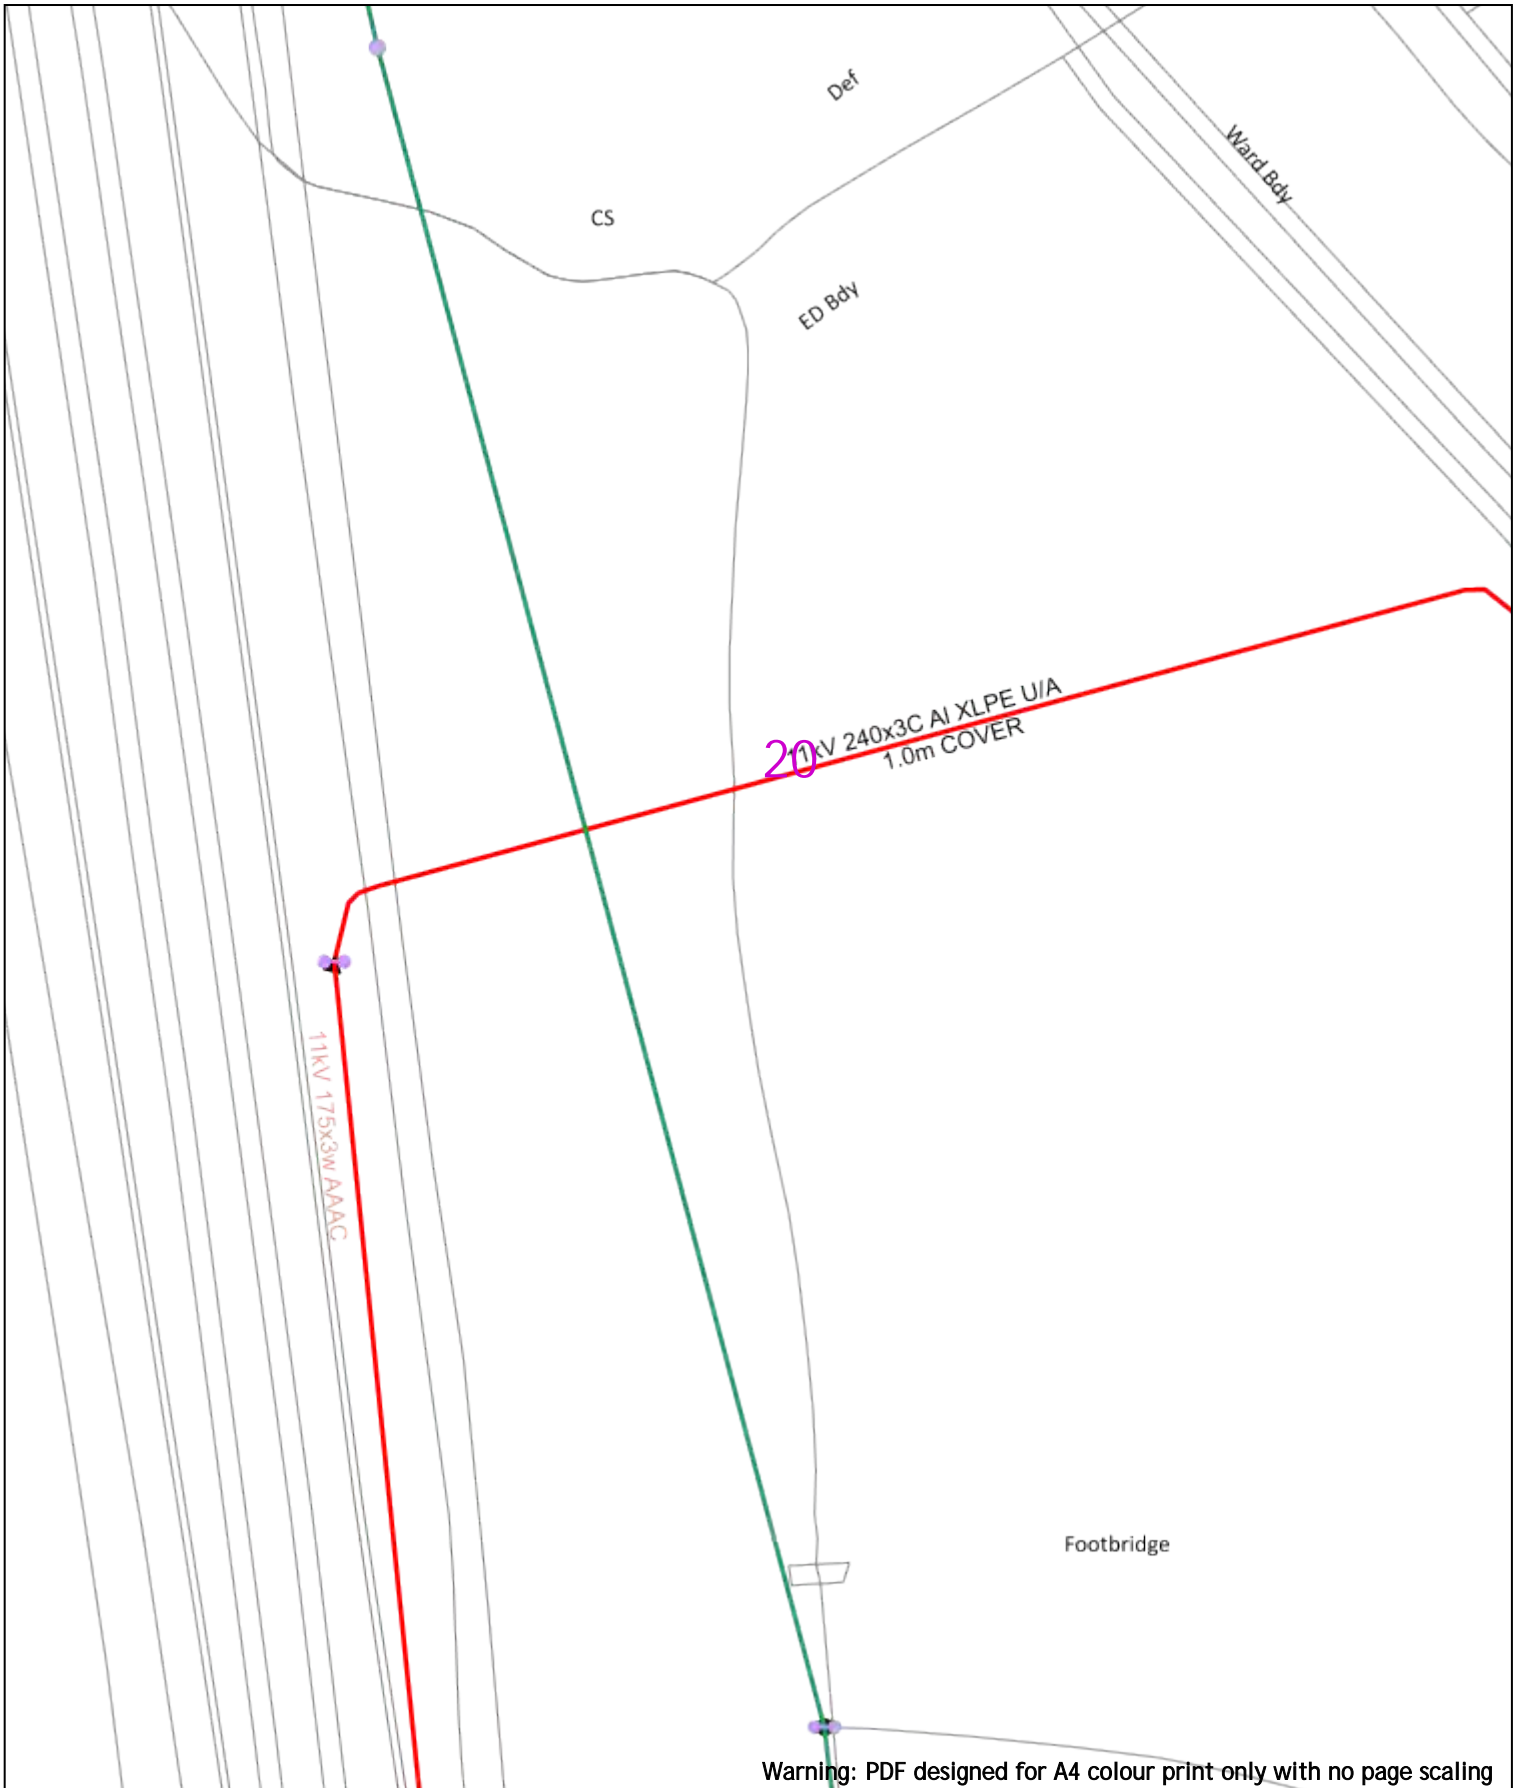

Warning: PDF designed for A4 colour print only with no page scaling

20m Dig Sites Area: Line: Extra High Voltage cables in vicinity

Date Requested: 24/06/2022
 Job Reference: 25881010
 Site Location: 448066 213346
 Requested by: Mr Joe Shawyer
 Your Scheme/Reference: 31188_002

Voltages (V)			
LV (Low Voltage) and Services	Up to 1,000V		
HV (High Voltage)	Over 1,000V to 11,000V		
EHV (Extra High Voltage)	22,000V to 132,000V		
Transmission	275,000V and 400,000V		
NORMAL DEPTH TO THE TOP OF THE CABLE WHEN LAID			
Services	LV	HV	EHV
Footpath/Unmade	0.45m	0.45m	0.6m 0.8m
Road Crossing	0.6m	0.6m	0.75m 0.9m
Agricultural	1m	1m	1m 1.1m

Legend	
	Service Cable
	LV Mains
	2 - 11kV
	66kV
	11kV
	22kV
	33kV
	66kV
	132kV
	275kV
	400kV
	Fibre Optic
	Pilot Cable


Distribution Structures (Electric)	
	Pole, Existing Location
	Pole Structure, Existing Location - Single
	Pole Structure, Existing Location - H
	Duct Route
	Cross Section Route

WARNING
 There may have been subsequent alteration to the surface levels. Trial holes must be undertaken to determine position and depths of cables. HS (G) 47 Booklet from the Health and Safety Executive - Avoiding Danger from Buried Cables - should be consulted before commencing excavation work.
 WHEN WORKING IN THE VICINITY OF OVERHEAD LINES THE HEALTH AND SAFETY GUIDANCE NOTES G56 SHOULD BE CONSULTED (AVAILABLE FROM THE HSE WEBSITE)

Southern Electric Power Distribution plc
 Registered Office: No.1 Forbury Place
 43 Forbury Road Reading RG1 3JH
 Registered In England & Wales No.04094290


If you're unsure & need to seek advice before commencing excavations, please contact:
 General Enquiries: 0800 048 3516

Subject to revision - Master held by SSEN Asset Data Team:
Asset.Data@sse.com
 01256 337 294

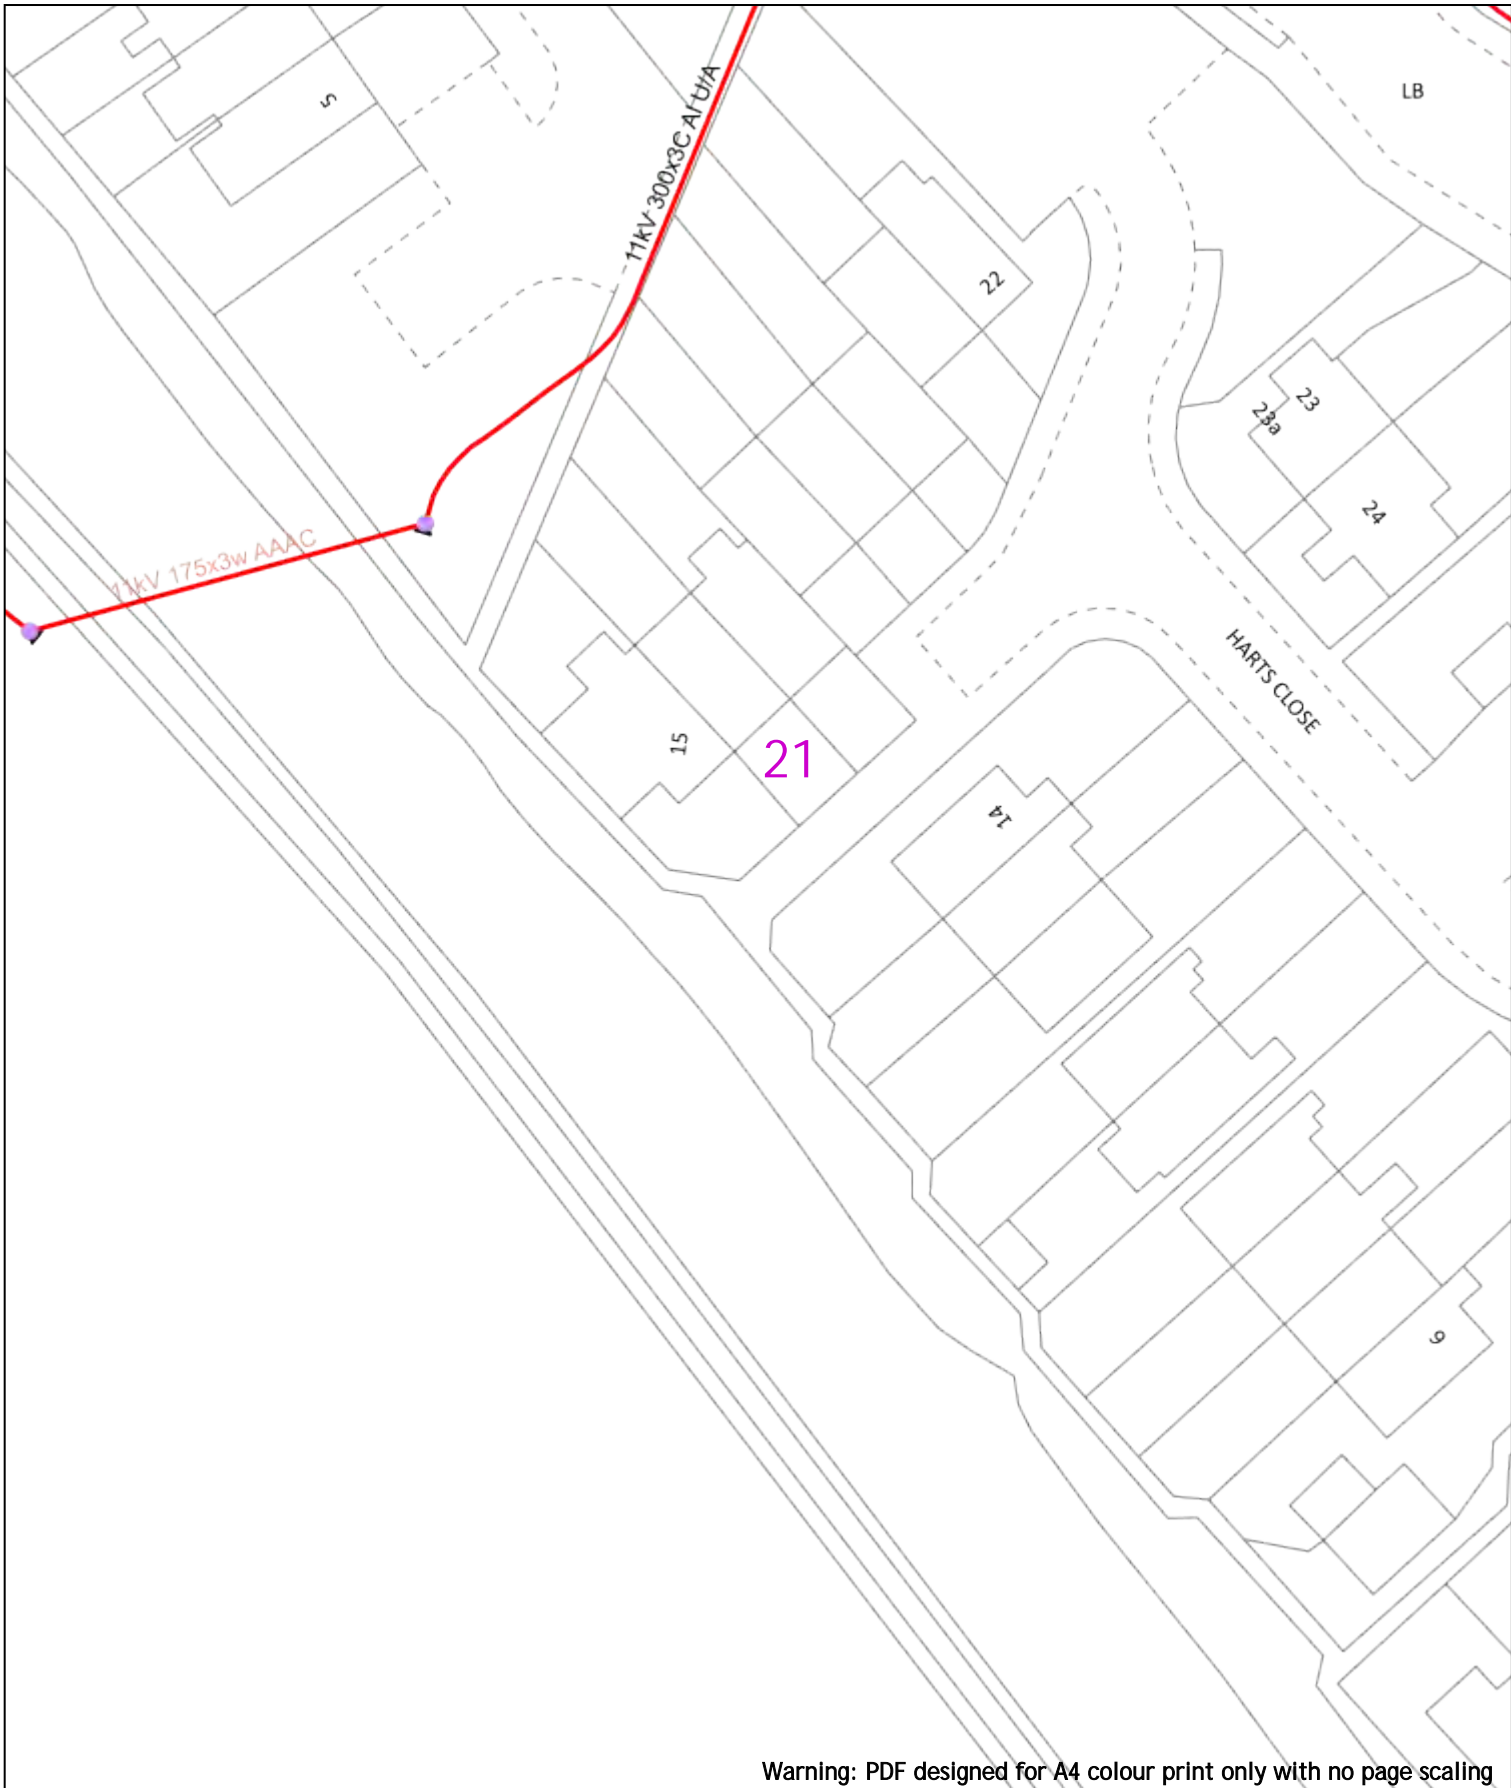


Warning: PDF designed for A4 colour print only with no page scaling

		Dig Sites Area: Line:		Extra High Voltage cables in vicinity	
Date Requested: 24/06/2022 Job Reference: 25881010 Site Location: 448066 213346 Requested by: Mr Joe Shawyer Your Scheme/Reference: 31188_002		<table border="1"> <thead> <tr> <th colspan="4">Voltages (V)</th> </tr> </thead> <tbody> <tr> <td>LV (Low Voltage) and Services</td> <td colspan="3">Up to 1,000V</td> </tr> <tr> <td>HV (High Voltage)</td> <td colspan="3">Over 1,000V to 11,000V</td> </tr> <tr> <td>EHV (Extra High Voltage)</td> <td colspan="3">22,000V to 132,000V</td> </tr> <tr> <td>Transmission</td> <td colspan="3">275,000V and 400,000V</td> </tr> </tbody> </table> <table border="1"> <thead> <tr> <th colspan="5">NORMAL DEPTH TO THE TOP OF THE CABLE WHEN LAID</th> </tr> <tr> <th>Services</th> <th>LV</th> <th>HV</th> <th>EHV</th> <th></th> </tr> </thead> <tbody> <tr> <td>Footpath/Unmade</td> <td>0.45m</td> <td>0.45m</td> <td>0.6m</td> <td>0.8m</td> </tr> <tr> <td>Road Crossing</td> <td>0.6m</td> <td>0.6m</td> <td>0.75m</td> <td>0.9m</td> </tr> <tr> <td>Agricultural</td> <td>1m</td> <td>1m</td> <td>1m</td> <td>1.1m</td> </tr> </tbody> </table>		Voltages (V)				LV (Low Voltage) and Services	Up to 1,000V			HV (High Voltage)	Over 1,000V to 11,000V			EHV (Extra High Voltage)	22,000V to 132,000V			Transmission	275,000V and 400,000V			NORMAL DEPTH TO THE TOP OF THE CABLE WHEN LAID					Services	LV	HV	EHV		Footpath/Unmade	0.45m	0.45m	0.6m	0.8m	Road Crossing	0.6m	0.6m	0.75m	0.9m	Agricultural	1m	1m	1m	1.1m	<table border="1"> <thead> <tr> <th colspan="2">Legend</th> </tr> </thead> <tbody> <tr><td></td><td>Service Cable</td></tr> <tr><td></td><td>LV Mains</td></tr> <tr><td></td><td>2 - 11kV</td></tr> <tr><td></td><td>66kV</td></tr> <tr><td></td><td>11kV</td></tr> <tr><td></td><td>22kV</td></tr> <tr><td></td><td>33kV</td></tr> <tr><td></td><td>66kV</td></tr> <tr><td></td><td>132kV</td></tr> <tr><td></td><td>275kV</td></tr> <tr><td></td><td>400kV</td></tr> <tr><td></td><td>Fibre Optic</td></tr> <tr><td></td><td>Pilot Cable</td></tr> </tbody> </table> <table border="1"> <thead> <tr> <th colspan="2">Distribution Structures (Electric)</th> </tr> </thead> <tbody> <tr><td></td><td>Pole, Existing Location</td></tr> <tr><td></td><td>Pole Structure, Existing Location - Single</td></tr> <tr><td></td><td>Pole Structure, Existing Location - H</td></tr> <tr><td></td><td>Duct Route</td></tr> <tr><td></td><td>Cross Section Route</td></tr> </tbody> </table>		Legend			Service Cable		LV Mains		2 - 11kV		66kV		11kV		22kV		33kV		66kV		132kV		275kV		400kV		Fibre Optic		Pilot Cable	Distribution Structures (Electric)			Pole, Existing Location		Pole Structure, Existing Location - Single		Pole Structure, Existing Location - H		Duct Route		Cross Section Route	<p style="text-align: center;">Southern Electric Power Distribution plc Registered Office: No.1 Forbury Place 43 Forbury Road Reading RG1 3JH Registered In England & Wales No.04094290</p> <p>If you're unsure & need to seek advice before commencing excavations, please contact: General Enquiries: 0800 048 3516</p> <p>Subject to revision – Master held by SSEN Asset Data Team: Asset.Data@sse.com 01256 337 294</p>	
Voltages (V)	
LV (Low Voltage) and Services	Up to 1,000V	
HV (High Voltage)	Over 1,000V to 11,000V	
EHV (Extra High Voltage)	22,000V to 132,000V	
Transmission	275,000V and 400,000V	
NORMAL DEPTH TO THE TOP OF THE CABLE WHEN LAID	
Services	LV	HV	EHV	
Footpath/Unmade	0.45m	0.45m	0.6m	0.8m	
Road Crossing	0.6m	0.6m	0.75m	0.9m	
Agricultural	1m	1m	1m	1.1m	
Legend	
	Service Cable	
	LV Mains	
	2 - 11kV	
	66kV	
	11kV	
	22kV	
	33kV	
	66kV	
	132kV	
	275kV	
	400kV	
	Fibre Optic	
	Pilot Cable	
Distribution Structures (Electric)	
	Pole, Existing Location	
	Pole Structure, Existing Location - Single	
	Pole Structure, Existing Location - H	
	Duct Route	
	Cross Section Route	
Scale: 1:500 (When plotted at A4)		<p style="text-align: center;">WARNING</p> <p>There may have been subsequent alteration to the surface levels. Trial holes must be undertaken to determine position and depths of cables. HS (G) 47 Booklet from the Health and Safety Executive – Avoiding Danger from Buried Cables – should be consulted before commencing excavation work.</p> <p>WHEN WORKING IN THE VICINITY OF OVERHEAD LINES THE HEALTH AND SAFETY GUIDANCE NOTES G56 SHOULD BE CONSULTED (AVAILABLE FROM THE HSE WEBSITE)</p>		<p style="text-align: center;"><small>BASED UPON THE ORDNANCE SURVEY MAP WITH THE SANCTION OF THE CONTROLLER OF HM STATIONERY OFFICE CROWN COPYRIGHT RESERVED.</small></p> <p style="text-align: center;"><small>This copy has been made by or with the authority of Scottish and Southern Energy Power Distribution Ltd. Pursuant to section 47 of the Copyright, Designs and Patents Act 1988 ("The Act"). Unless the Act provides a relevant exception to copyright the copy must not be copied without prior permission of the copyright owner.</small></p> <p style="text-align: center;"><small>Plans generated by DigSAFE Pro™ software provided by LinesearchbeforeyouDig.</small></p>	

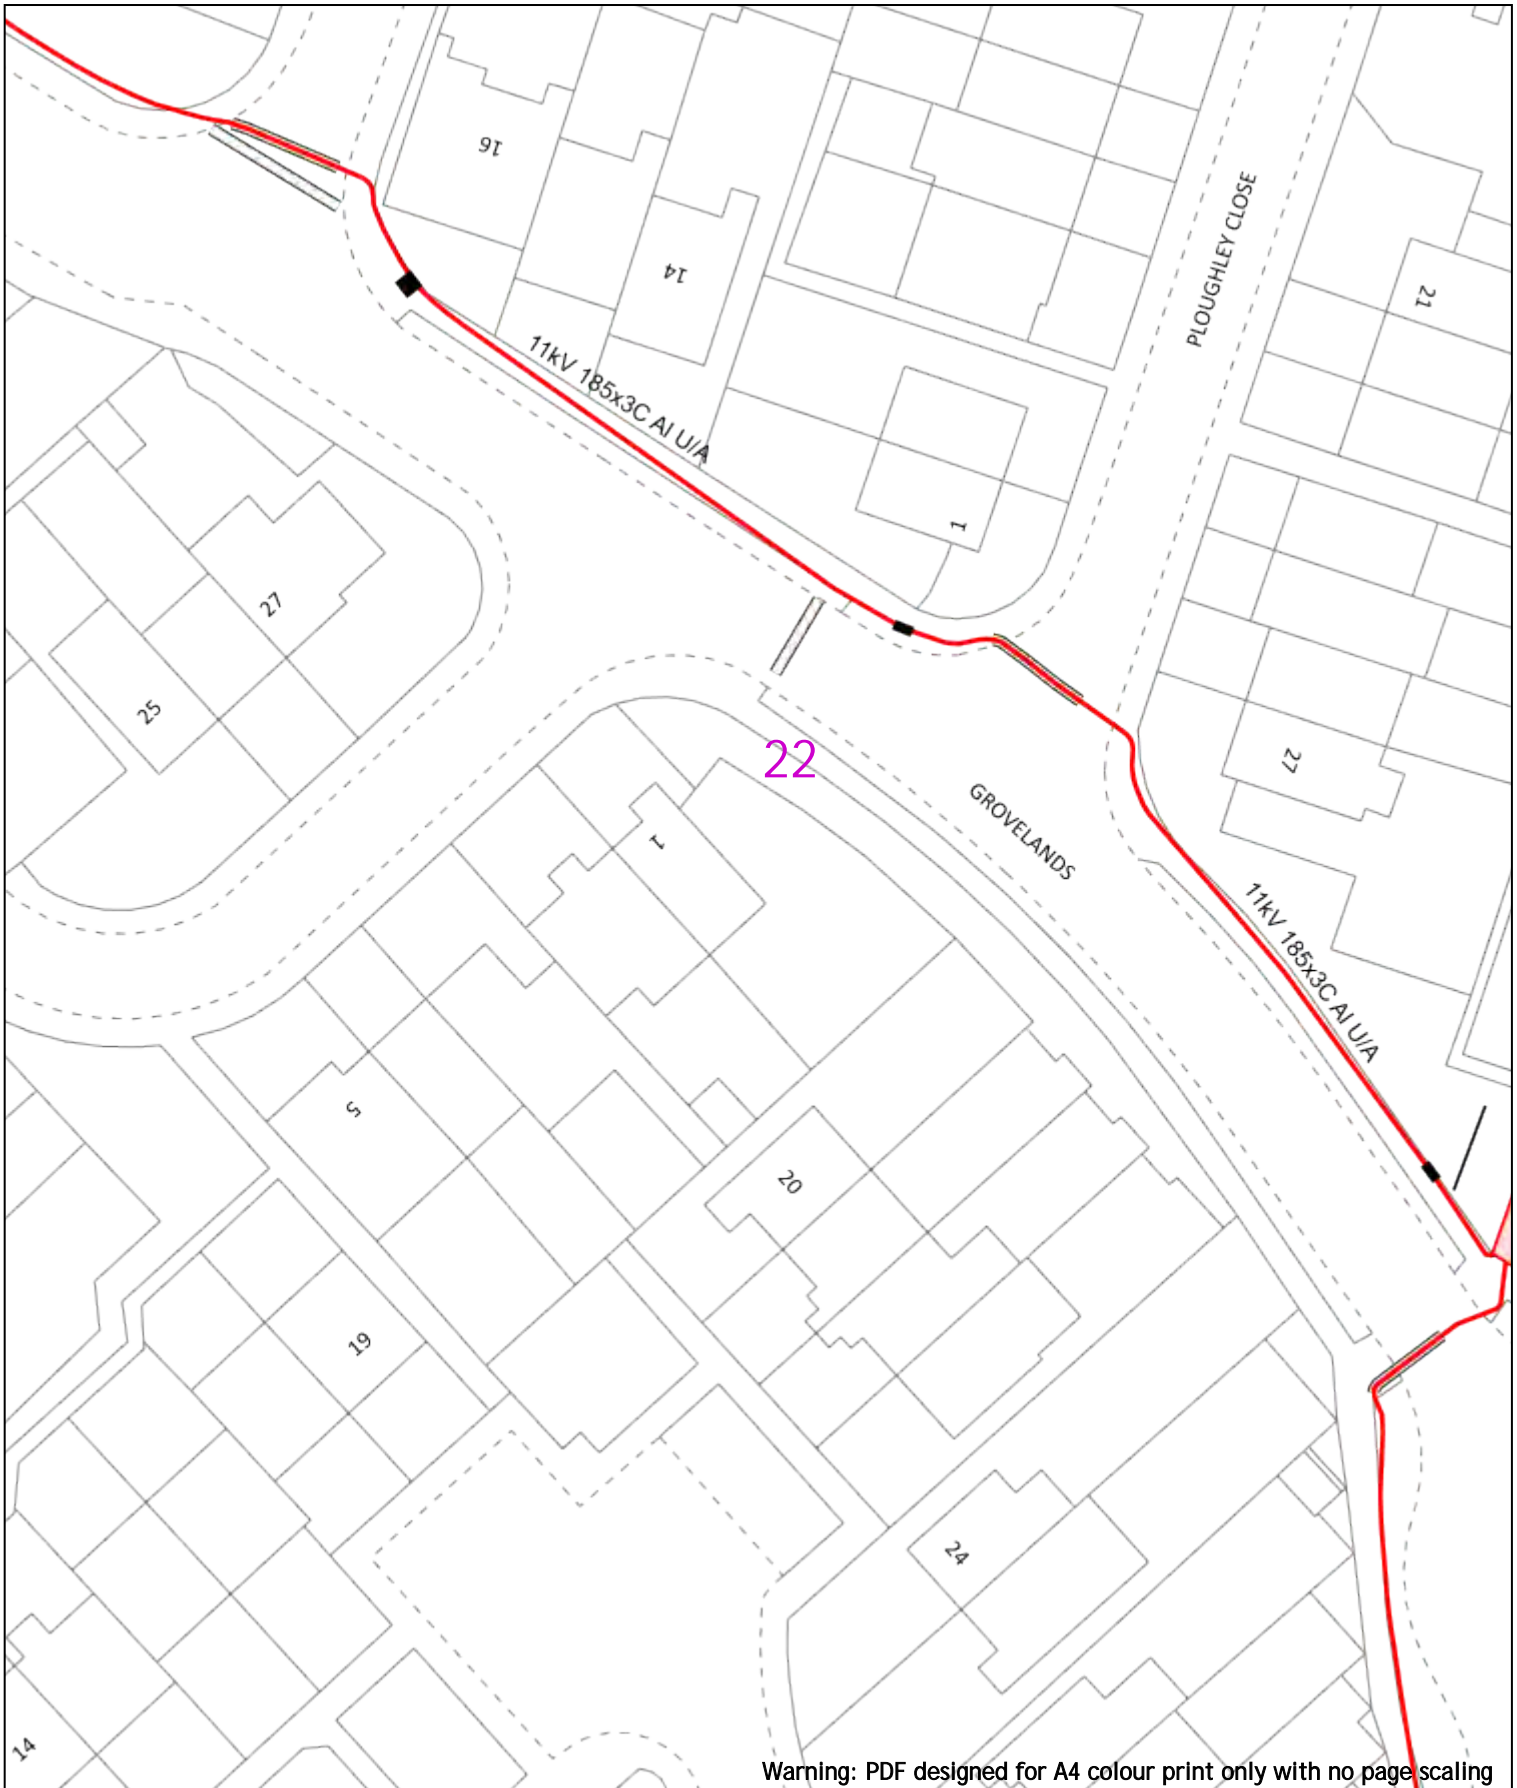


Warning: PDF designed for A4 colour print only with no page scaling

<p>0 20m Dig Sites Area: Line: Extra High Voltage cables in vicinity</p>																										
<p>Date Requested: 24/06/2022 Job Reference: 25881010 Site Location: 448066 213346 Requested by: Mr Joe Shawyer Your Scheme/Reference: 31188_002</p>	<p>Voltages (V)</p> <table border="1"> <tr> <td>LV (Low Voltage) and Services</td> <td>Up to 1,000V</td> </tr> <tr> <td>HV (High Voltage)</td> <td>Over 1,000V to 11,000V</td> </tr> <tr> <td>EHV (Extra High Voltage)</td> <td>22,000V to 132,000V</td> </tr> <tr> <td>Transmission</td> <td>275,000V and 400,000V</td> </tr> </table> <p>NORMAL DEPTH TO THE TOP OF THE CABLE WHEN LAID</p> <table border="1"> <tr> <td>Services</td> <td>LV</td> <td>HV</td> <td>EHV</td> </tr> <tr> <td>Footpath/Unmade</td> <td>0.45m</td> <td>0.45m</td> <td>0.6m</td> </tr> <tr> <td>Road Crossing</td> <td>0.6m</td> <td>0.6m</td> <td>0.75m</td> </tr> <tr> <td>Agricultural</td> <td>1m</td> <td>1m</td> <td>1.1m</td> </tr> </table>			LV (Low Voltage) and Services	Up to 1,000V	HV (High Voltage)	Over 1,000V to 11,000V	EHV (Extra High Voltage)	22,000V to 132,000V	Transmission	275,000V and 400,000V	Services	LV	HV	EHV	Footpath/Unmade	0.45m	0.45m	0.6m	Road Crossing	0.6m	0.6m	0.75m	Agricultural	1m	1m
LV (Low Voltage) and Services	Up to 1,000V																									
HV (High Voltage)	Over 1,000V to 11,000V																									
EHV (Extra High Voltage)	22,000V to 132,000V																									
Transmission	275,000V and 400,000V																									
Services	LV	HV	EHV																							
Footpath/Unmade	0.45m	0.45m	0.6m																							
Road Crossing	0.6m	0.6m	0.75m																							
Agricultural	1m	1m	1.1m																							
<p>Scale: 1:500 (When plotted at A4)</p>		<p>Southern Electric Power Distribution plc Registered Office: No.1 Forbury Place 43 Forbury Road Reading RG1 3JH Registered In England & Wales No.04094290</p> <p>If you're unsure & need to seek advice before commencing excavations, please contact: General Enquiries: 0800 048 3516</p> <p>Subject to revision – Master held by SSEN Asset Data Team: Asset.Data@sse.com 01256 337 294</p>																								
<p><small>BASED UPON THE ORDNANCE SURVEY MAP WITH THE SANCTION OF THE CONTROLLER OF HM STATIONERY OFFICE CROWN COPYRIGHT RESERVED. This copy has been made by or with the authority of Scottish and Southern Energy Power Distribution Ltd. Pursuant to section 47 of the Copyright, Designs and Patents Act 1988 ("The Act"). Unless the Act provides a relevant exception to copyright the copy must not be copied without prior permission of the copyright owner. Plans generated by DigSAFE Pro™ software provided by LinesearchbeforeDigs.</small></p>																										

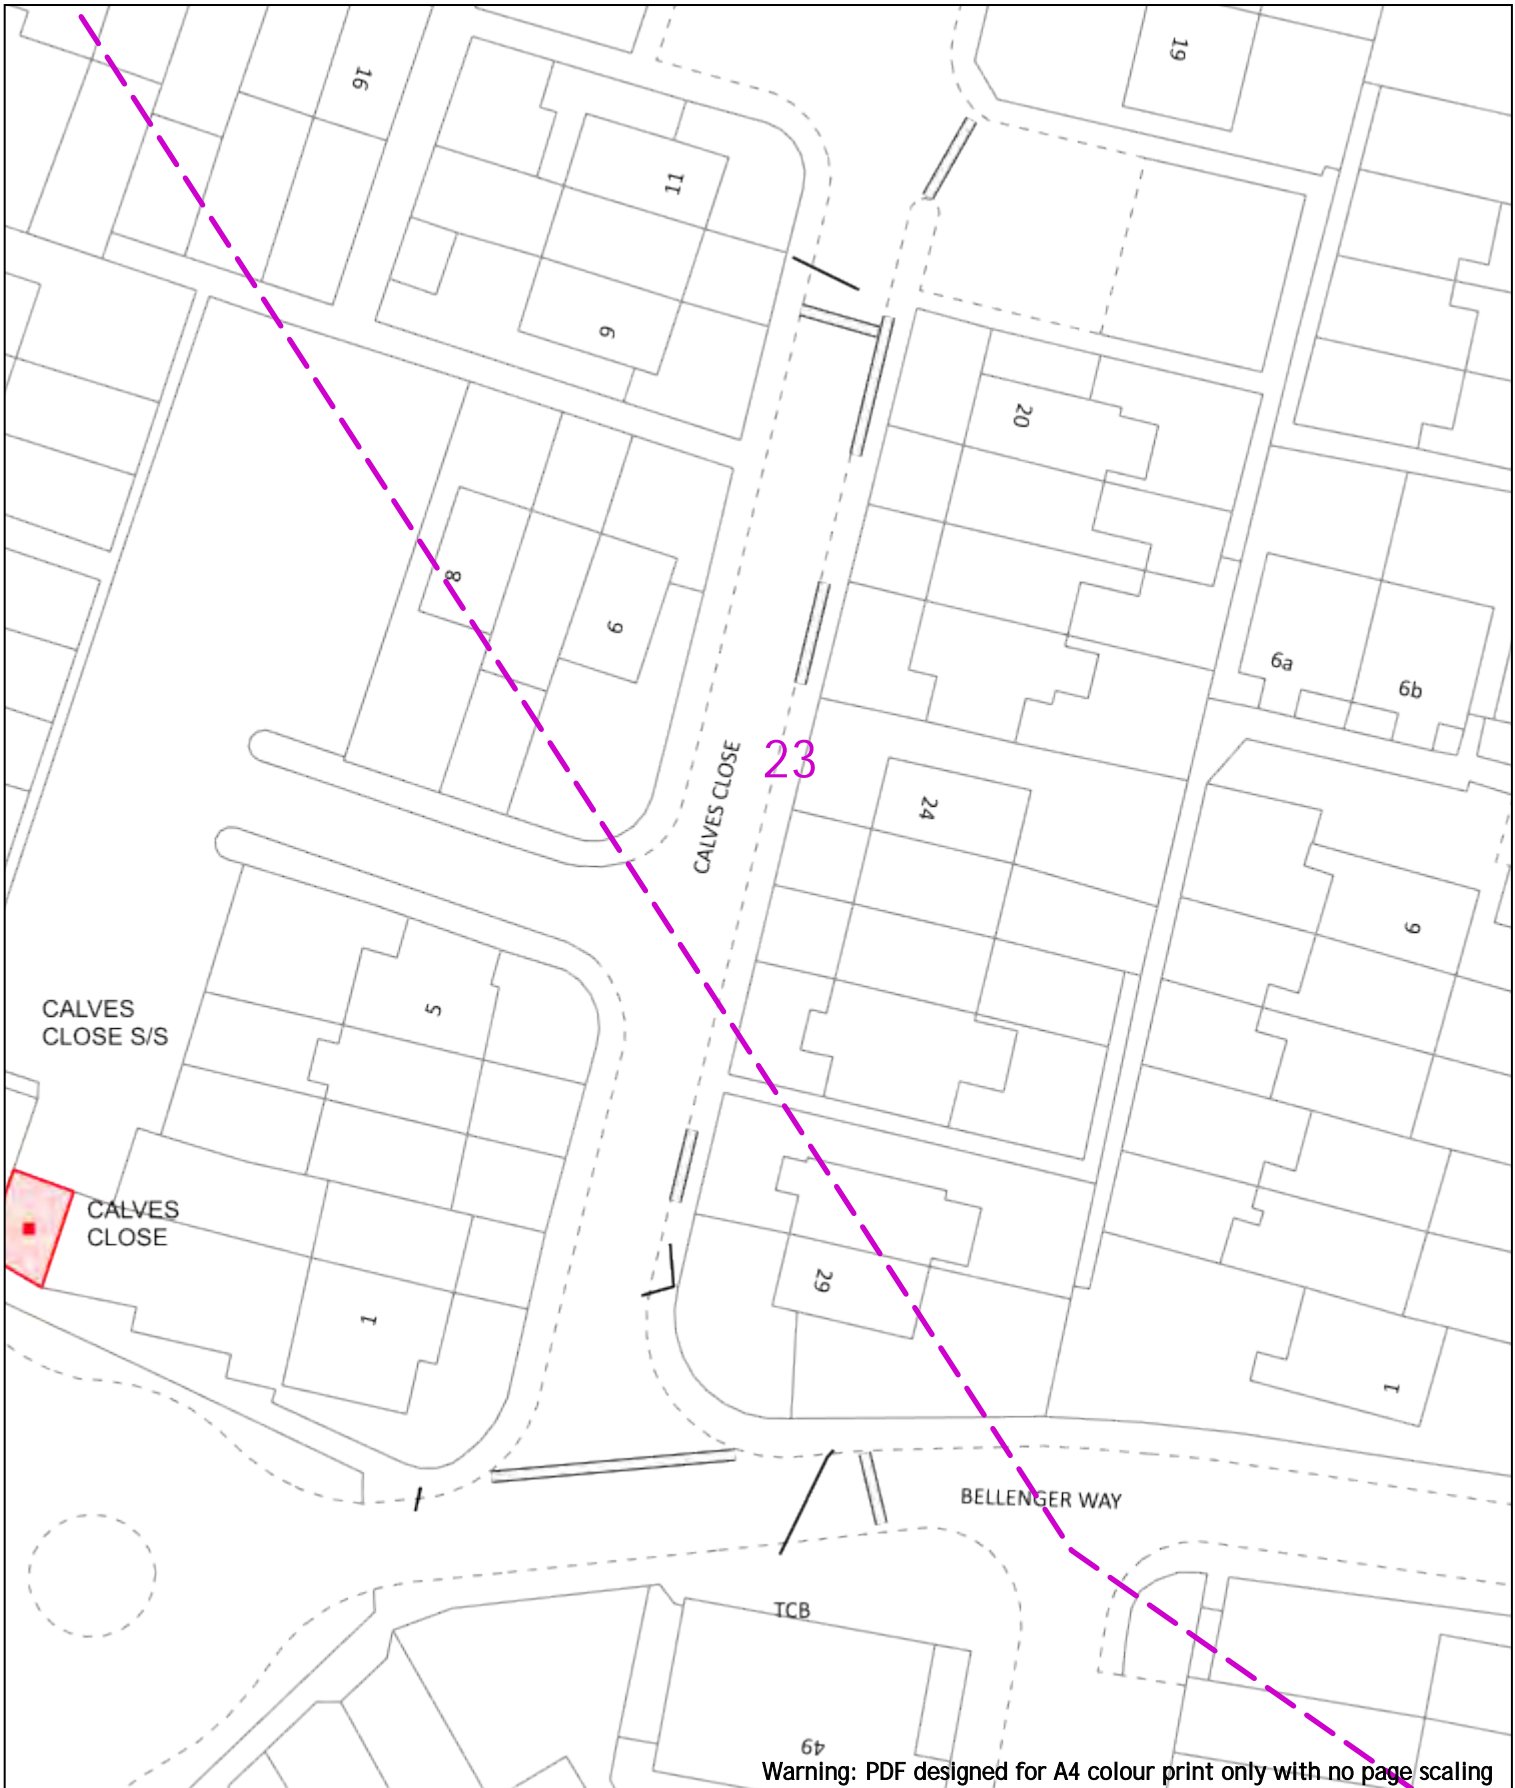

Warning: PDF designed for A4 colour print only with no page scaling

	<p>20m Dig Sites Area: Line: </p>	<p>Extra High Voltage cables in vicinity</p>																									
<p>Date Requested: 24/06/2022 Job Reference: 25881010 Site Location: 448066 213346 Requested by: Mr Joe Shawyer Your Scheme/Reference: 31188_002</p>	<p>Voltages (V)</p> <table border="1"> <tr> <td>LV (Low Voltage) and Services</td> <td>Up to 1,000V</td> </tr> <tr> <td>HV (High Voltage)</td> <td>Over 1,000V to 11,000V</td> </tr> <tr> <td>EHV (Extra High Voltage)</td> <td>22,000V to 132,000V</td> </tr> <tr> <td>Transmission</td> <td>275,000V and 400,000V</td> </tr> </table> <p>NORMAL DEPTH TO THE TOP OF THE CABLE WHEN LAID</p> <table border="1"> <thead> <tr> <th>Services</th> <th>LV</th> <th>HV</th> <th>EHV</th> </tr> </thead> <tbody> <tr> <td>Footpath/Unmade</td> <td>0.45m</td> <td>0.45m</td> <td>0.6m</td> </tr> <tr> <td>Road Crossing</td> <td>0.6m</td> <td>0.6m</td> <td>0.75m</td> </tr> <tr> <td>Agricultural</td> <td>1m</td> <td>1m</td> <td>1.1m</td> </tr> </tbody> </table>	LV (Low Voltage) and Services	Up to 1,000V	HV (High Voltage)	Over 1,000V to 11,000V	EHV (Extra High Voltage)	22,000V to 132,000V	Transmission	275,000V and 400,000V	Services	LV	HV	EHV	Footpath/Unmade	0.45m	0.45m	0.6m	Road Crossing	0.6m	0.6m	0.75m	Agricultural	1m	1m	1.1m	<p>Legend</p> <ul style="list-style-type: none"> Service Cable LV Mains 11kV 22kV 33kV 66kV 132kV 275kV 400kV Fibre Optic Pipe Cable <p>Distribution Structures (Electric)</p> <ul style="list-style-type: none"> Pole, Existing Location Pole Structure, Existing Location - Single Pole Structure, Existing Location - H Duct Route Cross Section Route 	<p>Southern Electric Power Distribution plc Registered Office: No.1 Forbury Place 43 Forbury Road Reading RG1 3JH Registered In England & Wales No.04094290</p> <p>If you're unsure & need to seek advice before commencing excavations, please contact: General Enquiries: 0800 048 3516</p> <p>Subject to revision – Master held by SSEN Asset Data Team: Asset.Data@sse.com 01256 337 294</p>
LV (Low Voltage) and Services	Up to 1,000V																										
HV (High Voltage)	Over 1,000V to 11,000V																										
EHV (Extra High Voltage)	22,000V to 132,000V																										
Transmission	275,000V and 400,000V																										
Services	LV	HV	EHV																								
Footpath/Unmade	0.45m	0.45m	0.6m																								
Road Crossing	0.6m	0.6m	0.75m																								
Agricultural	1m	1m	1.1m																								
<p>Scale: 1:500 (When plotted at A4)</p> <p><small>BASED UPON THE ORDNANCE SURVEY MAP WITH THE SANCTION OF THE CONTROLLER OF HM STATIONERY OFFICE CROWN COPYRIGHT RESERVED. This copy has been made by or with the authority of Scottish and Southern Energy Power Distribution Ltd. Pursuant to section 47 of the Copyright, Designs and Patents Act 1988 ("The Act"). Unless the Act provides a relevant exception to copyright the copy must not be copied without prior permission of the copyright owner. Plans generated by DigSAFE Pro™ software provided by Linesearchbeforedig.</small></p>																											

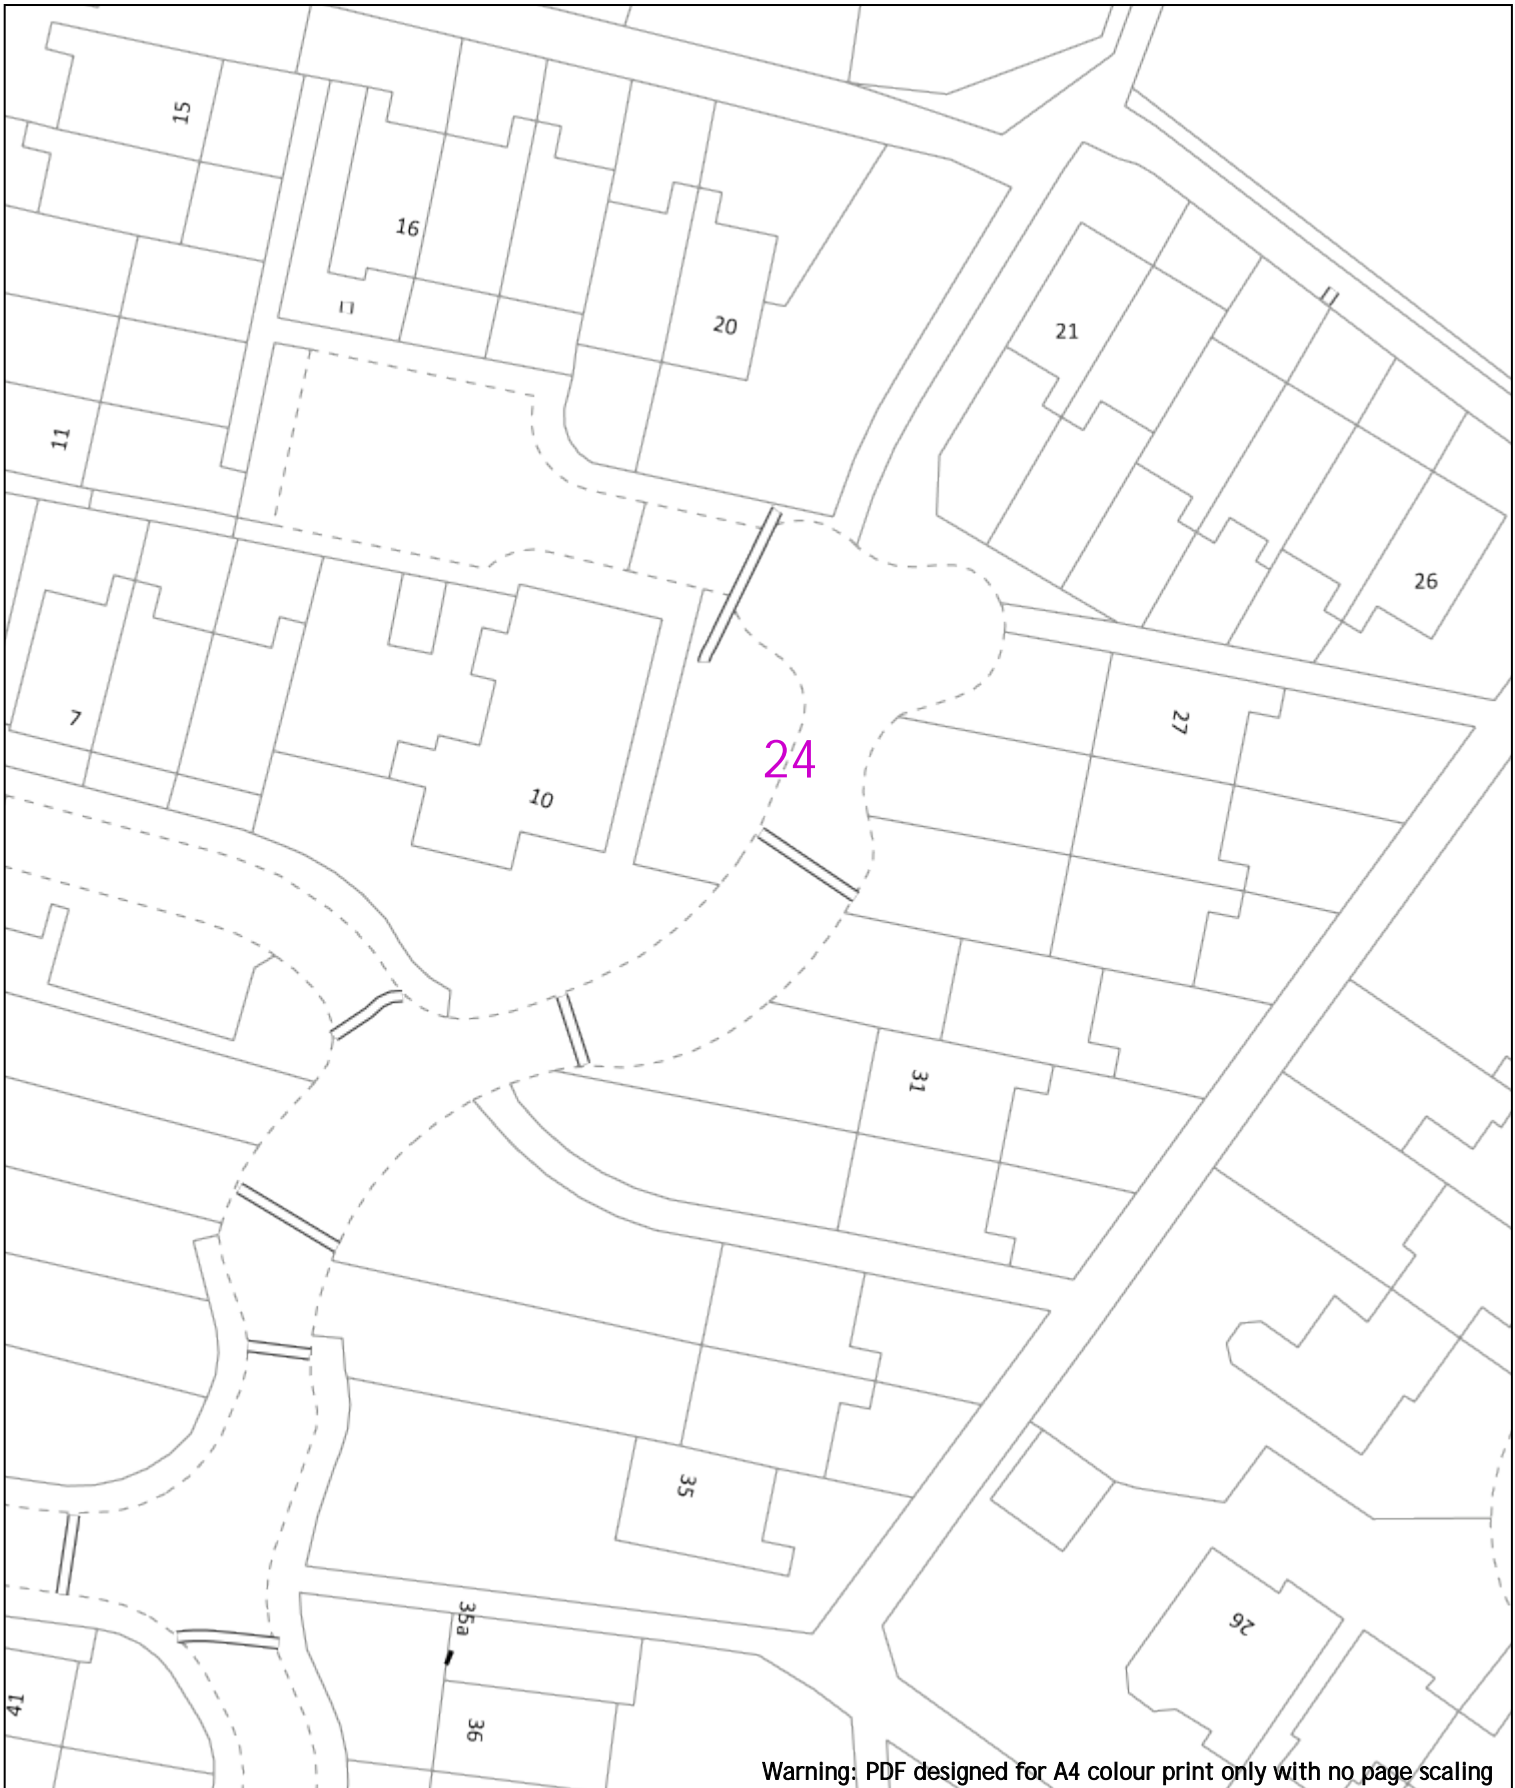

Warning: PDF designed for A4 colour print only with no page scaling

<p>0 20m</p>	<p>Dig Sites Area: Line: </p>	<p>Extra High Voltage cables in vicinity</p>																									
<p>Date Requested: 24/06/2022 Job Reference: 25881010 Site Location: 448066 213346 Requested by: Mr Joe Shawyer Your Scheme/Reference: 31188_002</p>	<p>Voltages (V)</p> <table border="1"> <tr> <td>LV (Low Voltage) and Services</td> <td>Up to 1,000V</td> </tr> <tr> <td>HV (High Voltage)</td> <td>Over 1,000V to 11,000V</td> </tr> <tr> <td>EHV (Extra High Voltage)</td> <td>22,000V to 132,000V</td> </tr> <tr> <td>Transmission</td> <td>275,000V and 400,000V</td> </tr> </table> <p>NORMAL DEPTH TO THE TOP OF THE CABLE WHEN LAID</p> <table border="1"> <thead> <tr> <th>Services</th> <th>LV</th> <th>HV</th> <th>EHV</th> </tr> </thead> <tbody> <tr> <td>Footpath/Unmade</td> <td>0.45m</td> <td>0.45m</td> <td>0.6m</td> </tr> <tr> <td>Road Crossing</td> <td>0.6m</td> <td>0.6m</td> <td>0.75m</td> </tr> <tr> <td>Agricultural</td> <td>1m</td> <td>1m</td> <td>1.1m</td> </tr> </tbody> </table>	LV (Low Voltage) and Services	Up to 1,000V	HV (High Voltage)	Over 1,000V to 11,000V	EHV (Extra High Voltage)	22,000V to 132,000V	Transmission	275,000V and 400,000V	Services	LV	HV	EHV	Footpath/Unmade	0.45m	0.45m	0.6m	Road Crossing	0.6m	0.6m	0.75m	Agricultural	1m	1m	1.1m	<p>Legend</p> <ul style="list-style-type: none"> Service Cable LV Mains 6.6kV 11kV 22kV 33kV 66kV 132kV 275kV 400kV Fibre Optic Pipit Cable <p>Distribution Structures (Electric)</p> <ul style="list-style-type: none"> Pole, Existing Location Pole Structure, Existing Location - Single Pole Structure, Existing Location - H Duct Route Cross Section Route 	<p style="text-align: center;">Southern Electric Power Distribution plc Registered Office: No.1 Forbury Place 43 Forbury Road Reading RG1 3JH Registered In England & Wales No.04094290</p> <p>If you're unsure & need to seek advice before commencing excavations, please contact: General Enquiries: 0800 048 3516</p> <p>Subject to revision – Master held by SSEN Asset Data Team: Asset.Data@sse.com 01256 337 294</p>
LV (Low Voltage) and Services	Up to 1,000V																										
HV (High Voltage)	Over 1,000V to 11,000V																										
EHV (Extra High Voltage)	22,000V to 132,000V																										
Transmission	275,000V and 400,000V																										
Services	LV	HV	EHV																								
Footpath/Unmade	0.45m	0.45m	0.6m																								
Road Crossing	0.6m	0.6m	0.75m																								
Agricultural	1m	1m	1.1m																								
<p style="font-size: small;">Scale: 1:500 (When plotted at A4)</p> <p style="font-size: x-small; text-align: center;"> BASED UPON THE ORDNANCE SURVEY MAP WITH THE SANCTION OF THE CONTROLLER OF HM STATIONERY OFFICE CROWN COPYRIGHT RESERVED. This copy has been made by or with the authority of Scottish and Southern Energy Power Distribution Ltd. Pursuant to section 47 of the Copyright, Designs and Patents Act 1988 ("The Act"). Unless the Act provides a relevant exception to copyright the copy must not be copied without prior permission of the copyright owner. Plans generated by DigSAFE Pro™ software provided by LinesearchbeforeDig. </p>																											

Warning: PDF designed for A4 colour print only with no page scaling

0 20m Dig Sites Area: Line:

**Extra High Voltage
cables in vicinity**



Date Requested: 24/06/2022
 Job Reference: 25881010
 Site Location: 448066 213346
 Requested by: Mr Joe Shawyer
 Your Scheme/Reference: 31188_002

Voltages (V)			
LV (Low Voltage) and Services	Up to 1,000V		
HV (High Voltage)	Over 1,000V to 11,000V		
EHV (Extra High Voltage)	22,000V to 132,000V		
Transmission	275,000V and 400,000V		
NORMAL DEPTH TO THE TOP OF THE CABLE WHEN LAID			
Services	LV	HV	EHV
Footpath/Unmade	0.45m	0.45m	0.6m 0.8m
Road Crossing	0.6m	0.6m	0.75m 0.9m
Agricultural	1m	1m	1m 1.1m

<p>Legend</p> <ul style="list-style-type: none"> Service Cable LV Mains 2 - 11kV 66kV 11kV 22kV 33kV 66kV 132kV 275kV 400kV Fibre Optic Pipit Cable 	<p>Distribution Structures (Electric)</p> <ul style="list-style-type: none"> Pole, Existing Location Pole Structure, Existing Location - Single Pole Structure, Existing Location - H Duct Route Cross Section Route
--	---

WARNING
 There may have been subsequent alteration to the surface levels. Trial holes must be undertaken to determine position and depths of cables. HS (G) 47 Booklet from the Health and Safety Executive - Avoiding Danger from Buried Cables - should be consulted before commencing excavation work.
WHEN WORKING IN THE VICINITY OF OVERHEAD LINES THE HEALTH AND SAFETY GUIDANCE NOTES G56 SHOULD BE CONSULTED (AVAILABLE FROM THE HSE WEBSITE)

Southern Electric Power Distribution plc
 Registered Office: No.1 Forbury Place
 43 Forbury Road Reading RG1 3JH
 Registered In England & Wales No.04094290

If you're unsure & need to seek advice before commencing excavations, please contact:
 General Enquiries: 0800 048 3516

Subject to revision - Master held by SSEN Asset Data Team:
Asset.Data@sse.com
 01256 337 294

Scale: 1:500 (When plotted at A4)

Warning: PDF designed for A4 colour print only with no page scaling

0 20m

Dig Sites Area: Line:

Extra High Voltage cables in vicinity



Date Requested: 24/06/2022
 Job Reference: 25881010
 Site Location: 448066 213346
 Requested by: Mr Joe Shawyer
 Your Scheme/Reference: 31188_002

Voltages (V)			
LV (Low Voltage) and Services	Up to 1,000V		
HV (High Voltage)	Over 1,000V to 11,000V		
EHV (Extra High Voltage)	22,000V to 132,000V		
Transmission	275,000V and 400,000V		
NORMAL DEPTH TO THE TOP OF THE CABLE WHEN LAID			
Services	LV	HV	EHV
Footpath/Unmade	0.45m	0.45m	0.6m 0.8m
Road Crossing	0.6m	0.6m	0.75m 0.9m
Agricultural	1m	1m	1m 1.1m

Legend	
	Service Cable
	LV Mains
	11kV
	22kV
	33kV
	66kV
	132kV
	275kV
	400kV
	Fibre Optic
	Pipe Cable

Distribution Structures (Electric)	
	Pole, Existing Location
	Pole Structure, Existing Location - Single
	Pole Structure, Existing Location - H
	Duct Route
	Cross Section Route


Southern Electric Power Distribution plc
 Registered Office: No.1 Forbury Place
 43 Forbury Road Reading RG1 3JH
 Registered In England & Wales No.04094290

If you're unsure & need to seek advice before commencing excavations, please contact:
 General Enquiries: 0800 048 3516

Subject to revision – Master held by SSEN Asset Data Team:
Asset.Data@sse.com
 01256 337 294

Scale: 1:500 (When plotted at A4)


WARNING
 There may have been subsequent alteration to the surface levels. Trial holes must be undertaken to determine position and depths of cables. HS (G) 47 Booklet from the Health and Safety Executive – Avoiding Danger from Buried Cables – should be consulted before commencing excavation work.
WHEN WORKING IN THE VICINITY OF OVERHEAD LINES THE HEALTH AND SAFETY GUIDANCE NOTES G56 SHOULD BE CONSULTED (AVAILABLE FROM THE HSE WEBSITE)

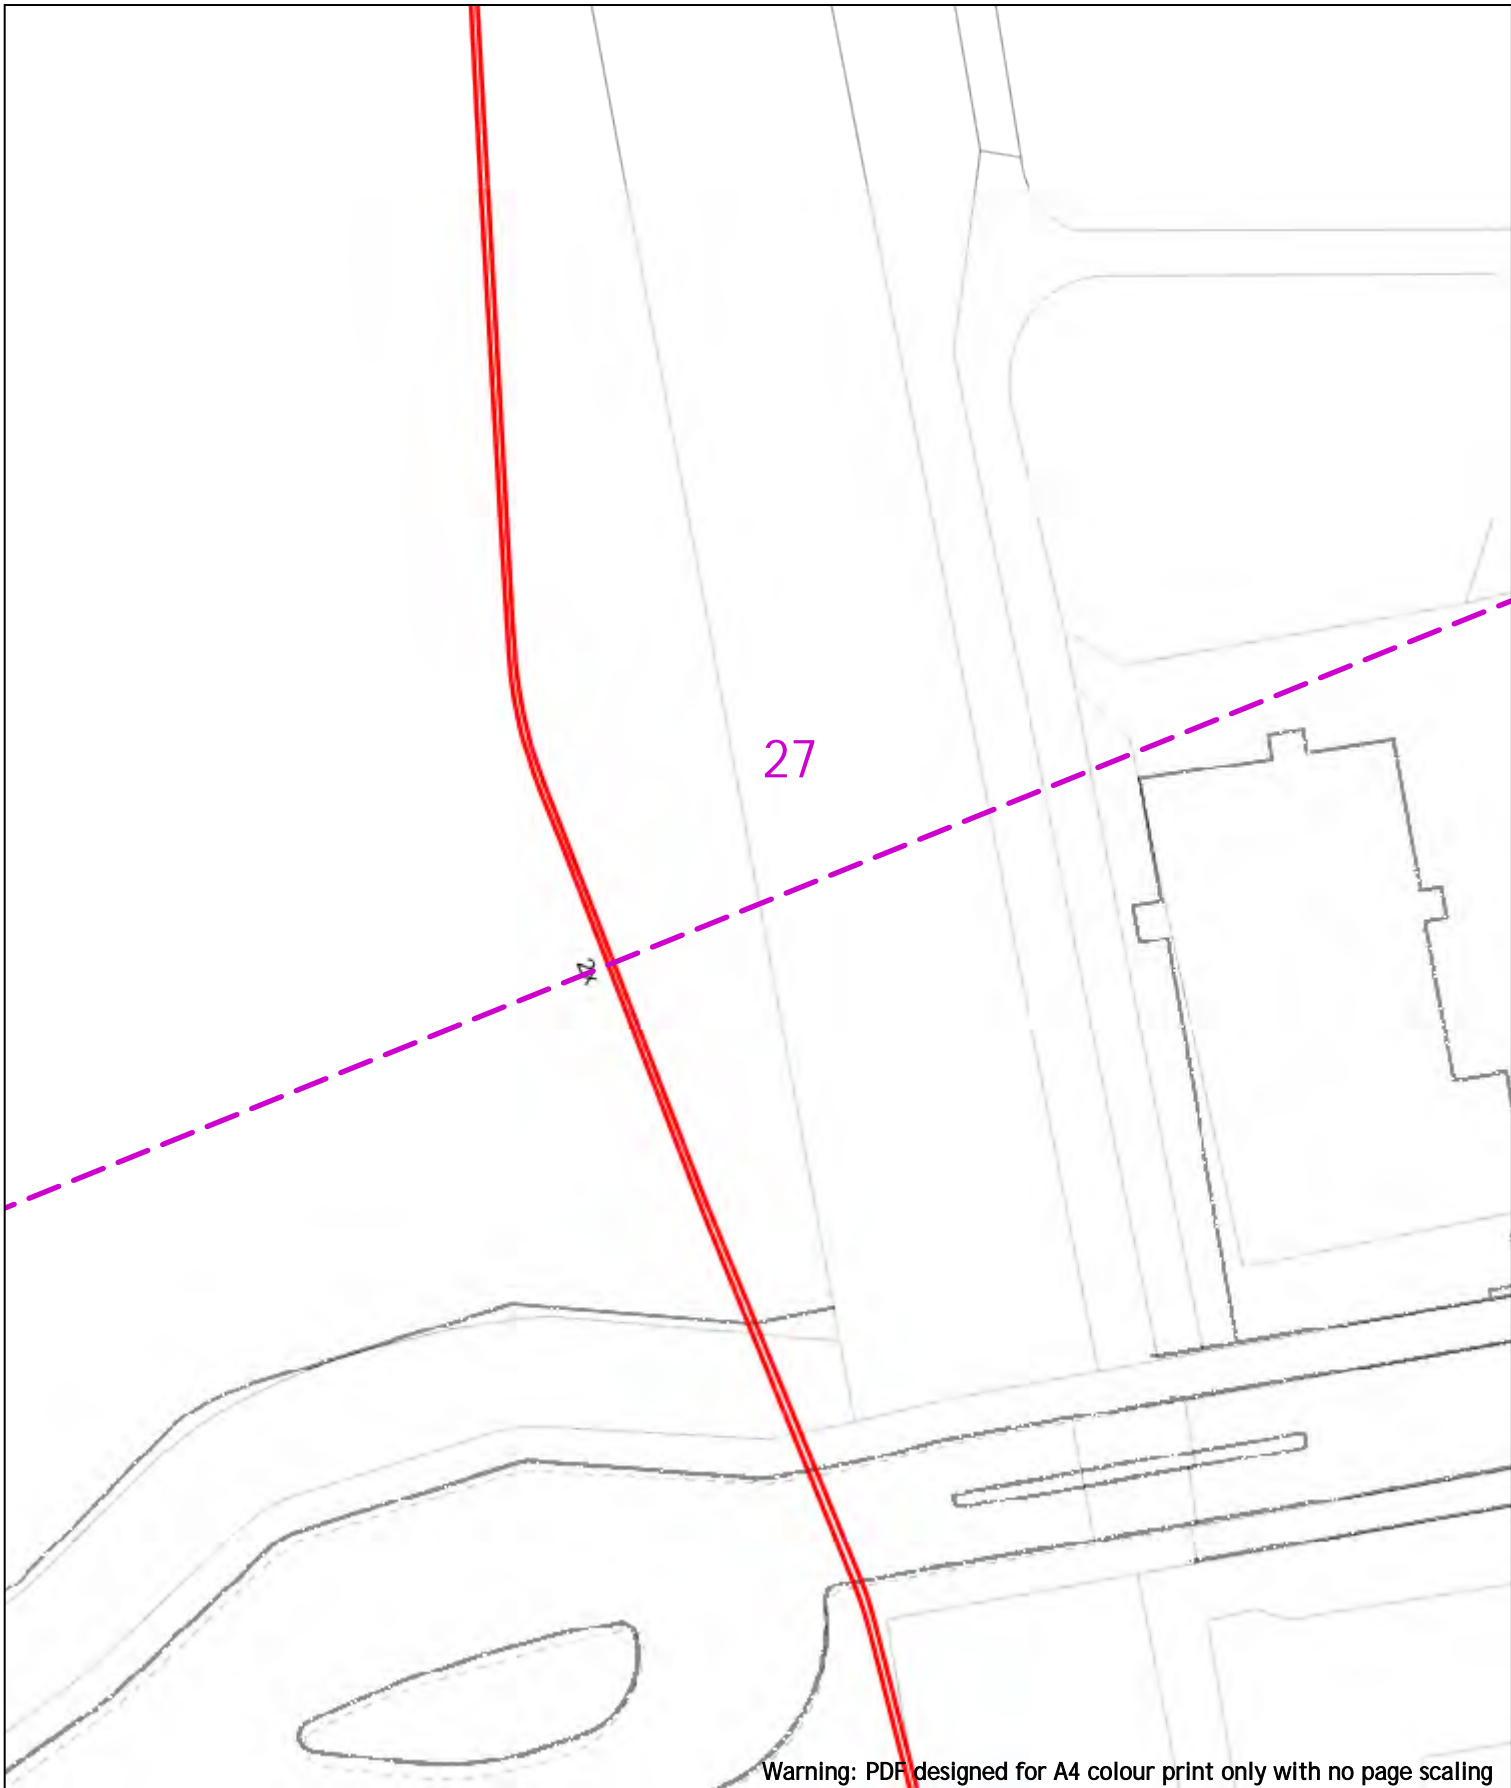

Warning: PDF designed for A4 colour print only with no page scaling

<p>0 20m</p> <p>Date Requested: 24/06/2022 Job Reference: 25881010 Site Location: 448066 213346 Requested by: Mr Joe Shawyer Your Scheme/Reference: 31188_002</p>	<p>Dig Sites Area: Line: </p> <p style="text-align: center; background-color: red; color: white; padding: 2px;">Extra High Voltage cables in vicinity</p>	<p> </p> <p style="text-align: center;">Southern Electric Power Distribution plc Registered Office: No.1 Forbury Place 43 Forbury Road Reading RG1 3JH Registered In England & Wales No.04094290</p> <p style="font-size: small;">If you're unsure & need to seek advice before commencing excavations, please contact: General Enquiries: 0800 048 3516</p> <p style="font-size: small;">Subject to revision – Master held by SSEN Asset Data Team: Asset.Data@sse.com 01256 337 294</p>	
<p>Scale: 1:500 (When plotted at A4)</p>	<table border="1" style="width: 100%; border-collapse: collapse; font-size: x-small;"> <thead> <tr> <th colspan="4">Voltages (V)</th> </tr> </thead> <tbody> <tr> <td>LV (Low Voltage) and Services</td> <td colspan="3">Up to 1,000V</td> </tr> <tr> <td>HV (High Voltage)</td> <td colspan="3">Over 1,000V to 11,000V</td> </tr> <tr> <td>EHV (Extra High Voltage)</td> <td colspan="3">22,000V to 132,000V</td> </tr> <tr> <td>Transmission</td> <td colspan="3">275,000V and 400,000V</td> </tr> <tr> <th colspan="4">NORMAL DEPTH TO THE TOP OF THE CABLE WHEN LAID</th> </tr> <tr> <td>Services</td> <td>LV</td> <td>HV</td> <td>EHV</td> </tr> <tr> <td>Footpath/Unmade</td> <td>0.45m</td> <td>0.45m</td> <td>0.6m</td> </tr> <tr> <td>Road Crossing</td> <td>0.6m</td> <td>0.6m</td> <td>0.75m</td> </tr> <tr> <td>Agricultural</td> <td>1m</td> <td>1m</td> <td>1.1m</td> </tr> </tbody> </table> <p style="font-size: x-small; text-align: center;">WARNING There may have been subsequent alteration to the surface levels. Trial holes must be undertaken to determine position and depths of cables. HS (G) 47 Booklet from the Health and Safety Executive – Avoiding Danger from Buried Cables – should be consulted before commencing excavation work. WHEN WORKING IN THE VICINITY OF OVERHEAD LINES THE HEALTH AND SAFETY GUIDANCE NOTES G56 SHOULD BE CONSULTED (AVAILABLE FROM THE HSE WEBSITE)</p>	Voltages (V)				LV (Low Voltage) and Services	Up to 1,000V			HV (High Voltage)	Over 1,000V to 11,000V			EHV (Extra High Voltage)	22,000V to 132,000V			Transmission	275,000V and 400,000V			NORMAL DEPTH TO THE TOP OF THE CABLE WHEN LAID				Services	LV	HV	EHV	Footpath/Unmade	0.45m	0.45m	0.6m	Road Crossing	0.6m	0.6m	0.75m	Agricultural	1m	1m	1.1m	<table border="1" style="width: 100%; border-collapse: collapse; font-size: x-small;"> <thead> <tr> <th colspan="2">Legend</th> <th colspan="2">Distribution Structures (Electric)</th> </tr> </thead> <tbody> <tr> <td></td> <td>Service Cable</td> <td></td> <td>Pole, Existing Location</td> </tr> <tr> <td></td> <td>LV Mains</td> <td></td> <td>Pole Structure, Existing Location - Single</td> </tr> <tr> <td></td> <td>6.6kV</td> <td></td> <td>Pole Structure, Existing Location - H</td> </tr> <tr> <td></td> <td>11kV</td> <td></td> <td>Duct Route</td> </tr> <tr> <td></td> <td>22kV</td> <td></td> <td>Cross Section Route</td> </tr> <tr> <td></td> <td>33kV</td> <td></td> <td></td> </tr> <tr> <td></td> <td>66kV</td> <td></td> <td></td> </tr> <tr> <td></td> <td>132kV</td> <td></td> <td></td> </tr> <tr> <td></td> <td>275kV</td> <td></td> <td></td> </tr> <tr> <td></td> <td>400kV</td> <td></td> <td></td> </tr> <tr> <td></td> <td>Fibre Optic</td> <td></td> <td></td> </tr> <tr> <td></td> <td>Pipe Cable</td> <td></td> <td></td> </tr> </tbody> </table>	Legend		Distribution Structures (Electric)			Service Cable		Pole, Existing Location		LV Mains		Pole Structure, Existing Location - Single		6.6kV		Pole Structure, Existing Location - H		11kV		Duct Route		22kV		Cross Section Route		33kV				66kV				132kV				275kV				400kV				Fibre Optic				Pipe Cable		
Voltages (V)	
LV (Low Voltage) and Services	Up to 1,000V	
HV (High Voltage)	Over 1,000V to 11,000V	
EHV (Extra High Voltage)	22,000V to 132,000V	
Transmission	275,000V and 400,000V	
NORMAL DEPTH TO THE TOP OF THE CABLE WHEN LAID	
Services	LV	HV	EHV	
Footpath/Unmade	0.45m	0.45m	0.6m	
Road Crossing	0.6m	0.6m	0.75m	
Agricultural	1m	1m	1.1m	
Legend		Distribution Structures (Electric)	
	Service Cable		Pole, Existing Location	
	LV Mains		Pole Structure, Existing Location - Single	
	6.6kV		Pole Structure, Existing Location - H	
	11kV		Duct Route	
	22kV		Cross Section Route	
	33kV	
	66kV	
	132kV	
	275kV	
	400kV	
	Fibre Optic	
	Pipe Cable	


BASED UPON THE ORDNANCE SURVEY MAP WITH THE SANCTION OF THE CONTROLLER OF HM STATIONERY OFFICE CROWN COPYRIGHT RESERVED.
 This copy has been made by or with the authority of Scottish and Southern Energy Power Distribution Ltd. Pursuant to section 47 of the Copyright, Designs and Patents Act 1988 ("The Act"). Unless the Act provides a relevant exception to copyright the copy must not be copied without prior permission of the copyright owner.
 Plans generated by DigSAFE Pro™ software provided by LinesearchbeforeDig.

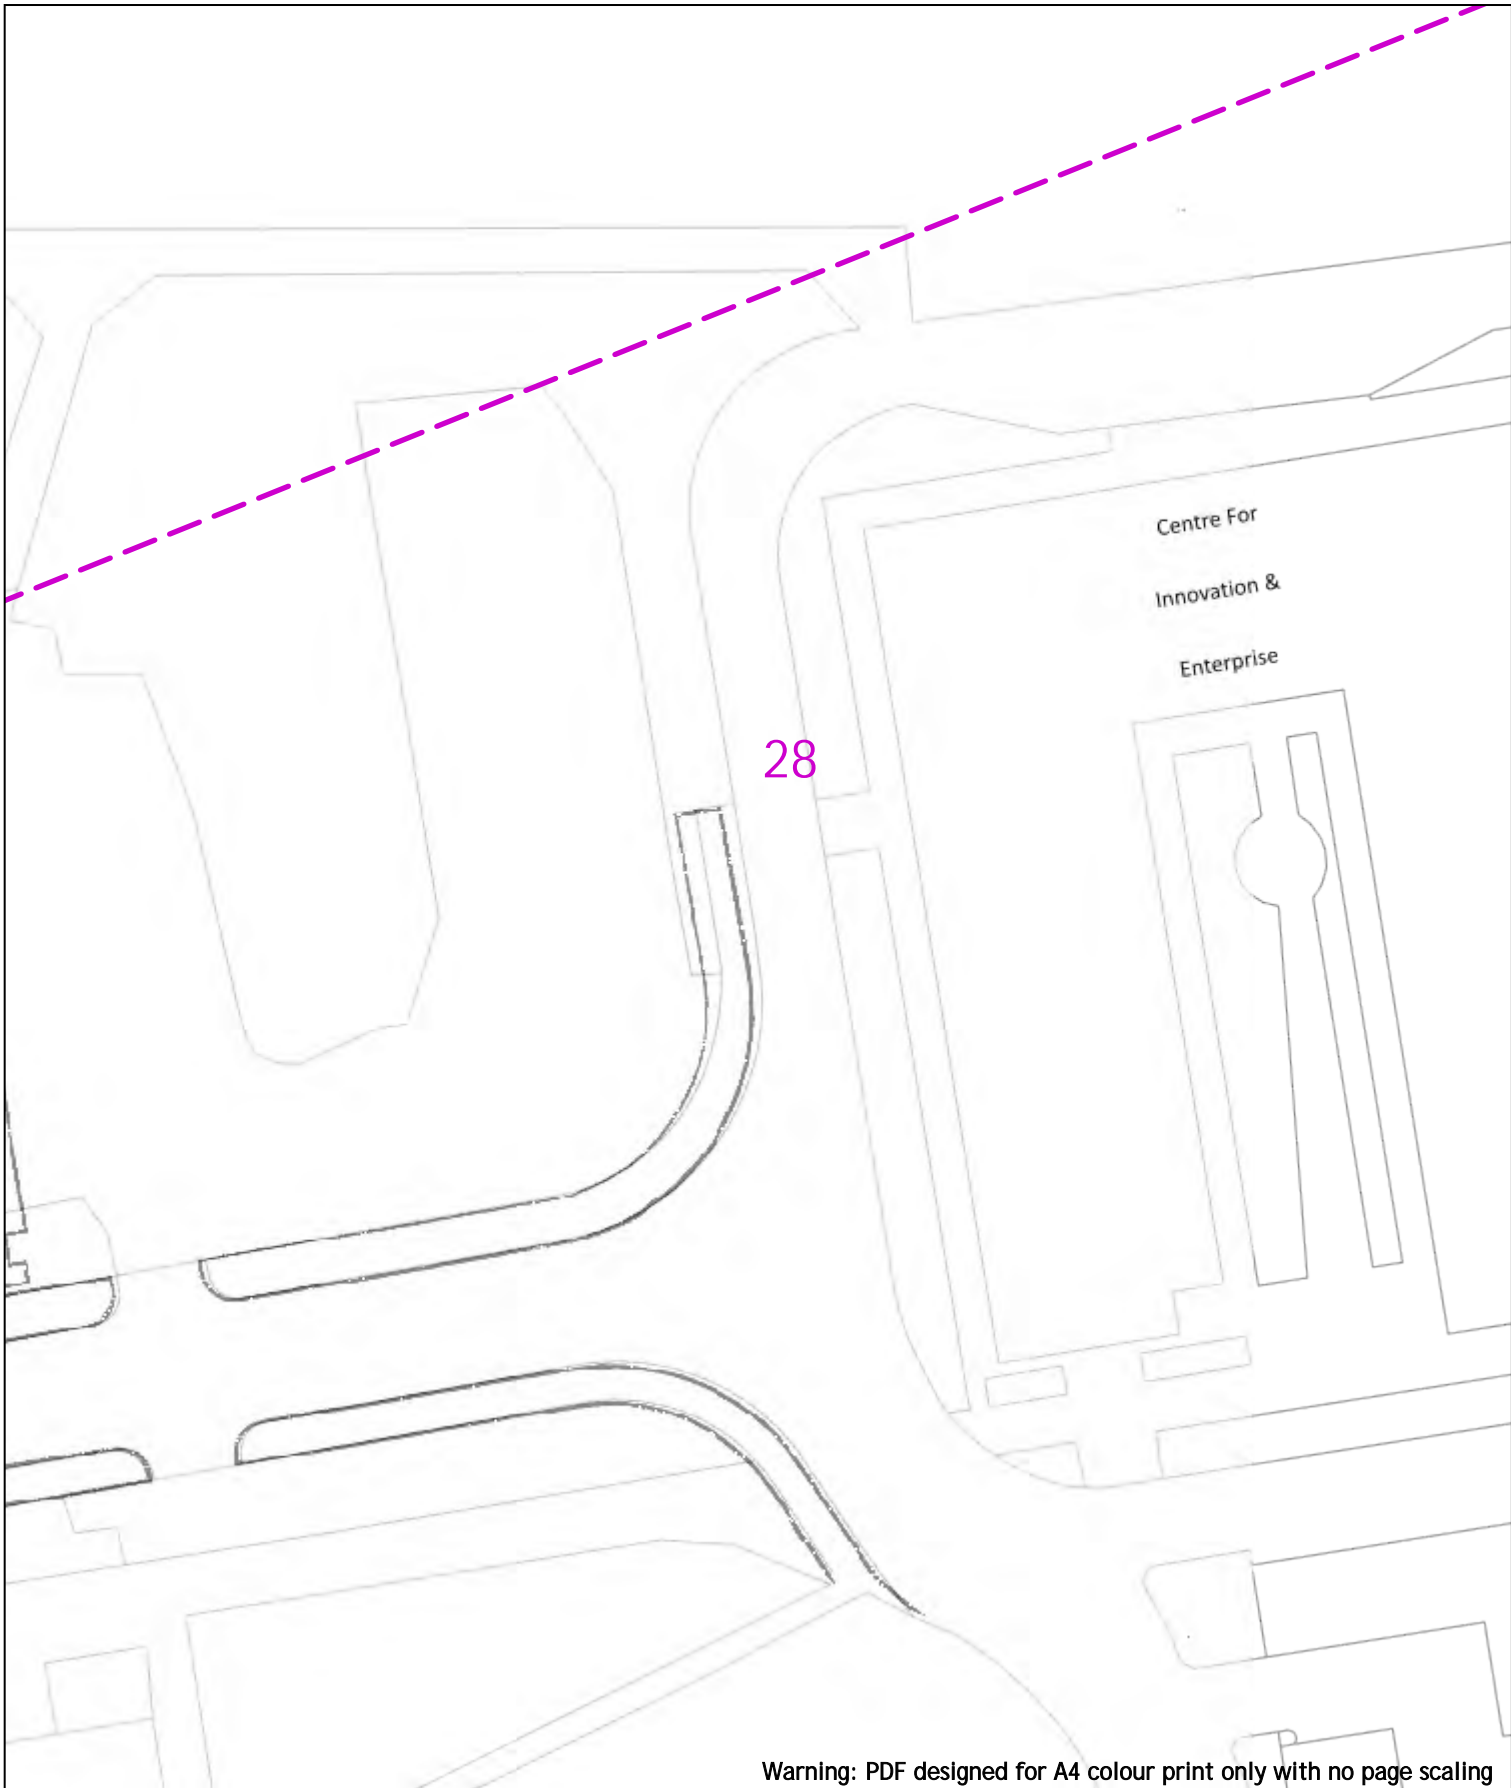

Warning: PDF designed for A4 colour print only with no page scaling

<p>0 20m Dig Sites Area: Line: Extra High Voltage cables in vicinity</p>	
<p>Date Requested: 24/06/2022 Job Reference: 25881010 Site Location: 448066 213346 Requested by: Mr Joe Shawyer Your Scheme/Reference: 31188_002</p>	<table border="1"> <thead> <tr> <th colspan="4">Voltages (V)</th> </tr> </thead> <tbody> <tr> <td>LV (Low Voltage) and Services</td> <td colspan="3">Up to 1,000V</td> </tr> <tr> <td>HV (High Voltage)</td> <td colspan="3">Over 1,000V to 11,000V</td> </tr> <tr> <td>EHV (Extra High Voltage)</td> <td colspan="3">22,000V to 132,000V</td> </tr> <tr> <td>Transmission</td> <td colspan="3">275,000V and 400,000V</td> </tr> </tbody> </table> <table border="1"> <thead> <tr> <th colspan="4">NORMAL DEPTH TO THE TOP OF THE CABLE WHEN LAID</th> </tr> <tr> <th>Services</th> <th>LV</th> <th>HV</th> <th>EHV</th> </tr> </thead> <tbody> <tr> <td>Footpath/Unmade</td> <td>0.45m</td> <td>0.45m</td> <td>0.8m</td> </tr> <tr> <td>Road Crossing</td> <td>0.6m</td> <td>0.6m</td> <td>0.9m</td> </tr> <tr> <td>Agricultural</td> <td>1m</td> <td>1m</td> <td>1.1m</td> </tr> </tbody> </table>	Voltages (V)				LV (Low Voltage) and Services	Up to 1,000V			HV (High Voltage)	Over 1,000V to 11,000V			EHV (Extra High Voltage)	22,000V to 132,000V			Transmission	275,000V and 400,000V			NORMAL DEPTH TO THE TOP OF THE CABLE WHEN LAID				Services	LV	HV	EHV	Footpath/Unmade	0.45m	0.45m	0.8m	Road Crossing	0.6m	0.6m	0.9m	Agricultural	1m	1m	1.1m	<table border="1"> <thead> <tr> <th colspan="2">Legend</th> </tr> </thead> <tbody> <tr> <td></td> <td>Service Cable</td> </tr> <tr> <td></td> <td>LV Mains</td> </tr> <tr> <td></td> <td>2 - 11kV</td> </tr> <tr> <td></td> <td>66kV</td> </tr> <tr> <td></td> <td>11kV</td> </tr> <tr> <td></td> <td>22kV</td> </tr> <tr> <td></td> <td>33kV</td> </tr> <tr> <td></td> <td>66kV</td> </tr> <tr> <td></td> <td>132kV</td> </tr> <tr> <td></td> <td>275kV</td> </tr> <tr> <td></td> <td>400kV</td> </tr> <tr> <td></td> <td>Fibre Optic</td> </tr> <tr> <td></td> <td>Pipe Cable</td> </tr> </tbody> </table> <table border="1"> <thead> <tr> <th colspan="2">Distribution Structures (Electric)</th> </tr> </thead> <tbody> <tr> <td></td> <td>Pole, Existing Location</td> </tr> <tr> <td></td> <td>Pole Structure, Existing Location - Single</td> </tr> <tr> <td></td> <td>Pole Structure, Existing Location - H</td> </tr> <tr> <td></td> <td>Duct Route</td> </tr> <tr> <td></td> <td>Cross Section Route</td> </tr> </tbody> </table> <p>WARNING There may have been subsequent alteration to the surface levels. Trial holes must be undertaken to determine position and depths of cables. HS (G) 47 Booklet from the Health and Safety Executive - Avoiding Danger from Buried Cables - should be consulted before commencing excavation work. WHEN WORKING IN THE VICINITY OF OVERHEAD LINES THE HEALTH AND SAFETY GUIDANCE NOTES G56 SHOULD BE CONSULTED (AVAILABLE FROM THE HSE WEBSITE)</p>	Legend			Service Cable		LV Mains		2 - 11kV		66kV		11kV		22kV		33kV		66kV		132kV		275kV		400kV		Fibre Optic		Pipe Cable	Distribution Structures (Electric)			Pole, Existing Location		Pole Structure, Existing Location - Single		Pole Structure, Existing Location - H		Duct Route		Cross Section Route
Voltages (V)	
LV (Low Voltage) and Services	Up to 1,000V	
HV (High Voltage)	Over 1,000V to 11,000V	
EHV (Extra High Voltage)	22,000V to 132,000V	
Transmission	275,000V and 400,000V	
NORMAL DEPTH TO THE TOP OF THE CABLE WHEN LAID	
Services	LV	HV	EHV	
Footpath/Unmade	0.45m	0.45m	0.8m	
Road Crossing	0.6m	0.6m	0.9m	
Agricultural	1m	1m	1.1m	
Legend	
	Service Cable	
	LV Mains	
	2 - 11kV	
	66kV	
	11kV	
	22kV	
	33kV	
	66kV	
	132kV	
	275kV	
	400kV	
	Fibre Optic	
	Pipe Cable	
Distribution Structures (Electric)	
	Pole, Existing Location	
	Pole Structure, Existing Location - Single	
	Pole Structure, Existing Location - H	
	Duct Route	
	Cross Section Route	
<p>Scale: 1:500 (When plotted at A4)</p>		<p>Southern Electric Power Distribution plc Registered Office: No.1 Forbury Place 43 Forbury Road Reading RG1 3JH Registered In England & Wales No.04094290</p> <p>If you're unsure & need to seek advice before commencing excavations, please contact: General Enquiries: 0800 048 3516</p> <p>Subject to revision - Master held by SSEN Asset Data Team: Asset.Data@sse.com 01256 337 294</p>	


BASED UPON THE ORDNANCE SURVEY MAP WITH THE SANCTION OF THE CONTROLLER OF HM STATIONERY OFFICE CROWN COPYRIGHT RESERVED.
 This copy has been made by or with the authority of Scottish and Southern Energy Power Distribution Ltd. Pursuant to section 47 of the Copyright, Designs and Patents Act 1988 ("The Act"). Unless the Act provides a relevant exception to copyright the copy must not be copied without prior permission of the copyright owner.
 Plans generated by DigSAFE Pro™ software provided by LinesearchbeforeDig.

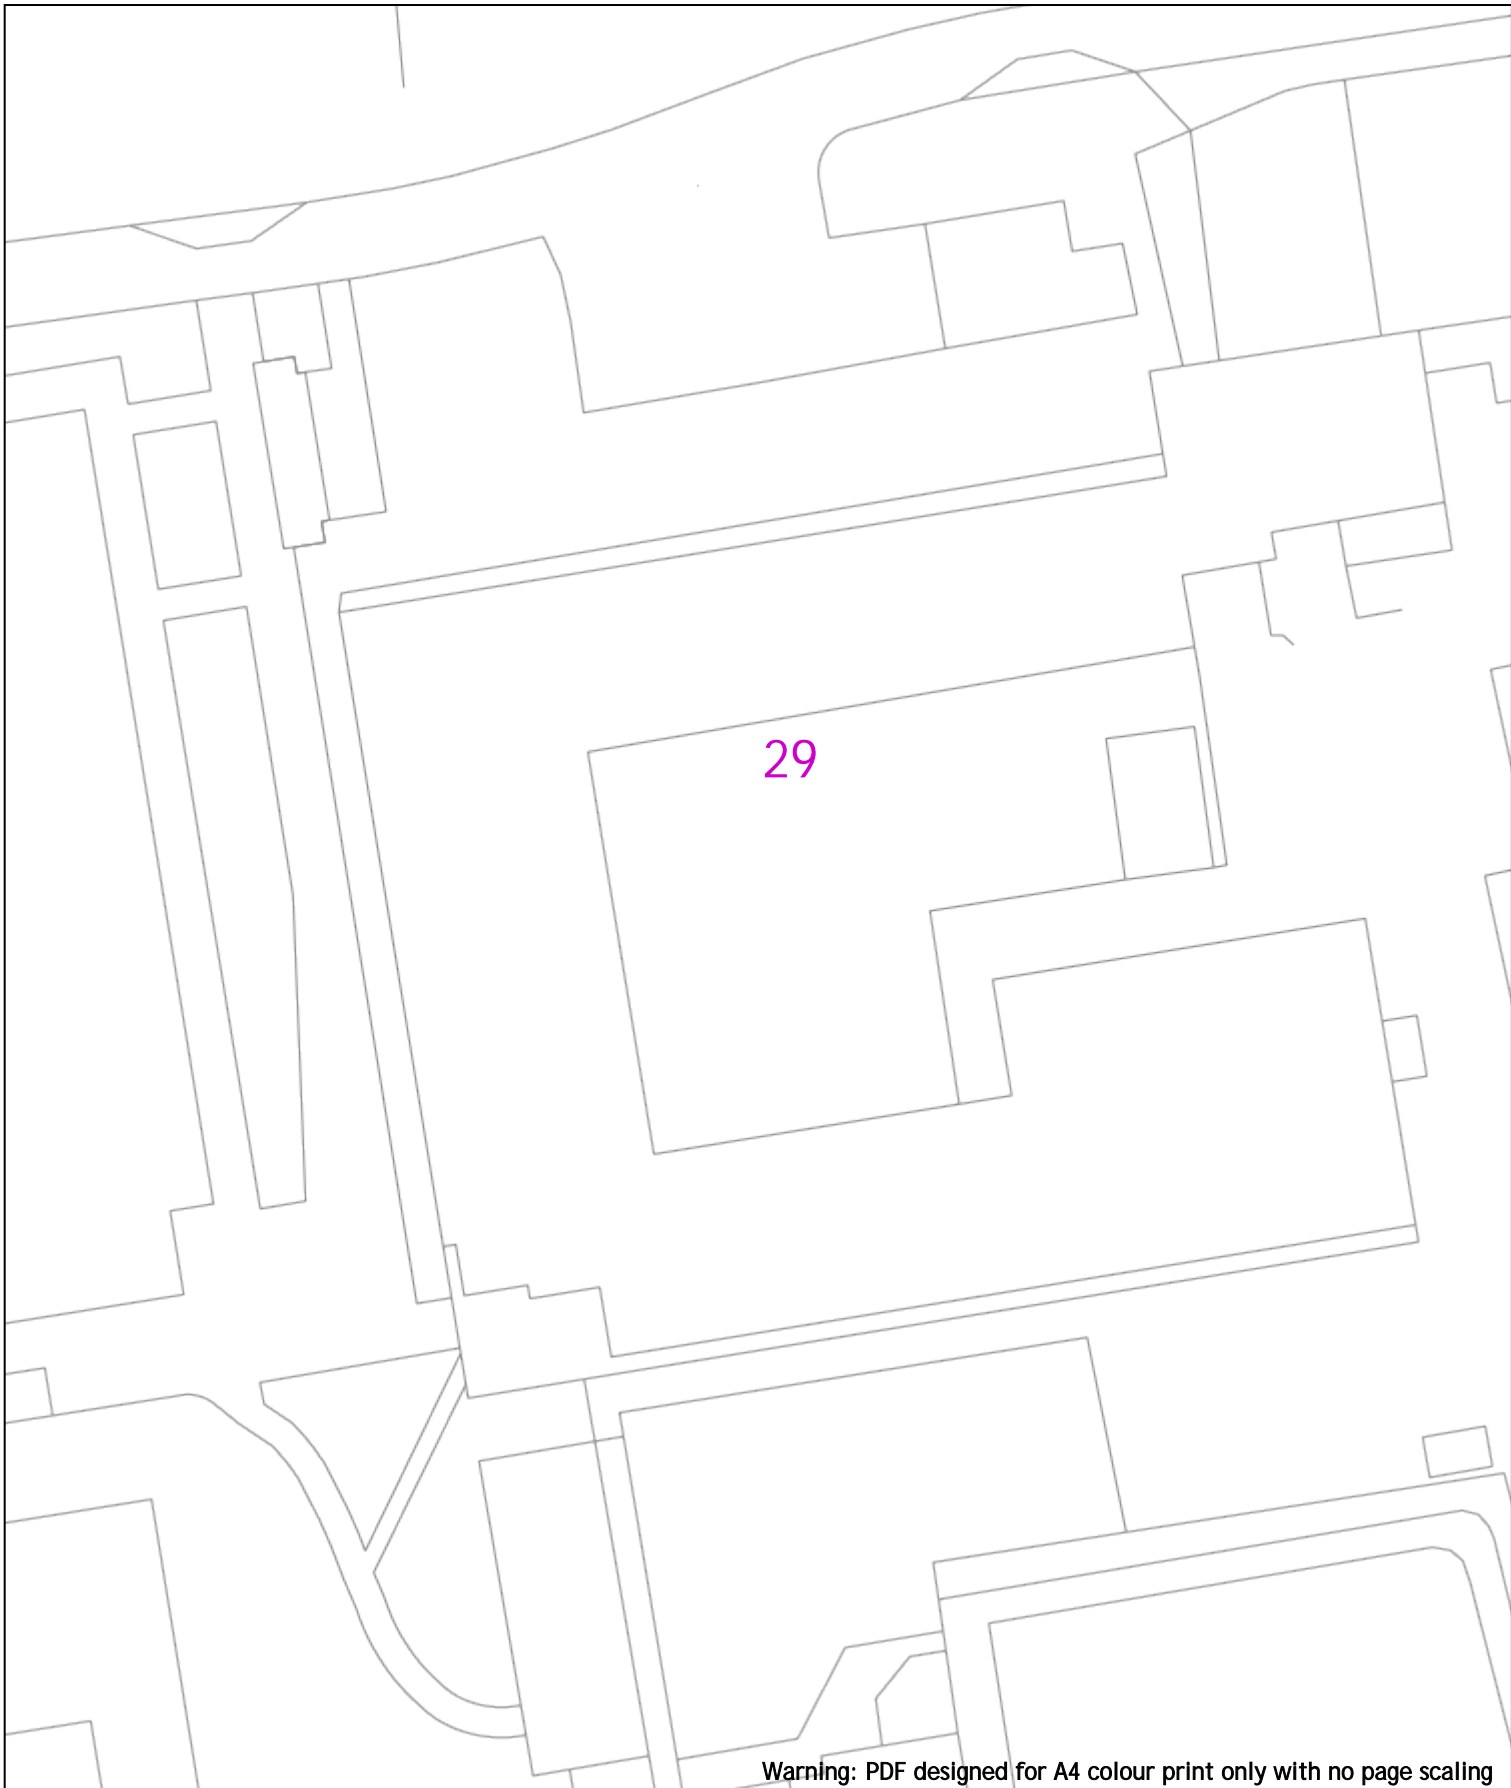

Warning: PDF designed for A4 colour print only with no page scaling

<p>0 20m</p> <p>Date Requested: 24/06/2022 Job Reference: 25881010 Site Location: 448066 213346 Requested by: Mr Joe Shawyer Your Scheme/Reference: 31188_002</p>	<p>Dig Sites Area: Line: </p> <p style="text-align: center;">Extra High Voltage cables in vicinity</p>	
<p>Scale: 1:500 (When plotted at A4)</p>	<table border="1" style="width: 100%; border-collapse: collapse;"> <thead> <tr> <th colspan="5">Voltages (V)</th> </tr> </thead> <tbody> <tr> <td>LV (Low Voltage) and Services</td> <td colspan="4">Up to 1,000V</td> </tr> <tr> <td>HV (High Voltage)</td> <td colspan="4">Over 1,000V to 11,000V</td> </tr> <tr> <td>EHV (Extra High Voltage)</td> <td colspan="4">22,000V to 132,000V</td> </tr> <tr> <td>Transmission</td> <td colspan="4">275,000V and 400,000V</td> </tr> <tr> <th colspan="5">NORMAL DEPTH TO THE TOP OF THE CABLE WHEN LAID</th> </tr> <tr> <td></td> <td>Services</td> <td>LV</td> <td>HV</td> <td>EHV</td> </tr> <tr> <td>Footpath/Unmade</td> <td>0.45m</td> <td>0.45m</td> <td>0.6m</td> <td>0.8m</td> </tr> <tr> <td>Road Crossing</td> <td>0.6m</td> <td>0.6m</td> <td>0.75m</td> <td>0.9m</td> </tr> <tr> <td>Agricultural</td> <td>1m</td> <td>1m</td> <td>1m</td> <td>1.1m</td> </tr> </tbody> </table> <p style="font-size: small; text-align: center;"> WARNING There may have been subsequent alteration to the surface levels. Trial holes must be undertaken to determine position and depths of cables. HS (G) 47 Booklet from the Health and Safety Executive – Avoiding Danger from Buried Cables – should be consulted before commencing excavation work. WHEN WORKING IN THE VICINITY OF OVERHEAD LINES THE HEALTH AND SAFETY GUIDANCE NOTES G66 SHOULD BE CONSULTED (AVAILABLE FROM THE HSE WEBSITE) </p>	Voltages (V)					LV (Low Voltage) and Services	Up to 1,000V				HV (High Voltage)	Over 1,000V to 11,000V				EHV (Extra High Voltage)	22,000V to 132,000V				Transmission	275,000V and 400,000V				NORMAL DEPTH TO THE TOP OF THE CABLE WHEN LAID						Services	LV	HV	EHV	Footpath/Unmade	0.45m	0.45m	0.6m	0.8m	Road Crossing	0.6m	0.6m	0.75m	0.9m	Agricultural	1m	1m	1m	1.1m	<p style="text-align: center;">Southern Electric Power Distribution plc Registered Office: No.1 Forbury Place 43 Forbury Road Reading RG1 3JH Registered In England & Wales No.04094290</p> <p style="font-size: small;"> If you're unsure & need to seek advice before commencing excavations, please contact: General Enquiries: 0800 048 3516 </p> <p style="font-size: small;"> Subject to revision – Master held by SSEN Asset Data Team: Asset.Data@sse.com 01256 337 294 </p>
Voltages (V)	
LV (Low Voltage) and Services	Up to 1,000V	
HV (High Voltage)	Over 1,000V to 11,000V	
EHV (Extra High Voltage)	22,000V to 132,000V	
Transmission	275,000V and 400,000V	
NORMAL DEPTH TO THE TOP OF THE CABLE WHEN LAID	
	Services	LV	HV	EHV	
Footpath/Unmade	0.45m	0.45m	0.6m	0.8m	
Road Crossing	0.6m	0.6m	0.75m	0.9m	
Agricultural	1m	1m	1m	1.1m	

BASED UPON THE ORDNANCE SURVEY MAP WITH THE SANCTION OF THE CONTROLLER OF HM STATIONERY OFFICE CROWN COPYRIGHT RESERVED.
 This copy has been made by or with the authority of Scottish and Southern Energy Power Distribution Ltd. Pursuant to section 47 of the Copyright, Designs and Patents Act 1988 ("The Act"). Unless the Act provides a relevant exception to copyright the copy must not be copied without prior permission of the copyright owner.
 Plans generated by DigSAFE Pro™ software provided by LinesearchbeforeUdig.

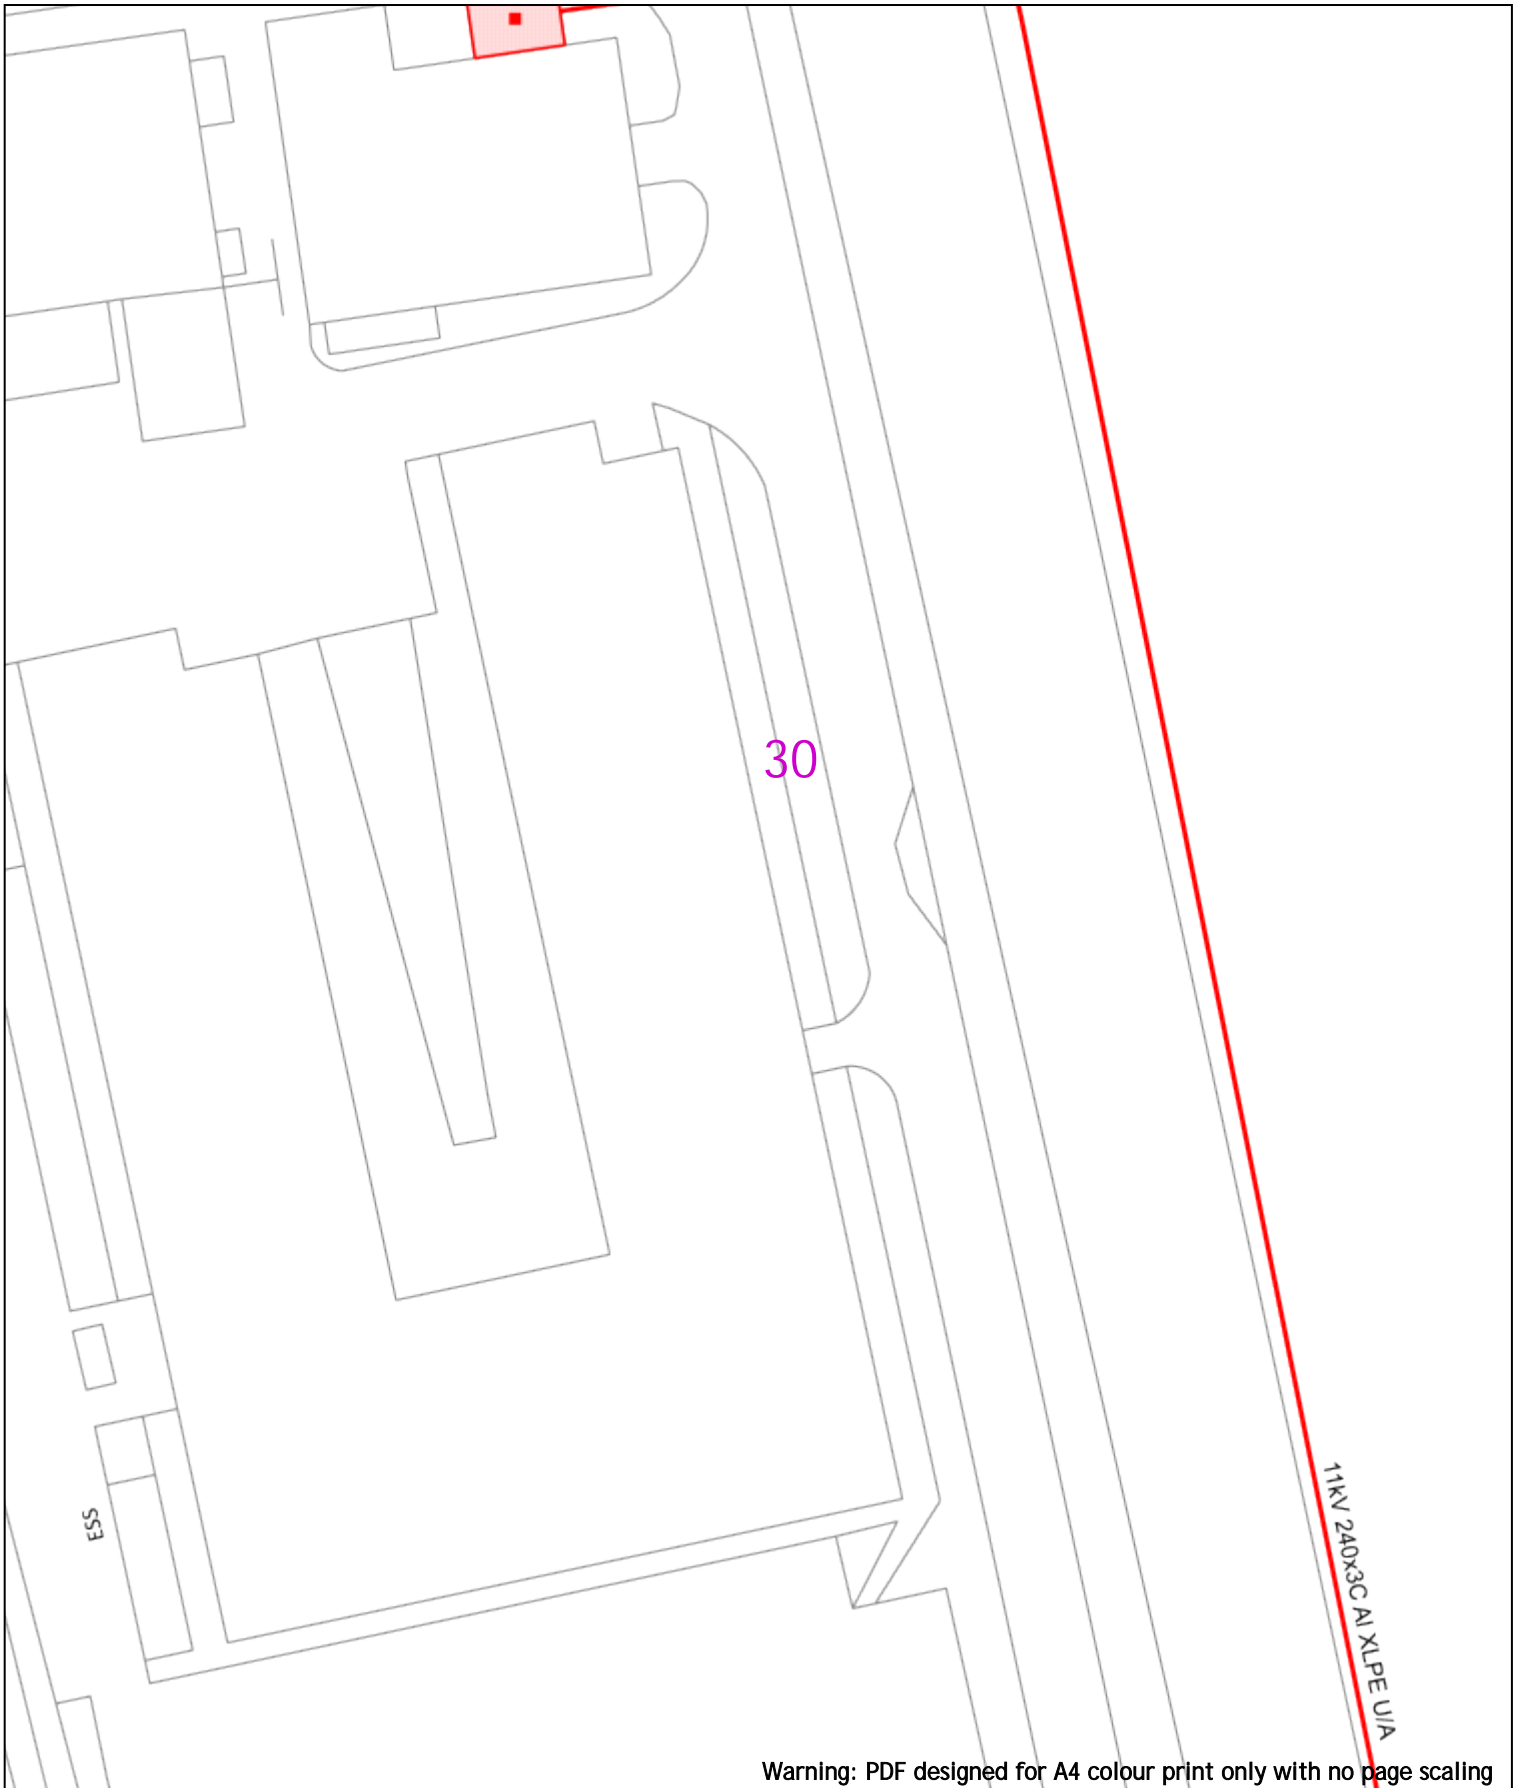

Warning: PDF designed for A4 colour print only with no page scaling

<p>0 20m Dig Sites Area: Line: Extra High Voltage cables in vicinity</p>	
<p>Date Requested: 24/06/2022 Job Reference: 25881010 Site Location: 448066 213346 Requested by: Mr Joe Shawyer Your Scheme/Reference: 31188_002</p>	<table border="1"> <thead> <tr> <th colspan="4">Voltages (V)</th> </tr> </thead> <tbody> <tr> <td>LV (Low Voltage) and Services</td> <td colspan="3">Up to 1,000V</td> </tr> <tr> <td>HV (High Voltage)</td> <td colspan="3">Over 1,000V to 11,000V</td> </tr> <tr> <td>EHV (Extra High Voltage)</td> <td colspan="3">22,000V to 132,000V</td> </tr> <tr> <td>Transmission</td> <td colspan="3">275,000V and 400,000V</td> </tr> </tbody> </table> <table border="1"> <thead> <tr> <th colspan="4">NORMAL DEPTH TO THE TOP OF THE CABLE WHEN LAID</th> </tr> <tr> <th>Services</th> <th>LV</th> <th>HV</th> <th>EHV</th> </tr> </thead> <tbody> <tr> <td>Footpath/Unmade</td> <td>0.45m</td> <td>0.45m</td> <td>0.6m</td> </tr> <tr> <td>Road Crossing</td> <td>0.6m</td> <td>0.6m</td> <td>0.75m</td> </tr> <tr> <td>Agricultural</td> <td>1m</td> <td>1m</td> <td>1.1m</td> </tr> </tbody> </table> <p>Legend</p> <ul style="list-style-type: none"> Service Cable LV Mains 66kV 11kV 22kV 33kV 66kV 132kV 275kV 400kV Fibre Optic Pipe Cable <p>Distribution Structures (Electric)</p> <ul style="list-style-type: none"> Pole, Existing Location Pole Structure, Existing Location - Single Pole Structure, Existing Location - H Duct Route Cross Section Route <p>WARNING There may have been subsequent alteration to the surface levels. Trial holes must be undertaken to determine position and depths of cables. HS (G) 47 Booklet from the Health and Safety Executive - Avoiding Danger from Buried Cables - should be consulted before commencing excavation work. WHEN WORKING IN THE VICINITY OF OVERHEAD LINES THE HEALTH AND SAFETY GUIDANCE NOTES G56 SHOULD BE CONSULTED (AVAILABLE FROM THE HSE WEBSITE)</p>	Voltages (V)				LV (Low Voltage) and Services	Up to 1,000V			HV (High Voltage)	Over 1,000V to 11,000V			EHV (Extra High Voltage)	22,000V to 132,000V			Transmission	275,000V and 400,000V			NORMAL DEPTH TO THE TOP OF THE CABLE WHEN LAID				Services	LV	HV	EHV	Footpath/Unmade	0.45m	0.45m	0.6m	Road Crossing	0.6m	0.6m	0.75m	Agricultural	1m	1m	1.1m
Voltages (V)	
LV (Low Voltage) and Services	Up to 1,000V	
HV (High Voltage)	Over 1,000V to 11,000V	
EHV (Extra High Voltage)	22,000V to 132,000V	
Transmission	275,000V and 400,000V	
NORMAL DEPTH TO THE TOP OF THE CABLE WHEN LAID	
Services	LV	HV	EHV																																						
Footpath/Unmade	0.45m	0.45m	0.6m																																						
Road Crossing	0.6m	0.6m	0.75m																																						
Agricultural	1m	1m	1.1m																																						
<p>Scale: 1:500 (When plotted at A4)</p>	<p>BASED UPON THE ORDNANCE SURVEY MAP WITH THE SANCTION OF THE CONTROLLER OF HM STATIONERY OFFICE CROWN COPYRIGHT RESERVED. This copy has been made by or with the authority of Scottish and Southern Energy Power Distribution Ltd. Pursuant to section 47 of the Copyright, Designs and Patents Act 1988 ("The Act"). Unless the Act provides a relevant exception to copyright the copy must not be copied without prior permission of the copyright owner. Plans generated by DigSAFE Pro™ software provided by Linesearchbeforedig.</p>	
<p>Southern Electric Power Distribution plc Registered Office: No.1 Forbury Place 43 Forbury Road Reading RG1 3JH Registered In England & Wales No.04094290</p> <p>If you're unsure & need to seek advice before commencing excavations, please contact: General Enquiries: 0800 048 3516</p> <p>Subject to revision - Master held by SSEN Asset Data Team: Asset.Data@sse.com 01256 337 294</p>	

Warning: PDF designed for A4 colour print only with no page scaling














0  20m Dig Sites Area:  Line: 






**Extra High Voltage
cables in vicinity**



Date Requested: 24/06/2022
 Job Reference: 25881010
 Site Location: 448066 213346
 Requested by: Mr Joe Shawyer
 Your Scheme/Reference: 31188_002

Voltages (V)			
LV (Low Voltage) and Services	Up to 1,000V		
HV (High Voltage)	Over 1,000V to 11,000V		
EHV (Extra High Voltage)	22,000V to 132,000V		
Transmission	275,000V and 400,000V		
NORMAL DEPTH TO THE TOP OF THE CABLE WHEN LAID			
Services	LV	HV	EHV
Footpath/Unmade	0.45m	0.45m	0.6m 0.8m
Road Crossing	0.6m	0.6m	0.75m 0.9m
Agricultural	1m	1m	1m 1.1m

Legend	
	Service Cable
	LV Mains
	2 - 11kV
	66kV
	11kV
	22kV
	33kV
	66kV
	132kV
	275kV
	400kV
	Fibre Optic
	Pipe Cable

Distribution Structures (Electric)	
	Pole, Existing Location
	Pole Structure, Existing Location - Single
	Pole Structure, Existing Location - H
	Duct Route
	Cross Section Route

WARNING

There may have been subsequent alteration to the surface levels. Trial holes must be undertaken to determine position and depths of cables. HS (G) 47 Booklet from the Health and Safety Executive - Avoiding Danger from Buried Cables - should be consulted before commencing excavation work.
WHEN WORKING IN THE VICINITY OF OVERHEAD LINES THE HEALTH AND SAFETY GUIDANCE NOTES G56 SHOULD BE CONSULTED (AVAILABLE FROM THE HSE WEBSITE)

Southern Electric Power Distribution plc
 Registered Office: No.1 Forbury Place
 43 Forbury Road Reading RG1 3JH
 Registered In England & Wales No.04094290

If you're unsure & need to seek advice before commencing excavations, please contact:
 General Enquiries: 0800 048 3516

Subject to revision - Master held by SSEN Asset Data Team:
Asset.Data@sse.com
 01256 337 294

Scale: 1:500 (When plotted at A4)

PARK FARM

32

Warning: PDF designed for A4 colour print only with no page scaling

0 20m

Dig Sites

Area:



Line:



**Extra High Voltage
cables in vicinity**



Date Requested: 24/06/2022
Job Reference: 25881010
Site Location: 448066 213346
Requested by: Mr Joe Shawyer

Your Scheme/Reference: 31188_002

Voltages (V)				
LV (Low Voltage) and Services	Up to 1,000V			
HV (High Voltage)	Over 1,000V to 11,000V			
EHV (Extra High Voltage)	22,000V to 132,000V			
Transmission	275,000V and 400,000V			
NORMAL DEPTH TO THE TOP OF THE CABLE WHEN LAID				
Services	LV	HV	EHV	
Footpath/Unmade	0.45m	0.45m	0.6m	0.8m
Road Crossing	0.6m	0.6m	0.75m	0.9m
Agricultural	1m	1m	1m	1.1m

Legend	
	Service Cable
	LV Mains
	2 - 11kV
	66kV
	11kV
	22kV
	33kV
	66kV
	132kV
	275kV
	400kV
	Fibre Optic
	Pipe Cable

Distribution Structures (Electric)	
	Pole, Existing Location
	Pole Structure, Existing Location - Single
	Pole Structure, Existing Location - H
	Duct Route
	Cross Section Route

WARNING

There may have been subsequent alteration to the surface levels. Trial holes must be undertaken to determine position and depths of cables. HS (G) 47 Booklet from the Health and Safety Executive - Avoiding Danger from Buried Cables - should be consulted before commencing excavation work.
WHEN WORKING IN THE VICINITY OF OVERHEAD LINES THE HEALTH AND SAFETY GUIDANCE NOTES G56 SHOULD BE CONSULTED (AVAILABLE FROM THE HSE WEBSITE)

Southern Electric Power Distribution plc
Registered Office: No.1 Forbury Place
43 Forbury Road Reading RG1 3JH
Registered In England & Wales No.04094290

If you're unsure & need to seek advice before commencing excavations, please contact:
General Enquiries: 0800 048 3516

Subject to revision - Master held by SSEN Asset Data Team:
Asset.Data@sse.com
01256 337 294

Scale: 1:500 (When plotted at A4)

Parker's Farm

33

Slurry Bed

Warning: PDF designed for A4 colour print only with no page scaling

0 20m

Dig Sites

Area:



Line:



Extra High Voltage
cables in vicinity



Date Requested: 24/06/2022

Job Reference: 25881010

Site Location: 448066 213346

Requested by: Mr Joe Shawyer

Your Scheme/Reference: 31188_002

Voltages (V)				
LV (Low Voltage) and Services	Up to 1,000V			
HV (High Voltage)	Over 1,000V to 11,000V			
EHV (Extra High Voltage)	22,000V to 132,000V			
Transmission	275,000V and 400,000V			
NORMAL DEPTH TO THE TOP OF THE CABLE WHEN LAID				
Services	LV	HV	EHV	
Footpath/Unmade	0.45m	0.45m	0.6m	0.8m
Road Crossing	0.6m	0.6m	0.75m	0.9m
Agricultural	1m	1m	1m	1.1m

Legend	
	Service Cable
	LV Mains
	2 - 11kV
	66kV
	11kV
	22kV
	33kV
	66kV
	132kV
	275kV
	400kV
	Fibre Optic
	Pilot Cable

Distribution Structures (Electric)	
	Pole, Existing Location
	Pole Structure, Existing Location - Single
	Pole Structure, Existing Location - H
	Duct Route
	Cross Section Route


Southern Electric Power Distribution plc
Registered Office: No.1 Forbury Place
43 Forbury Road Reading RG1 3JH
Registered In England & Wales No.04094290

If you're unsure & need to seek advice before commencing excavations, please contact:
General Enquiries: 0800 048 3516

Subject to revision - Master held by SSEN Asset Data Team:
Asset.Data@sse.com
01256 337 294


Scale: 1:500 (When plotted at A4)

There may have been subsequent alteration to the surface levels. Trial holes must be undertaken to determine position and depths of cables. HS (G) 47 Booklet from the Health and Safety Executive - Avoiding Danger from Buried Cables - should be consulted before commencing excavation work.
WHEN WORKING IN THE VICINITY OF OVERHEAD LINES THE HEALTH AND SAFETY GUIDANCE NOTES G56 SHOULD BE CONSULTED (AVAILABLE FROM THE HSE WEBSITE)

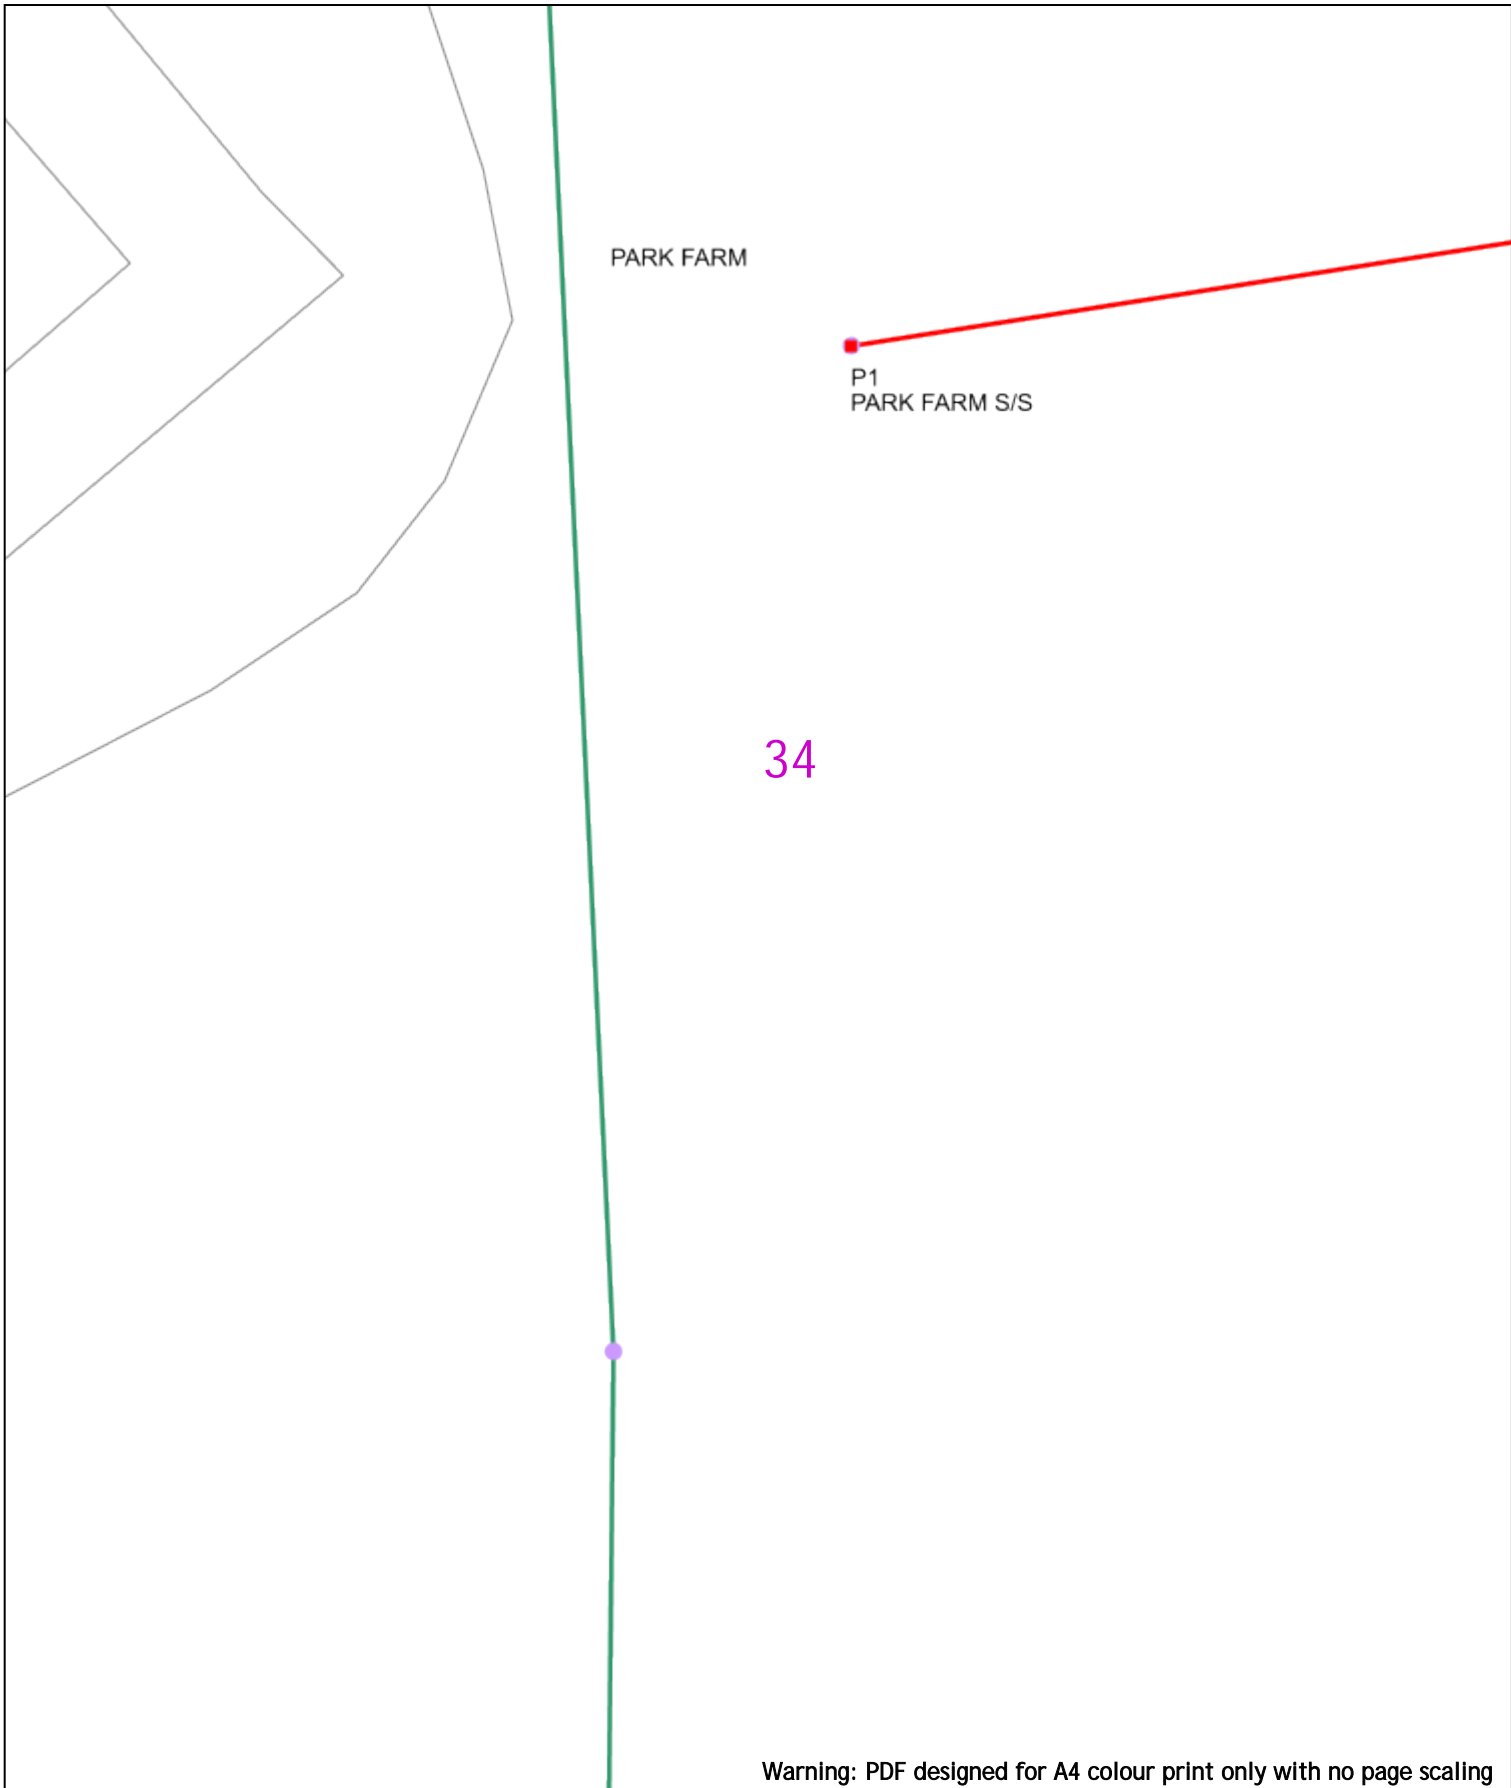

Warning: PDF designed for A4 colour print only with no page scaling

<p>0 20m Dig Sites Area: Line: </p>	<p>Extra High Voltage cables in vicinity</p>																										
<p>Date Requested: 24/06/2022 Job Reference: 25881010 Site Location: 448066 213346 Requested by: Mr Joe Shawyer Your Scheme/Reference: 31188_002</p>	<p>Voltages (V)</p> <table border="1"> <tr> <td>LV (Low Voltage) and Services</td> <td>Up to 1,000V</td> </tr> <tr> <td>HV (High Voltage)</td> <td>Over 1,000V to 11,000V</td> </tr> <tr> <td>EHV (Extra High Voltage)</td> <td>22,000V to 132,000V</td> </tr> <tr> <td>Transmission</td> <td>275,000V and 400,000V</td> </tr> </table> <p>NORMAL DEPTH TO THE TOP OF THE CABLE WHEN LAID</p> <table border="1"> <thead> <tr> <th>Services</th> <th>LV</th> <th>HV</th> <th>EHV</th> </tr> </thead> <tbody> <tr> <td>Footpath/Unmade</td> <td>0.45m</td> <td>0.45m</td> <td>0.6m</td> </tr> <tr> <td>Road Crossing</td> <td>0.6m</td> <td>0.6m</td> <td>0.75m</td> </tr> <tr> <td>Agricultural</td> <td>1m</td> <td>1m</td> <td>1.1m</td> </tr> </tbody> </table>	LV (Low Voltage) and Services	Up to 1,000V	HV (High Voltage)	Over 1,000V to 11,000V	EHV (Extra High Voltage)	22,000V to 132,000V	Transmission	275,000V and 400,000V	Services	LV	HV	EHV	Footpath/Unmade	0.45m	0.45m	0.6m	Road Crossing	0.6m	0.6m	0.75m	Agricultural	1m	1m	1.1m	<p>Legend</p> <ul style="list-style-type: none"> Service Cable LV Mains 2 - 11kV 66kV 11kV 22kV 33kV 66kV 132kV 275kV 400kV Fibre Optic Pipe Cable <p>Distribution Structures (Electric)</p> <ul style="list-style-type: none"> Pole, Existing Location Pole Structure, Existing Location - Single Pole Structure, Existing Location - H Duct Route Cross Section Route <p>WARNING</p> <p>There may have been subsequent alteration to the surface levels. Trial holes must be undertaken to determine position and depths of cables. HS (G) 47 Booklet from the Health and Safety Executive - Avoiding Danger from Buried Cables - should be consulted before commencing excavation work.</p> <p>WHEN WORKING IN THE VICINITY OF OVERHEAD LINES THE HEALTH AND SAFETY GUIDANCE NOTES G56 SHOULD BE CONSULTED (AVAILABLE FROM THE HSE WEBSITE)</p>	<p>Southern Electric Power Distribution plc Registered Office: No.1 Forbury Place 43 Forbury Road Reading RG1 3JH Registered In England & Wales No.04094290</p> <p>If you're unsure & need to seek advice before commencing excavations, please contact: General Enquiries: 0800 048 3516</p> <p>Subject to revision - Master held by SSEN Asset Data Team: Asset.Data@sse.com 01256 337 294</p>
LV (Low Voltage) and Services	Up to 1,000V																										
HV (High Voltage)	Over 1,000V to 11,000V																										
EHV (Extra High Voltage)	22,000V to 132,000V																										
Transmission	275,000V and 400,000V																										
Services	LV	HV	EHV																								
Footpath/Unmade	0.45m	0.45m	0.6m																								
Road Crossing	0.6m	0.6m	0.75m																								
Agricultural	1m	1m	1.1m																								
<p>BASED UPON THE ORDNANCE SURVEY MAP WITH THE SANCTION OF THE CONTROLLER OF HM STATIONERY OFFICE CROWN COPYRIGHT RESERVED. This copy has been made by or with the authority of Scottish and Southern Energy Power Distribution Ltd. Pursuant to section 47 of the Copyright, Designs and Patents Act 1988 ("The Act"). Unless the Act provides a relevant exception to copyright the copy must not be copied without prior permission of the copyright owner. Plans generated by DigSAFE Pro™ software provided by LinesearchbeforeUdig.</p>																											

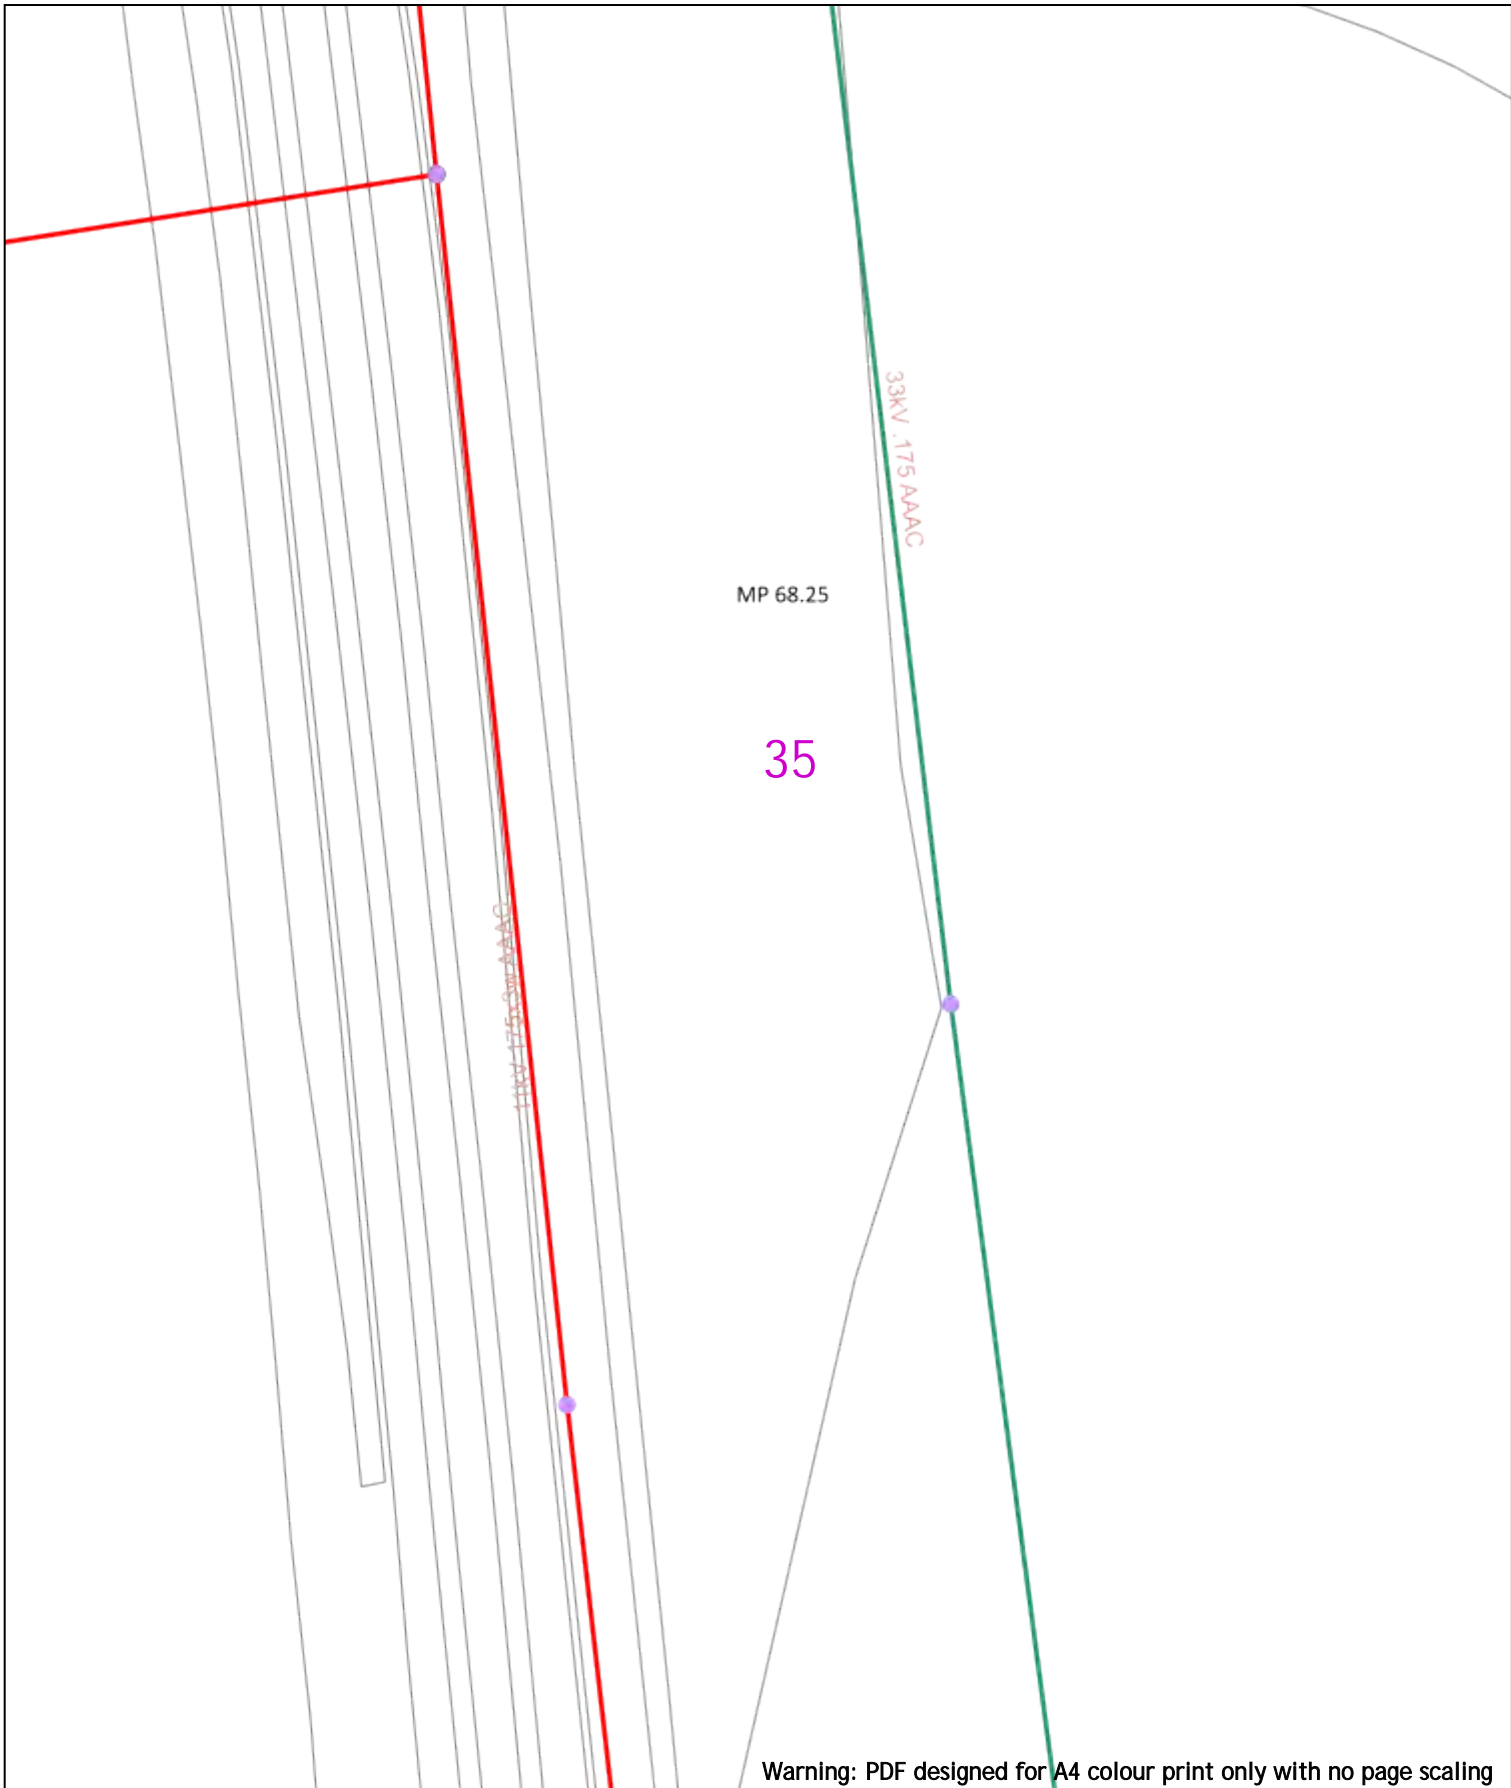


MP 68.25

35


Warning: PDF designed for A4 colour print only with no page scaling

<p>0 20m Dig Sites Area: Line: Extra High Voltage cables in vicinity</p>	
<p>Date Requested: 24/06/2022 Job Reference: 25881010 Site Location: 448066 213346 Requested by: Mr Joe Shawyer Your Scheme/Reference: 31188_002</p>	<table border="1"> <thead> <tr> <th colspan="4">Voltages (V)</th> </tr> </thead> <tbody> <tr> <td>LV (Low Voltage) and Services</td> <td colspan="3">Up to 1,000V</td> </tr> <tr> <td>HV (High Voltage)</td> <td colspan="3">Over 1,000V to 11,000V</td> </tr> <tr> <td>EHV (Extra High Voltage)</td> <td colspan="3">22,000V to 132,000V</td> </tr> <tr> <td>Transmission</td> <td colspan="3">275,000V and 400,000V</td> </tr> </tbody> </table> <table border="1"> <thead> <tr> <th colspan="4">NORMAL DEPTH TO THE TOP OF THE CABLE WHEN LAID</th> </tr> <tr> <th>Services</th> <th>LV</th> <th>HV</th> <th>EHV</th> </tr> </thead> <tbody> <tr> <td>Footpath/Unmade</td> <td>0.45m</td> <td>0.45m</td> <td>0.6m</td> </tr> <tr> <td>Road Crossing</td> <td>0.6m</td> <td>0.6m</td> <td>0.75m</td> </tr> <tr> <td>Agricultural</td> <td>1m</td> <td>1m</td> <td>1.1m</td> </tr> </tbody> </table> <p>WARNING There may have been subsequent alteration to the surface levels. Trial holes must be undertaken to determine position and depths of cables. HS (G) 47 Booklet from the Health and Safety Executive – Avoiding Danger from Buried Cables – should be consulted before commencing excavation work. WHEN WORKING IN THE VICINITY OF OVERHEAD LINES THE HEALTH AND SAFETY GUIDANCE NOTES G56 SHOULD BE CONSULTED (AVAILABLE FROM THE HSE WEBSITE)</p>			Voltages (V)				LV (Low Voltage) and Services	Up to 1,000V			HV (High Voltage)	Over 1,000V to 11,000V			EHV (Extra High Voltage)	22,000V to 132,000V			Transmission	275,000V and 400,000V			NORMAL DEPTH TO THE TOP OF THE CABLE WHEN LAID				Services	LV	HV	EHV	Footpath/Unmade	0.45m	0.45m	0.6m	Road Crossing	0.6m	0.6m	0.75m	Agricultural	1m	1m
Voltages (V)	
LV (Low Voltage) and Services	Up to 1,000V	
HV (High Voltage)	Over 1,000V to 11,000V	
EHV (Extra High Voltage)	22,000V to 132,000V	
Transmission	275,000V and 400,000V	
NORMAL DEPTH TO THE TOP OF THE CABLE WHEN LAID	
Services	LV	HV	EHV																																							
Footpath/Unmade	0.45m	0.45m	0.6m																																							
Road Crossing	0.6m	0.6m	0.75m																																							
Agricultural	1m	1m	1.1m																																							
<p>Scale: 1:500 (When plotted at A4)</p>		<p>BASED UPON THE ORDNANCE SURVEY MAP WITH THE SANCTION OF THE CONTROLLER OF HM STATIONERY OFFICE CROWN COPYRIGHT RESERVED. This copy has been made by or with the authority of Scottish and Southern Energy Power Distribution Ltd. Pursuant to section 47 of the Copyright, Designs and Patents Act 1988 ("The Act"). Unless the Act provides a relevant exception to copyright the copy must not be copied without prior permission of the copyright owner. Plans generated by DigSAFE Pro™ software provided by LinesearchbeforeUdig.</p>	

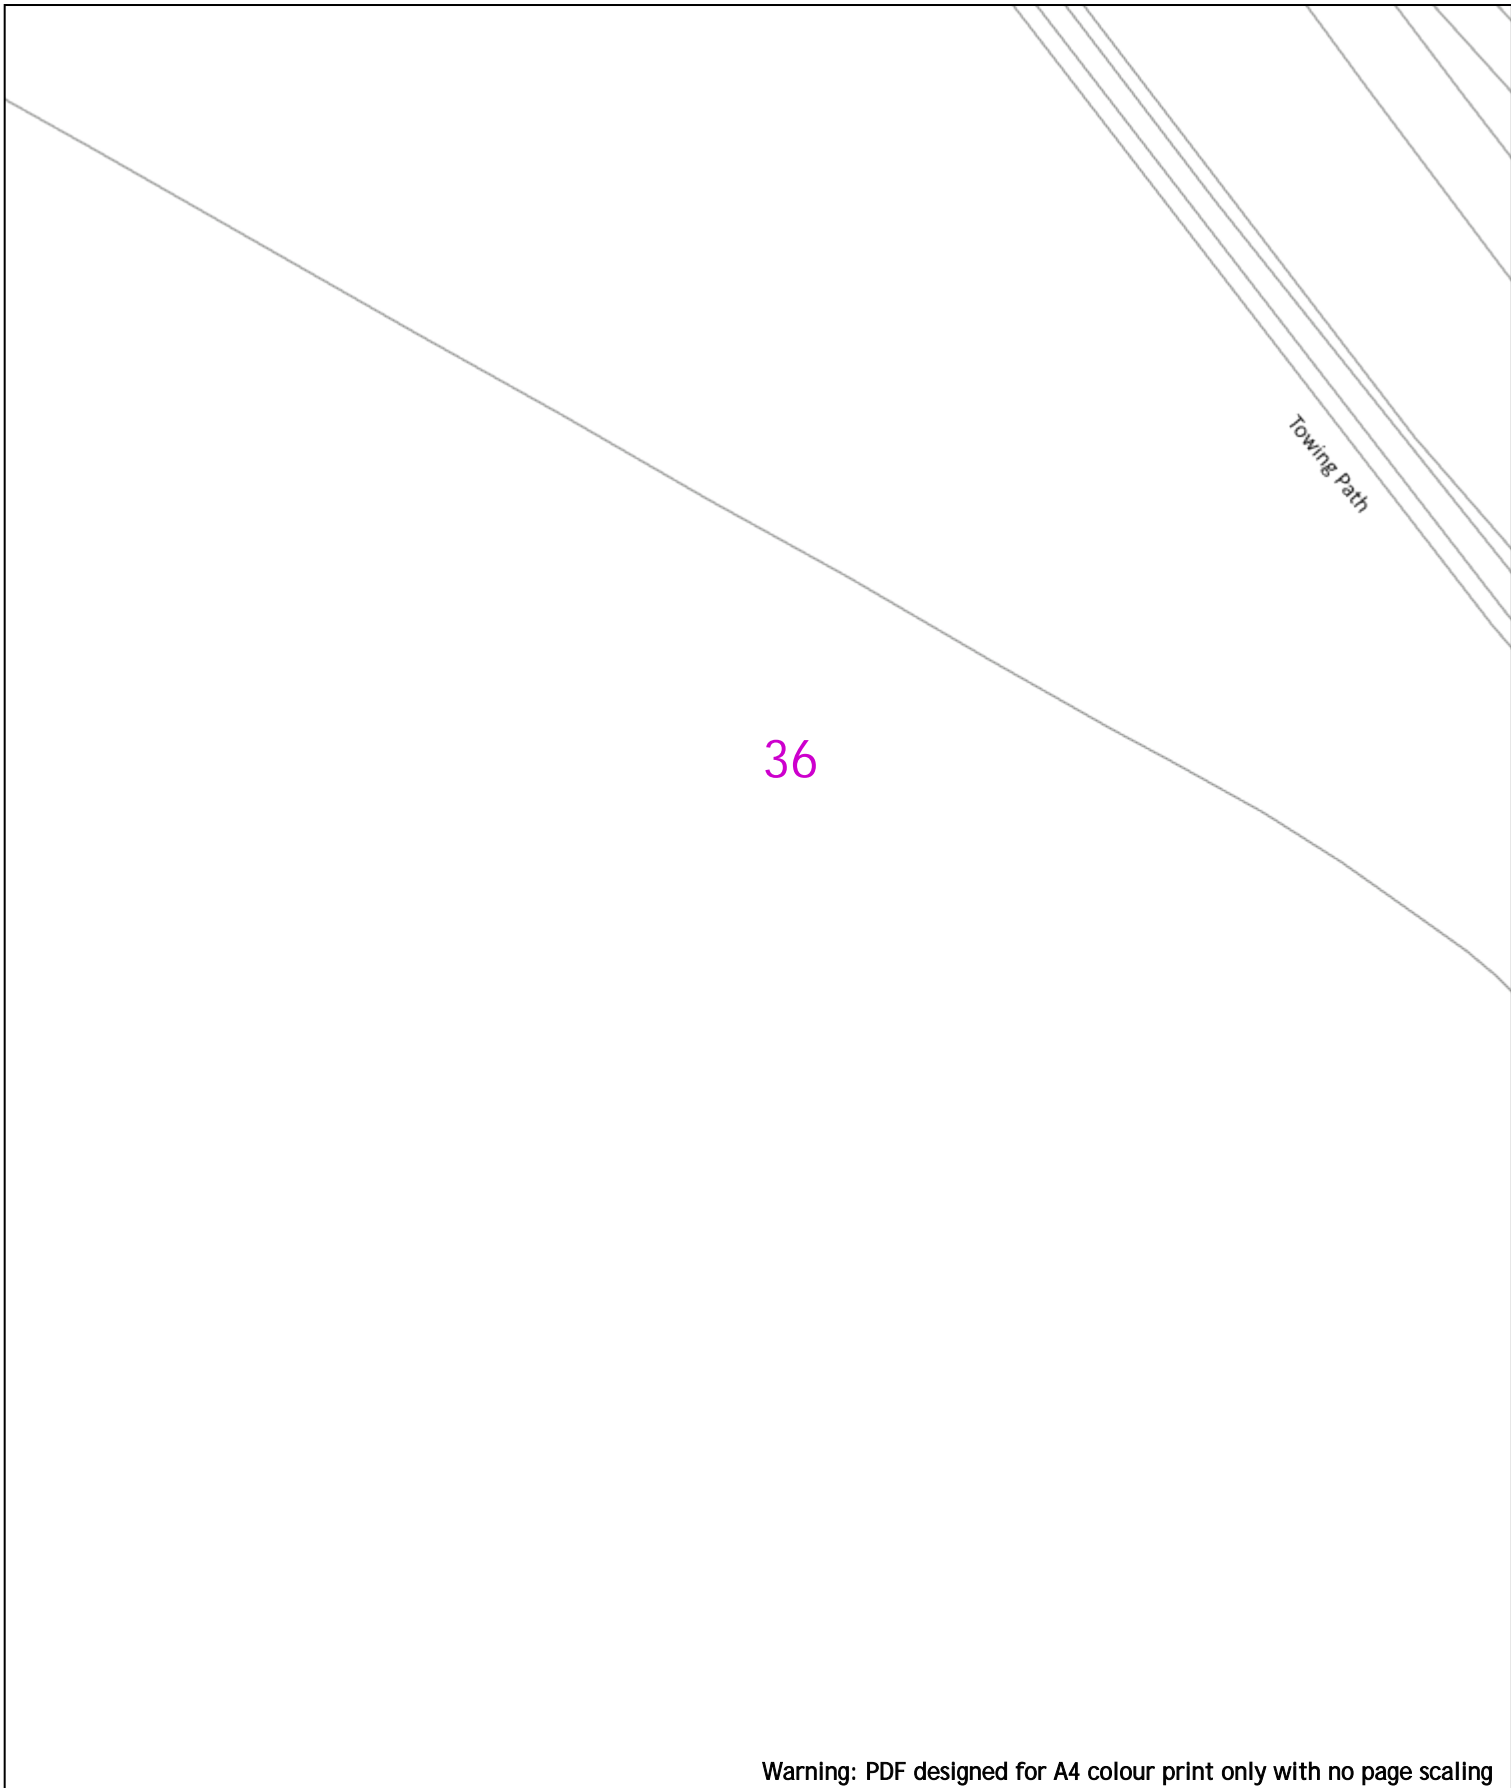

Warning: PDF designed for A4 colour print only with no page scaling

<p>0 20m Dig Sites Area: Line: </p>	<p>Extra High Voltage cables in vicinity</p>	
<p>Date Requested: 24/06/2022 Job Reference: 25881010 Site Location: 448066 213346 Requested by: Mr Joe Shawyer Your Scheme/Reference: 31188_002</p>	<table border="1" style="width: 100%; border-collapse: collapse;"> <thead> <tr> <th colspan="4">Voltages (V)</th> </tr> </thead> <tbody> <tr> <td>LV (Low Voltage) and Services</td> <td colspan="3">Up to 1,000V</td> </tr> <tr> <td>HV (High Voltage)</td> <td colspan="3">Over 1,000V to 11,000V</td> </tr> <tr> <td>EHV (Extra High Voltage)</td> <td colspan="3">22,000V to 132,000V</td> </tr> <tr> <td>Transmission</td> <td colspan="3">275,000V and 400,000V</td> </tr> </tbody> </table> <table border="1" style="width: 100%; border-collapse: collapse; margin-top: 5px;"> <thead> <tr> <th colspan="4">NORMAL DEPTH TO THE TOP OF THE CABLE WHEN LAID</th> </tr> <tr> <th>Services</th> <th>LV</th> <th>HV</th> <th>EHV</th> </tr> </thead> <tbody> <tr> <td>Footpath/Unmade</td> <td>0.45m</td> <td>0.45m</td> <td>0.6m 0.8m</td> </tr> <tr> <td>Road Crossing</td> <td>0.6m</td> <td>0.6m</td> <td>0.75m 0.9m</td> </tr> <tr> <td>Agricultural</td> <td>1m</td> <td>1m</td> <td>1m 1.1m</td> </tr> </tbody> </table>	Voltages (V)				LV (Low Voltage) and Services	Up to 1,000V			HV (High Voltage)	Over 1,000V to 11,000V			EHV (Extra High Voltage)	22,000V to 132,000V			Transmission	275,000V and 400,000V			NORMAL DEPTH TO THE TOP OF THE CABLE WHEN LAID				Services	LV	HV	EHV	Footpath/Unmade	0.45m	0.45m	0.6m 0.8m	Road Crossing	0.6m	0.6m	0.75m 0.9m	Agricultural	1m	1m	1m 1.1m	<table border="1" style="width: 100%; border-collapse: collapse;"> <thead> <tr> <th colspan="2">Legend</th> </tr> </thead> <tbody> <tr><td></td><td>Service Cable</td></tr> <tr><td></td><td>LV Mains</td></tr> <tr><td></td><td>2 - 11kV</td></tr> <tr><td></td><td>66kV</td></tr> <tr><td></td><td>11kV</td></tr> <tr><td></td><td>22kV</td></tr> <tr><td></td><td>33kV</td></tr> <tr><td></td><td>66kV</td></tr> <tr><td></td><td>132kV</td></tr> <tr><td></td><td>275kV</td></tr> <tr><td></td><td>400kV</td></tr> <tr><td></td><td>Fibre Optic</td></tr> <tr><td></td><td>Pipe Cable</td></tr> </tbody> </table> <table border="1" style="width: 100%; border-collapse: collapse; margin-top: 5px;"> <thead> <tr> <th colspan="2">Distribution Structures (Electric)</th> </tr> </thead> <tbody> <tr> <td></td> <td>Pole, Existing Location</td> </tr> <tr> <td></td> <td>Pole Structure, Existing Location - Single</td> </tr> <tr> <td></td> <td>Pole Structure, Existing Location - M</td> </tr> <tr> <td></td> <td>Duct Route</td> </tr> <tr> <td></td> <td>Cross Section Route</td> </tr> </tbody> </table>	Legend			Service Cable		LV Mains		2 - 11kV		66kV		11kV		22kV		33kV		66kV		132kV		275kV		400kV		Fibre Optic		Pipe Cable	Distribution Structures (Electric)			Pole, Existing Location		Pole Structure, Existing Location - Single		Pole Structure, Existing Location - M		Duct Route		Cross Section Route
Voltages (V)	
LV (Low Voltage) and Services	Up to 1,000V	
HV (High Voltage)	Over 1,000V to 11,000V	
EHV (Extra High Voltage)	22,000V to 132,000V	
Transmission	275,000V and 400,000V	
NORMAL DEPTH TO THE TOP OF THE CABLE WHEN LAID	
Services	LV	HV	EHV	
Footpath/Unmade	0.45m	0.45m	0.6m 0.8m	
Road Crossing	0.6m	0.6m	0.75m 0.9m	
Agricultural	1m	1m	1m 1.1m	
Legend	
	Service Cable	
	LV Mains	
	2 - 11kV	
	66kV	
	11kV	
	22kV	
	33kV	
	66kV	
	132kV	
	275kV	
	400kV	
	Fibre Optic	
	Pipe Cable	
Distribution Structures (Electric)	
	Pole, Existing Location	
	Pole Structure, Existing Location - Single	
	Pole Structure, Existing Location - M	
	Duct Route	
	Cross Section Route	
<p>WARNING</p> <p>There may have been subsequent alteration to the surface levels. Trial holes must be undertaken to determine position and depths of cables. HS (G) 47 Booklet from the Health and Safety Executive - Avoiding Danger from Buried Cables - should be consulted before commencing excavation work.</p> <p>WHEN WORKING IN THE VICINITY OF OVERHEAD LINES THE HEALTH AND SAFETY GUIDANCE NOTES G56 SHOULD BE CONSULTED (AVAILABLE FROM THE HSE WEBSITE)</p>		<p style="text-align: center;">Southern Electric Power Distribution plc Registered Office: No.1 Forbury Place 43 Forbury Road Reading RG1 3JH Registered In England & Wales No.04094290</p> <p>If you're unsure & need to seek advice before commencing excavations, please contact: General Enquiries: 0800 048 3516</p> <p>Subject to revision - Master held by SSEN Asset Data Team: Asset.Data@sse.com 01256 337 294</p>	
<p>Scale: 1:500 (When plotted at A4)</p> <p style="text-align: center;">BASED UPON THE ORDNANCE SURVEY MAP WITH THE SANCTION OF THE CONTROLLER OF H.M. STATIONERY OFFICE CROWN COPYRIGHT RESERVED. This copy has been made by or with the authority of Scottish and Southern Energy Power Distribution Ltd. Pursuant to section 47 of the Copyright, Designs and Patents Act 1988 ("The Act"). Unless the Act provides a relevant exception to copyright the copy must not be copied without prior permission of the copyright owner. Plans generated by DigSAFE Pro™ software provided by LinesearchbeforeUdig.</p>	

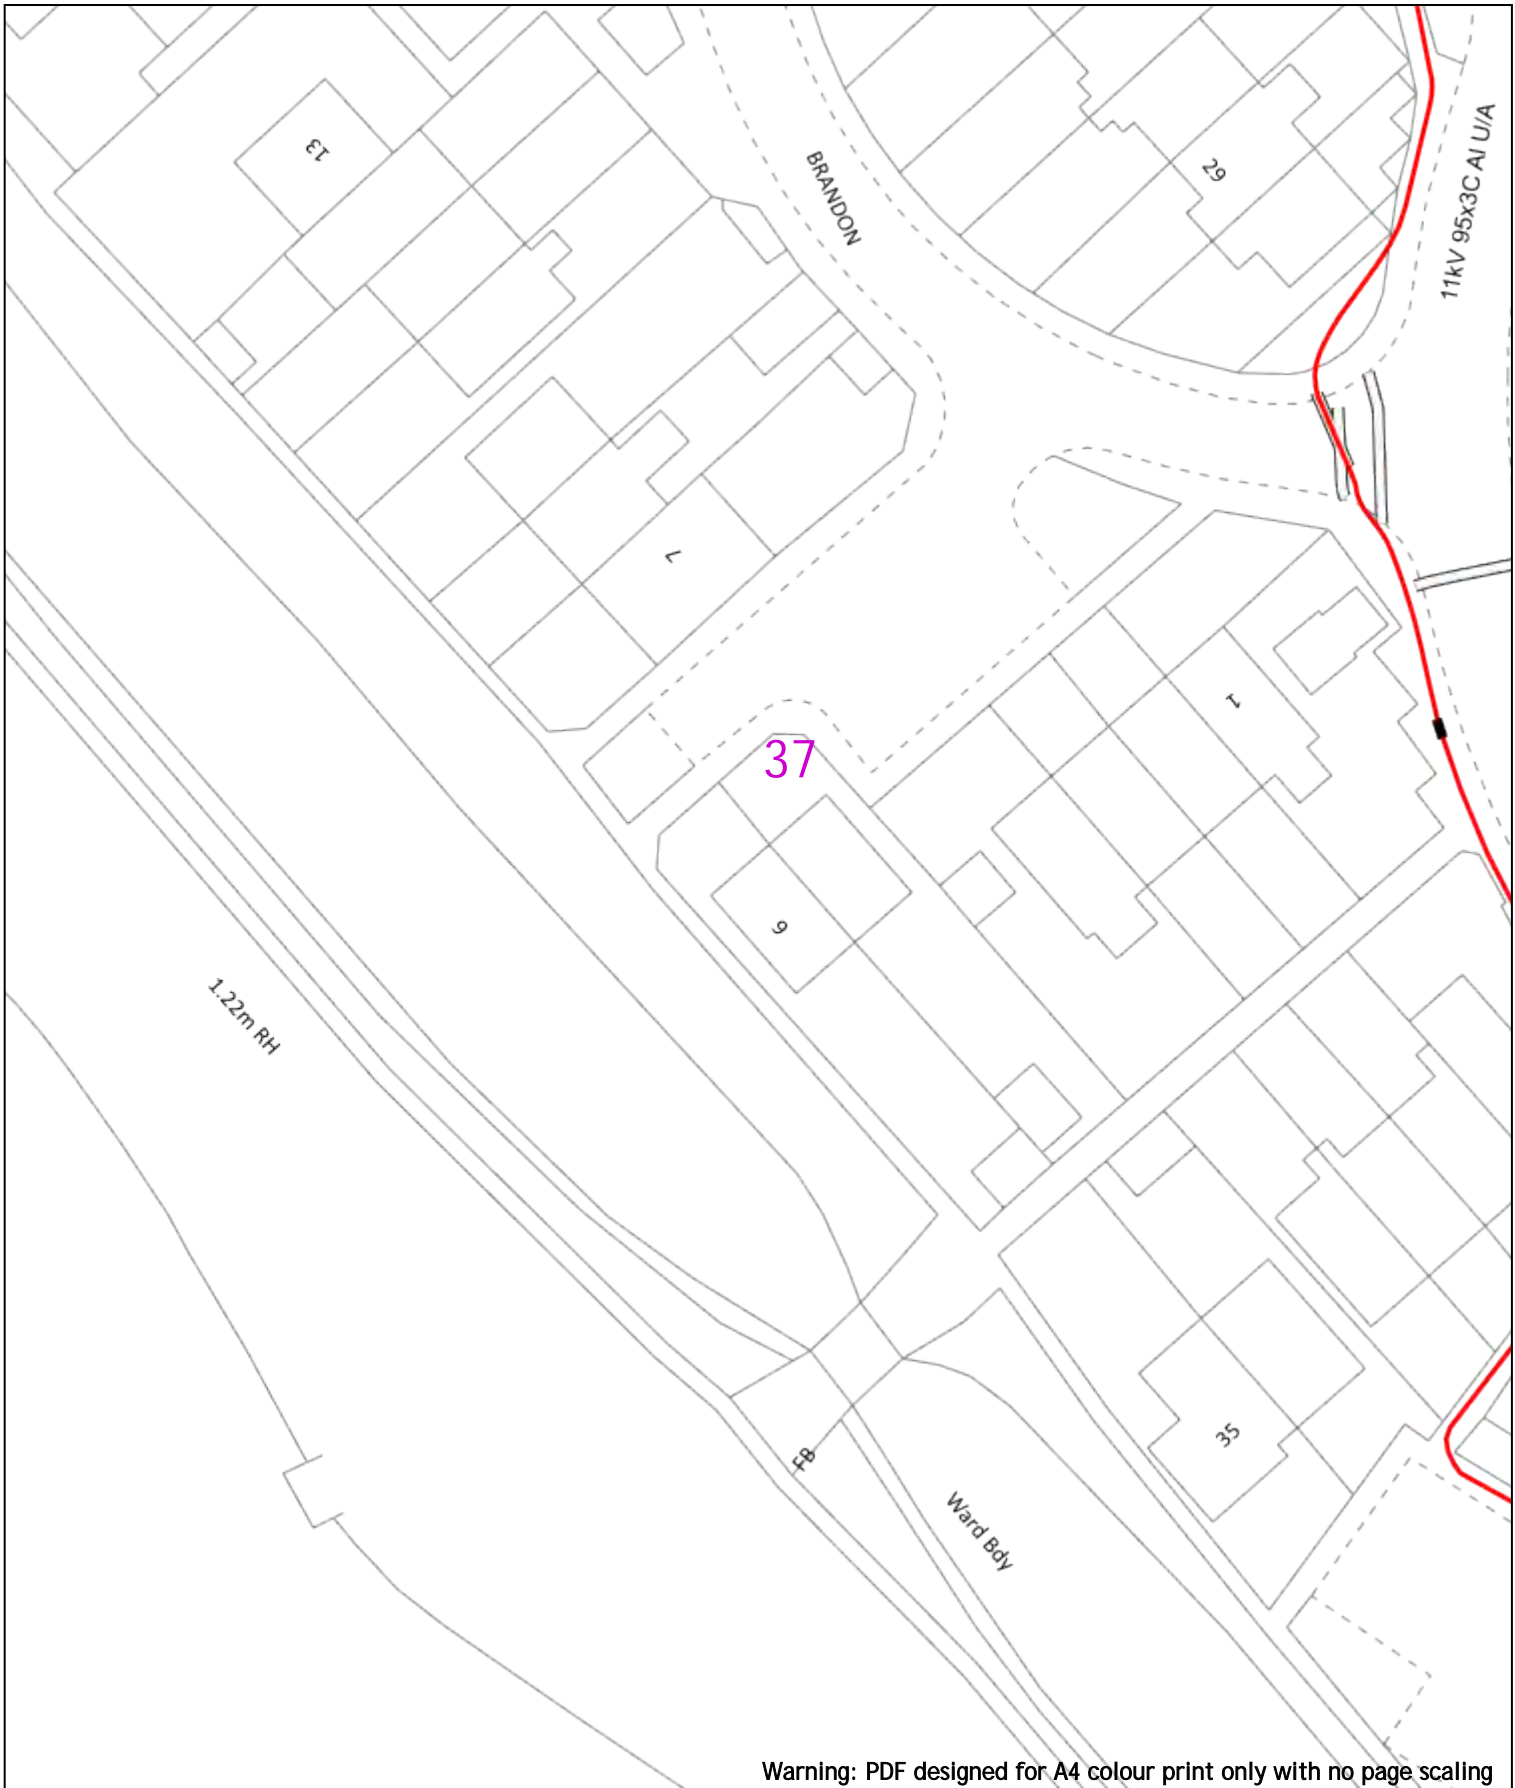

Warning: PDF designed for A4 colour print only with no page scaling


0 20m Dig Sites Area: Line: **Extra High Voltage cables in vicinity**

<p>Date Requested: 24/06/2022 Job Reference: 25881010 Site Location: 448066 213346 Requested by: Mr Joe Shawyer Your Scheme/Reference: 31188_002</p>	<p>Voltages (V)</p> <p>LV (Low Voltage) and Services Up to 1,000V HV (High Voltage) Over 1,000V to 11,000V EHV (Extra High Voltage) 22,000V to 132,000V Transmission 275,000V and 400,000V</p> <p>NORMAL DEPTH TO THE TOP OF THE CABLE WHEN LAID</p> <table border="1"> <thead> <tr> <th>Services</th> <th>LV</th> <th>HV</th> <th>EHV</th> </tr> </thead> <tbody> <tr> <td>Footpath/Unmade</td> <td>0.45m</td> <td>0.45m</td> <td>0.8m</td> </tr> <tr> <td>Road Crossing</td> <td>0.6m</td> <td>0.6m</td> <td>0.9m</td> </tr> <tr> <td>Agricultural</td> <td>1m</td> <td>1m</td> <td>1.1m</td> </tr> </tbody> </table>	Services	LV	HV	EHV	Footpath/Unmade	0.45m	0.45m	0.8m	Road Crossing	0.6m	0.6m	0.9m	Agricultural	1m	1m	1.1m	<p>Legend</p> <ul style="list-style-type: none"> Service Cable LV Mains 2 - 11kV 66kV 11kV 22kV 33kV 66kV 132kV 275kV 400kV Fibre Optic Pilot Cable <p>Distribution Structures (Electric)</p> <ul style="list-style-type: none"> Pole, Existing Location Pole Structure, Existing Location - Single Pole Structure, Existing Location - H Duct Route Cross Section Route 	<p></p> <p></p> <p>Southern Electric Power Distribution plc Registered Office: No.1 Forbury Place 43 Forbury Road Reading RG1 3JH Registered In England & Wales No.04094290</p> <p>If you're unsure & need to seek advice before commencing excavations, please contact: General Enquiries: 0800 048 3516</p> <p>Subject to revision – Master held by SSEN Asset Data Team: Asset.Data@sse.com 01256 337 294</p>
Services	LV	HV	EHV																
Footpath/Unmade	0.45m	0.45m	0.8m																
Road Crossing	0.6m	0.6m	0.9m																
Agricultural	1m	1m	1.1m																

Scale: 1:500 (When plotted at A4)

WARNING
 There may have been subsequent alteration to the surface levels. Trial holes must be undertaken to determine position and depths of cables. HS (G) 47 Booklet from the Health and Safety Executive – Avoiding Danger from Buried Cables – should be consulted before commencing excavation work.
 WHEN WORKING IN THE VICINITY OF OVERHEAD LINES THE HEALTH AND SAFETY GUIDANCE NOTES G56 SHOULD BE CONSULTED (AVAILABLE FROM THE HSE WEBSITE)

BASED UPON THE ORDNANCE SURVEY MAP WITH THE SANCTION OF THE CONTROLLER OF HM STATIONERY OFFICE CROWN COPYRIGHT RESERVED.
 This copy has been made by or with the authority of Scottish and Southern Energy Power Distribution Ltd. Pursuant to section 47 of the Copyright, Designs and Patents Act 1988 ("The Act"). Unless the Act provides a relevant exception to copyright the copy must not be copied without prior permission of the copyright owner.
 Plans generated by DigSAFE Pro™ software provided by LinesearchbeforeDig.

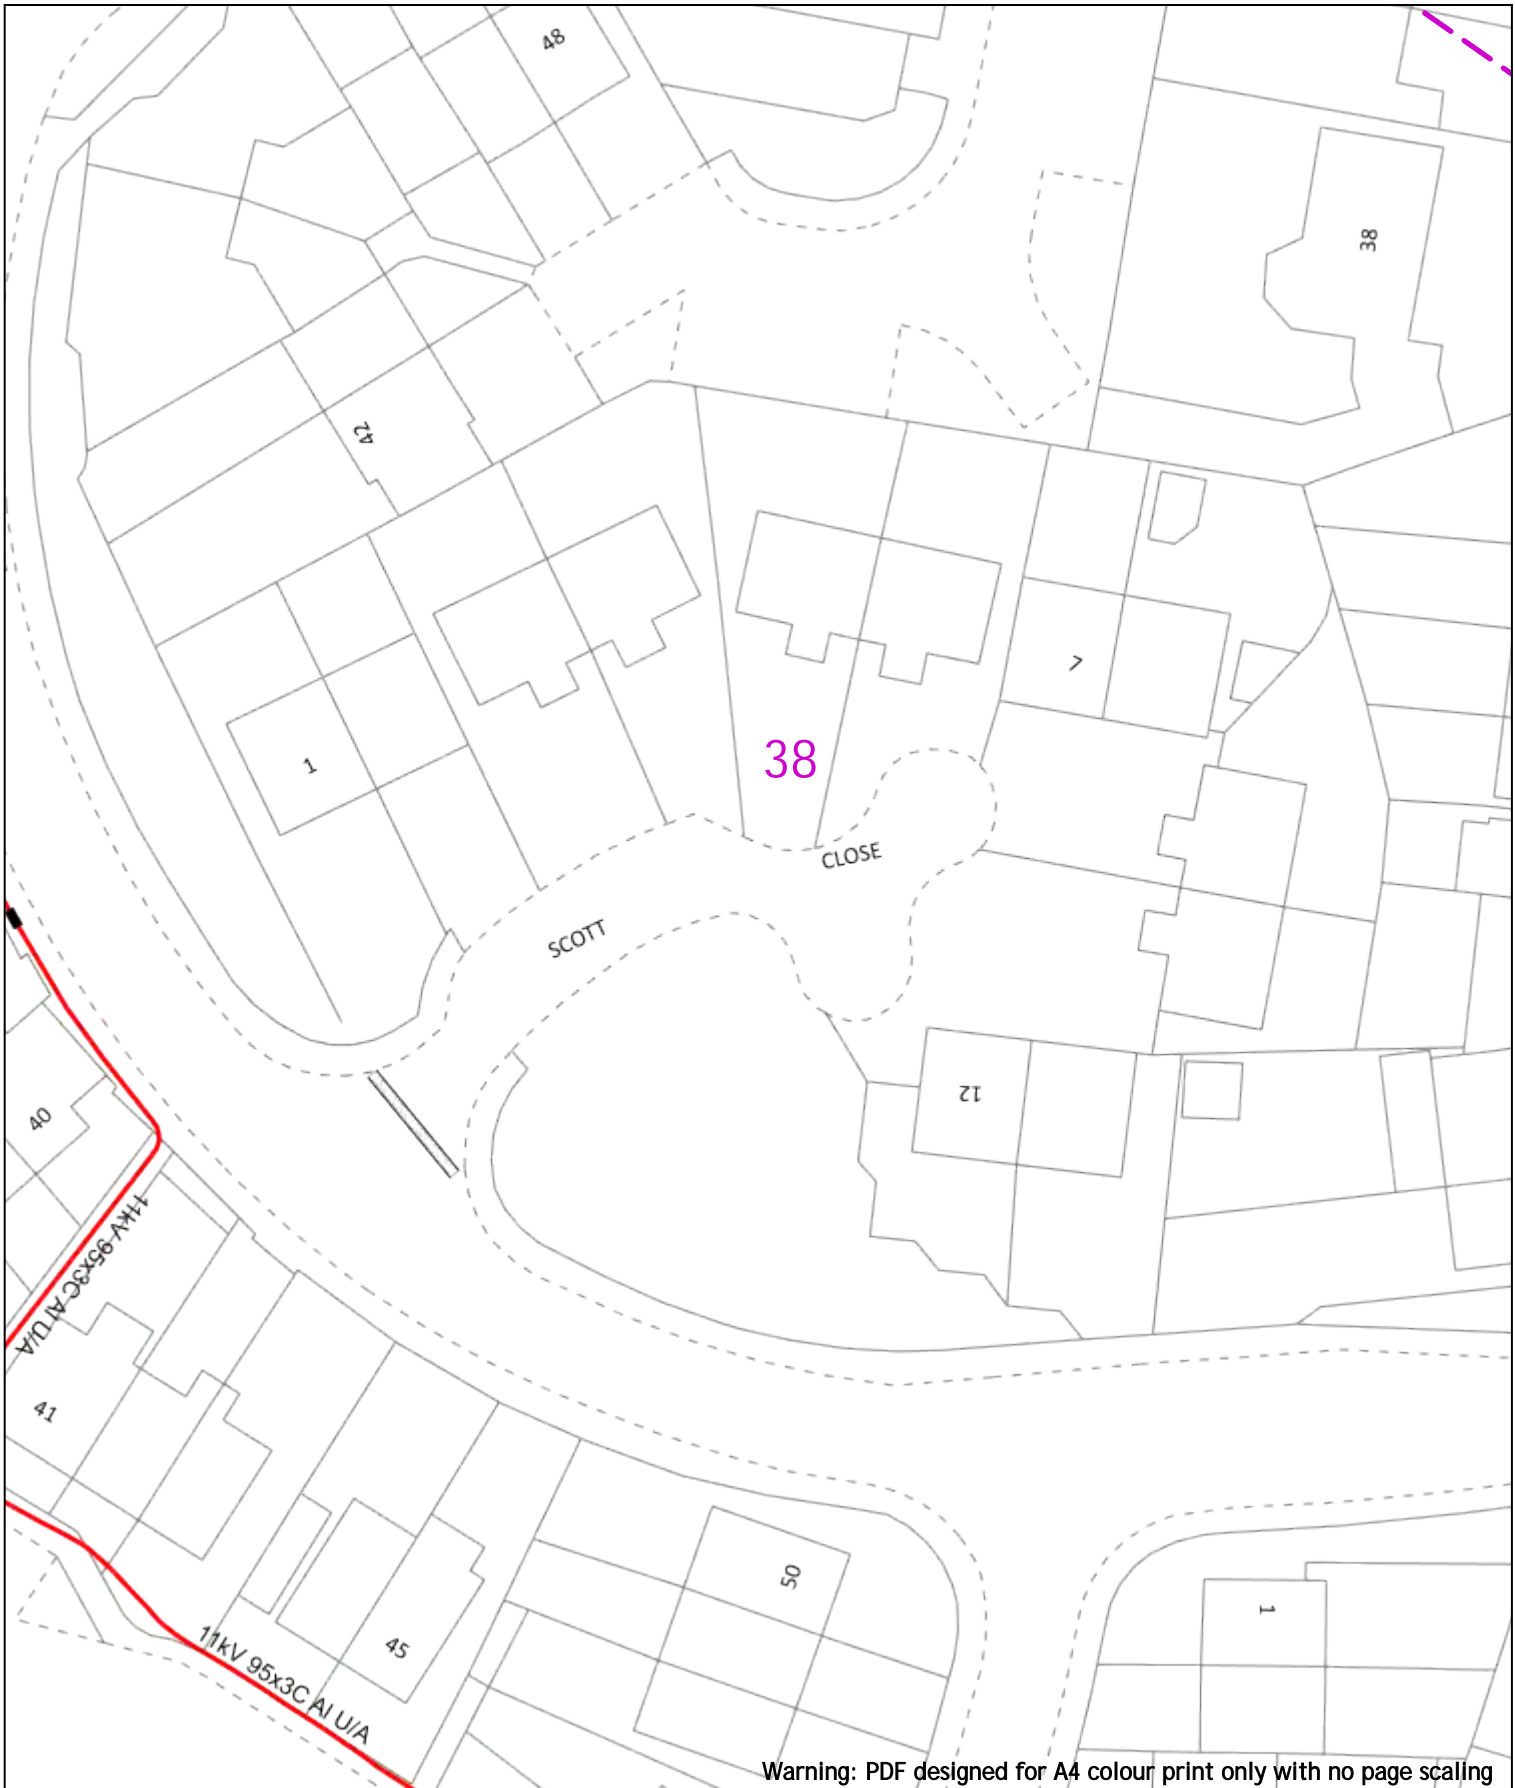

Warning: PDF designed for A4 colour print only with no page scaling

0 20m

Dig Sites Area: Line:

**Extra High Voltage
cables in vicinity**

Date Requested: 24/06/2022
 Job Reference: 25881010
 Site Location: 448066 213346
 Requested by: Mr Joe Shawyer
 Your Scheme/Reference: 31188_002

Voltages (V)

LV (Low Voltage) and Services	Up to 1,000V		
HV (High Voltage)	Over 1,000V to 11,000V		
EHV (Extra High Voltage)	22,000V to 132,000V		
Transmission	275,000V and 400,000V		

NORMAL DEPTH TO THE TOP OF THE CABLE WHEN LAID

Services	LV	HV	EHV
Footpath/Unmade	0.45m	0.45m	0.6m
Road Crossing	0.6m	0.6m	0.75m
Agricultural	1m	1m	1.1m

Legend

- Service Cable
- LV Mains
- 2 - 8.3kV
- 6.6kV
- 11kV
- 22kV
- 33kV
- 66kV
- 132kV
- 275kV
- 400kV
- Fibre Optic
- Pipit Cable

Distribution Structures (Electric)

- Pole, Existing Location
- Pole Structure, Existing Location - Single
- Pole Structure, Existing Location - H
- Duct Route
- Cross Section Route

Scale: 1:500 (When plotted at A4)


WARNING
 There may have been subsequent alteration to the surface levels. Trial holes must be undertaken to determine position and depths of cables. HS (G) 47 Booklet from the Health and Safety Executive - Avoiding Danger from Buried Cables - should be consulted before commencing excavation work.
WHEN WORKING IN THE VICINITY OF OVERHEAD LINES THE HEALTH AND SAFETY GUIDANCE NOTES G56 SHOULD BE CONSULTED (AVAILABLE FROM THE HSE WEBSITE)

BASED UPON THE ORDNANCE SURVEY MAP WITH THE SANCTION OF THE CONTROLLER OF HM STATIONERY OFFICE CROWN COPYRIGHT RESERVED.
 This copy has been made by or with the authority of Scottish and Southern Energy Power Distribution Ltd. Pursuant to section 47 of the Copyright, Designs and Patents Act 1988 ('The Act'). Unless the Act provides a relevant exception to copyright the copy must not be copied without prior permission of the copyright owner.
 Plans generated by DigSAFE Pro™ software provided by LinesearchbeforeDig.

Southern Electric Power Distribution plc
 Registered Office: No.1 Forbury Place
 43 Forbury Road Reading RG1 3JH
 Registered In England & Wales No.04094290


If you're unsure & need to seek advice before commencing excavations, please contact:
 General Enquiries: 0800 048 3516

Subject to revision - Master held by SSEN Asset Data Team:
Asset.Data@sse.com
 01256 337 294

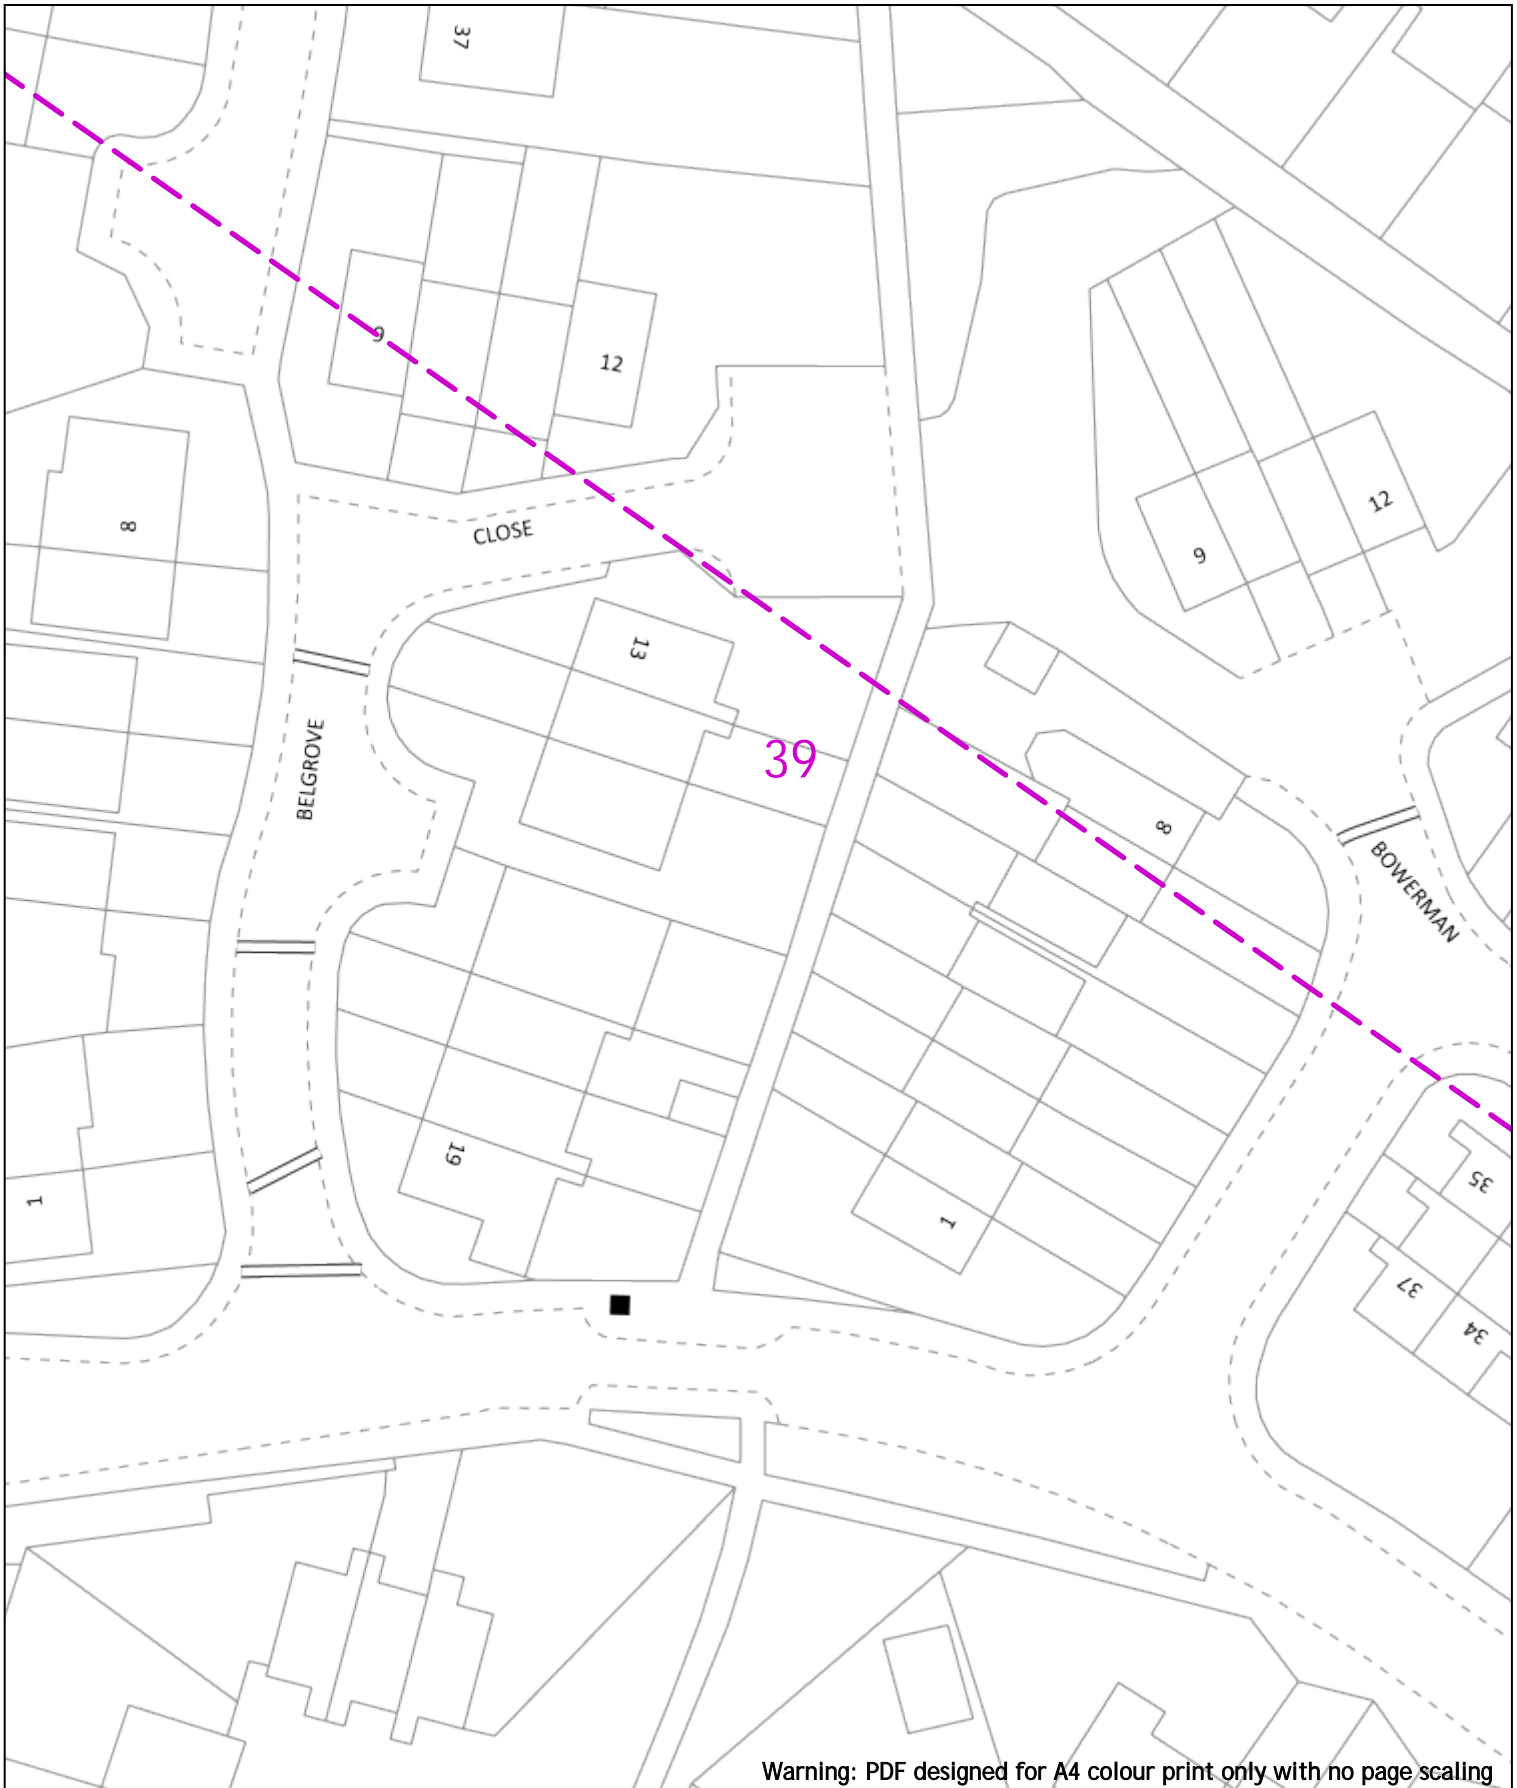

Warning: PDF designed for A4 colour print only with no page scaling

<p>0 20m Dig Sites Area: Line: Extra High Voltage cables in vicinity</p>	
<p>Date Requested: 24/06/2022 Job Reference: 25881010 Site Location: 448066 213346 Requested by: Mr Joe Shawyer Your Scheme/Reference: 31188_002</p>	<table border="1"> <thead> <tr> <th colspan="4">Voltages (V)</th> </tr> </thead> <tbody> <tr> <td>LV (Low Voltage) and Services</td> <td colspan="3">Up to 1,000V</td> </tr> <tr> <td>HV (High Voltage)</td> <td colspan="3">Over 1,000V to 11,000V</td> </tr> <tr> <td>EHV (Extra High Voltage)</td> <td colspan="3">22,000V to 132,000V</td> </tr> <tr> <td>Transmission</td> <td colspan="3">275,000V and 400,000V</td> </tr> </tbody> </table> <table border="1"> <thead> <tr> <th colspan="4">NORMAL DEPTH TO THE TOP OF THE CABLE WHEN LAID</th> </tr> <tr> <th>Services</th> <th>LV</th> <th>HV</th> <th>EHV</th> </tr> </thead> <tbody> <tr> <td>Footpath/Unmade</td> <td>0.45m</td> <td>0.45m</td> <td>0.6m</td> </tr> <tr> <td>Road Crossing</td> <td>0.6m</td> <td>0.6m</td> <td>0.75m</td> </tr> <tr> <td>Agricultural</td> <td>1m</td> <td>1m</td> <td>1.1m</td> </tr> </tbody> </table> <p>Legend</p> <ul style="list-style-type: none"> Service Cable LV Mains 2 - 3.3kV 6.6kV 11kV 22kV 33kV 66kV 132kV 275kV 400kV Fibre Optic Pipe Cable <p>Distribution Structures (Electric)</p> <ul style="list-style-type: none"> Pole, Existing Location Pole Structure, Existing Location - Single Pole Structure, Existing Location - H Duct Route Cross Section Route <p>WARNING</p> <p>There may have been subsequent alteration to the surface levels. Trial holes must be undertaken to determine position and depths of cables. HS (G) 47 Booklet from the Health and Safety Executive - Avoiding Danger from Buried Cables - should be consulted before commencing excavation work.</p> <p>WHEN WORKING IN THE VICINITY OF OVERHEAD LINES THE HEALTH AND SAFETY GUIDANCE NOTES G56 SHOULD BE CONSULTED (AVAILABLE FROM THE HSE WEBSITE)</p>	Voltages (V)				LV (Low Voltage) and Services	Up to 1,000V			HV (High Voltage)	Over 1,000V to 11,000V			EHV (Extra High Voltage)	22,000V to 132,000V			Transmission	275,000V and 400,000V			NORMAL DEPTH TO THE TOP OF THE CABLE WHEN LAID				Services	LV	HV	EHV	Footpath/Unmade	0.45m	0.45m	0.6m	Road Crossing	0.6m	0.6m	0.75m	Agricultural	1m	1m	1.1m
Voltages (V)	
LV (Low Voltage) and Services	Up to 1,000V	
HV (High Voltage)	Over 1,000V to 11,000V	
EHV (Extra High Voltage)	22,000V to 132,000V	
Transmission	275,000V and 400,000V	
NORMAL DEPTH TO THE TOP OF THE CABLE WHEN LAID	
Services	LV	HV	EHV																																						
Footpath/Unmade	0.45m	0.45m	0.6m																																						
Road Crossing	0.6m	0.6m	0.75m																																						
Agricultural	1m	1m	1.1m																																						
<p>Scale: 1:500 (When plotted at A4)</p>	<p>Based upon the Ordnance Survey map with the sanction of the Controller of Her Majesty's Stationery Office Crown Copyright Reserved.</p> <p>This copy has been made by or with the authority of Scottish and Southern Energy Power Distribution Ltd. Pursuant to section 47 of the Copyright, Designs and Patents Act 1988 ('The Act'). Unless the Act provides a relevant exception to copyright the copy must not be copied without prior permission of the copyright owner.</p> <p>Plans generated by DigSAFE Pro™ software provided by Linesearchbeforedig.</p>	
<p>Southern Electric Power Distribution plc Registered Office: No.1 Forbury Place 43 Forbury Road Reading RG1 3JH Registered In England & Wales No.04094290</p> <p>If you're unsure & need to seek advice before commencing excavations, please contact: General Enquiries: 0800 048 3516</p> <p>Subject to revision - Master held by SSEN Asset Data Team: Asset.Data@sse.com 01256 337 294</p>	

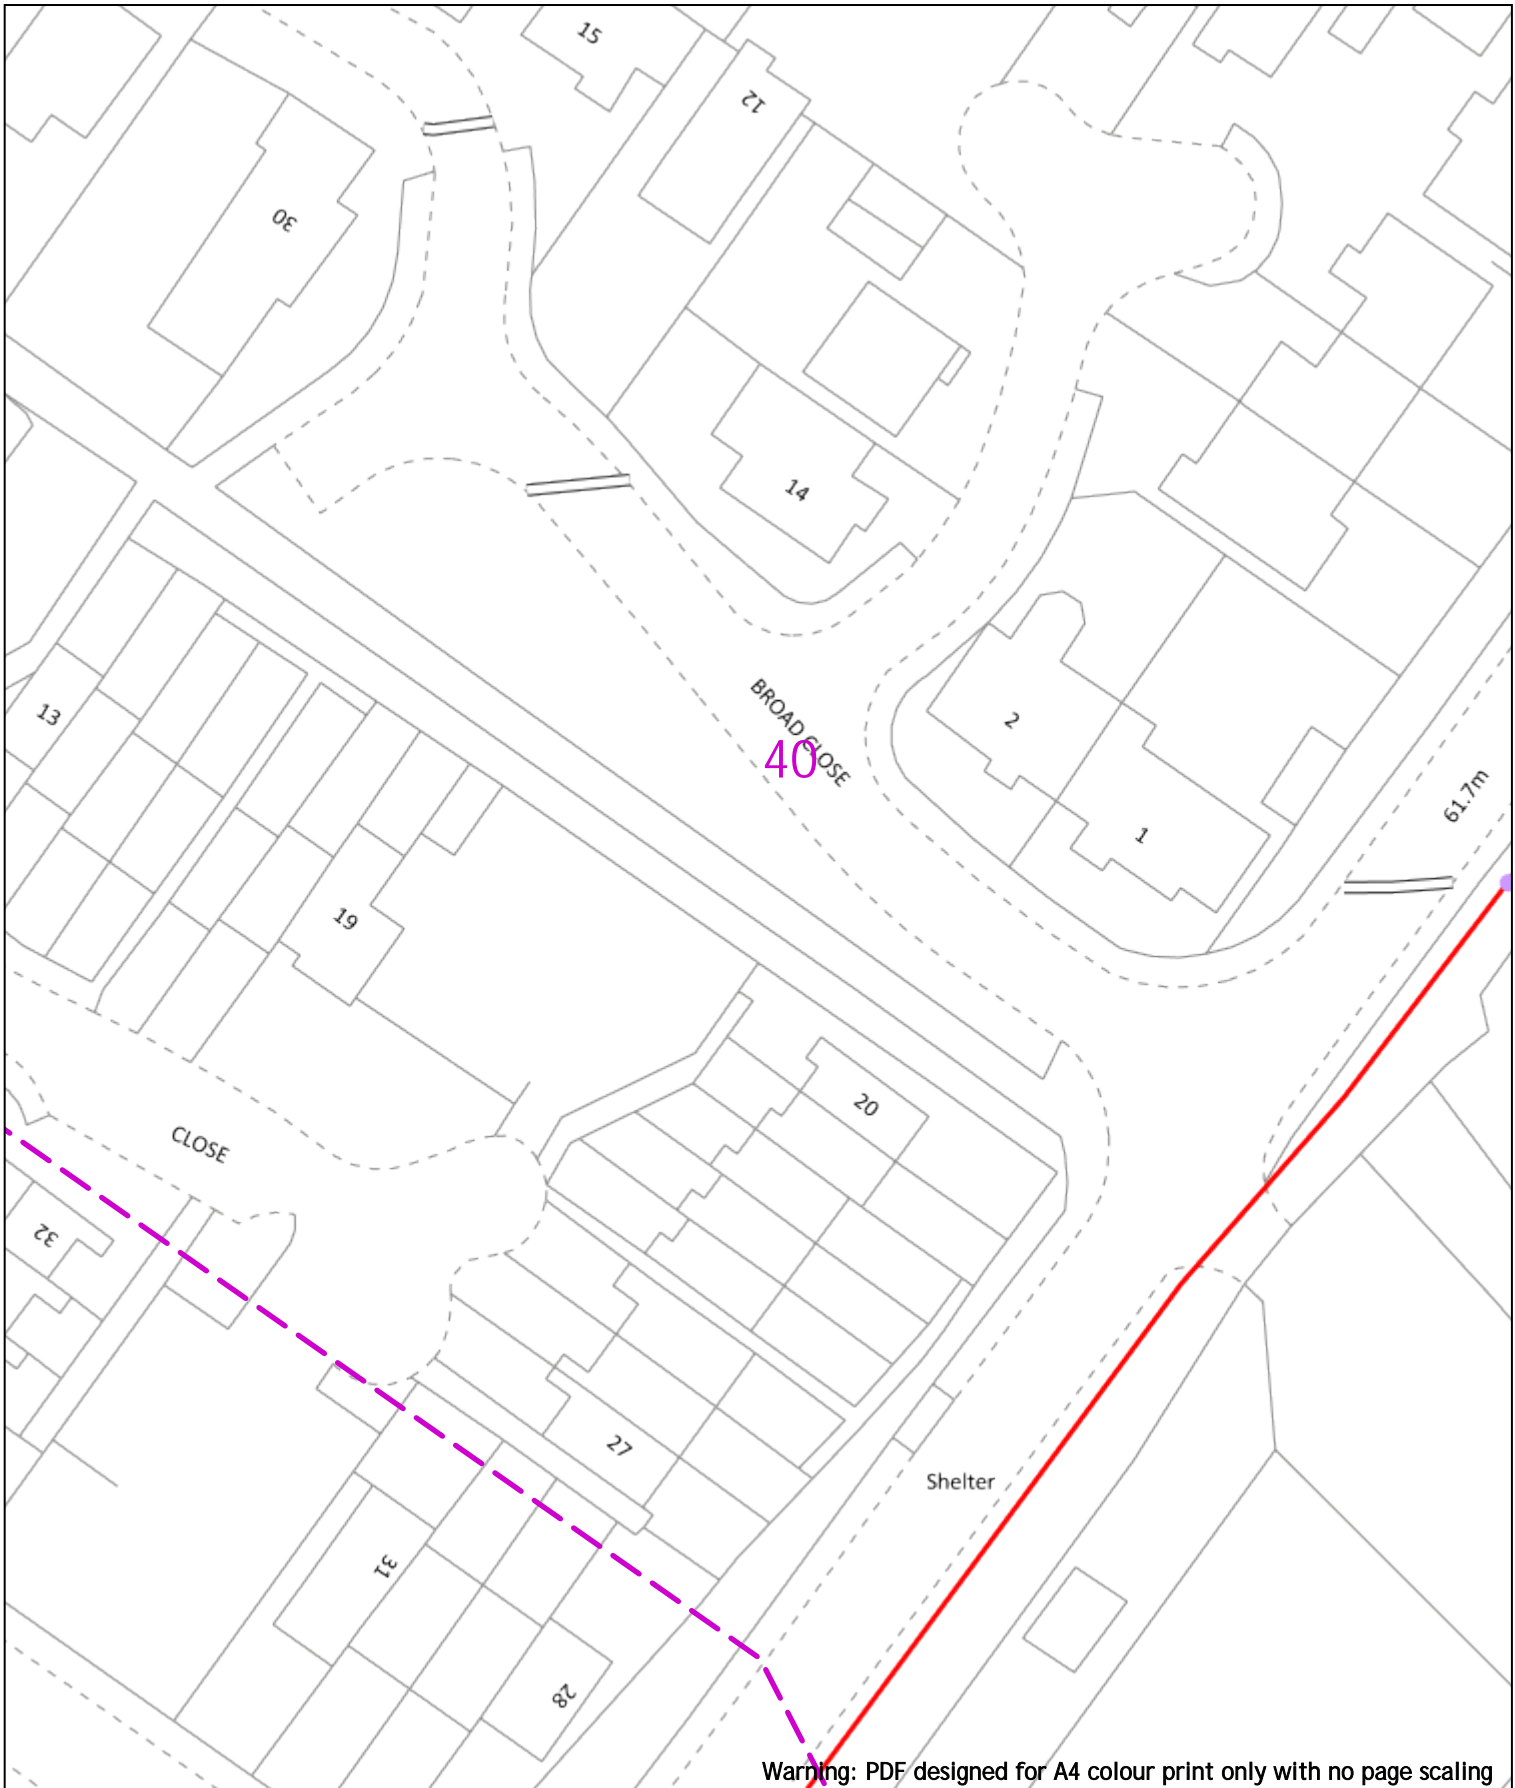

0 20m Dig Sites Area: Line: **Extra High Voltage cables in vicinity**

Date Requested: 24/06/2022
 Job Reference: 25881010
 Site Location: 448066 213346
 Requested by: Mr Joe Shawyer
 Your Scheme/Reference: 31188_002

Voltages (V)	
LV (Low Voltage) and Services	Up to 1,000V
HV (High Voltage)	Over 1,000V to 11,000V
EHV (Extra High Voltage)	22,000V to 132,000V
Transmission	275,000V and 400,000V

NORMAL DEPTH TO THE TOP OF THE CABLE WHEN LAID			
Services	LV	HV	EHV
Footpath/Unmade	0.45m	0.45m	0.6m
Road Crossing	0.6m	0.6m	0.75m
Agricultural	1m	1m	1.1m

Legend	
	Service Cable
	LV Mains
	7 - 11kV
	66kV
	11kV
	22kV
	33kV
	66kV
	132kV
	275kV
	400kV
	Fibre Optic
	Pipe Cable

Distribution Structures (Electric)	
	Pole, Existing Location
	Pole Structure, Existing Location - Single
	Pole Structure, Existing Location - H
	Duct Route
	Cross Section Route

WARNING
 There may have been subsequent alteration to the surface levels. Trial holes must be undertaken to determine position and depths of cables. HS (G) 47 Booklet from the Health and Safety Executive - Avoiding Danger from Buried Cables - should be consulted before commencing excavation work.
 WHEN WORKING IN THE VICINITY OF OVERHEAD LINES THE HEALTH AND SAFETY GUIDANCE NOTES G56 SHOULD BE CONSULTED (AVAILABLE FROM THE HSE WEBSITE)

Scale: 1:500 (When plotted at A4)

Southern Electric Power Distribution plc
 Registered Office: No.1 Forbury Place
 43 Forbury Road Reading RG1 3JH
 Registered In England & Wales No.04094290

If you're unsure & need to seek advice before commencing excavations, please contact:
 General Enquiries: 0800 048 3516

Subject to revision - Master held by SSEN Asset Data Team:
Asset.Data@sse.com
 01256 337 294

BASED UPON THE ORDNANCE SURVEY MAP WITH THE SANCTION OF THE CONTROLLER OF HM STATIONERY OFFICE CROWN COPYRIGHT RESERVED.
 This copy has been made by or with the authority of Scottish and Southern Energy Power Distribution Ltd. Pursuant to section 47 of the Copyright, Designs and Patents Act 1988 ('The Act'). Unless the Act provides a relevant exception to copyright the copy must not be copied without prior permission of the copyright owner.
 Plans generated by DigSAFE Pro™ software provided by LinesearchbeforeDigs.

68.9m

41

Cycle Track

11kV_075x33C PL

Warning: PDF designed for A4 colour print only with no page scaling

0 20m Dig Sites

Area: [Dashed Purple Box]

Line: [Dashed Purple Line]

Extra High Voltage cables in vicinity



Date Requested: 24/06/2022
Job Reference: 25881010
Site Location: 448066 213346
Requested by: Mr Joe Shawyer
Your Scheme/Reference: 31188_002

Voltages (V)				
LV (Low Voltage) and Services	Up to 1,000V			
HV (High Voltage)	Over 1,000V to 11,000V			
EHV (Extra High Voltage)	22,000V to 132,000V			
Transmission	275,000V and 400,000V			
NORMAL DEPTH TO THE TOP OF THE CABLE WHEN LAID				
Services	LV	HV	EHV	

Legend	
[Yellow Line]	Service Cable
[Red Line]	LV Mains
[Blue Line]	2 - 11kV
[Green Line]	66kV
[Light Purple Line]	275kV
[Light Orange Line]	400kV
[Light Yellow Line]	Fibre Optic
[Light Blue Line]	Pipe Cable

Distribution Structures (Electric)	
[Purple Circle]	Pole, Existing Location
[Purple Square]	Pole Structure, Existing Location - Single
[Purple Triangle]	Pole Structure, Existing Location - H
[Blue Line]	Duct Route
[Red Line]	Cross Section Route

Southern Electric Power Distribution plc
Registered Office: No.1 Forbury Place
43 Forbury Road Reading RG1 3JH
Registered In England & Wales No.04094290

If you're unsure & need to seek advice before commencing excavations, please contact:
General Enquiries: 0800 048 3516

Scale: 1:500 (When plotted at A4)


WARNING
There may have been subsequent alteration to the surface levels. Trial holes must be undertaken to determine position and depths of cables. HS (G) 47 Booklet from the Health and Safety Executive - Avoiding Danger from Buried Cables - should be consulted before commencing excavation work.
WHEN WORKING IN THE VICINITY OF OVERHEAD LINES THE HEALTH AND SAFETY GUIDANCE NOTES G56 SHOULD BE CONSULTED (AVAILABLE FROM THE HSE WEBSITE)

Subject to revision - Master held by SSEN Asset Data Team:
Asset.Data@sse.com
01256 337 294



Warning: PDF designed for A4 colour print only with no page scaling

<p>0 20m</p> <p>Date Requested: 24/06/2022 Job Reference: 25881010 Site Location: 448066 213346 Requested by: Mr Joe Shawyer Your Scheme/Reference: 31188_002</p>	<p>Dig Sites Area: Line: </p>	<p>Extra High Voltage cables in vicinity</p>	
<table border="1" style="width: 100%; border-collapse: collapse;"> <thead> <tr> <th colspan="4">Voltages (V)</th> </tr> </thead> <tbody> <tr> <td>LV (Low Voltage) and Services</td> <td colspan="3">Up to 1,000V</td> </tr> <tr> <td>HV (High Voltage)</td> <td colspan="3">Over 1,000V to 11,000V</td> </tr> <tr> <td>EHV (Extra High Voltage)</td> <td colspan="3">22,000V to 132,000V</td> </tr> <tr> <td>Transmission</td> <td colspan="3">275,000V and 400,000V</td> </tr> <tr> <th colspan="4">NORMAL DEPTH TO THE TOP OF THE CABLE WHEN LAID</th> </tr> <tr> <td>Services</td> <td>LV</td> <td>HV</td> <td>EHV</td> </tr> <tr> <td>Footpath/Unmade</td> <td>0.45m</td> <td>0.45m</td> <td>0.6m</td> </tr> <tr> <td>Road Crossing</td> <td>0.6m</td> <td>0.6m</td> <td>0.75m</td> </tr> <tr> <td>Agricultural</td> <td>1m</td> <td>1m</td> <td>1.1m</td> </tr> </tbody> </table>		Voltages (V)				LV (Low Voltage) and Services	Up to 1,000V			HV (High Voltage)	Over 1,000V to 11,000V			EHV (Extra High Voltage)	22,000V to 132,000V			Transmission	275,000V and 400,000V			NORMAL DEPTH TO THE TOP OF THE CABLE WHEN LAID				Services	LV	HV	EHV	Footpath/Unmade	0.45m	0.45m	0.6m	Road Crossing	0.6m	0.6m	0.75m	Agricultural	1m	1m	1.1m	<table border="1" style="width: 100%; border-collapse: collapse;"> <thead> <tr> <th colspan="2">Legend</th> <th colspan="2">Distribution Structures (Electric)</th> </tr> </thead> <tbody> <tr> <td></td> <td>Service Cable</td> <td></td> <td>Pole, Existing Location</td> </tr> <tr> <td></td> <td>LV Mains</td> <td></td> <td>Pole Structure, Existing Location - Single</td> </tr> <tr> <td></td> <td>2 - 11kV</td> <td></td> <td>Pole Structure, Existing Location - H</td> </tr> <tr> <td></td> <td>66kV</td> <td></td> <td>Duct Route</td> </tr> <tr> <td></td> <td>11kV</td> <td></td> <td>Cross Section Route</td> </tr> <tr> <td></td> <td>22kV</td> <td></td> <td></td> </tr> <tr> <td></td> <td>33kV</td> <td></td> <td></td> </tr> <tr> <td></td> <td>66kV</td> <td></td> <td></td> </tr> <tr> <td></td> <td>132kV</td> <td></td> <td></td> </tr> <tr> <td></td> <td>275kV</td> <td></td> <td></td> </tr> <tr> <td></td> <td>400kV</td> <td></td> <td></td> </tr> <tr> <td></td> <td>Fibre Optic</td> <td></td> <td></td> </tr> <tr> <td></td> <td>Pipe Cable</td> <td></td> <td></td> </tr> </tbody> </table>		Legend		Distribution Structures (Electric)			Service Cable		Pole, Existing Location		LV Mains		Pole Structure, Existing Location - Single		2 - 11kV		Pole Structure, Existing Location - H		66kV		Duct Route		11kV		Cross Section Route		22kV				33kV				66kV				132kV				275kV				400kV				Fibre Optic				Pipe Cable		
Voltages (V)	
LV (Low Voltage) and Services	Up to 1,000V	
HV (High Voltage)	Over 1,000V to 11,000V	
EHV (Extra High Voltage)	22,000V to 132,000V	
Transmission	275,000V and 400,000V	
NORMAL DEPTH TO THE TOP OF THE CABLE WHEN LAID	
Services	LV	HV	EHV	
Footpath/Unmade	0.45m	0.45m	0.6m	
Road Crossing	0.6m	0.6m	0.75m	
Agricultural	1m	1m	1.1m	
Legend		Distribution Structures (Electric)	
	Service Cable		Pole, Existing Location	
	LV Mains		Pole Structure, Existing Location - Single	
	2 - 11kV		Pole Structure, Existing Location - H	
	66kV		Duct Route	
	11kV		Cross Section Route	
	22kV	
	33kV	
	66kV	
	132kV	
	275kV	
	400kV	
	Fibre Optic	
	Pipe Cable	
<p>Scale: 1:500 (When plotted at A4)</p>		<p>WARNING</p> <p>There may have been subsequent alteration to the surface levels. Trial holes must be undertaken to determine position and depths of cables. HS (G) 47 Booklet from the Health and Safety Executive - Avoiding Danger from Buried Cables - should be consulted before commencing excavation work.</p> <p>WHEN WORKING IN THE VICINITY OF OVERHEAD LINES THE HEALTH AND SAFETY GUIDANCE NOTES G56 SHOULD BE CONSULTED (AVAILABLE FROM THE HSE WEBSITE)</p>		<p style="text-align: center;">Southern Electric Power Distribution plc Registered Office: No.1 Forbury Place 43 Forbury Road Reading RG1 3JH Registered In England & Wales No.04094290</p> <p>If you're unsure & need to seek advice before commencing excavations, please contact: General Enquiries: 0800 048 3516</p> <p>Subject to revision - Master held by SSEN Asset Data Team: Asset.Data@sse.com 01256 337 294</p>	

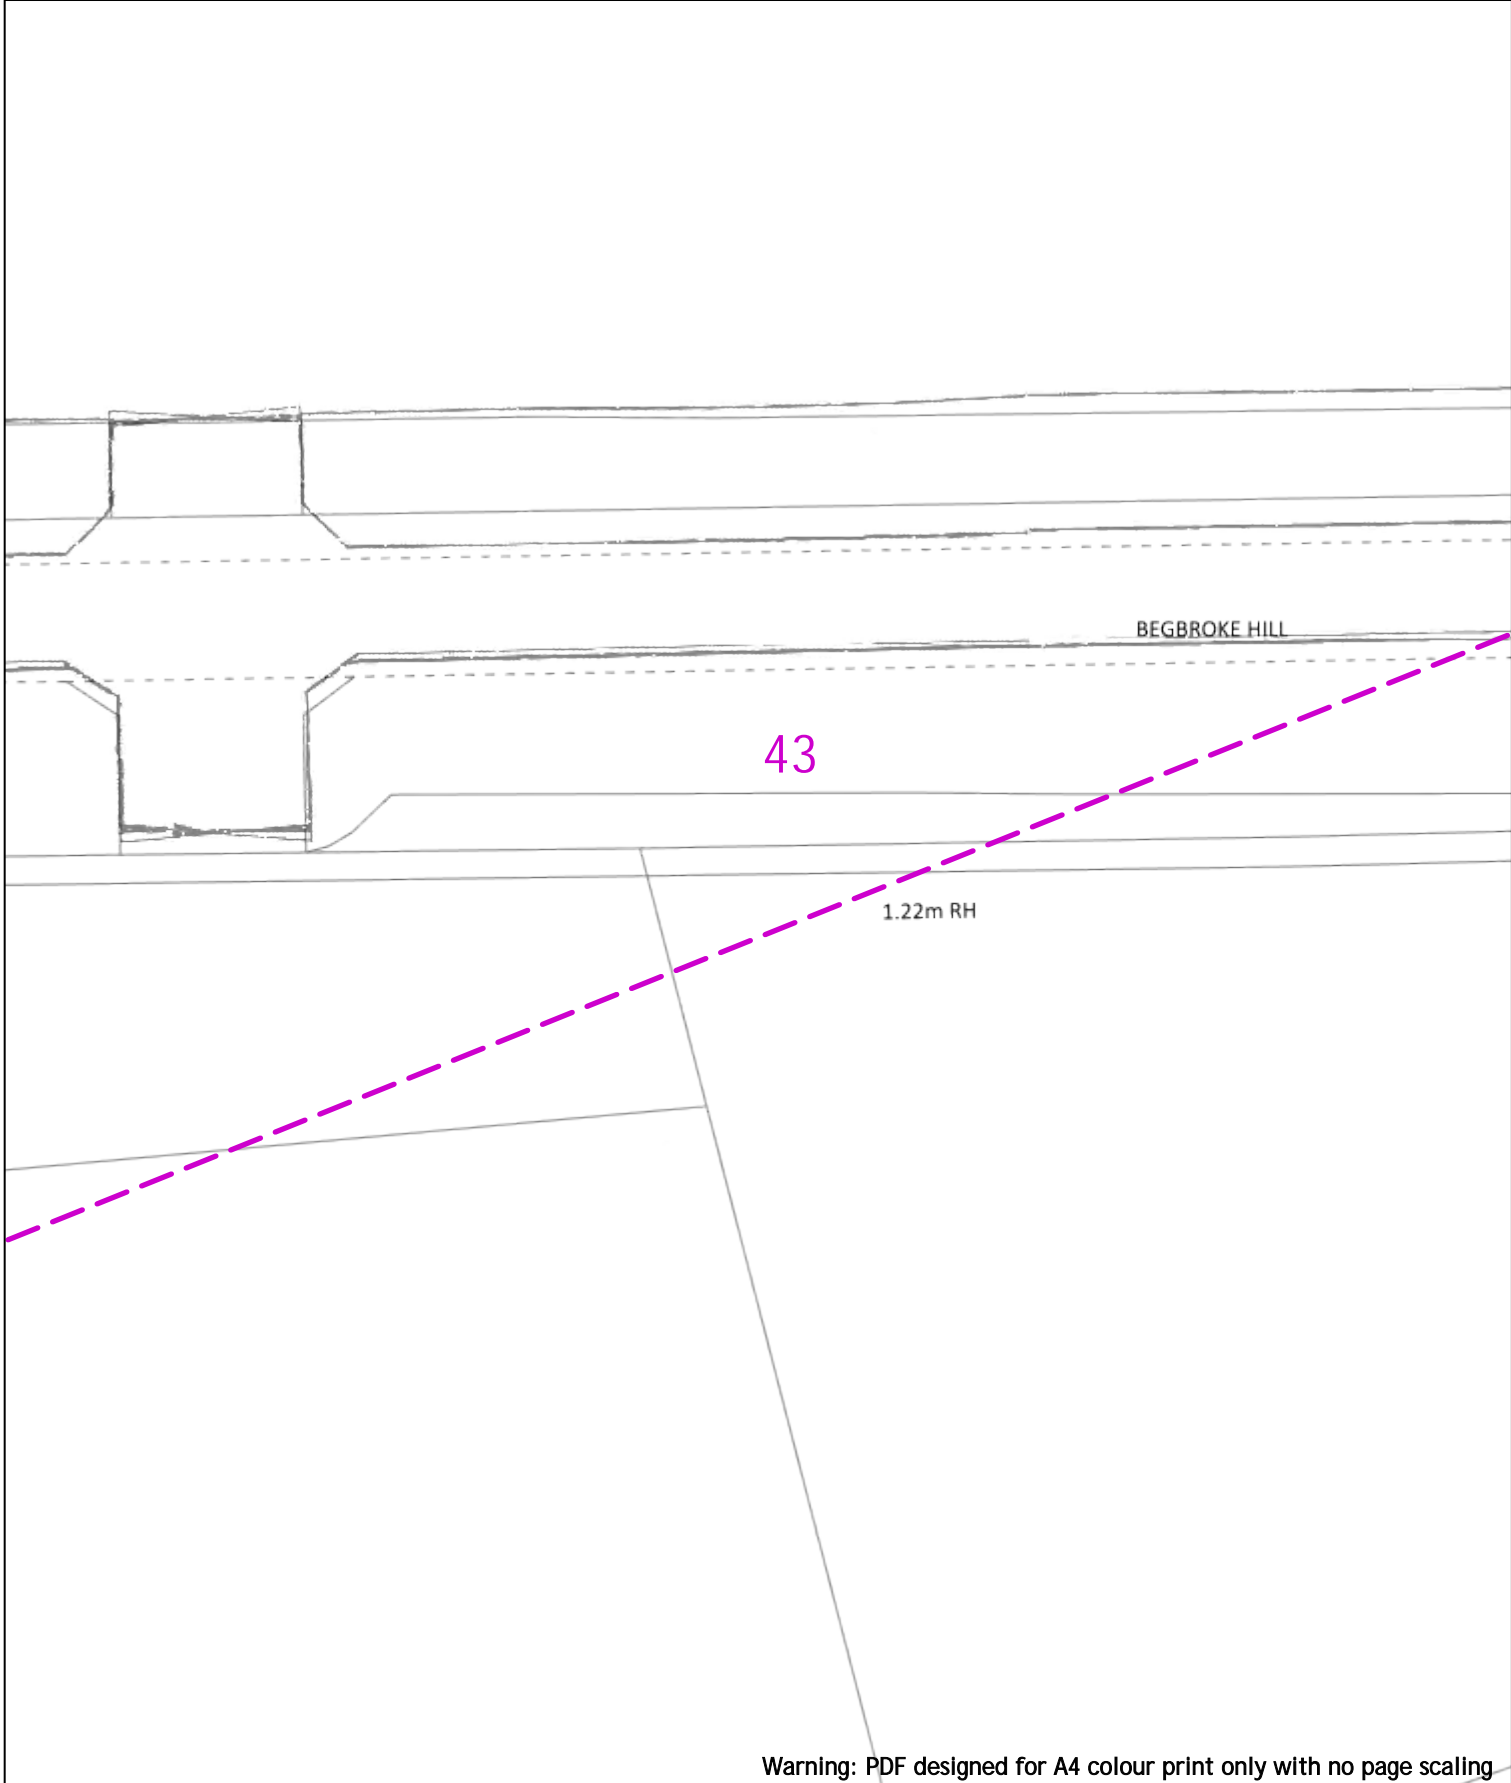

Warning: PDF designed for A4 colour print only with no page scaling

20m Dig Sites Area: Line:

**Extra High Voltage
cables in vicinity**

Date Requested: 24/06/2022
 Job Reference: 25881010
 Site Location: 448066 213346
 Requested by: Mr Joe Shawyer
 Your Scheme/Reference: 31188_002

Voltages (V)				
LV (Low Voltage) and Services	Up to 1,000V			
HV (High Voltage)	Over 1,000V to 11,000V			
EHV (Extra High Voltage)	22,000V to 132,000V			
Transmission	275,000V and 400,000V			
NORMAL DEPTH TO THE TOP OF THE CABLE WHEN LAID				
Services	LV	HV	EHV	
Footpath/Unmade	0.45m	0.45m	0.6m	0.8m
Road Crossing	0.6m	0.6m	0.75m	0.9m
Agricultural	1m	1m	1m	1.1m

Legend		Distribution Structures (Electric)	
	Service Cable		Pole, Existing Location
	LV Mains		Pole Structure, Existing Location - Single
	2 - 11kV		Pole Structure, Existing Location - H
	66kV		Duct Route
	11kV		Cross Section Route
	22kV		
	33kV		
	66kV		
	132kV		
	275kV		
	400kV		
	Fibre Optic		
	Pipe Cable		

WARNING
 There may have been subsequent alteration to the surface levels. Trial holes must be undertaken to determine position and depths of cables. HS (G) 47 Booklet from the Health and Safety Executive - Avoiding Danger from Buried Cables - should be consulted before commencing excavation work.
WHEN WORKING IN THE VICINITY OF OVERHEAD LINES THE HEALTH AND SAFETY GUIDANCE NOTES G56 SHOULD BE CONSULTED (AVAILABLE FROM THE HSE WEBSITE)


Scale: 1:500 (When plotted at A4)

Southern Electric Power Distribution plc
 Registered Office: No.1 Forbury Place
 43 Forbury Road Reading RG1 3JH
 Registered In England & Wales No.04094290

If you're unsure & need to seek advice before commencing excavations, please contact:
 General Enquiries: 0800 048 3516


Subject to revision - Master held by SSEN Asset Data Team:
Asset.Data@sse.com
 01256 337 294

BASED UPON THE ORDNANCE SURVEY MAP WITH THE SANCTION OF THE CONTROLLER OF HM STATIONERY OFFICE CROWN COPYRIGHT RESERVED.
 This copy has been made by or with the authority of Scottish and Southern Energy Power Distribution Ltd. Pursuant to section 47 of the Copyright, Designs and Patents Act 1988 ("The Act"). Unless the Act provides a relevant exception to copyright the copy must not be copied without prior permission of the copyright owner.
 Plans generated by DigSAFE Pro™ software provided by Linesearchbeforedig.

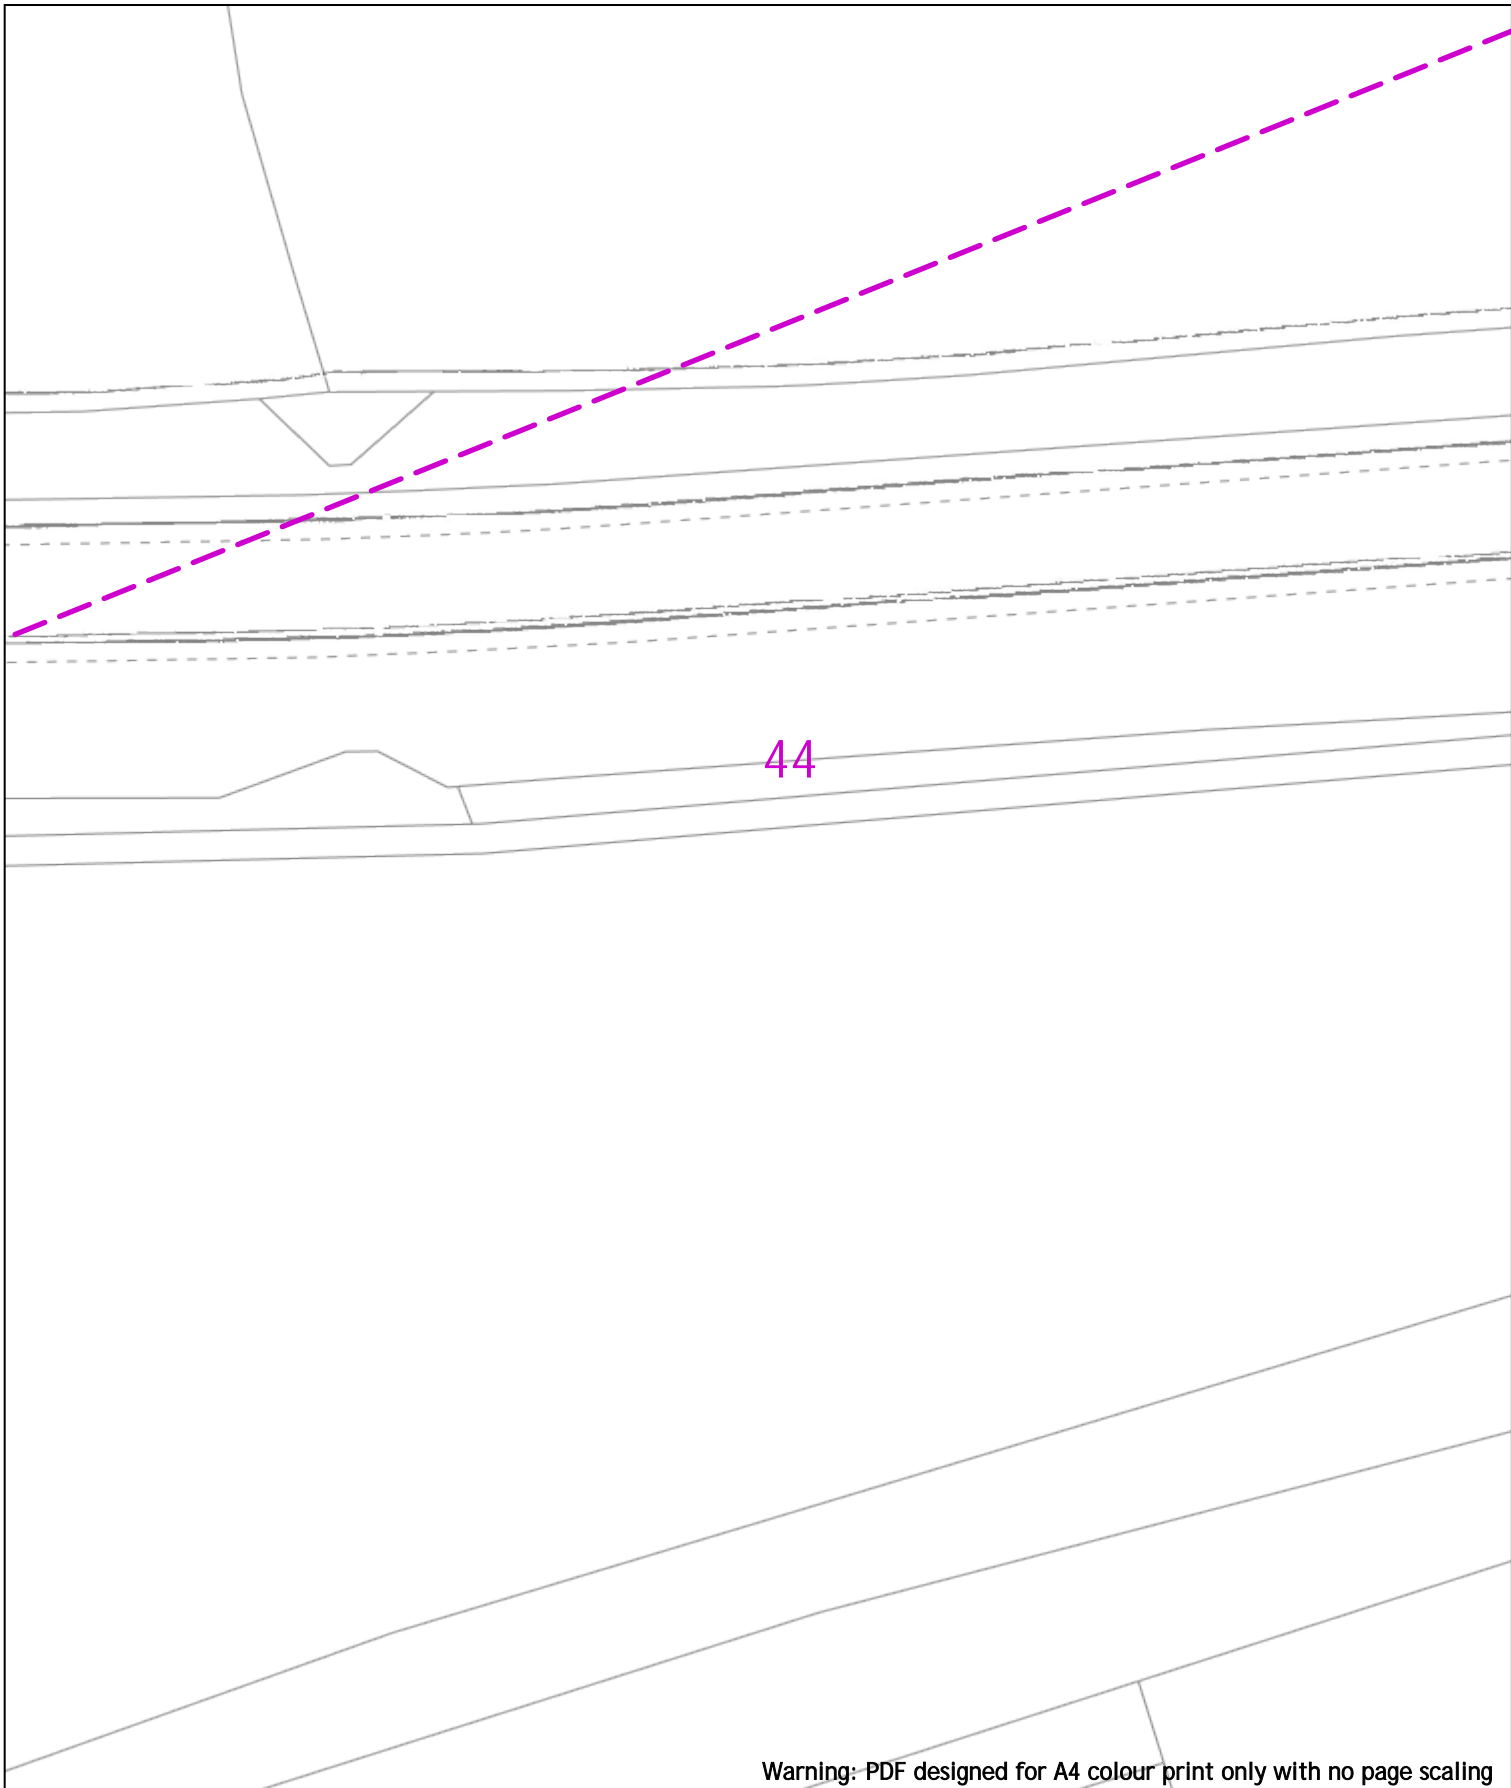

Warning: PDF designed for A4 colour print only with no page scaling

<p>0 20m Dig Sites Area: Line: Extra High Voltage cables in vicinity</p>	<p>Legend</p> <table style="font-size: small;"> <tr><td></td><td>Service Cable</td></tr> <tr><td></td><td>LV Mains</td></tr> <tr><td></td><td>2 - 11kV</td></tr> <tr><td></td><td>66kV</td></tr> <tr><td></td><td>11kV</td></tr> <tr><td></td><td>22kV</td></tr> <tr><td></td><td>33kV</td></tr> <tr><td></td><td>66kV</td></tr> <tr><td></td><td>132kV</td></tr> <tr><td></td><td>275kV</td></tr> <tr><td></td><td>400kV</td></tr> <tr><td></td><td>Fibre Optic</td></tr> <tr><td></td><td>Pipe Cable</td></tr> </table> <p>Distribution Structures (Electric)</p> <table style="font-size: small;"> <tr><td></td><td>Pole, Existing Location</td></tr> <tr><td></td><td>Pole Structure, Existing Location - Single</td></tr> <tr><td></td><td>Pole Structure, Existing Location - H</td></tr> <tr><td></td><td>Duct Route</td></tr> <tr><td></td><td>Cross Section Route</td></tr> </table>		Service Cable		LV Mains		2 - 11kV		66kV		11kV		22kV		33kV		66kV		132kV		275kV		400kV		Fibre Optic		Pipe Cable		Pole, Existing Location		Pole Structure, Existing Location - Single		Pole Structure, Existing Location - H		Duct Route		Cross Section Route			<p>Southern Electric Power Distribution plc Registered Office: No.1 Forbury Place 43 Forbury Road Reading RG1 3JH Registered In England & Wales No.04094290</p> <p>If you're unsure & need to seek advice before commencing excavations, please contact: General Enquiries: 0800 048 3516</p> <p>Subject to revision – Master held by SSEN Asset Data Team: Asset.Data@sse.com 01256 337 294</p>									
	Service Cable	
	LV Mains	
	2 - 11kV	
	66kV	
	11kV	
	22kV	
	33kV	
	66kV	
	132kV	
	275kV	
	400kV	
	Fibre Optic	
	Pipe Cable	
	Pole, Existing Location	
	Pole Structure, Existing Location - Single	
	Pole Structure, Existing Location - H	
	Duct Route	
	Cross Section Route	
<p>Date Requested: 24/06/2022 Job Reference: 25881010 Site Location: 448066 213346 Requested by: Mr Joe Shawyer Your Scheme/Reference: 31188_002</p>	<table style="font-size: x-small; border-collapse: collapse;"> <thead> <tr><th colspan="4">Voltages (V)</th></tr> </thead> <tbody> <tr><td>LV (Low Voltage) and Services</td><td colspan="3">Up to 1,000V</td></tr> <tr><td>HV (High Voltage)</td><td colspan="3">Over 1,000V to 11,000V</td></tr> <tr><td>EHV (Extra High Voltage)</td><td colspan="3">22,000V to 132,000V</td></tr> <tr><td>Transmission</td><td colspan="3">275,000V and 400,000V</td></tr> </tbody> </table> <table style="font-size: x-small; border-collapse: collapse;"> <thead> <tr><th colspan="5">NORMAL DEPTH TO THE TOP OF THE CABLE WHEN LAID</th></tr> <tr><th>Services</th><th>LV</th><th>HV</th><th>EHV</th><th></th></tr> </thead> <tbody> <tr><td>Footpath/Unmade</td><td>0.45m</td><td>0.45m</td><td>0.6m</td><td>0.8m</td></tr> <tr><td>Road Crossing</td><td>0.6m</td><td>0.6m</td><td>0.75m</td><td>0.9m</td></tr> <tr><td>Agricultural</td><td>1m</td><td>1m</td><td>1m</td><td>1.1m</td></tr> </tbody> </table>	Voltages (V)				LV (Low Voltage) and Services	Up to 1,000V			HV (High Voltage)	Over 1,000V to 11,000V			EHV (Extra High Voltage)	22,000V to 132,000V			Transmission	275,000V and 400,000V			NORMAL DEPTH TO THE TOP OF THE CABLE WHEN LAID					Services	LV	HV	EHV		Footpath/Unmade	0.45m	0.45m	0.6m	0.8m	Road Crossing	0.6m	0.6m	0.75m	0.9m	Agricultural	1m	1m	1m	1.1m	<p>WARNING</p> <p>There may have been subsequent alteration to the surface levels. Trial holes must be undertaken to determine position and depths of cables. HS (G) 47 Booklet from the Health and Safety Executive – Avoiding Danger from Buried Cables – should be consulted before commencing excavation work.</p> <p>WHEN WORKING IN THE VICINITY OF OVERHEAD LINES THE HEALTH AND SAFETY GUIDANCE NOTES G66 SHOULD BE CONSULTED (AVAILABLE FROM THE HSE WEBSITE)</p>		
Voltages (V)	
LV (Low Voltage) and Services	Up to 1,000V	
HV (High Voltage)	Over 1,000V to 11,000V	
EHV (Extra High Voltage)	22,000V to 132,000V	
Transmission	275,000V and 400,000V	
NORMAL DEPTH TO THE TOP OF THE CABLE WHEN LAID	
Services	LV	HV	EHV	
Footpath/Unmade	0.45m	0.45m	0.6m	0.8m	
Road Crossing	0.6m	0.6m	0.75m	0.9m	
Agricultural	1m	1m	1m	1.1m	
<p>Scale: 1:500 (When plotted at A4)</p> <p>BASED UPON THE ORDNANCE SURVEY MAP WITH THE SANCTION OF THE CONTROLLER OF H.M. STATIONERY OFFICE CROWN COPYRIGHT RESERVED. This copy has been made by or with the authority of Scottish and Southern Energy Power Distribution Ltd. Pursuant to section 47 of the Copyright, Designs and Patents Act 1988 ("The Act"). Unless the Act provides a relevant exception to copyright the copy must not be copied without prior permission of the copyright owner. Plans generated by DigSAFE Pro™ software provided by LinesearchbeforeUdig.</p>	

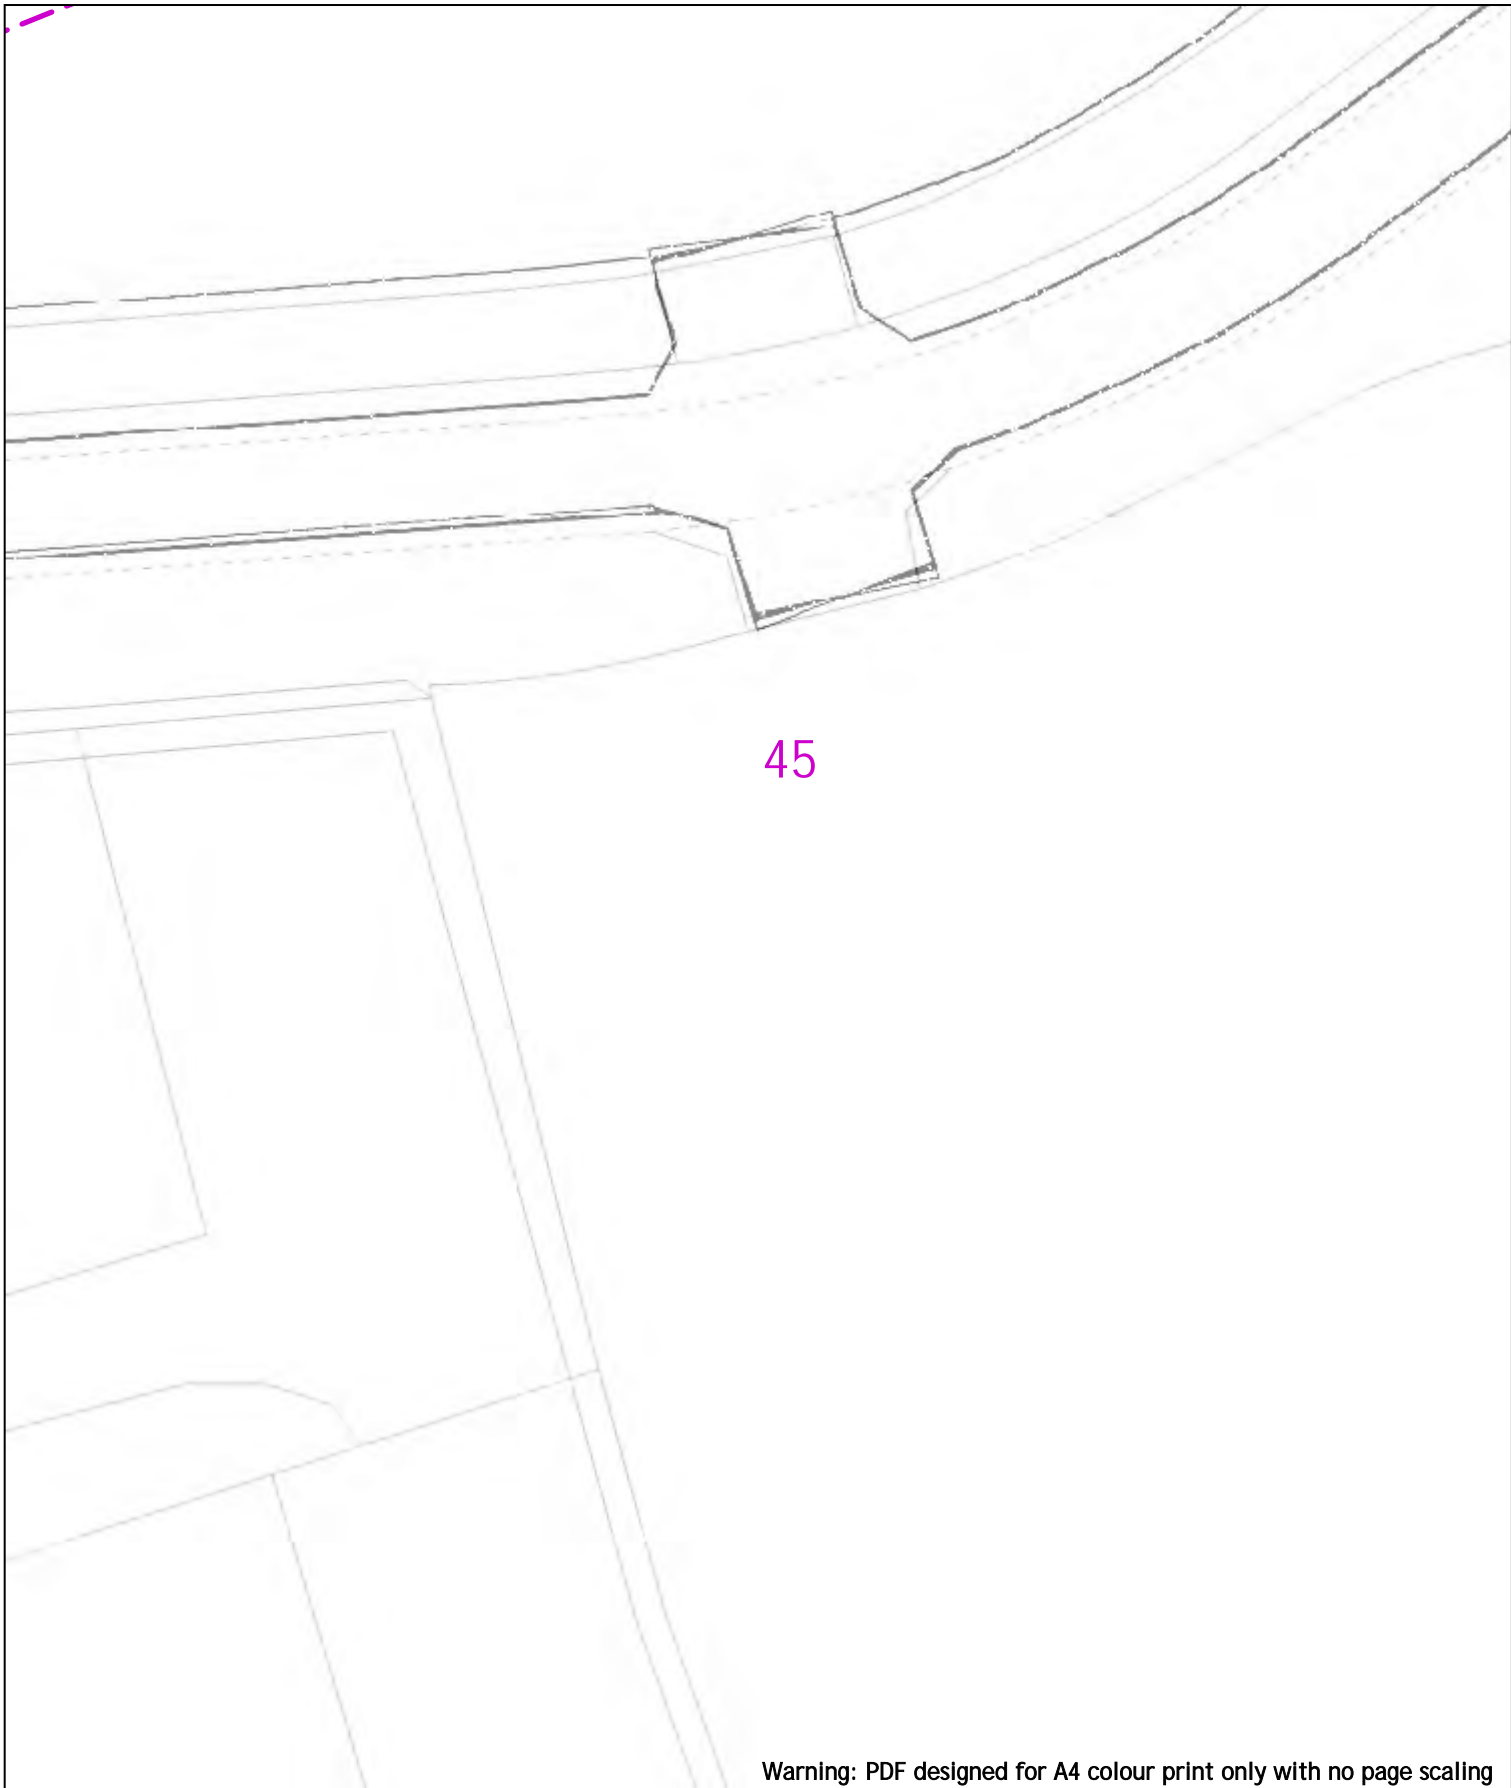

45


Warning: PDF designed for A4 colour print only with no page scaling

		Dig Sites Area: Line:	Extra High Voltage cables in vicinity	
Date Requested: 24/06/2022 Job Reference: 25881010 Site Location: 448066 213346 Requested by: Mr Joe Shawyer Your Scheme/Reference: 31188_002	<table border="1"> <thead> <tr> <th colspan="5">Voltages (V)</th> </tr> </thead> <tbody> <tr> <td>LV (Low Voltage) and Services</td> <td colspan="4">Up to 1,000V</td> </tr> <tr> <td>HV (High Voltage)</td> <td colspan="4">Over 1,000V to 11,000V</td> </tr> <tr> <td>EHV (Extra High Voltage)</td> <td colspan="4">22,000V to 132,000V</td> </tr> <tr> <td>Transmission</td> <td colspan="4">275,000V and 400,000V</td> </tr> </tbody> </table> <table border="1"> <thead> <tr> <th colspan="5">NORMAL DEPTH TO THE TOP OF THE CABLE WHEN LAID</th> </tr> <tr> <th>Services</th> <th>LV</th> <th>HV</th> <th>EHV</th> <th></th> </tr> </thead> <tbody> <tr> <td>Footpath/Unmade</td> <td>0.45m</td> <td>0.45m</td> <td>0.6m</td> <td>0.8m</td> </tr> <tr> <td>Road Crossing</td> <td>0.6m</td> <td>0.6m</td> <td>0.75m</td> <td>0.9m</td> </tr> <tr> <td>Agricultural</td> <td>1m</td> <td>1m</td> <td>1m</td> <td>1.1m</td> </tr> </tbody> </table>	Voltages (V)					LV (Low Voltage) and Services	Up to 1,000V				HV (High Voltage)	Over 1,000V to 11,000V				EHV (Extra High Voltage)	22,000V to 132,000V				Transmission	275,000V and 400,000V				NORMAL DEPTH TO THE TOP OF THE CABLE WHEN LAID					Services	LV	HV	EHV		Footpath/Unmade	0.45m	0.45m	0.6m	0.8m	Road Crossing	0.6m	0.6m	0.75m	0.9m	Agricultural	1m	1m	1m	1.1m	<table border="1"> <thead> <tr> <th colspan="2">Legend</th> </tr> </thead> <tbody> <tr> <td></td> <td>Service Cable</td> </tr> <tr> <td></td> <td>LV Mains</td> </tr> <tr> <td></td> <td>2 - 11kV</td> </tr> <tr> <td></td> <td>66kV</td> </tr> <tr> <td></td> <td>11kV</td> </tr> <tr> <td></td> <td>22kV</td> </tr> <tr> <td></td> <td>33kV</td> </tr> <tr> <td></td> <td>66kV</td> </tr> <tr> <td></td> <td>132kV</td> </tr> <tr> <td></td> <td>275kV</td> </tr> <tr> <td></td> <td>400kV</td> </tr> <tr> <td></td> <td>Fibre Optic</td> </tr> <tr> <td></td> <td>Pipe Cable</td> </tr> </tbody> </table> <table border="1"> <thead> <tr> <th colspan="2">Distribution Structures (Electric)</th> </tr> </thead> <tbody> <tr> <td></td> <td>Pole, Existing Location</td> </tr> <tr> <td></td> <td>Pole Structure, Existing Location - Single</td> </tr> <tr> <td></td> <td>Pole Structure, Existing Location - H</td> </tr> <tr> <td></td> <td>Duct Route</td> </tr> <tr> <td></td> <td>Cross Section Route</td> </tr> </tbody> </table>	Legend			Service Cable		LV Mains		2 - 11kV		66kV		11kV		22kV		33kV		66kV		132kV		275kV		400kV		Fibre Optic		Pipe Cable	Distribution Structures (Electric)			Pole, Existing Location		Pole Structure, Existing Location - Single		Pole Structure, Existing Location - H		Duct Route		Cross Section Route	<p style="text-align: center;">Southern Electric Power Distribution plc Registered Office: No.1 Forbury Place 43 Forbury Road Reading RG1 3JH Registered In England & Wales No.04094290</p> <p>If you're unsure & need to seek advice before commencing excavations, please contact: General Enquiries: 0800 048 3516</p> <p>Subject to revision – Master held by SSEN Asset Data Team: Asset.Data@sse.com 01256 337 294</p>
Voltages (V)	
LV (Low Voltage) and Services	Up to 1,000V	
HV (High Voltage)	Over 1,000V to 11,000V	
EHV (Extra High Voltage)	22,000V to 132,000V	
Transmission	275,000V and 400,000V	
NORMAL DEPTH TO THE TOP OF THE CABLE WHEN LAID	
Services	LV	HV	EHV	
Footpath/Unmade	0.45m	0.45m	0.6m	0.8m	
Road Crossing	0.6m	0.6m	0.75m	0.9m	
Agricultural	1m	1m	1m	1.1m	
Legend	
	Service Cable	
	LV Mains	
	2 - 11kV	
	66kV	
	11kV	
	22kV	
	33kV	
	66kV	
	132kV	
	275kV	
	400kV	
	Fibre Optic	
	Pipe Cable	
Distribution Structures (Electric)	
	Pole, Existing Location	
	Pole Structure, Existing Location - Single	
	Pole Structure, Existing Location - H	
	Duct Route	
	Cross Section Route	
<p>Scale: 1:500 (When plotted at A4)</p> <p style="color: red; font-size: small;">There may have been subsequent alteration to the surface levels. Trial holes must be undertaken to determine position and depths of cables. HS (G) 47 Booklet from the Health and Safety Executive – Avoiding Danger from Buried Cables – should be consulted before commencing excavation work. WHEN WORKING IN THE VICINITY OF OVERHEAD LINES THE HEALTH AND SAFETY GUIDANCE NOTES G56 SHOULD BE CONSULTED (AVAILABLE FROM THE HSE WEBSITE)</p> <p style="font-size: x-small; text-align: center;">BASED UPON THE ORDNANCE SURVEY MAP WITH THE SANCTION OF THE CONTROLLER OF H.M. STATIONERY OFFICE CROWN COPYRIGHT RESERVED. This copy has been made by or with the authority of Scottish and Southern Energy Power Distribution Ltd. Pursuant to section 47 of the Copyright, Designs and Patents Act 1988 ("The Act"). Unless the Act provides a relevant exception to copyright the copy must not be copied without prior permission of the copyright owner. Plans generated by DigSAFE Pro™ software provided by LinesearchbeforeUdig.</p>	




Warning: PDF designed for A4 colour print only with no page scaling

<p>0 20m Dig Sites Area: Line: </p>	<p>Extra High Voltage cables in vicinity</p>																																		
<p>Date Requested: 24/06/2022 Job Reference: 25881010 Site Location: 448066 213346 Requested by: Mr Joe Shawyer Your Scheme/Reference: 31188_002</p>	<p>Voltages (V)</p> <table border="1"> <tr> <td>LV (Low Voltage) and Services</td> <td colspan="3">Up to 1,000V</td> </tr> <tr> <td>HV (High Voltage)</td> <td colspan="3">Over 1,000V to 11,000V</td> </tr> <tr> <td>EHV (Extra High Voltage)</td> <td colspan="3">22,000V to 132,000V</td> </tr> <tr> <td>Transmission</td> <td colspan="3">275,000V and 400,000V</td> </tr> </table> <p>NORMAL DEPTH TO THE TOP OF THE CABLE WHEN LAID</p> <table border="1"> <thead> <tr> <th>Services</th> <th>LV</th> <th>HV</th> <th>EHV</th> </tr> </thead> <tbody> <tr> <td>Footpath/Unmade</td> <td>0.45m</td> <td>0.45m</td> <td>0.6m 0.8m</td> </tr> <tr> <td>Road Crossing</td> <td>0.6m</td> <td>0.6m</td> <td>0.75m 0.9m</td> </tr> <tr> <td>Agricultural</td> <td>1m</td> <td>1m</td> <td>1m 1.1m</td> </tr> </tbody> </table>	LV (Low Voltage) and Services	Up to 1,000V			HV (High Voltage)	Over 1,000V to 11,000V			EHV (Extra High Voltage)	22,000V to 132,000V			Transmission	275,000V and 400,000V			Services	LV	HV	EHV	Footpath/Unmade	0.45m	0.45m	0.6m 0.8m	Road Crossing	0.6m	0.6m	0.75m 0.9m	Agricultural	1m	1m	1m 1.1m	<p>Legend</p> <ul style="list-style-type: none"> Service Cable LV Mains 2 - 11kV 66kV 11kV 22kV 33kV 66kV 132kV 275kV 400kV Fibre Optic Pipe Cable <p>Distribution Structures (Electric)</p> <ul style="list-style-type: none"> Pole, Existing Location Pole Structure, Existing Location - Single Pole Structure, Existing Location - H Duct Route Cross Section Route <p>WARNING</p> <p>There may have been subsequent alteration to the surface levels. Trial holes must be undertaken to determine position and depths of cables. HS (G) 47 Booklet from the Health and Safety Executive - Avoiding Danger from Buried Cables - should be consulted before commencing excavation work.</p> <p>WHEN WORKING IN THE VICINITY OF OVERHEAD LINES THE HEALTH AND SAFETY GUIDANCE NOTES G56 SHOULD BE CONSULTED (AVAILABLE FROM THE HSE WEBSITE)</p>	<p>Southern Electric Power Distribution plc Registered Office: No.1 Forbury Place 43 Forbury Road Reading RG1 3JH Registered In England & Wales No.04094290</p> <p>If you're unsure & need to seek advice before commencing excavations, please contact: General Enquiries: 0800 048 3516</p> <p>Subject to revision - Master held by SSEN Asset Data Team: Asset.Data@sse.com 01256 337 294</p>
LV (Low Voltage) and Services	Up to 1,000V																																		
HV (High Voltage)	Over 1,000V to 11,000V																																		
EHV (Extra High Voltage)	22,000V to 132,000V																																		
Transmission	275,000V and 400,000V																																		
Services	LV	HV	EHV																																
Footpath/Unmade	0.45m	0.45m	0.6m 0.8m																																
Road Crossing	0.6m	0.6m	0.75m 0.9m																																
Agricultural	1m	1m	1m 1.1m																																
<p>Scale: 1:500 (When plotted at A4)</p> <p><small>BASED UPON THE ORDNANCE SURVEY MAP WITH THE SANCTION OF THE CONTROLLER OF HM STATIONERY OFFICE CROWN COPYRIGHT RESERVED. This copy has been made by or with the authority of Scottish and Southern Energy Power Distribution Ltd. Pursuant to section 47 of the Copyright, Designs and Patents Act 1988 ("The Act"). Unless the Act provides a relevant exception to copyright the copy must not be copied without prior permission of the copyright owner. Plans generated by DigSAFE Pro™ software provided by LinesearchbeforeUdig.</small></p>																																			

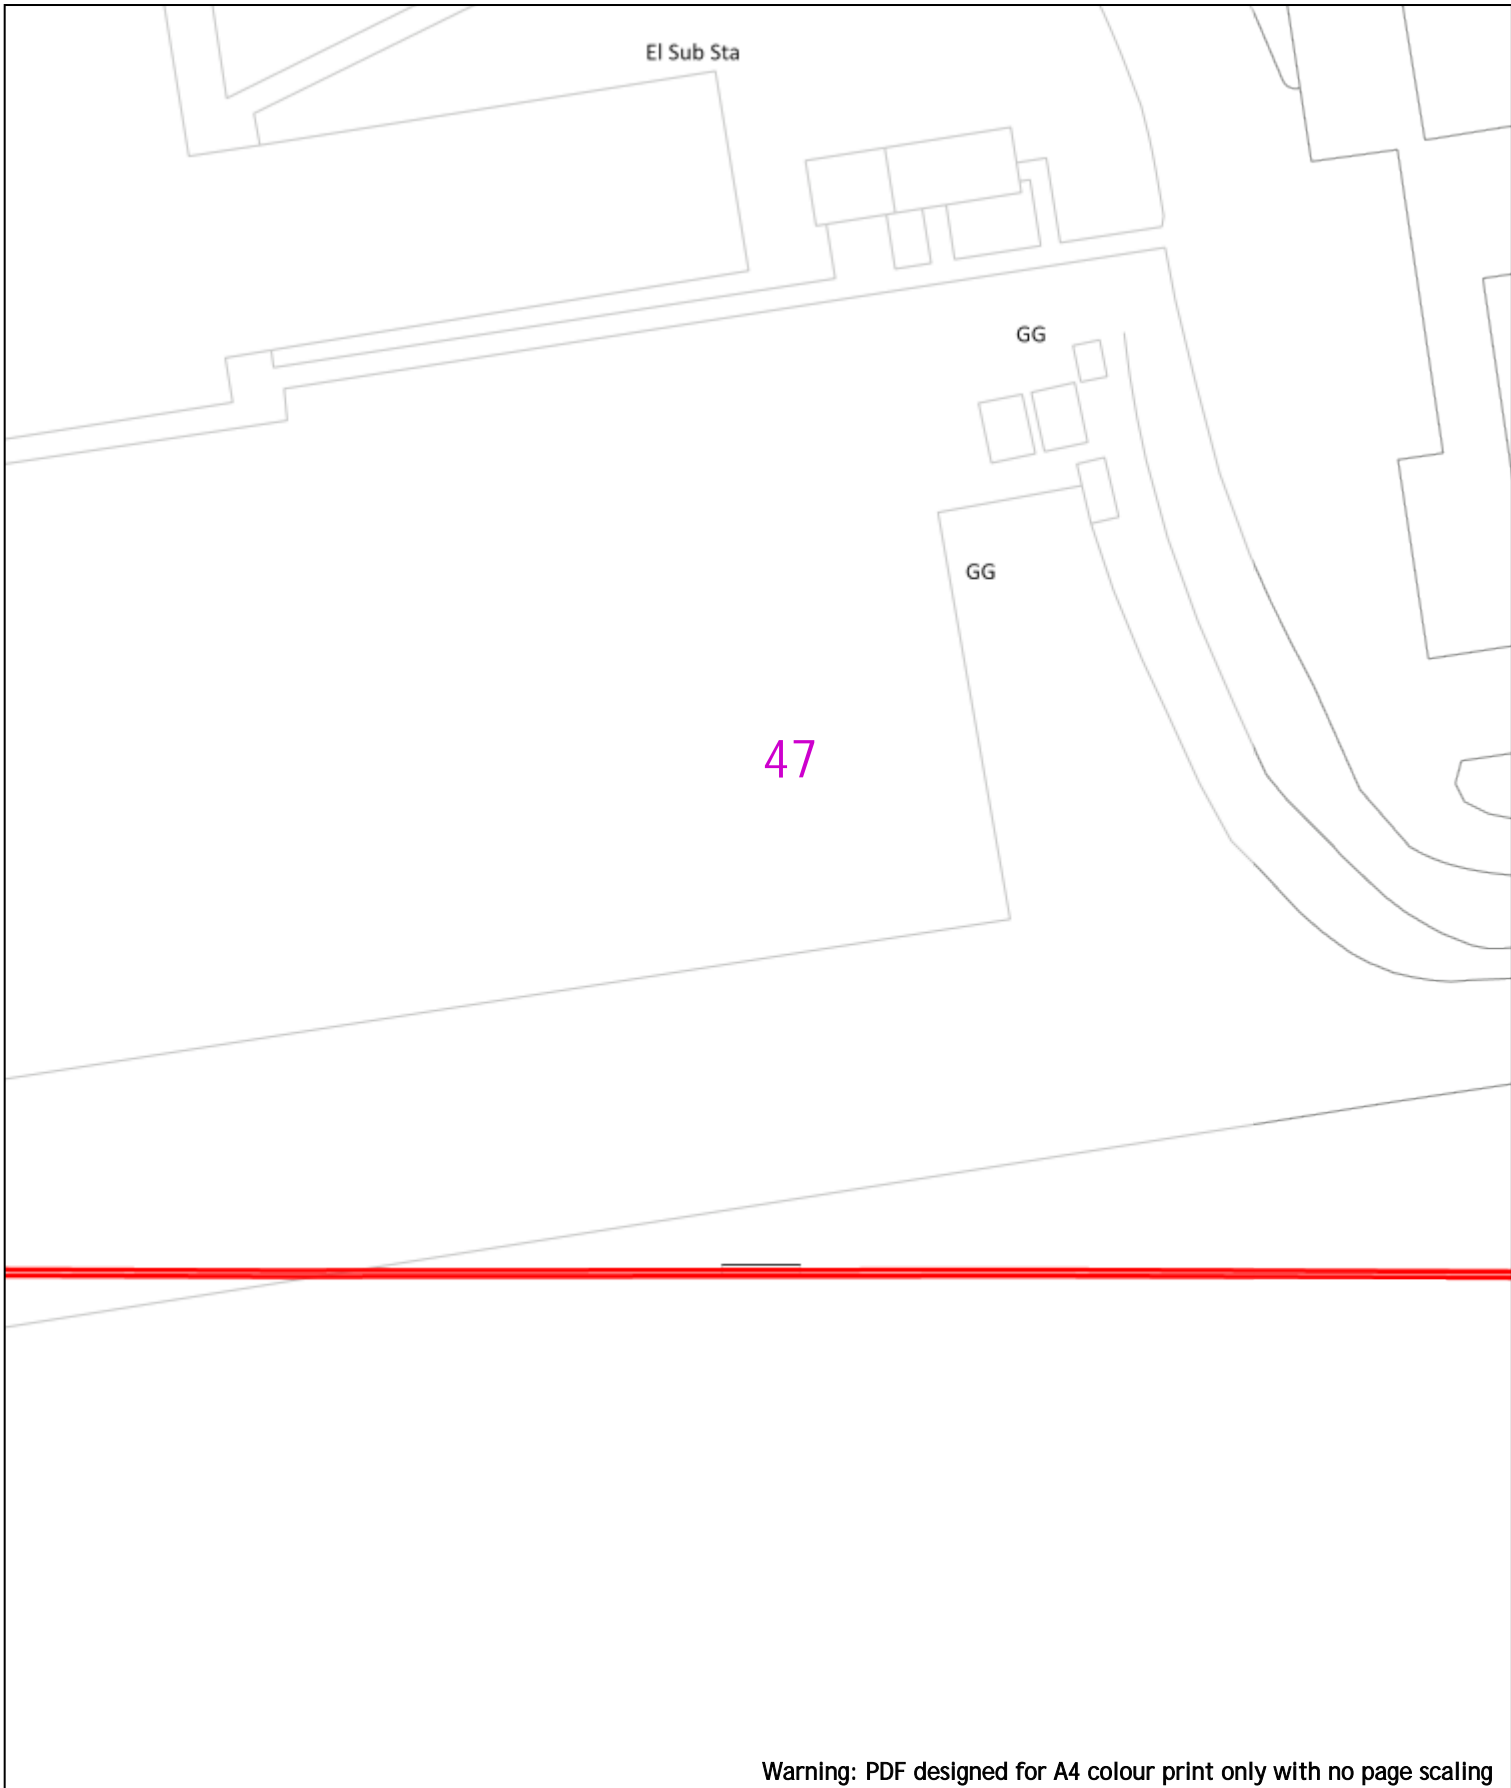

Warning: PDF designed for A4 colour print only with no page scaling

<p>0 20m Dig Sites Area: Line: </p>	<p style="text-align: center; background-color: red; color: white; padding: 5px;">Extra High Voltage cables in vicinity</p>	
<p>Date Requested: 24/06/2022 Job Reference: 25881010 Site Location: 448066 213346 Requested by: Mr Joe Shawyer Your Scheme/Reference: 31188_002</p>	<table border="1" style="width: 100%; border-collapse: collapse;"> <thead> <tr> <th colspan="4">Voltages (V)</th> </tr> </thead> <tbody> <tr> <td>LV (Low Voltage) and Services</td> <td colspan="3">Up to 1,000V</td> </tr> <tr> <td>HV (High Voltage)</td> <td colspan="3">Over 1,000V to 11,000V</td> </tr> <tr> <td>EHV (Extra High Voltage)</td> <td colspan="3">22,000V to 132,000V</td> </tr> <tr> <td>Transmission</td> <td colspan="3">275,000V and 400,000V</td> </tr> </tbody> </table> <table border="1" style="width: 100%; border-collapse: collapse; margin-top: 5px;"> <thead> <tr> <th colspan="5">NORMAL DEPTH TO THE TOP OF THE CABLE WHEN LAID</th> </tr> <tr> <th>Services</th> <th>LV</th> <th>HV</th> <th>EHV</th> <th></th> </tr> </thead> <tbody> <tr> <td>Footpath/Unmade</td> <td>0.45m</td> <td>0.45m</td> <td>0.6m</td> <td>0.8m</td> </tr> <tr> <td>Road Crossing</td> <td>0.6m</td> <td>0.6m</td> <td>0.75m</td> <td>0.9m</td> </tr> <tr> <td>Agricultural</td> <td>1m</td> <td>1m</td> <td>1m</td> <td>1.1m</td> </tr> </tbody> </table>	Voltages (V)				LV (Low Voltage) and Services	Up to 1,000V			HV (High Voltage)	Over 1,000V to 11,000V			EHV (Extra High Voltage)	22,000V to 132,000V			Transmission	275,000V and 400,000V			NORMAL DEPTH TO THE TOP OF THE CABLE WHEN LAID					Services	LV	HV	EHV		Footpath/Unmade	0.45m	0.45m	0.6m	0.8m	Road Crossing	0.6m	0.6m	0.75m	0.9m	Agricultural	1m	1m	1m	1.1m	<table border="1" style="width: 100%; border-collapse: collapse;"> <thead> <tr> <th>Legend</th> <th>Distribution Structures (Electric)</th> </tr> </thead> <tbody> <tr> <td> Service Cable</td> <td> Pole, Existing Location</td> </tr> <tr> <td> LV Mains</td> <td> Pole Structure, Existing Location - Single</td> </tr> <tr> <td> 2 - 11kV</td> <td> Pole Structure, Existing Location - H</td> </tr>">Southern Electric Power Distribution plc Registered Office: No.1 Forbury Place 43 Forbury Road Reading RG1 3JH Registered In England & Wales No.04094290</p> <p>If you're unsure & need to seek advice before commencing excavations, please contact: General Enquiries: 0800 048 3516</p> <p>Subject to revision – Master held by SSEN Asset Data Team: Asset.Data@sse.com 01256 337 294</p>
Voltages (V)	
LV (Low Voltage) and Services	Up to 1,000V	
HV (High Voltage)	Over 1,000V to 11,000V	
EHV (Extra High Voltage)	22,000V to 132,000V	
Transmission	275,000V and 400,000V	
NORMAL DEPTH TO THE TOP OF THE CABLE WHEN LAID	
Services	LV	HV	EHV	
Footpath/Unmade	0.45m	0.45m	0.6m	0.8m	
Road Crossing	0.6m	0.6m	0.75m	0.9m	
Agricultural	1m	1m	1m	1.1m	
Legend	Distribution Structures (Electric)	
Service Cable	Pole, Existing Location	
LV Mains	Pole Structure, Existing Location - Single	
2 - 11kV	Pole Structure, Existing Location - H	
<p>Scale: 1:500 (When plotted at A4)</p> <p style="text-align: center;">WARNING</p> <p style="text-align: center;">There may have been subsequent alteration to the surface levels. Trial holes must be undertaken to determine position and depths of cables. HS (G) 47 Booklet from the Health and Safety Executive – Avoiding Danger from Buried Cables – should be consulted before commencing excavation work.</p> <p style="text-align: center;">WHEN WORKING IN THE VICINITY OF OVERHEAD LINES THE HEALTH AND SAFETY GUIDANCE NOTES G56 SHOULD BE CONSULTED (AVAILABLE FROM THE HSE WEBSITE)</p> <p style="text-align: center; font-size: x-small;">BASED UPON THE ORDNANCE SURVEY MAP WITH THE SANCTION OF THE CONTROLLER OF HM STATIONERY OFFICE CROWN COPYRIGHT RESERVED. This copy has been made by or with the authority of Scottish and Southern Energy Power Distribution Ltd. Pursuant to section 47 of the Copyright, Designs and Patents Act 1988 ("The Act"). Unless the Act provides a relevant exception to copyright the copy must not be copied without prior permission of the copyright owner. Plans generated by DigSAFE Pro™ software provided by LinesearchbeforeUdig.</p>	

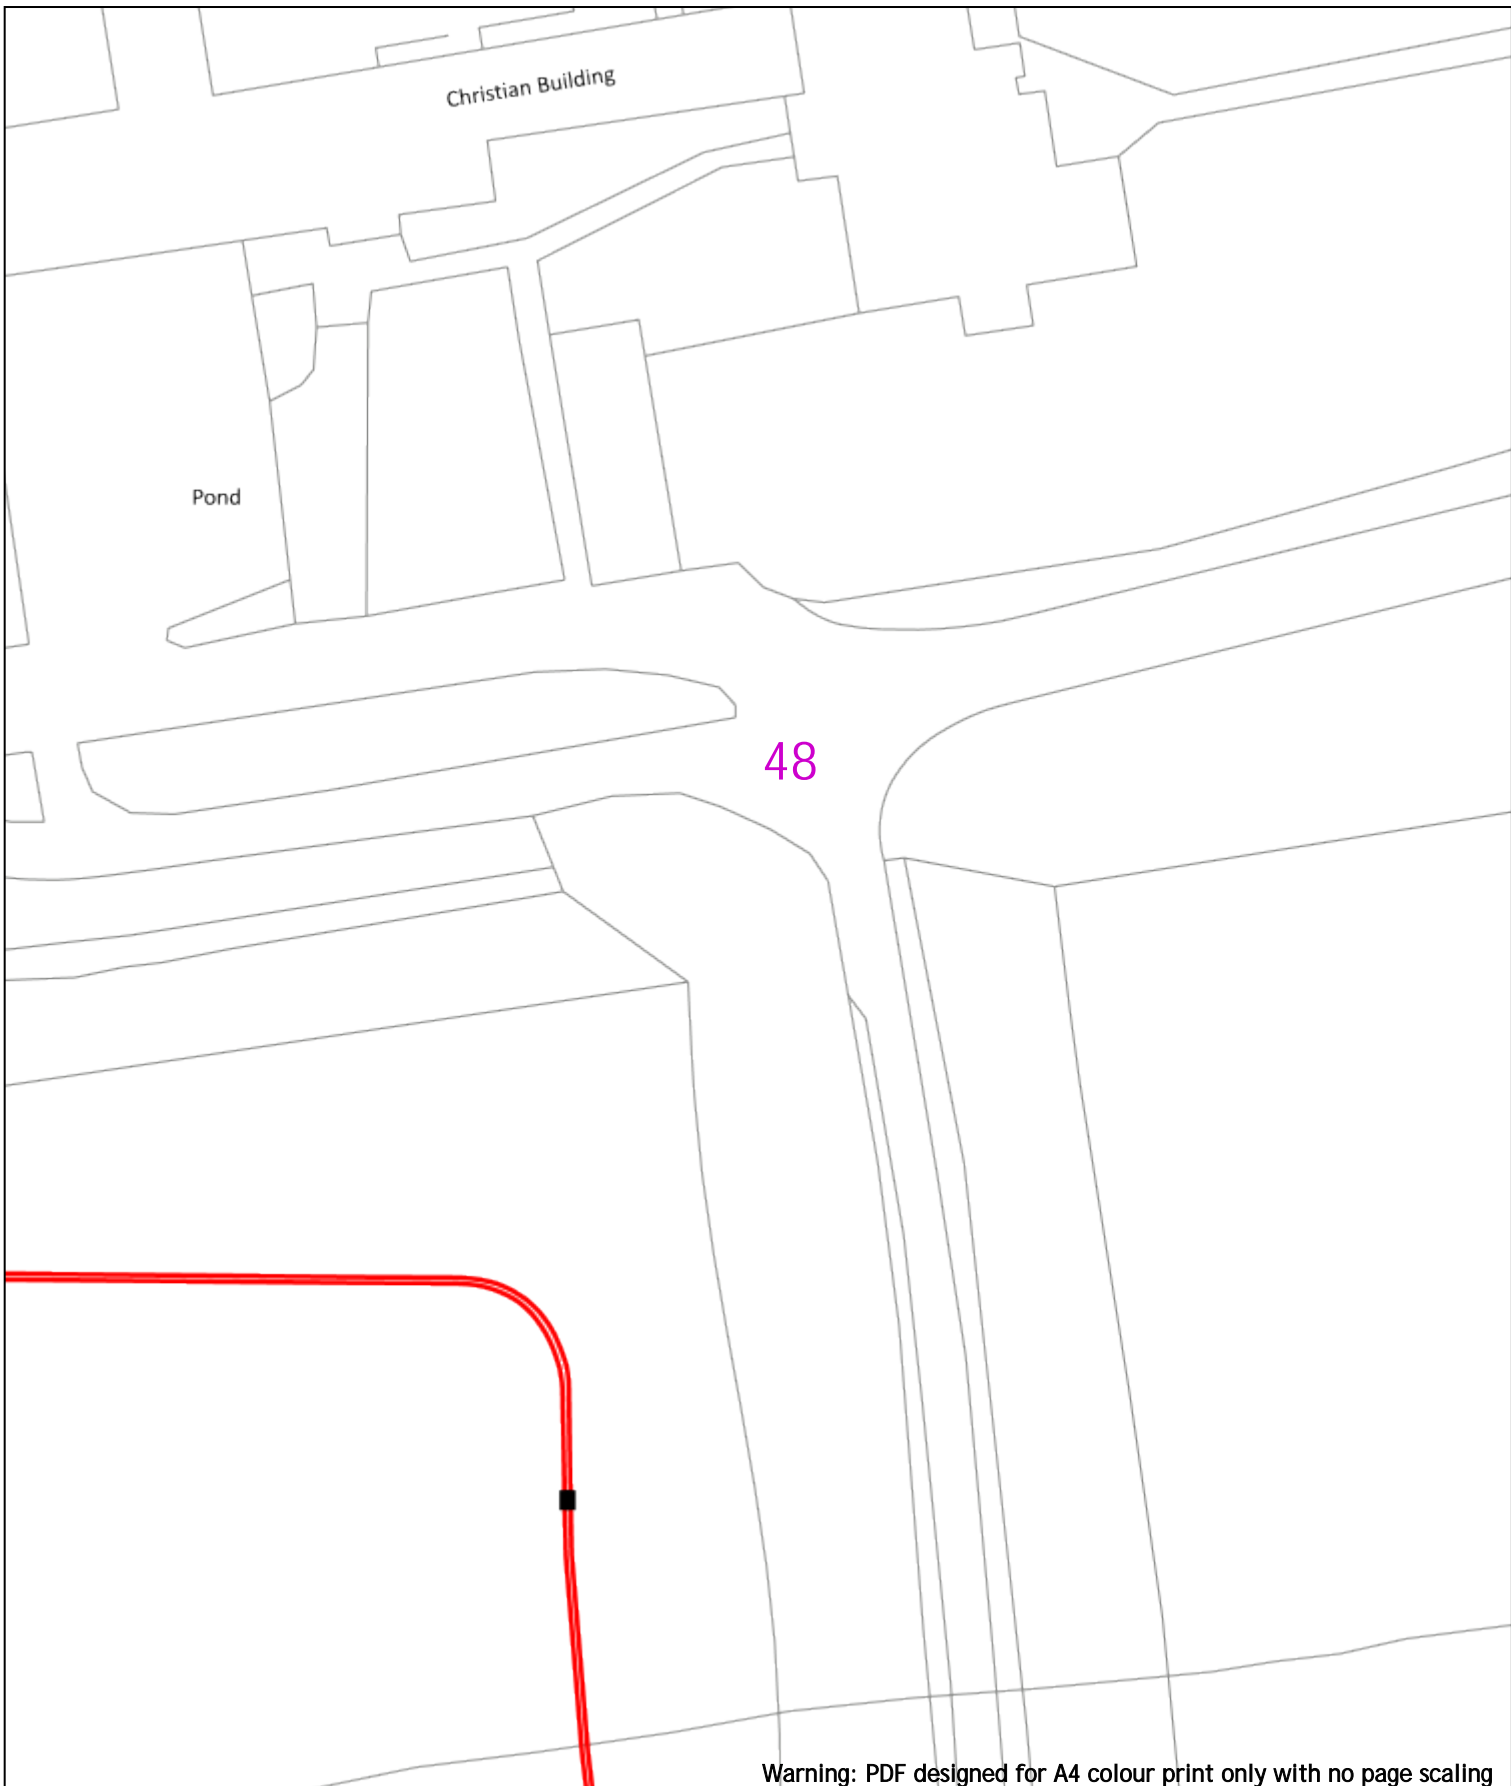

Warning: PDF designed for A4 colour print only with no page scaling



20m Dig Sites Area: Line:

Extra High Voltage cables in vicinity



Date Requested: 24/06/2022
 Job Reference: 25881010
 Site Location: 448066 213346
 Requested by: Mr Joe Shawyer
 Your Scheme/Reference: 31188_002

Voltages (V)				
LV (Low Voltage) and Services	Up to 1,000V			
HV (High Voltage)	Over 1,000V to 11,000V			
EHV (Extra High Voltage)	22,000V to 132,000V			
Transmission	275,000V and 400,000V			
NORMAL DEPTH TO THE TOP OF THE CABLE WHEN LAID				
Services	LV	HV	EHV	
Footpath/Unmade	0.45m	0.45m	0.6m	0.8m
Road Crossing	0.6m	0.6m	0.75m	0.9m
Agricultural	1m	1m	1m	1.1m

Legend		Distribution Structures (Electric)	
	Service Cable		Pole, Existing Location
	LV Mains		Pole Structure, Existing Location - Single
	2 - 11kV		Pole Structure, Existing Location - H
	66kV		Duct Route
	11kV		Cross Section Route
	22kV		
	33kV		
	66kV		
	132kV		
	275kV		
	400kV		
	Fibre Optic		
	Pipe Cable		


WARNING
 There may have been subsequent alteration to the surface levels. Trial holes must be undertaken to determine position and depths of cables. HS (G) 47 Booklet from the Health and Safety Executive - Avoiding Danger from Buried Cables - should be consulted before commencing excavation work.
WHEN WORKING IN THE VICINITY OF OVERHEAD LINES THE HEALTH AND SAFETY GUIDANCE NOTES G66 SHOULD BE CONSULTED (AVAILABLE FROM THE HSE WEBSITE)

Southern Electric Power Distribution plc
 Registered Office: No.1 Forbury Place
 43 Forbury Road Reading RG1 3JH
 Registered In England & Wales No.04094290

If you're unsure & need to seek advice before commencing excavations, please contact:
 General Enquiries: 0800 048 3516

Subject to revision - Master held by SSEN Asset Data Team:
Asset.Data@sse.com
 01256 337 294

Scale: 1:500 (When plotted at A4)

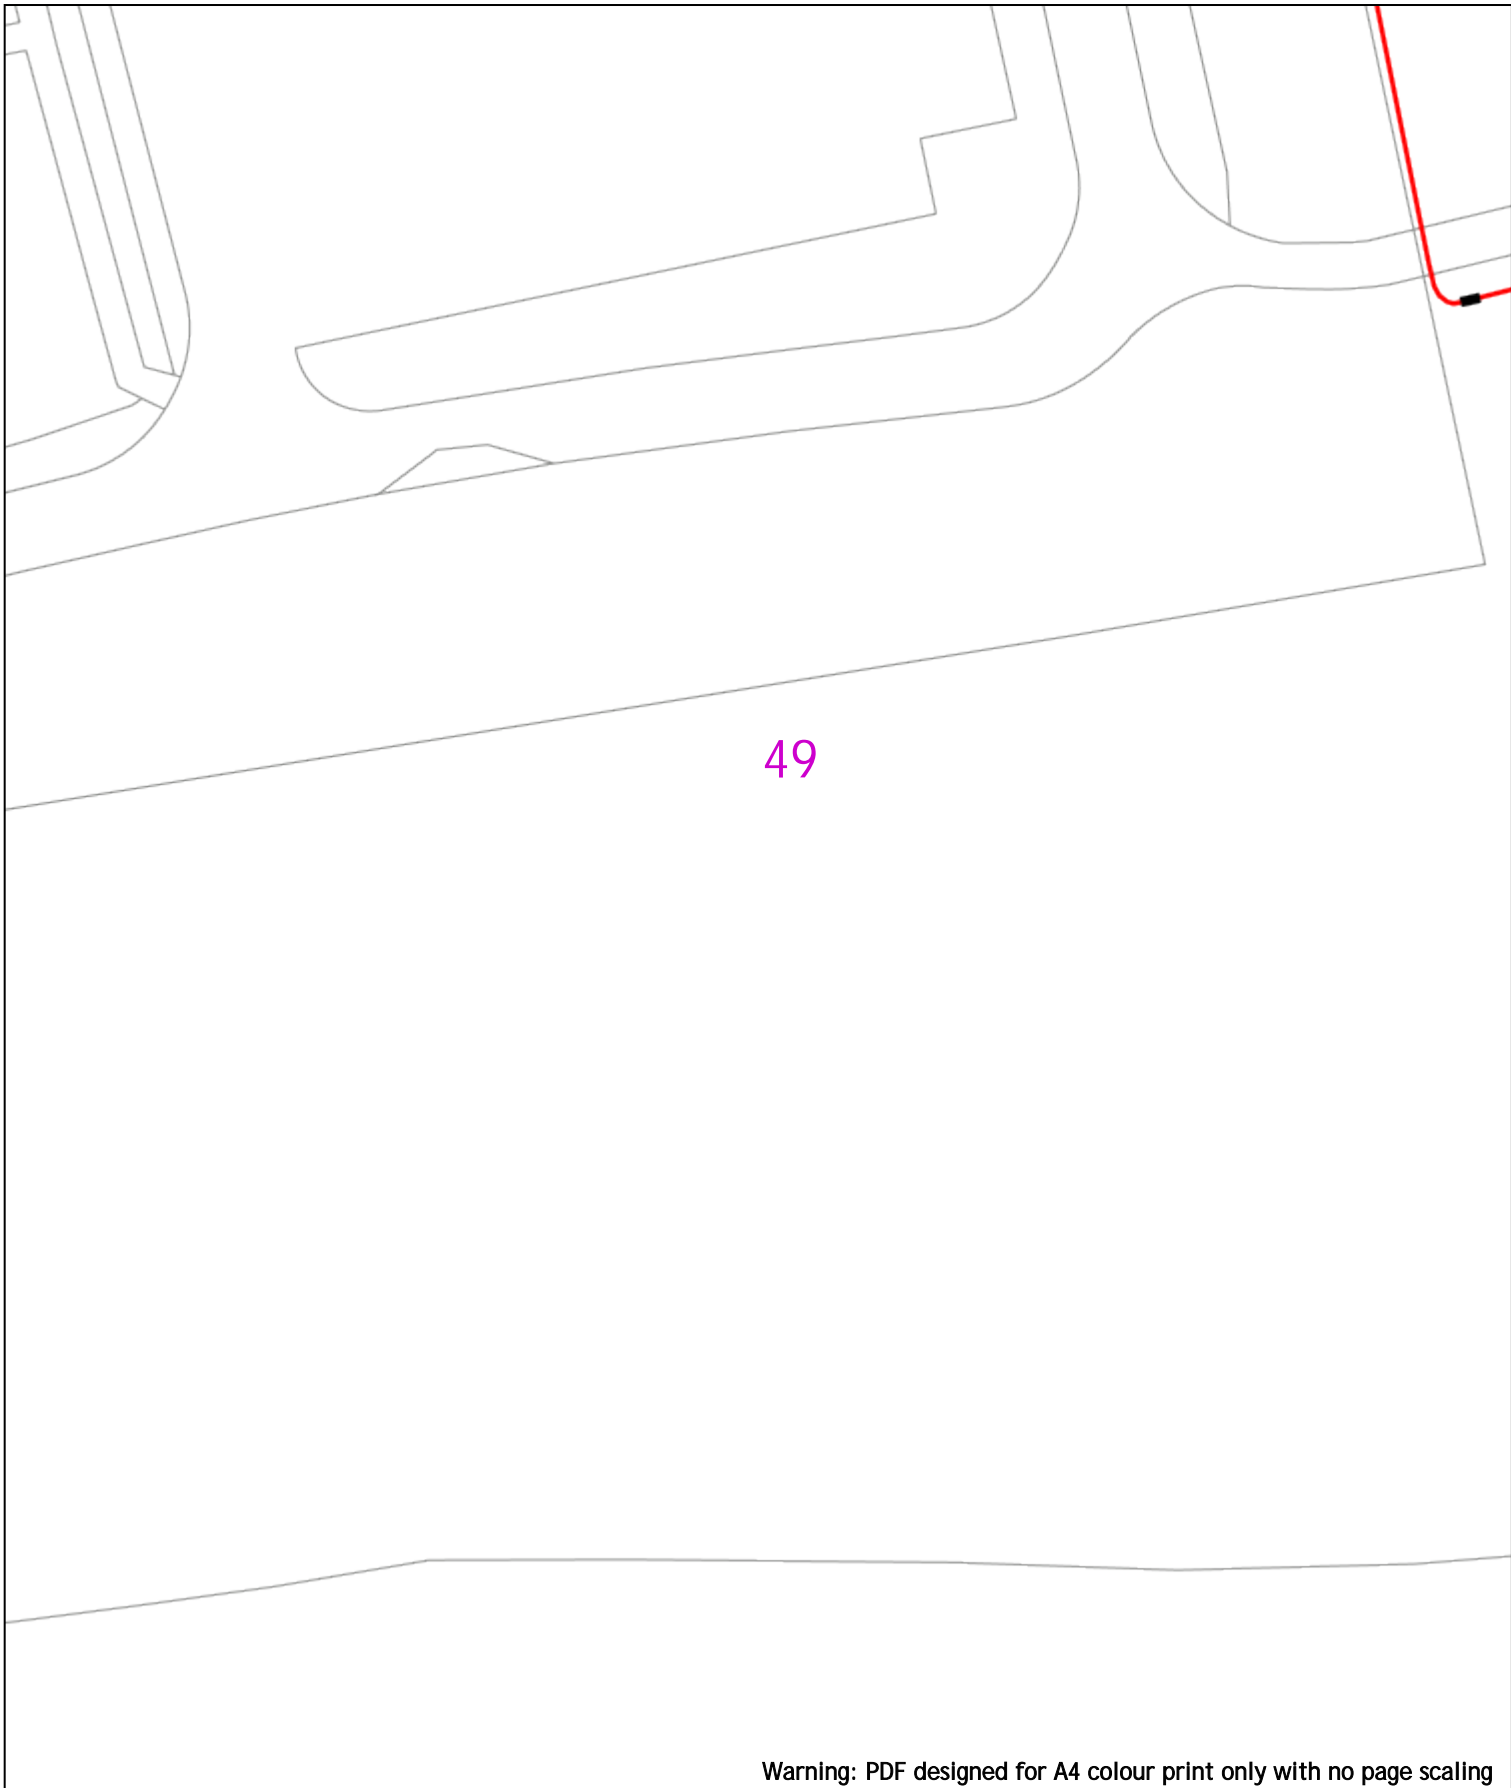

Warning: PDF designed for A4 colour print only with no page scaling

<p>0 20m Dig Sites Area: Line: Extra High Voltage cables in vicinity</p>	
<p>Date Requested: 24/06/2022 Job Reference: 25881010 Site Location: 448066 213346 Requested by: Mr Joe Shawyer Your Scheme/Reference: 31188_002</p>	<table border="1"> <thead> <tr> <th colspan="4">Voltages (V)</th> </tr> </thead> <tbody> <tr> <td>LV (Low Voltage) and Services</td> <td colspan="3">Up to 1,000V</td> </tr> <tr> <td>HV (High Voltage)</td> <td colspan="3">Over 1,000V to 11,000V</td> </tr> <tr> <td>EHV (Extra High Voltage)</td> <td colspan="3">22,000V to 132,000V</td> </tr> <tr> <td>Transmission</td> <td colspan="3">275,000V and 400,000V</td> </tr> </tbody> </table> <table border="1"> <thead> <tr> <th colspan="4">NORMAL DEPTH TO THE TOP OF THE CABLE WHEN LAID</th> </tr> <tr> <th>Services</th> <th>LV</th> <th>HV</th> <th>EHV</th> </tr> </thead> <tbody> <tr> <td>Footpath/Unmade</td> <td>0.45m</td> <td>0.45m</td> <td>0.6m</td> </tr> <tr> <td>Road Crossing</td> <td>0.6m</td> <td>0.6m</td> <td>0.75m</td> </tr> <tr> <td>Agricultural</td> <td>1m</td> <td>1m</td> <td>1.1m</td> </tr> </tbody> </table> <div style="display: flex; justify-content: space-between;"> <div data-bbox="638 1892 845 2161"> <p>Legend</p> <ul style="list-style-type: none"> Service Cable LV Mains 2 - 11kV 66kV 11kV 22kV 33kV 66kV 132kV 275kV 400kV Fibre Optic Pipit Cable </div> <div data-bbox="845 1892 1173 2161"> <p>Distribution Structures (Electric)</p> <ul style="list-style-type: none"> Pole, Existing Location Pole Structure, Existing Location - Single Pole Structure, Existing Location - M Duct Route Cross Section Route </div> </div> <p style="text-align: center; color: red; font-weight: bold; font-size: small;">WARNING</p> <p style="text-align: center; color: red; font-size: x-small;">There may have been subsequent alteration to the surface levels. Trial holes must be undertaken to determine position and depths of cables. HS (G) 47 Booklet from the Health and Safety Executive - Avoiding Danger from Buried Cables - should be consulted before commencing excavation work.</p> <p style="text-align: center; color: red; font-size: x-small;">WHEN WORKING IN THE VICINITY OF OVERHEAD LINES THE HEALTH AND SAFETY GUIDANCE NOTES G56 SHOULD BE CONSULTED (AVAILABLE FROM THE HSE WEBSITE)</p>	Voltages (V)				LV (Low Voltage) and Services	Up to 1,000V			HV (High Voltage)	Over 1,000V to 11,000V			EHV (Extra High Voltage)	22,000V to 132,000V			Transmission	275,000V and 400,000V			NORMAL DEPTH TO THE TOP OF THE CABLE WHEN LAID				Services	LV	HV	EHV	Footpath/Unmade	0.45m	0.45m	0.6m	Road Crossing	0.6m	0.6m	0.75m	Agricultural	1m	1m	1.1m
Voltages (V)	
LV (Low Voltage) and Services	Up to 1,000V	
HV (High Voltage)	Over 1,000V to 11,000V	
EHV (Extra High Voltage)	22,000V to 132,000V	
Transmission	275,000V and 400,000V	
NORMAL DEPTH TO THE TOP OF THE CABLE WHEN LAID	
Services	LV	HV	EHV																																						
Footpath/Unmade	0.45m	0.45m	0.6m																																						
Road Crossing	0.6m	0.6m	0.75m																																						
Agricultural	1m	1m	1.1m																																						
<p>Scale: 1:500 (When plotted at A4)</p>	<p style="text-align: center; font-size: x-small;">BASED UPON THE ORDNANCE SURVEY MAP WITH THE SANCTION OF THE CONTROLLER OF HM STATIONERY OFFICE CROWN COPYRIGHT RESERVED. This copy has been made by or with the authority of Scottish and Southern Energy Power Distribution Ltd. Pursuant to section 47 of the Copyright, Designs and Patents Act 1988 ("The Act"). Unless the Act provides a relevant exception to copyright the copy must not be copied without prior permission of the copyright owner. Plans generated by DigSAFE Pro™ software provided by LinesearchbeforeUdig.</p>	

Southern Electric Power Distribution plc
 Registered Office: No.1 Forbury Place
 43 Forbury Road Reading RG1 3JH
 Registered In England & Wales No.04094290

If you're unsure & need to seek advice before commencing excavations, please contact:
 General Enquiries: 0800 048 3516

Subject to revision – Master held by SSEN Asset Data Team:
Asset.Data@sse.com
 01256 337 294

Warning: PDF designed for A4 colour print only with no page scaling

0  20m














Dig Sites Area:  Line: 






Extra High Voltage cables in vicinity

 

Date Requested: 24/06/2022
 Job Reference: 25881010
 Site Location: 448066 213346
 Requested by: Mr Joe Shawyer
 Your Scheme/Reference: 31188_002

Voltages (V)			
LV (Low Voltage) and Services	Up to 1,000V		
HV (High Voltage)	Over 1,000V to 11,000V		
EHV (Extra High Voltage)	22,000V to 132,000V		
Transmission	275,000V and 400,000V		
NORMAL DEPTH TO THE TOP OF THE CABLE WHEN LAID			
Services	LV	HV	EHV
Footpath/Unmade	0.45m	0.45m	0.6m
Road Crossing	0.6m	0.6m	0.75m
Agricultural	1m	1m	1.1m

Legend	
	Service Cable
	LV Mains
	2 - 11kV
	66kV
	11kV
	22kV
	33kV
	66kV
	132kV
	275kV
	400kV
	Fibre Optic
	Pipe Cable

Distribution Structures (Electric)	
	Pole, Existing Location
	Pole Structure, Existing Location - Single
	Pole Structure, Existing Location - H
	Duct Route
	Cross Section Route


Southern Electric Power Distribution plc
 Registered Office: No.1 Forbury Place
 43 Forbury Road Reading RG1 3JH
 Registered In England & Wales No.04094290

If you're unsure & need to seek advice before commencing excavations, please contact:
 General Enquiries: 0800 048 3516

Subject to revision – Master held by SSEN Asset Data Team:
Asset.Data@sse.com
 01256 337 294

Scale: 1:500 (When plotted at A4)

WARNING
 There may have been subsequent alteration to the surface levels. Trial holes must be undertaken to determine position and depths of cables. HS (G) 47 Booklet from the Health and Safety Executive – Avoiding Danger from Buried Cables – should be consulted before commencing excavation work.
WHEN WORKING IN THE VICINITY OF OVERHEAD LINES THE HEALTH AND SAFETY GUIDANCE NOTES G56 SHOULD BE CONSULTED (AVAILABLE FROM THE HSE WEBSITE)

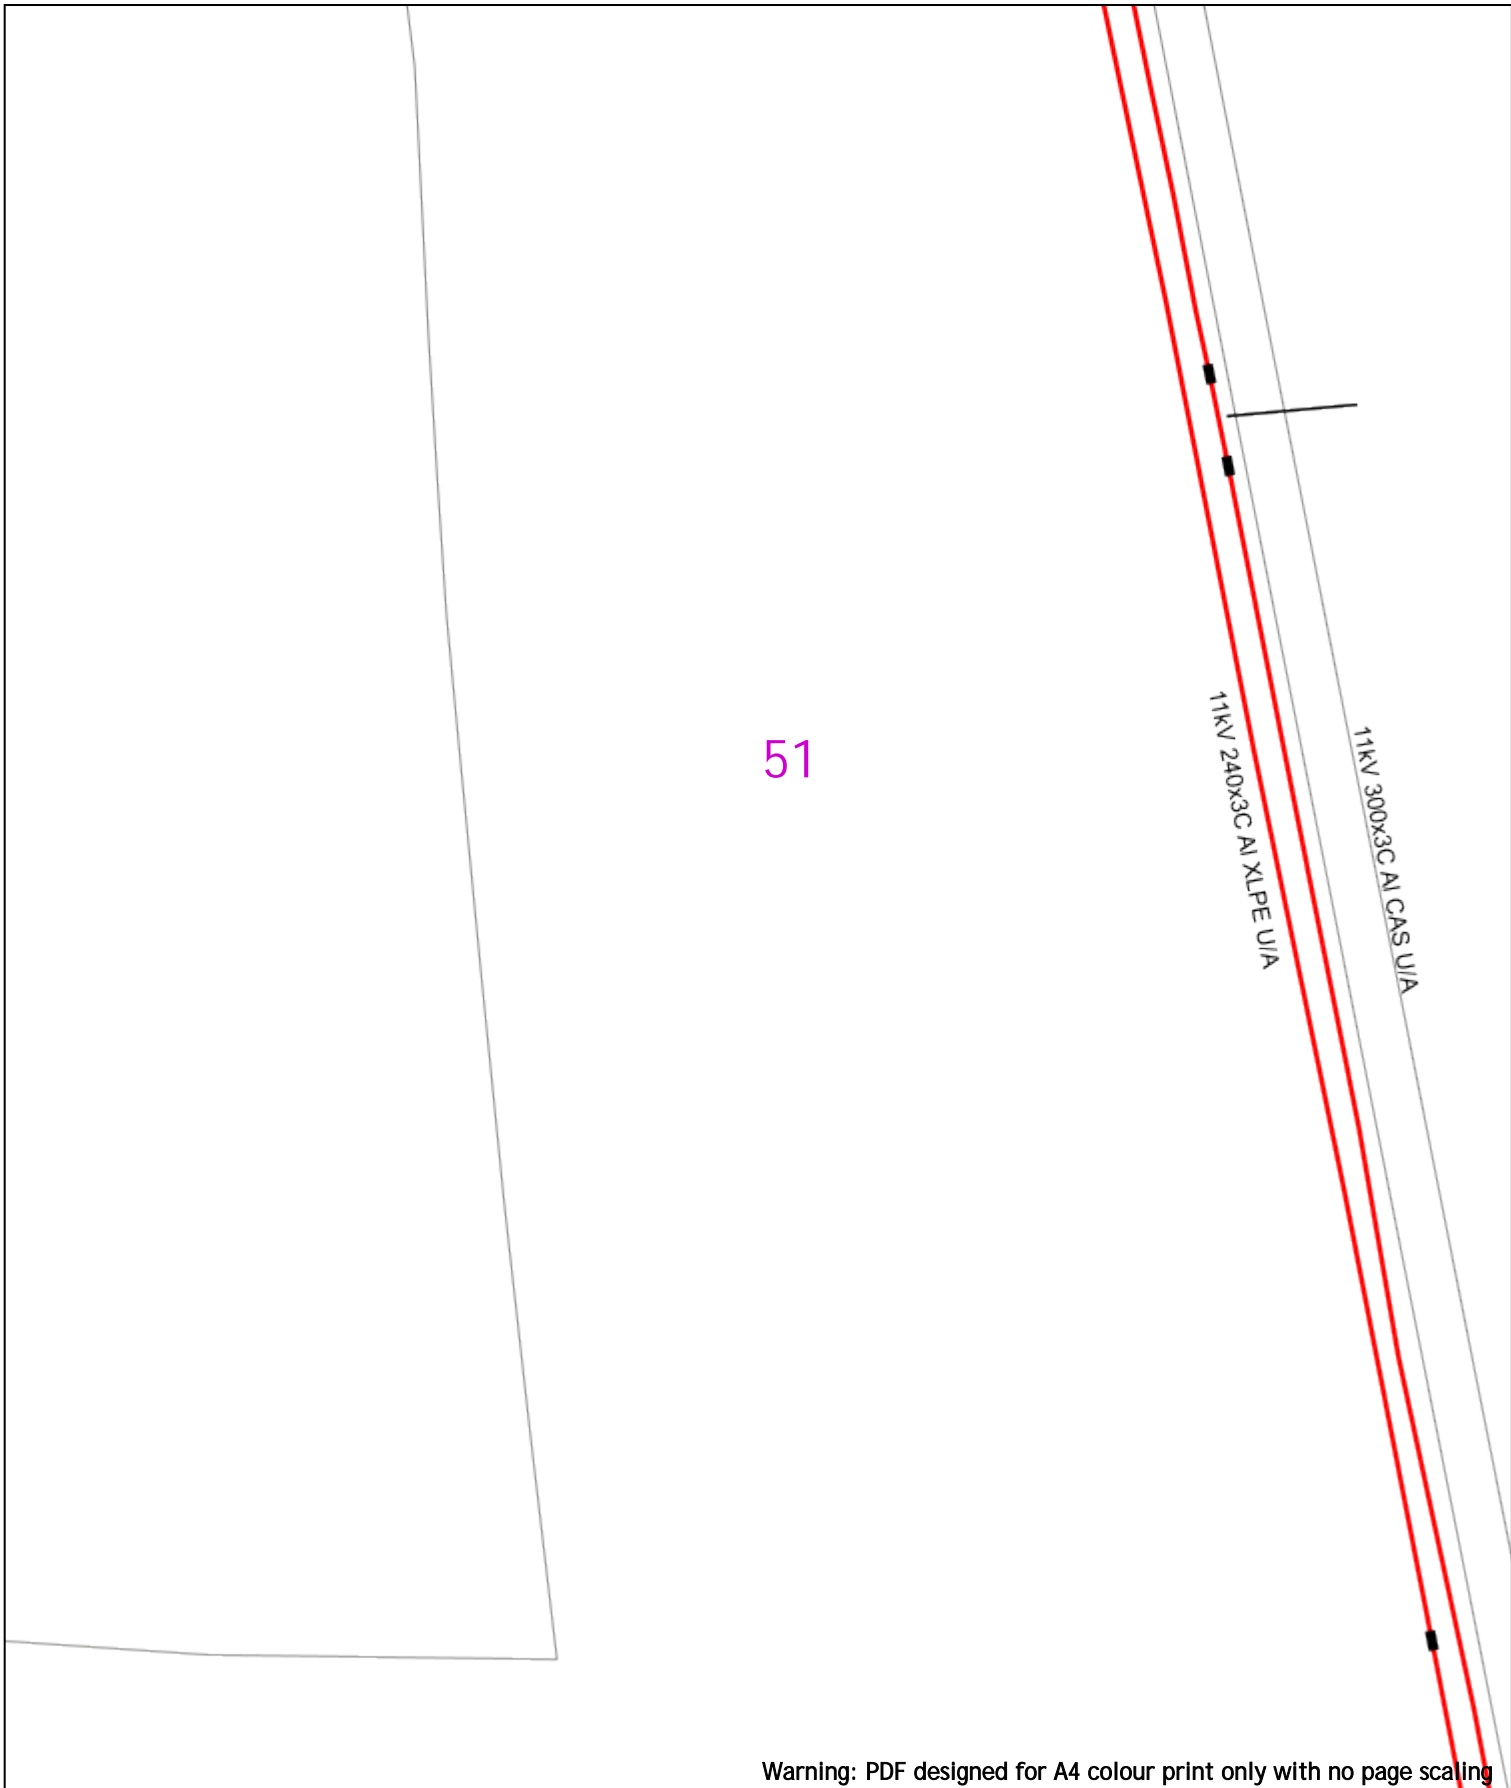

Warning: PDF designed for A4 colour print only with no page scaling

20m Dig Sites Area: Line: **Extra High Voltage cables in vicinity**

Date Requested: 24/06/2022
 Job Reference: 25881010
 Site Location: 448066 213346
 Requested by: Mr Joe Shawyer
 Your Scheme/Reference: 31188_002

Voltages (V)			
LV (Low Voltage) and Services	Up to 1,000V		
HV (High Voltage)	Over 1,000V to 11,000V		
EHV (Extra High Voltage)	22,000V to 132,000V		
Transmission	275,000V and 400,000V		

NORMAL DEPTH TO THE TOP OF THE CABLE WHEN LAID				
Services	LV	HV	EHV	
Footpath/Unmade	0.45m	0.45m	0.6m	0.8m
Road Crossing	0.6m	0.6m	0.75m	0.9m
Agricultural	1m	1m	1m	1.1m

<p>Legend</p> <ul style="list-style-type: none"> Service Cable LV Mains 2 - 11kV 66kV 11kV 22kV 33kV 66kV 132kV 275kV 400kV Fibre Optic Pipit Cable 	<p>Distribution Structures (Electric)</p> <ul style="list-style-type: none"> ● Pole, Existing Location ○ Pole Structure, Existing Location - Single ○ Pole Structure, Existing Location - H Duct Route Cross Section Route
---	---

WARNING
 There may have been subsequent alteration to the surface levels. Trial holes must be undertaken to determine position and depths of cables. HS (G) 47 Booklet from the Health and Safety Executive - Avoiding Danger from Buried Cables - should be consulted before commencing excavation work.
WHEN WORKING IN THE VICINITY OF OVERHEAD LINES THE HEALTH AND SAFETY GUIDANCE NOTES G56 SHOULD BE CONSULTED (AVAILABLE FROM THE HSE WEBSITE)

Southern Electric Power Distribution plc
 Registered Office: No.1 Forbury Place
 43 Forbury Road Reading RG1 3JH
 Registered In England & Wales No.04094290

If you're unsure & need to seek advice before commencing excavations, please contact:
 General Enquiries: 0800 048 3516

Subject to revision - Master held by SSEN Asset Data Team:
Asset.Data@sse.com
 01256 337 294

Warning: PDF designed for A4 colour print only with no page scaling

0  20m Dig Sites Area:  Line: 

**Extra High Voltage
cables in vicinity**



Date Requested: 24/06/2022
 Job Reference: 25881010
 Site Location: 448066 213346
 Requested by: Mr Joe Shawyer
 Your Scheme/Reference: 31188_002

Voltages (V)			
LV (Low Voltage) and Services	Up to 1,000V		
HV (High Voltage)	Over 1,000V to 11,000V		
EHV (Extra High Voltage)	22,000V to 132,000V		
Transmission	275,000V and 400,000V		
NORMAL DEPTH TO THE TOP OF THE CABLE WHEN LAID			
Services	LV	HV	EHV
Footpath/Unmade	0.45m	0.45m	0.6m 0.8m
Road Crossing	0.6m	0.6m	0.75m 0.9m
Agricultural	1m	1m	1m 1.1m

Legend	Distribution Structures (Electric)
Service Cable	Pole, Existing Location
LV Mains	Pole Structure, Existing Location - Single
2 - 11kV	Pole Structure, Existing Location - H
66kV	Duct Route
11kV	Cross Section Route
22kV	
33kV	
66kV	
132kV	
275kV	
400kV	
Fibre Optic	
Pipit Cable	

WARNING
 There may have been subsequent alteration to the surface levels. Trial holes must be undertaken to determine position and depths of cables. HS (G) 47 Booklet from the Health and Safety Executive - Avoiding Danger from Buried Cables - should be consulted before commencing excavation work.
WHEN WORKING IN THE VICINITY OF OVERHEAD LINES THE HEALTH AND SAFETY GUIDANCE NOTES G56 SHOULD BE CONSULTED (AVAILABLE FROM THE HSE WEBSITE)

Southern Electric Power Distribution plc
 Registered Office: No.1 Forbury Place
 43 Forbury Road Reading RG1 3JH
 Registered In England & Wales No.04094290

If you're unsure & need to seek advice before commencing excavations, please contact:
 General Enquiries: 0800 048 3516

Subject to revision - Master held by SSEN Asset Data Team:
Asset.Data@sse.com
 01256 337 294

Scale: 1:500 (When plotted at A4)

53

Warning: PDF designed for A4 colour print only with no page scaling

0  20m Dig Sites Area:  Line: 

**Extra High Voltage
cables in vicinity**



Date Requested: 24/06/2022
Job Reference: 25881010
Site Location: 448066 213346
Requested by: Mr Joe Shawyer

Your Scheme/Reference: 31188_002

Voltages (V)			
LV (Low Voltage) and Services	Up to 1,000V		
HV (High Voltage)	Over 1,000V to 11,000V		
EHV (Extra High Voltage)	22,000V to 132,000V		
Transmission	275,000V and 400,000V		
NORMAL DEPTH TO THE TOP OF THE CABLE WHEN LAID			
Services	LV	HV	EHV
Footpath/Unmade	0.45m	0.45m	0.6m 0.8m
Road Crossing	0.6m	0.6m	0.75m 0.9m
Agricultural	1m	1m	1m 1.1m

Legend	Distribution Structures (Electric)
Service Cable	Pole, Existing Location
LV Mains	Pole Structure, Existing Location - Single
2 - 11kV	Pole Structure, Existing Location - H
66kV	Duct Route
11kV	Cross Section Route
22kV	
33kV	
66kV	
132kV	
275kV	
400kV	
Fibre Optic	
Pipit Cable	


WARNING
There may have been subsequent alteration to the surface levels. Trial holes must be undertaken to determine position and depths of cables. HS (G) 47 Booklet from the Health and Safety Executive - Avoiding Danger from Buried Cables - should be consulted before commencing excavation work.
WHEN WORKING IN THE VICINITY OF OVERHEAD LINES THE HEALTH AND SAFETY GUIDANCE NOTES G56 SHOULD BE CONSULTED (AVAILABLE FROM THE HSE WEBSITE)

Southern Electric Power Distribution plc
Registered Office: No.1 Forbury Place
43 Forbury Road Reading RG1 3JH
Registered In England & Wales No.04094290

If you're unsure & need to seek advice before commencing excavations, please contact:
General Enquiries: 0800 048 3516

Subject to revision - Master held by SSEN Asset Data Team:
Asset.Data@sse.com
01256 337 294

Scale: 1:500 (When plotted at A4)

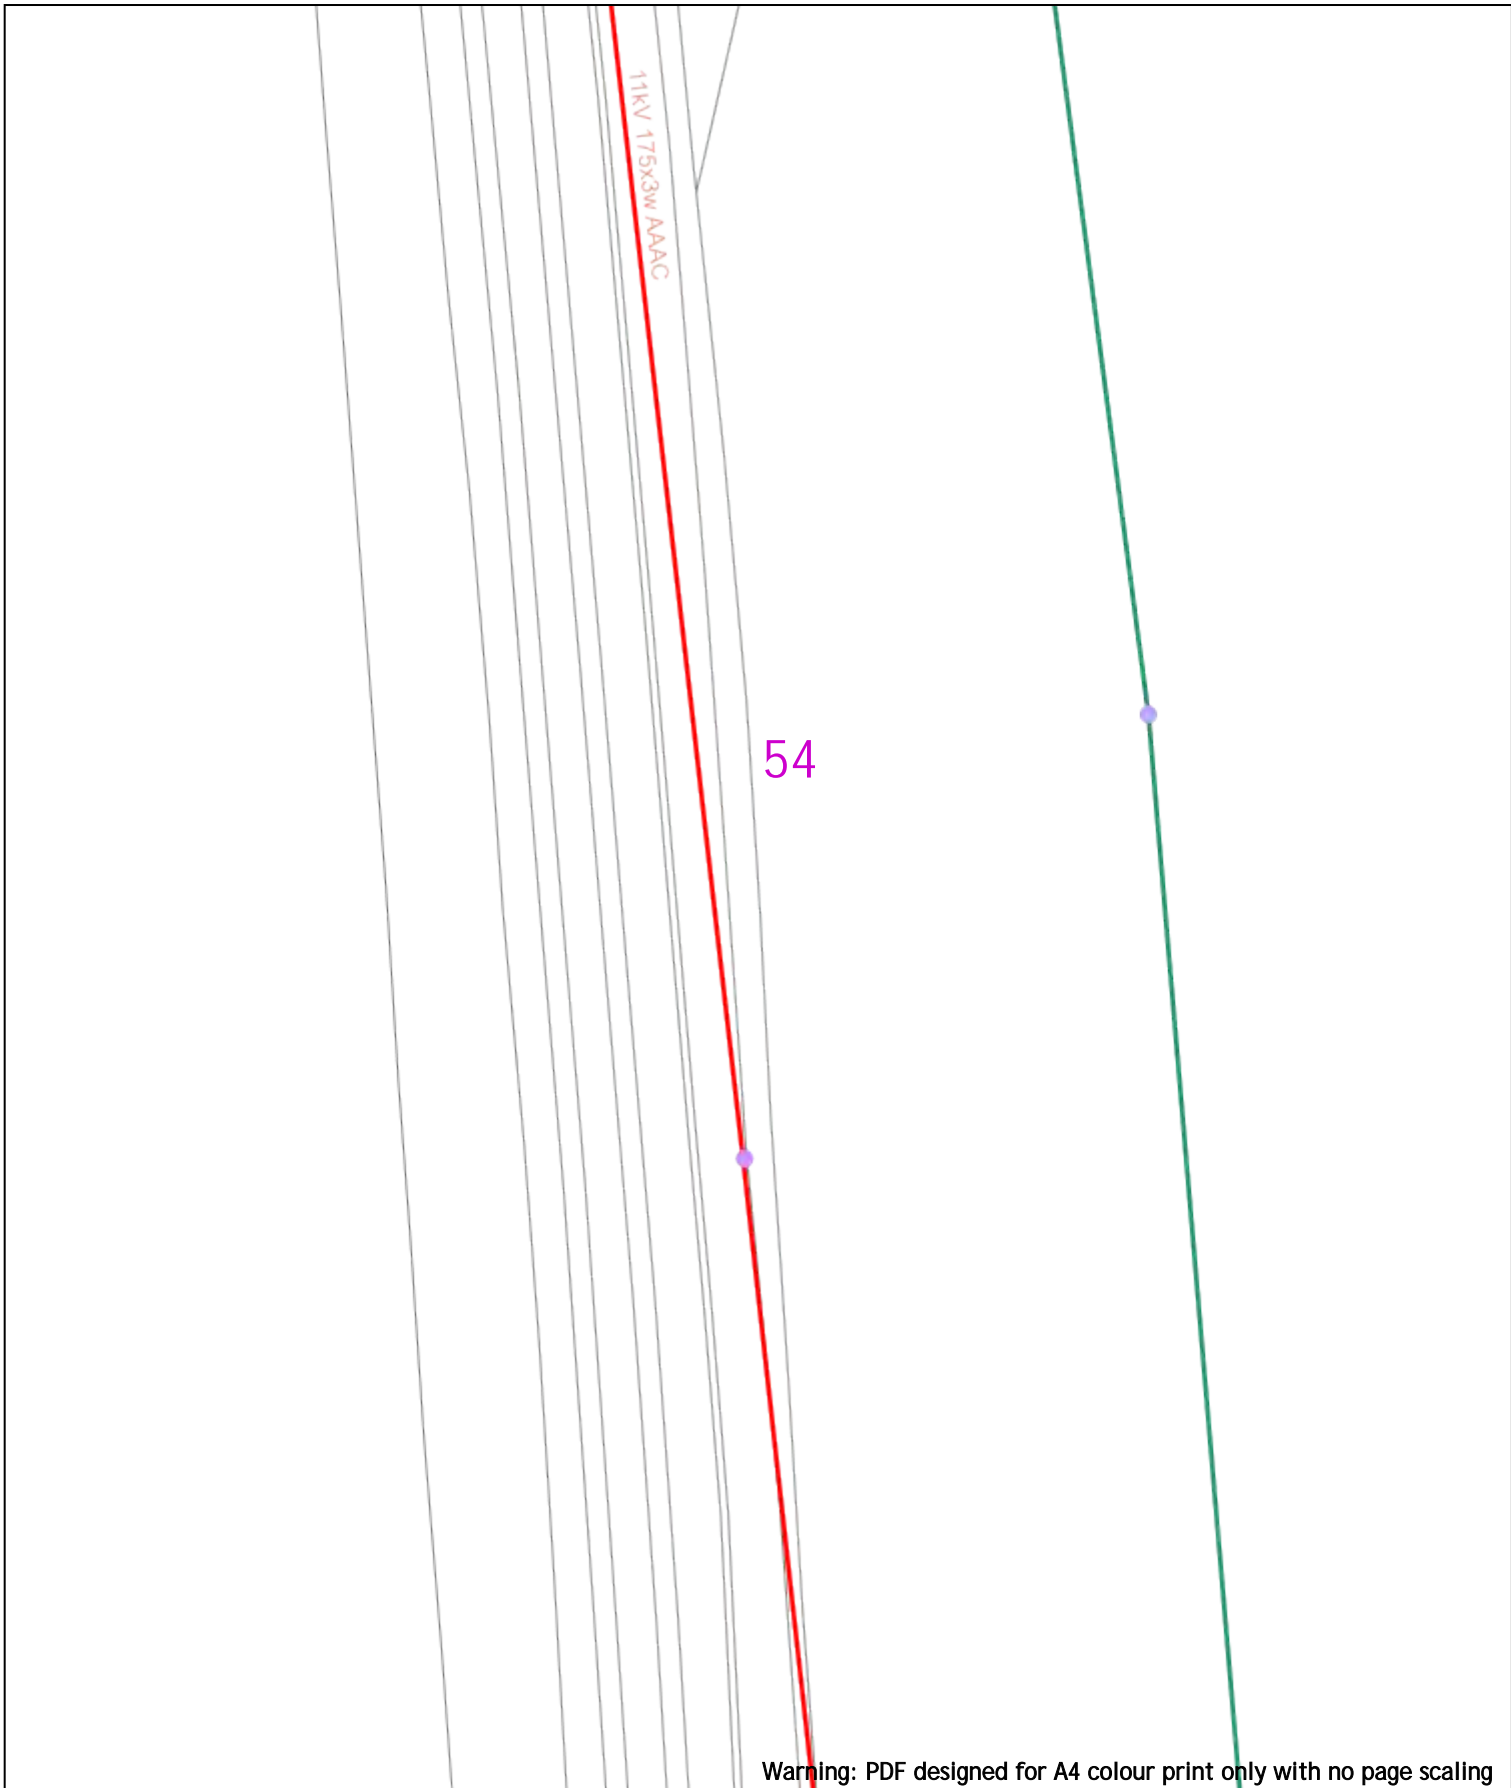

Warning: PDF designed for A4 colour print only with no page scaling

20m Dig Sites Area: Line: **Extra High Voltage cables in vicinity**

Date Requested: 24/06/2022
 Job Reference: 25881010
 Site Location: 448066 213346
 Requested by: Mr Joe Shawyer
 Your Scheme/Reference: 31188_002

Voltages (V)			
LV (Low Voltage) and Services	Up to 1,000V		
HV (High Voltage)	Over 1,000V to 11,000V		
EHV (Extra High Voltage)	22,000V to 132,000V		
Transmission	275,000V and 400,000V		
NORMAL DEPTH TO THE TOP OF THE CABLE WHEN LAID			
Services	LV	HV	EHV
Footpath/Unmade	0.45m	0.45m	0.6m 0.8m
Road Crossing	0.6m	0.6m	0.75m 0.9m
Agricultural	1m	1m	1m 1.1m

Legend		Distribution Structures (Electric)	
	Service Cable	●	Pole, Existing Location
	LV Mains	○	Pole Structure, Existing Location - Single
	2 - 3.3kV	○	New Structure, Existing Location - H
	6.6kV		Duct Route
	11kV		Cross Section Route
	22kV		
	33kV		
	66kV		
	132kV		
	275kV		
	400kV		
	Fibre Optic		
	Pipe Cable		

WARNING
 There may have been subsequent alteration to the surface levels. Trial holes must be undertaken to determine position and depths of cables. HS (G) 47 Booklet from the Health and Safety Executive - Avoiding Danger from Buried Cables - should be consulted before commencing excavation work.
WHEN WORKING IN THE VICINITY OF OVERHEAD LINES THE HEALTH AND SAFETY GUIDANCE NOTES G56 SHOULD BE CONSULTED (AVAILABLE FROM THE HSE WEBSITE)

Southern Electric Power Distribution plc
 Registered Office: No.1 Forbury Place
 43 Forbury Road Reading RG1 3JH
 Registered In England & Wales No.04094290

If you're unsure & need to seek advice before commencing excavations, please contact:
 General Enquiries: 0800 048 3516

Subject to revision - Master held by SSEN Asset Data Team:
Asset.Data@sse.com
 01256 337 294

Warning: PDF designed for A4 colour print only with no page scaling

0  20m Dig Sites Area:  Line: 

**Extra High Voltage
cables in vicinity**



Date Requested: 24/06/2022
 Job Reference: 25881010
 Site Location: 448066 213346
 Requested by: Mr Joe Shawyer
 Your Scheme/Reference: 31188_002

Voltages (V)			
LV (Low Voltage) and Services	Up to 1,000V		
HV (High Voltage)	Over 1,000V to 11,000V		
EHV (Extra High Voltage)	22,000V to 132,000V		
Transmission	275,000V and 400,000V		
NORMAL DEPTH TO THE TOP OF THE CABLE WHEN LAID			
Services	LV	HV	EHV
Footpath/Unmade	0.45m	0.45m	0.6m 0.8m
Road Crossing	0.6m	0.6m	0.75m 0.9m
Agricultural	1m	1m	1m 1.1m

Legend	Distribution Structures (Electric)
Service Cable	Pole, Existing Location
LV Mains	Pole Structure, Existing Location - Single
2 - 11kV	Pole Structure, Existing Location - H

WARNING
 There may have been subsequent alteration to the surface levels. Trial holes must be undertaken to determine position and depths of cables. HS (G) 47 Booklet from the Health and Safety Executive - Avoiding Danger from Buried Cables - should be consulted before commencing excavation work.
WHEN WORKING IN THE VICINITY OF OVERHEAD LINES THE HEALTH AND SAFETY GUIDANCE NOTES G56 SHOULD BE CONSULTED (AVAILABLE FROM THE HSE WEBSITE)

Southern Electric Power Distribution plc
 Registered Office: No.1 Forbury Place
 43 Forbury Road Reading RG1 3JH
 Registered In England & Wales No.04094290

If you're unsure & need to seek advice before commencing excavations, please contact:
 General Enquiries: 0800 048 3516

Subject to revision - Master held by SSEN Asset Data Team:
Asset.Data@sse.com
 01256 337 294

Scale: 1:500 (When plotted at A4)

Warning: PDF designed for A4 colour print only with no page scaling














0  20m Dig Sites Area:  Line: 


 



**Extra High Voltage
cables in vicinity**



Date Requested: 24/06/2022
 Job Reference: 25881010
 Site Location: 448066 213346
 Requested by: Mr Joe Shawyer
 Your Scheme/Reference: 31188_002

Voltages (V)			
LV (Low Voltage) and Services	Up to 1,000V		
HV (High Voltage)	Over 1,000V to 11,000V		
EHV (Extra High Voltage)	22,000V to 132,000V		
Transmission	275,000V and 400,000V		
NORMAL DEPTH TO THE TOP OF THE CABLE WHEN LAID			
Services	LV	HV	EHV
Footpath/Unmade	0.45m	0.45m	0.6m 0.8m
Road Crossing	0.6m	0.6m	0.75m 0.9m
Agricultural	1m	1m	1m 1.1m

Legend	
	Service Cable
	LV Mains
	2 - 11kV
	66kV
	11kV
	22kV
	33kV
	66kV
	132kV
	275kV
	400kV
	Fibre Optic
	Pipe Cable

Distribution Structures (Electric)	
	Pole, Existing Location
	Pole Structure, Existing Location - Single
	Pole Structure, Existing Location - H
	Duct Route
	Cross Section Route

WARNING


There may have been subsequent alteration to the surface levels. Trial holes must be undertaken to determine position and depths of cables. HS (G) 47 Booklet from the Health and Safety Executive - Avoiding Danger from Buried Cables - should be consulted before commencing excavation work.
WHEN WORKING IN THE VICINITY OF OVERHEAD LINES THE HEALTH AND SAFETY GUIDANCE NOTES G56 SHOULD BE CONSULTED (AVAILABLE FROM THE HSE WEBSITE)

Southern Electric Power Distribution plc
 Registered Office: No.1 Forbury Place
 43 Forbury Road Reading RG1 3JH
 Registered In England & Wales No.04094290

If you're unsure & need to seek advice before commencing excavations, please contact:
 General Enquiries: 0800 048 3516

Subject to revision - Master held by SSEN Asset Data Team:
Asset.Data@sse.com
 01256 337 294

Scale: 1:500 (When plotted at A4)

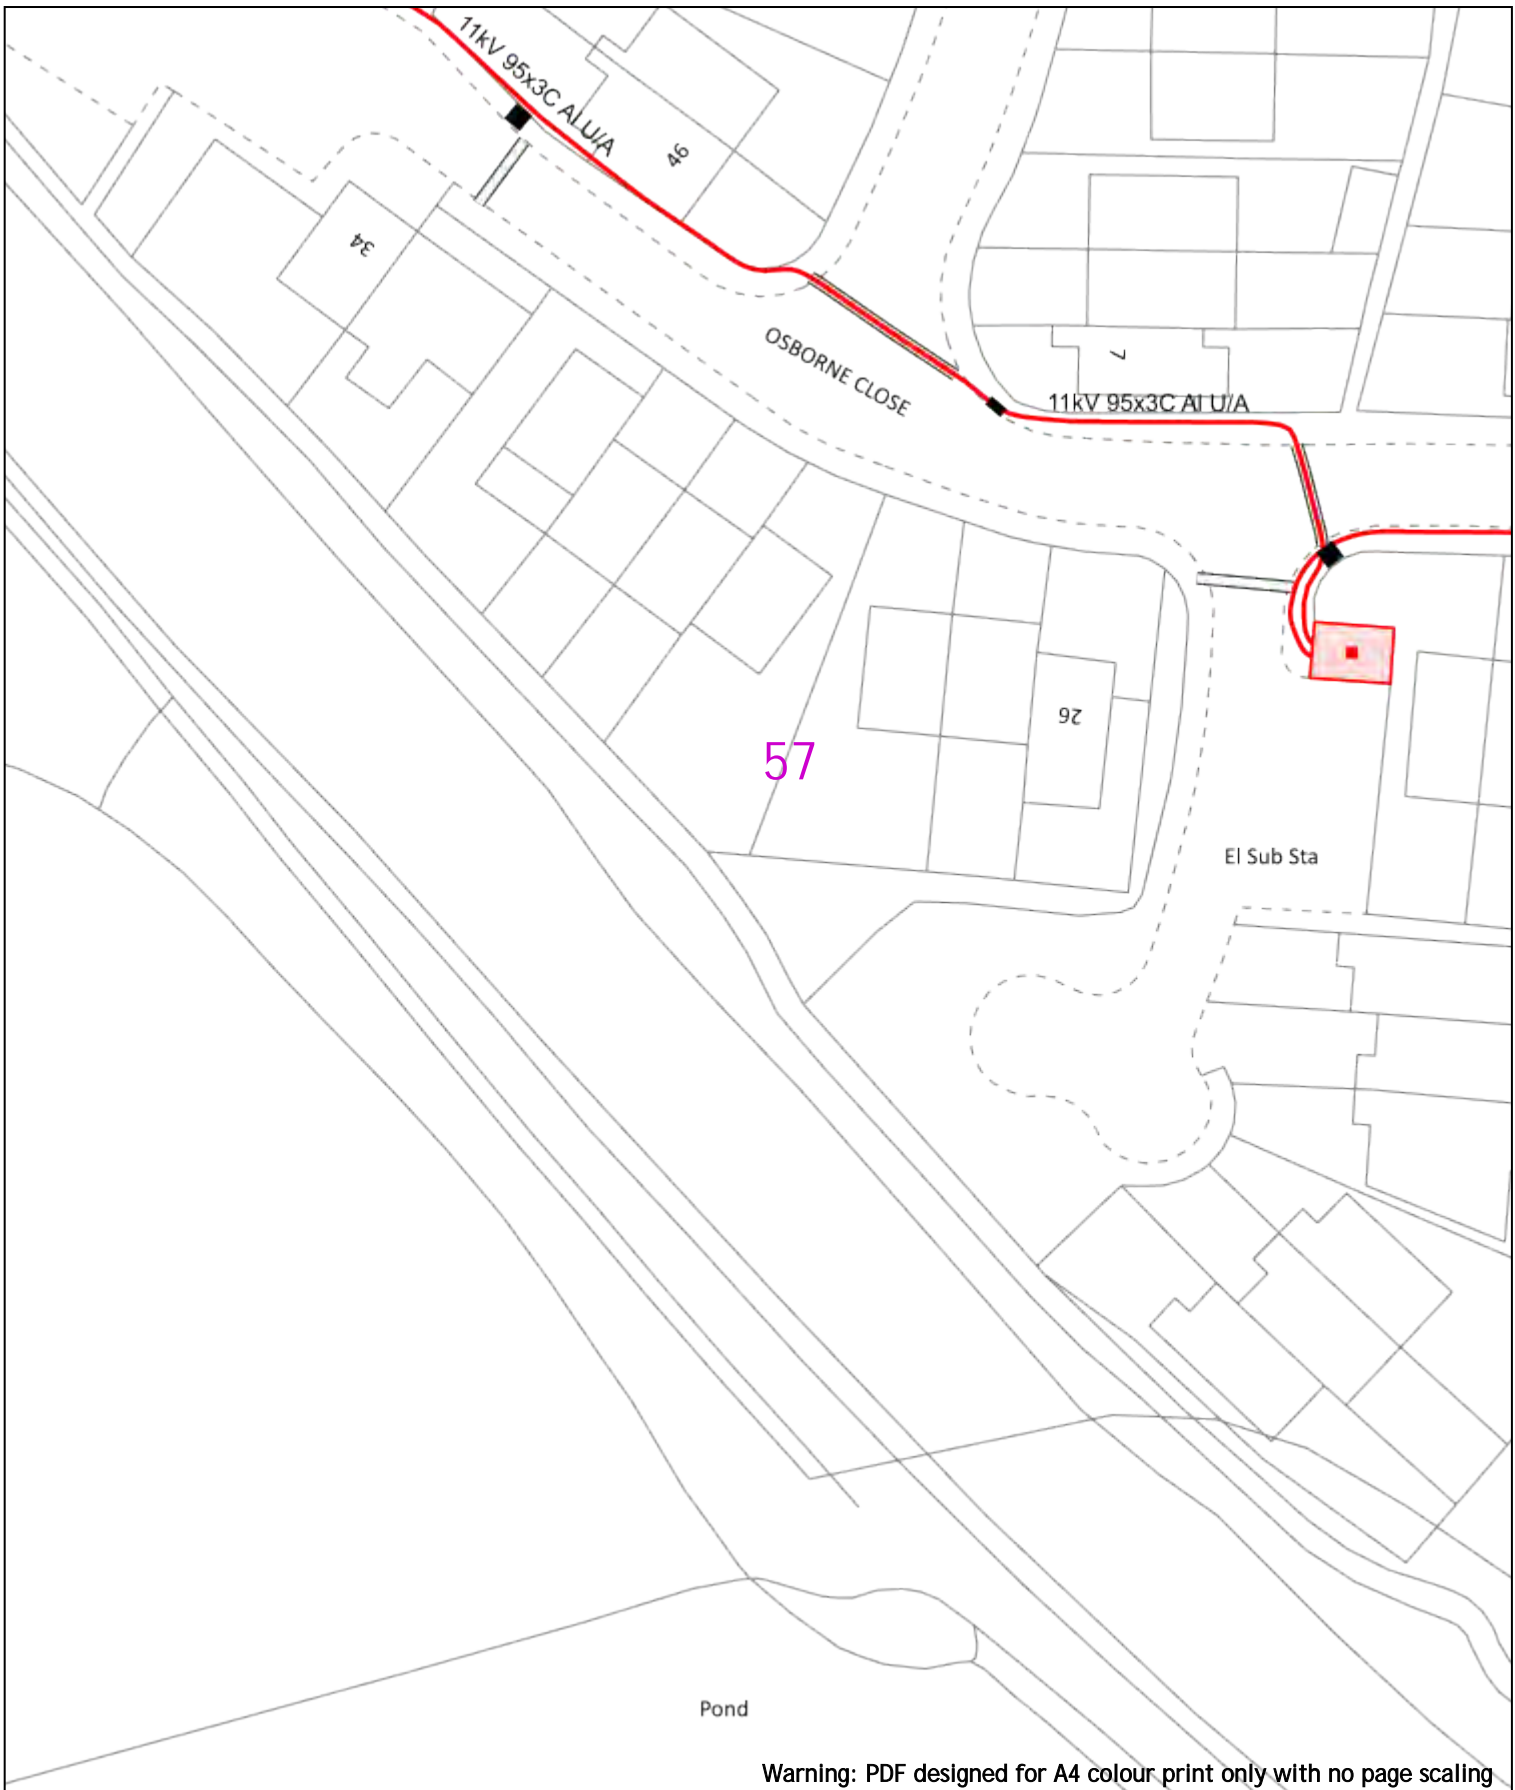

Warning: PDF designed for A4 colour print only with no page scaling



20m Dig Sites Area: Line:

Extra High Voltage cables in vicinity



Date Requested: 24/06/2022
 Job Reference: 25881010
 Site Location: 448066 213346
 Requested by: Mr Joe Shawyer
 Your Scheme/Reference: 31188_002

Voltages (V)			
LV (Low Voltage) and Services	Up to 1,000V		
HV (High Voltage)	Over 1,000V to 11,000V		
EHV (Extra High Voltage)	22,000V to 132,000V		
Transmission	275,000V and 400,000V		
NORMAL DEPTH TO THE TOP OF THE CABLE WHEN LAID			
Services	LV	HV	EHV
Footpath/Unmade	0.45m	0.45m	0.6m
Road Crossing	0.6m	0.6m	0.75m
Agricultural	1m	1m	1.1m

Legend	
	Service Cable
	LV Mains
	2 - 11kV
	66kV
	11kV
	22kV
	33kV
	66kV
	132kV
	275kV
	400kV
	Fibre Optic
	Pipe Cable

Distribution Structures (Electric)	
	Pole, Existing Location
	Pole Structure, Existing Location - Single
	Pole Structure, Existing Location - H
	Duct Route
	Cross Section Route


WARNING
 There may have been subsequent alteration to the surface levels. Trial holes must be undertaken to determine position and depths of cables. HS (G) 47 Booklet from the Health and Safety Executive - Avoiding Danger from Buried Cables - should be consulted before commencing excavation work.
 WHEN WORKING IN THE VICINITY OF OVERHEAD LINES THE HEALTH AND SAFETY GUIDANCE NOTES G56 SHOULD BE CONSULTED (AVAILABLE FROM THE HSE WEBSITE)

Southern Electric Power Distribution plc
 Registered Office: No.1 Forbury Place
 43 Forbury Road Reading RG1 3JH
 Registered In England & Wales No.04094290

If you're unsure & need to seek advice before commencing excavations, please contact:
 General Enquiries: 0800 048 3516


Subject to revision - Master held by SSEN Asset Data Team:
Asset_Data@sse.com
 01256 337 294

Scale: 1:500 (When plotted at A4)

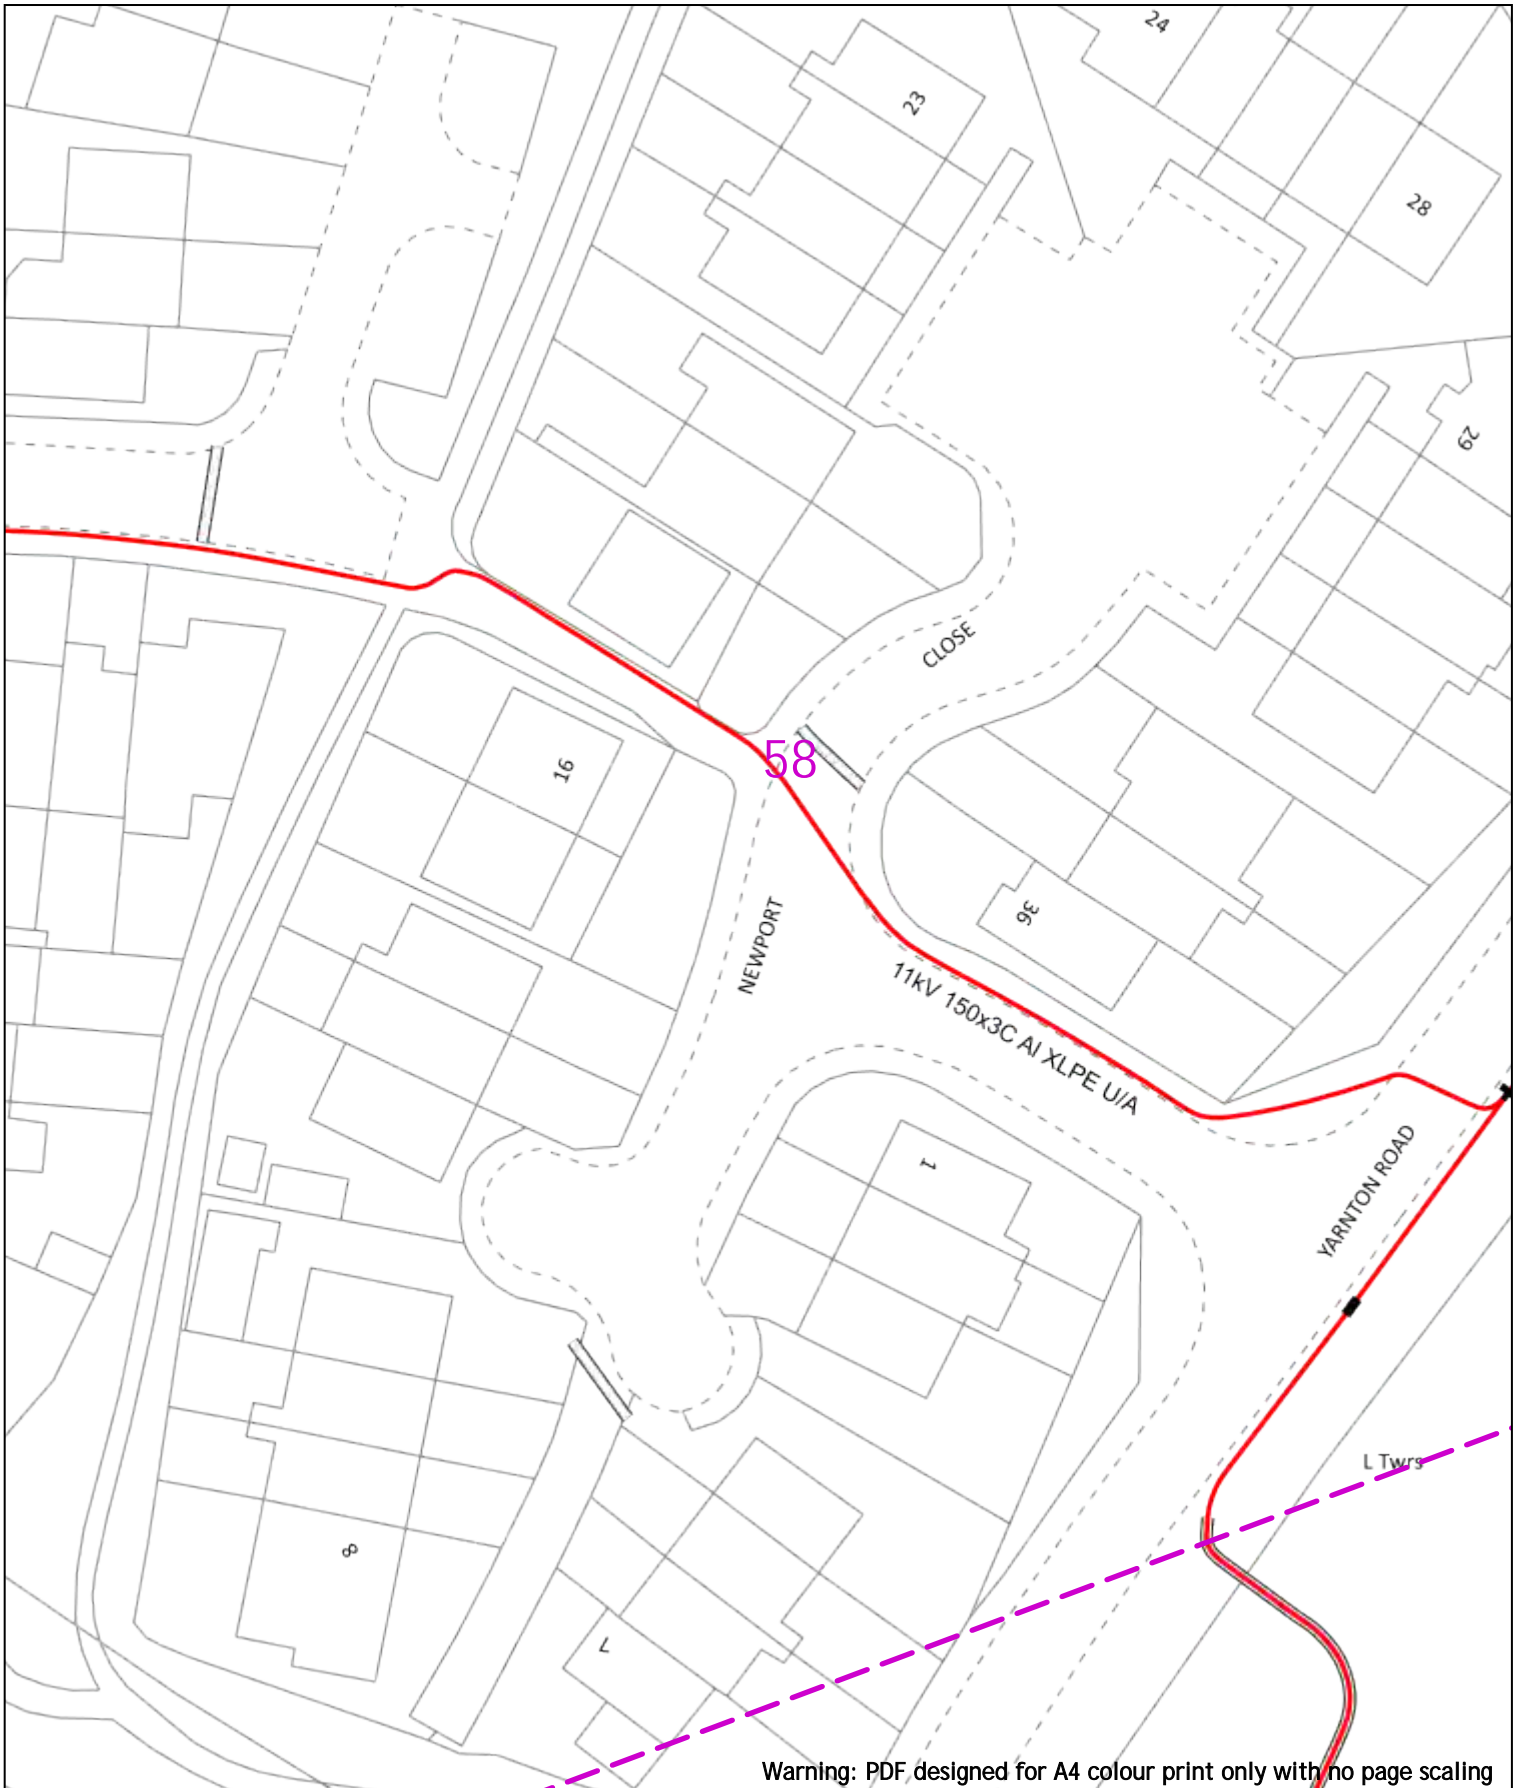

Warning: PDF designed for A4 colour print only with no page scaling

<p>0 20m</p>	<p>Dig Sites Area: Line: </p>	<p>Extra High Voltage cables in vicinity</p>																									
<p>Date Requested: 24/06/2022 Job Reference: 25881010 Site Location: 448066 213346 Requested by: Mr Joe Shawyer Your Scheme/Reference: 31188_002</p>	<p>Voltages (V)</p> <table border="1"> <tr> <td>LV (Low Voltage) and Services</td> <td>Up to 1,000V</td> </tr> <tr> <td>HV (High Voltage)</td> <td>Over 1,000V to 11,000V</td> </tr> <tr> <td>EHV (Extra High Voltage)</td> <td>22,000V to 132,000V</td> </tr> <tr> <td>Transmission</td> <td>275,000V and 400,000V</td> </tr> </table> <p>NORMAL DEPTH TO THE TOP OF THE CABLE WHEN LAID</p> <table border="1"> <thead> <tr> <th>Services</th> <th>LV</th> <th>HV</th> <th>EHV</th> </tr> </thead> <tbody> <tr> <td>Footpath/Unmade</td> <td>0.45m</td> <td>0.45m</td> <td>0.6m</td> </tr> <tr> <td>Road Crossing</td> <td>0.6m</td> <td>0.6m</td> <td>0.75m</td> </tr> <tr> <td>Agricultural</td> <td>1m</td> <td>1m</td> <td>1.1m</td> </tr> </tbody> </table>	LV (Low Voltage) and Services	Up to 1,000V	HV (High Voltage)	Over 1,000V to 11,000V	EHV (Extra High Voltage)	22,000V to 132,000V	Transmission	275,000V and 400,000V	Services	LV	HV	EHV	Footpath/Unmade	0.45m	0.45m	0.6m	Road Crossing	0.6m	0.6m	0.75m	Agricultural	1m	1m	1.1m	<p>Legend</p> <ul style="list-style-type: none"> Service Cable LV Mains 7 - 11kV 6.6kV 11kV 22kV 33kV 66kV 132kV 275kV 400kV Fibre Optic Pipe Cable <p>Distribution Structures (Electric)</p> <ul style="list-style-type: none"> Pole, Existing Location Pole Structure, Existing Location - Single Pole Structure, Existing Location - H Duct Route Cross Section Route 	<p>Southern Electric Power Distribution plc Registered Office: No.1 Forbury Place 43 Forbury Road Reading RG1 3JH Registered In England & Wales No.04094290</p> <p>If you're unsure & need to seek advice before commencing excavations, please contact: General Enquiries: 0800 048 3516</p> <p>Subject to revision – Master held by SSEN Asset Data Team: Asset.Data@sse.com 01256 337 294</p>
<p>Scale: 1:500 (When plotted at A4)</p> <p>WARNING There may have been subsequent alteration to the surface levels. Trial holes must be undertaken to determine position and depths of cables. HS (G) 47 Booklet from the Health and Safety Executive – Avoiding Danger from Buried Cables – should be consulted before commencing excavation work. WHEN WORKING IN THE VICINITY OF OVERHEAD LINES THE HEALTH AND SAFETY GUIDANCE NOTES G56 SHOULD BE CONSULTED (AVAILABLE FROM THE HSE WEBSITE)</p> <p><small>BASED UPON THE ORDNANCE SURVEY MAP WITH THE SANCTION OF THE CONTROLLER OF HM STATIONERY OFFICE CROWN COPYRIGHT RESERVED. This copy has been made by or with the authority of Scottish and Southern Energy Power Distribution Ltd. Pursuant to section 47 of the Copyright, Designs and Patents Act 1988 ("The Act"). Unless the Act provides a relevant exception to copyright the copy must not be copied without prior permission of the copyright owner. Plans generated by DigSAFE Pro™ software provided by LinesearchbeforeDig.</small></p>																											

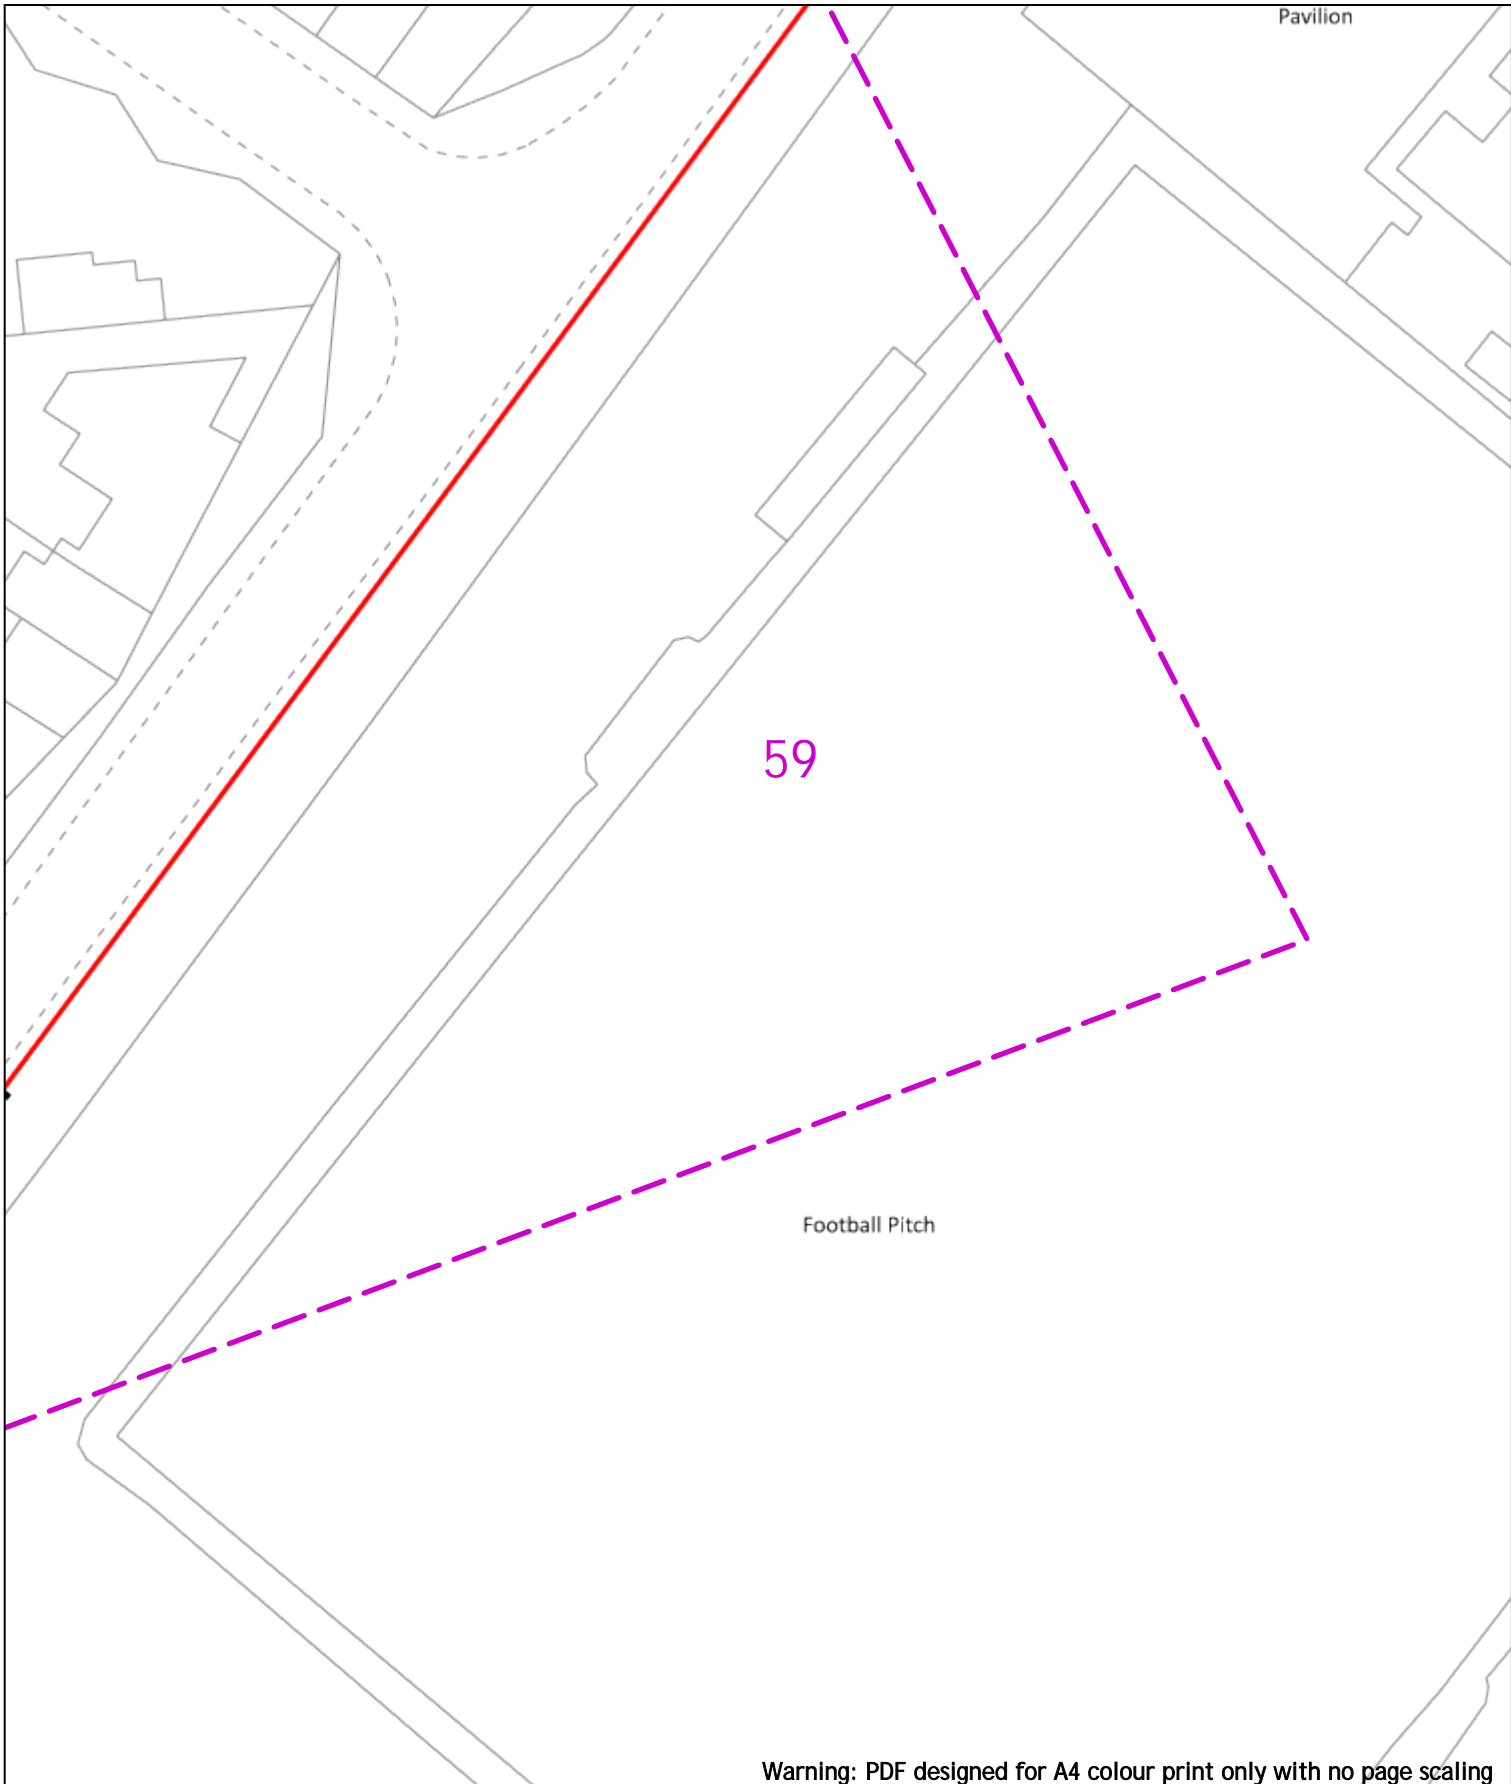

Warning: PDF designed for A4 colour print only with no page scaling



20m Dig Sites Area: Line:

Extra High Voltage cables in vicinity



Date Requested: 24/06/2022
 Job Reference: 25881010
 Site Location: 448066 213346
 Requested by: Mr Joe Shawyer
 Your Scheme/Reference: 31188_002

Voltages (V)				
LV (Low Voltage) and Services	Up to 1,000V			
HV (High Voltage)	Over 1,000V to 11,000V			
EHV (Extra High Voltage)	22,000V to 132,000V			
Transmission	275,000V and 400,000V			
NORMAL DEPTH TO THE TOP OF THE CABLE WHEN LAID				
Services	LV	HV	EHV	
Footpath/Unmade	0.45m	0.45m	0.6m	0.8m
Road Crossing	0.6m	0.6m	0.75m	0.9m
Agricultural	1m	1m	1m	1.1m

Legend	
	Service Cable
	LV Mains
	2 - 11kV
	66kV
	11kV
	22kV
	33kV
	66kV
	132kV
	275kV
	400kV
	Fibre Optic
	Pilot Cable

Distribution Structures (Electric)	
	Pole, Existing Location
	Pole Structure, Existing Location - Single
	Pole Structure, Existing Location - H
	Duct Route
	Cross Section Route

Southern Electric Power Distribution plc
 Registered Office: No.1 Forbury Place
 43 Forbury Road Reading RG1 3JH
 Registered In England & Wales No.04094290


If you're unsure & need to seek advice before commencing excavations, please contact:
 General Enquiries: 0800 048 3516

Subject to revision – Master held by SSEN Asset Data Team:
Asset.Data@sse.com
 01256 337 294

Scale: 1:500 (When plotted at A4)

WARNING
 There may have been subsequent alteration to the surface levels. Trial holes must be undertaken to determine position and depths of cables. HS (G) 47 Booklet from the Health and Safety Executive – Avoiding Danger from Buried Cables – should be consulted before commencing excavation work.
WHEN WORKING IN THE VICINITY OF OVERHEAD LINES THE HEALTH AND SAFETY GUIDANCE NOTES G56 SHOULD BE CONSULTED (AVAILABLE FROM THE HSE WEBSITE)

60

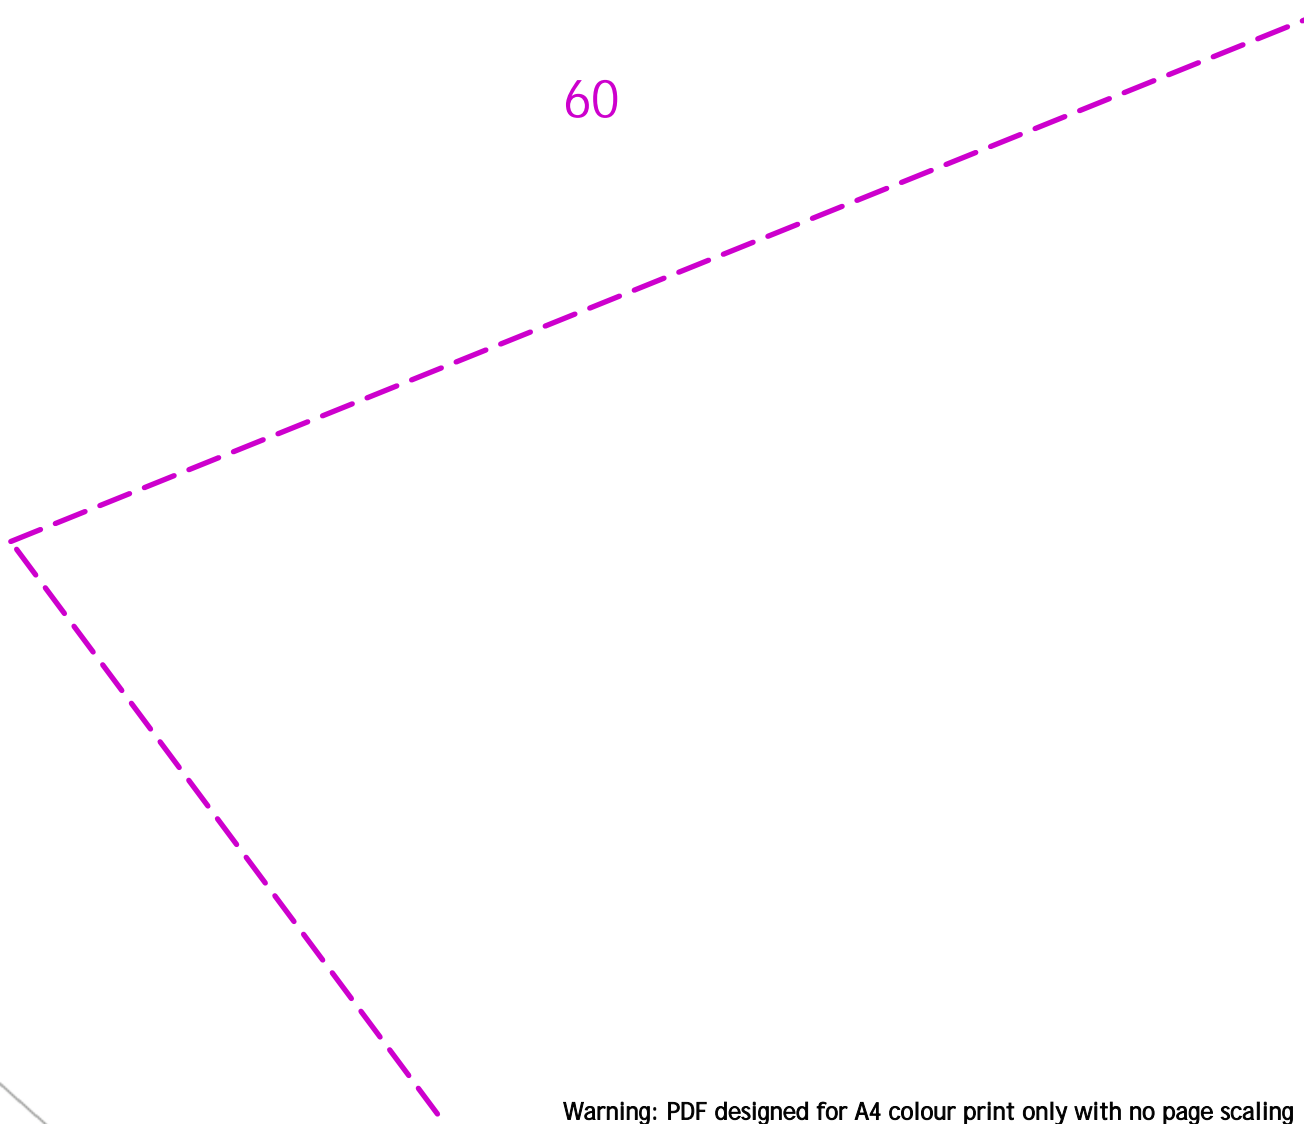

Warning: PDF designed for A4 colour print only with no page scaling



20m Dig Sites Area: [dashed magenta box] Line: [dashed magenta line]

Extra High Voltage cables in vicinity



Date Requested: 24/06/2022
 Job Reference: 25881010
 Site Location: 448066 213346
 Requested by: Mr Joe Shawyer
 Your Scheme/Reference: 31188_002

Voltages (V)			
LV (Low Voltage) and Services	Up to 1,000V		
HV (High Voltage)	Over 1,000V to 11,000V		
EHV (Extra High Voltage)	22,000V to 132,000V		
Transmission	275,000V and 400,000V		
NORMAL DEPTH TO THE TOP OF THE CABLE WHEN LAID			
Services	LV	HV	EHV
Footpath/Unmade	0.45m	0.45m	0.6m 0.8m
Road Crossing	0.6m	0.6m	0.75m 0.9m
Agricultural	1m	1m	1m 1.1m

Legend	
[Orange line]	Service Cable
[Red line]	LV Mains
[Yellow line]	2 - 11kV
[Green line]	66kV
[Pink line]	275kV
[Light Purple line]	400kV
[Light Green line]	Fibre Optic
[Light Orange line]	Pipe Cable

Distribution Structures (Electric)	
[Purple circle]	Pole, Existing Location
[Purple circle]	Pole Structure, Existing Location - Single
[Purple circle]	Pole Structure, Existing Location - H
[Black line]	Duct Route
[Blue line]	Cross Section Route


Southern Electric Power Distribution plc
 Registered Office: No.1 Forbury Place
 43 Forbury Road Reading RG1 3JH
 Registered In England & Wales No.04094290

If you're unsure & need to seek advice before commencing excavations, please contact:
 General Enquiries: 0800 048 3516

Subject to revision – Master held by SSEN Asset Data Team:
Asset.Data@sse.com
 01256 337 294

Scale: 1:500 (When plotted at A4)

WARNING
 There may have been subsequent alteration to the surface levels. Trial holes must be undertaken to determine position and depths of cables. HS (G) 47 Booklet from the Health and Safety Executive – Avoiding Danger from Buried Cables – should be consulted before commencing excavation work.
 WHEN WORKING IN THE VICINITY OF OVERHEAD LINES THE HEALTH AND SAFETY GUIDANCE NOTES G56 SHOULD BE CONSULTED (AVAILABLE FROM THE HSE WEBSITE)

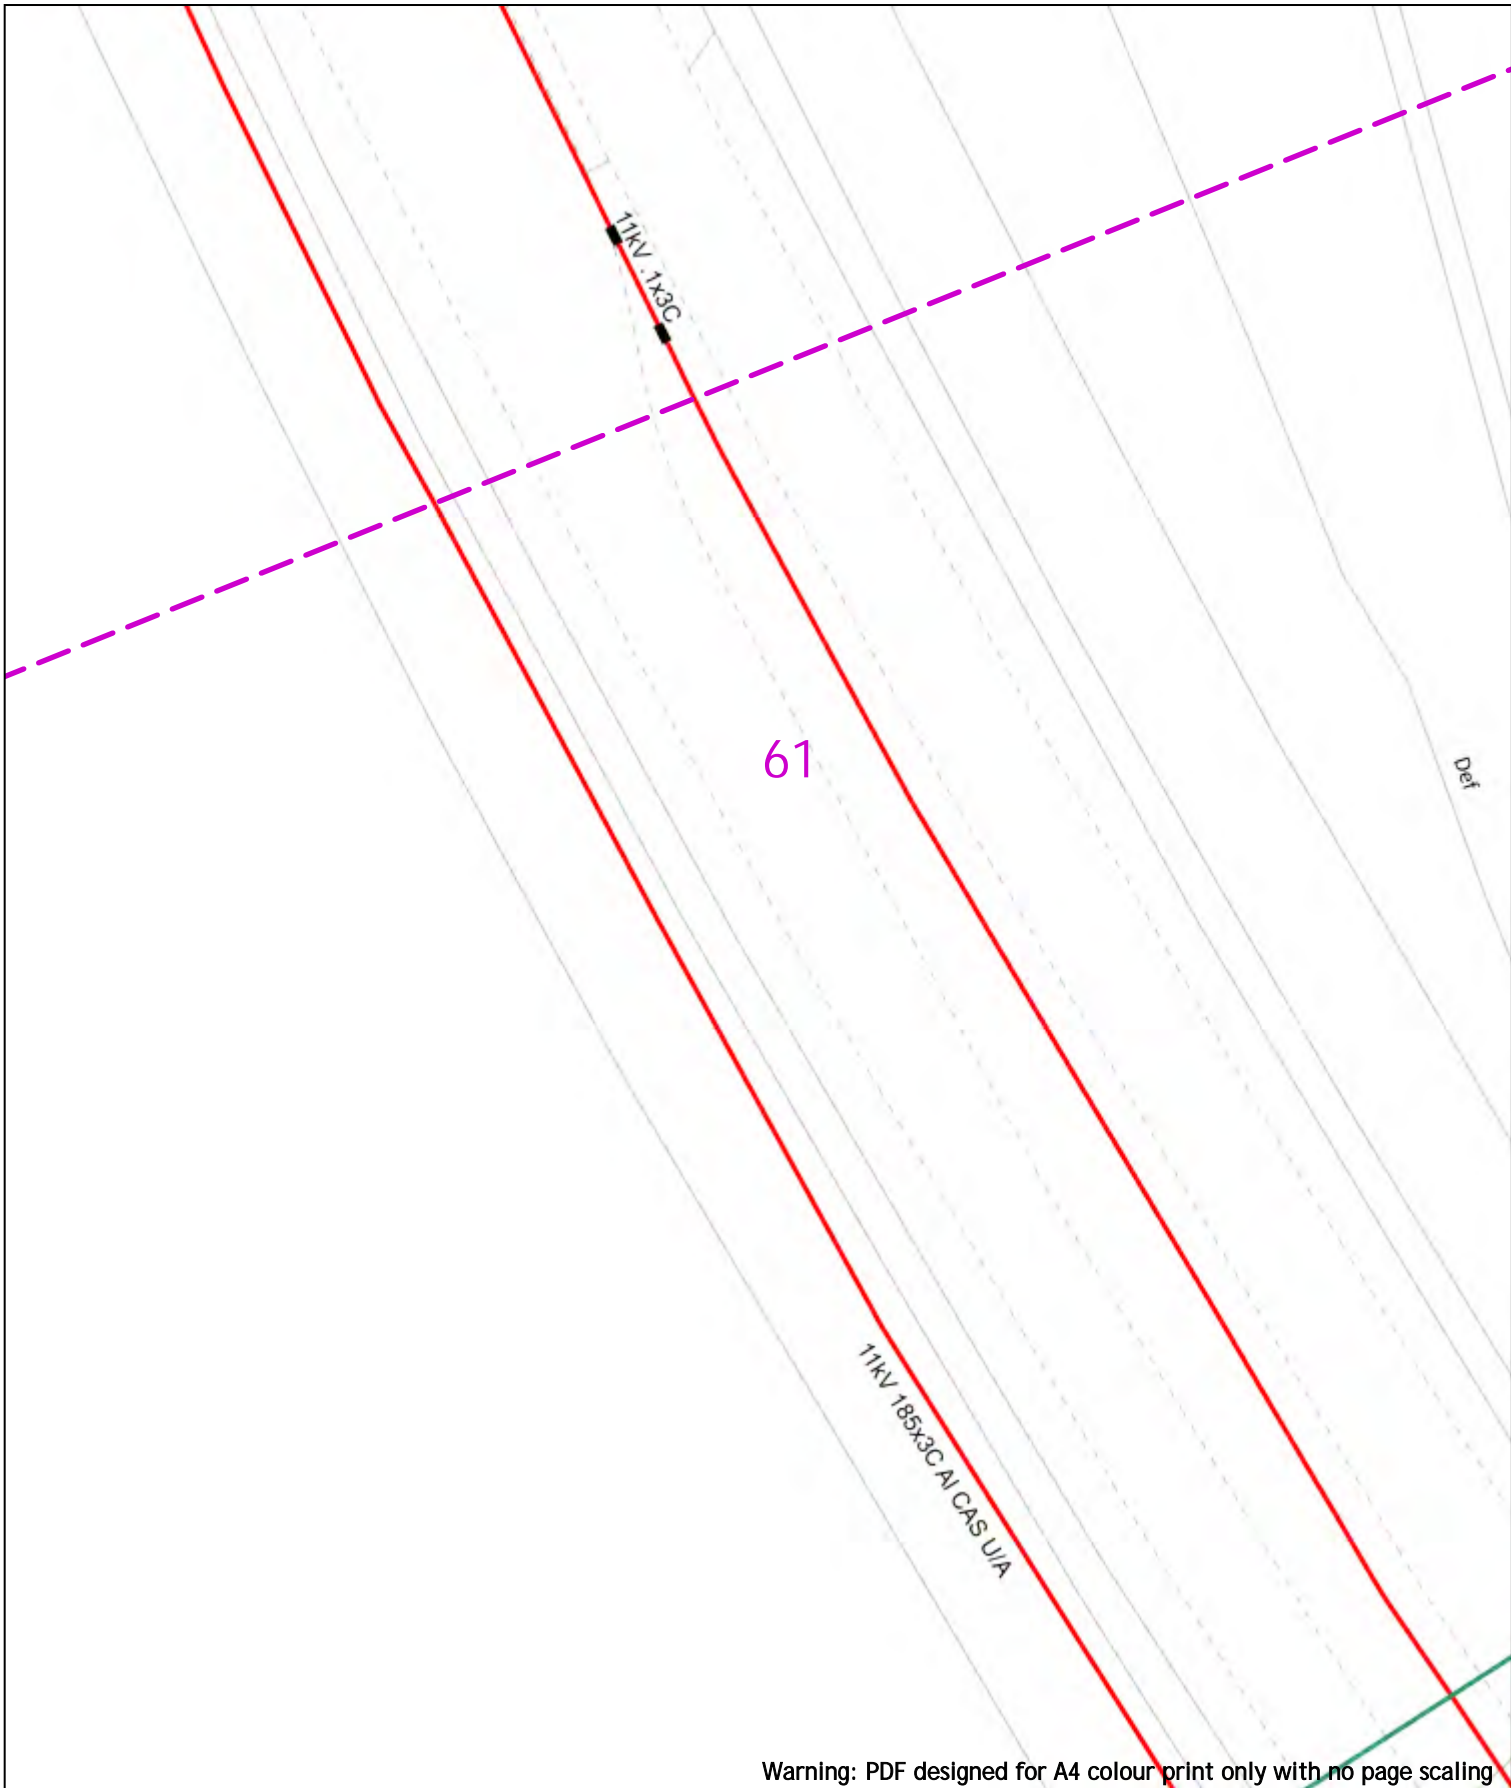

Warning: PDF designed for A4 colour print only with no page scaling

0 20m

Dig Sites Area: Line:

Extra High Voltage cables in vicinity

Date Requested: 24/06/2022
 Job Reference: 25881010
 Site Location: 448066 213346
 Requested by: Mr Joe Shawyer
 Your Scheme/Reference: 31188_002

Voltages (V)				
LV (Low Voltage) and Services	Up to 1,000V			
HV (High Voltage)	Over 1,000V to 11,000V			
EHV (Extra High Voltage)	22,000V to 132,000V			
Transmission	275,000V and 400,000V			

NORMAL DEPTH TO THE TOP OF THE CABLE WHEN LAID				
Services	LV	HV	EHV	
Footpath/Unmade	0.45m	0.45m	0.6m	0.8m
Road Crossing	0.6m	0.6m	0.75m	0.9m
Agricultural	1m	1m	1m	1.1m

Legend	
	Service Cable
	LV Mains
	2 - 11kV
	66kV
	11kV
	22kV
	33kV
	66kV
	132kV
	275kV
	400kV
	Fibre Optic
	Pipe Cable

Distribution Structures (Electric)	
	Pole, Existing Location
	Pole Structure, Existing Location - Single
	Pole Structure, Existing Location - H
	Duct Route
	Cross Section Route

Southern Electric Power Distribution plc
 Registered Office: No.1 Forbury Place
 43 Forbury Road Reading RG1 3JH
 Registered In England & Wales No.04094290


If you're unsure & need to seek advice before commencing excavations, please contact:
 General Enquiries: 0800 048 3516

Subject to revision – Master held by SSEN Asset Data Team:
Asset.Data@sse.com
 01256 337 294

Scale: 1:500 (When plotted at A4)

WARNING
 There may have been subsequent alteration to the surface levels. Trial holes must be undertaken to determine position and depths of cables. HS (G) 47 Booklet from the Health and Safety Executive – Avoiding Danger from Buried Cables – should be consulted before commencing excavation work.
 WHEN WORKING IN THE VICINITY OF OVERHEAD LINES THE HEALTH AND SAFETY GUIDANCE NOTES G56 SHOULD BE CONSULTED (AVAILABLE FROM THE HSE WEBSITE)

BASED UPON THE ORDNANCE SURVEY MAP WITH THE SANCTION OF THE CONTROLLER OF HM STATIONERY OFFICE CROWN COPYRIGHT RESERVED.
 This copy has been made by or with the authority of Scottish and Southern Energy Power Distribution Ltd. Pursuant to section 47 of the Copyright, Designs and Patents Act 1988 ("The Act"). Unless the Act provides a relevant exception to copyright the copy must not be copied without prior permission of the copyright owner.
 Plans generated by DigSAFE Pro™ software provided by LinesearchbeforeDig.

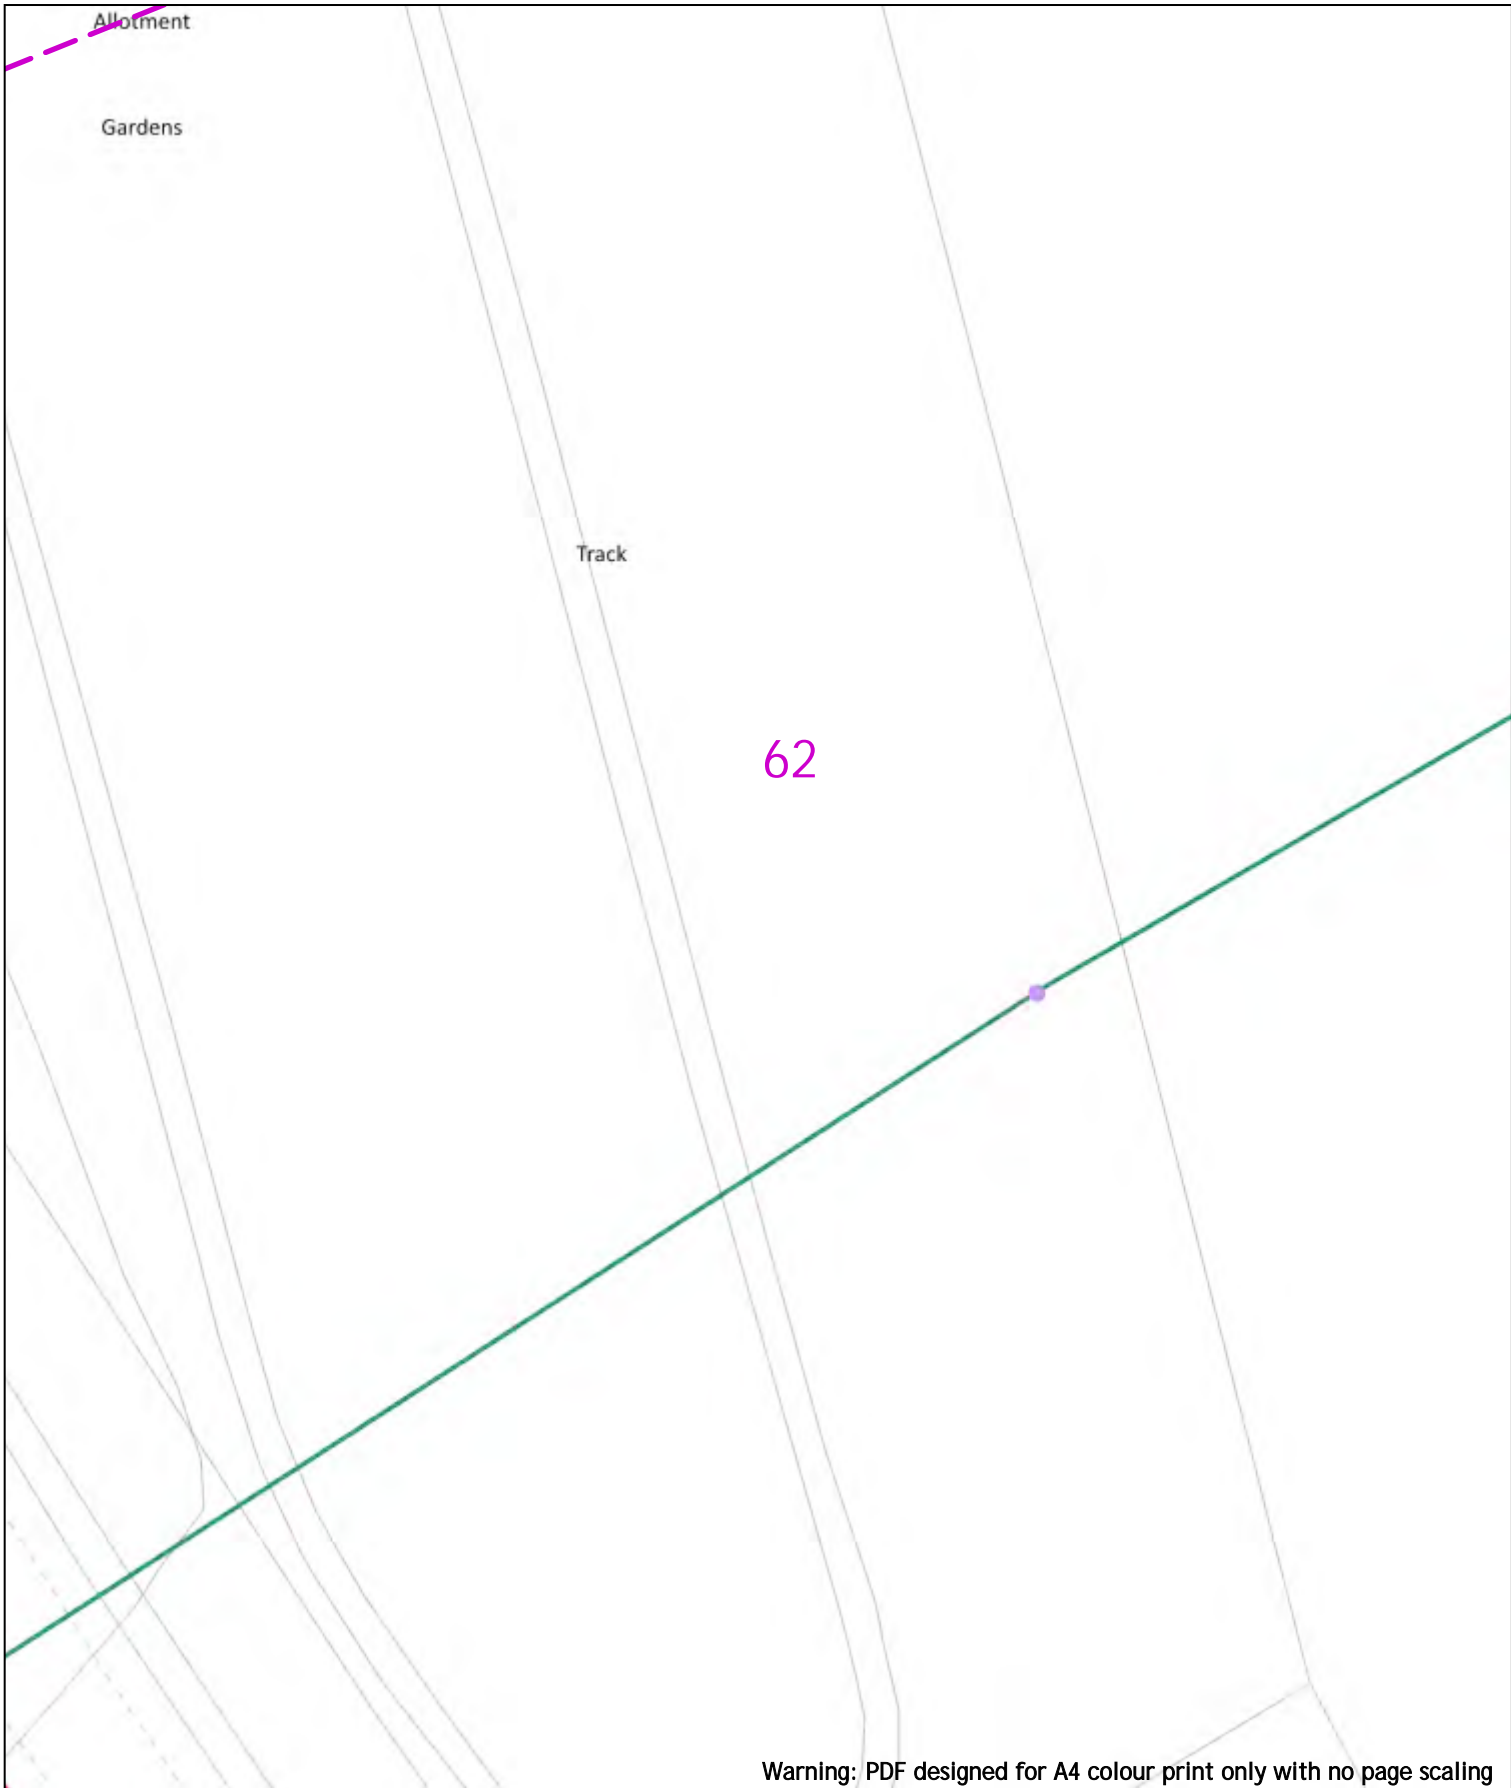

Warning: PDF designed for A4 colour print only with no page scaling

20m Dig Sites Area: Line: Extra High Voltage cables in vicinity

Date Requested: 24/06/2022
 Job Reference: 25881010
 Site Location: 448066 213346
 Requested by: Mr Joe Shawyer
 Your Scheme/Reference: 31188_002

Voltages (V)			
LV (Low Voltage) and Services	Up to 1,000V		
HV (High Voltage)	Over 1,000V to 11,000V		
EHV (Extra High Voltage)	22,000V to 132,000V		
Transmission	275,000V and 400,000V		


NORMA L DEPTH TO THE TOP OF THE CABLE WHEN LAID	Services			
	LV	HV	EHV	
Footpath/Unmade	0.45m	0.45m	0.6m	0.8m
Road Crossing	0.6m	0.6m	0.75m	0.9m
Agricultural	1m	1m	1m	1.1m

Legend		Distribution Structures (Electric)	
	Service Cable	●	Pole, Existing Location
	LV Mains	○	Pole Structure, Existing Location - Single
	2 - 11kV	□	Pole Structure, Existing Location - H
	66kV		Duct Route
	11kV		Cross Section Route
	22kV		
	33kV		
	66kV		
	132kV		
	275kV		
	400kV		
	Fibre Optic		
	Pipe Cable		

WARNING
 There may have been subsequent alteration to the surface levels. Trial holes must be undertaken to determine position and depths of cables. HS (G) 47 Booklet from the Health and Safety Executive - Avoiding Danger from Buried Cables - should be consulted before commencing excavation work.
WHEN WORKING IN THE VICINITY OF OVERHEAD LINES THE HEALTH AND SAFETY GUIDANCE NOTES G56 SHOULD BE CONSULTED (AVAILABLE FROM THE HSE WEBSITE)


Scale: 1:500 (When plotted at A4)

Subject to revision - Master held by SSEN Asset Data Team:
Asset.Data@sse.com
 01256 337 294

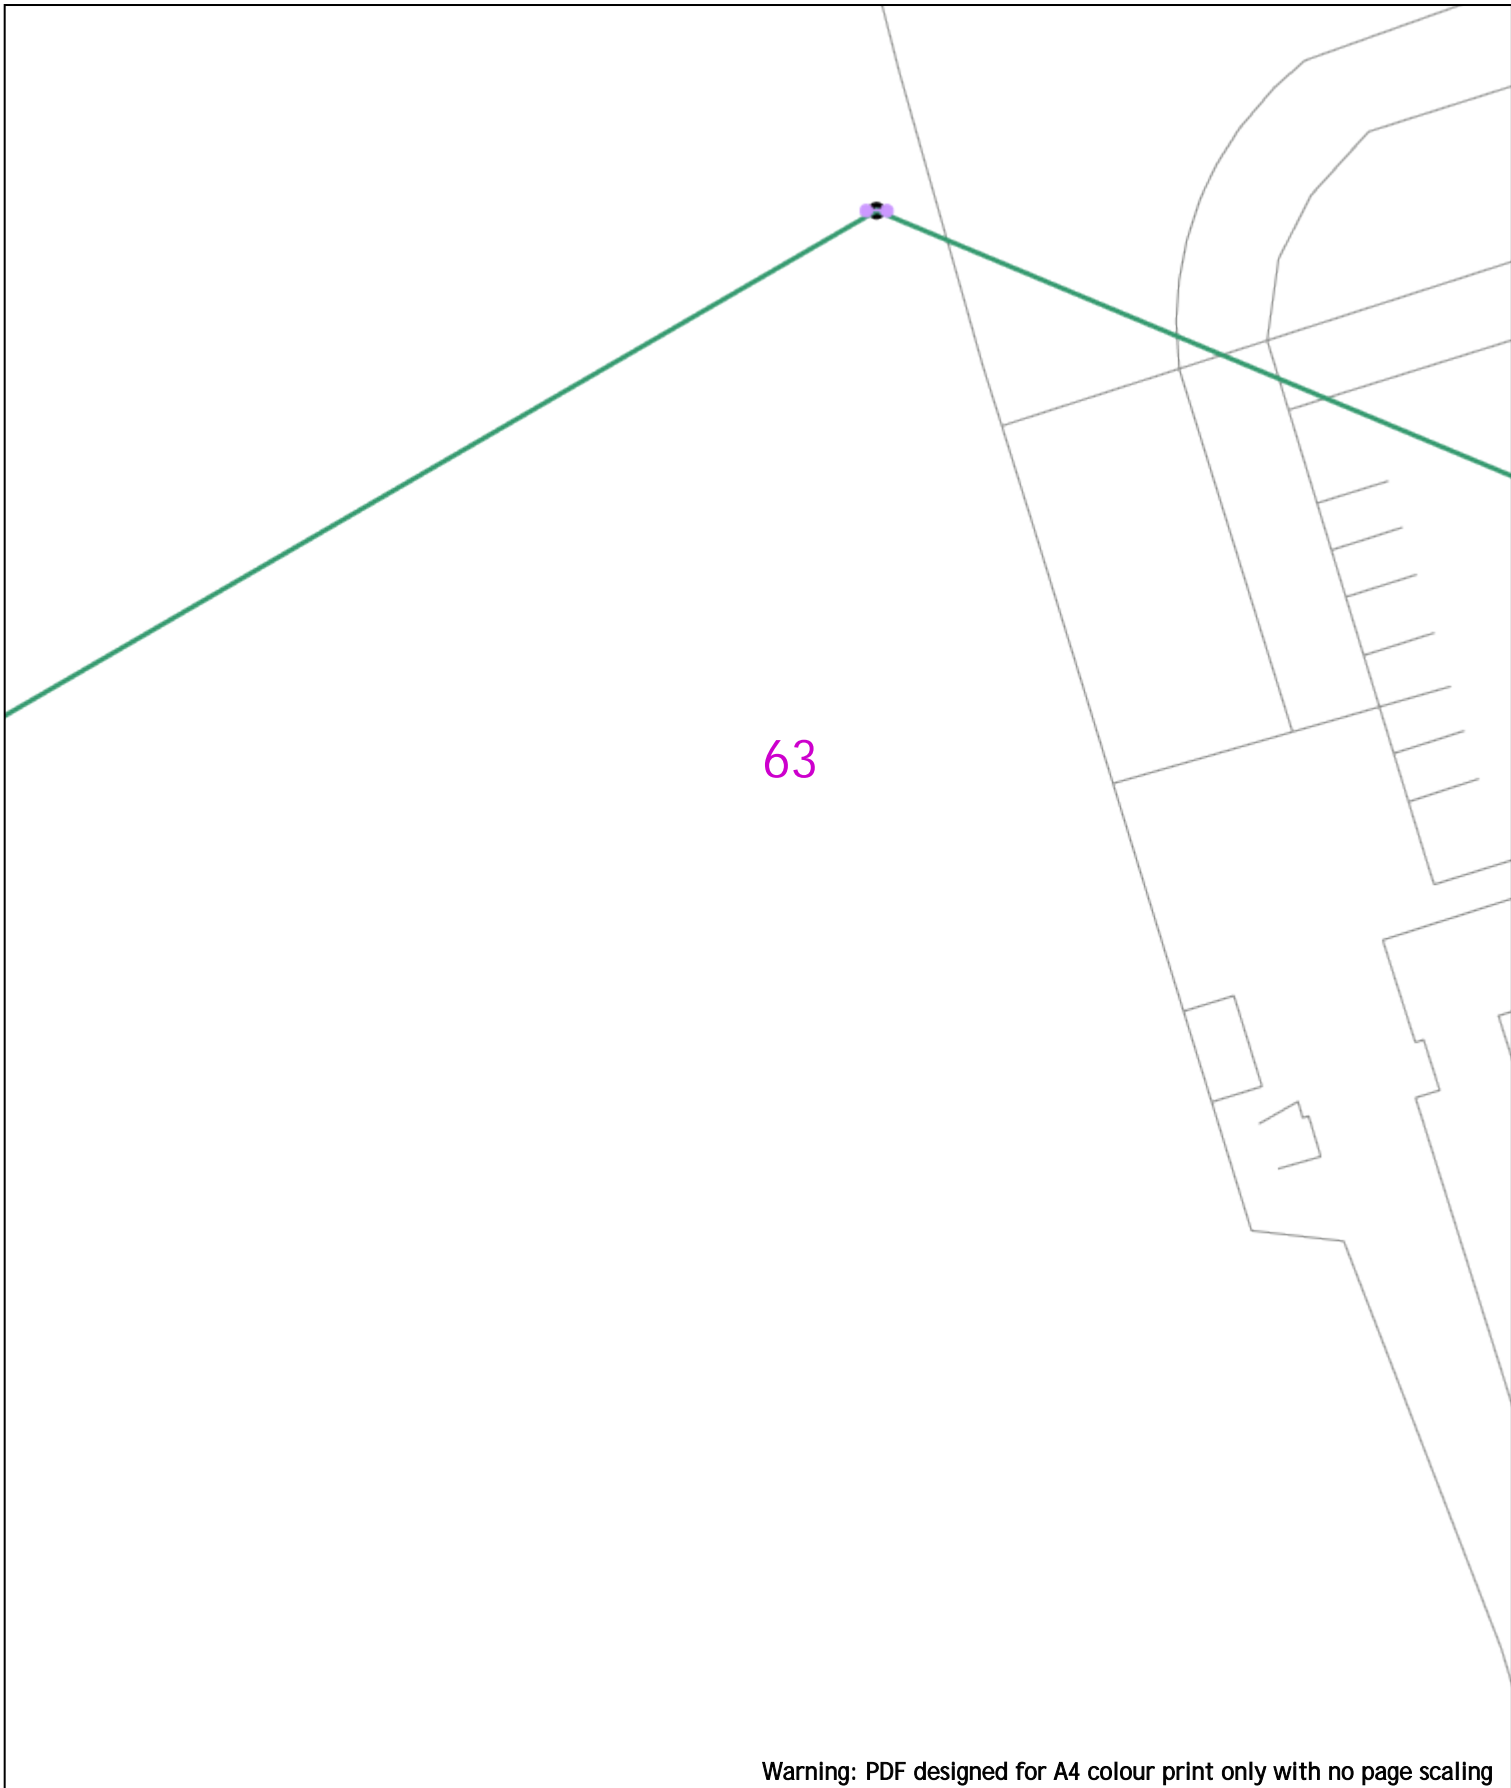

Warning: PDF designed for A4 colour print only with no page scaling

<p>0 20m Dig Sites Area: Line: </p>	<p>Extra High Voltage cables in vicinity</p>	
<p>Date Requested: 24/06/2022 Job Reference: 25881010 Site Location: 448066 213346 Requested by: Mr Joe Shawyer Your Scheme/Reference: 31188_002</p>	<table border="1" style="width: 100%; border-collapse: collapse;"> <thead> <tr> <th colspan="4">Voltages (V)</th> </tr> </thead> <tbody> <tr> <td>LV (Low Voltage) and Services</td> <td colspan="3">Up to 1,000V</td> </tr> <tr> <td>HV (High Voltage)</td> <td colspan="3">Over 1,000V to 11,000V</td> </tr> <tr> <td>EHV (Extra High Voltage)</td> <td colspan="3">22,000V to 132,000V</td> </tr> <tr> <td>Transmission</td> <td colspan="3">275,000V and 400,000V</td> </tr> <tr> <th colspan="4">NORMAL DEPTH TO THE TOP OF THE CABLE WHEN LAID</th> </tr> <tr> <td>Services</td> <td>LV</td> <td>HV</td> <td>EHV</td> </tr> <tr> <td>Footpath/Unmade</td> <td>0.45m</td> <td>0.45m</td> <td>0.6m</td> </tr> <tr> <td>Road Crossing</td> <td>0.6m</td> <td>0.6m</td> <td>0.75m</td> </tr> <tr> <td>Agricultural</td> <td>1m</td> <td>1m</td> <td>1.1m</td> </tr> </tbody> </table>	Voltages (V)				LV (Low Voltage) and Services	Up to 1,000V			HV (High Voltage)	Over 1,000V to 11,000V			EHV (Extra High Voltage)	22,000V to 132,000V			Transmission	275,000V and 400,000V			NORMAL DEPTH TO THE TOP OF THE CABLE WHEN LAID				Services	LV	HV	EHV	Footpath/Unmade	0.45m	0.45m	0.6m	Road Crossing	0.6m	0.6m	0.75m	Agricultural	1m	1m	1.1m	<table border="1" style="width: 100%; border-collapse: collapse;"> <thead> <tr> <th colspan="2">Legend</th> </tr> </thead> <tbody> <tr> <td></td> <td>Service Cable</td> </tr> <tr> <td></td> <td>LV Mains</td> </tr> <tr> <td></td> <td>2 - 11kV</td> </tr> <tr> <td></td> <td>66kV</td> </tr> <tr> <td></td> <td>132kV</td> </tr> <tr> <td></td> <td>275kV</td> </tr> <tr> <td></td> <td>400kV</td> </tr> <tr> <td></td> <td>Fibre Optic</td> </tr> <tr> <td></td> <td>Pipe Cable</td> </tr> </tbody> </table>	Legend			Service Cable		LV Mains		2 - 11kV		66kV		110kV		220kV		330kV		660kV		132kV		275kV		400kV		Fibre Optic		Pipe Cable	<table border="1" style="width: 100%; border-collapse: collapse;"> <thead> <tr> <th colspan="2">Distribution Structures (Electric)</th> </tr> </thead> <tbody> <tr> <td></td> <td>Pole, Existing Location</td> </tr> <tr> <td></td> <td>Pole Structure, Existing Location - Single</td> </tr> <tr> <td></td> <td>Pole Structure, Existing Location - H</td> </tr> <tr> <td></td> <td>Duct Route</td> </tr> <tr> <td></td> <td>Cross Section Route</td> </tr> </tbody> </table>	Distribution Structures (Electric)			Pole, Existing Location		Pole Structure, Existing Location - Single		Pole Structure, Existing Location - H		Duct Route		Cross Section Route
Voltages (V)	
LV (Low Voltage) and Services	Up to 1,000V	
HV (High Voltage)	Over 1,000V to 11,000V	
EHV (Extra High Voltage)	22,000V to 132,000V	
Transmission	275,000V and 400,000V	
NORMAL DEPTH TO THE TOP OF THE CABLE WHEN LAID	
Services	LV	HV	EHV	
Footpath/Unmade	0.45m	0.45m	0.6m	
Road Crossing	0.6m	0.6m	0.75m	
Agricultural	1m	1m	1.1m	
Legend	
	Service Cable	
	LV Mains	
	2 - 11kV	
	66kV	
	132kV	
	275kV	
	400kV	
	Fibre Optic	
	Pipe Cable	
Distribution Structures (Electric)	
	Pole, Existing Location	
	Pole Structure, Existing Location - Single	
	Pole Structure, Existing Location - H	
	Duct Route	
	Cross Section Route	
<p>Scale: 1:500 (When plotted at A4)</p>		<p>Southern Electric Power Distribution plc Registered Office: No.1 Forbury Place 43 Forbury Road Reading RG1 3JH Registered In England & Wales No.04094290</p> <p>If you're unsure & need to seek advice before commencing excavations, please contact: General Enquiries: 0800 048 3516</p> <p>Subject to revision – Master held by SSEN Asset Data Team: Asset.Data@sse.com 01256 337 294</p>	
<p>BASED UPON THE ORDNANCE SURVEY MAP WITH THE SANCTION OF THE CONTROLLER OF HM STATIONERY OFFICE CROWN COPYRIGHT RESERVED. This copy has been made by or with the authority of Scottish and Southern Energy Power Distribution Ltd. Pursuant to section 47 of the Copyright, Designs and Patents Act 1988 ("The Act"). Unless the Act provides a relevant exception to copyright the copy must not be copied without prior permission of the copyright owner. Plans generated by DigSAFE Pro™ software provided by LinesearchbeforeUdig.</p>	

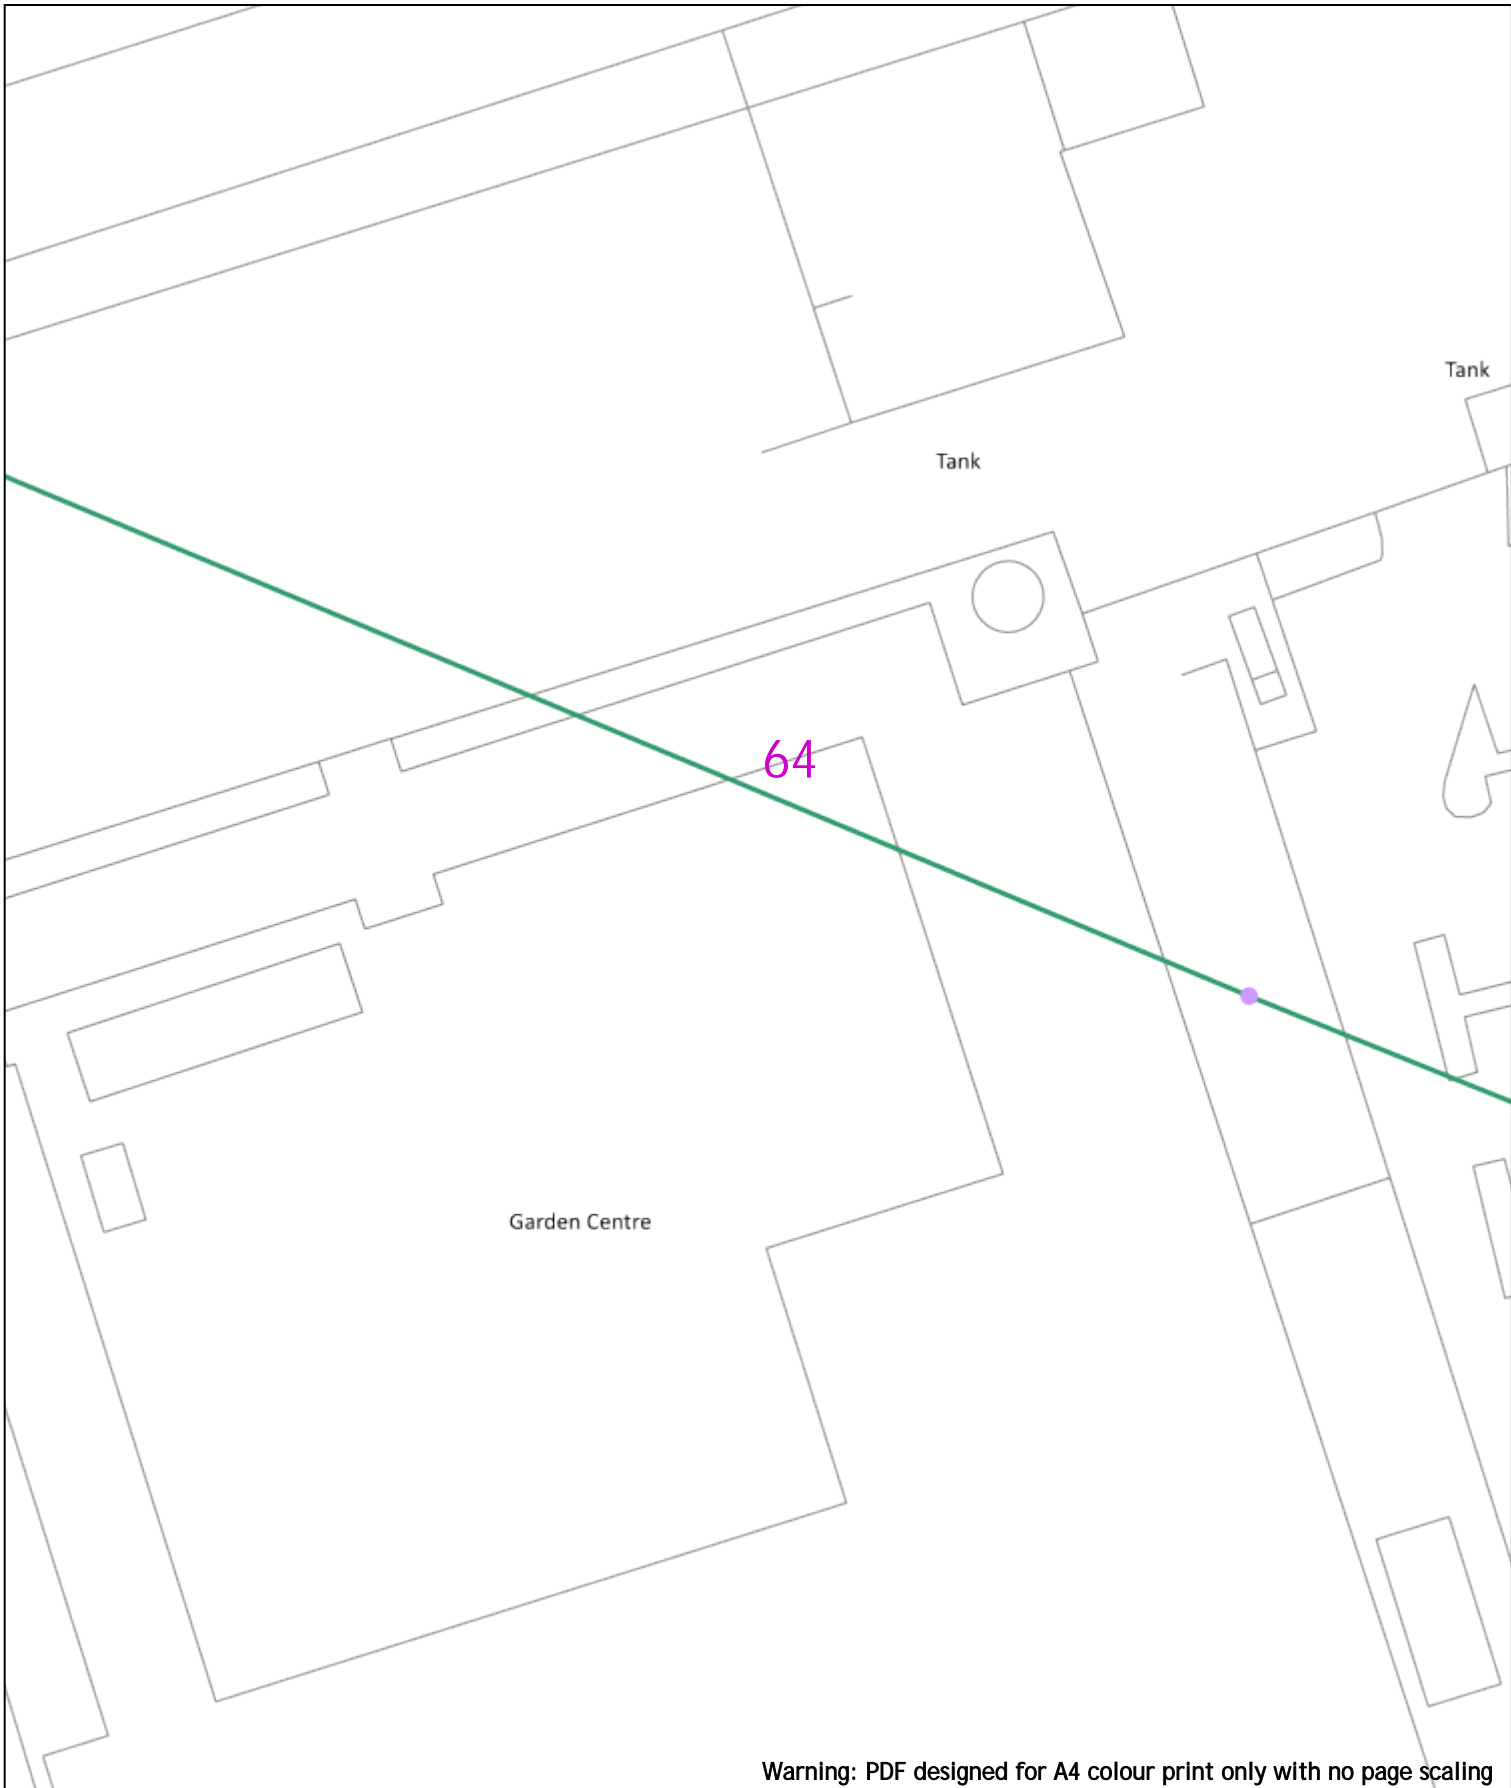

Warning: PDF designed for A4 colour print only with no page scaling

		Dig Sites Area: Line:		Extra High Voltage cables in vicinity	
Date Requested: 24/06/2022 Job Reference: 25881010 Site Location: 448066 213346 Requested by: Mr Joe Shawyer Your Scheme/Reference: 31188_002		<table border="1"> <thead> <tr> <th colspan="4">Voltages (V)</th> </tr> </thead> <tbody> <tr> <td>LV (Low Voltage) and Services</td> <td colspan="3">Up to 1,000V</td> </tr> <tr> <td>HV (High Voltage)</td> <td colspan="3">Over 1,000V to 11,000V</td> </tr> <tr> <td>EHV (Extra High Voltage)</td> <td colspan="3">22,000V to 132,000V</td> </tr> <tr> <td>Transmission</td> <td colspan="3">275,000V and 400,000V</td> </tr> </tbody> </table> <table border="1"> <thead> <tr> <th colspan="4">NORMAL DEPTH TO THE TOP OF THE CABLE WHEN LAID</th> </tr> <tr> <th>Services</th> <th>LV</th> <th>HV</th> <th>EHV</th> </tr> </thead> <tbody> <tr> <td>Footpath/Unmade</td> <td>0.45m</td> <td>0.45m</td> <td>0.6m</td> </tr> <tr> <td>Road Crossing</td> <td>0.6m</td> <td>0.6m</td> <td>0.75m</td> </tr> <tr> <td>Agricultural</td> <td>1m</td> <td>1m</td> <td>1.1m</td> </tr> </tbody> </table>		Voltages (V)				LV (Low Voltage) and Services	Up to 1,000V			HV (High Voltage)	Over 1,000V to 11,000V			EHV (Extra High Voltage)	22,000V to 132,000V			Transmission	275,000V and 400,000V			NORMAL DEPTH TO THE TOP OF THE CABLE WHEN LAID				Services	LV	HV	EHV	Footpath/Unmade	0.45m	0.45m	0.6m	Road Crossing	0.6m	0.6m	0.75m	Agricultural	1m	1m	1.1m	<table border="1"> <thead> <tr> <th colspan="2">Legend</th> </tr> </thead> <tbody> <tr><td></td><td>Service Cable</td></tr> <tr><td></td><td>LV Mains</td></tr> <tr><td></td><td>2 - 11kV</td></tr> <tr><td></td><td>66kV</td></tr> <tr><td></td><td>11kV</td></tr> <tr><td></td><td>22kV</td></tr> <tr><td></td><td>33kV</td></tr> <tr><td></td><td>66kV</td></tr> <tr><td></td><td>132kV</td></tr> <tr><td></td><td>275kV</td></tr> <tr><td></td><td>400kV</td></tr> <tr><td></td><td>Fibre Optic</td></tr> <tr><td></td><td>Pipe Cable</td></tr> </tbody> </table> <table border="1"> <thead> <tr> <th colspan="2">Distribution Structures (Electric)</th> </tr> </thead> <tbody> <tr><td></td><td>Pole, Existing Location</td></tr> <tr><td></td><td>Pole Structure, Existing Location - Single</td></tr> <tr><td></td><td>Pole Structure, Existing Location - H</td></tr> <tr><td></td><td>Duct Route</td></tr> <tr><td></td><td>Cross Section Route</td></tr> </tbody> </table>		Legend			Service Cable		LV Mains		2 - 11kV		66kV		11kV		22kV		33kV		66kV		132kV		275kV		400kV		Fibre Optic		Pipe Cable	Distribution Structures (Electric)			Pole, Existing Location		Pole Structure, Existing Location - Single		Pole Structure, Existing Location - H		Duct Route		Cross Section Route	<p style="text-align: center;">Southern Electric Power Distribution plc Registered Office: No.1 Forbury Place 43 Forbury Road Reading RG1 3JH Registered In England & Wales No.04094290</p> <p>If you're unsure & need to seek advice before commencing excavations, please contact: General Enquiries: 0800 048 3516</p> <p>Subject to revision – Master held by SSEN Asset Data Team: Asset.Data@sse.com 01256 337 294</p>	
Voltages (V)	
LV (Low Voltage) and Services	Up to 1,000V	
HV (High Voltage)	Over 1,000V to 11,000V	
EHV (Extra High Voltage)	22,000V to 132,000V	
Transmission	275,000V and 400,000V	
NORMAL DEPTH TO THE TOP OF THE CABLE WHEN LAID	
Services	LV	HV	EHV	
Footpath/Unmade	0.45m	0.45m	0.6m	
Road Crossing	0.6m	0.6m	0.75m	
Agricultural	1m	1m	1.1m	
Legend	
	Service Cable	
	LV Mains	
	2 - 11kV	
	66kV	
	11kV	
	22kV	
	33kV	
	66kV	
	132kV	
	275kV	
	400kV	
	Fibre Optic	
	Pipe Cable	
Distribution Structures (Electric)	
	Pole, Existing Location	
	Pole Structure, Existing Location - Single	
	Pole Structure, Existing Location - H	
	Duct Route	
	Cross Section Route	
Scale: 1:500 (When plotted at A4)		<p style="color: red; font-size: small;"> WARNING There may have been subsequent alteration to the surface levels. Trial holes must be undertaken to determine position and depths of cables. HS (G) 47 Booklet from the Health and Safety Executive – Avoiding Danger from Buried Cables – should be consulted before commencing excavation work. WHEN WORKING IN THE VICINITY OF OVERHEAD LINES THE HEALTH AND SAFETY GUIDANCE NOTES G56 SHOULD BE CONSULTED (AVAILABLE FROM THE HSE WEBSITE) </p>		<p style="font-size: x-small;"> BASED UPON THE ORDNANCE SURVEY MAP WITH THE SANCTION OF THE CONTROLLER OF HM STATIONERY OFFICE CROWN COPYRIGHT RESERVED. This copy has been made by or with the authority of Scottish and Southern Energy Power Distribution Ltd. Pursuant to section 47 of the Copyright, Designs and Patents Act 1988 ("The Act"). Unless the Act provides a relevant exception to copyright the copy must not be copied without prior permission of the copyright owner. Plans generated by DigSAFE Pro™ software provided by LinesearchbeforeUdig. </p>	



Warning: PDF designed for A4 colour print only with no page scaling

0 20m Dig Sites Area: Line: **Extra High Voltage cables in vicinity**

Date Requested: 24/06/2022
 Job Reference: 25881010
 Site Location: 448066 213346
 Requested by: Mr Joe Shawyer
 Your Scheme/Reference: 31188_002

Voltages (V)			
LV (Low Voltage) and Services	Up to 1,000V		
HV (High Voltage)	Over 1,000V to 11,000V		
EHV (Extra High Voltage)	22,000V to 132,000V		
Transmission	275,000V and 400,000V		
NORMAL DEPTH TO THE TOP OF THE CABLE WHEN LAID			
Services	LV	HV	EHV
Footpath/Unmade	0.45m	0.45m	0.6m
Road Crossing	0.6m	0.6m	0.75m
Agricultural	1m	1m	1.1m

Legend	
	Service Cable
	LV Mains
	2 - 11kV
	66kV
	11kV
	22kV
	33kV
	66kV
	132kV
	275kV
	400kV
	Fibre Optic
	Pilot Cable

Distribution Structures (Electric)	
	Pole, Existing Location
	Pole Structure, Existing Location - Single
	Pole Structure, Existing Location - H
	Duct Route
	Cross Section Route

Southern Electric Power Distribution plc
 Registered Office: No.1 Forbury Place
 43 Forbury Road Reading RG1 3JH
 Registered In England & Wales No.04094290

If you're unsure & need to seek advice before commencing excavations, please contact:
 General Enquiries: 0800 048 3516

Subject to revision – Master held by SSEN Asset Data Team:
Asset.Data@sse.com
 01256 337 294

Scale: 1:500 (When plotted at A4)

WARNING
 There may have been subsequent alteration to the surface levels. Trial holes must be undertaken to determine position and depths of cables. HS (G) 47 Booklet from the Health and Safety Executive – Avoiding Danger from Buried Cables – should be consulted before commencing excavation work.
WHEN WORKING IN THE VICINITY OF OVERHEAD LINES THE HEALTH AND SAFETY GUIDANCE NOTES G56 SHOULD BE CONSULTED (AVAILABLE FROM THE HSE WEBSITE)

BASED UPON THE ORDNANCE SURVEY MAP WITH THE SANCTION OF THE CONTROLLER OF HM STATIONERY OFFICE CROWN COPYRIGHT RESERVED.
 This copy has been made by or with the authority of Scottish and Southern Energy Power Distribution Ltd. Pursuant to section 47 of the Copyright, Designs and Patents Act 1988 ("The Act"). Unless the Act provides a relevant exception to copyright the copy must not be copied without prior permission of the copyright owner.
 Plans generated by DigSAFE Pro™ software provided by LinesearchbeforeUdig.

Warning: PDF designed for A4 colour print only with no page scaling

0 20m Dig Sites Area: Line:

**Extra High Voltage
cables in vicinity**



Date Requested: 24/06/2022
 Job Reference: 25881010
 Site Location: 448066 213346
 Requested by: Mr Joe Shawyer
 Your Scheme/Reference: 31188_002

Voltages (V)			
LV (Low Voltage) and Services	Up to 1,000V		
HV (High Voltage)	Over 1,000V to 11,000V		
EHV (Extra High Voltage)	22,000V to 132,000V		
Transmission	275,000V and 400,000V		
NORMAL DEPTH TO THE TOP OF THE CABLE WHEN LAID			
Services	LV	HV	EHV
Footpath/Unmade	0.45m	0.45m	0.6m 0.8m
Road Crossing	0.6m	0.6m	0.75m 0.9m
Agricultural	1m	1m	1m 1.1m

Legend	
	Service Cable
	LV Mains
	2 - 11kV
	66kV
	275kV
	400kV
	Fibre Optic
	Pipe Cable

Distribution Structures (Electric)	
	Pole, Existing Location
	Pole Structure, Existing Location - Single
	Pole Structure, Existing Location - H
	Duct Route
	Cross Section Route

WARNING
 There may have been subsequent alteration to the surface levels. Trial holes must be undertaken to determine position and depths of cables. HS (G) 47 Booklet from the Health and Safety Executive - Avoiding Danger from Buried Cables - should be consulted before commencing excavation work.
WHEN WORKING IN THE VICINITY OF OVERHEAD LINES THE HEALTH AND SAFETY GUIDANCE NOTES G66 SHOULD BE CONSULTED (AVAILABLE FROM THE HSE WEBSITE)

Southern Electric Power Distribution plc
 Registered Office: No.1 Forbury Place
 43 Forbury Road Reading RG1 3JH
 Registered In England & Wales No.04094290

If you're unsure & need to seek advice before commencing excavations, please contact:
 General Enquiries: 0800 048 3516

Subject to revision - Master held by SSEN Asset Data Team:
Asset.Data@sse.com
 01256 337 294

Scale: 1:500 (When plotted at A4)

Def

67

Warning: PDF designed for A4 colour print only with no page scaling

0 20m Dig Sites Area: Line:

**Extra High Voltage
cables in vicinity**



Date Requested: 24/06/2022
Job Reference: 25881010
Site Location: 448066 213346
Requested by: Mr Joe Shawyer
Your Scheme/Reference: 31188_002

Voltages (V)			
LV (Low Voltage) and Services	Up to 1,000V		
HV (High Voltage)	Over 1,000V to 11,000V		
EHV (Extra High Voltage)	22,000V to 132,000V		
Transmission	275,000V and 400,000V		
NORMAL DEPTH TO THE TOP OF THE CABLE WHEN LAID			
Services	LV	HV	EHV
Footpath/Unmade	0.45m	0.45m	0.6m 0.8m
Road Crossing	0.6m	0.6m	0.75m 0.9m
Agricultural	1m	1m	1m 1.1m

Legend

- Service Cable
- LV Mains
- 2 - 11kV
- 66kV
- 11kV
- 22kV
- 33kV
- 66kV
- 132kV
- 275kV
- 400kV
- Fibre Optic
- Pipe Cable

Distribution Structures (Electric)

- Pole, Existing Location
- Pole Structure, Existing Location - Single
- Pole Structure, Existing Location - H
- Duct Route
- Cross Section Route


WARNING
There may have been subsequent alteration to the surface levels. Trial holes must be undertaken to determine position and depths of cables. HS (G) 47 Booklet from the Health and Safety Executive - Avoiding Danger from Buried Cables - should be consulted before commencing excavation work.
WHEN WORKING IN THE VICINITY OF OVERHEAD LINES THE HEALTH AND SAFETY GUIDANCE NOTES G56 SHOULD BE CONSULTED (AVAILABLE FROM THE HSE WEBSITE)

Southern Electric Power Distribution plc
Registered Office: No.1 Forbury Place
43 Forbury Road Reading RG1 3JH
Registered In England & Wales No.04094290

If you're unsure & need to seek advice before commencing excavations, please contact:
General Enquiries: 0800 048 3516

Subject to revision - Master held by SSEN Asset Data Team:
Asset.Data@sse.com
01256 337 294

Scale: 1:500 (When plotted at A4)

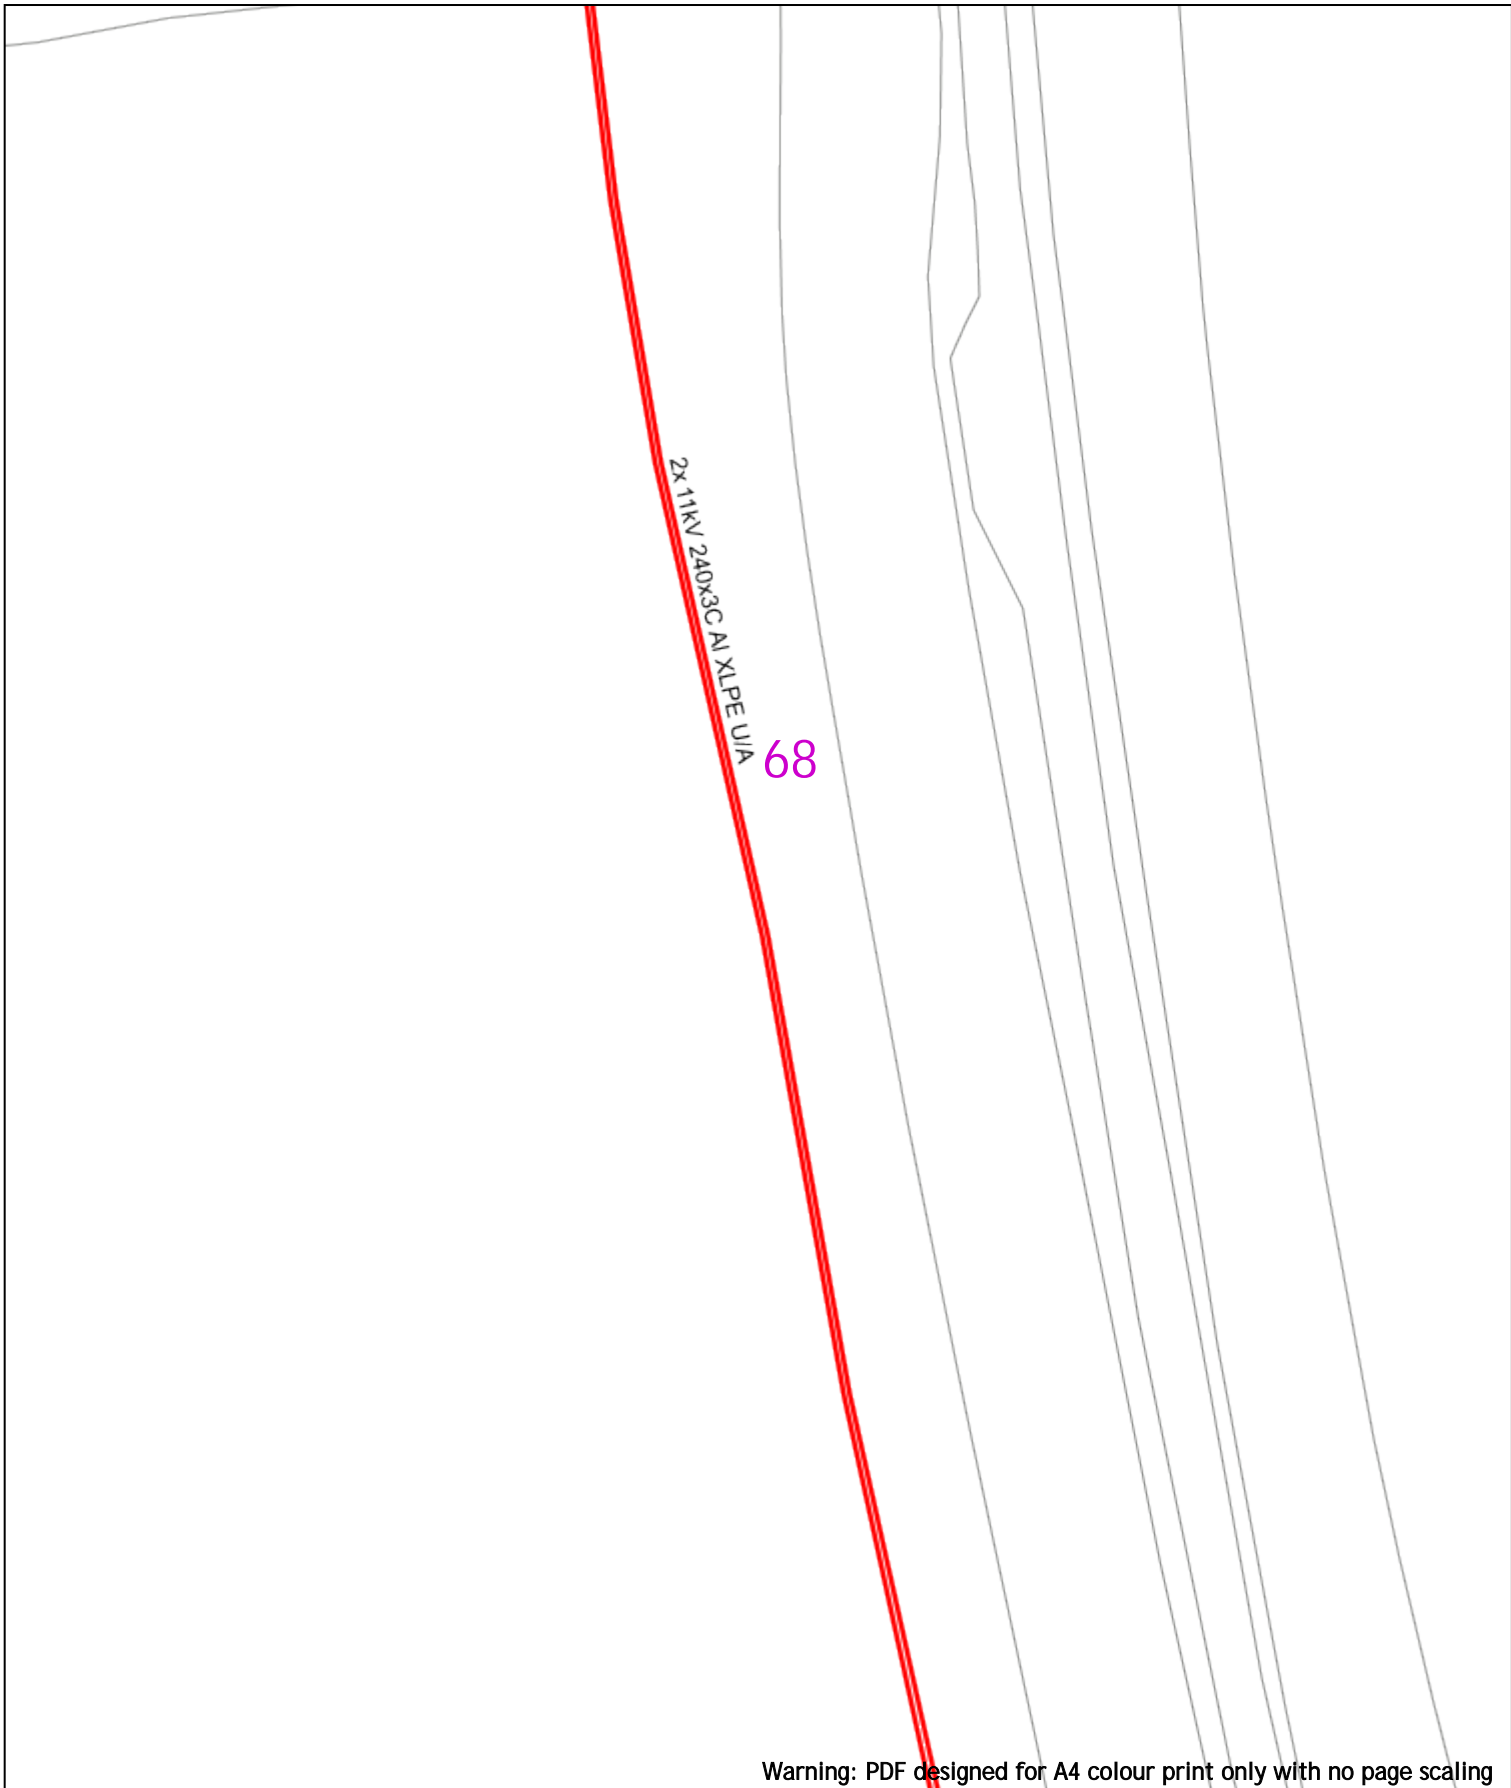

Warning: PDF designed for A4 colour print only with no page scaling

20m Dig Sites Area: Line:

**Extra High Voltage
cables in vicinity**

Date Requested: 24/06/2022
 Job Reference: 25881010
 Site Location: 448066 213346
 Requested by: Mr Joe Shawyer
 Your Scheme/Reference: 31188_002

Voltages (V)			
LV (Low Voltage) and Services	Up to 1,000V		
HV (High Voltage)	Over 1,000V to 11,000V		
EHV (Extra High Voltage)	22,000V to 132,000V		
Transmission	275,000V and 400,000V		

NORMAL DEPTH TO THE TOP OF THE CABLE WHEN LAID				
Services	LV	HV	EHV	
Footpath/Unmade	0.45m	0.45m	0.6m	0.8m
Road Crossing	0.6m	0.6m	0.75m	0.9m
Agricultural	1m	1m	1m	1.1m

Legend

- Service Cable
- LV Mains
- 2 - 11kV
- 66kV
- 11kV
- 22kV
- 33kV
- 66kV
- 132kV
- 275kV
- 400kV
- Fibre Optic
- Pipit Cable

Distribution Structures (Electric)

- Pole, Existing Location
- Pole Structure, Existing Location - Single
- Pole Structure, Existing Location - H
- Duct Route
- Cross Section Route

Southern Electric Power Distribution plc

Registered Office: No.1 Forbury Place
 43 Forbury Road Reading RG1 3JH
 Registered In England & Wales No.04094290

If you're unsure & need to seek advice before commencing excavations, please contact:
 General Enquiries: 0800 048 3516

Subject to revision – Master held by SSEN Asset Data Team:
Asset.Data@sse.com
 01256 337 294

Scale: 1:500 (When plotted at A4)

WARNING

There may have been subsequent alteration to the surface levels. Trial holes must be undertaken to determine position and depths of cables. HS (G) 47 Booklet from the Health and Safety Executive – Avoiding Danger from Buried Cables – should be consulted before commencing excavation work.
WHEN WORKING IN THE VICINITY OF OVERHEAD LINES THE HEALTH AND SAFETY GUIDANCE NOTES G56 SHOULD BE CONSULTED (AVAILABLE FROM THE HSE WEBSITE)

BASED UPON THE ORDNANCE SURVEY MAP WITH THE SANCTION OF THE CONTROLLER OF HM STATIONERY OFFICE CROWN COPYRIGHT RESERVED.
 This copy has been made by or with the authority of Scottish and Southern Energy Power Distribution Ltd. Pursuant to section 47 of the Copyright, Designs and Patents Act 1988 ("The Act"). Unless the Act provides a relevant exception to copyright the copy must not be copied without prior permission of the copyright owner.
 Plans generated by DigSAFE Pro™ software provided by LinesearchbeforeUdig.

Warning: PDF designed for A4 colour print only with no page scaling

0  20m Dig Sites Area:  Line: 

**Extra High Voltage
cables in vicinity**



Date Requested: 24/06/2022
 Job Reference: 25881010
 Site Location: 448066 213346
 Requested by: Mr Joe Shawyer
 Your Scheme/Reference: 31188_002

Voltages (V)			
LV (Low Voltage) and Services	Up to 1,000V		
HV (High Voltage)	Over 1,000V to 11,000V		
EHV (Extra High Voltage)	22,000V to 132,000V		
Transmission	275,000V and 400,000V		
NORMAL DEPTH TO THE TOP OF THE CABLE WHEN LAID			
Services	LV	HV	EHV
Footpath/Unmade	0.45m	0.45m	0.6m 0.8m
Road Crossing	0.6m	0.6m	0.75m 0.9m
Agricultural	1m	1m	1m 1.1m

Legend	Distribution Structures (Electric)
Service Cable	Pole, Existing Location
LV Mains	Pole Structure, Existing Location - Single
2 - 11kV	Pole Structure, Existing Location - H

WARNING
 There may have been subsequent alteration to the surface levels. Trial holes must be undertaken to determine position and depths of cables. HS (G) 47 Booklet from the Health and Safety Executive - Avoiding Danger from Buried Cables - should be consulted before commencing excavation work.
WHEN WORKING IN THE VICINITY OF OVERHEAD LINES THE HEALTH AND SAFETY GUIDANCE NOTES G56 SHOULD BE CONSULTED (AVAILABLE FROM THE HSE WEBSITE)

Southern Electric Power Distribution plc
 Registered Office: No.1 Forbury Place
 43 Forbury Road Reading RG1 3JH
 Registered In England & Wales No.04094290

If you're unsure & need to seek advice before commencing excavations, please contact:
 General Enquiries: 0800 048 3516

Subject to revision - Master held by SSEN Asset Data Team:
Asset.Data@sse.com
 01256 337 294

Scale: 1:500 (When plotted at A4)

Warning: PDF designed for A4 colour print only with no page scaling

0 20m Dig Sites Area: Line:

**Extra High Voltage
cables in vicinity**



Date Requested: 24/06/2022
 Job Reference: 25881010
 Site Location: 448066 213346
 Requested by: Mr Joe Shawyer
 Your Scheme/Reference: 31188_002

Voltages (V)			
LV (Low Voltage) and Services	Up to 1,000V		
HV (High Voltage)	Over 1,000V to 11,000V		
EHV (Extra High Voltage)	22,000V to 132,000V		
Transmission	275,000V and 400,000V		
NORMAL DEPTH TO THE TOP OF THE CABLE WHEN LAID			
Services	LV	HV	EHV
Footpath/Unmade	0.45m	0.45m	0.6m 0.8m
Road Crossing	0.6m	0.6m	0.75m 0.9m
Agricultural	1m	1m	1m 1.1m

Legend	Distribution Structures (Electric)
Service Cable	Pole, Existing Location
LV Mains	Pole Structure, Existing Location - Single
2 - 11kV	Pole Structure, Existing Location - H
66kV	Duct Route
11kV	Cross Section Route
22kV	
33kV	
66kV	
132kV	
275kV	
400kV	
Fibre Optic	
Pipit Cable	

WARNING
 There may have been subsequent alteration to the surface levels. Trial holes must be undertaken to determine position and depths of cables. HS (G) 47 Booklet from the Health and Safety Executive - Avoiding Danger from Buried Cables - should be consulted before commencing excavation work.
WHEN WORKING IN THE VICINITY OF OVERHEAD LINES THE HEALTH AND SAFETY GUIDANCE NOTES G56 SHOULD BE CONSULTED (AVAILABLE FROM THE HSE WEBSITE)

Southern Electric Power Distribution plc
 Registered Office: No.1 Forbury Place
 43 Forbury Road Reading RG1 3JH
 Registered In England & Wales No.04094290

If you're unsure & need to seek advice before commencing excavations, please contact:
 General Enquiries: 0800 048 3516

Subject to revision - Master held by SSEN Asset Data Team:
Asset.Data@sse.com
 01256 337 294

Scale: 1:500 (When plotted at A4)

Warning: PDF designed for A4 colour print only with no page scaling

0  20m Dig Sites Area:  Line: 

**Extra High Voltage
cables in vicinity**



Date Requested: 24/06/2022
 Job Reference: 25881010
 Site Location: 448066 213346
 Requested by: Mr Joe Shawyer
 Your Scheme/Reference: 31188_002

Voltages (V)			
LV (Low Voltage) and Services	Up to 1,000V		
HV (High Voltage)	Over 1,000V to 11,000V		
EHV (Extra High Voltage)	22,000V to 132,000V		
Transmission	275,000V and 400,000V		
NORMAL DEPTH TO THE TOP OF THE CABLE WHEN LAID			
Services	LV	HV	EHV
Footpath/Unmade	0.45m	0.45m	0.6m 0.8m
Road Crossing	0.6m	0.6m	0.75m 0.9m
Agricultural	1m	1m	1m 1.1m

Legend	
	Service Cable
	LV Mains
	2 - 11kV
	66kV
	11kV
	22kV
	33kV
	66kV
	132kV
	275kV
	400kV
	Fibre Optic
	Pipe Cable

Distribution Structures (Electric)	
	Pole, Existing Location
	Pole Structure, Existing Location - Single
	Pole Structure, Existing Location - H
	Duct Route
	Cross Section Route


Southern Electric Power Distribution plc
 Registered Office: No.1 Forbury Place
 43 Forbury Road Reading RG1 3JH
 Registered In England & Wales No.04094290

If you're unsure & need to seek advice before commencing excavations, please contact:
 General Enquiries: 0800 048 3516

Subject to revision – Master held by SSEN Asset Data Team:
Asset.Data@sse.com
 01256 337 294

Scale: 1:500 (When plotted at A4)

WARNING
 There may have been subsequent alteration to the surface levels. Trial holes must be undertaken to determine position and depths of cables. HS (G) 47 Booklet from the Health and Safety Executive – Avoiding Danger from Buried Cables – should be consulted before commencing excavation work.
WHEN WORKING IN THE VICINITY OF OVERHEAD LINES THE HEALTH AND SAFETY GUIDANCE NOTES G56 SHOULD BE CONSULTED (AVAILABLE FROM THE HSE WEBSITE)

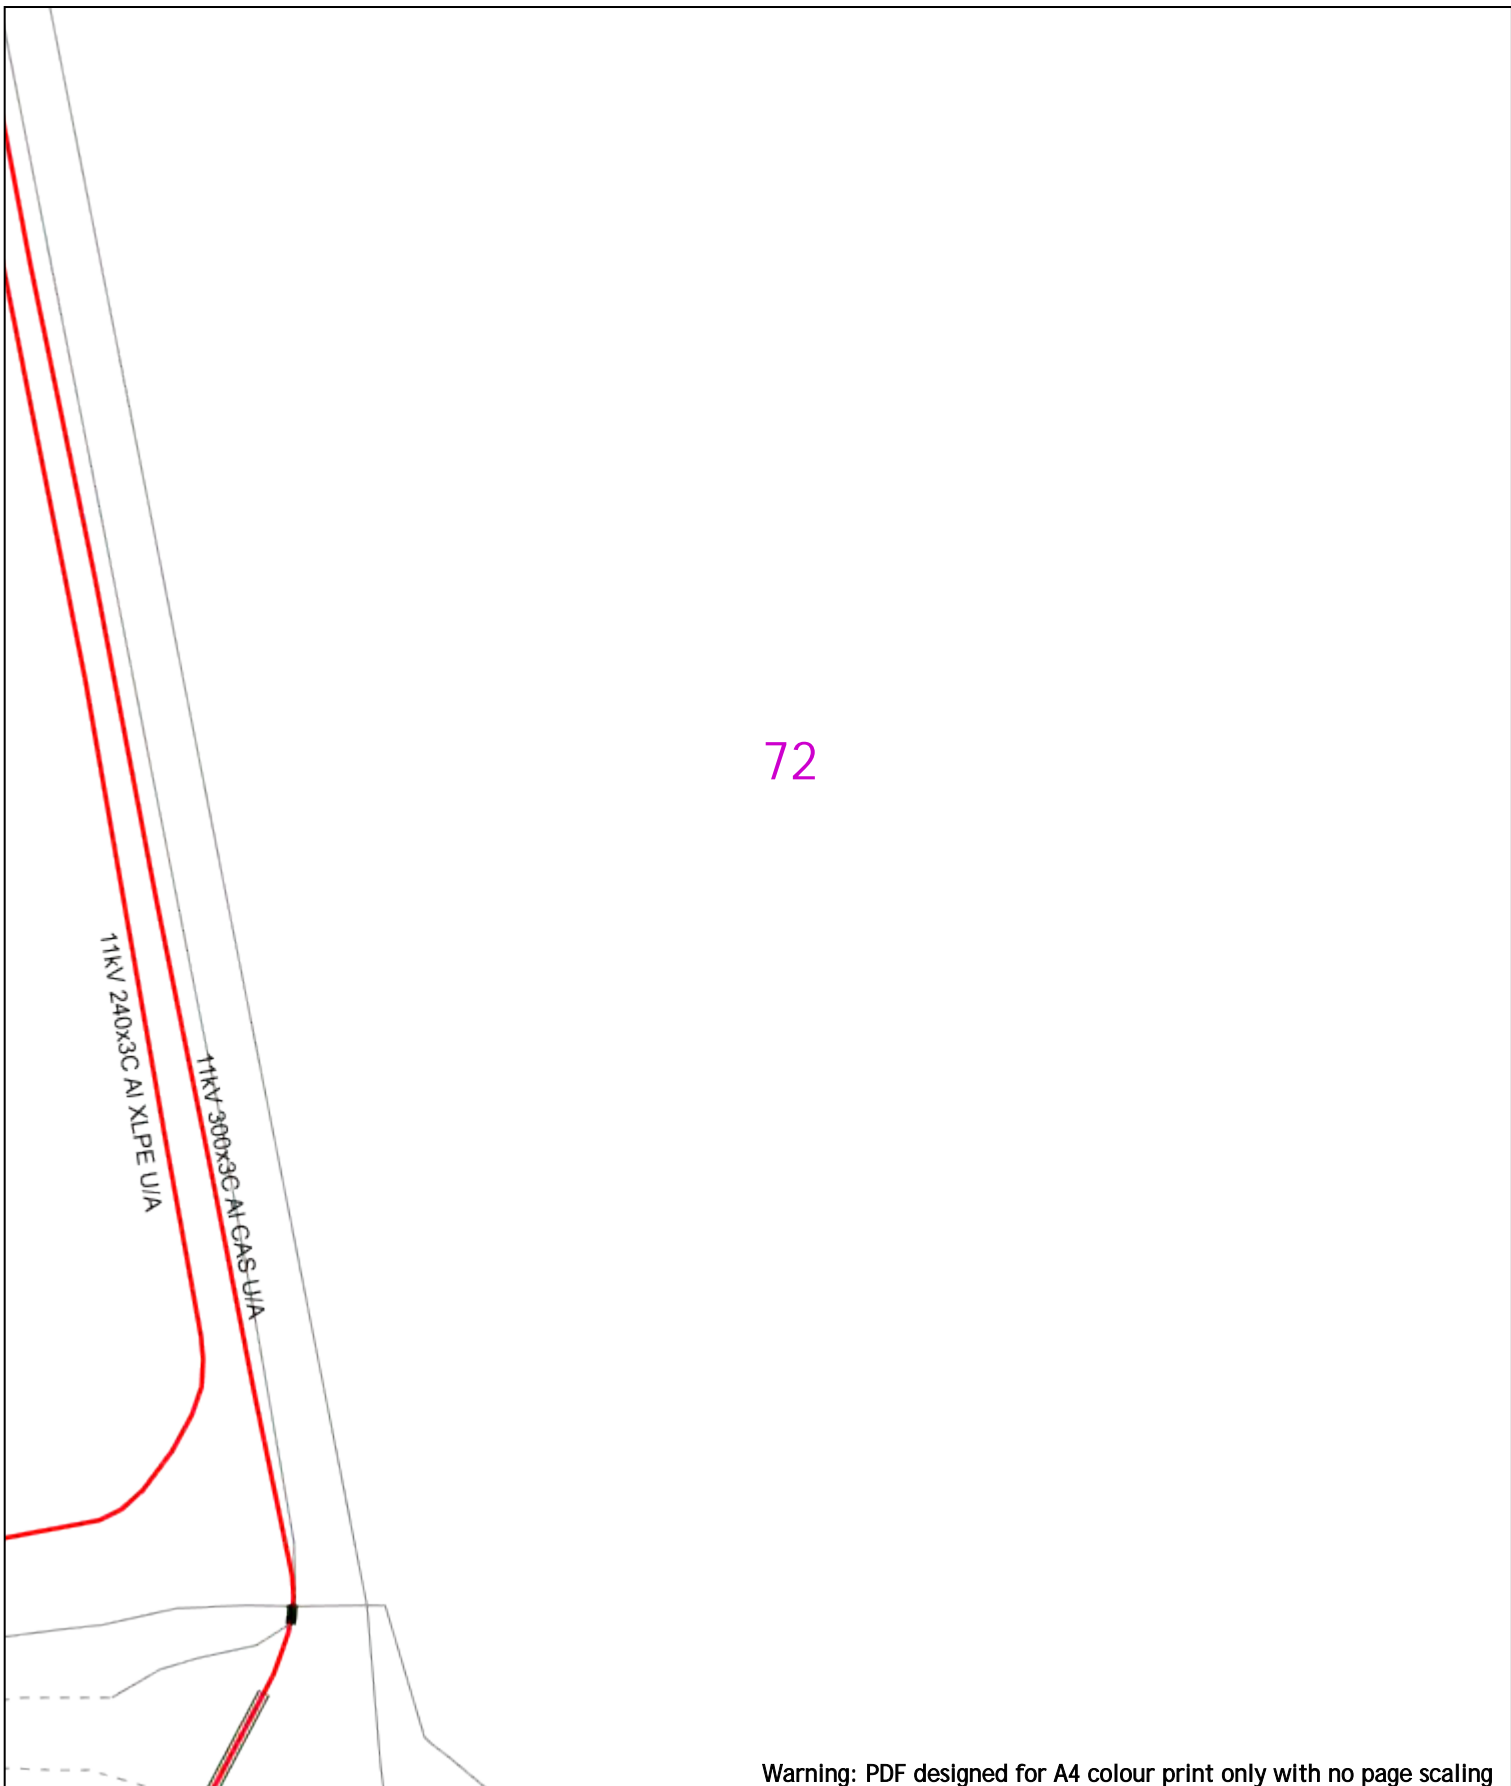

Warning: PDF designed for A4 colour print only with no page scaling



20m Dig Sites Area: Line:

Extra High Voltage cables in vicinity



Date Requested: 24/06/2022
 Job Reference: 25881010
 Site Location: 448066 213346
 Requested by: Mr Joe Shawyer
 Your Scheme/Reference: 31188_002

Voltages (V)			
LV (Low Voltage) and Services	Up to 1,000V		
HV (High Voltage)	Over 1,000V to 11,000V		
EHV (Extra High Voltage)	22,000V to 132,000V		
Transmission	275,000V and 400,000V		
NORMAL DEPTH TO THE TOP OF THE CABLE WHEN LAID			
Services	LV	HV	EHV
Footpath/Unmade	0.45m	0.45m	0.6m 0.8m
Road Crossing	0.6m	0.6m	0.75m 0.9m
Agricultural	1m	1m	1m 1.1m

Legend	
	Service Cable
	LV Mains
	2 - 11kV
	66kV
	11kV
	22kV
	33kV
	66kV
	132kV
	275kV
	400kV
	Fibre Optic
	Pilot Cable

Distribution Structures (Electric)	
	Pole, Existing Location
	Pole Structure, Existing Location - Single
	Pole Structure, Existing Location - H
	Duct Route
	Cross Section Route

Southern Electric Power Distribution plc
 Registered Office: No.1 Forbury Place
 43 Forbury Road Reading RG1 3JH
 Registered In England & Wales No.04094290

If you're unsure & need to seek advice before commencing excavations, please contact:
 General Enquiries: 0800 048 3516

Scale: 1:500 (When plotted at A4)

WARNING
 There may have been subsequent alteration to the surface levels. Trial holes must be undertaken to determine position and depths of cables. HS (G) 47 Booklet from the Health and Safety Executive - Avoiding Danger from Buried Cables - should be consulted before commencing excavation work.
WHEN WORKING IN THE VICINITY OF OVERHEAD LINES THE HEALTH AND SAFETY GUIDANCE NOTES G56 SHOULD BE CONSULTED (AVAILABLE FROM THE HSE WEBSITE)

Subject to revision - Master held by SSEN Asset Data Team:
Asset.Data@sse.com
 01256 337 294

73

61.7m

Warning: PDF designed for A4 colour print only with no page scaling

0 20m

Dig Sites

Area:

Line:

Line:

**Extra High Voltage
cables in vicinity**



Date Requested: 24/06/2022
Job Reference: 25881010
Site Location: 448066 213346
Requested by: Mr Joe Shawyer

Your Scheme/Reference: 31188_002

Voltages (V)				
LV (Low Voltage) and Services	Up to 1,000V			
HV (High Voltage)	Over 1,000V to 11,000V			
EHV (Extra High Voltage)	22,000V to 132,000V			
Transmission	275,000V and 400,000V			
NORMAL DEPTH TO THE TOP OF THE CABLE WHEN LAID				
Services	LV	HV	EHV	
Footpath/Unmade	0.45m	0.45m	0.6m	0.8m
Road Crossing	0.6m	0.6m	0.75m	0.9m
Agricultural	1m	1m	1m	1.1m

Legend	
	Service Cable
	LV Mains
	2 - 11kV
	66kV
	11kV
	22kV
	33kV
	66kV
	132kV
	275kV
	400kV
	Fibre Optic
	Pipe Cable

Distribution Structures (Electric)	
	Pole, Existing Location
	Pole Structure, Existing Location - Single
	Pole Structure, Existing Location - H
	Duct Route
	Cross Section Route

WARNING

There may have been subsequent alteration to the surface levels. Trial holes must be undertaken to determine position and depths of cables. HS (G) 47 Booklet from the Health and Safety Executive - Avoiding Danger from Buried Cables - should be consulted before commencing excavation work.


WHEN WORKING IN THE VICINITY OF OVERHEAD LINES THE HEALTH AND SAFETY GUIDANCE NOTES G56 SHOULD BE CONSULTED (AVAILABLE FROM THE HSE WEBSITE)

Southern Electric Power Distribution plc
Registered Office: No.1 Forbury Place
43 Forbury Road Reading RG1 3JH
Registered In England & Wales No.04094290

If you're unsure & need to seek advice before commencing excavations, please contact:
General Enquiries: 0800 048 3516

Subject to revision - Master held by SSEN Asset Data Team:
Asset.Data@sse.com
01256 337 294

Scale: 1:500 (When plotted at A4)

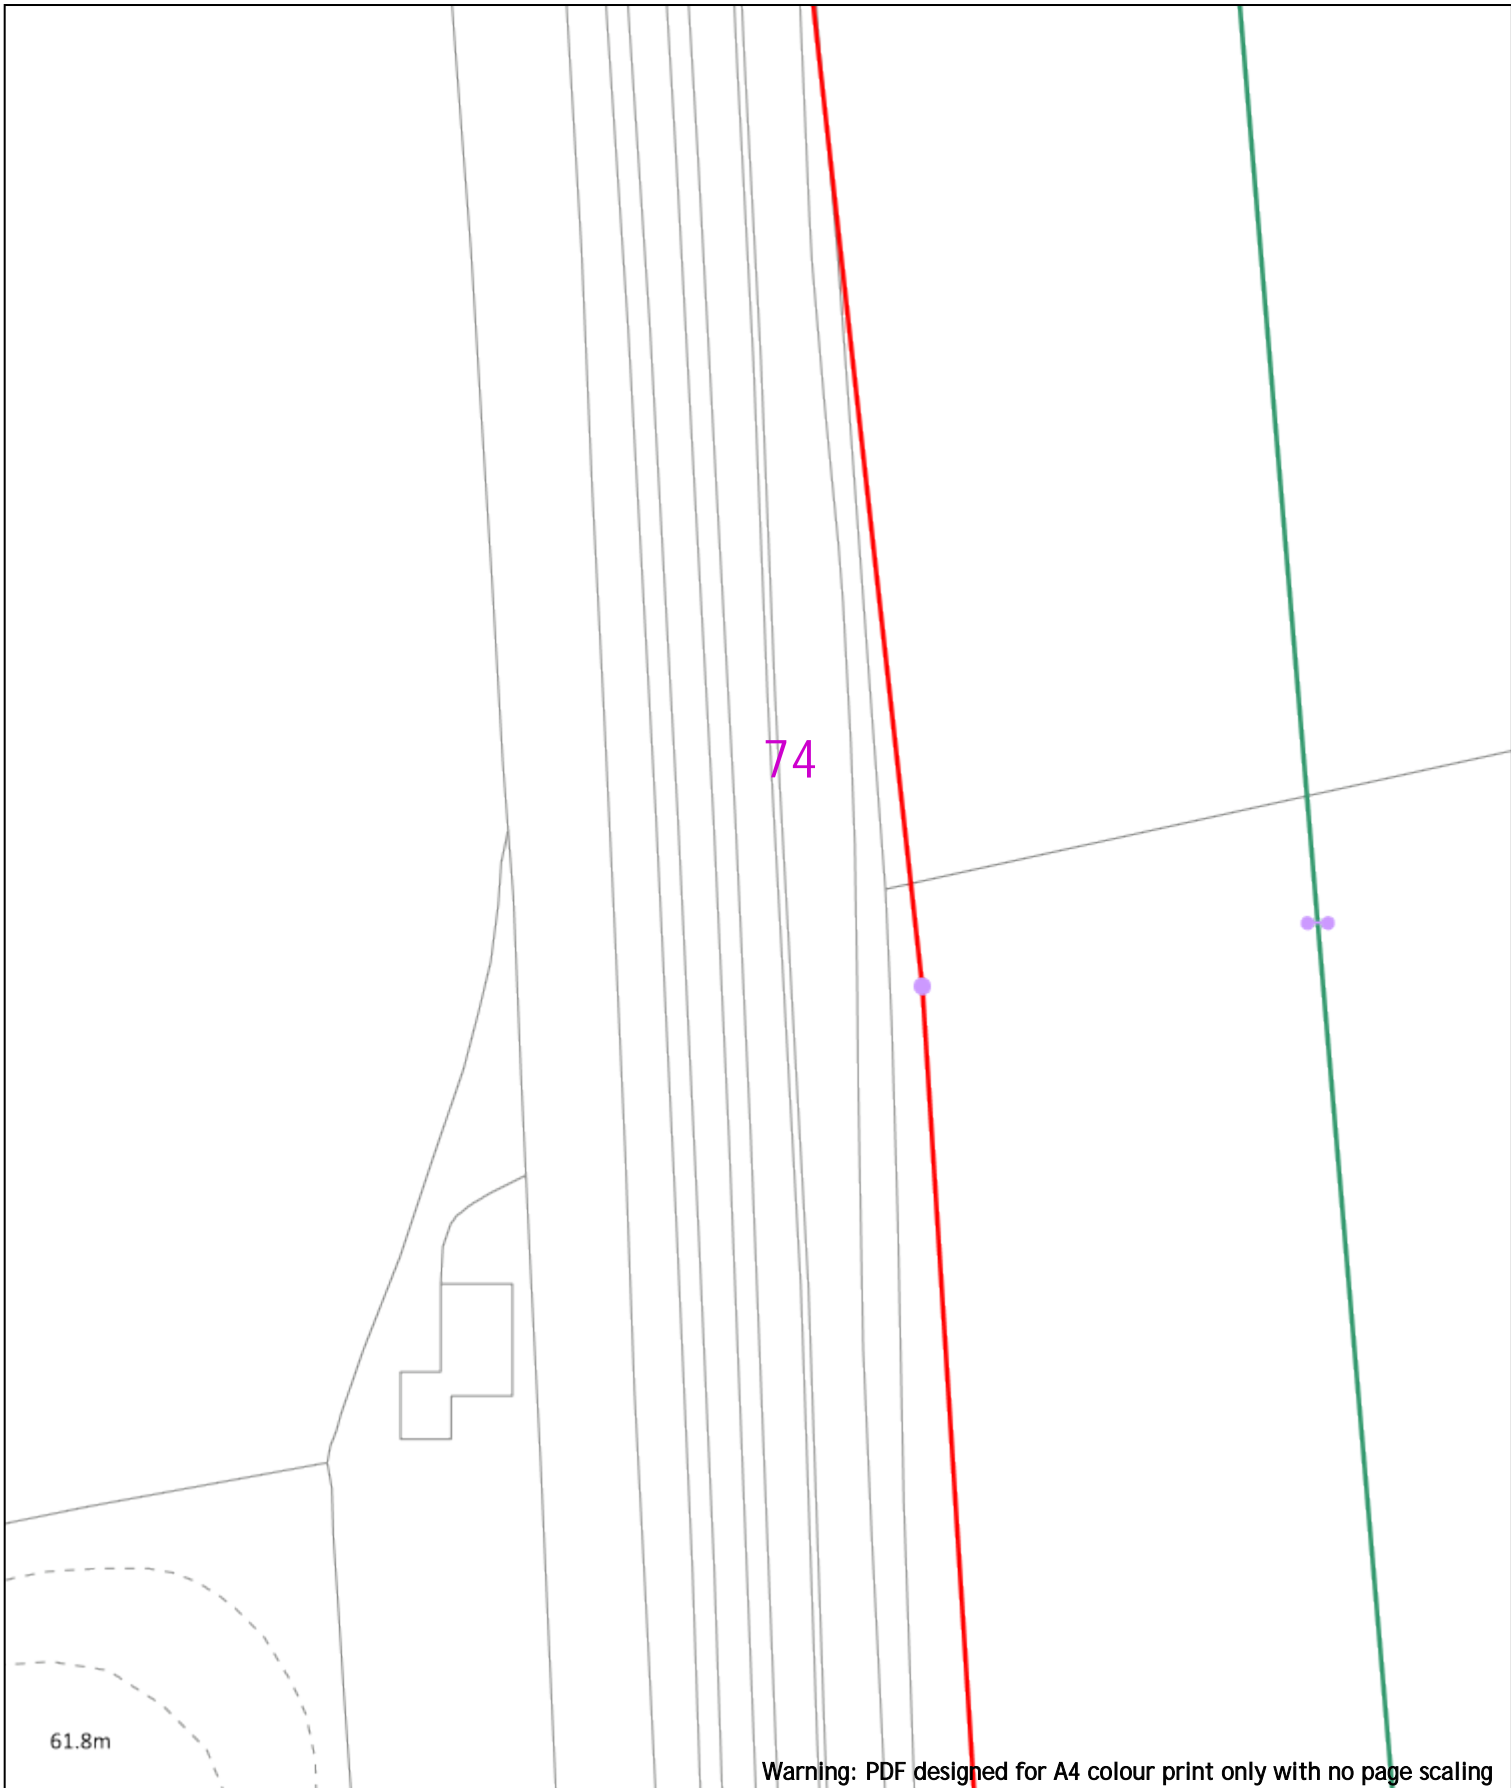

0 20m Dig Sites Area: Line: **Extra High Voltage cables in vicinity**

Date Requested: 24/06/2022
 Job Reference: 25881010
 Site Location: 448066 213346
 Requested by: Mr Joe Shawyer
 Your Scheme/Reference: 31188_002

Voltages (V)			
LV (Low Voltage) and Services	Up to 1,000V		
HV (High Voltage)	Over 1,000V to 11,000V		
EHV (Extra High Voltage)	22,000V to 132,000V		
Transmission	275,000V and 400,000V		
NORMAL DEPTH TO THE TOP OF THE CABLE WHEN LAID			
Services	LV	HV	EHV
Footpath/Unmade	0.45m	0.45m	0.6m
Road Crossing	0.6m	0.6m	0.75m
Agricultural	1m	1m	1.1m

Legend	
	Service Cable
	LV Mains
	2 - 11kV
	66kV
	275kV
	400kV
	Fibre Optic
	Pilot Cable

Distribution Structures (Electric)	
	Pole, Existing Location
	Pole Structure, Existing Location - Single
	Pole Structure, Existing Location - H
	Duct Route
	Cross Section Route

Southern Electric Power Distribution plc
 Registered Office: No.1 Forbury Place
 43 Forbury Road Reading RG1 3JH
 Registered In England & Wales No.04094290

If you're unsure & need to seek advice before commencing excavations, please contact:
 General Enquiries: 0800 048 3516

Subject to revision – Master held by SSEN Asset Data Team:
Asset.Data@sse.com
 01256 337 294

Drain

75

Warning: PDF designed for A4 colour print only with no page scaling

0  20m

Dig Sites

Area:



Line:



**Extra High Voltage
cables in vicinity**



Date Requested: 24/06/2022
Job Reference: 25881010
Site Location: 448066 213346
Requested by: Mr Joe Shawyer

Your Scheme/Reference: 31188_002

Voltages (V)			
LV (Low Voltage) and Services	Up to 1,000V		
HV (High Voltage)	Over 1,000V to 11,000V		
EHV (Extra High Voltage)	22,000V to 132,000V		
Transmission	275,000V and 400,000V		
NORMAL DEPTH TO THE TOP OF THE CABLE WHEN LAID			
Services	LV	HV	EHV
Footpath/Unmade	0.45m	0.45m	0.6m 0.8m
Road Crossing	0.6m	0.6m	0.75m 0.9m
Agricultural	1m	1m	1m 1.1m

Legend	
	Service Cable
	LV Mains
	2 - 11kV
	66kV
	11kV
	22kV
	33kV
	66kV
	132kV
	275kV
	400kV
	Fibre Optic
	Pipe Cable

Distribution Structures (Electric)	
	Pole, Existing Location
	Pole Structure, Existing Location - Single
	Pole Structure, Existing Location - H
	Duct Route
	Cross Section Route

Southern Electric Power Distribution plc
Registered Office: No.1 Forbury Place
43 Forbury Road Reading RG1 3JH
Registered In England & Wales No.04094290

If you're unsure & need to seek advice before commencing excavations, please contact:
General Enquiries: 0800 048 3516

Subject to revision - Master held by SSEN Asset Data Team:
Asset.Data@sse.com
01256 337 294

Scale: 1:500 (When plotted at A4)

WARNING
There may have been subsequent alteration to the surface levels. Trial holes must be undertaken to determine position and depths of cables. HS (G) 47 Booklet from the Health and Safety Executive - Avoiding Danger from Buried Cables - should be consulted before commencing excavation work.
WHEN WORKING IN THE VICINITY OF OVERHEAD LINES THE HEALTH AND SAFETY GUIDANCE NOTES G56 SHOULD BE CONSULTED (AVAILABLE FROM THE HSE WEBSITE)

76

Warning: PDF designed for A4 colour print only with no page scaling

0  20m Dig Sites Area:  Line: 

**Extra High Voltage
cables in vicinity**



Date Requested: 24/06/2022
Job Reference: 25881010
Site Location: 448066 213346
Requested by: Mr Joe Shawyer

Your Scheme/Reference: 31188_002

Voltages (V)			
LV (Low Voltage) and Services	Up to 1,000V		
HV (High Voltage)	Over 1,000V to 11,000V		
EHV (Extra High Voltage)	22,000V to 132,000V		
Transmission	275,000V and 400,000V		
NORMAL DEPTH TO THE TOP OF THE CABLE WHEN LAID			
Services	LV	HV	EHV
Footpath/Unmade	0.45m	0.45m	0.6m 0.8m
Road Crossing	0.6m	0.6m	0.75m 0.9m
Agricultural	1m	1m	1m 1.1m

Legend		Distribution Structures (Electric)	
	Service Cable		Pole, Existing Location
	LV Mains		Pole Structure, Existing Location - Single
	2 - 11kV		Pole Structure, Existing Location - H
	66kV		Duct Route
	11kV		Cross Section Route
	22kV		
	33kV		
	66kV		
	132kV		
	275kV		
	400kV		
	Fibre Optic		
	Pipe Cable		


WARNING
There may have been subsequent alteration to the surface levels. Trial holes must be undertaken to determine position and depths of cables. HS (G) 47 Booklet from the Health and Safety Executive - Avoiding Danger from Buried Cables - should be consulted before commencing excavation work.
WHEN WORKING IN THE VICINITY OF OVERHEAD LINES THE HEALTH AND SAFETY GUIDANCE NOTES G56 SHOULD BE CONSULTED (AVAILABLE FROM THE HSE WEBSITE)

Scale: 1:500 (When plotted at A4)

Southern Electric Power Distribution plc
Registered Office: No.1 Forbury Place
43 Forbury Road Reading RG1 3JH
Registered In England & Wales No.04094290

If you're unsure & need to seek advice before commencing excavations, please contact:
General Enquiries: 0800 048 3516


Subject to revision - Master held by SSEN Asset Data Team:
Asset.Data@sse.com
01256 337 294

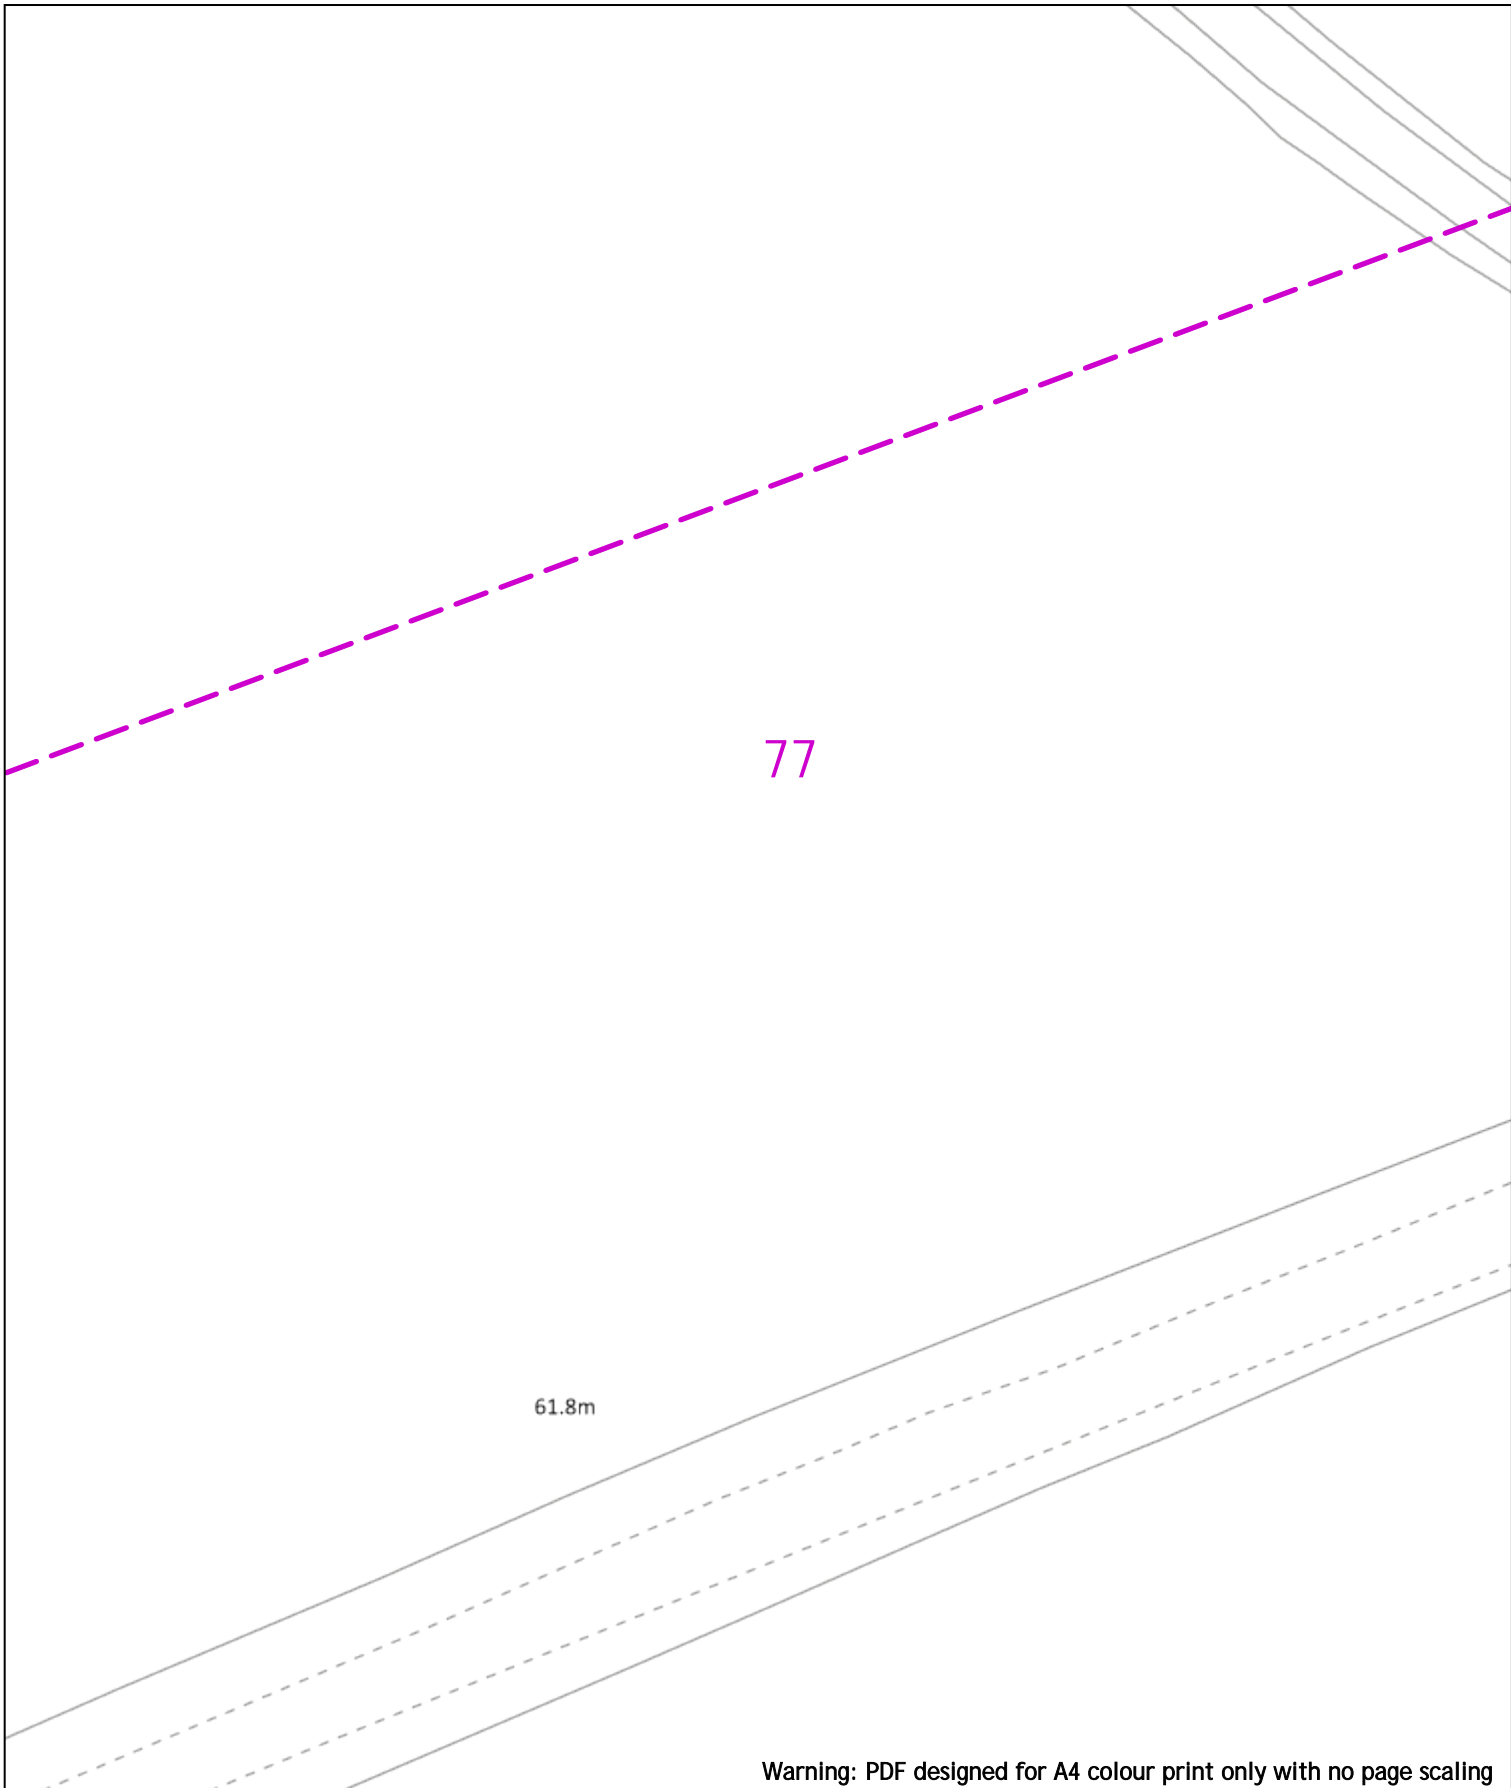

Warning: PDF designed for A4 colour print only with no page scaling


<p>0 20m Dig Sites Area: Line: Extra High Voltage cables in vicinity</p>	
<p>Date Requested: 24/06/2022 Job Reference: 25881010 Site Location: 448066 213346 Requested by: Mr Joe Shawyer Your Scheme/Reference: 31188_002</p>	<table border="1"> <thead> <tr> <th colspan="4">Voltages (V)</th> </tr> </thead> <tbody> <tr> <td>LV (Low Voltage) and Services</td> <td colspan="3">Up to 1,000V</td> </tr> <tr> <td>HV (High Voltage)</td> <td colspan="3">Over 1,000V to 11,000V</td> </tr> <tr> <td>EHV (Extra High Voltage)</td> <td colspan="3">22,000V to 132,000V</td> </tr> <tr> <td>Transmission</td> <td colspan="3">275,000V and 400,000V</td> </tr> </tbody> </table> <table border="1"> <thead> <tr> <th colspan="4">NORMAL DEPTH TO THE TOP OF THE CABLE WHEN LAID</th> </tr> <tr> <th>Services</th> <th>LV</th> <th>HV</th> <th>EHV</th> </tr> </thead> <tbody> <tr> <td>Footpath/Unmade</td> <td>0.45m</td> <td>0.45m</td> <td>0.6m 0.8m</td> </tr> <tr> <td>Road Crossing</td> <td>0.6m</td> <td>0.6m</td> <td>0.75m 0.9m</td> </tr> <tr> <td>Agricultural</td> <td>1m</td> <td>1m</td> <td>1m 1.1m</td> </tr> </tbody> </table> <p>WARNING There may have been subsequent alteration to the surface levels. Trial holes must be undertaken to determine position and depths of cables. HS (G) 47 Booklet from the Health and Safety Executive – Avoiding Danger from Buried Cables – should be consulted before commencing excavation work. WHEN WORKING IN THE VICINITY OF OVERHEAD LINES THE HEALTH AND SAFETY GUIDANCE NOTES G56 SHOULD BE CONSULTED (AVAILABLE FROM THE HSE WEBSITE)</p>	Voltages (V)				LV (Low Voltage) and Services	Up to 1,000V			HV (High Voltage)	Over 1,000V to 11,000V			EHV (Extra High Voltage)	22,000V to 132,000V			Transmission	275,000V and 400,000V			NORMAL DEPTH TO THE TOP OF THE CABLE WHEN LAID				Services	LV	HV	EHV	Footpath/Unmade	0.45m	0.45m	0.6m 0.8m	Road Crossing	0.6m	0.6m	0.75m 0.9m	Agricultural	1m	1m	1m 1.1m	<table border="1"> <thead> <tr> <th colspan="2">Legend</th> </tr> </thead> <tbody> <tr> <td></td> <td>Service Cable</td> </tr> <tr> <td></td> <td>LV Mains</td> </tr> <tr> <td></td> <td>2 – 11kV</td> </tr> <tr> <td></td> <td>66kV</td> </tr> <tr> <td></td> <td>11kV</td> </tr> <tr> <td></td> <td>22kV</td> </tr> <tr> <td></td> <td>33kV</td> </tr> <tr> <td></td> <td>66kV</td> </tr> <tr> <td></td> <td>132kV</td> </tr> <tr> <td></td> <td>275kV</td> </tr> <tr> <td></td> <td>400kV</td> </tr> <tr> <td></td> <td>Fibre Optic</td> </tr> <tr> <td></td> <td>Pilot Cable</td> </tr> </tbody> </table> <table border="1"> <thead> <tr> <th colspan="2">Distribution Structures (Electric)</th> </tr> </thead> <tbody> <tr> <td></td> <td>Pole, Existing Location</td> </tr> <tr> <td></td> <td>Pole Structure, Existing Location – Single</td> </tr> <tr> <td></td> <td>Pole Structure, Existing Location – H</td> </tr> <tr> <td></td> <td>Duct Route</td> </tr> <tr> <td></td> <td>Cross Section Route</td> </tr> </tbody> </table>	Legend			Service Cable		LV Mains		2 – 11kV		66kV		11kV		22kV		33kV		66kV		132kV		275kV		400kV		Fibre Optic		Pilot Cable	Distribution Structures (Electric)			Pole, Existing Location		Pole Structure, Existing Location – Single		Pole Structure, Existing Location – H		Duct Route		Cross Section Route
Voltages (V)	
LV (Low Voltage) and Services	Up to 1,000V	
HV (High Voltage)	Over 1,000V to 11,000V	
EHV (Extra High Voltage)	22,000V to 132,000V	
Transmission	275,000V and 400,000V	
NORMAL DEPTH TO THE TOP OF THE CABLE WHEN LAID	
Services	LV	HV	EHV	
Footpath/Unmade	0.45m	0.45m	0.6m 0.8m	
Road Crossing	0.6m	0.6m	0.75m 0.9m	
Agricultural	1m	1m	1m 1.1m	
Legend	
	Service Cable	
	LV Mains	
	2 – 11kV	
	66kV	
	11kV	
	22kV	
	33kV	
	66kV	
	132kV	
	275kV	
	400kV	
	Fibre Optic	
	Pilot Cable	
Distribution Structures (Electric)	
	Pole, Existing Location	
	Pole Structure, Existing Location – Single	
	Pole Structure, Existing Location – H	
	Duct Route	
	Cross Section Route	
<p>Scale: 1:500 (When plotted at A4)</p>		<p>Southern Electric Power Distribution plc Registered Office: No.1 Forbury Place 43 Forbury Road Reading RG1 3JH Registered In England & Wales No.04094290</p> <p>If you're unsure & need to seek advice before commencing excavations, please contact: General Enquiries: 0800 048 3516</p> <p>Subject to revision – Master held by SSEN Asset Data Team: Asset.Data@sse.com 01256 337 294</p>	

BASED UPON THE ORDNANCE SURVEY MAP WITH THE SANCTION OF THE CONTROLLER OF HM STATIONERY OFFICE CROWN COPYRIGHT RESERVED.
 This copy has been made by or with the authority of Scottish and Southern Energy Power Distribution Ltd. Pursuant to section 47 of the Copyright, Designs and Patents Act 1988 ("The Act"). Unless the Act provides a relevant exception to copyright the copy must not be copied without prior permission of the copyright owner.
 Plans generated by DigSAFE Pro™ software provided by LinesearchbeforeUdig.

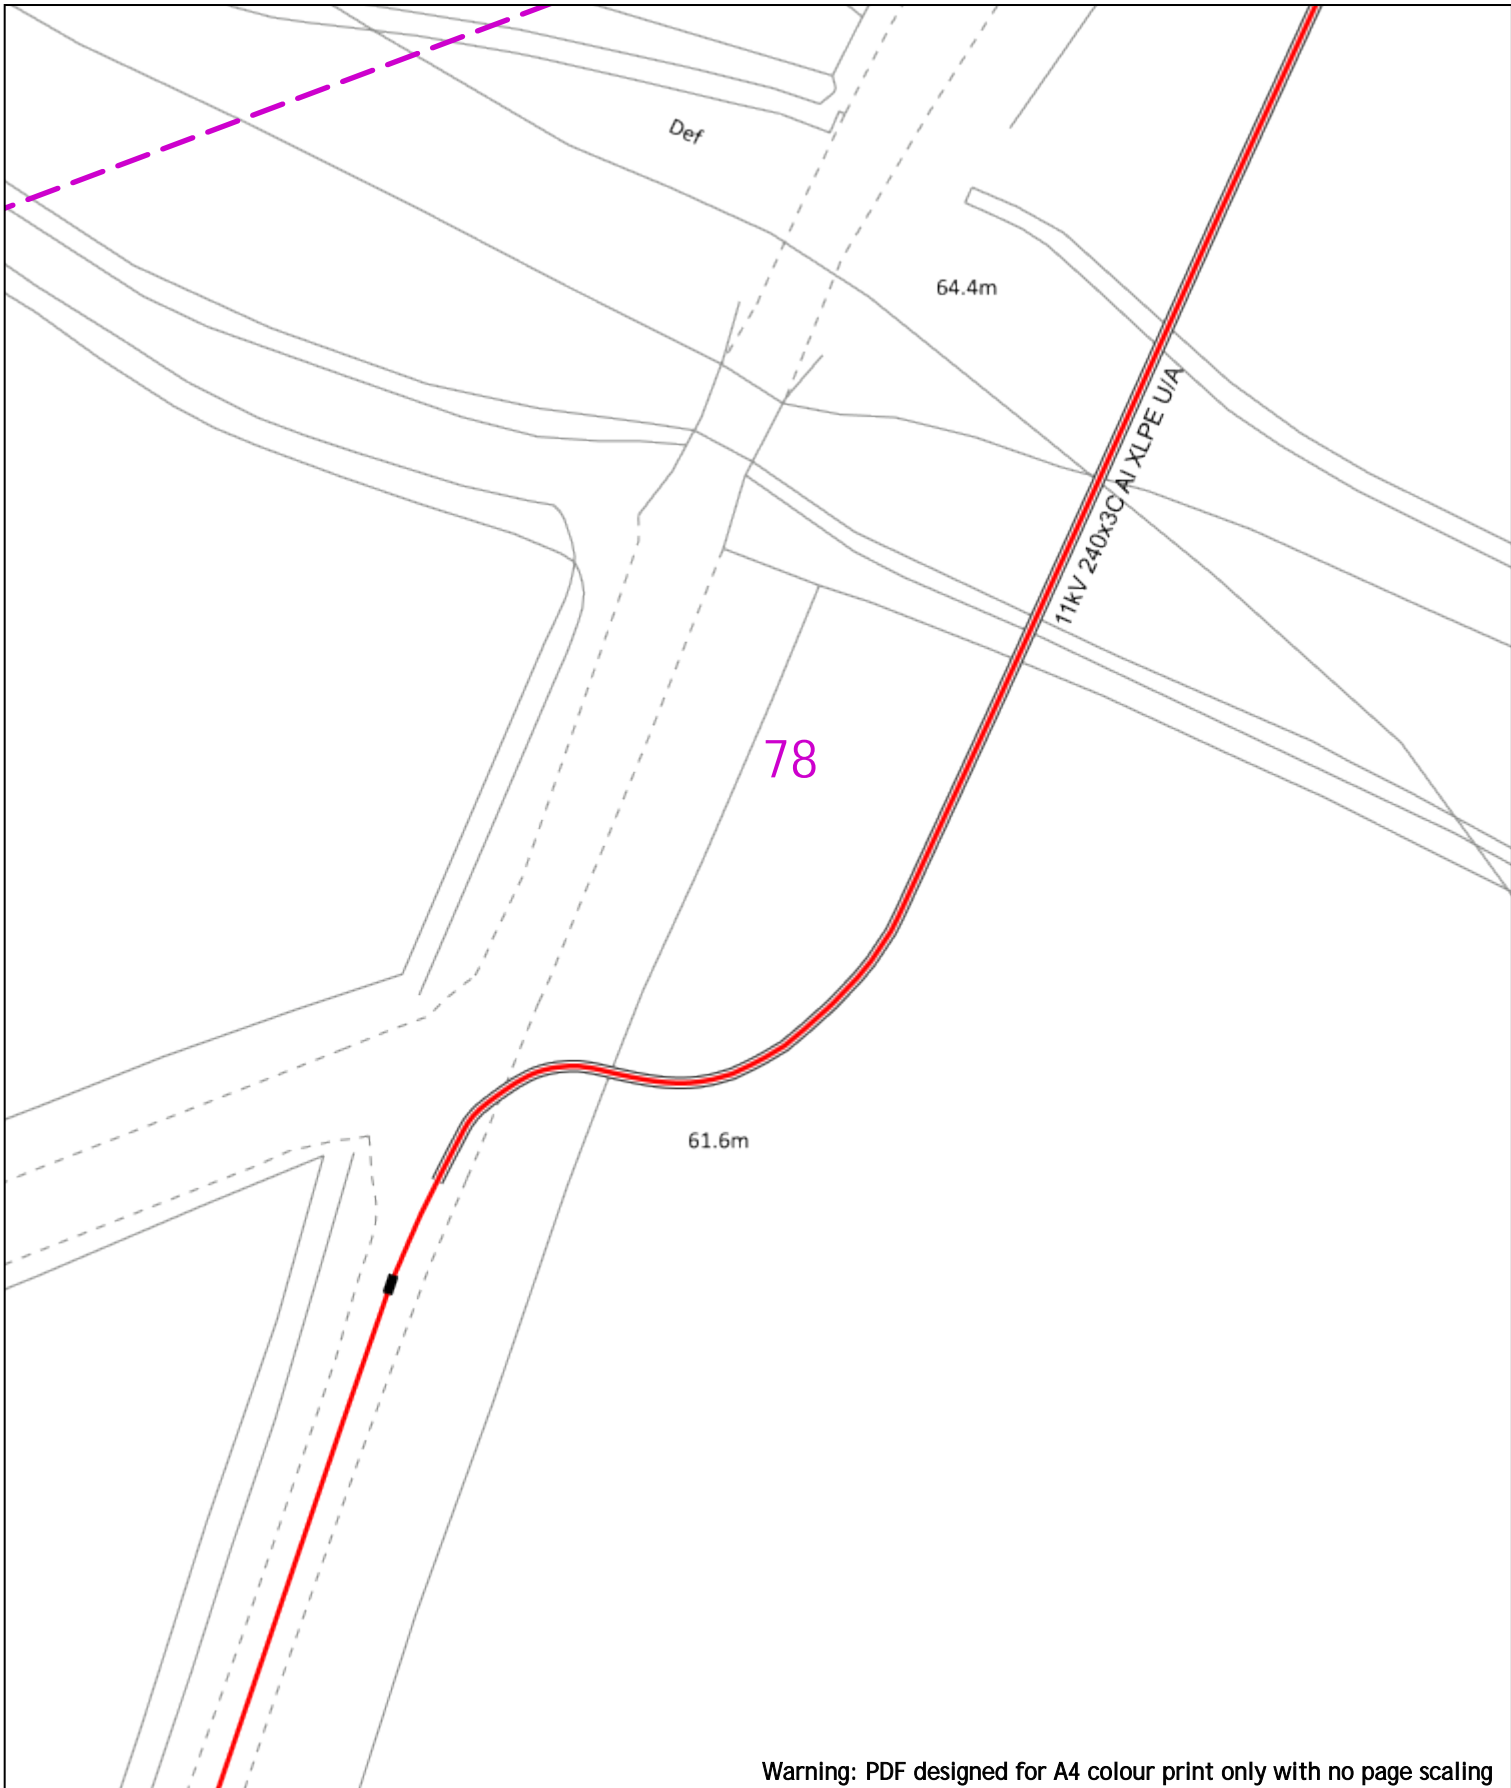

Warning: PDF designed for A4 colour print only with no page scaling

<p>0 20m</p>	<p>Dig Sites Area: Line: </p>	<p>Extra High Voltage cables in vicinity</p>																																	
<p>Date Requested: 24/06/2022 Job Reference: 25881010 Site Location: 448066 213346 Requested by: Mr Joe Shawyer Your Scheme/Reference: 31188_002</p>	<p>Voltages (V)</p> <table border="1"> <tr> <td>LV (Low Voltage) and Services</td> <td colspan="3">Up to 1,000V</td> </tr> <tr> <td>HV (High Voltage)</td> <td colspan="3">Over 1,000V to 11,000V</td> </tr> <tr> <td>EHV (Extra High Voltage)</td> <td colspan="3">22,000V to 132,000V</td> </tr> <tr> <td>Transmission</td> <td colspan="3">275,000V and 400,000V</td> </tr> </table> <p>NORMAL DEPTH TO THE TOP OF THE CABLE WHEN LAID</p> <table border="1"> <thead> <tr> <th>Services</th> <th>LV</th> <th>HV</th> <th>EHV</th> </tr> </thead> <tbody> <tr> <td>Footpath/Unmade</td> <td>0.45m</td> <td>0.45m</td> <td>0.6m</td> </tr> <tr> <td>Road Crossing</td> <td>0.6m</td> <td>0.6m</td> <td>0.75m</td> </tr> <tr> <td>Agricultural</td> <td>1m</td> <td>1m</td> <td>1.1m</td> </tr> </tbody> </table>	LV (Low Voltage) and Services	Up to 1,000V			HV (High Voltage)	Over 1,000V to 11,000V			EHV (Extra High Voltage)	22,000V to 132,000V			Transmission	275,000V and 400,000V			Services	LV	HV	EHV	Footpath/Unmade	0.45m	0.45m	0.6m	Road Crossing	0.6m	0.6m	0.75m	Agricultural	1m	1m	1.1m	<p>Legend</p> <ul style="list-style-type: none"> Service Cable LV Mains 2 - 11kV 6.6kV 11kV 22kV 33kV 66kV 132kV 275kV 400kV Fibre Optic Pipit Cable <p>Distribution Structures (Electric)</p> <ul style="list-style-type: none"> Pole, Existing Location Pole Structure, Existing Location - Single Pole Structure, Existing Location - H Duct Route Cross Section Route 	<p style="text-align: center;">Southern Electric Power Distribution plc Registered Office: No.1 Forbury Place 43 Forbury Road Reading RG1 3JH Registered In England & Wales No.04094290</p> <p>If you're unsure & need to seek advice before commencing excavations, please contact: General Enquiries: 0800 048 3516</p> <p>Subject to revision – Master held by SSEN Asset Data Team: Asset.Data@sse.com 01256 337 294</p>
LV (Low Voltage) and Services	Up to 1,000V																																		
HV (High Voltage)	Over 1,000V to 11,000V																																		
EHV (Extra High Voltage)	22,000V to 132,000V																																		
Transmission	275,000V and 400,000V																																		
Services	LV	HV	EHV																																
Footpath/Unmade	0.45m	0.45m	0.6m																																
Road Crossing	0.6m	0.6m	0.75m																																
Agricultural	1m	1m	1.1m																																
<p style="font-size: small;">Scale: 1:500 (When plotted at A4)</p> <p style="font-size: x-small; text-align: center;"> BASED UPON THE ORDNANCE SURVEY MAP WITH THE SANCTION OF THE CONTROLLER OF HM STATIONERY OFFICE CROWN COPYRIGHT RESERVED. This copy has been made by or with the authority of Scottish and Southern Energy Power Distribution Ltd. Pursuant to section 47 of the Copyright, Designs and Patents Act 1988 ("The Act"). Unless the Act provides a relevant exception to copyright the copy must not be copied without prior permission of the copyright owner. Plans generated by DigSAFE Pro™ software provided by Linesearchbeforedig. </p>																																			

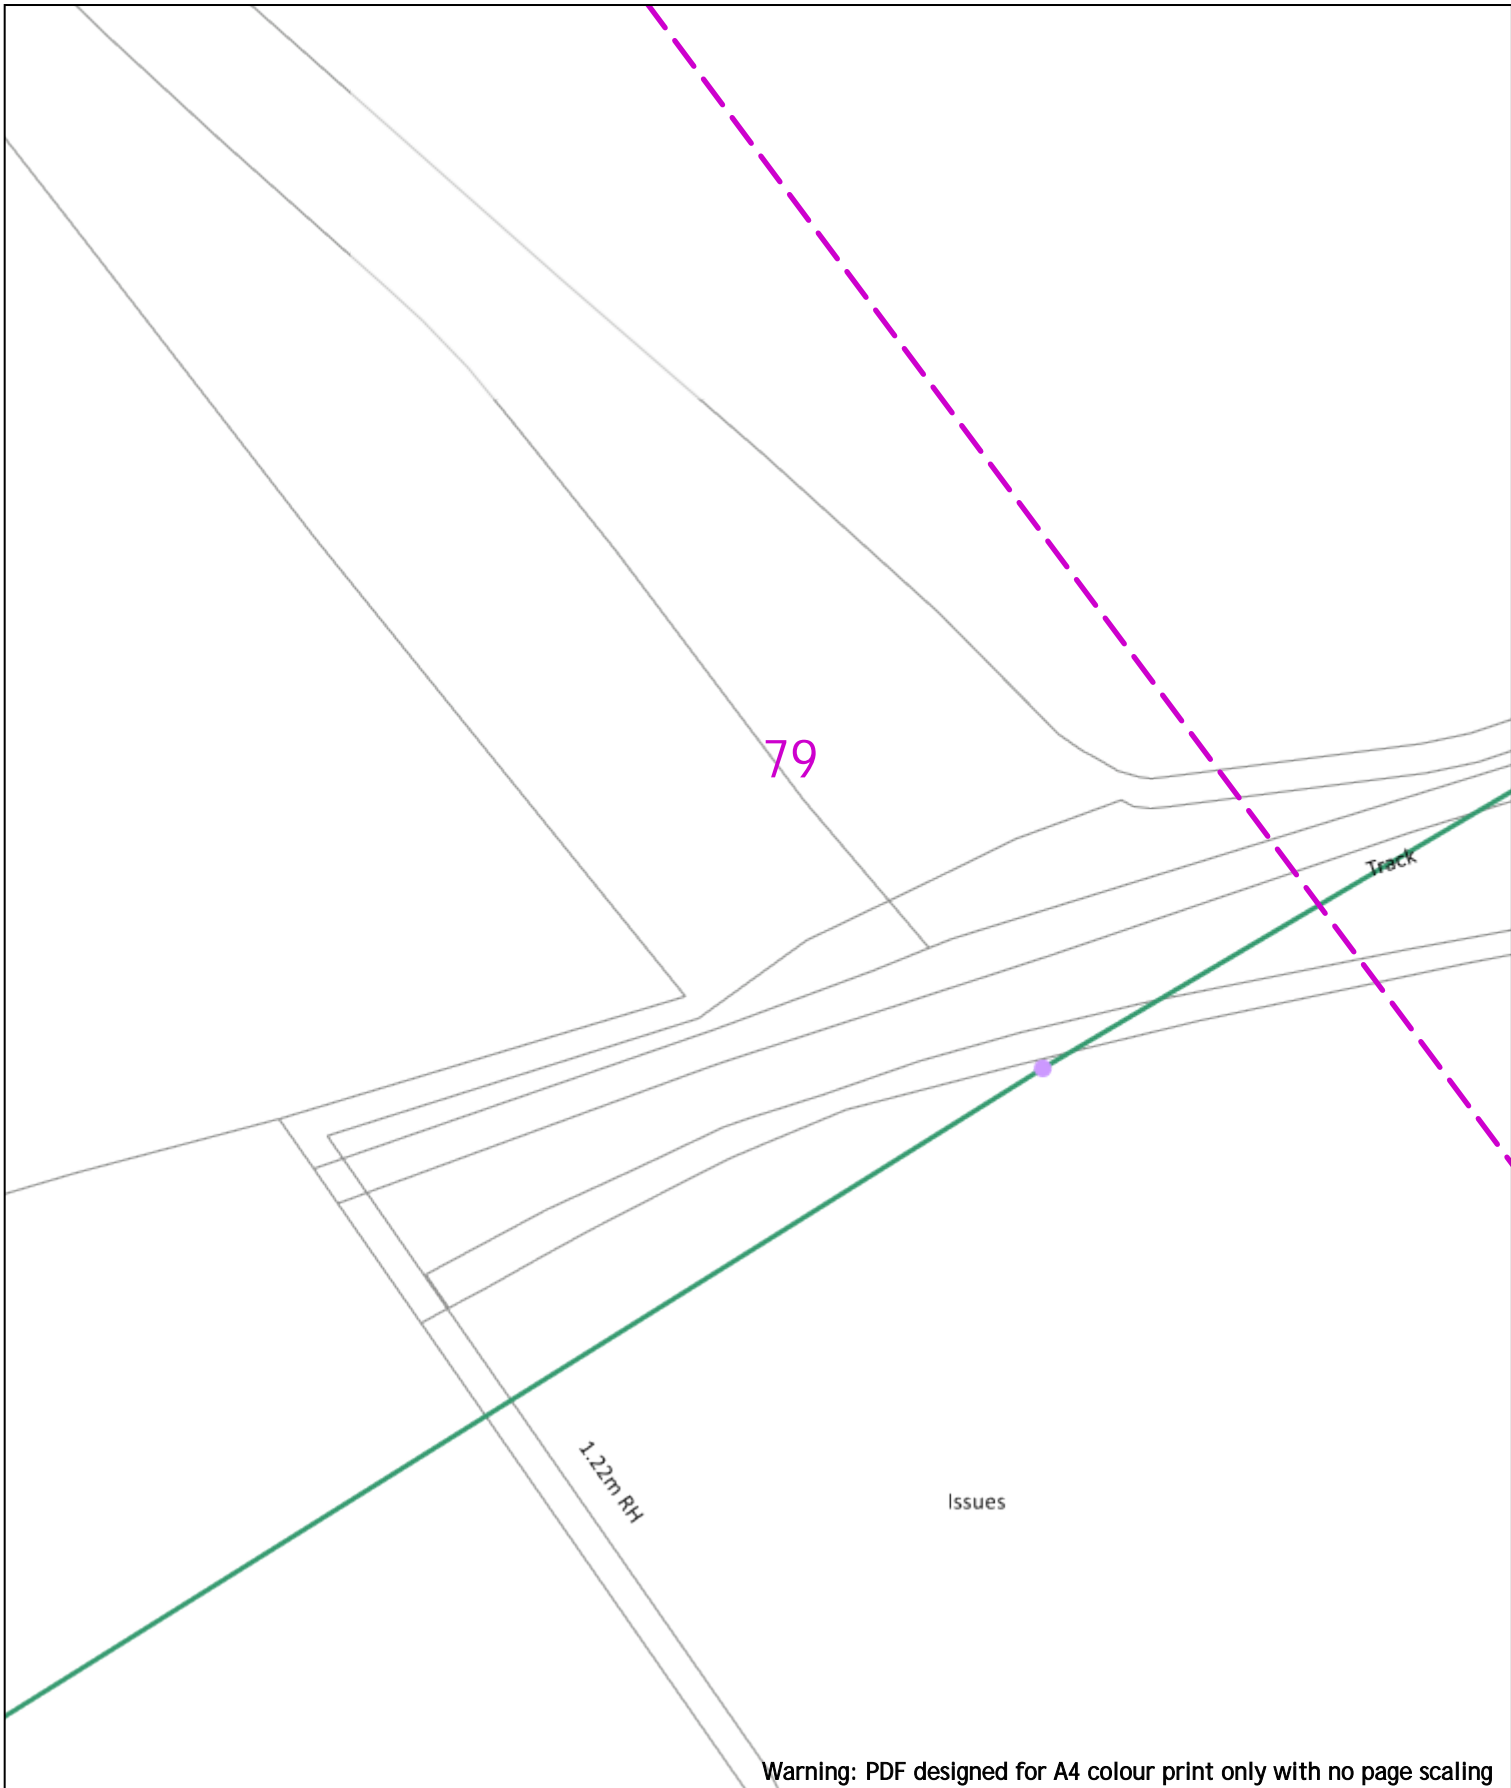

Warning: PDF designed for A4 colour print only with no page scaling

20m Dig Sites Area: Line: Extra High Voltage cables in vicinity

Date Requested: 24/06/2022
 Job Reference: 25881010
 Site Location: 448066 213346
 Requested by: Mr Joe Shawyer
 Your Scheme/Reference: 31188_002

Voltages (V)				
LV (Low Voltage) and Services	Up to 1,000V			
HV (High Voltage)	Over 1,000V to 11,000V			
EHV (Extra High Voltage)	22,000V to 132,000V			
Transmission	275,000V and 400,000V			
NORMAL DEPTH TO THE TOP OF THE CABLE WHEN LAID				
Services	LV	HV	EHV	

Legend		Distribution Structures (Electric)	
	Service Cable		Pole, Existing Location
	LV Mains		Pole Structure, Existing Location - Single
	66kV		Pole Structure, Existing Location - H
	11kV		Duct Route
	22kV		Cross Section Route
	33kV		
	66kV		
	132kV		
	275kV		
	400kV		
	Fibre Optic		
	Pipe Cable		

WARNING
 There may have been subsequent alteration to the surface levels. Trial holes must be undertaken to determine position and depths of cables. HS (G) 47 Booklet from the Health and Safety Executive - Avoiding Danger from Buried Cables - should be consulted before commencing excavation work.
WHEN WORKING IN THE VICINITY OF OVERHEAD LINES THE HEALTH AND SAFETY GUIDANCE NOTES G56 SHOULD BE CONSULTED (AVAILABLE FROM THE HSE WEBSITE)

Scale: 1:500 (When plotted at A4)

Southern Electric Power Distribution plc
 Registered Office: No.1 Forbury Place
 43 Forbury Road Reading RG1 3JH
 Registered In England & Wales No.04094290

If you're unsure & need to seek advice before commencing excavations, please contact:
 General Enquiries: 0800 048 3516

Subject to revision - Master held by SSEN Asset Data Team:
Asset.Data@sse.com
 01256 337 294



1.22m RH

80

Warning: PDF designed for A4 colour print only with no page scaling



20m Dig Sites Area: [Dashed Purple Box] Line: [Dashed Purple Line]

Extra High Voltage cables in vicinity



Date Requested: 24/06/2022
 Job Reference: 25881010
 Site Location: 448066 213346
 Requested by: Mr Joe Shawyer
 Your Scheme/Reference: 31188_002

Voltages (V)				
LV (Low Voltage) and Services	Up to 1,000V			
HV (High Voltage)	Over 1,000V to 11,000V			
EHV (Extra High Voltage)	22,000V to 132,000V			
Transmission	275,000V and 400,000V			
NORMAL DEPTH TO THE TOP OF THE CABLE WHEN LAID				
Services	LV	HV	EHV	

Legend	
[Yellow Line]	Service Cable
[Orange Line]	LV Mains
[Red Line]	2 - 11kV
[Green Line]	66kV
[Blue Line]	11kV
[Light Blue Line]	22kV
[Dark Blue Line]	33kV
[Purple Line]	66kV
[Light Purple Line]	132kV
[Dark Purple Line]	275kV
[Black Line]	400kV
[Red Line]	Fibre Optic
[Blue Line]	Pipe Cable

Distribution Structures (Electric)	
[Purple Circle]	Pole, Existing Location
[Purple Square]	Pole Structure, Existing Location - Single
[Purple Rectangle]	Pole Structure, Existing Location - RH
[Blue Line]	Duct Route
[Red Line]	Cross Section Route


Southern Electric Power Distribution plc
 Registered Office: No.1 Forbury Place
 43 Forbury Road Reading RG1 3JH
 Registered In England & Wales No.04094290

If you're unsure & need to seek advice before commencing excavations, please contact:
 General Enquiries: 0800 048 3516

Scale: 1:500 (When plotted at A4)

WARNING
 There may have been subsequent alteration to the surface levels. Trial holes must be undertaken to determine position and depths of cables. HS (G) 47 Booklet from the Health and Safety Executive - Avoiding Danger from Buried Cables - should be consulted before commencing excavation work.
WHEN WORKING IN THE VICINITY OF OVERHEAD LINES THE HEALTH AND SAFETY GUIDANCE NOTES G56 SHOULD BE CONSULTED (AVAILABLE FROM THE HSE WEBSITE)

Subject to revision - Master held by SSEN Asset Data Team:
Asset.Data@sse.com
 01256 337 294

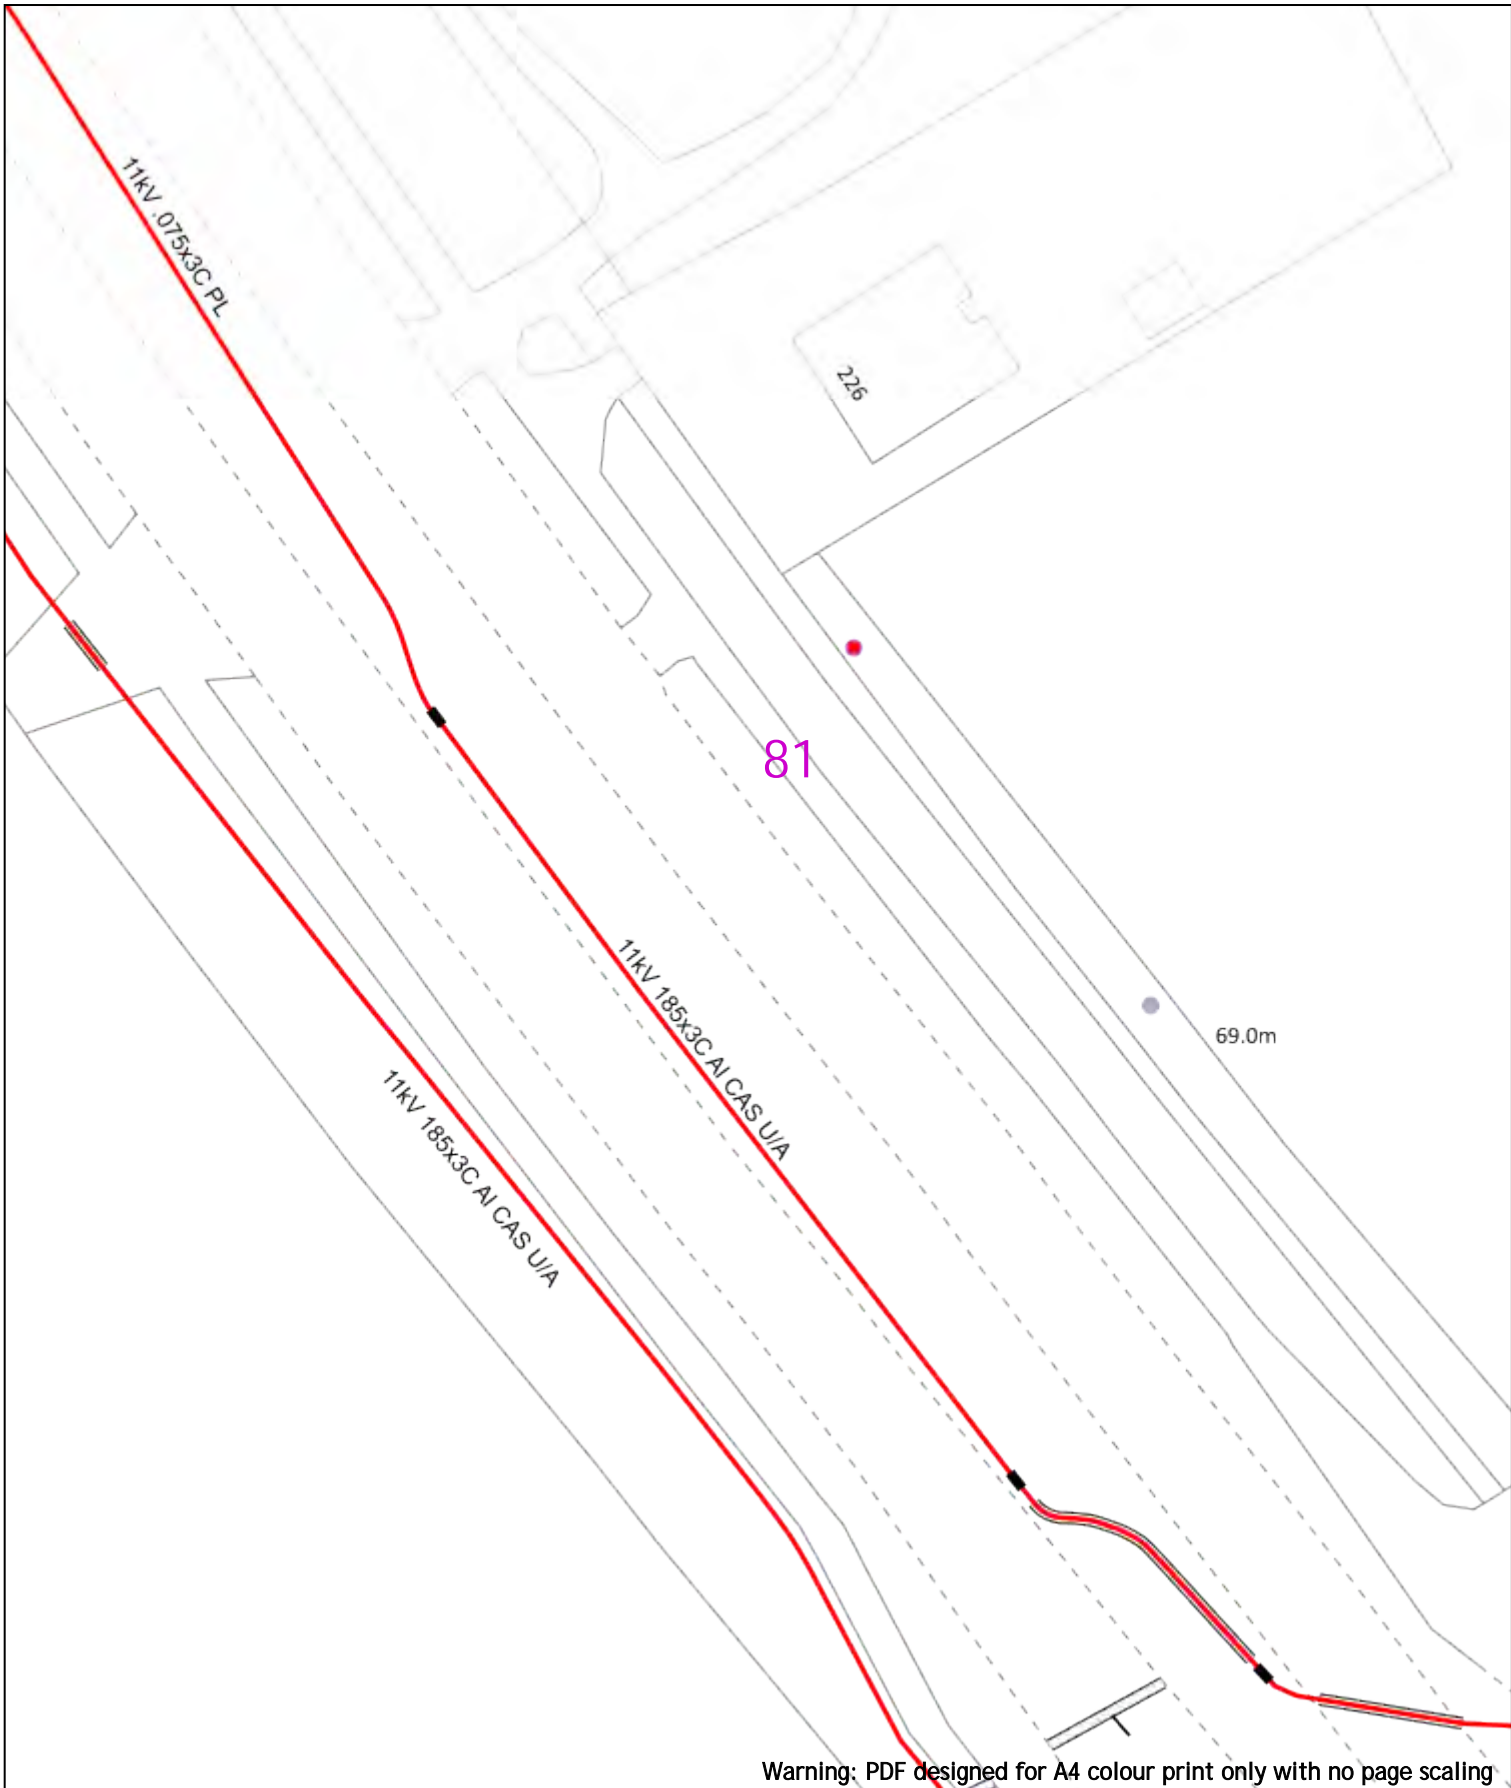

Warning: PDF designed for A4 colour print only with no page scaling

		Dig Sites: Area: Line:	Extra High Voltage cables in vicinity	
Date Requested: 24/06/2022 Job Reference: 25881010 Site Location: 448066 213346 Requested by: Mr Joe Shawyer Your Scheme/Reference: 31188_002		<table border="1"> <thead> <tr> <th colspan="4">Voltages (V)</th> </tr> <tr> <th>Services</th> <th>LV</th> <th>HV</th> <th>EHV</th> </tr> </thead> <tbody> <tr> <td>LV (Low Voltage) and Services</td> <td>Up to 1,000V</td> <td></td> <td></td> </tr> <tr> <td>HV (High Voltage)</td> <td>Over 1,000V to 11,000V</td> <td></td> <td></td> </tr> <tr> <td>EHV (Extra High Voltage)</td> <td>22,000V to 132,000V</td> <td></td> <td></td> </tr> <tr> <td>Transmission</td> <td>275,000V and 400,000V</td> <td></td> <td></td> </tr> </tbody> </table> <p>NORMAL DEPTH TO THE TOP OF THE CABLE WHEN LAID</p> <table border="1"> <thead> <tr> <th>Services</th> <th>LV</th> <th>HV</th> <th>EHV</th> </tr> </thead> <tbody> <tr> <td>Footpath/Unmade</td> <td>0.45m</td> <td>0.45m</td> <td>0.6m</td> </tr> <tr> <td>Road Crossing</td> <td>0.6m</td> <td>0.6m</td> <td>0.75m</td> </tr> <tr> <td>Agricultural</td> <td>1m</td> <td>1m</td> <td>1.1m</td> </tr> </tbody> </table>	Voltages (V)				Services	LV	HV	EHV	LV (Low Voltage) and Services	Up to 1,000V			HV (High Voltage)	Over 1,000V to 11,000V			EHV (Extra High Voltage)	22,000V to 132,000V			Transmission	275,000V and 400,000V			Services	LV	HV	EHV	Footpath/Unmade	0.45m	0.45m	0.6m	Road Crossing	0.6m	0.6m	0.75m	Agricultural	1m	1m	1.1m	<table border="1"> <thead> <tr> <th colspan="2">Legend</th> </tr> </thead> <tbody> <tr><td></td><td>Service Cable</td></tr> <tr><td></td><td>LV Mains</td></tr> <tr><td></td><td>7 - 11kV</td></tr> <tr><td></td><td>66kV</td></tr> <tr><td></td><td>11kV</td></tr> <tr><td></td><td>22kV</td></tr> <tr><td></td><td>33kV</td></tr> <tr><td></td><td>66kV</td></tr> <tr><td></td><td>132kV</td></tr> <tr><td></td><td>275kV</td></tr> <tr><td></td><td>400kV</td></tr> <tr><td></td><td>Fibre Optic</td></tr> <tr><td></td><td>Pilot Cable</td></tr> </tbody> </table> <table border="1"> <thead> <tr> <th colspan="2">Distribution Structures (Electric)</th> </tr> </thead> <tbody> <tr><td></td><td>Pole, Existing Location</td></tr> <tr><td></td><td>Pole Structure, Existing Location - Single</td></tr> <tr><td></td><td>Pole Structure, Existing Location - H</td></tr> <tr><td></td><td>Duct Route</td></tr> <tr><td></td><td>Cross Section Route</td></tr> </tbody> </table>	Legend			Service Cable		LV Mains		7 - 11kV		66kV		11kV		22kV		33kV		66kV		132kV		275kV		400kV		Fibre Optic		Pilot Cable	Distribution Structures (Electric)			Pole, Existing Location		Pole Structure, Existing Location - Single		Pole Structure, Existing Location - H		Duct Route		Cross Section Route	<p style="text-align: center;">Southern Electric Power Distribution plc Registered Office: No.1 Forbury Place 43 Forbury Road Reading RG1 3JH Registered In England & Wales No.04094290</p> <p>If you're unsure & need to seek advice before commencing excavations, please contact: General Enquiries: 0800 048 3516</p> <p>Subject to revision – Master held by SSEN Asset Data Team: Asset.Data@sse.com 01256 337 294</p>
Voltages (V)	
Services	LV	HV	EHV	
LV (Low Voltage) and Services	Up to 1,000V	
HV (High Voltage)	Over 1,000V to 11,000V	
EHV (Extra High Voltage)	22,000V to 132,000V	
Transmission	275,000V and 400,000V	
Services	LV	HV	EHV	
Footpath/Unmade	0.45m	0.45m	0.6m	
Road Crossing	0.6m	0.6m	0.75m	
Agricultural	1m	1m	1.1m	
Legend	
	Service Cable	
	LV Mains	
	7 - 11kV	
	66kV	
	11kV	
	22kV	
	33kV	
	66kV	
	132kV	
	275kV	
	400kV	
	Fibre Optic	
	Pilot Cable	
Distribution Structures (Electric)	
	Pole, Existing Location	
	Pole Structure, Existing Location - Single	
	Pole Structure, Existing Location - H	
	Duct Route	
	Cross Section Route	
Scale: 1:500 (When plotted at A4)		<p style="text-align: center;">WARNING</p> <p>There may have been subsequent alteration to the surface levels. Trial holes must be undertaken to determine position and depths of cables. HS (G) 47 Booklet from the Health and Safety Executive – Avoiding Danger from Buried Cables – should be consulted before commencing excavation work.</p> <p style="text-align: center;">WHEN WORKING IN THE VICINITY OF OVERHEAD LINES THE HEALTH AND SAFETY GUIDANCE NOTES G56 SHOULD BE CONSULTED (AVAILABLE FROM THE HSE WEBSITE)</p>	
<p style="text-align: center;"><small>BASED UPON THE ORDNANCE SURVEY MAP WITH THE SANCTION OF THE CONTROLLER OF HM STATIONERY OFFICE CROWN COPYRIGHT RESERVED. This copy has been made by or with the authority of Scottish and Southern Energy Power Distribution Ltd. Pursuant to section 47 of the Copyright, Designs and Patents Act 1988 ("The Act"). Unless the Act provides a relevant exception to copyright the copy must not be copied without prior permission of the copyright owner. Plans generated by DigSAFE Pro™ software provided by LinesearchbeforeDigs.</small></p>	



Warning: PDF designed for A4 colour print only with no page scaling



20m Dig Sites Area: Line:

Extra High Voltage cables in vicinity



Date Requested: 24/06/2022
 Job Reference: 25881010
 Site Location: 448066 213346
 Requested by: Mr Joe Shawyer
 Your Scheme/Reference: 31188_002

Voltages (V)			
LV (Low Voltage) and Services	Up to 1,000V		
HV (High Voltage)	Over 1,000V to 11,000V		
EHV (Extra High Voltage)	22,000V to 132,000V		
Transmission	275,000V and 400,000V		
NORMAL DEPTH TO THE TOP OF THE CABLE WHEN LAID			
Services	LV	HV	EHV

Legend	
	Service Cable
	LV Mains
	2 - 11kV
	66kV
	11kV
	22kV
	33kV
	66kV
	132kV
	275kV
	400kV
	Fibre Optic
	Pilot Cable

Distribution Structures (Electric)	
	Pole, Existing Location
	Pole Structure, Existing Location - Single
	Pole Structure, Existing Location - H
	Duct Route
	Cross Section Route


Southern Electric Power Distribution plc
 Registered Office: No.1 Forbury Place
 43 Forbury Road Reading RG1 3JH
 Registered In England & Wales No.04094290

If you're unsure & need to seek advice before commencing excavations, please contact:
 General Enquiries: 0800 048 3516

Subject to revision – Master held by SSEN Asset Data Team:
Asset.Data@sse.com
 01256 337 294


Scale: 1:500 (When plotted at A4)

WARNING
 There may have been subsequent alteration to the surface levels. Trial holes must be undertaken to determine position and depths of cables. HS (G) 47 Booklet from the Health and Safety Executive – Avoiding Danger from Buried Cables – should be consulted before commencing excavation work.
WHEN WORKING IN THE VICINITY OF OVERHEAD LINES THE HEALTH AND SAFETY GUIDANCE NOTES G56 SHOULD BE CONSULTED (AVAILABLE FROM THE HSE WEBSITE)

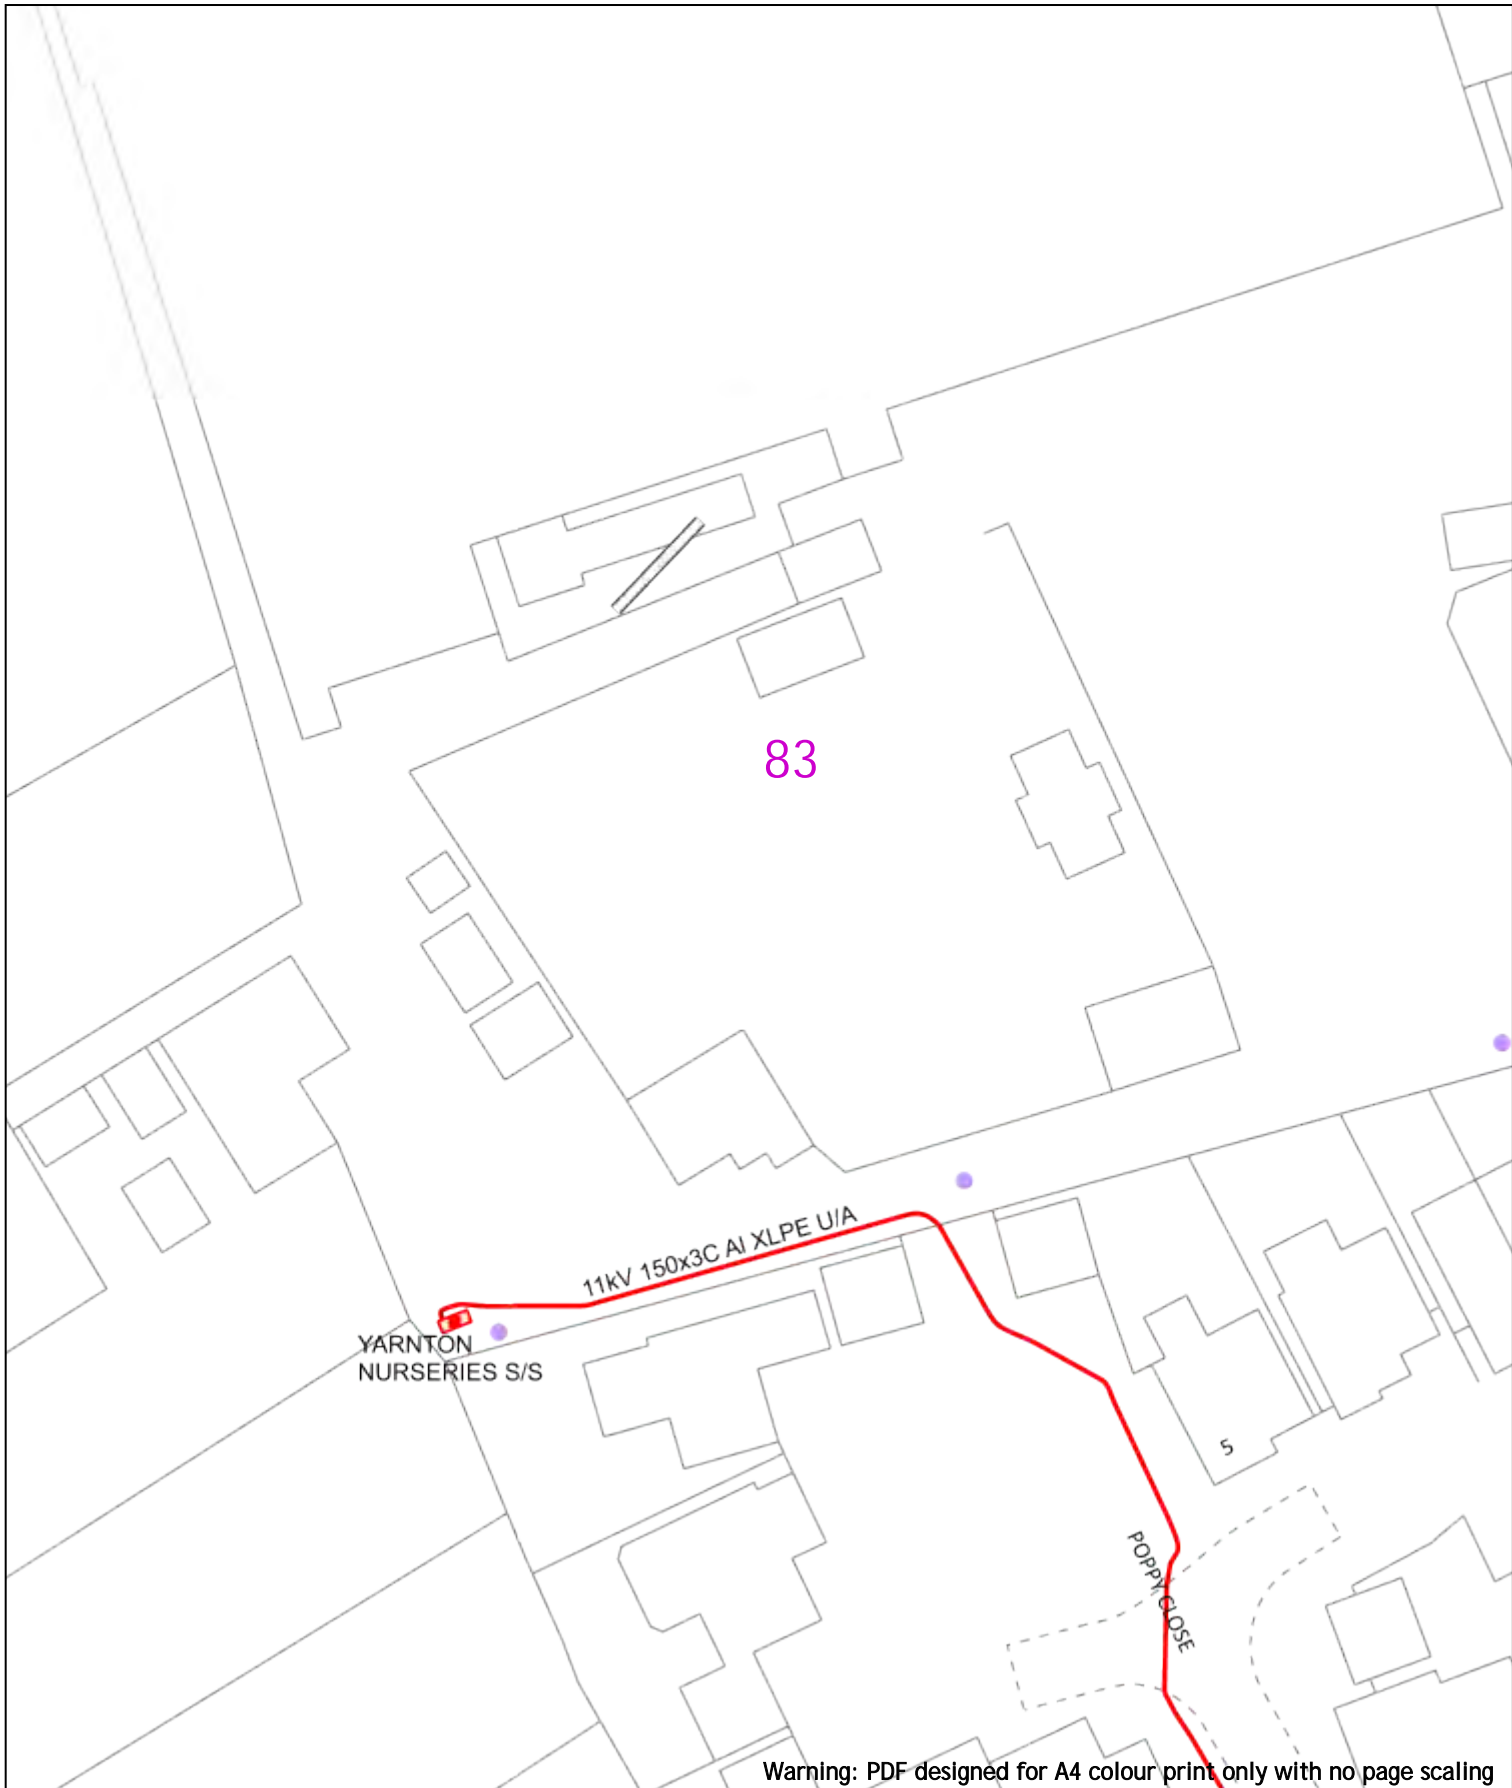

Warning: PDF designed for A4 colour print only with no page scaling


<p>0 20m</p> <p>Date Requested: 24/06/2022 Job Reference: 25881010 Site Location: 448066 213346 Requested by: Mr Joe Shawyer Your Scheme/Reference: 31188_002</p>	<p>Dig Sites: Area: Line: </p> <p style="background-color: red; color: white; text-align: center; padding: 2px;">Extra High Voltage cables in vicinity</p>	<p>Legend</p> <ul style="list-style-type: none"> Service Cable LV Mains 6kV 11kV 22kV 33kV 66kV 132kV 275kV 400kV Fibre Optic Pipit Cable <p>Distribution Structures (Electric)</p> <ul style="list-style-type: none"> Pole, Existing Location Pole Structure, Existing Location - Single Pole Structure, Existing Location - H Duct Route Cross Section Route 	<p> Scottish & Southern Electricity Networks</p> <p style="text-align: center;">Southern Electric Power Distribution plc Registered Office: No.1 Forbury Place 43 Forbury Road Reading RG1 3JH Registered In England & Wales No.04094290</p> <p style="font-size: small;">If you're unsure & need to seek advice before commencing excavations, please contact: General Enquiries: 0800 048 3516</p> <p style="font-size: small;">Subject to revision – Master held by SSEN Asset Data Team: Asset.Data@sse.com 01256 337 294</p>																																
<p>Scale: 1:500 (When plotted at A4)</p>		<p>Voltages (V)</p> <table border="1" style="width: 100%; border-collapse: collapse; font-size: x-small;"> <tr> <td>LV (Low Voltage) and Services</td> <td colspan="3">Up to 1,000V</td> </tr> <tr> <td>HV (High Voltage)</td> <td colspan="3">Over 1,000V to 11,000V</td> </tr> <tr> <td>EHV (Extra High Voltage)</td> <td colspan="3">22,000V to 132,000V</td> </tr> <tr> <td>Transmission</td> <td colspan="3">275,000V and 400,000V</td> </tr> </table> <p>NORMAL DEPTH TO THE TOP OF THE CABLE WHEN LAID</p> <table border="1" style="width: 100%; border-collapse: collapse; font-size: x-small;"> <thead> <tr> <th>Services</th> <th>LV</th> <th>HV</th> <th>EHV</th> </tr> </thead> <tbody> <tr> <td>Footpath/Unmade</td> <td>0.45m</td> <td>0.45m</td> <td>0.6m</td> </tr> <tr> <td>Road Crossing</td> <td>0.6m</td> <td>0.6m</td> <td>0.75m</td> </tr> <tr> <td>Agricultural</td> <td>1m</td> <td>1m</td> <td>1.1m</td> </tr> </tbody> </table> <p style="font-size: x-small; color: red;">WARNING There may have been subsequent alteration to the surface levels. Trial holes must be undertaken to determine position and depths of cables. HS (G) 47 Booklet from the Health and Safety Executive – Avoiding Danger from Buried Cables – should be consulted before commencing excavation work. WHEN WORKING IN THE VICINITY OF OVERHEAD LINES THE HEALTH AND SAFETY GUIDANCE NOTES G56 SHOULD BE CONSULTED (AVAILABLE FROM THE HSE WEBSITE)</p>		LV (Low Voltage) and Services	Up to 1,000V			HV (High Voltage)	Over 1,000V to 11,000V			EHV (Extra High Voltage)	22,000V to 132,000V			Transmission	275,000V and 400,000V			Services	LV	HV	EHV	Footpath/Unmade	0.45m	0.45m	0.6m	Road Crossing	0.6m	0.6m	0.75m	Agricultural	1m	1m	1.1m
LV (Low Voltage) and Services	Up to 1,000V																																		
HV (High Voltage)	Over 1,000V to 11,000V																																		
EHV (Extra High Voltage)	22,000V to 132,000V																																		
Transmission	275,000V and 400,000V																																		
Services	LV	HV	EHV																																
Footpath/Unmade	0.45m	0.45m	0.6m																																
Road Crossing	0.6m	0.6m	0.75m																																
Agricultural	1m	1m	1.1m																																
<p>BASED UPON THE ORDNANCE SURVEY MAP WITH THE SANCTION OF THE CONTROLLER OF HM STATIONERY OFFICE CROWN COPYRIGHT RESERVED. This copy has been made by or with the authority of Scottish and Southern Energy Power Distribution Ltd. Pursuant to section 47 of the Copyright, Designs and Patents Act 1988 ("The Act"). Unless the Act provides a relevant exception to copyright the copy must not be copied without prior permission of the copyright owner. Plans generated by DigSAFE Pro™ software provided by LinesearchbeforeUdig.</p>																																			

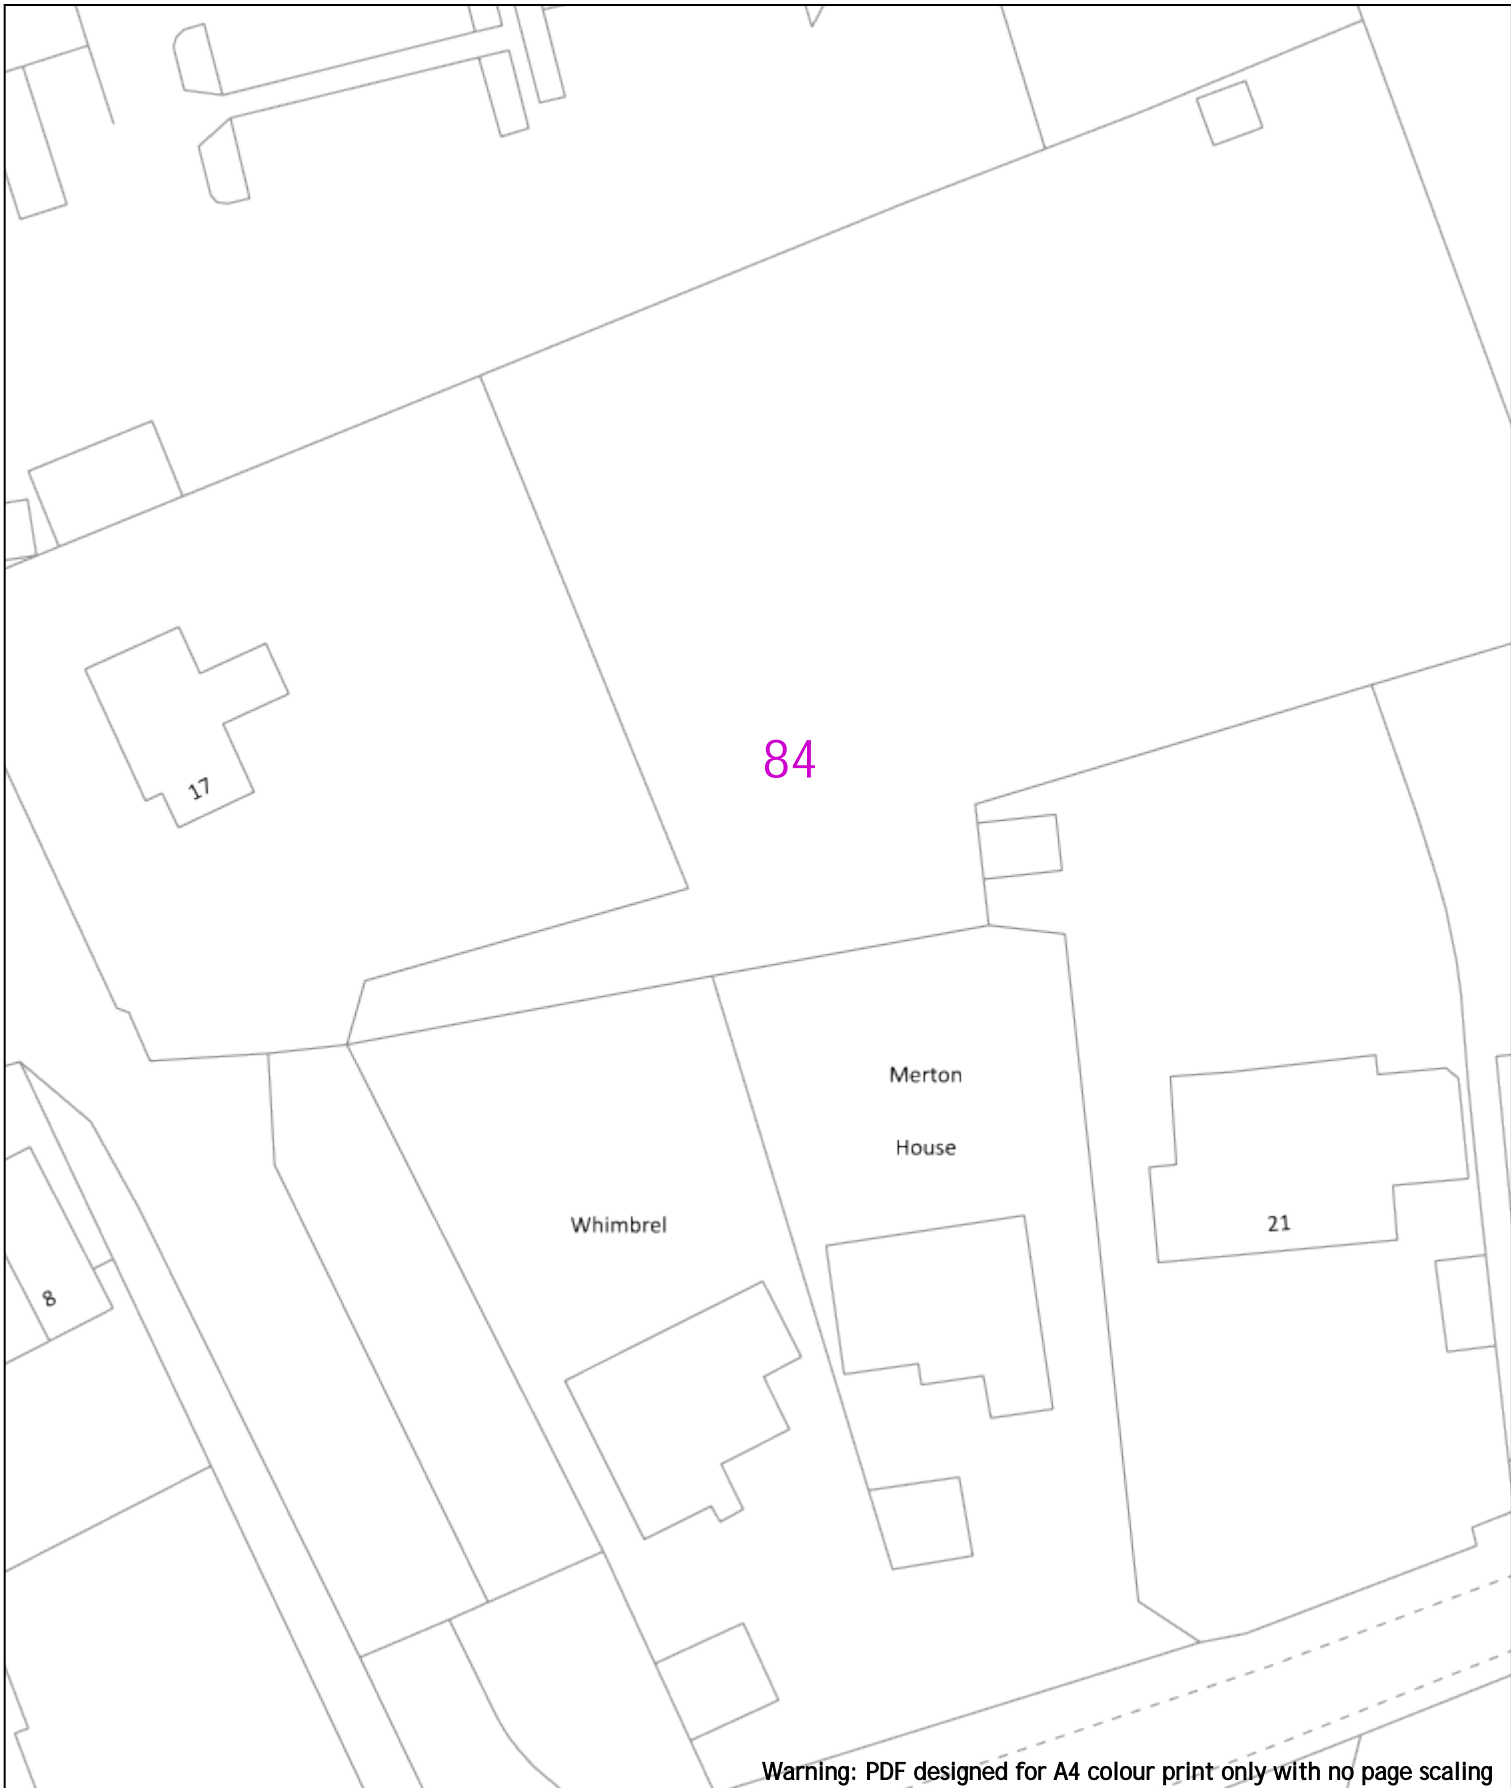

Warning: PDF designed for A4 colour print only with no page scaling

<p>0 20m Dig Sites Area: Line: Extra High Voltage cables in vicinity</p>	
<p>Date Requested: 24/06/2022 Job Reference: 25881010 Site Location: 448066 213346 Requested by: Mr Joe Shawyer Your Scheme/Reference: 31188_002</p>	<table border="1"> <thead> <tr> <th colspan="5">Voltages (V)</th> </tr> </thead> <tbody> <tr> <td>LV (Low Voltage) and Services</td> <td colspan="4">Up to 1,000V</td> </tr> <tr> <td>HV (High Voltage)</td> <td colspan="4">Over 1,000V to 11,000V</td> </tr> <tr> <td>EHV (Extra High Voltage)</td> <td colspan="4">22,000V to 132,000V</td> </tr> <tr> <td>Transmission</td> <td colspan="4">275,000V and 400,000V</td> </tr> <tr> <th colspan="5">NORMAL DEPTH TO THE TOP OF THE CABLE WHEN LAID</th> </tr> <tr> <td>Services</td> <td>LV</td> <td>HV</td> <td>EHV</td> <td></td> </tr> <tr> <td>Footpath/Unmade</td> <td>0.45m</td> <td>0.45m</td> <td>0.6m</td> <td>0.8m</td> </tr> <tr> <td>Road Crossing</td> <td>0.6m</td> <td>0.6m</td> <td>0.75m</td> <td>0.9m</td> </tr> <tr> <td>Agricultural</td> <td>1m</td> <td>1m</td> <td>1m</td> <td>1.1m</td> </tr> </tbody> </table> <p>WARNING There may have been subsequent alteration to the surface levels. Trial holes must be undertaken to determine position and depths of cables. HS (G) 47 Booklet from the Health and Safety Executive – Avoiding Danger from Buried Cables – should be consulted before commencing excavation work. WHEN WORKING IN THE VICINITY OF OVERHEAD LINES THE HEALTH AND SAFETY GUIDANCE NOTES G66 SHOULD BE CONSULTED (AVAILABLE FROM THE HSE WEBSITE)</p>	Voltages (V)					LV (Low Voltage) and Services	Up to 1,000V				HV (High Voltage)	Over 1,000V to 11,000V				EHV (Extra High Voltage)	22,000V to 132,000V				Transmission	275,000V and 400,000V				NORMAL DEPTH TO THE TOP OF THE CABLE WHEN LAID					Services	LV	HV	EHV		Footpath/Unmade	0.45m	0.45m	0.6m	0.8m	Road Crossing	0.6m	0.6m	0.75m	0.9m	Agricultural	1m	1m	1m	1.1m	<table border="1"> <thead> <tr> <th colspan="2">Legend</th> <th colspan="2">Distribution Structures (Electric)</th> </tr> </thead> <tbody> <tr> <td></td> <td>Service Cable</td> <td></td> <td>Pole, Existing Location</td> </tr> <tr> <td></td> <td>LV Mains</td> <td></td> <td>Pole Structure, Existing Location - Single</td> </tr> <tr> <td></td> <td>2 - 11kV</td> <td></td> <td>Pole Structure, Existing Location - H</td> </tr> <tr> <td></td> <td>66kV</td> <td></td> <td>Duct Route</td> </tr> <tr> <td></td> <td>11kV</td> <td></td> <td>Cross Section Route</td> </tr> <tr> <td></td> <td>22kV</td> <td></td> <td></td> </tr> <tr> <td></td> <td>33kV</td> <td></td> <td></td> </tr> <tr> <td></td> <td>66kV</td> <td></td> <td></td> </tr> <tr> <td></td> <td>132kV</td> <td></td> <td></td> </tr> <tr> <td></td> <td>275kV</td> <td></td> <td></td> </tr> <tr> <td></td> <td>400kV</td> <td></td> <td></td> </tr> <tr> <td></td> <td>Fibre Optic</td> <td></td> <td></td> </tr> <tr> <td></td> <td>Pipe Cable</td> <td></td> <td></td> </tr> </tbody> </table>	Legend		Distribution Structures (Electric)			Service Cable		Pole, Existing Location		LV Mains		Pole Structure, Existing Location - Single		2 - 11kV		Pole Structure, Existing Location - H		66kV		Duct Route		11kV		Cross Section Route		22kV				33kV				66kV				132kV				275kV				400kV				Fibre Optic				Pipe Cable		
Voltages (V)	
LV (Low Voltage) and Services	Up to 1,000V	
HV (High Voltage)	Over 1,000V to 11,000V	
EHV (Extra High Voltage)	22,000V to 132,000V	
Transmission	275,000V and 400,000V	
NORMAL DEPTH TO THE TOP OF THE CABLE WHEN LAID	
Services	LV	HV	EHV	
Footpath/Unmade	0.45m	0.45m	0.6m	0.8m	
Road Crossing	0.6m	0.6m	0.75m	0.9m	
Agricultural	1m	1m	1m	1.1m	
Legend		Distribution Structures (Electric)	
	Service Cable		Pole, Existing Location	
	LV Mains		Pole Structure, Existing Location - Single	
	2 - 11kV		Pole Structure, Existing Location - H	
	66kV		Duct Route	
	11kV		Cross Section Route	
	22kV	
	33kV	
	66kV	
	132kV	
	275kV	
	400kV	
	Fibre Optic	
	Pipe Cable	
<p>Scale: 1:500 (When plotted at A4)</p>	<p>Subject to revision – Master held by SSEN Asset Data Team: Asset.Data@sse.com 01256 337 294</p>	

BASED UPON THE ORDNANCE SURVEY MAP WITH THE SANCTION OF THE CONTROLLER OF HM STATIONERY OFFICE CROWN COPYRIGHT RESERVED.
 This copy has been made by or with the authority of Scottish and Southern Energy Power Distribution Ltd. Pursuant to section 47 of the Copyright, Designs and Patents Act 1988 ("The Act"). Unless the Act provides a relevant exception to copyright the copy must not be copied without prior permission of the copyright owner.
 Plans generated by DigSAFE Pro™ software provided by LinesearchbeforeDig.

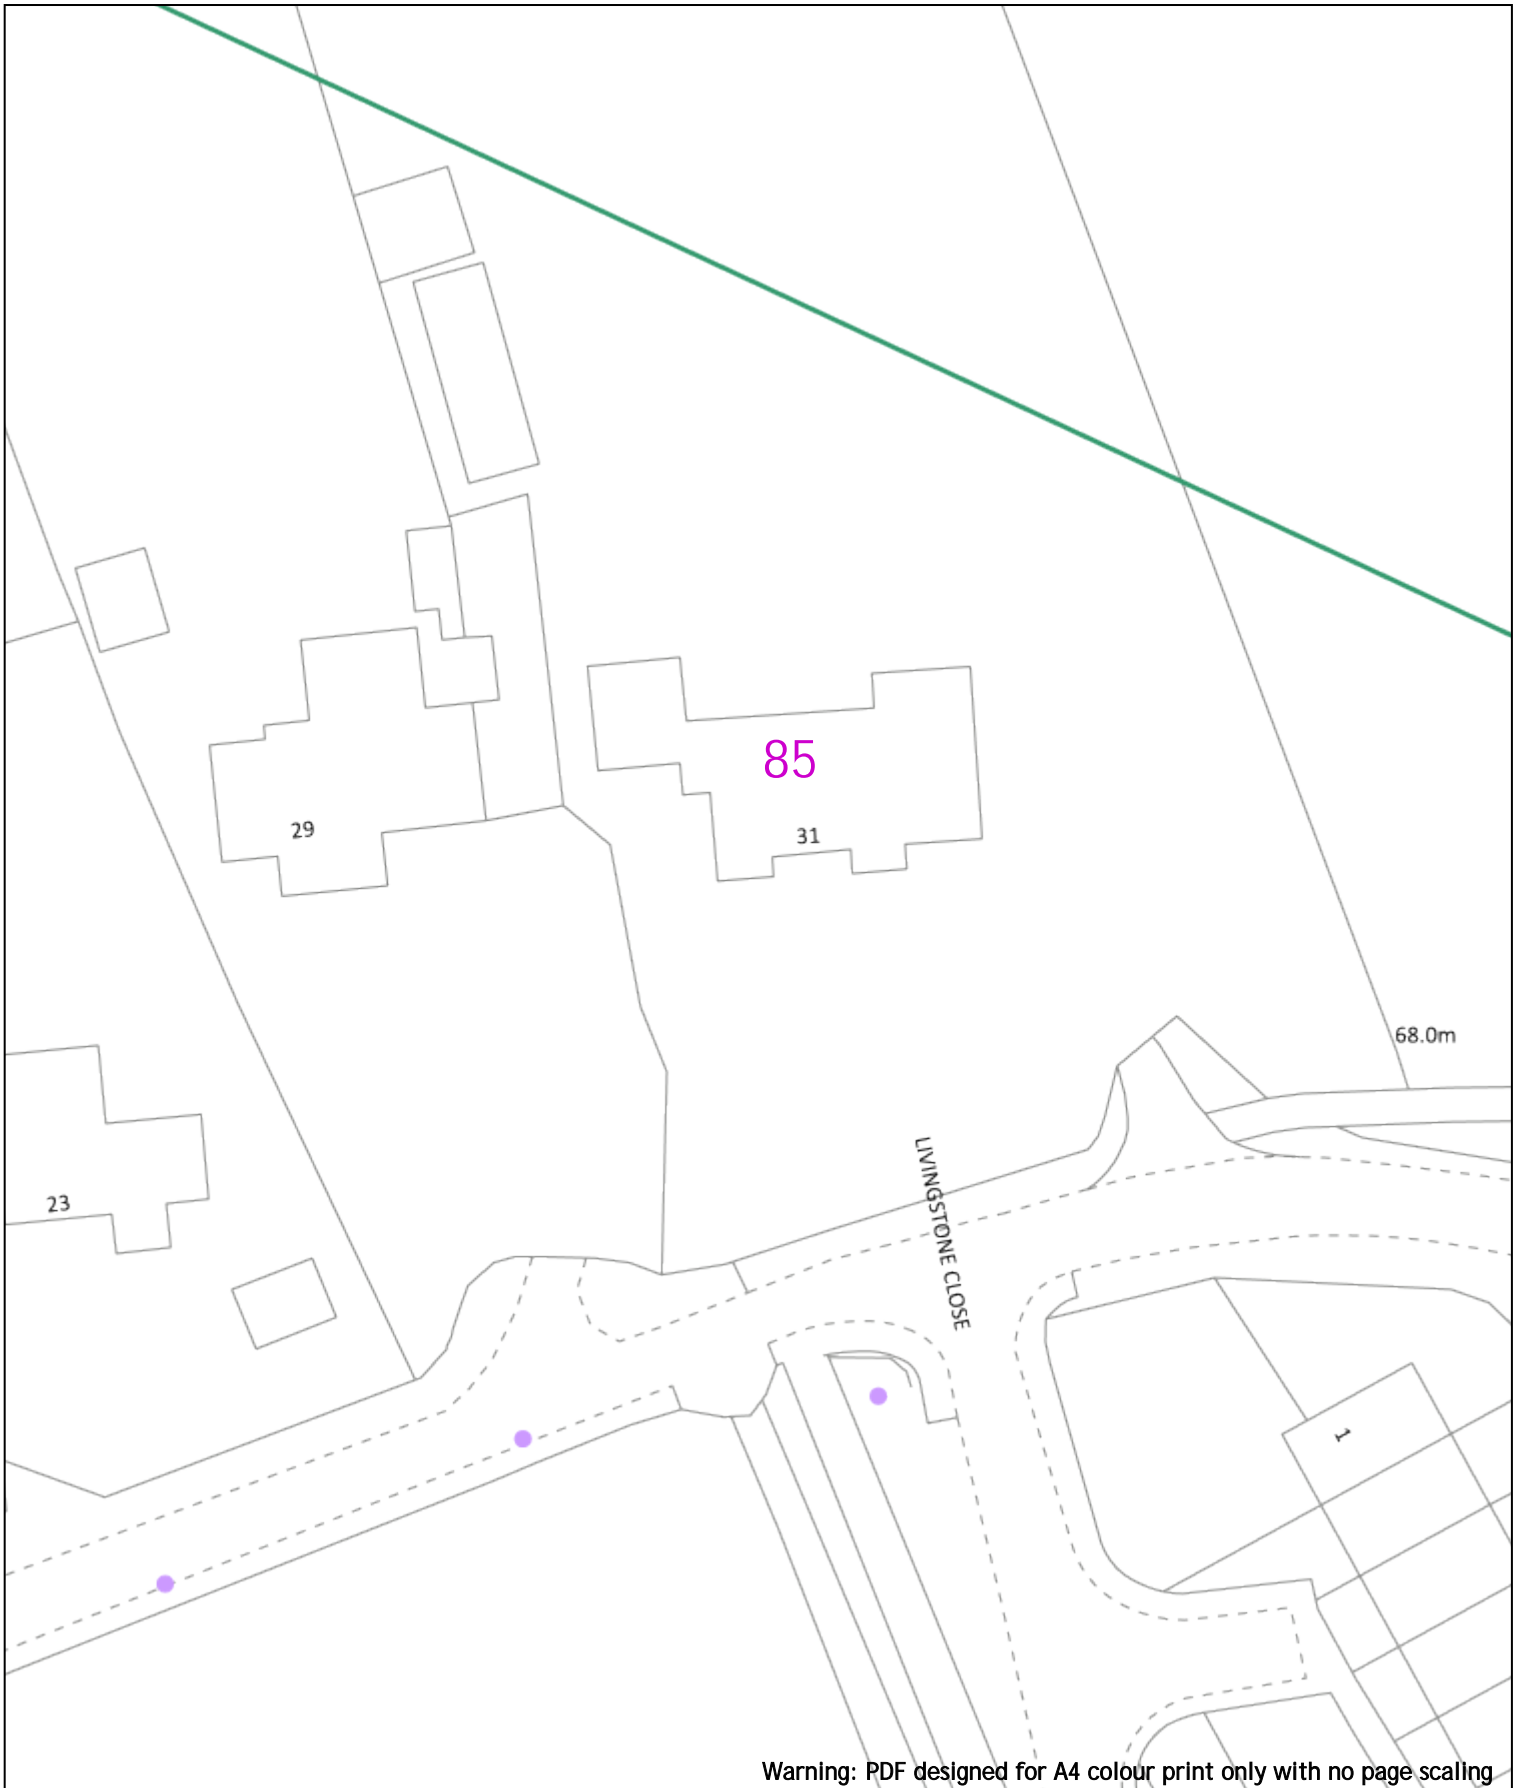

Warning: PDF designed for A4 colour print only with no page scaling

0 20m Dig Sites Area: Line: **Extra High Voltage cables in vicinity**

Date Requested: 24/06/2022
 Job Reference: 25881010
 Site Location: 448066 213346
 Requested by: Mr Joe Shawyer
 Your Scheme/Reference: 31188_002

Voltages (V)				
LV (Low Voltage) and Services	Up to 1,000V			
HV (High Voltage)	Over 1,000V to 11,000V			
EHV (Extra High Voltage)	22,000V to 132,000V			
Transmission	275,000V and 400,000V			
NORMAL DEPTH TO THE TOP OF THE CABLE WHEN LAID				
Services	LV	HV	EHV	
Footpath/Unmade	0.45m	0.45m	0.6m	0.8m
Road Crossing	0.6m	0.6m	0.75m	0.9m
Agricultural	1m	1m	1m	1.1m


Legend	
	Service Cable
	LV Mains
	2 - 11kV
	66kV
	11kV
	22kV
	33kV
	66kV
	132kV
	275kV
	400kV
	Fibre Optic
	Pilot Cable

Distribution Structures (Electric)	
	Pole, Existing Location
	Pole Structure, Existing Location - Single
	Pole Structure, Existing Location - H
	Duct Route
	Cross Section Route

Southern Electric Power Distribution plc
 Registered Office: No.1 Forbury Place
 43 Forbury Road Reading RG1 3JH
 Registered In England & Wales No.04094290


If you're unsure & need to seek advice before commencing excavations, please contact:
 General Enquiries: 0800 048 3516

Subject to revision – Master held by SSEN Asset Data Team:
Asset.Data@sse.com
 01256 337 294

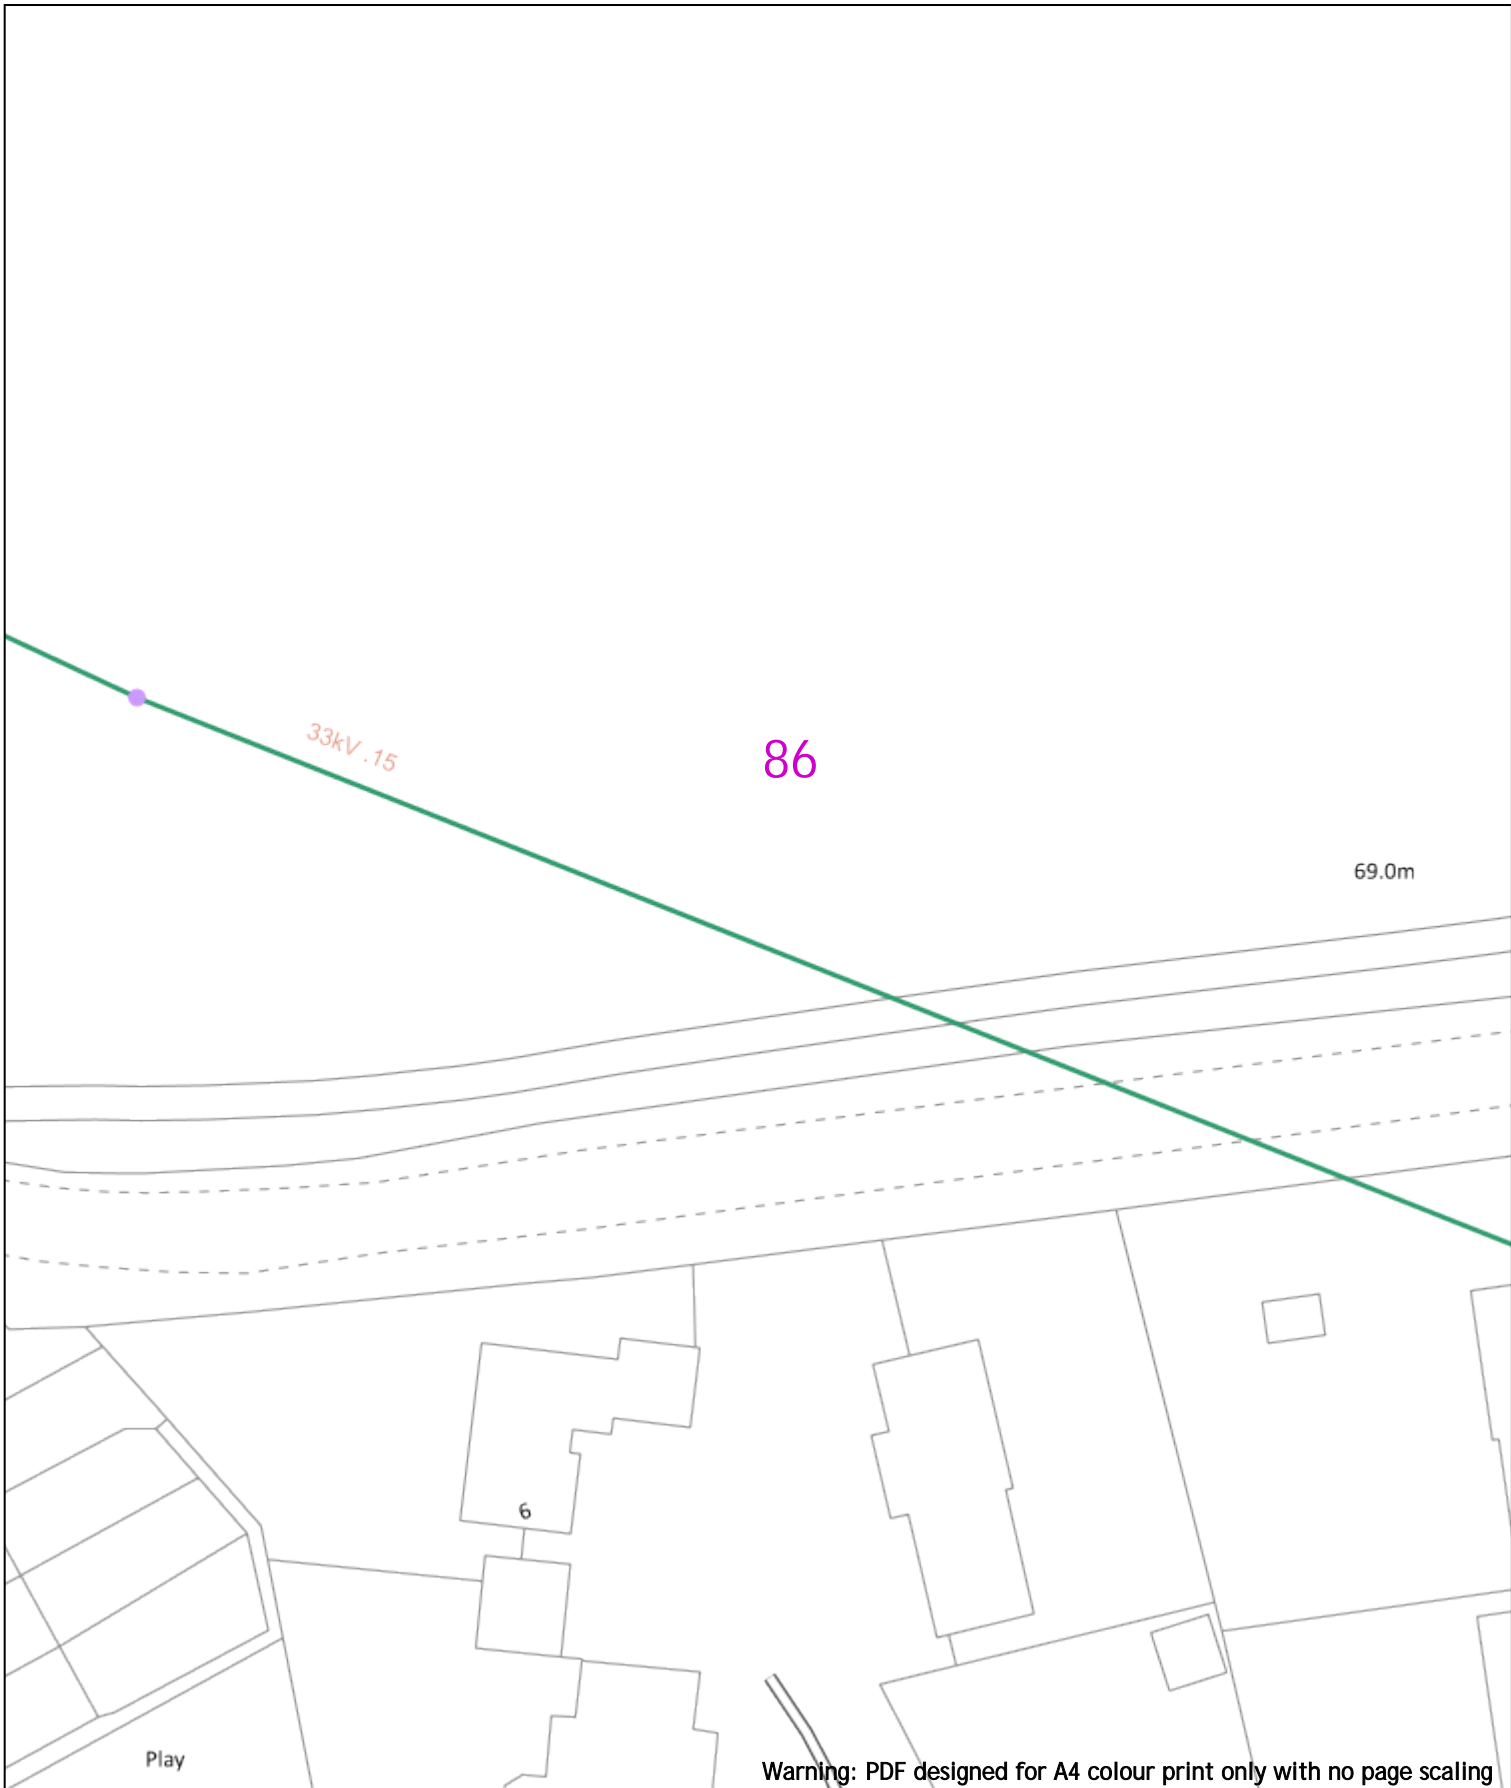


Warning: PDF designed for A4 colour print only with no page scaling

<p>0 20m Dig Sites Area: Line: Extra High Voltage cables in vicinity</p>	
<p>Date Requested: 24/06/2022 Job Reference: 25881010 Site Location: 448066 213346 Requested by: Mr Joe Shawyer Your Scheme/Reference: 31188_002</p>	<table border="1"> <thead> <tr> <th colspan="4">Voltages (V)</th> </tr> </thead> <tbody> <tr> <td>LV (Low Voltage) and Services</td> <td colspan="3">Up to 1,000V</td> </tr> <tr> <td>HV (High Voltage)</td> <td colspan="3">Over 1,000V to 11,000V</td> </tr> <tr> <td>EHV (Extra High Voltage)</td> <td colspan="3">22,000V to 132,000V</td> </tr> <tr> <td>Transmission</td> <td colspan="3">275,000V and 400,000V</td> </tr> </tbody> </table> <table border="1"> <thead> <tr> <th colspan="4">NORMAL DEPTH TO THE TOP OF THE CABLE WHEN LAID</th> </tr> <tr> <th>Services</th> <th>LV</th> <th>HV</th> <th>EHV</th> </tr> </thead> <tbody> <tr> <td>Footpath/Unmade</td> <td>0.45m</td> <td>0.45m</td> <td>0.6m</td> </tr> <tr> <td>Road Crossing</td> <td>0.6m</td> <td>0.6m</td> <td>0.75m</td> </tr> <tr> <td>Agricultural</td> <td>1m</td> <td>1m</td> <td>1.1m</td> </tr> </tbody> </table> <p>WARNING There may have been subsequent alteration to the surface levels. Trial holes must be undertaken to determine position and depths of cables. HS (G) 47 Booklet from the Health and Safety Executive – Avoiding Danger from Buried Cables – should be consulted before commencing excavation work. WHEN WORKING IN THE VICINITY OF OVERHEAD LINES THE HEALTH AND SAFETY GUIDANCE NOTES G56 SHOULD BE CONSULTED (AVAILABLE FROM THE HSE WEBSITE)</p> <table border="1"> <thead> <tr> <th colspan="2">Legend</th> <th colspan="2">Distribution Structures (Electric)</th> </tr> </thead> <tbody> <tr> <td></td> <td>Service Cable</td> <td></td> <td>Pole, Existing Location</td> </tr> <tr> <td></td> <td>LV Mains</td> <td></td> <td>Pole Structure, Existing Location - Single</td> </tr> <tr> <td></td> <td>66kV</td> <td></td> <td>Pole Structure, Existing Location - H</td> </tr> <tr> <td></td> <td>11kV</td> <td></td> <td>Duct Route</td> </tr> <tr> <td></td> <td>22kV</td> <td></td> <td>Cross Section Route</td> </tr> <tr> <td></td> <td>33kV</td> <td></td> <td></td> </tr> <tr> <td></td> <td>66kV</td> <td></td> <td></td> </tr> <tr> <td></td> <td>132kV</td> <td></td> <td></td> </tr> <tr> <td></td> <td>275kV</td> <td></td> <td></td> </tr> <tr> <td></td> <td>400kV</td> <td></td> <td></td> </tr> <tr> <td></td> <td>Fibre Optic</td> <td></td> <td></td> </tr> <tr> <td></td> <td>Pilot Cable</td> <td></td> <td></td> </tr> </tbody> </table>	Voltages (V)				LV (Low Voltage) and Services	Up to 1,000V			HV (High Voltage)	Over 1,000V to 11,000V			EHV (Extra High Voltage)	22,000V to 132,000V			Transmission	275,000V and 400,000V			NORMAL DEPTH TO THE TOP OF THE CABLE WHEN LAID				Services	LV	HV	EHV	Footpath/Unmade	0.45m	0.45m	0.6m	Road Crossing	0.6m	0.6m	0.75m	Agricultural	1m	1m	1.1m	Legend		Distribution Structures (Electric)			Service Cable		Pole, Existing Location		LV Mains		Pole Structure, Existing Location - Single		66kV		Pole Structure, Existing Location - H		11kV		Duct Route		22kV		Cross Section Route		33kV				66kV				132kV				275kV				400kV				Fibre Optic				Pilot Cable		
Voltages (V)	
LV (Low Voltage) and Services	Up to 1,000V	
HV (High Voltage)	Over 1,000V to 11,000V	
EHV (Extra High Voltage)	22,000V to 132,000V	
Transmission	275,000V and 400,000V	
NORMAL DEPTH TO THE TOP OF THE CABLE WHEN LAID	
Services	LV	HV	EHV	
Footpath/Unmade	0.45m	0.45m	0.6m	
Road Crossing	0.6m	0.6m	0.75m	
Agricultural	1m	1m	1.1m	
Legend		Distribution Structures (Electric)	
	Service Cable		Pole, Existing Location	
	LV Mains		Pole Structure, Existing Location - Single	
	66kV		Pole Structure, Existing Location - H	
	11kV		Duct Route	
	22kV		Cross Section Route	
	33kV	
	66kV	
	132kV	
	275kV	
	400kV	
	Fibre Optic	
	Pilot Cable	
<p>Scale: 1:500 (When plotted at A4)</p>	<p>Based upon the Ordnance Survey map with the sanction of the Controller of HM Stationery Office Crown Copyright Reserved. This copy has been made by or with the authority of Scottish and Southern Energy Power Distribution Ltd. Pursuant to section 47 of the Copyright, Designs and Patents Act 1988 ("The Act"). Unless the Act provides a relevant exception to copyright the copy must not be copied without prior permission of the copyright owner. Plans generated by DigSAFE Pro™ software provided by LinesearchbeforeUdig.</p>	<p>Southern Electric Power Distribution plc Registered Office: No.1 Forbury Place 43 Forbury Road Reading RG1 3JH Registered In England & Wales No.04094290</p> <p>If you're unsure & need to seek advice before commencing excavations, please contact: General Enquiries: 0800 048 3516</p> <p>Subject to revision – Master held by SSEN Asset Data Team: Asset.Data@sse.com 01256 337 294</p>	

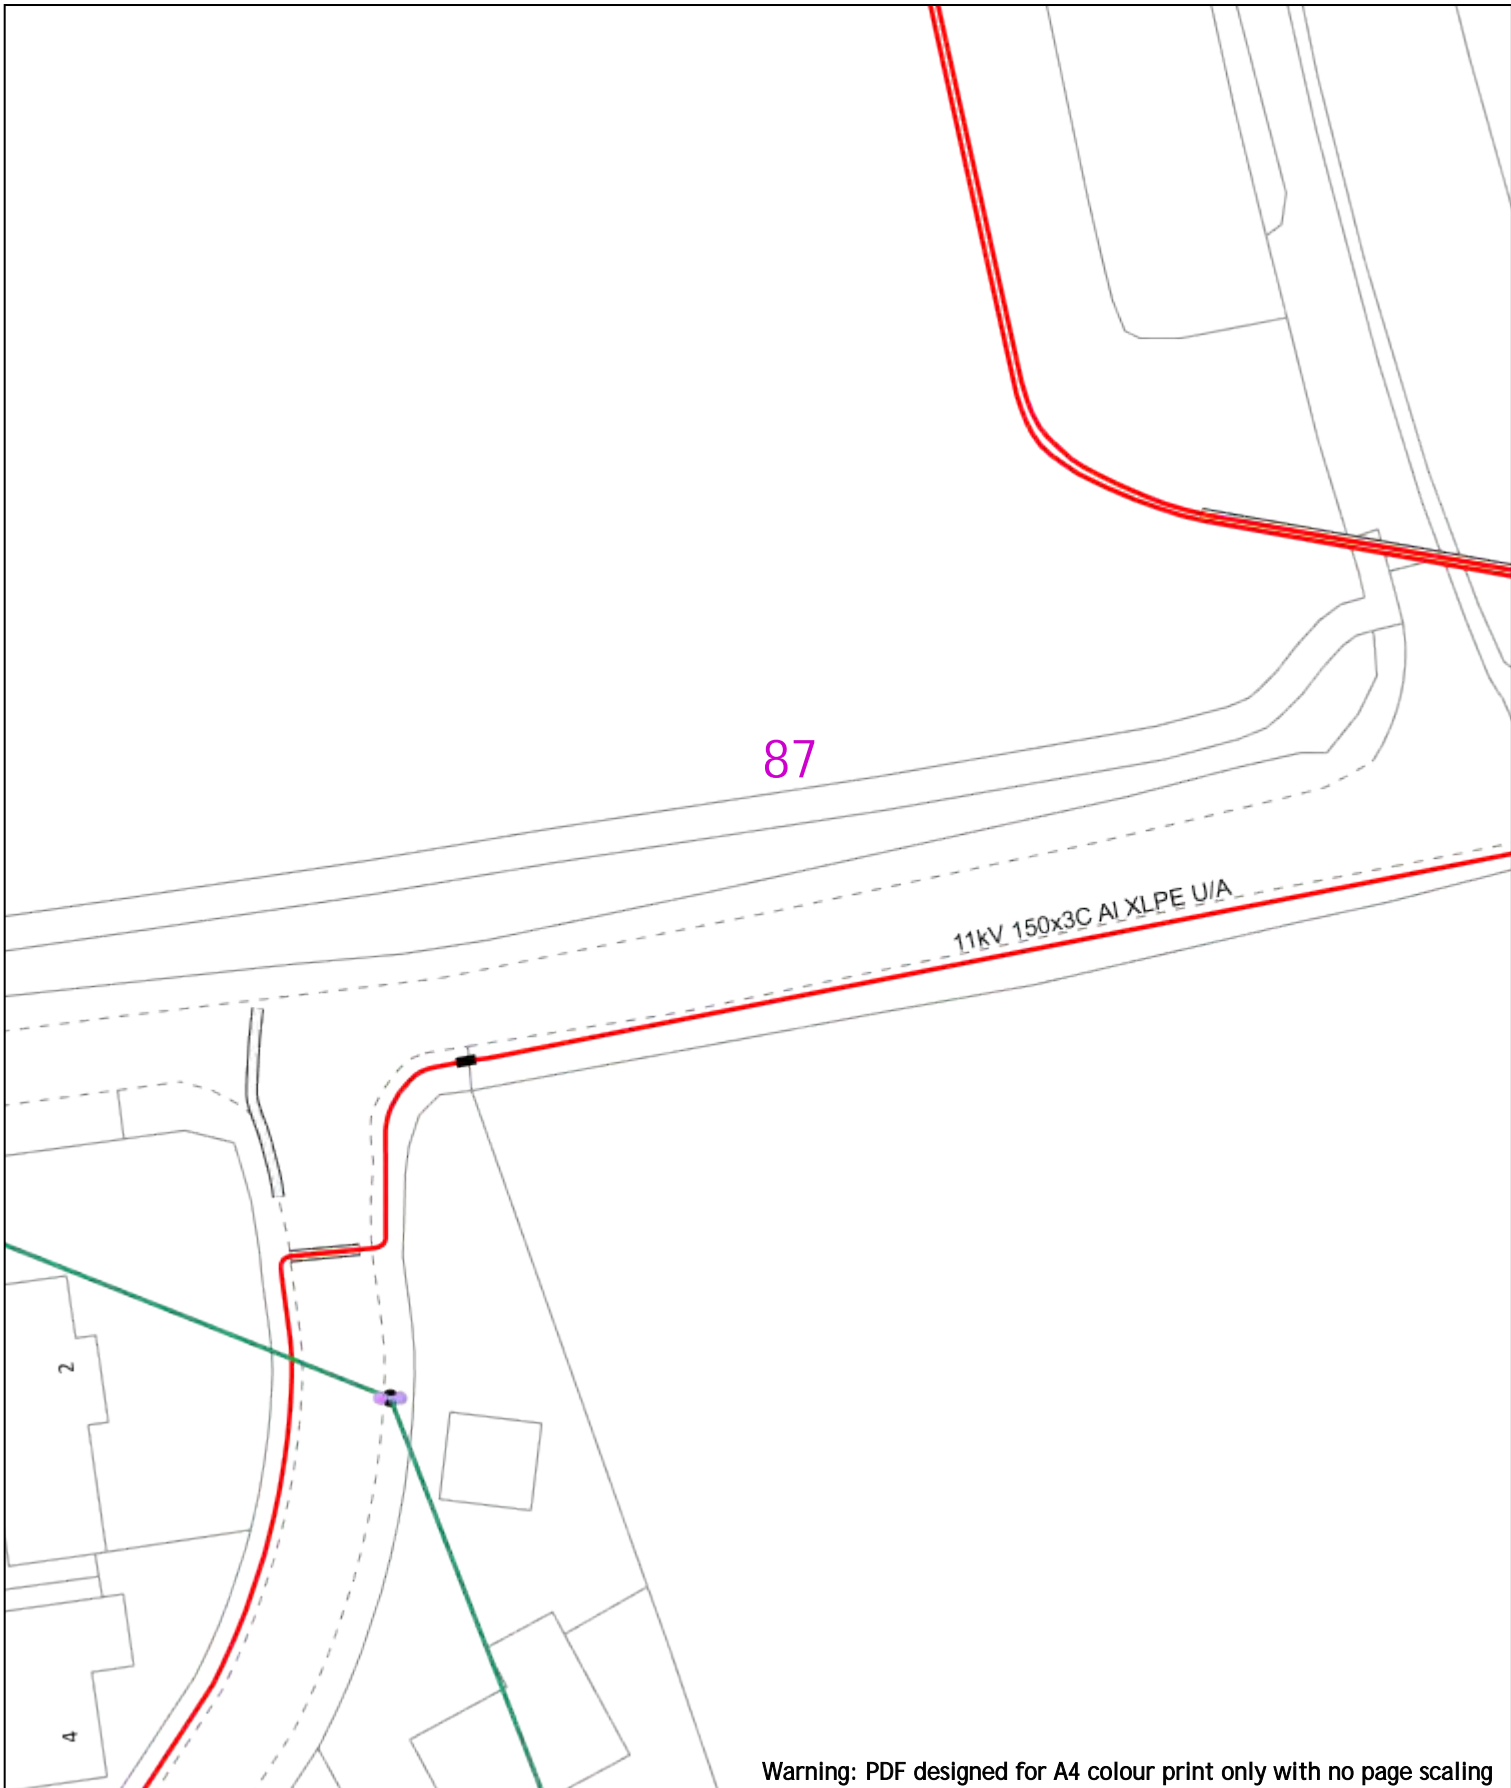

Warning: PDF designed for A4 colour print only with no page scaling

<p>0 20m Dig Sites Area: Line: Extra High Voltage cables in vicinity</p>	
<p>Date Requested: 24/06/2022 Job Reference: 25881010 Site Location: 448066 213346 Requested by: Mr Joe Shawyer Your Scheme/Reference: 31188_002</p>	<table border="1"> <thead> <tr> <th colspan="4">Voltages (V)</th> </tr> </thead> <tbody> <tr> <td>LV (Low Voltage) and Services</td> <td colspan="3">Up to 1,000V</td> </tr> <tr> <td>HV (High Voltage)</td> <td colspan="3">Over 1,000V to 11,000V</td> </tr> <tr> <td>EHV (Extra High Voltage)</td> <td colspan="3">22,000V to 132,000V</td> </tr> <tr> <td>Transmission</td> <td colspan="3">275,000V and 400,000V</td> </tr> <tr> <th colspan="4">NORMAL DEPTH TO THE TOP OF THE CABLE WHEN LAID</th> </tr> <tr> <td>Services</td> <td>LV</td> <td>HV</td> <td>EHV</td> </tr> <tr> <td>Footpath/Unmade</td> <td>0.45m</td> <td>0.45m</td> <td>0.6m 0.8m</td> </tr> <tr> <td>Road Crossing</td> <td>0.6m</td> <td>0.6m</td> <td>0.75m 0.9m</td> </tr> <tr> <td>Agricultural</td> <td>1m</td> <td>1m</td> <td>1m 1.1m</td> </tr> </tbody> </table>			Voltages (V)				LV (Low Voltage) and Services	Up to 1,000V			HV (High Voltage)	Over 1,000V to 11,000V			EHV (Extra High Voltage)	22,000V to 132,000V			Transmission	275,000V and 400,000V			NORMAL DEPTH TO THE TOP OF THE CABLE WHEN LAID				Services	LV	HV	EHV	Footpath/Unmade	0.45m	0.45m	0.6m 0.8m	Road Crossing	0.6m	0.6m	0.75m 0.9m	Agricultural	1m	1m	1m 1.1m	<table border="1"> <thead> <tr> <th colspan="2">Legend</th> <th colspan="2">Distribution Structures (Electric)</th> </tr> </thead> <tbody> <tr> <td></td> <td>Service Cable</td> <td></td> <td>Pole, Existing Location</td> </tr> <tr> <td></td> <td>LV Mains</td> <td></td> <td>Pole Structure, Existing Location - Single</td> </tr> <tr> <td></td> <td>2 - 11kV</td> <td></td> <td>Pole Structure, Existing Location - H</td> </tr> <tr> <td></td> <td>6kV</td> <td></td> <td>Duct Route</td> </tr> <tr> <td></td> <td>11kV</td> <td></td> <td>Cross Section Route</td> </tr> <tr> <td></td> <td>22kV</td> <td></td> <td></td> </tr> <tr> <td></td> <td>33kV</td> <td></td> <td></td> </tr> <tr> <td></td> <td>66kV</td> <td></td> <td></td> </tr> <tr> <td></td> <td>132kV</td> <td></td> <td></td> </tr> <tr> <td></td> <td>275kV</td> <td></td> <td></td> </tr> <tr> <td></td> <td>400kV</td> <td></td> <td></td> </tr> <tr> <td></td> <td>Fibre Optic</td> <td></td> <td></td> </tr> <tr> <td></td> <td>Pipe Cable</td> <td></td> <td></td> </tr> </tbody> </table> <p>WARNING There may have been subsequent alteration to the surface levels. Trial holes must be undertaken to determine position and depths of cables. HS (G) 47 Booklet from the Health and Safety Executive - Avoiding Danger from Buried Cables - should be consulted before commencing excavation work. WHEN WORKING IN THE VICINITY OF OVERHEAD LINES THE HEALTH AND SAFETY GUIDANCE NOTES G66 SHOULD BE CONSULTED (AVAILABLE FROM THE HSE WEBSITE)</p>	Legend		Distribution Structures (Electric)			Service Cable		Pole, Existing Location		LV Mains		Pole Structure, Existing Location - Single		2 - 11kV		Pole Structure, Existing Location - H		6kV		Duct Route		11kV		Cross Section Route		22kV				33kV				66kV				132kV				275kV				400kV				Fibre Optic				Pipe Cable
Voltages (V)	
LV (Low Voltage) and Services	Up to 1,000V	
HV (High Voltage)	Over 1,000V to 11,000V	
EHV (Extra High Voltage)	22,000V to 132,000V	
Transmission	275,000V and 400,000V	
NORMAL DEPTH TO THE TOP OF THE CABLE WHEN LAID	
Services	LV	HV	EHV	
Footpath/Unmade	0.45m	0.45m	0.6m 0.8m	
Road Crossing	0.6m	0.6m	0.75m 0.9m	
Agricultural	1m	1m	1m 1.1m	
Legend		Distribution Structures (Electric)	
	Service Cable		Pole, Existing Location	
	LV Mains		Pole Structure, Existing Location - Single	
	2 - 11kV		Pole Structure, Existing Location - H	
	6kV		Duct Route	
	11kV		Cross Section Route	
	22kV	
	33kV	
	66kV	
	132kV	
	275kV	
	400kV	
	Fibre Optic	
	Pipe Cable	
<p>Scale: 1:500 (When plotted at A4)</p>		<p>Southern Electric Power Distribution plc Registered Office: No.1 Forbury Place 43 Forbury Road Reading RG1 3JH Registered In England & Wales No.04094290</p> <p>If you're unsure & need to seek advice before commencing excavations, please contact: General Enquiries: 0800 048 3516</p> <p>Subject to revision - Master held by SSEN Asset Data Team: Asset.Data@sse.com 01256 337 294</p>	

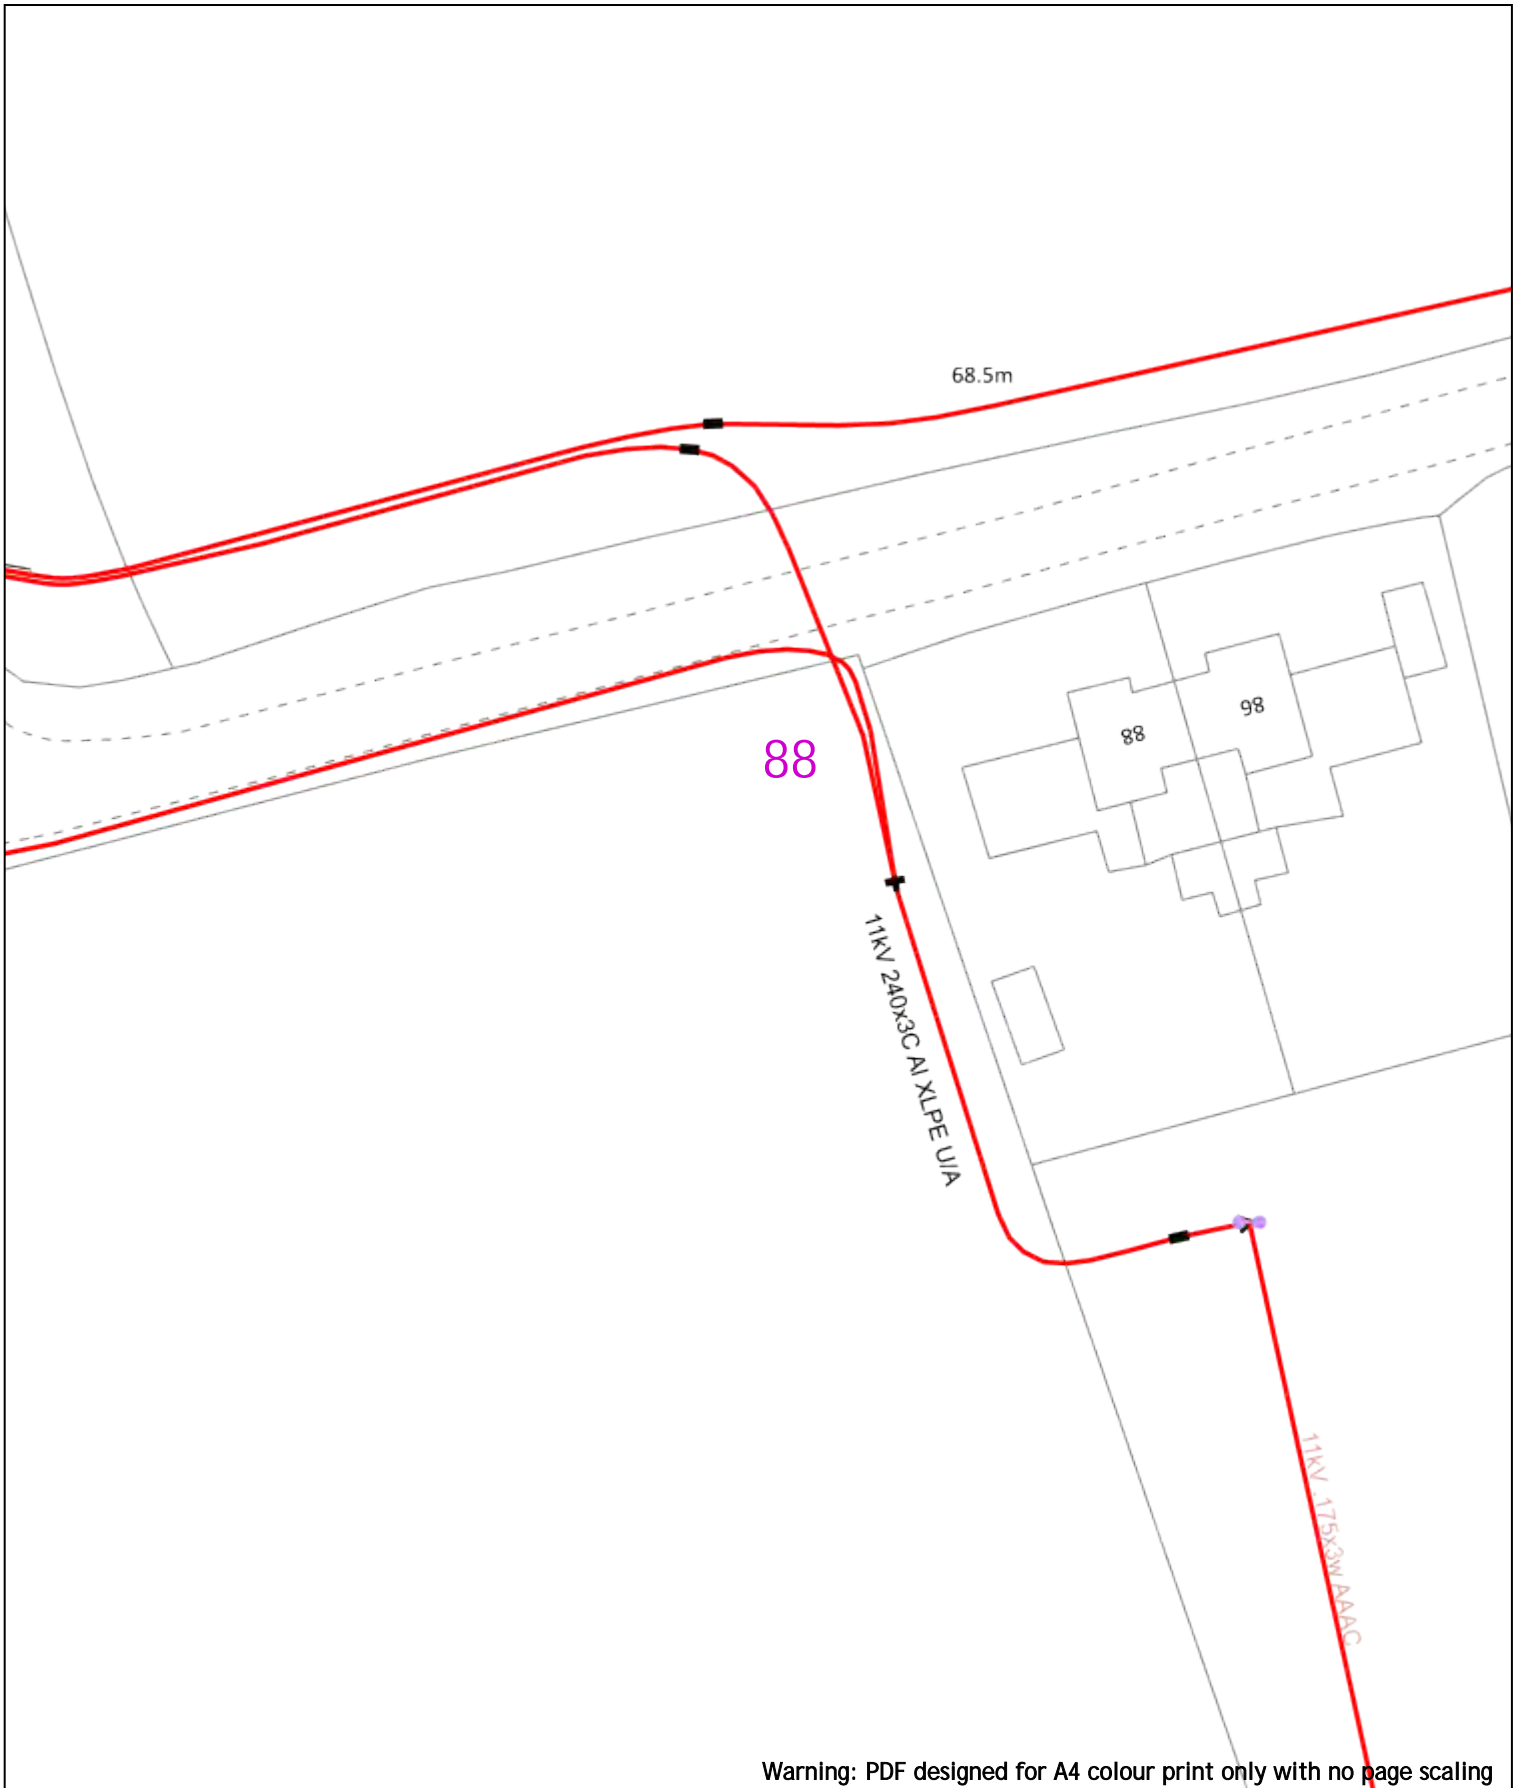

Warning: PDF designed for A4 colour print only with no page scaling

<p>0 20m</p> <p>Date Requested: 24/06/2022 Job Reference: 25881010 Site Location: 448066 213346 Requested by: Mr Joe Shawyer Your Scheme/Reference: 31188_002</p>	<p>Dig Sites: Area: Line: </p> <p style="text-align: center;">Extra High Voltage cables in vicinity</p>	<p></p> <p></p>	<p style="text-align: center;">Southern Electric Power Distribution plc Registered Office: No.1 Forbury Place 43 Forbury Road Reading RG1 3JH Registered In England & Wales No.04094290</p> <p style="text-align: center;">If you're unsure & need to seek advice before commencing excavations, please contact: General Enquiries: 0800 048 3516</p> <p style="text-align: center;">Subject to revision – Master held by SSEN Asset Data Team: Asset.Data@sse.com 01256 337 294</p>																																							
<table border="1" style="width: 100%; border-collapse: collapse;"> <thead> <tr> <th colspan="4">Voltages (V)</th> </tr> </thead> <tbody> <tr> <td>LV (Low Voltage) and Services</td> <td colspan="3">Up to 1,000V</td> </tr> <tr> <td>HV (High Voltage)</td> <td colspan="3">Over 1,000V to 11,000V</td> </tr> <tr> <td>EHV (Extra High Voltage)</td> <td colspan="3">22,000V to 132,000V</td> </tr> <tr> <td>Transmission</td> <td colspan="3">275,000V and 400,000V</td> </tr> <tr> <th colspan="4">NORMAL DEPTH TO THE TOP OF THE CABLE WHEN LAID</th> </tr> <tr> <td>Services</td> <td>LV</td> <td>HV</td> <td>EHV</td> </tr> <tr> <td>Footpath/Unmade</td> <td>0.45m</td> <td>0.45m</td> <td>0.6m</td> </tr> <tr> <td>Road Crossing</td> <td>0.6m</td> <td>0.6m</td> <td>0.75m</td> </tr> <tr> <td>Agricultural</td> <td>1m</td> <td>1m</td> <td>1.1m</td> </tr> </tbody> </table>		Voltages (V)				LV (Low Voltage) and Services	Up to 1,000V			HV (High Voltage)	Over 1,000V to 11,000V			EHV (Extra High Voltage)	22,000V to 132,000V			Transmission	275,000V and 400,000V			NORMAL DEPTH TO THE TOP OF THE CABLE WHEN LAID				Services	LV	HV	EHV	Footpath/Unmade	0.45m	0.45m	0.6m	Road Crossing	0.6m	0.6m	0.75m	Agricultural	1m	1m	1.1m	<p>Legend</p> <ul style="list-style-type: none"> Service Cable LV Mains 2 – 11kV 66kV 11kV 22kV 33kV 66kV 132kV 275kV 400kV Fibre Optic Pipit Cable <p>Distribution Structures (Electric)</p> <ul style="list-style-type: none"> Pole, Existing Location Pole Structure, Existing Location – Single Pole Structure, Existing Location – H Duct Route Cross Section Route <p style="text-align: center;">WARNING</p> <p style="font-size: small;">There may have been subsequent alteration to the surface levels. Trial holes must be undertaken to determine position and depths of cables. HS (G) 47 Booklet from the Health and Safety Executive – Avoiding Danger from Buried Cables – should be consulted before commencing excavation work.</p> <p style="font-size: x-small; text-align: center;">WHEN WORKING IN THE VICINITY OF OVERHEAD LINES THE HEALTH AND SAFETY GUIDANCE NOTES G56 SHOULD BE CONSULTED (AVAILABLE FROM THE HSE WEBSITE)</p>
Voltages (V)	
LV (Low Voltage) and Services	Up to 1,000V	
HV (High Voltage)	Over 1,000V to 11,000V	
EHV (Extra High Voltage)	22,000V to 132,000V	
Transmission	275,000V and 400,000V	
NORMAL DEPTH TO THE TOP OF THE CABLE WHEN LAID	
Services	LV	HV	EHV																																							
Footpath/Unmade	0.45m	0.45m	0.6m																																							
Road Crossing	0.6m	0.6m	0.75m																																							
Agricultural	1m	1m	1.1m																																							
<p>BASED UPON THE ORDNANCE SURVEY MAP WITH THE SANCTION OF THE CONTROLLER OF HM STATIONERY OFFICE CROWN COPYRIGHT RESERVED.</p> <p>This copy has been made by or with the authority of Scottish and Southern Energy Power Distribution Ltd. Pursuant to section 47 of the Copyright, Designs and Patents Act 1988 ("The Act"). Unless the Act provides a relevant exception to copyright the copy must not be copied without prior permission of the copyright owner.</p> <p>Plans generated by DigSAFE Pro™ software provided by Linesearchbefore4dig.</p>	

68.5m

89

Warning: PDF designed for A4 colour print only with no page scaling

0  20m

Dig Sites


Area:



Line:



Extra High Voltage
cables in vicinity

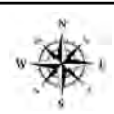

Date Requested: 24/06/2022
Job Reference: 25881010
Site Location: 448066 213346
Requested by: Mr Joe Shawyer
Your Scheme/Reference: 31188_002

Voltages (V)			
LV (Low Voltage) and Services	Up to 1,000V		
HV (High Voltage)	Over 1,000V to 11,000V		
EHV (Extra High Voltage)	22,000V to 132,000V		
Transmission	275,000V and 400,000V		
NORMAL DEPTH TO THE TOP OF THE CABLE WHEN LAID			
Services	LV	HV	EHV
Footpath/Unmade	0.45m	0.45m	0.6m
Road Crossing	0.6m	0.6m	0.75m
Agricultural	1m	1m	1.1m

Legend	
	Service Cable
	LV Mains
	2 - 11kV
	66kV
	11kV
	22kV
	33kV
	66kV
	132kV
	275kV
	400kV
	Fibre Optic
	Pipe Cable

Distribution Structures (Electric)	
	Pole, Existing Location
	Pole Structure, Existing Location - Single
	Pole Structure, Existing Location - H
	Duct Route
	Cross Section Route


Southern Electric Power Distribution plc
Registered Office: No.1 Forbury Place
43 Forbury Road Reading RG1 3JH
Registered In England & Wales No.04094290

If you're unsure & need to seek advice before commencing excavations, please contact:
General Enquiries: 0800 048 3516

Subject to revision - Master held by SSEN Asset Data Team:
Asset.Data@sse.com
01256 337 294

Scale: 1:500 (When plotted at A4)

WARNING
There may have been subsequent alteration to the surface levels. Trial holes must be undertaken to determine position and depths of cables. HS (G) 47 Booklet from the Health and Safety Executive - Avoiding Danger from Buried Cables - should be consulted before commencing excavation work.
WHEN WORKING IN THE VICINITY OF OVERHEAD LINES THE HEALTH AND SAFETY GUIDANCE NOTES G56 SHOULD BE CONSULTED (AVAILABLE FROM THE HSE WEBSITE)

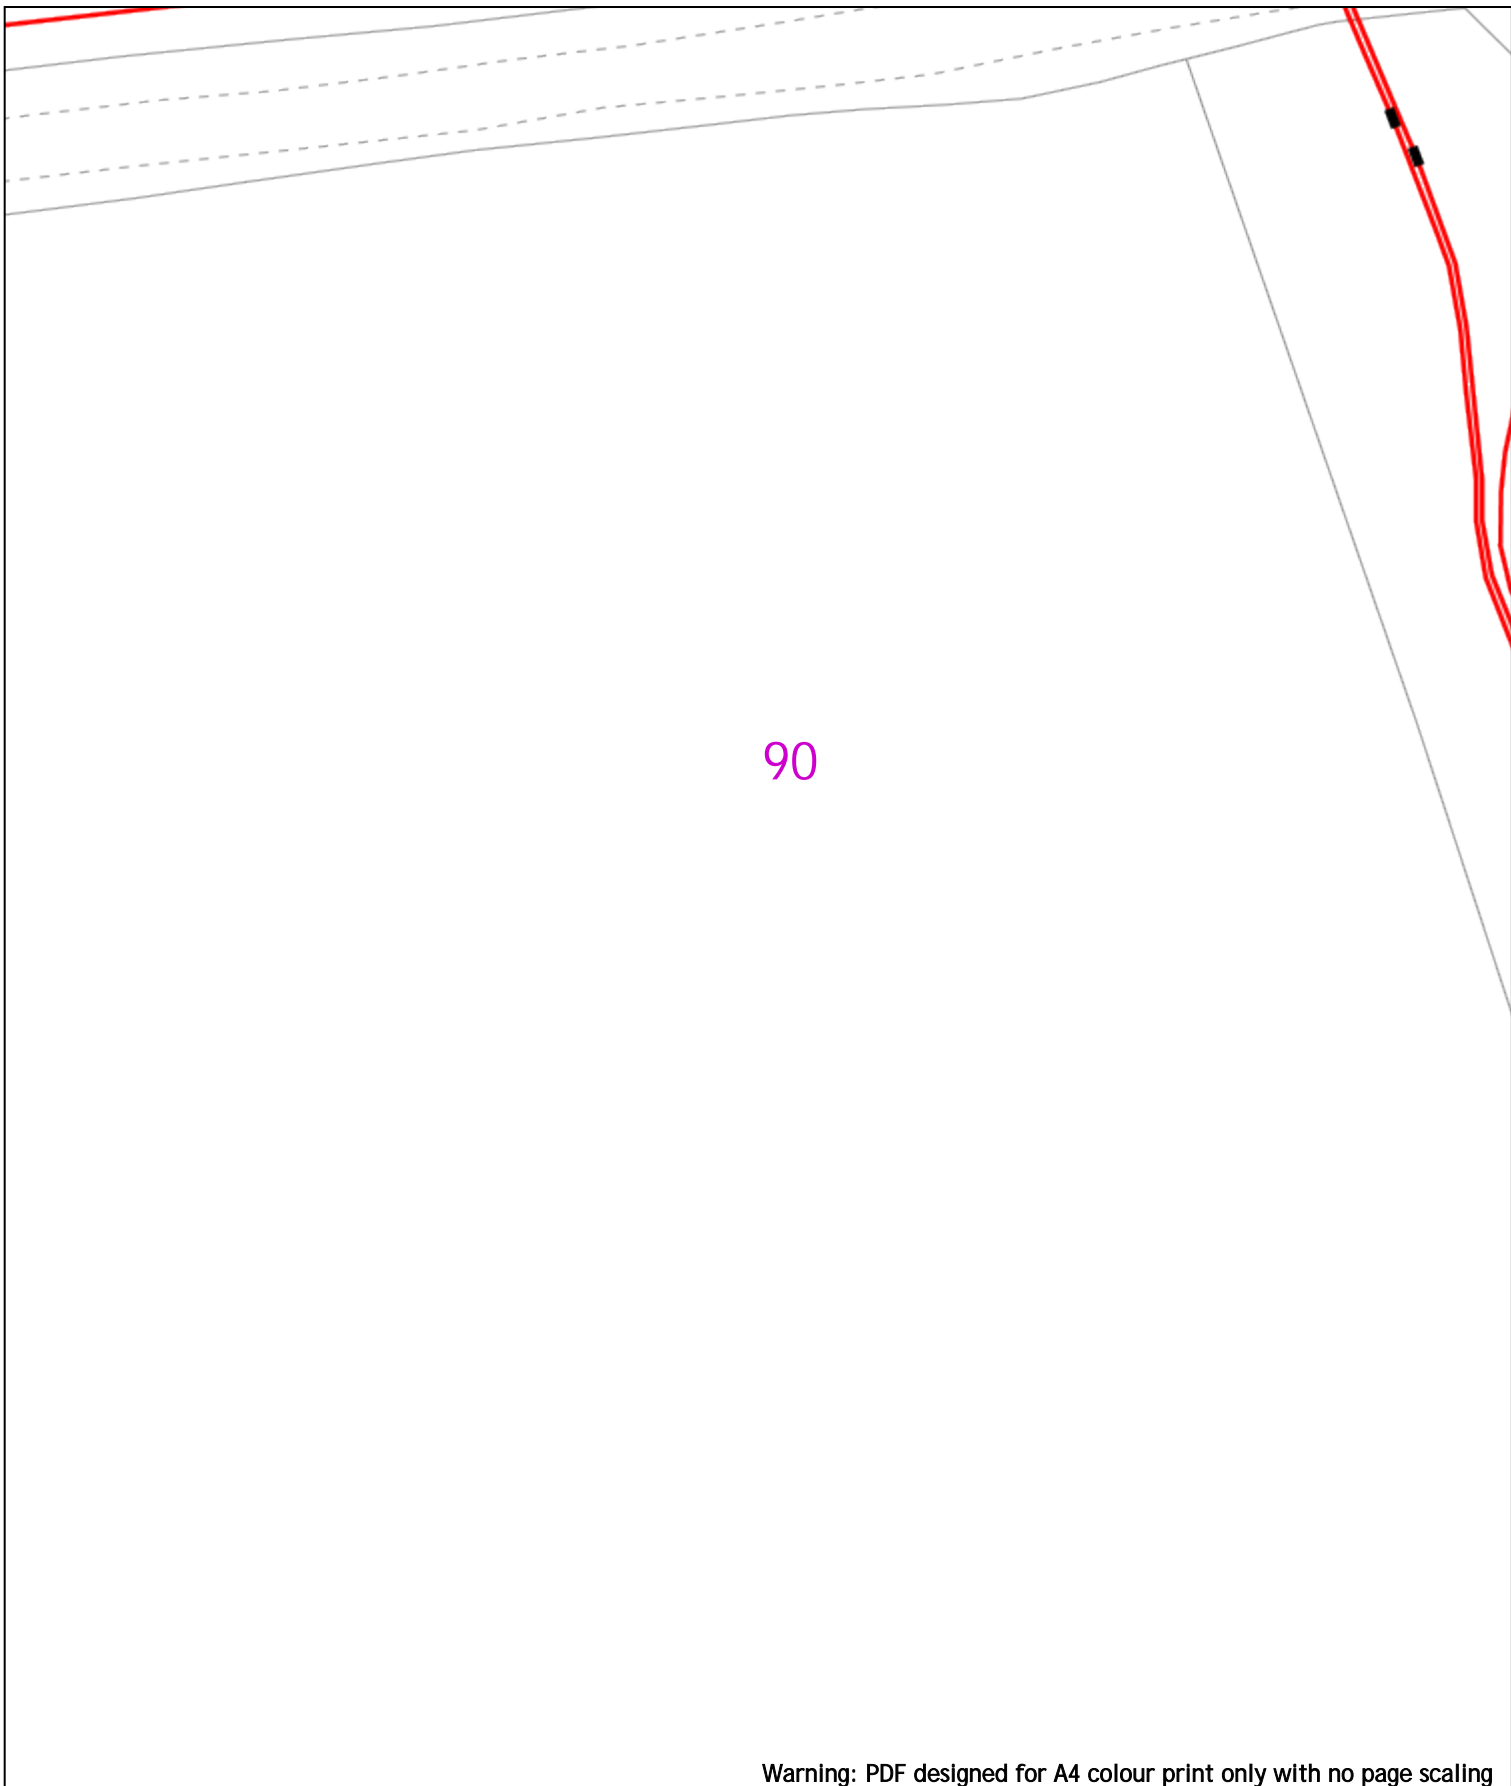


90

Warning: PDF designed for A4 colour print only with no page scaling


	Dig Sites Area: Line:	Extra High Voltage cables in vicinity	
Date Requested: 24/06/2022 Job Reference: 25881010 Site Location: 448066 213346 Requested by: Mr Joe Shawyer Your Scheme/Reference: 31188_002 Scale: 1:500 (When plotted at A4)	<table border="1"> <thead> <tr> <th colspan="4">Voltages (V)</th> </tr> </thead> <tbody> <tr> <td>LV (Low Voltage) and Services</td> <td colspan="3">Up to 1,000V</td> </tr> <tr> <td>HV (High Voltage)</td> <td colspan="3">Over 1,000V to 11,000V</td> </tr> <tr> <td>EHV (Extra High Voltage)</td> <td colspan="3">22,000V to 132,000V</td> </tr> <tr> <td>Transmission</td> <td colspan="3">275,000V and 400,000V</td> </tr> </tbody> </table> <table border="1"> <thead> <tr> <th colspan="4">NORMAL DEPTH TO THE TOP OF THE CABLE WHEN LAID</th> </tr> <tr> <th>Services</th> <th>LV</th> <th>HV</th> <th>EHV</th> </tr> </thead> <tbody> <tr> <td>Footpath/Unmade</td> <td>0.45m</td> <td>0.45m</td> <td>0.8m</td> </tr> <tr> <td>Road Crossing</td> <td>0.6m</td> <td>0.6m</td> <td>0.9m</td> </tr> <tr> <td>Agricultural</td> <td>1m</td> <td>1m</td> <td>1.1m</td> </tr> </tbody> </table>	Voltages (V)				LV (Low Voltage) and Services	Up to 1,000V			HV (High Voltage)	Over 1,000V to 11,000V			EHV (Extra High Voltage)	22,000V to 132,000V			Transmission	275,000V and 400,000V			NORMAL DEPTH TO THE TOP OF THE CABLE WHEN LAID				Services	LV	HV	EHV	Footpath/Unmade	0.45m	0.45m	0.8m	Road Crossing	0.6m	0.6m	0.9m	Agricultural	1m	1m	1.1m	<table border="1"> <thead> <tr> <th colspan="2">Legend</th> <th colspan="2">Distribution Structures (Electric)</th> </tr> </thead> <tbody> <tr> <td></td> <td>Service Cable</td> <td></td> <td>Pole, Existing Location</td> </tr> <tr> <td></td> <td>LV Mains</td> <td></td> <td>Pole Structure, Existing Location - Single</td> </tr> <tr> <td></td> <td>2 - 11kV</td> <td></td> <td>Pole Structure, Existing Location - H</td> </tr> <tr> <td></td> <td>66kV</td> <td></td> <td>Duct Route</td> </tr> <tr> <td></td> <td>11kV</td> <td></td> <td>Cross Section Route</td> </tr> <tr> <td></td> <td>22kV</td> <td></td> <td></td> </tr> <tr> <td></td> <td>33kV</td> <td></td> <td></td> </tr> <tr> <td></td> <td>66kV</td> <td></td> <td></td> </tr> <tr> <td></td> <td>132kV</td> <td></td> <td></td> </tr> <tr> <td></td> <td>275kV</td> <td></td> <td></td> </tr> <tr> <td></td> <td>400kV</td> <td></td> <td></td> </tr> <tr> <td></td> <td>Fibre Optic</td> <td></td> <td></td> </tr> <tr> <td></td> <td>Pipe Cable</td> <td></td> <td></td> </tr> </tbody> </table> <p>WARNING There may have been subsequent alteration to the surface levels. Trial holes must be undertaken to determine position and depths of cables. HS (G) 47 Booklet from the Health and Safety Executive - Avoiding Danger from Buried Cables - should be consulted before commencing excavation work. WHEN WORKING IN THE VICINITY OF OVERHEAD LINES THE HEALTH AND SAFETY GUIDANCE NOTES G56 SHOULD BE CONSULTED (AVAILABLE FROM THE HSE WEBSITE)</p>	Legend		Distribution Structures (Electric)			Service Cable		Pole, Existing Location		LV Mains		Pole Structure, Existing Location - Single		2 - 11kV		Pole Structure, Existing Location - H		66kV		Duct Route		11kV		Cross Section Route		22kV				33kV				66kV				132kV				275kV				400kV				Fibre Optic				Pipe Cable			<p style="text-align: center;">Southern Electric Power Distribution plc Registered Office: No.1 Forbury Place 43 Forbury Road Reading RG1 3JH Registered In England & Wales No.04094290</p> <p>If you're unsure & need to seek advice before commencing excavations, please contact: General Enquiries: 0800 048 3516</p> <p>Subject to revision - Master held by SSEN Asset Data Team: Asset.Data@sse.com 01256 337 294</p>
Voltages (V)	
LV (Low Voltage) and Services	Up to 1,000V	
HV (High Voltage)	Over 1,000V to 11,000V	
EHV (Extra High Voltage)	22,000V to 132,000V	
Transmission	275,000V and 400,000V	
NORMAL DEPTH TO THE TOP OF THE CABLE WHEN LAID	
Services	LV	HV	EHV	
Footpath/Unmade	0.45m	0.45m	0.8m	
Road Crossing	0.6m	0.6m	0.9m	
Agricultural	1m	1m	1.1m	
Legend		Distribution Structures (Electric)	
	Service Cable		Pole, Existing Location	
	LV Mains		Pole Structure, Existing Location - Single	
	2 - 11kV		Pole Structure, Existing Location - H	
	66kV		Duct Route	
	11kV		Cross Section Route	
	22kV	
	33kV	
	66kV	
	132kV	
	275kV	
	400kV	
	Fibre Optic	
	Pipe Cable	

BASED UPON THE ORDNANCE SURVEY MAP WITH THE SANCTION OF THE CONTROLLER OF H.M. STATIONERY OFFICE CROWN COPYRIGHT RESERVED.
 This copy has been made by or with the authority of Scottish and Southern Energy Power Distribution Ltd. Pursuant to section 47 of the Copyright, Designs and Patents Act 1988 ("The Act"). Unless the Act provides a relevant exception to copyright the copy must not be copied without prior permission of the copyright owner.
 Plans generated by DigSAFE Pro™ software provided by LinesearchbeforeUdig.

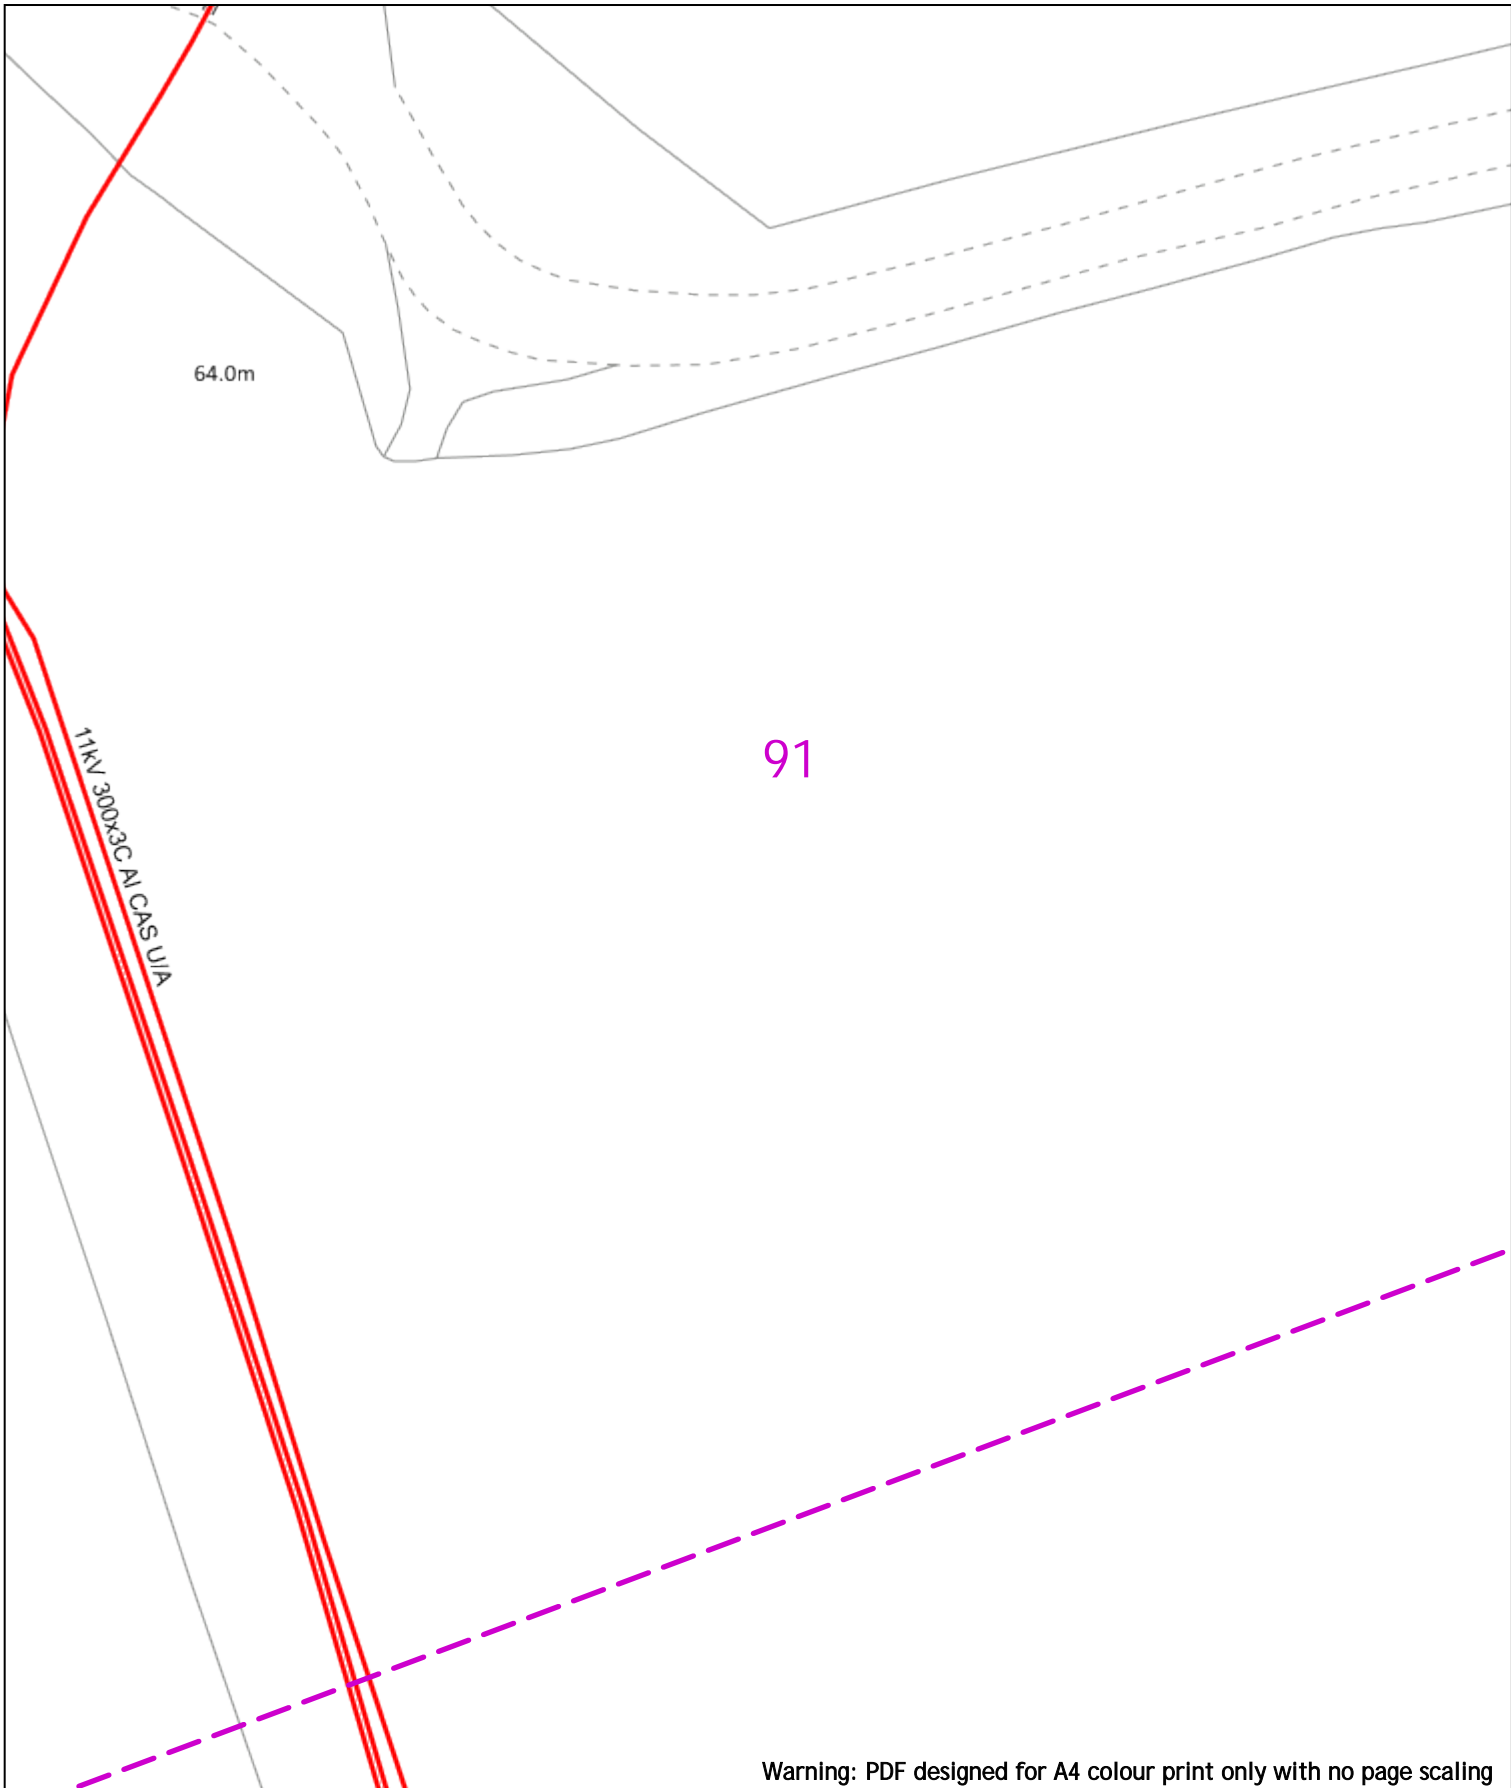

Warning: PDF designed for A4 colour print only with no page scaling

<p>0 20m</p>	<p>Dig Sites Area: Line: </p>	<p>Extra High Voltage cables in vicinity</p>																																	
<p>Date Requested: 24/06/2022 Job Reference: 25881010 Site Location: 448066 213346 Requested by: Mr Joe Shawyer Your Scheme/Reference: 31188_002</p>	<p>Voltages (V)</p> <table border="1"> <tr> <td>LV (Low Voltage) and Services</td> <td colspan="3">Up to 1,000V</td> </tr> <tr> <td>HV (High Voltage)</td> <td colspan="3">Over 1,000V to 11,000V</td> </tr> <tr> <td>EHV (Extra High Voltage)</td> <td colspan="3">22,000V to 132,000V</td> </tr> <tr> <td>Transmission</td> <td colspan="3">275,000V and 400,000V</td> </tr> </table> <p>NORMAL DEPTH TO THE TOP OF THE CABLE WHEN LAID</p> <table border="1"> <thead> <tr> <th>Services</th> <th>LV</th> <th>HV</th> <th>EHV</th> </tr> </thead> <tbody> <tr> <td>Footpath/Unmade</td> <td>0.45m</td> <td>0.45m</td> <td>0.6m</td> </tr> <tr> <td>Road Crossing</td> <td>0.6m</td> <td>0.6m</td> <td>0.75m</td> </tr> <tr> <td>Agricultural</td> <td>1m</td> <td>1m</td> <td>1.1m</td> </tr> </tbody> </table>	LV (Low Voltage) and Services	Up to 1,000V			HV (High Voltage)	Over 1,000V to 11,000V			EHV (Extra High Voltage)	22,000V to 132,000V			Transmission	275,000V and 400,000V			Services	LV	HV	EHV	Footpath/Unmade	0.45m	0.45m	0.6m	Road Crossing	0.6m	0.6m	0.75m	Agricultural	1m	1m	1.1m	<p>Legend</p> <ul style="list-style-type: none"> Service Cable LV Mains 6.6kV 11kV 22kV 33kV 66kV 132kV 275kV 400kV Fibre Optic Pipe Cable <p>Distribution Structures (Electric)</p> <ul style="list-style-type: none"> Pole, Existing Location Pole Structure, Existing Location - Single Pole Structure, Existing Location - H Duct Route Cross Section Route 	<p>Southern Electric Power Distribution plc Registered Office: No.1 Forbury Place 43 Forbury Road Reading RG1 3JH Registered In England & Wales No.04094290</p> <p>If you're unsure & need to seek advice before commencing excavations, please contact: General Enquiries: 0800 048 3516</p> <p>Subject to revision – Master held by SSEN Asset Data Team: Asset.Data@sse.com 01256 337 294</p>
LV (Low Voltage) and Services	Up to 1,000V																																		
HV (High Voltage)	Over 1,000V to 11,000V																																		
EHV (Extra High Voltage)	22,000V to 132,000V																																		
Transmission	275,000V and 400,000V																																		
Services	LV	HV	EHV																																
Footpath/Unmade	0.45m	0.45m	0.6m																																
Road Crossing	0.6m	0.6m	0.75m																																
Agricultural	1m	1m	1.1m																																
<p>Scale: 1:500 (When plotted at A4)</p> <p><small>BASED UPON THE ORDNANCE SURVEY MAP WITH THE SANCTION OF THE CONTROLLER OF HM STATIONERY OFFICE CROWN COPYRIGHT RESERVED. This copy has been made by or with the authority of Scottish and Southern Energy Power Distribution Ltd. Pursuant to section 47 of the Copyright, Designs and Patents Act 1988 ("The Act"). Unless the Act provides a relevant exception to copyright the copy must not be copied without prior permission of the copyright owner. Plans generated by DigSAFE Pro™ software provided by LinesearchbeforeUdig.</small></p>																																			

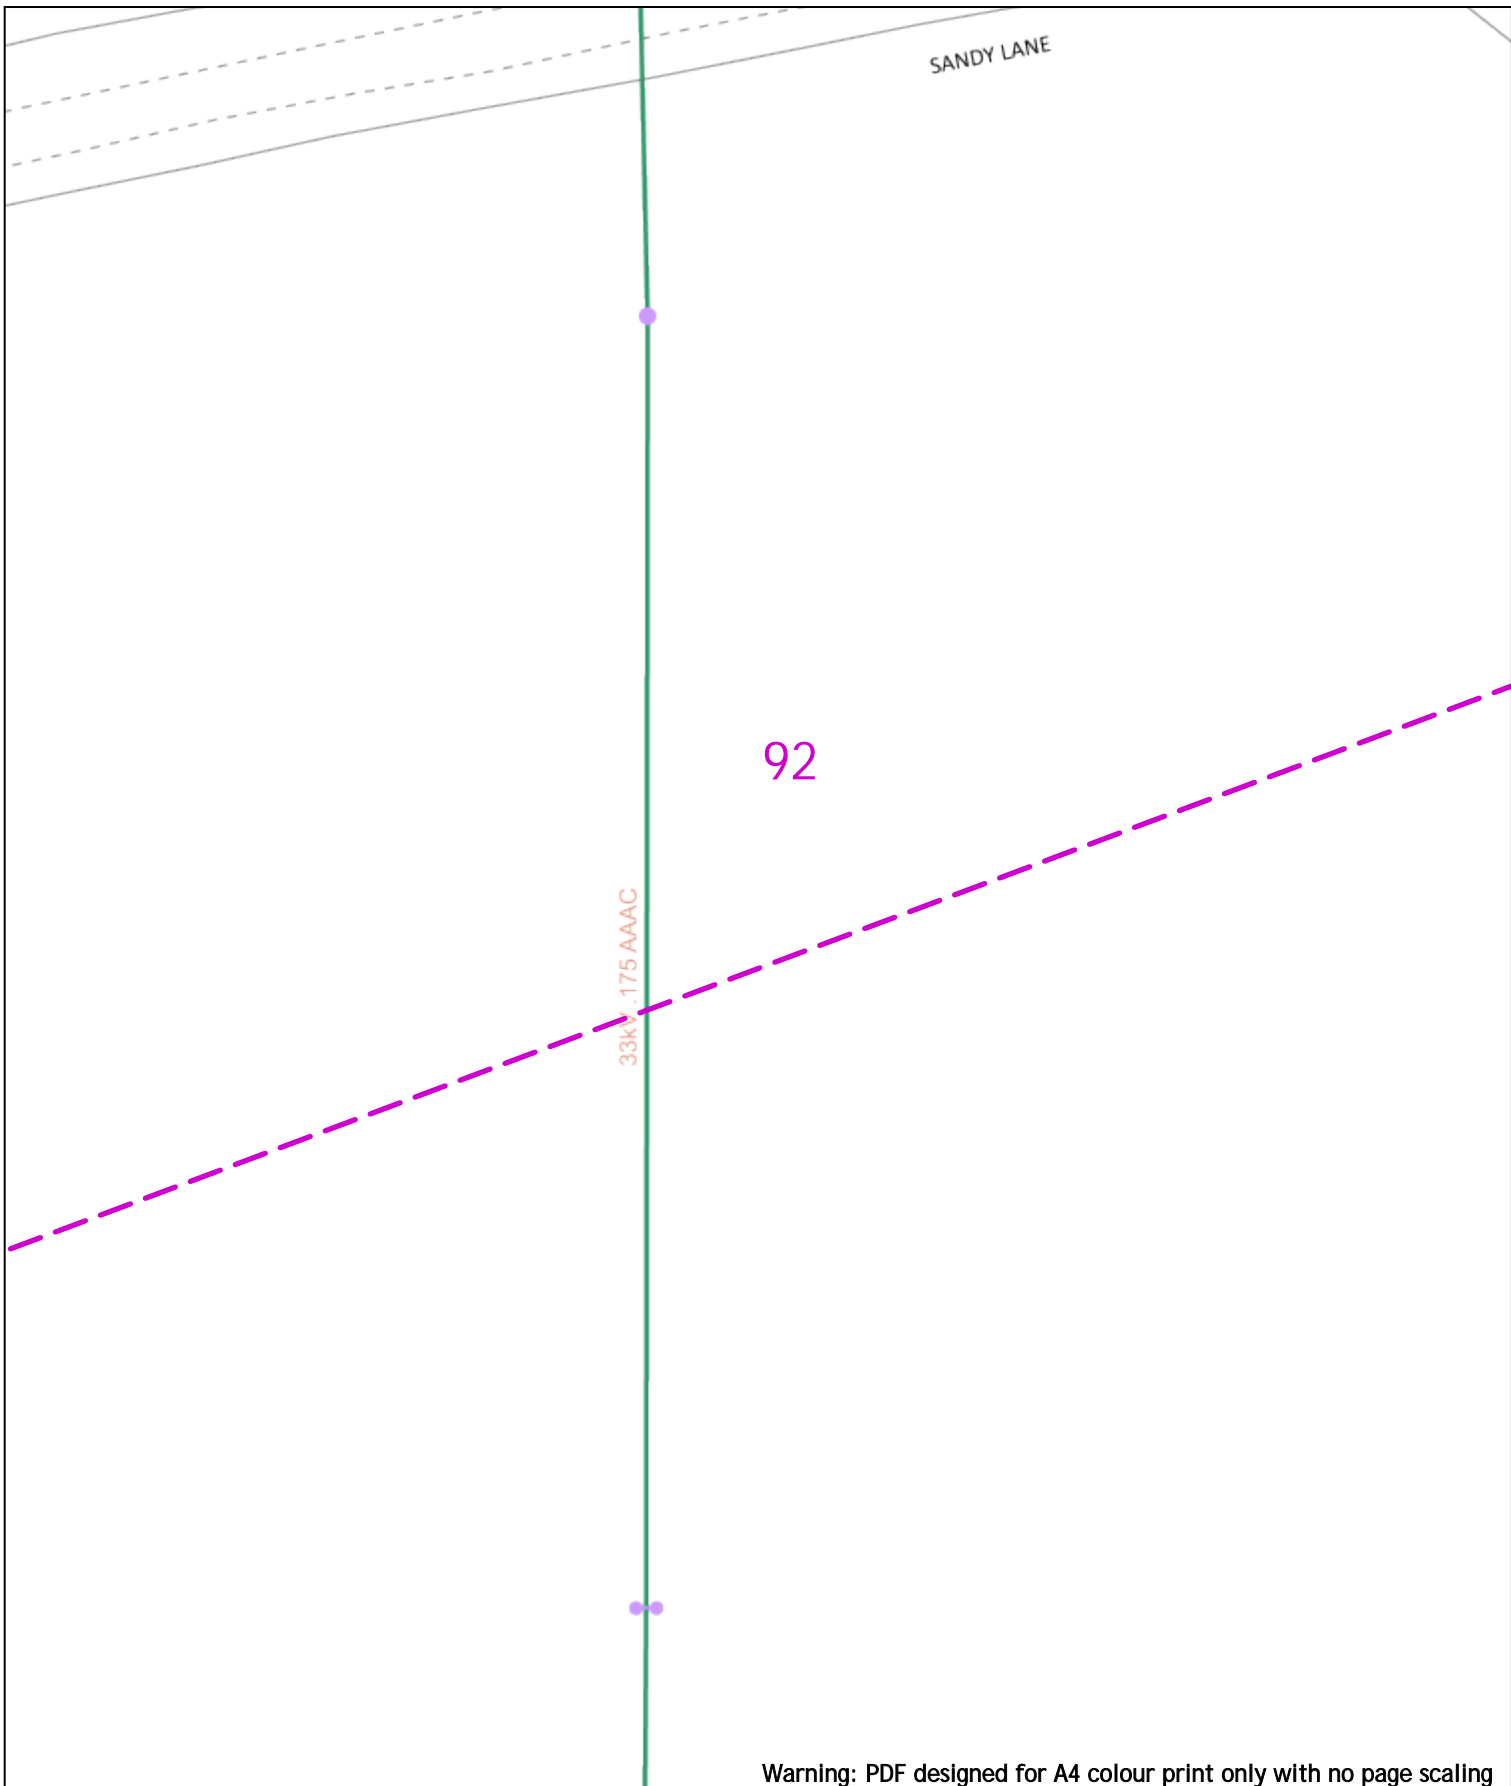

Warning: PDF designed for A4 colour print only with no page scaling



20m Dig Sites Area: Line:

Extra High Voltage cables in vicinity



Date Requested: 24/06/2022
 Job Reference: 25881010
 Site Location: 448066 213346
 Requested by: Mr Joe Shawyer
 Your Scheme/Reference: 31188_002

Voltages (V)			
LV (Low Voltage) and Services	Up to 1,000V		
HV (High Voltage)	Over 1,000V to 11,000V		
EHV (Extra High Voltage)	22,000V to 132,000V		
Transmission	275,000V and 400,000V		
NORMAL DEPTH TO THE TOP OF THE CABLE WHEN LAID			
Services	LV	HV	EHV
Footpath/Unmade	0.45m	0.45m	0.6m 0.8m
Road Crossing	0.6m	0.6m	0.75m 0.9m
Agricultural	1m	1m	1m 1.1m

Legend	
	Service Cable
	LV Mains
	2 - 11kV
	66kV
	11kV
	22kV
	33kV
	66kV
	132kV
	275kV
	400kV
	Fibre Optic
	Pipe Cable

Distribution Structures (Electric)	
	Pole, Existing Location
	Pole Structure, Existing Location - Single
	Pole Structure, Existing Location - H
	Duct Route
	Cross Section Route

Southern Electric Power Distribution plc
 Registered Office: No.1 Forbury Place
 43 Forbury Road Reading RG1 3JH
 Registered In England & Wales No.04094290


If you're unsure & need to seek advice before commencing excavations, please contact:
 General Enquiries: 0800 048 3516

Subject to revision – Master held by SSEN Asset Data Team:
Asset.Data@sse.com
 01256 337 294

Scale: 1:500 (When plotted at A4)

WARNING
 There may have been subsequent alteration to the surface levels. Trial holes must be undertaken to determine position and depths of cables. HS (G) 47 Booklet from the Health and Safety Executive – Avoiding Danger from Buried Cables – should be consulted before commencing excavation work.
 WHEN WORKING IN THE VICINITY OF OVERHEAD LINES THE HEALTH AND SAFETY GUIDANCE NOTES G56 SHOULD BE CONSULTED (AVAILABLE FROM THE HSE WEBSITE)

BASED UPON THE ORDNANCE SURVEY MAP WITH THE SANCTION OF THE CONTROLLER OF HM STATIONERY OFFICE CROWN COPYRIGHT RESERVED.
 This copy has been made by or with the authority of Scottish and Southern Energy Power Distribution Ltd. Pursuant to section 47 of the Copyright, Designs and Patents Act 1988 ("The Act"). Unless the Act provides a relevant exception to copyright the copy must not be copied without prior permission of the copyright owner.
 Plans generated by DigSAFE Pro™ software provided by LinesearchbeforeDig.

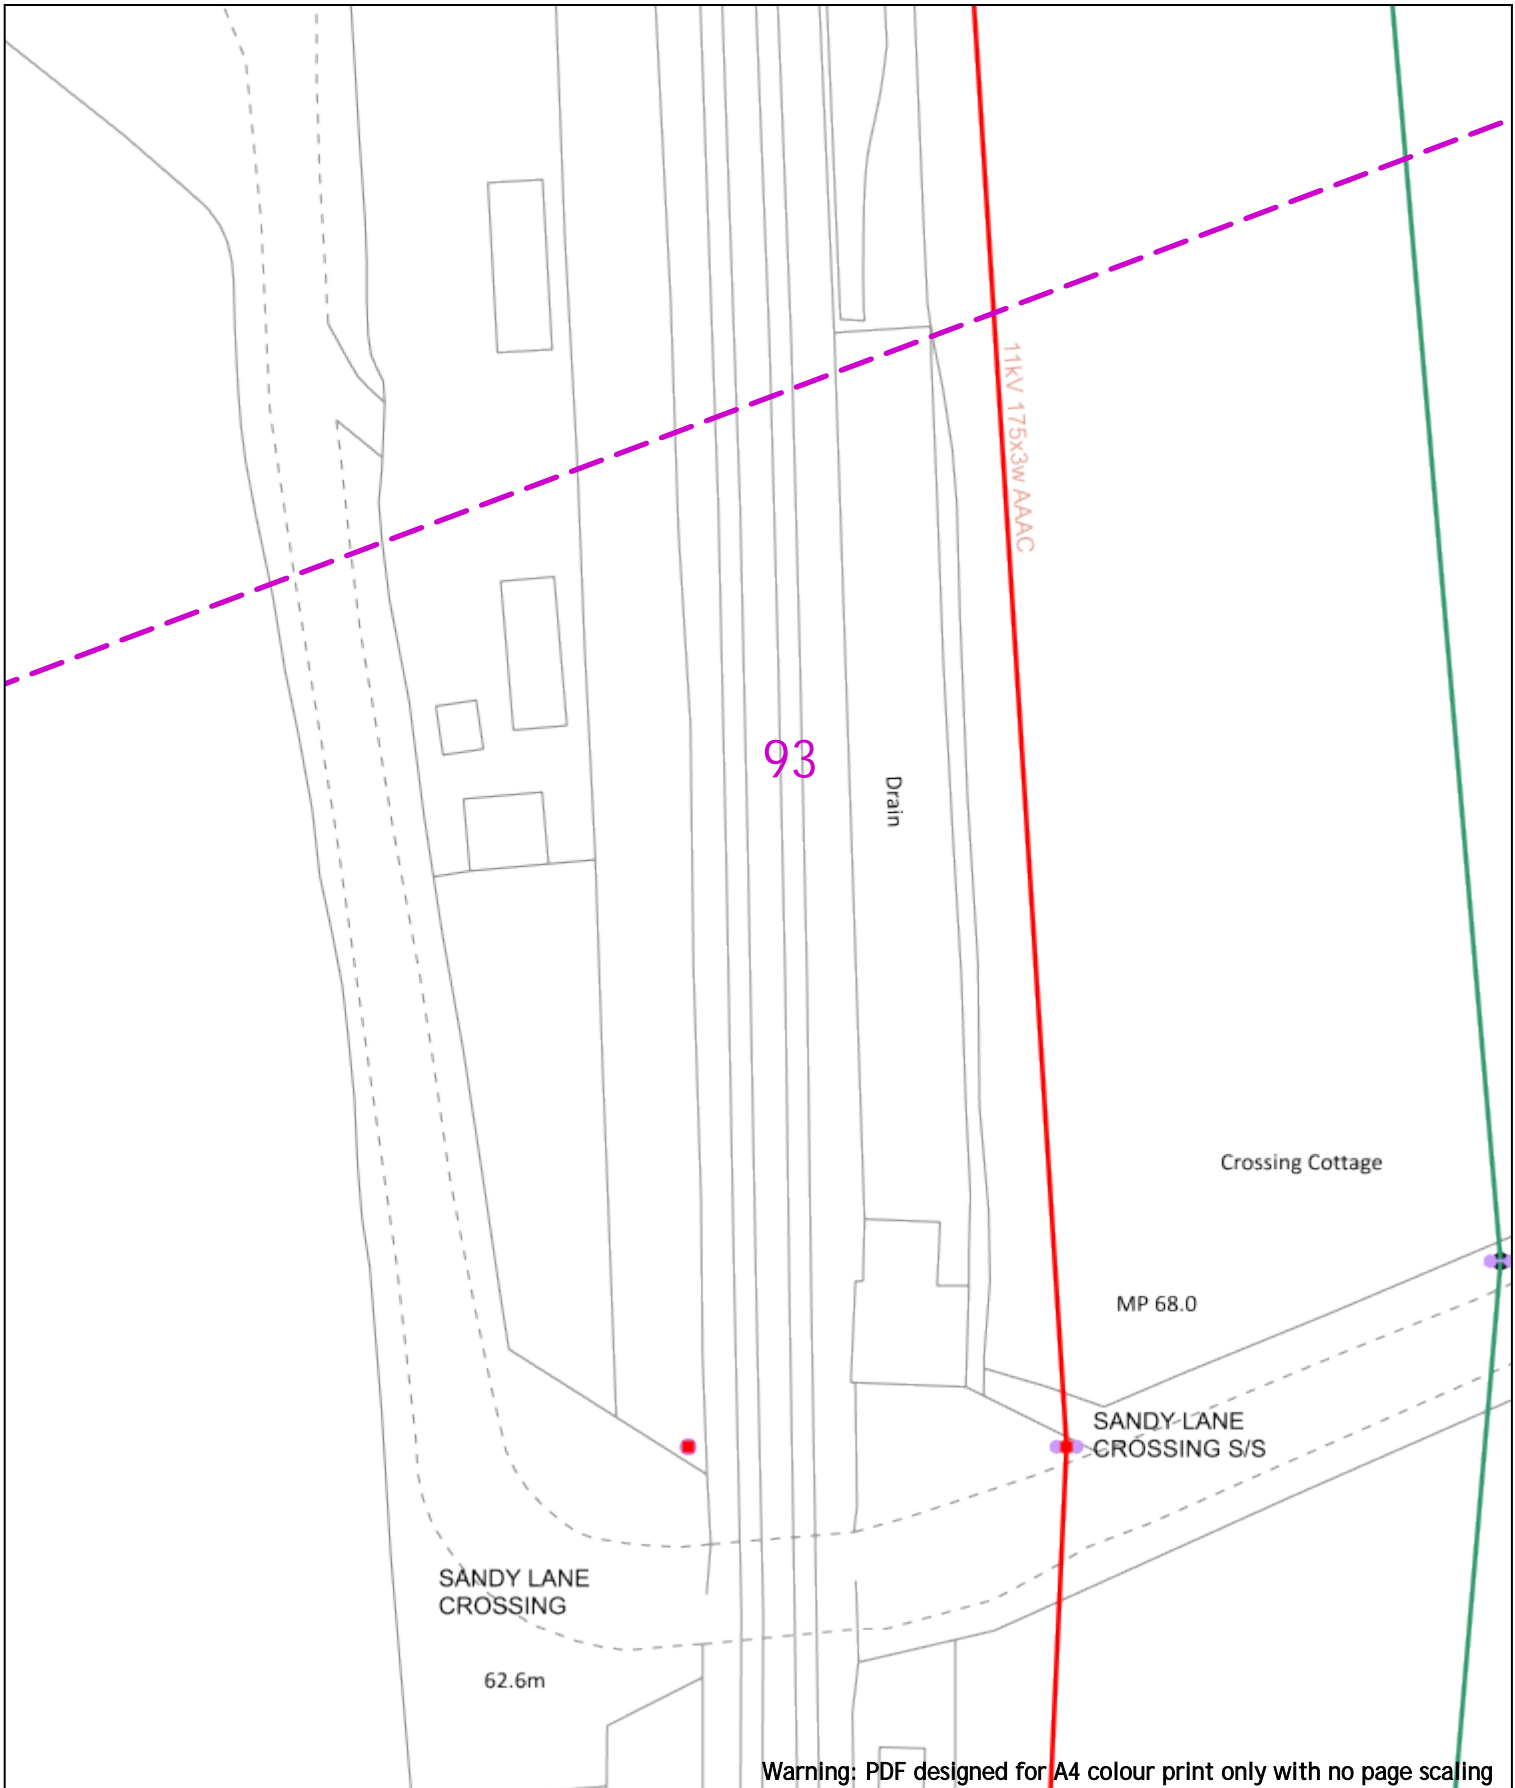

Warning: PDF designed for A4 colour print only with no page scaling

0 20m

Dig Sites: Area: Line:

Extra High Voltage cables in vicinity

Date Requested: 24/06/2022
 Job Reference: 25881010
 Site Location: 448066 213346
 Requested by: Mr Joe Shawyer
 Your Scheme/Reference: 31188_002

Voltages (V)			
LV (Low Voltage) and Services	Up to 1,000V		
HV (High Voltage)	Over 1,000V to 11,000V		
EHV (Extra High Voltage)	22,000V to 132,000V		
Transmission	275,000V and 400,000V		

NORMAL DEPTH TO THE TOP OF THE CABLE WHEN LAID			
Services	LV	HV	EHV
Footpath/Unmade	0.45m	0.45m	0.6m
Road Crossing	0.6m	0.6m	0.75m
Agricultural	1m	1m	1.1m

Legend	
	Service Cable
	LV Mains
	2 - 11kV
	66kV
	11kV
	22kV
	33kV
	66kV
	132kV
	275kV
	400kV
	Fibre Optic
	Pipe Cable

Distribution Structures (Electric)	
	Pole, Existing Location
	Pole Structure, Existing Location - Single
	Pole Structure, Existing Location - H
	Duct Route
	Cross Section Route

Southern Electric Power Distribution plc
 Registered Office: No.1 Forbury Place
 43 Forbury Road Reading RG1 3JH
 Registered In England & Wales No.04094290


If you're unsure & need to seek advice before commencing excavations, please contact:
 General Enquiries: 0800 048 3516

Subject to revision – Master held by SSEN Asset Data Team:
Asset.Data@sse.com
 01256 337 294

Scale: 1:500 (When plotted at A4)

WARNING
 There may have been subsequent alteration to the surface levels. Trial holes must be undertaken to determine position and depths of cables. HS (G) 47 Booklet from the Health and Safety Executive – Avoiding Danger from Buried Cables – should be consulted before commencing excavation work.
 WHEN WORKING IN THE VICINITY OF OVERHEAD LINES THE HEALTH AND SAFETY GUIDANCE NOTES G56 SHOULD BE CONSULTED (AVAILABLE FROM THE HSE WEBSITE)

BASED UPON THE ORDNANCE SURVEY MAP WITH THE SANCTION OF THE CONTROLLER OF HM STATIONERY OFFICE CROWN COPYRIGHT RESERVED.
 This copy has been made by or with the authority of Scottish and Southern Energy Power Distribution Ltd. Pursuant to section 47 of the Copyright, Designs and Patents Act 1988 ("The Act"). Unless the Act provides a relevant exception to copyright the copy must not be copied without prior permission of the copyright owner.
 Plans generated by DigSAFE Pro™ software provided by LinesearchbeforeDig.

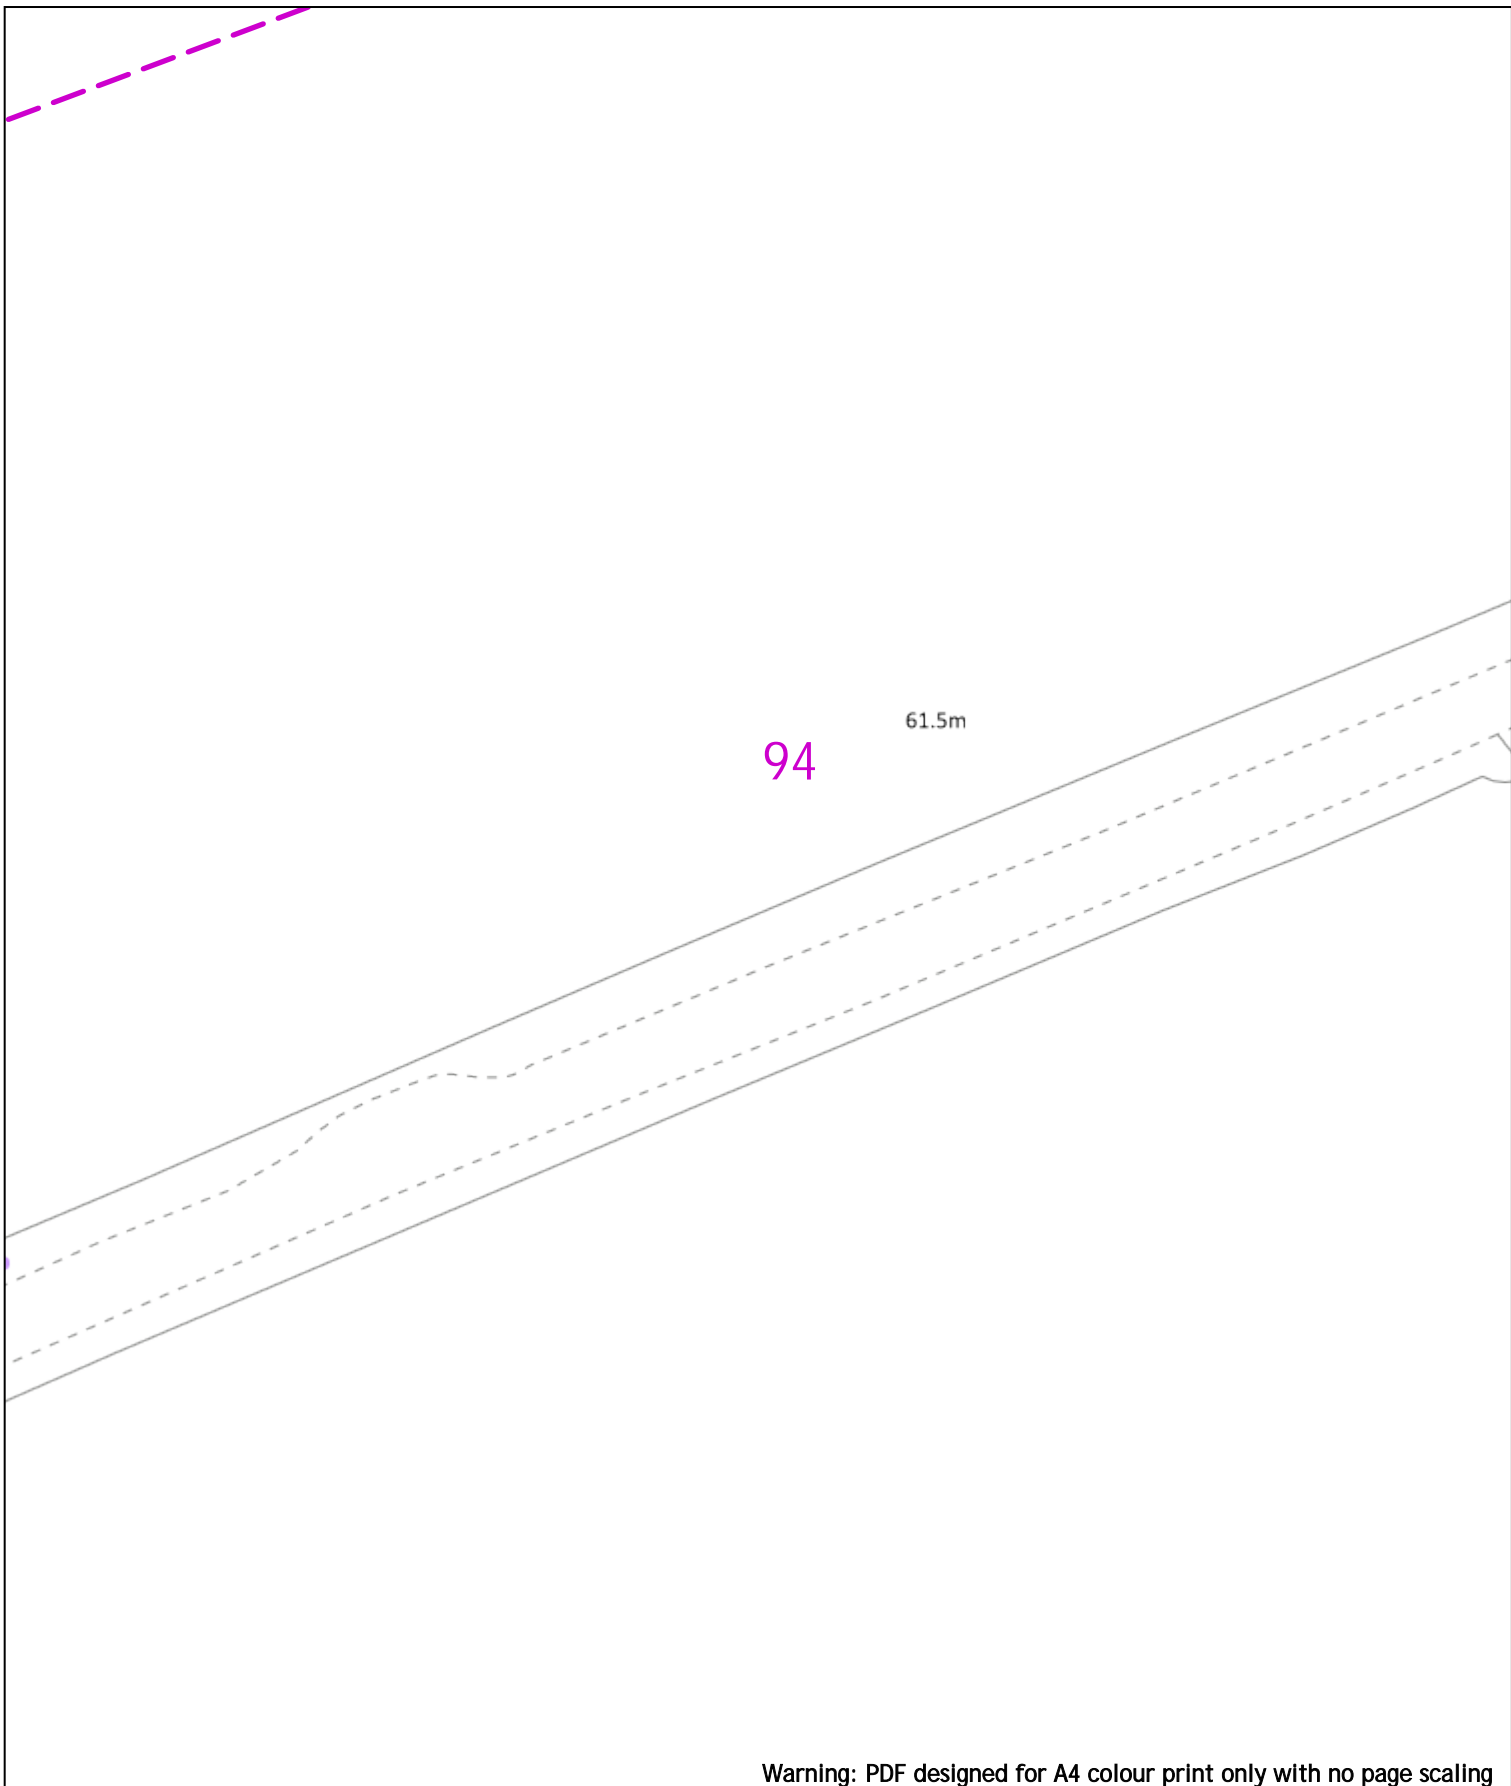

Warning: PDF designed for A4 colour print only with no page scaling



Dig Sites Area: Line:

Extra High Voltage cables in vicinity



Date Requested: 24/06/2022
 Job Reference: 25881010
 Site Location: 448066 213346
 Requested by: Mr Joe Shawyer
 Your Scheme/Reference: 31188_002

Voltages (V)			
LV (Low Voltage) and Services	Up to 1,000V		
HV (High Voltage)	Over 1,000V to 11,000V		
EHV (Extra High Voltage)	22,000V to 132,000V		
Transmission	275,000V and 400,000V		
NORMAL DEPTH TO THE TOP OF THE CABLE WHEN LAID			
Services	LV	HV	EHV
Footpath/Unmade	0.45m	0.45m	0.6m 0.8m
Road Crossing	0.6m	0.6m	0.75m 0.9m
Agricultural	1m	1m	1m 1.1m

Legend	
	Service Cable
	LV Mains
	2 - 11kV
	66kV
	275kV
	400kV
	Fibre Optic
	Pipe Cable

Distribution Structures (Electric)	
	Pole, Existing Location
	Pole Structure, Existing Location - Single
	Pole Structure, Existing Location - H
	Duct Route
	Cross Section Route


Southern Electric Power Distribution plc
 Registered Office: No.1 Forbury Place
 43 Forbury Road Reading RG1 3JH
 Registered In England & Wales No.04094290

If you're unsure & need to seek advice before commencing excavations, please contact:
 General Enquiries: 0800 048 3516

Scale: 1:500 (When plotted at A4)


WARNING
 There may have been subsequent alteration to the surface levels. Trial holes must be undertaken to determine position and depths of cables. HS (G) 47 Booklet from the Health and Safety Executive - Avoiding Danger from Buried Cables - should be consulted before commencing excavation work.
WHEN WORKING IN THE VICINITY OF OVERHEAD LINES THE HEALTH AND SAFETY GUIDANCE NOTES G56 SHOULD BE CONSULTED (AVAILABLE FROM THE HSE WEBSITE)

Subject to revision - Master held by SSEN Asset Data Team:
Asset.Data@sse.com
 01256 337 294

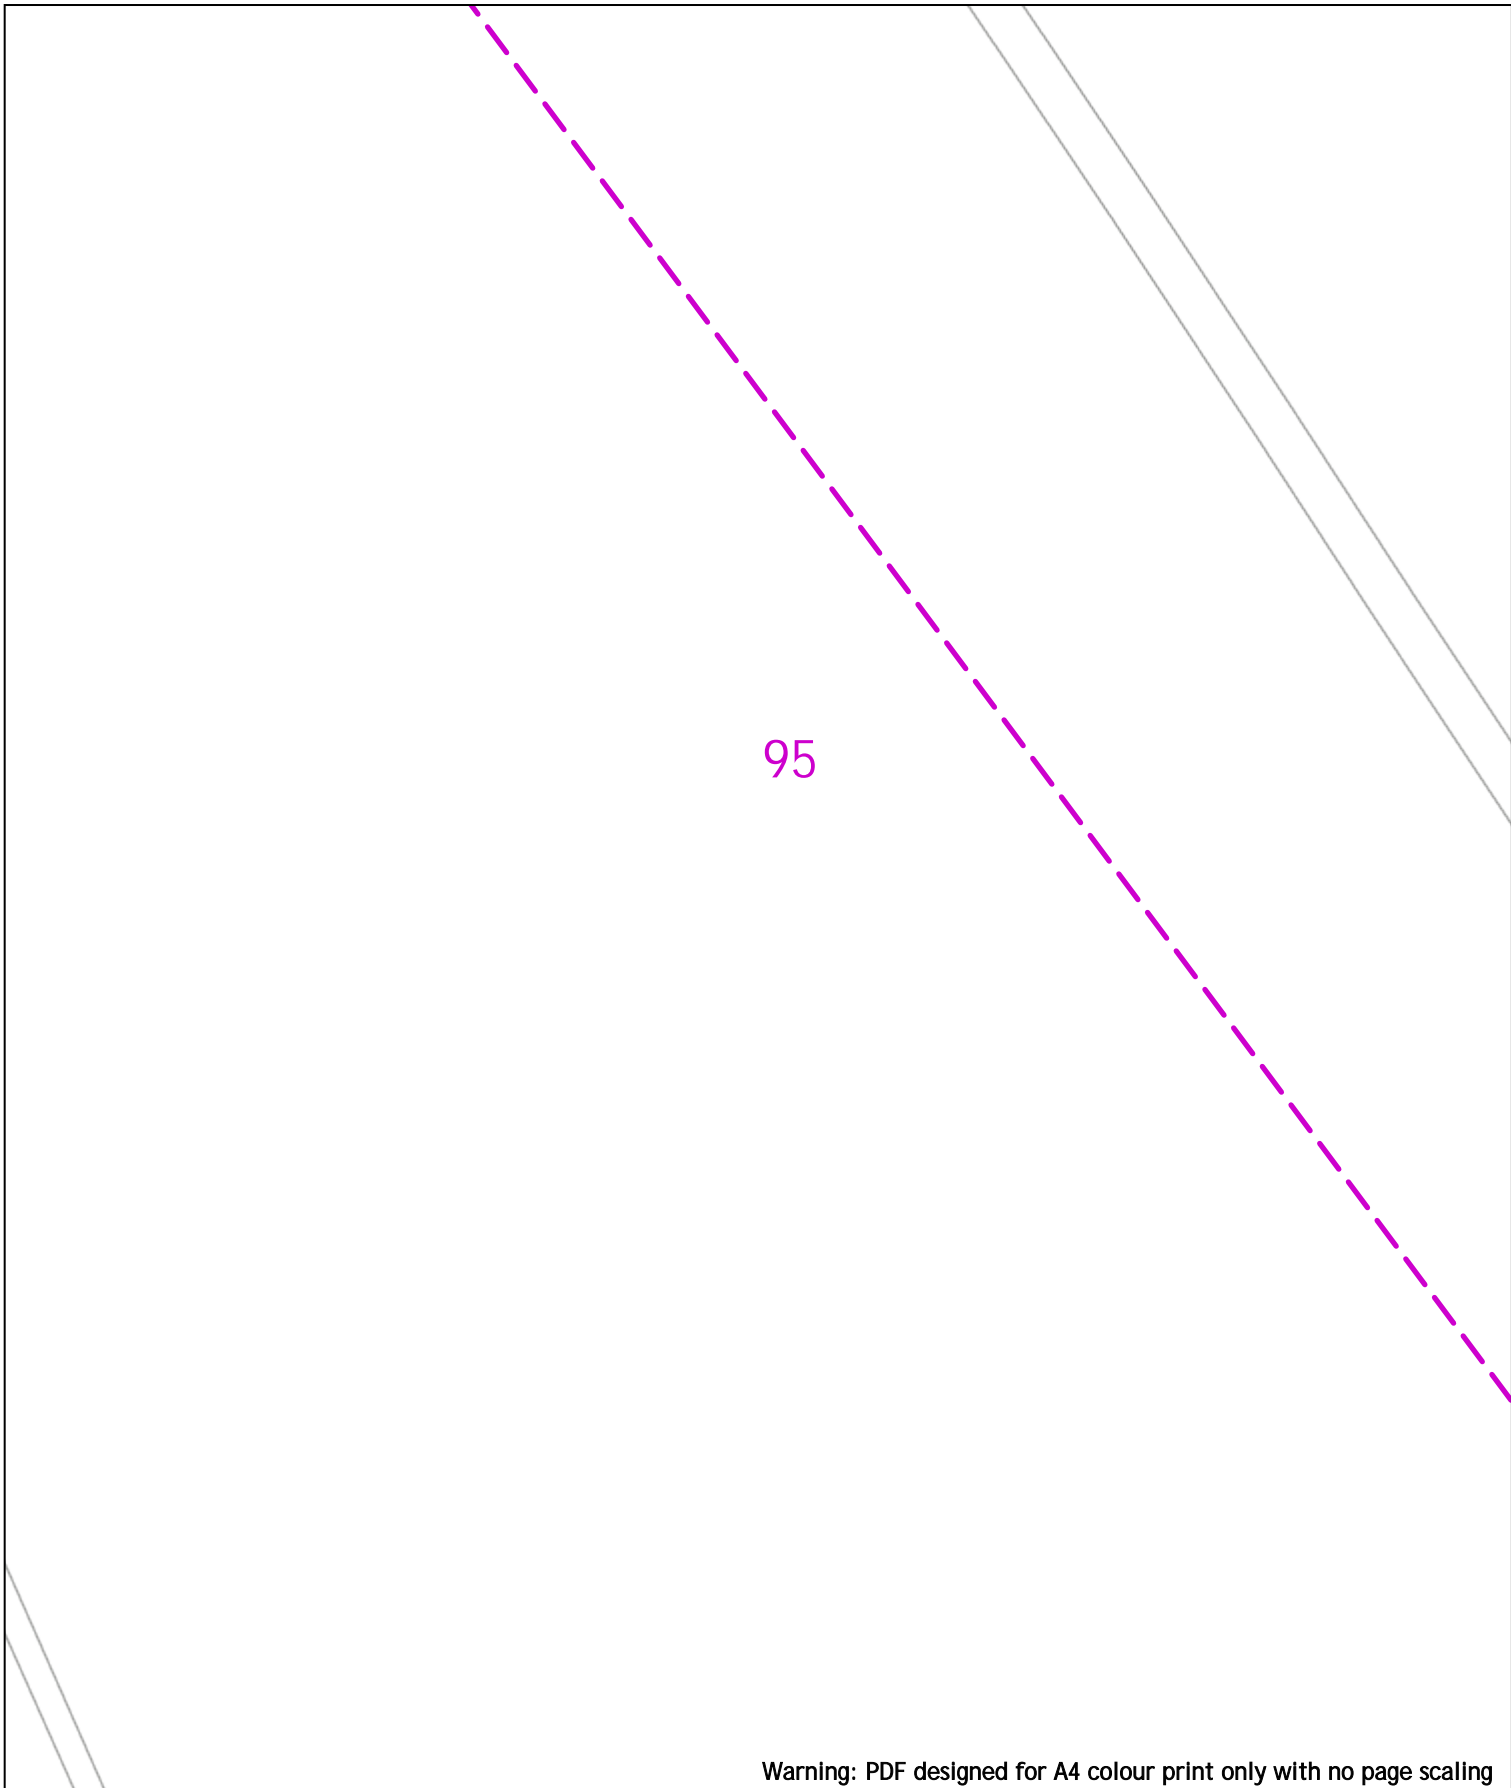


Warning: PDF designed for A4 colour print only with no page scaling

<p>0 20m Dig Sites Area: Line: </p>	<p>Extra High Voltage cables in vicinity</p>																																		
<p>Date Requested: 24/06/2022 Job Reference: 25881010 Site Location: 448066 213346 Requested by: Mr Joe Shawyer Your Scheme/Reference: 31188_002</p>	<p>Voltages (V)</p> <table border="1"> <tr> <td>LV (Low Voltage) and Services</td> <td colspan="3">Up to 1,000V</td> </tr> <tr> <td>HV (High Voltage)</td> <td colspan="3">Over 1,000V to 11,000V</td> </tr> <tr> <td>EHV (Extra High Voltage)</td> <td colspan="3">22,000V to 132,000V</td> </tr> <tr> <td>Transmission</td> <td colspan="3">275,000V and 400,000V</td> </tr> </table> <p>NORMAL DEPTH TO THE TOP OF THE CABLE WHEN LAID</p> <table border="1"> <thead> <tr> <th>Services</th> <th>LV</th> <th>HV</th> <th>EHV</th> </tr> </thead> <tbody> <tr> <td>Footpath/Unmade</td> <td>0.45m</td> <td>0.45m</td> <td>0.6m 0.8m</td> </tr> <tr> <td>Road Crossing</td> <td>0.6m</td> <td>0.6m</td> <td>0.75m 0.9m</td> </tr> <tr> <td>Agricultural</td> <td>1m</td> <td>1m</td> <td>1m 1.1m</td> </tr> </tbody> </table>	LV (Low Voltage) and Services	Up to 1,000V			HV (High Voltage)	Over 1,000V to 11,000V			EHV (Extra High Voltage)	22,000V to 132,000V			Transmission	275,000V and 400,000V			Services	LV	HV	EHV	Footpath/Unmade	0.45m	0.45m	0.6m 0.8m	Road Crossing	0.6m	0.6m	0.75m 0.9m	Agricultural	1m	1m	1m 1.1m	<p>Legend</p> <ul style="list-style-type: none"> Service Cable LV Mains 2 - 11kV 66kV 11kV 22kV 33kV 66kV 132kV 275kV 400kV Fibre Optic Pipe Cable <p>Distribution Structures (Electric)</p> <ul style="list-style-type: none"> Pole, Existing Location Pole Structure, Existing Location - Single Pole Structure, Existing Location - H Duct Route Cross Section Route <p>WARNING</p> <p>There may have been subsequent alteration to the surface levels. Trial holes must be undertaken to determine position and depths of cables. HS (G) 47 Booklet from the Health and Safety Executive - Avoiding Danger from Buried Cables - should be consulted before commencing excavation work.</p> <p>WHEN WORKING IN THE VICINITY OF OVERHEAD LINES THE HEALTH AND SAFETY GUIDANCE NOTES G56 SHOULD BE CONSULTED (AVAILABLE FROM THE HSE WEBSITE)</p>	<p>Southern Electric Power Distribution plc Registered Office: No.1 Forbury Place 43 Forbury Road Reading RG1 3JH Registered In England & Wales No.04094290</p> <p>If you're unsure & need to seek advice before commencing excavations, please contact: General Enquiries: 0800 048 3516</p> <p>Subject to revision - Master held by SSEN Asset Data Team: Asset.Data@sse.com 01256 337 294</p>
LV (Low Voltage) and Services	Up to 1,000V																																		
HV (High Voltage)	Over 1,000V to 11,000V																																		
EHV (Extra High Voltage)	22,000V to 132,000V																																		
Transmission	275,000V and 400,000V																																		
Services	LV	HV	EHV																																
Footpath/Unmade	0.45m	0.45m	0.6m 0.8m																																
Road Crossing	0.6m	0.6m	0.75m 0.9m																																
Agricultural	1m	1m	1m 1.1m																																
<p>BASED UPON THE ORDNANCE SURVEY MAP WITH THE SANCTION OF THE CONTROLLER OF HM STATIONERY OFFICE CROWN COPYRIGHT RESERVED. This copy has been made by or with the authority of Scottish and Southern Energy Power Distribution Ltd. Pursuant to section 47 of the Copyright, Designs and Patents Act 1988 ("The Act"). Unless the Act provides a relevant exception to copyright the copy must not be copied without prior permission of the copyright owner. Plans generated by DigSAFE Pro™ software provided by Linestechbefore066.</p>																																			

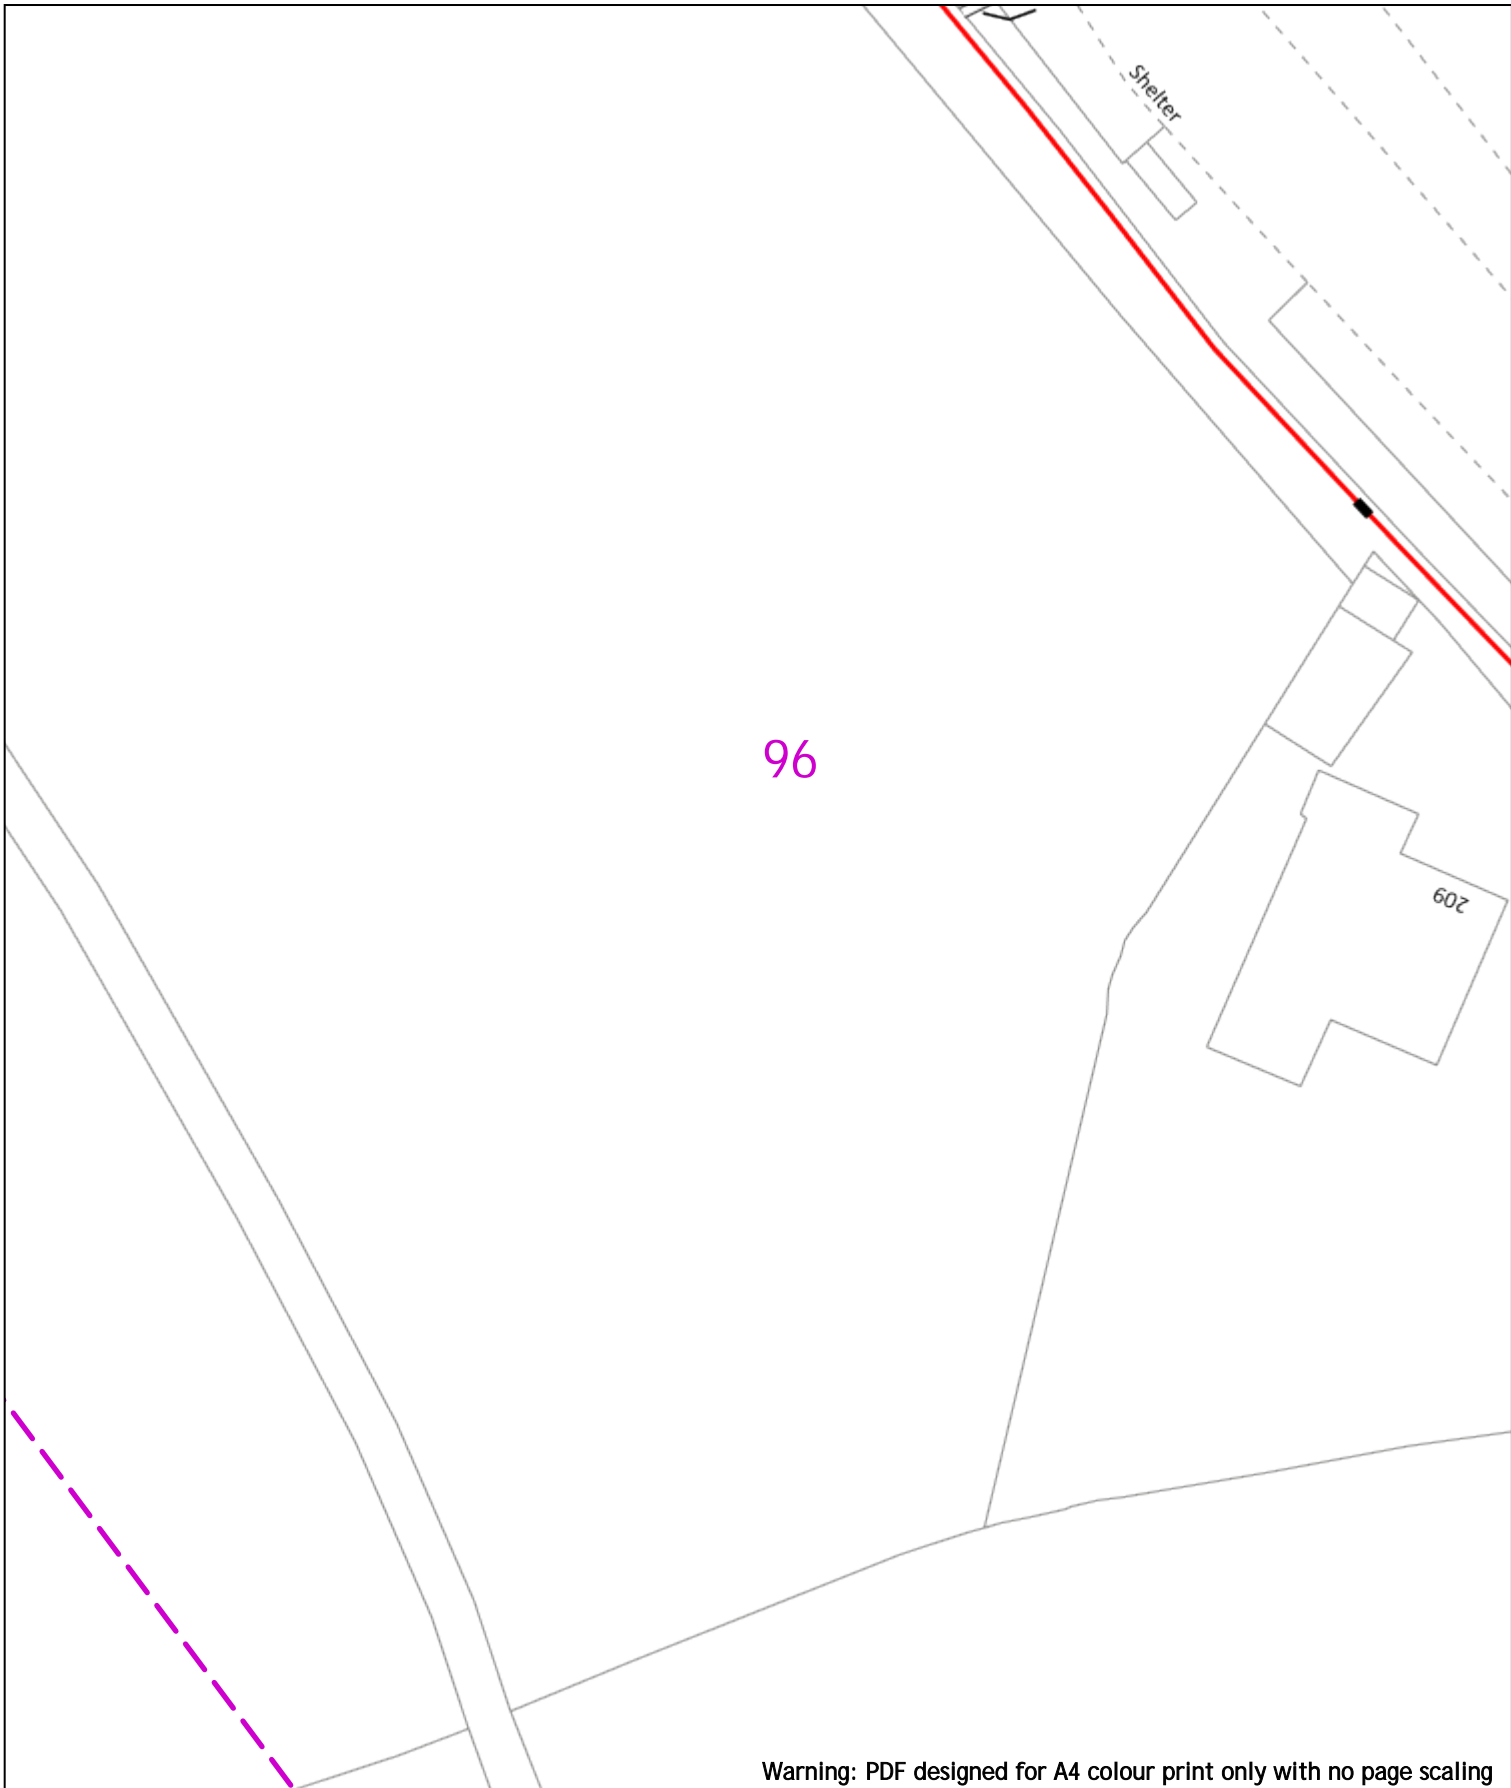

Warning: PDF designed for A4 colour print only with no page scaling

<p>0 20m</p> <p>Date Requested: 24/06/2022 Job Reference: 25881010 Site Location: 448066 213346 Requested by: Mr Joe Shawyer Your Scheme/Reference: 31188_002</p>	<p>Dig Sites Area: Line: </p> <p>Extra High Voltage cables in vicinity</p>																																	
<p>Scale: 1:500 (When plotted at A4)</p>	<p>Voltagess (V)</p> <table border="1" style="width: 100%; border-collapse: collapse;"> <tr> <td>LV (Low Voltage) and Services</td> <td colspan="3">Up to 1,000V</td> </tr> <tr> <td>HV (High Voltage)</td> <td colspan="3">Over 1,000V to 11,000V</td> </tr> <tr> <td>EHV (Extra High Voltage)</td> <td colspan="3">22,000V to 132,000V</td> </tr> <tr> <td>Transmission</td> <td colspan="3">275,000V and 400,000V</td> </tr> </table> <p>NORMAL DEPTH TO THE TOP OF THE CABLE WHEN LAID</p> <table border="1" style="width: 100%; border-collapse: collapse;"> <thead> <tr> <th>Services</th> <th>LV</th> <th>HV</th> <th>EHV</th> </tr> </thead> <tbody> <tr> <td>Footpath/Unmade</td> <td>0.45m</td> <td>0.45m</td> <td>0.6m</td> </tr> <tr> <td>Road Crossing</td> <td>0.6m</td> <td>0.6m</td> <td>0.75m</td> </tr> <tr> <td>Agricultural</td> <td>1m</td> <td>1m</td> <td>1.1m</td> </tr> </tbody> </table> <p>WARNING There may have been subsequent alteration to the surface levels. Trial holes must be undertaken to determine position and depths of cables. HS (G) 47 Booklet from the Health and Safety Executive – Avoiding Danger from Buried Cables – should be consulted before commencing excavation work. WHEN WORKING IN THE VICINITY OF OVERHEAD LINES THE HEALTH AND SAFETY GUIDANCE NOTES G56 SHOULD BE CONSULTED (AVAILABLE FROM THE HSE WEBSITE)</p>	LV (Low Voltage) and Services	Up to 1,000V			HV (High Voltage)	Over 1,000V to 11,000V			EHV (Extra High Voltage)	22,000V to 132,000V			Transmission	275,000V and 400,000V			Services	LV	HV	EHV	Footpath/Unmade	0.45m	0.45m	0.6m	Road Crossing	0.6m	0.6m	0.75m	Agricultural	1m	1m	1.1m	<p>Southern Electric Power Distribution plc Registered Office: No.1 Forbury Place 43 Forbury Road Reading RG1 3JH Registered In England & Wales No.04094290</p> <p>If you're unsure & need to seek advice before commencing excavations, please contact: General Enquiries: 0800 048 3516</p> <p>Subject to revision – Master held by SSEN Asset Data Team: Asset.Data@sse.com 01256 337 294</p>
LV (Low Voltage) and Services	Up to 1,000V																																	
HV (High Voltage)	Over 1,000V to 11,000V																																	
EHV (Extra High Voltage)	22,000V to 132,000V																																	
Transmission	275,000V and 400,000V																																	
Services	LV	HV	EHV																															
Footpath/Unmade	0.45m	0.45m	0.6m																															
Road Crossing	0.6m	0.6m	0.75m																															
Agricultural	1m	1m	1.1m																															

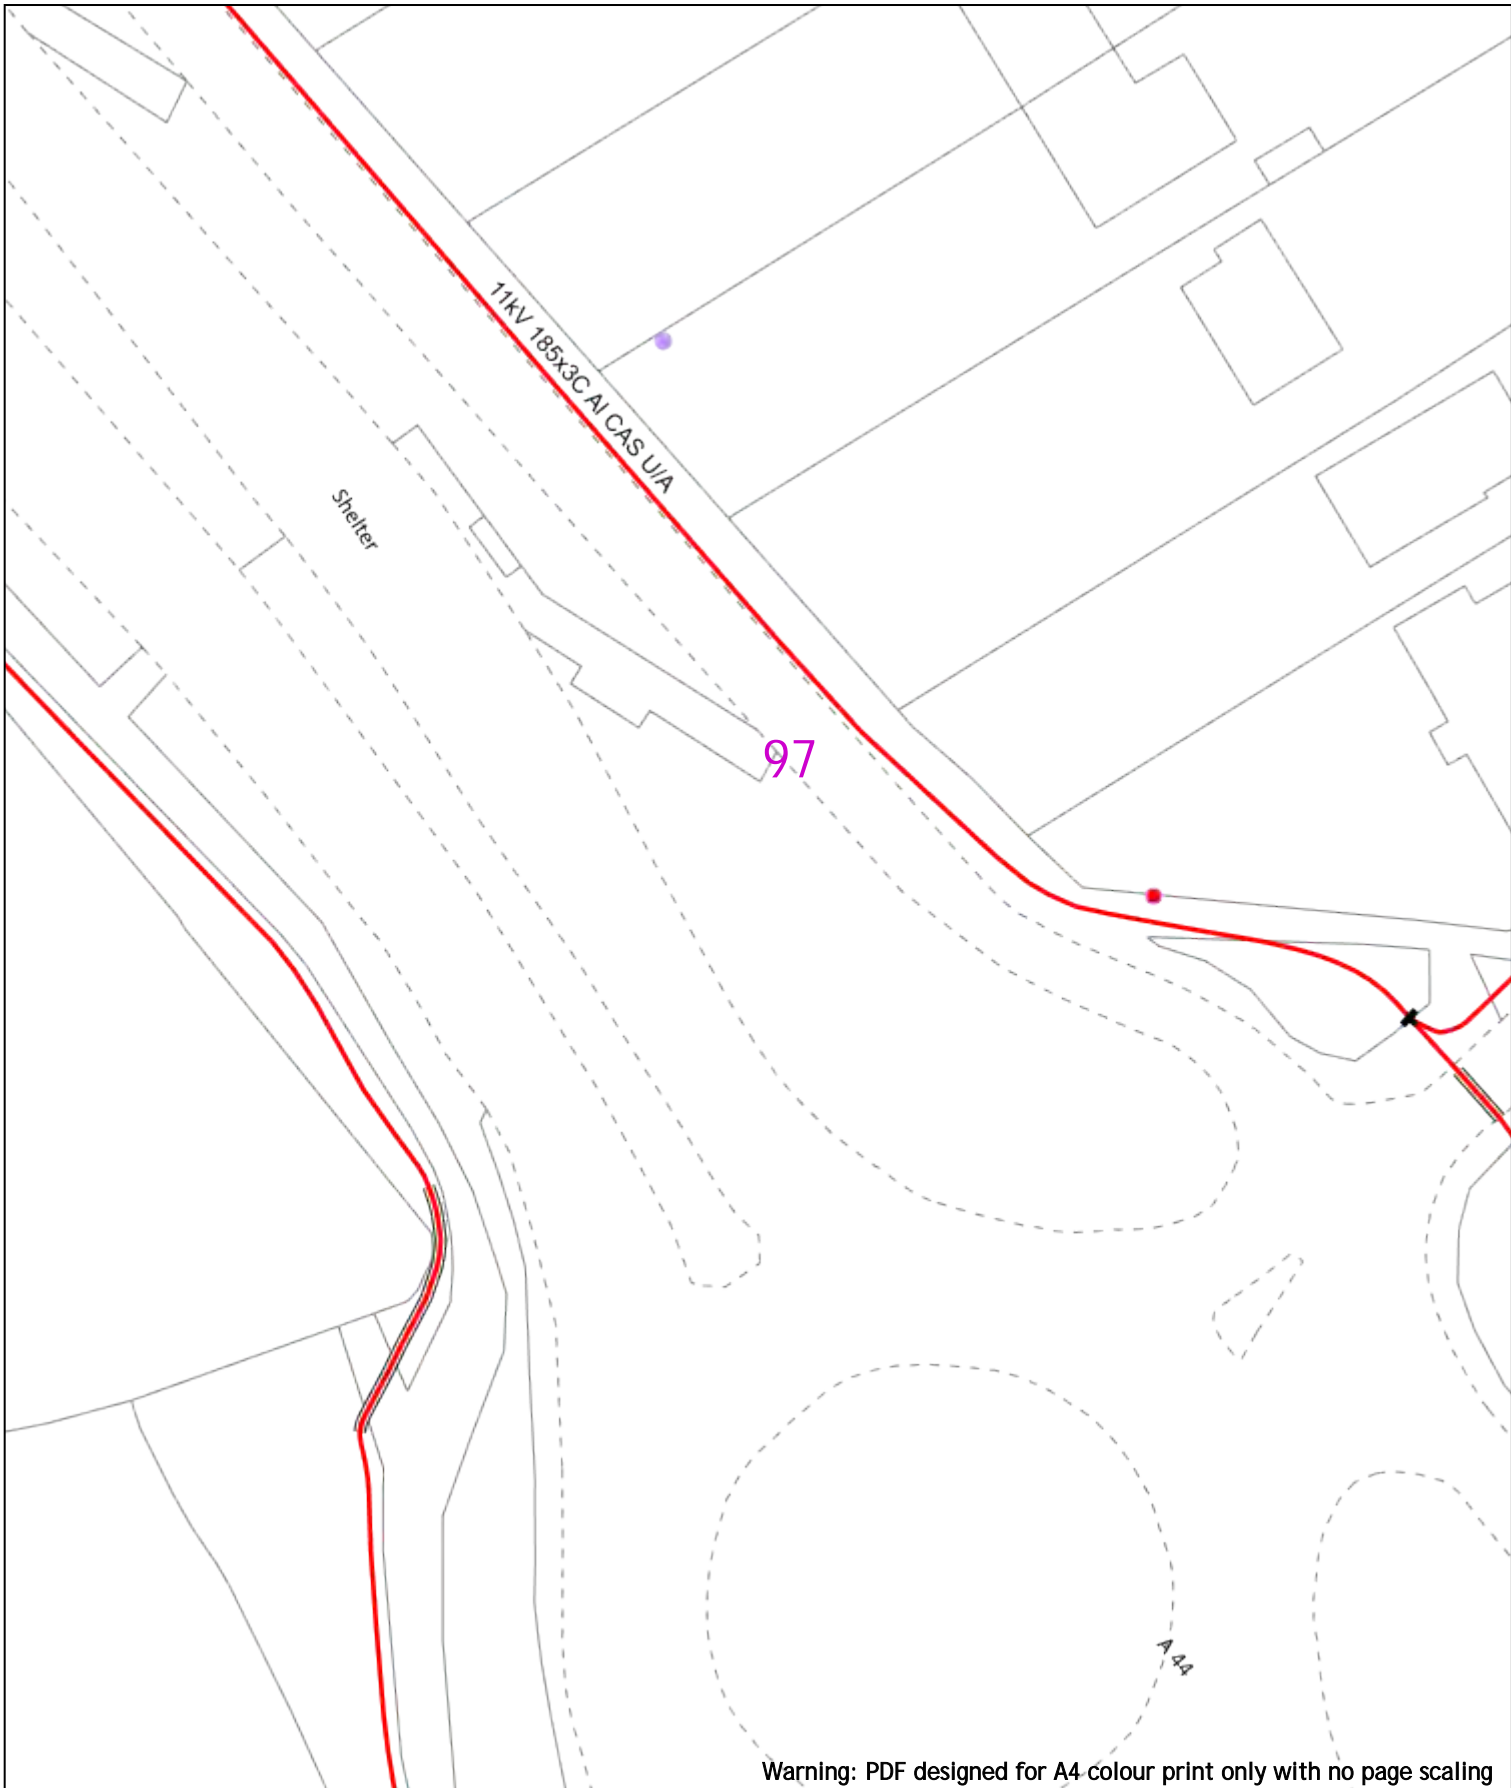

Warning: PDF designed for A4 colour print only with no page scaling

0 20m Dig Sites Area: Line: **Extra High Voltage cables in vicinity**

Date Requested: 24/06/2022
 Job Reference: 25881010
 Site Location: 448066 213346
 Requested by: Mr Joe Shawyer
 Your Scheme/Reference: 31188_002

Voltages (V)			
LV (Low Voltage) and Services	Up to 1,000V		
HV (High Voltage)	Over 1,000V to 11,000V		
EHV (Extra High Voltage)	22,000V to 132,000V		
Transmission	275,000V and 400,000V		
NORMAL DEPTH TO THE TOP OF THE CABLE WHEN LAID			
Services	LV	HV	EHV
Footpath/Unmade	0.45m	0.45m	0.6m
Road Crossing	0.6m	0.6m	0.75m
Agricultural	1m	1m	1.1m


Legend	
	Service Cable
	LV Mains
	7 - 11kV
	66kV
	11kV
	22kV
	33kV
	66kV
	132kV
	275kV
	400kV
	Fibre Optic
	Pipe Cable

Distribution Structures (Electric)	
	Pole, Existing Location
	Pole Structure, Existing Location - Single
	Pole Structure, Existing Location - H
	Duct Route
	Cross Section Route

Southern Electric Power Distribution plc
 Registered Office: No.1 Forbury Place
 43 Forbury Road Reading RG1 3JH
 Registered In England & Wales No.04094290

If you're unsure & need to seek advice before commencing excavations, please contact:
 General Enquiries: 0800 048 3516

Subject to revision – Master held by SSEN Asset Data Team:
Asset.Data@sse.com
 01256 337 294

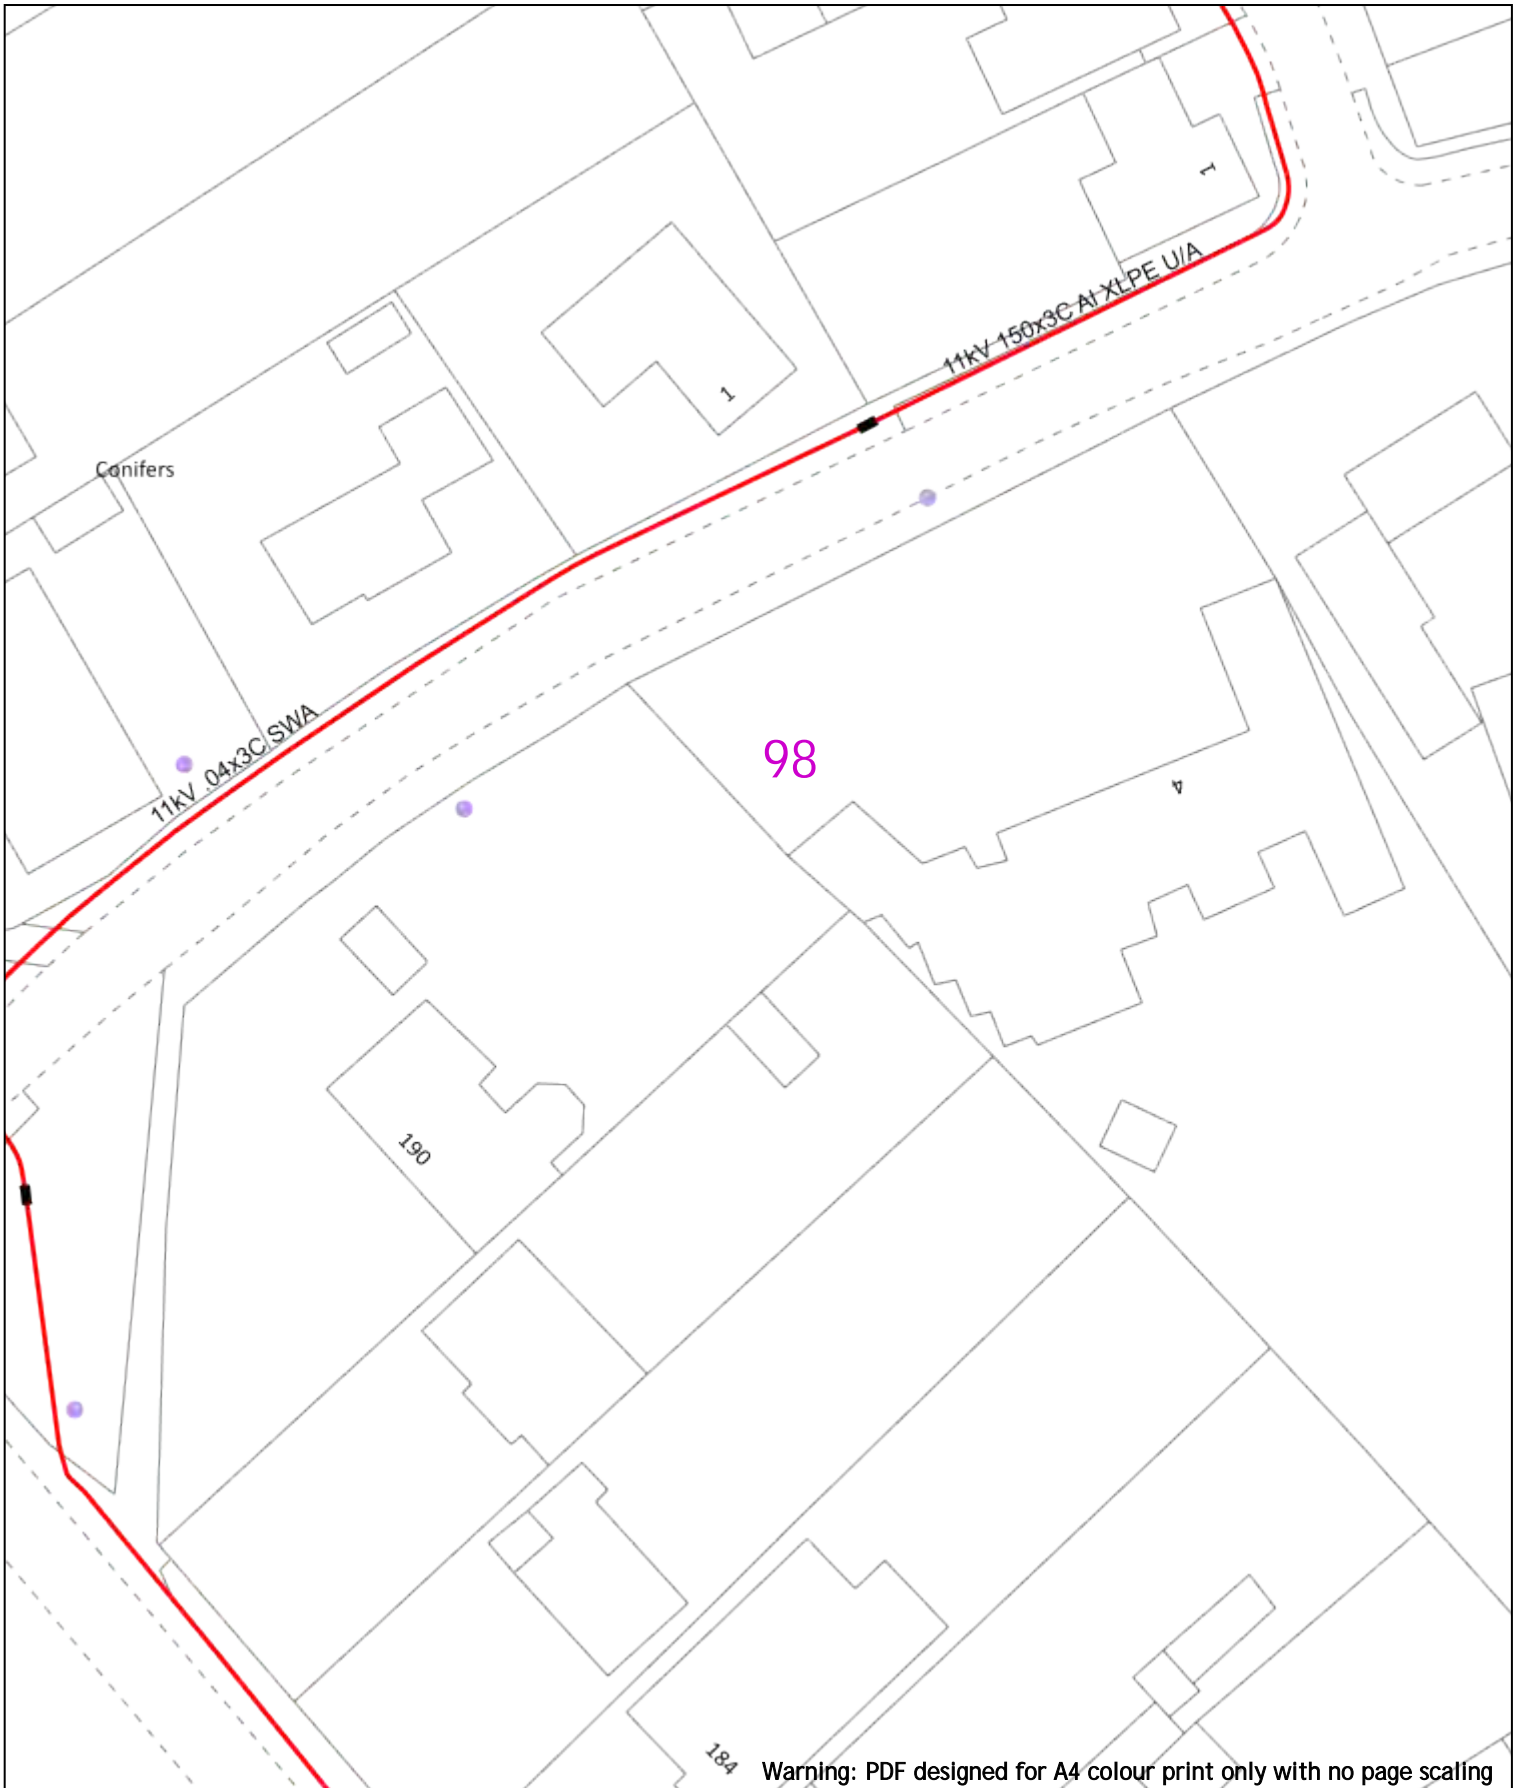

0 20m Dig Sites Area: Line: **Extra High Voltage cables in vicinity**

Date Requested: 24/06/2022
 Job Reference: 25881010
 Site Location: 448066 213346
 Requested by: Mr Joe Shawyer
 Your Scheme/Reference: 31188_002

Voltages (V)				
LV (Low Voltage) and Services	Up to 1,000V			
HV (High Voltage)	Over 1,000V to 11,000V			
EHV (Extra High Voltage)	22,000V to 132,000V			
Transmission	275,000V and 400,000V			
NORMAL DEPTH TO THE TOP OF THE CABLE WHEN LAID				
Services	LV	HV	EHV	
Footpath/Unmade	0.45m	0.45m	0.6m	0.8m
Road Crossing	0.6m	0.6m	0.75m	0.9m
Agricultural	1m	1m	1m	1.1m

Legend		Distribution Structures (Electric)	
	Service Cable		Pole, Existing Location
	LV Mains		Pole Structure, Existing Location - Single
	66kV		Pole Structure, Existing Location - H
	11kV		Duct Route
	22kV		Cross Section Route
	33kV		
	66kV		
	132kV		
	275kV		
	400kV		
	Fibre Optic		
	Pipe Cable		


WARNING
 There may have been subsequent alteration to the surface levels. Trial holes must be undertaken to determine position and depths of cables. HS (G) 47 Booklet from the Health and Safety Executive - Avoiding Danger from Buried Cables - should be consulted before commencing excavation work.
 WHEN WORKING IN THE VICINITY OF OVERHEAD LINES THE HEALTH AND SAFETY GUIDANCE NOTES G56 SHOULD BE CONSULTED (AVAILABLE FROM THE HSE WEBSITE)

Scale: 1:500 (When plotted at A4)

Southern Electric Power Distribution plc
 Registered Office: No.1 Forbury Place
 43 Forbury Road Reading RG1 3JH
 Registered In England & Wales No.04094290

If you're unsure & need to seek advice before commencing excavations, please contact:
 General Enquiries: 0800 048 3516


Subject to revision - Master held by SSEN Asset Data Team:
Asset.Data@sse.com
 01256 337 294

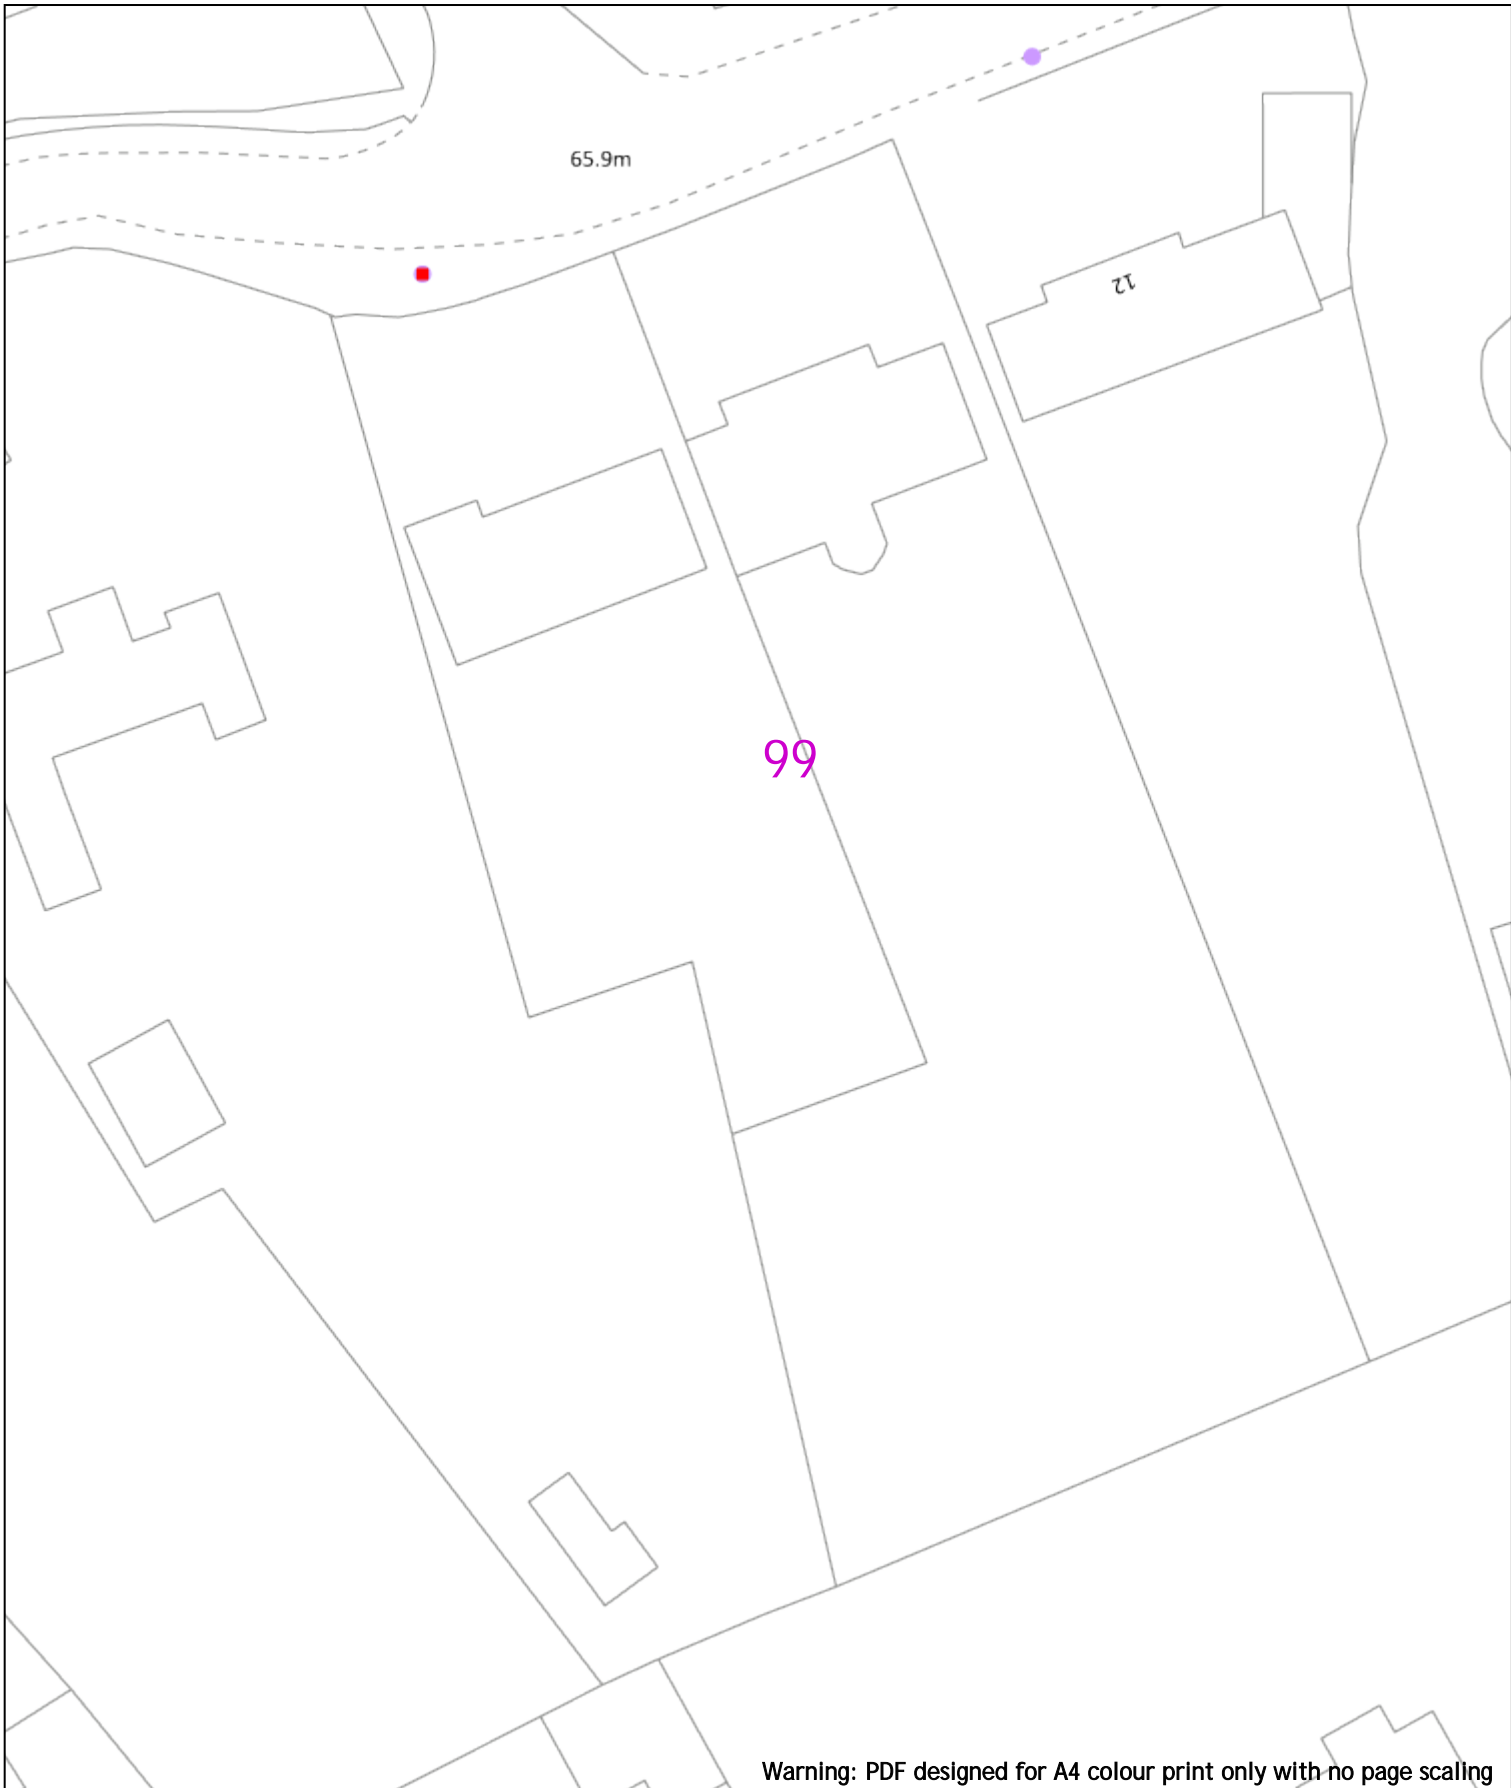

Warning: PDF designed for A4 colour print only with no page scaling

<p>0 20m Dig Sites Area: Line: Extra High Voltage cables in vicinity</p>	
<p>Date Requested: 24/06/2022 Job Reference: 25881010 Site Location: 448066 213346 Requested by: Mr Joe Shawyer Your Scheme/Reference: 31188_002</p>	<table border="1"> <thead> <tr> <th colspan="4">Voltages (V)</th> </tr> </thead> <tbody> <tr> <td>LV (Low Voltage) and Services</td> <td colspan="3">Up to 1,000V</td> </tr> <tr> <td>HV (High Voltage)</td> <td colspan="3">Over 1,000V to 11,000V</td> </tr> <tr> <td>EHV (Extra High Voltage)</td> <td colspan="3">22,000V to 132,000V</td> </tr> <tr> <td>Transmission</td> <td colspan="3">275,000V and 400,000V</td> </tr> </tbody> </table> <table border="1"> <thead> <tr> <th colspan="4">NORMAL DEPTH TO THE TOP OF THE CABLE WHEN LAID</th> </tr> <tr> <th>Services</th> <th>LV</th> <th>HV</th> <th>EHV</th> </tr> </thead> <tbody> <tr> <td>Footpath/Unmade</td> <td>0.45m</td> <td>0.45m</td> <td>0.6m</td> </tr> <tr> <td>Road Crossing</td> <td>0.6m</td> <td>0.6m</td> <td>0.75m</td> </tr> <tr> <td>Agricultural</td> <td>1m</td> <td>1m</td> <td>1.1m</td> </tr>
<table border="1"> <thead> <tr> <th colspan="2">Legend</th> </tr> </thead> <tbody> <tr> <td></td> <td>Service Cable</td> </tr> <tr> <td></td> <td>LV Mains</td> </tr> <tr> <td></td> <td>2 - 11kV</td> </tr> <tr> <td></td> <td>66kV</td> </tr> <tr> <td></td> <td>11kV</td> </tr> <tr> <td></td> <td>22kV</td> </tr> <tr> <td></td> <td>33kV</td> </tr> <tr> <td></td> <td>66kV</td> </tr> <tr> <td></td> <td>132kV</td> </tr> <tr> <td></td> <td>275kV</td> </tr> <tr> <td></td> <td>400kV</td> </tr> <tr> <td></td> <td>Fibre Optic</td> </tr> <tr> <td></td> <td>Pilot Cable</td> </tr> </tbody> </table> <table border="1"> <thead> <tr> <th colspan="2">Distribution Structures (Electric)</th> </tr> </thead> <tbody> <tr> <td></td> <td>Pole, Existing Location</td> </tr> <tr> <td></td> <td>Pole Structure, Existing Location - Single</td> </tr> <tr> <td></td> <td>Pole Structure, Existing Location - H</td> </tr> <tr> <td></td> <td>Duct Route</td> </tr> <tr> <td></td> <td>Cross Section Route</td> </tr> </tbody> </table> <p>WARNING There may have been subsequent alteration to the surface levels. Trial holes must be undertaken to determine position and depths of cables. HS (G) 47 Booklet from the Health and Safety Executive - Avoiding Danger from Buried Cables - should be consulted before commencing excavation work. WHEN WORKING IN THE VICINITY OF OVERHEAD LINES THE HEALTH AND SAFETY GUIDANCE NOTES G56 SHOULD BE CONSULTED (AVAILABLE FROM THE HSE WEBSITE)</p>	Legend			Service Cable		LV Mains		2 - 11kV		66kV		11kV		22kV		33kV		66kV		132kV		275kV		400kV		Fibre Optic		Pilot Cable	Distribution Structures (Electric)			Pole, Existing Location		Pole Structure, Existing Location - Single		Pole Structure, Existing Location - H		Duct Route		Cross Section Route	<p>Southern Electric Power Distribution plc Registered Office: No.1 Forbury Place 43 Forbury Road Reading RG1 3JH Registered In England & Wales No.04094290</p> <p>If you're unsure & need to seek advice before commencing excavations, please contact: General Enquiries: 0800 048 3516</p> <p>Subject to revision - Master held by SSEN Asset Data Team: Asset.Data@sse.com 01256 337 294</p>
Legend	
	Service Cable	
	LV Mains	
	2 - 11kV	
	66kV	
	11kV	
	22kV	
	33kV	
	66kV	
	132kV	
	275kV	
	400kV	
	Fibre Optic	
	Pilot Cable	
Distribution Structures (Electric)	
	Pole, Existing Location	
	Pole Structure, Existing Location - Single	
	Pole Structure, Existing Location - H	
	Duct Route	
	Cross Section Route	

BASED UPON THE ORDNANCE SURVEY MAP WITH THE SANCTION OF THE CONTROLLER OF HM STATIONERY OFFICE CROWN COPYRIGHT RESERVED.
 This copy has been made by or with the authority of Scottish and Southern Energy Power Distribution Ltd. Pursuant to section 47 of the Copyright, Designs and Patents Act 1988 ("The Act"). Unless the Act provides a relevant exception to copyright the copy must not be copied without prior permission of the copyright owner.
 Plans generated by DigSAFE Pro™ software provided by LinesearchbeforeUdig.

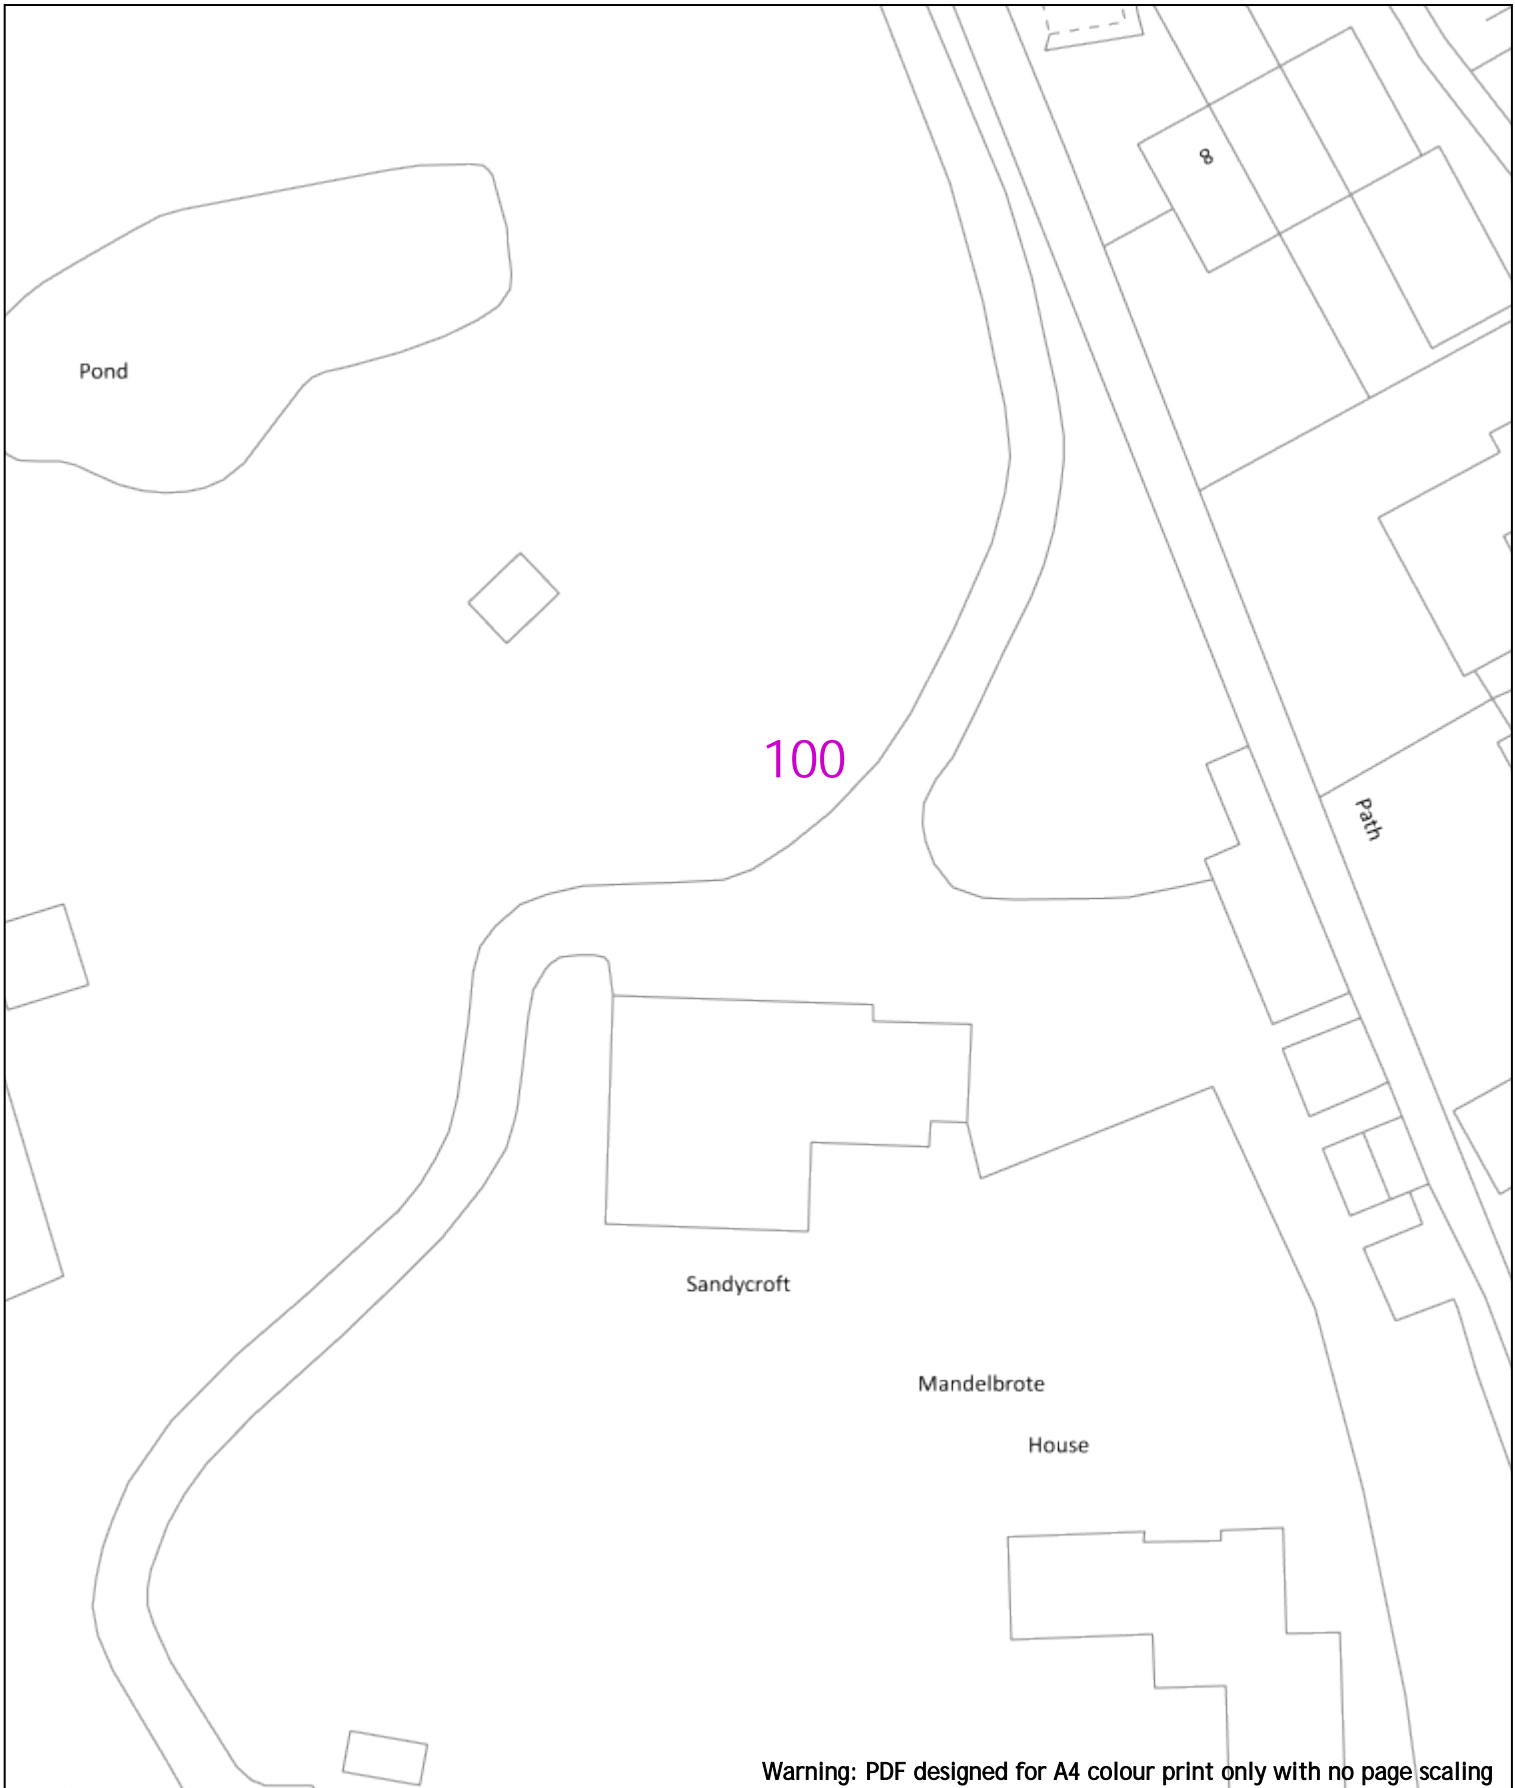

0 20m Dig Sites Area: Line: **Extra High Voltage cables in vicinity**

Date Requested: 24/06/2022
 Job Reference: 25881010
 Site Location: 448066 213346
 Requested by: Mr Joe Shawyer
 Your Scheme/Reference: 31188_002

Voltages (V)			
LV (Low Voltage) and Services	Up to 1,000V		
HV (High Voltage)	Over 1,000V to 11,000V		
EHV (Extra High Voltage)	22,000V to 132,000V		
Transmission	275,000V and 400,000V		

NORMAL DEPTH TO THE TOP OF THE CABLE WHEN LAID			
Services	LV	HV	EHV
Footpath/Unmade	0.45m	0.45m	0.8m
Road Crossing	0.6m	0.6m	0.9m
Agricultural	1m	1m	1.1m

Legend	
	Service Cable
	LV Mains
	2 - 11kV
	66kV
	11kV
	22kV
	33kV
	66kV
	132kV
	275kV
	400kV
	Fibre Optic
	Pilot Cable

Distribution Structures (Electric)	
	Pole, Existing Location
	Pole Structure, Existing Location - Single
	Pole Structure, Existing Location - H
	Duct Route
	Cross Section Route

WARNING
 There may have been subsequent alteration to the surface levels. Trial holes must be undertaken to determine position and depths of cables. HS (G) 47 Booklet from the Health and Safety Executive - Avoiding Danger from Buried Cables - should be consulted before commencing excavation work.
WHEN WORKING IN THE VICINITY OF OVERHEAD LINES THE HEALTH AND SAFETY GUIDANCE NOTES G56 SHOULD BE CONSULTED (AVAILABLE FROM THE HSE WEBSITE)


Scale: 1:500 (When plotted at A4)

Southern Electric Power Distribution plc
 Registered Office: No.1 Forbury Place
 43 Forbury Road Reading RG1 3JH
 Registered In England & Wales No.04094290

If you're unsure & need to seek advice before commencing excavations, please contact:
 General Enquiries: 0800 048 3516

Subject to revision - Master held by SSEN Asset Data Team:
Asset.Data@sse.com
 01256 337 294

BASED UPON THE ORDNANCE SURVEY MAP WITH THE SANCTION OF THE CONTROLLER OF HM STATIONERY OFFICE CROWN COPYRIGHT RESERVED.
 This copy has been made by or with the authority of Scottish and Southern Energy Power Distribution Ltd. Pursuant to section 47 of the Copyright, Designs and Patents Act 1988 ("The Act"). Unless the Act provides a relevant exception to copyright the copy must not be copied without prior permission of the copyright owner.
 Plans generated by DigSAFE Pro™ software provided by LinesearchbeforeUdig.

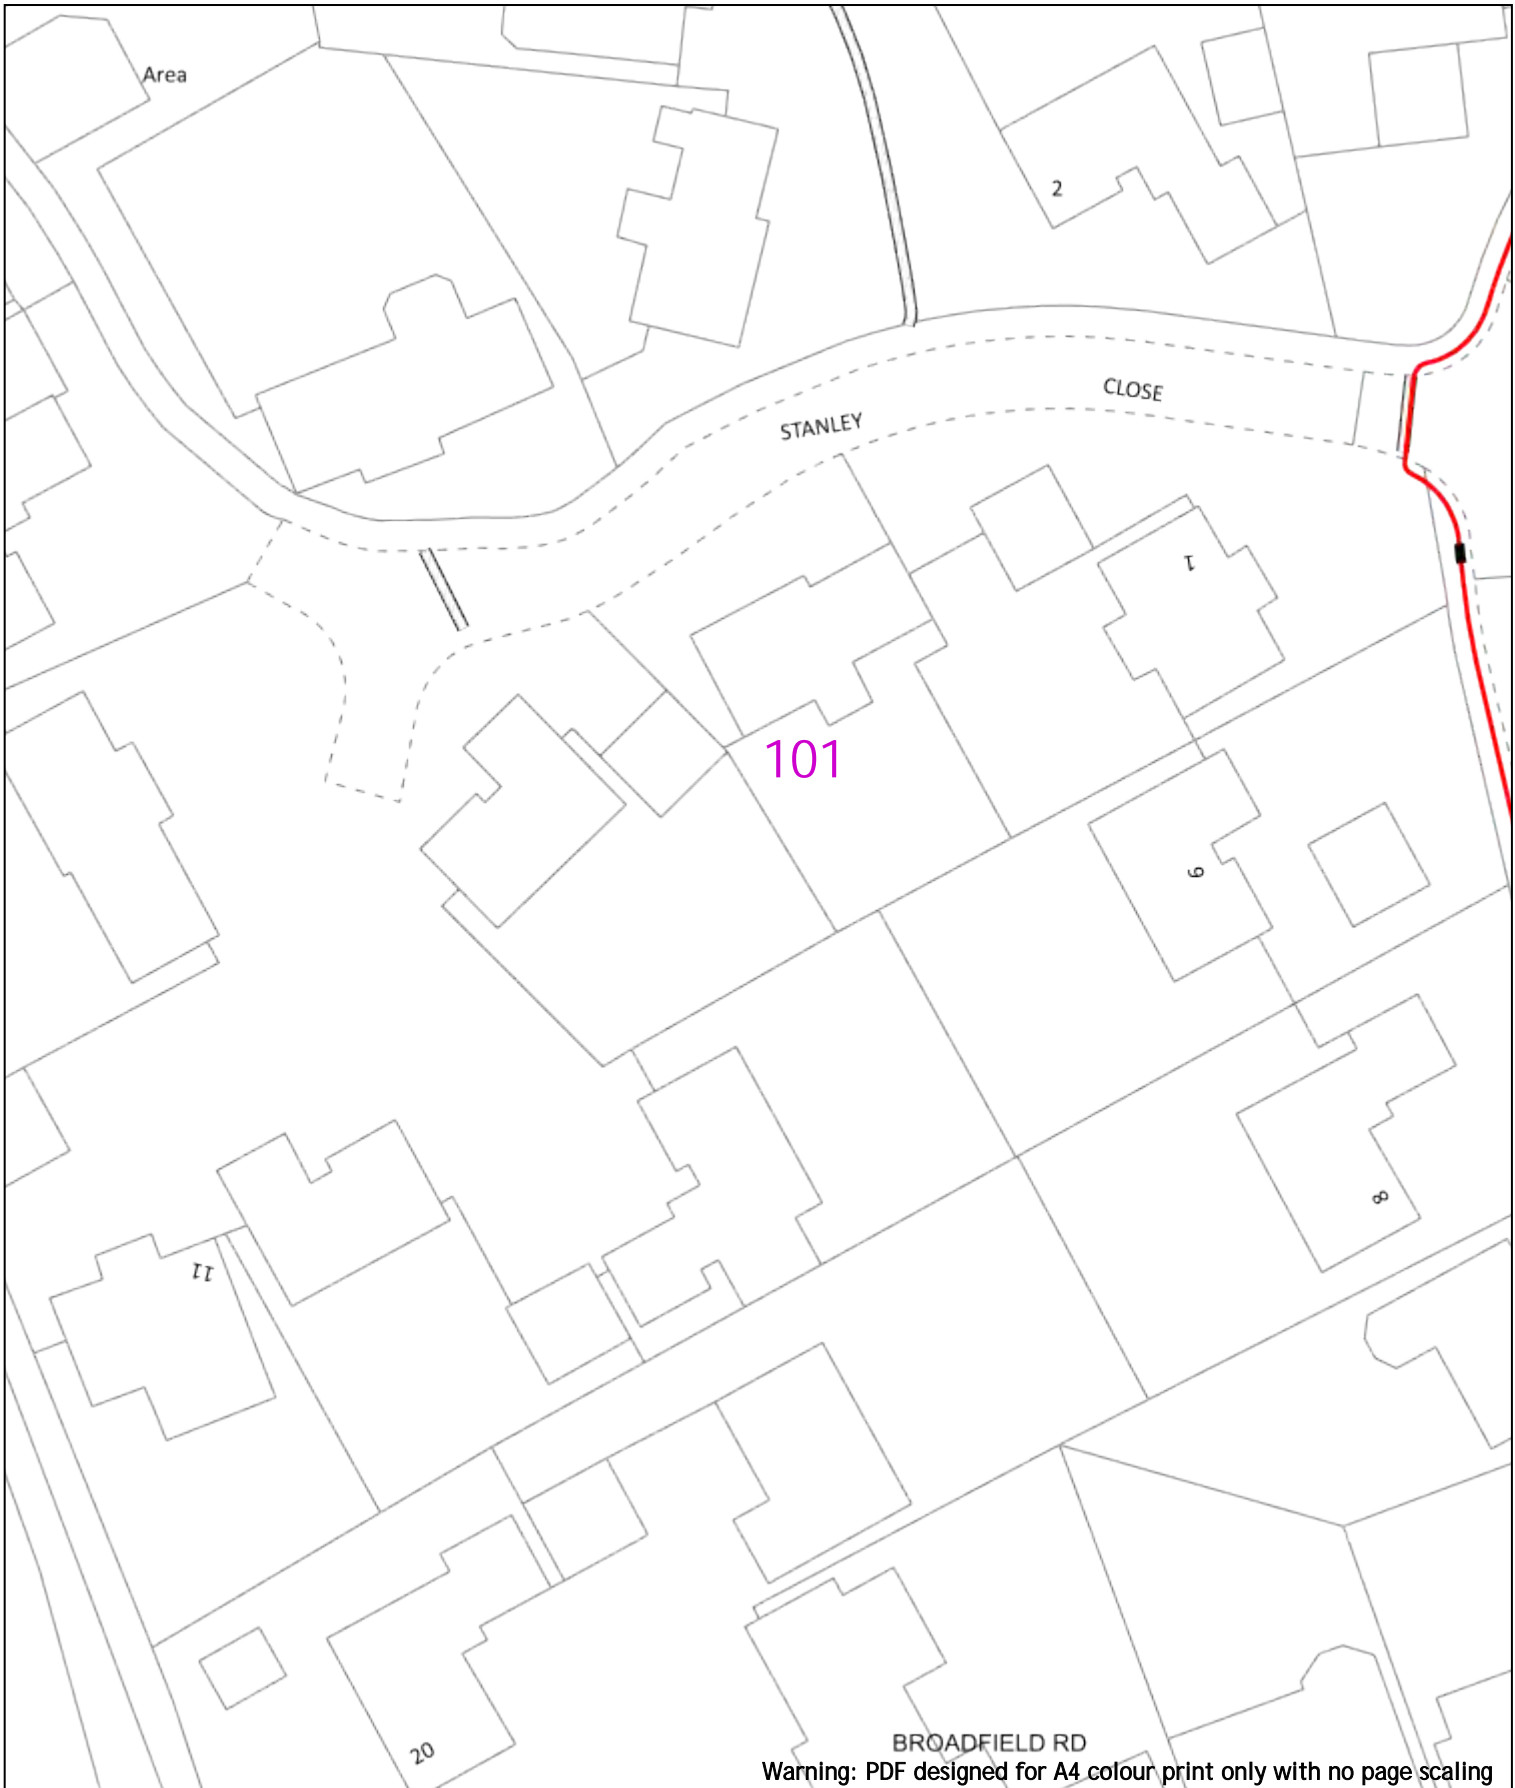

BROADFIELD RD
Warning: PDF designed for A4 colour print only with no page scaling

0 20m Dig Sites Area: Line: **Extra High Voltage cables in vicinity**

Date Requested: 24/06/2022
Job Reference: 25881010
Site Location: 448066 213346
Requested by: Mr Joe Shawyer
Your Scheme/Reference: 31188_002

Voltages (V)	
LV (Low Voltage) and Services	Up to 1,000V
HV (High Voltage)	Over 1,000V to 11,000V
EHV (Extra High Voltage)	22,000V to 132,000V
Transmission	275,000V and 400,000V

NORMAL DEPTH TO THE TOP OF THE CABLE WHEN LAID			
Services	LV	HV	EHV
Footpath/Unmade	0.45m	0.45m	0.6m
Road Crossing	0.6m	0.6m	0.75m
Agricultural	1m	1m	1.1m

Legend	
	Service Cable
	LV Mains
	2 - 11kV
	66kV
	11kV
	22kV
	33kV
	66kV
	132kV
	275kV
	400kV
	Fibre Optic
	Pipe Cable

Distribution Structures (Electric)	
	Pole, Existing Location
	Pole Structure, Existing Location - Single
	Pole Structure, Existing Location - H
	Duct Route
	Cross Section Route

Southern Electric Power Distribution plc
Registered Office: No.1 Forbury Place
43 Forbury Road Reading RG1 3JH
Registered In England & Wales No.04094290


If you're unsure & need to seek advice before commencing excavations, please contact:
General Enquiries: 0800 048 3516

Subject to revision – Master held by SSEN Asset Data Team:
Asset.Data@sse.com
01256 337 294

Scale: 1:500 (When plotted at A4)

WARNING
There may have been subsequent alteration to the surface levels. Trial holes must be undertaken to determine position and depths of cables. HS (G) 47 Booklet from the Health and Safety Executive – Avoiding Danger from Buried Cables – should be consulted before commencing excavation work.
WHEN WORKING IN THE VICINITY OF OVERHEAD LINES THE HEALTH AND SAFETY GUIDANCE NOTES G56 SHOULD BE CONSULTED (AVAILABLE FROM THE HSE WEBSITE)

BASED UPON THE ORDNANCE SURVEY MAP WITH THE SANCTION OF THE CONTROLLER OF HM STATIONERY OFFICE CROWN COPYRIGHT RESERVED.
This copy has been made by or with the authority of Scottish and Southern Energy Power Distribution Ltd. Pursuant to section 47 of the Copyright, Designs and Patents Act 1988 ("The Act"). Unless the Act provides a relevant exception to copyright the copy must not be copied without prior permission of the copyright owner.
Plans generated by DigSAFE Pro™ software provided by LinesearchbeforeDig.

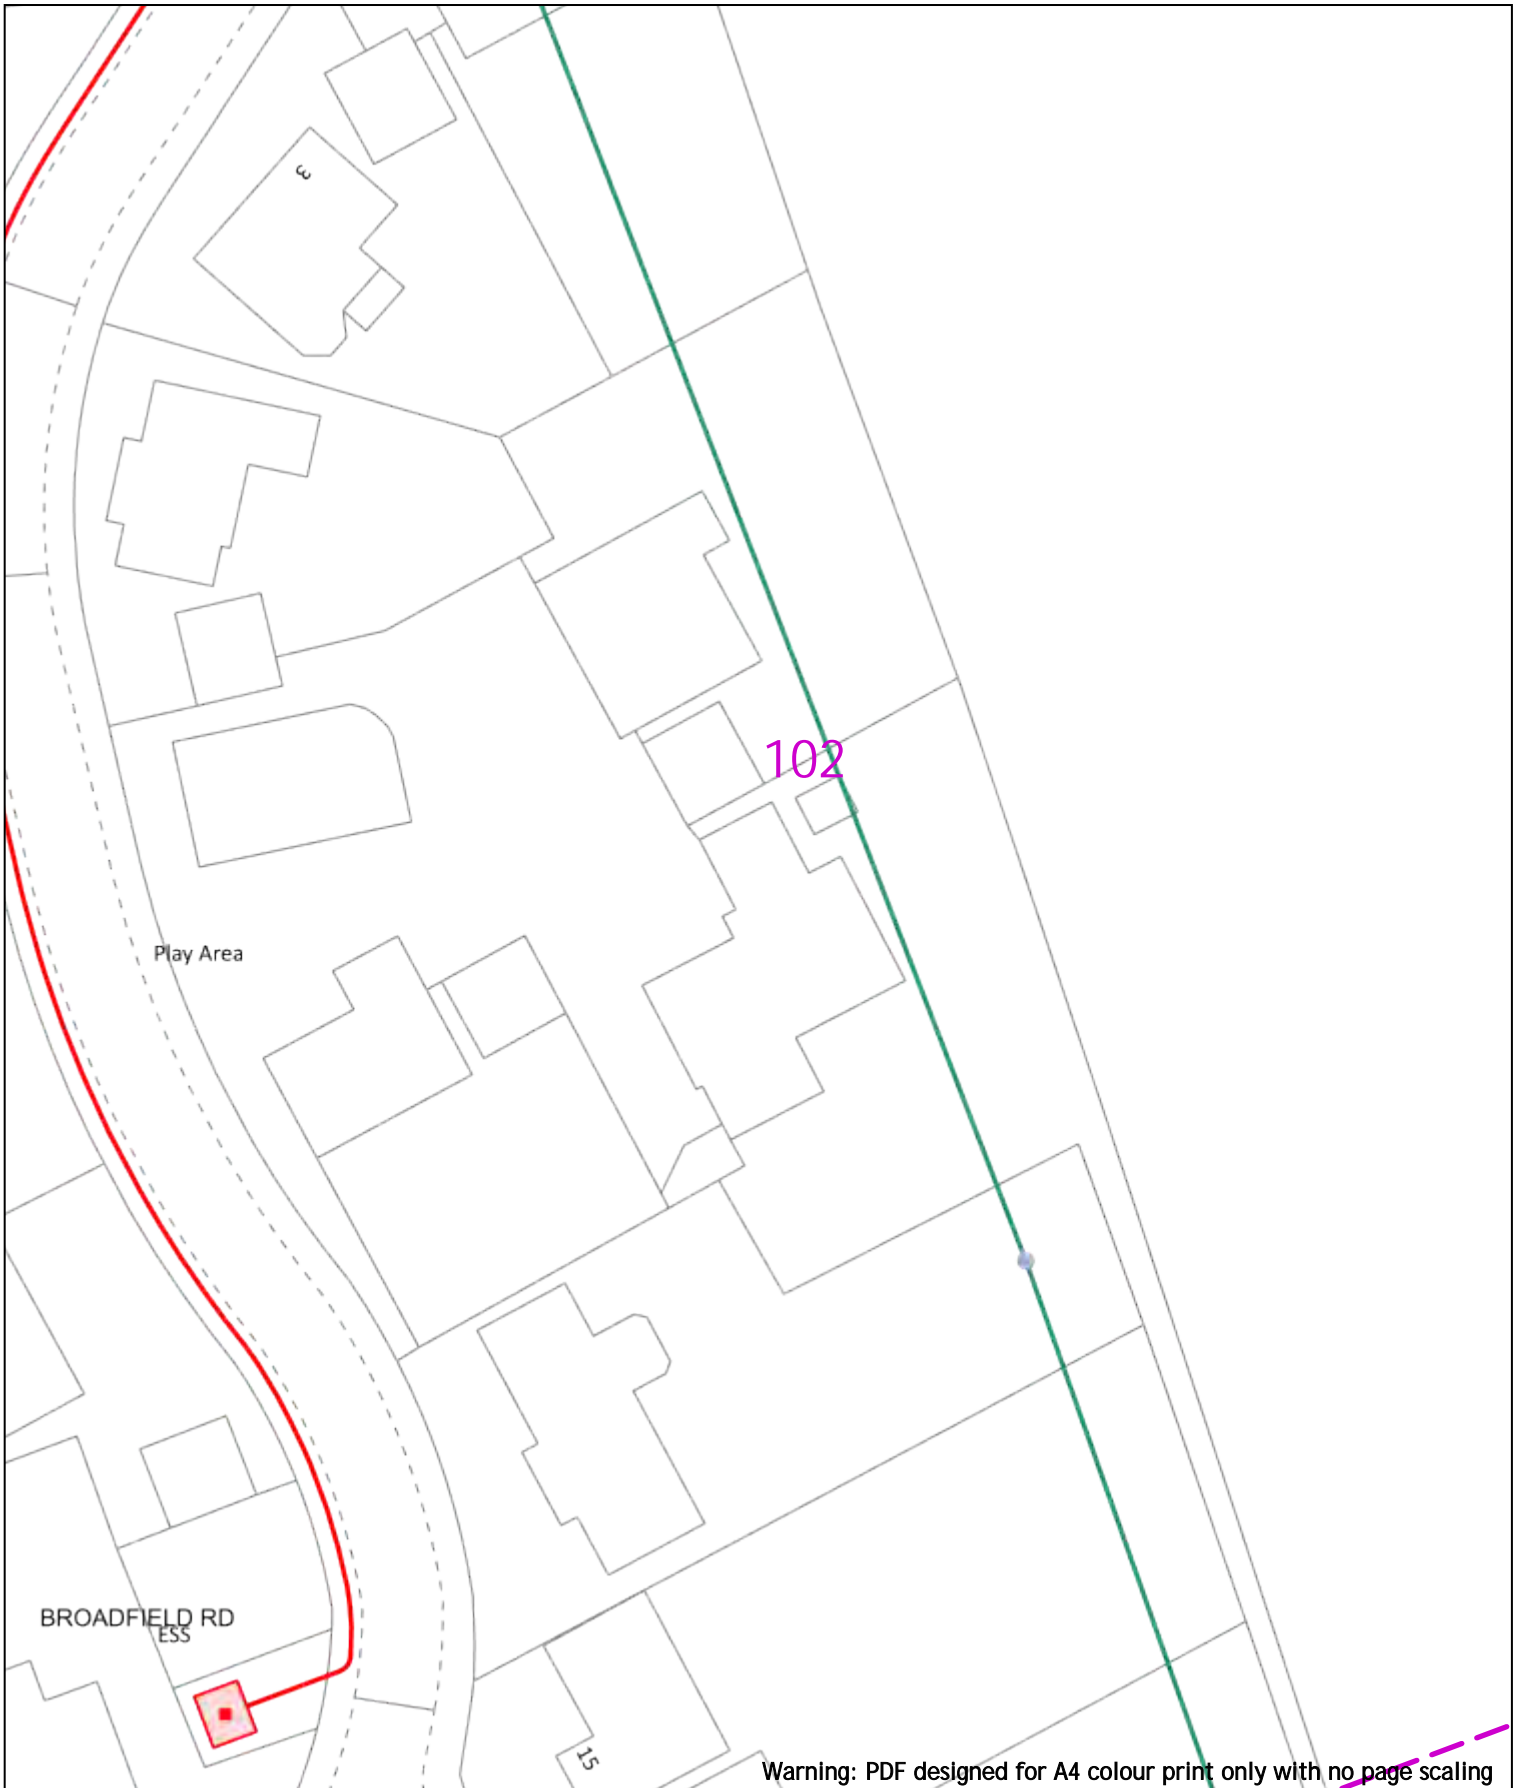

Warning: PDF designed for A4 colour print only with no page scaling

<p>0 20m Dig Sites Area: Line: Extra High Voltage cables in vicinity</p>	
<p>Date Requested: 24/06/2022 Job Reference: 25881010 Site Location: 448066 213346 Requested by: Mr Joe Shawyer Your Scheme/Reference: 31188_002</p>	<table border="1"> <thead> <tr> <th colspan="4">Voltages (V)</th> </tr> </thead> <tbody> <tr> <td>LV (Low Voltage) and Services</td> <td colspan="3">Up to 1,000V</td> </tr> <tr> <td>HV (High Voltage)</td> <td colspan="3">Over 1,000V to 11,000V</td> </tr> <tr> <td>EHV (Extra High Voltage)</td> <td colspan="3">22,000V to 132,000V</td> </tr> <tr> <td>Transmission</td> <td colspan="3">275,000V and 400,000V</td> </tr> <tr> <th colspan="4">NORMAL DEPTH TO THE TOP OF THE CABLE WHEN LAID</th> </tr> <tr> <td>Services</td> <td>LV</td> <td>HV</td> <td>EHV</td> </tr> <tr> <td>Footpath/Unmade</td> <td>0.45m</td> <td>0.45m</td> <td>0.6m</td> </tr> <tr> <td>Road Crossing</td> <td>0.6m</td> <td>0.6m</td> <td>0.75m</td> </tr> <tr> <td>Agricultural</td> <td>1m</td> <td>1m</td> <td>1.1m</td> </tr>
<p>Scale: 1:500 (When plotted at A4)</p>		<p>Southern Electric Power Distribution plc Registered Office: No.1 Forbury Place 43 Forbury Road Reading RG1 3JH Registered In England & Wales No.04094290</p> <p>If you're unsure & need to seek advice before commencing excavations, please contact: General Enquiries: 0800 048 3516</p> <p>Subject to revision – Master held by SSEN Asset Data Team: Asset.Data@sse.com 01256 337 294</p>																																							

WARNING
 There may have been subsequent alteration to the surface levels. Trial holes must be undertaken to determine position and depths of cables. HS (G) 47 Booklet from the Health and Safety Executive – Avoiding Danger from Buried Cables – should be consulted before commencing excavation work.
WHEN WORKING IN THE VICINITY OF OVERHEAD LINES THE HEALTH AND SAFETY GUIDANCE NOTES G56 SHOULD BE CONSULTED (AVAILABLE FROM THE HSE WEBSITE)