

0 20m Dig Sites Area: Line: **Extra High Voltage cables in vicinity**

Date Requested: 24/06/2022  
 Job Reference: 25881037  
 Site Location: 448662 213014  
 Requested by: Mr Joe Shawyer  
 Your Scheme/Reference: 31188\_003

Voltages (V)	
LV (Low Voltage) and Services	Up to 1,000V
HV (High Voltage)	Over 1,000V to 11,000V
EHV (Extra High Voltage)	22,000V to 132,000V
Transmission	275,000V and 400,000V

NORMAL DEPTH TO THE TOP OF THE CABLE WHEN LAID			
Services	LV	HV	EHV
Footpath/Unmade	0.45m	0.45m	0.6m
Road Crossing	0.6m	0.6m	0.75m
Agricultural	1m	1m	1.1m

Legend	
	Service Cable
	LV Mains
	2 - 11kV
	6.6kV
	11kV
	22kV
	33kV
	66kV
	132kV
	275kV
	400kV
	Fibre Optic
	Pipe Cable

Distribution Structures (Electric)	
	Pole, Existing Location
	Pole Structure, Existing Location - Single
	Pole Structure, Existing Location - H
	Duct Route
	Cross Section Route

**WARNING**  
 There may have been subsequent alteration to the surface levels. Trial holes must be undertaken to determine position and depths of cables. HS (G) 47 Booklet from the Health and Safety Executive - Avoiding Danger from Buried Cables - should be consulted before commencing excavation work.  
 WHEN WORKING IN THE VICINITY OF OVERHEAD LINES THE HEALTH AND SAFETY GUIDANCE NOTES G56 SHOULD BE CONSULTED (AVAILABLE FROM THE HSE WEBSITE)


Scale: 1:500 (When plotted at A4)

Based upon the Ordnance Survey map with the sanction of the Controller of HM Stationery Office Crown Copyright Reserved.  
 This copy has been made by or with the authority of Scottish and Southern Energy Power Distribution Ltd. Pursuant to section 47 of the Copyright, Designs and Patents Act 1988 ("The Act"). Unless the Act provides a relevant exception to copyright the copy must not be copied without prior permission of the copyright owner.  
 Plans generated by DigSAFE Pro™ software provided by Lineworksbefore@dig.

**Southern Electric Power Distribution plc**  
 Registered Office: No.1 Forbury Place  
 43 Forbury Road Reading RG1 3JH  
 Registered In England & Wales No.04094290


If you're unsure & need to seek advice before commencing excavations, please contact:  
 General Enquiries: 0800 048 3516

Subject to revision - Master held by SSEN Asset Data Team:  
[Asset.Data@sse.com](mailto:Asset.Data@sse.com)  
 01256 337 294

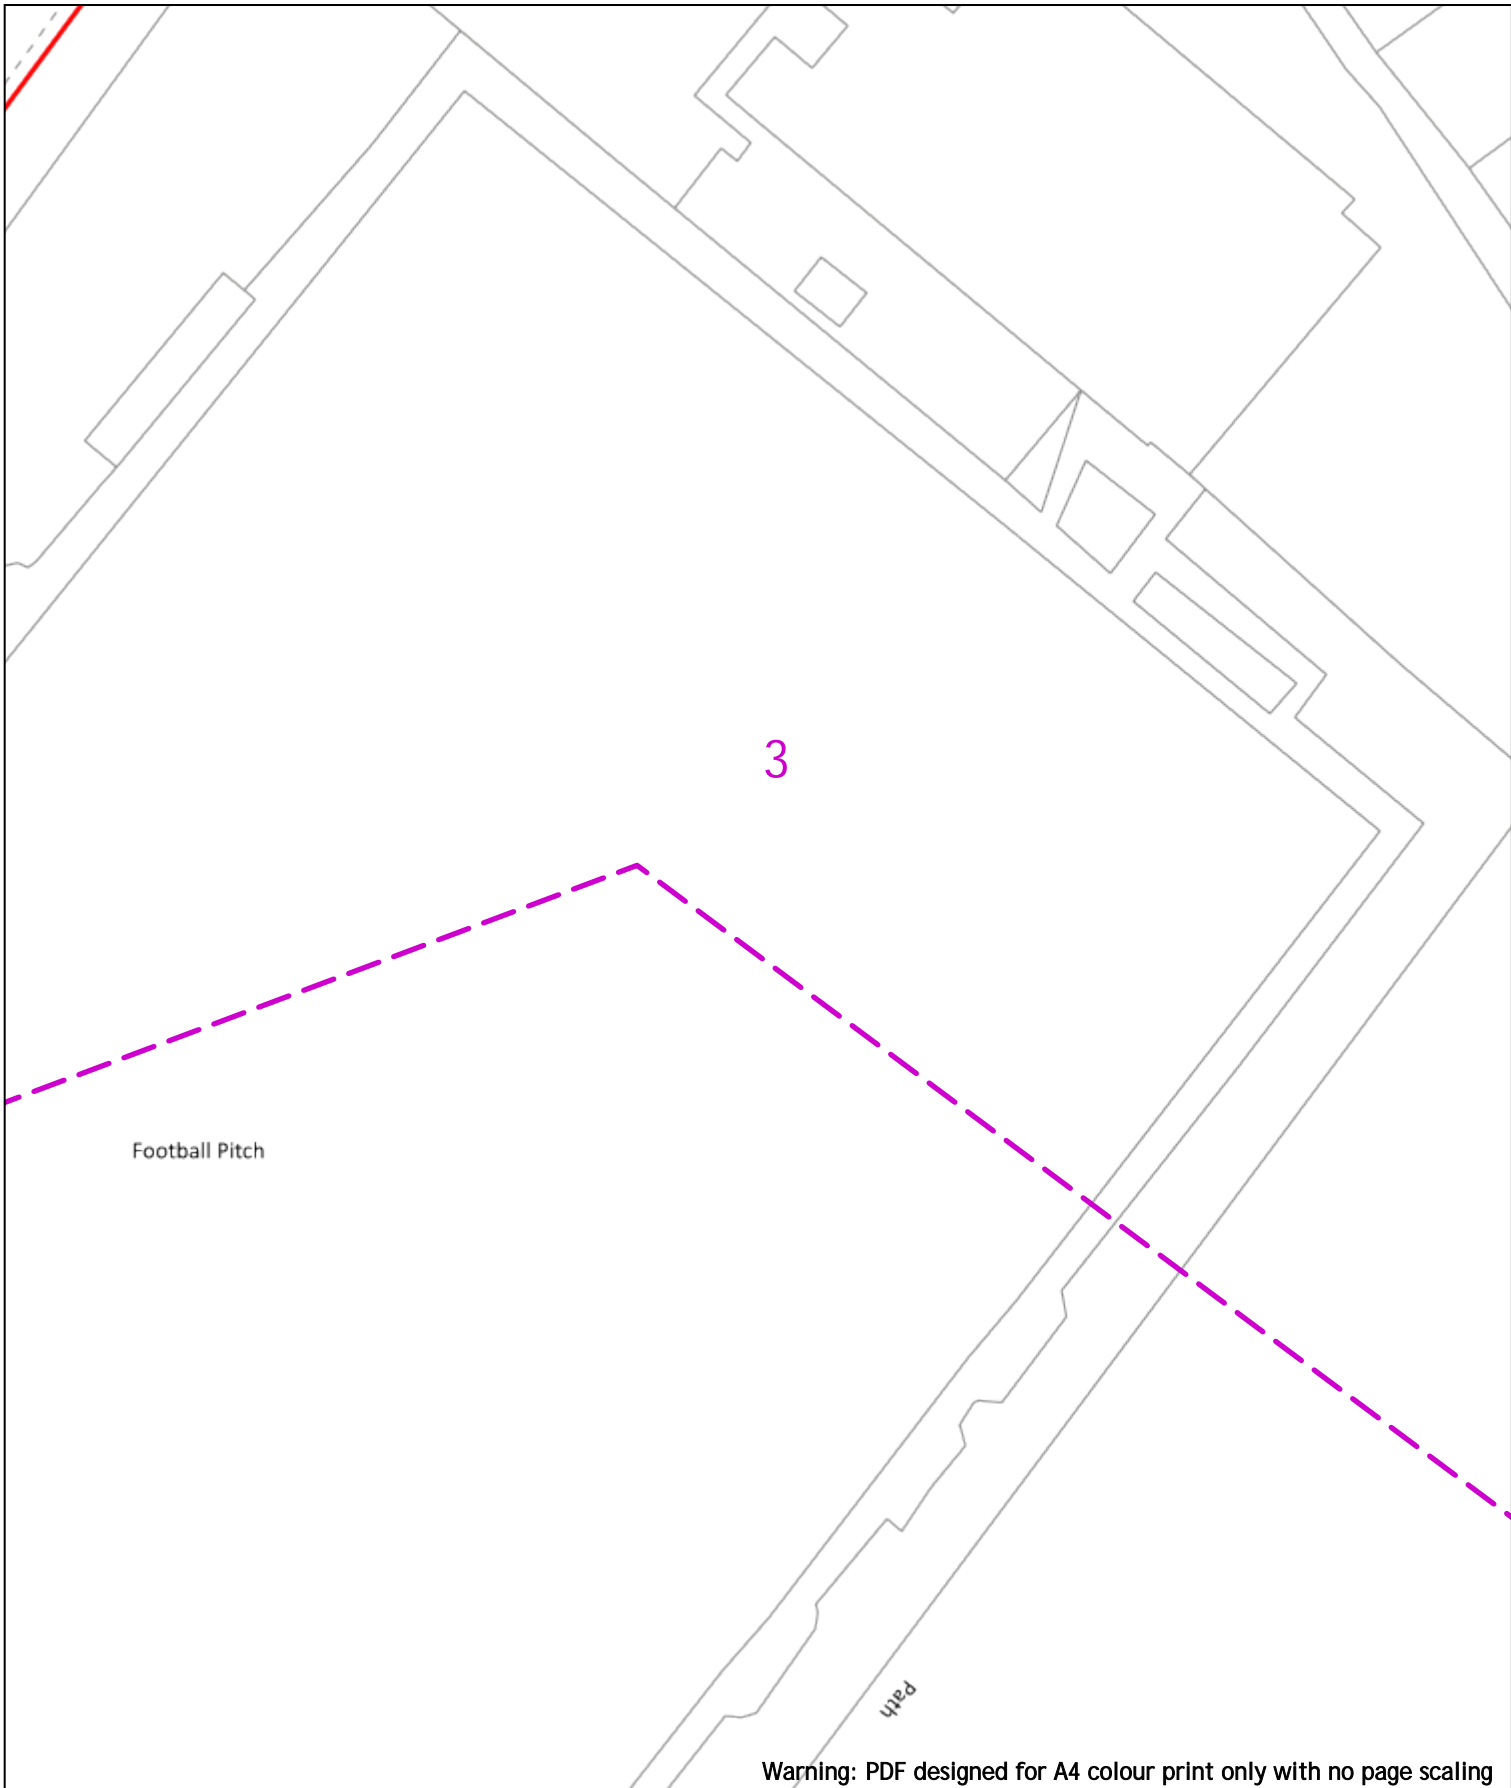


Warning: PDF designed for A4 colour print only with no page scaling

	<p>20m Dig Sites Area:  Line: </p>	<p><b>Extra High Voltage cables in vicinity</b></p>	
<p>Date Requested: 24/06/2022          Job Reference: 25881037          Site Location: 448662 213014          Requested by: Mr Joe Shawyer          Your Scheme/Reference: 31188_003</p>	<table border="1"> <thead> <tr> <th colspan="5">Voltages (V)</th> </tr> </thead> <tbody> <tr> <td>LV (Low Voltage) and Services</td> <td colspan="4">Up to 1,000V</td> </tr> <tr> <td>HV (High Voltage)</td> <td colspan="4">Over 1,000V to 11,000V</td> </tr> <tr> <td>EHV (Extra High Voltage)</td> <td colspan="4">22,000V to 132,000V</td> </tr> <tr> <td>Transmission</td> <td colspan="4">275,000V and 400,000V</td> </tr> </tbody> </table> <table border="1"> <thead> <tr> <th colspan="5">NORMAL DEPTH TO THE TOP OF THE CABLE WHEN LAID</th> </tr> <tr> <th>Services</th> <th>LV</th> <th>HV</th> <th>EHV</th> <th></th> </tr> </thead> <tbody> <tr> <td>Footpath/Unmade</td> <td>0.45m</td> <td>0.45m</td> <td>0.6m</td> <td>0.8m</td> </tr> <tr> <td>Road Crossing</td> <td>0.6m</td> <td>0.6m</td> <td>0.75m</td> <td>0.9m</td> </tr> <tr> <td>Agricultural</td> <td>1m</td> <td>1m</td> <td>1m</td> <td>1.1m</td> </tr> </tbody> </table>	Voltages (V)					LV (Low Voltage) and Services	Up to 1,000V				HV (High Voltage)	Over 1,000V to 11,000V				EHV (Extra High Voltage)	22,000V to 132,000V				Transmission	275,000V and 400,000V				NORMAL DEPTH TO THE TOP OF THE CABLE WHEN LAID					Services	LV	HV	EHV		Footpath/Unmade	0.45m	0.45m	0.6m	0.8m	Road Crossing	0.6m	0.6m	0.75m	0.9m	Agricultural	1m	1m	1m	1.1m	<table border="1"> <thead> <tr> <th colspan="2">Legend</th> <th colspan="2">Distribution Structures (Electric)</th> </tr> </thead> <tbody> <tr> <td></td> <td>Service Cable</td> <td></td> <td>Pole, Existing Location</td> </tr> <tr> <td></td> <td>LV Mains</td> <td></td> <td>Pole Structure, Existing Location - Single</td> </tr> <tr> <td></td> <td>2 - 11kV</td> <td></td> <td>Pole Structure, Existing Location - H</td> </tr> <tr> <td></td> <td>66kV</td> <td></td> <td>Duct Route</td> </tr> <tr> <td></td> <td>Fibre Optic</td> <td></td> <td></td> </tr> <tr> <td></td> <td>Pipe Cable</td> <td></td> <td></td> </tr> </tbody> </table> <p><b>WARNING</b>          There may have been subsequent alteration to the surface levels. Trial holes must be undertaken to determine position and depths of cables. HS (G) 47 Booklet from the Health and Safety Executive - Avoiding Danger from Buried Cables - should be consulted before commencing excavation work.  Wales No.04094290</p> <p>If you're unsure &amp; need to seek advice before commencing excavations, please contact:          General Enquiries: 0800 048 3516</p> <p>Subject to revision - Master held by SSEN Asset Data Team:  <a href="mailto:Asset.Data@sse.com">Asset.Data@sse.com</a>          01256 337 294</p>
Voltages (V)	
LV (Low Voltage) and Services	Up to 1,000V	
HV (High Voltage)	Over 1,000V to 11,000V	
EHV (Extra High Voltage)	22,000V to 132,000V	
Transmission	275,000V and 400,000V	
NORMAL DEPTH TO THE TOP OF THE CABLE WHEN LAID	
Services	LV	HV	EHV	
Footpath/Unmade	0.45m	0.45m	0.6m	0.8m	
Road Crossing	0.6m	0.6m	0.75m	0.9m	
Agricultural	1m	1m	1m	1.1m	
Legend		Distribution Structures (Electric)	
	Service Cable		Pole, Existing Location	
	LV Mains		Pole Structure, Existing Location - Single	
	2 - 11kV		Pole Structure, Existing Location - H	
	66kV		Duct Route	
	Fibre Optic	
	Pipe Cable	
<p>Scale: 1:500 (When plotted at A4)</p> <p><small>BASED UPON THE ORDNANCE SURVEY MAP WITH THE SANCTION OF THE CONTROLLER OF HM STATIONERY OFFICE CROWN COPYRIGHT RESERVED.          This copy has been made by or with the authority of Scottish and Southern Energy Power Distribution Ltd. Pursuant to section 47 of the Copyright, Designs and Patents Act 1988 ("The Act"). Unless the Act provides a relevant exception to copyright the copy must not be copied without prior permission of the copyright owner.          Plans generated by DigSAFE Pro™ software provided by LinesearchbeforeUdig.</small></p>	

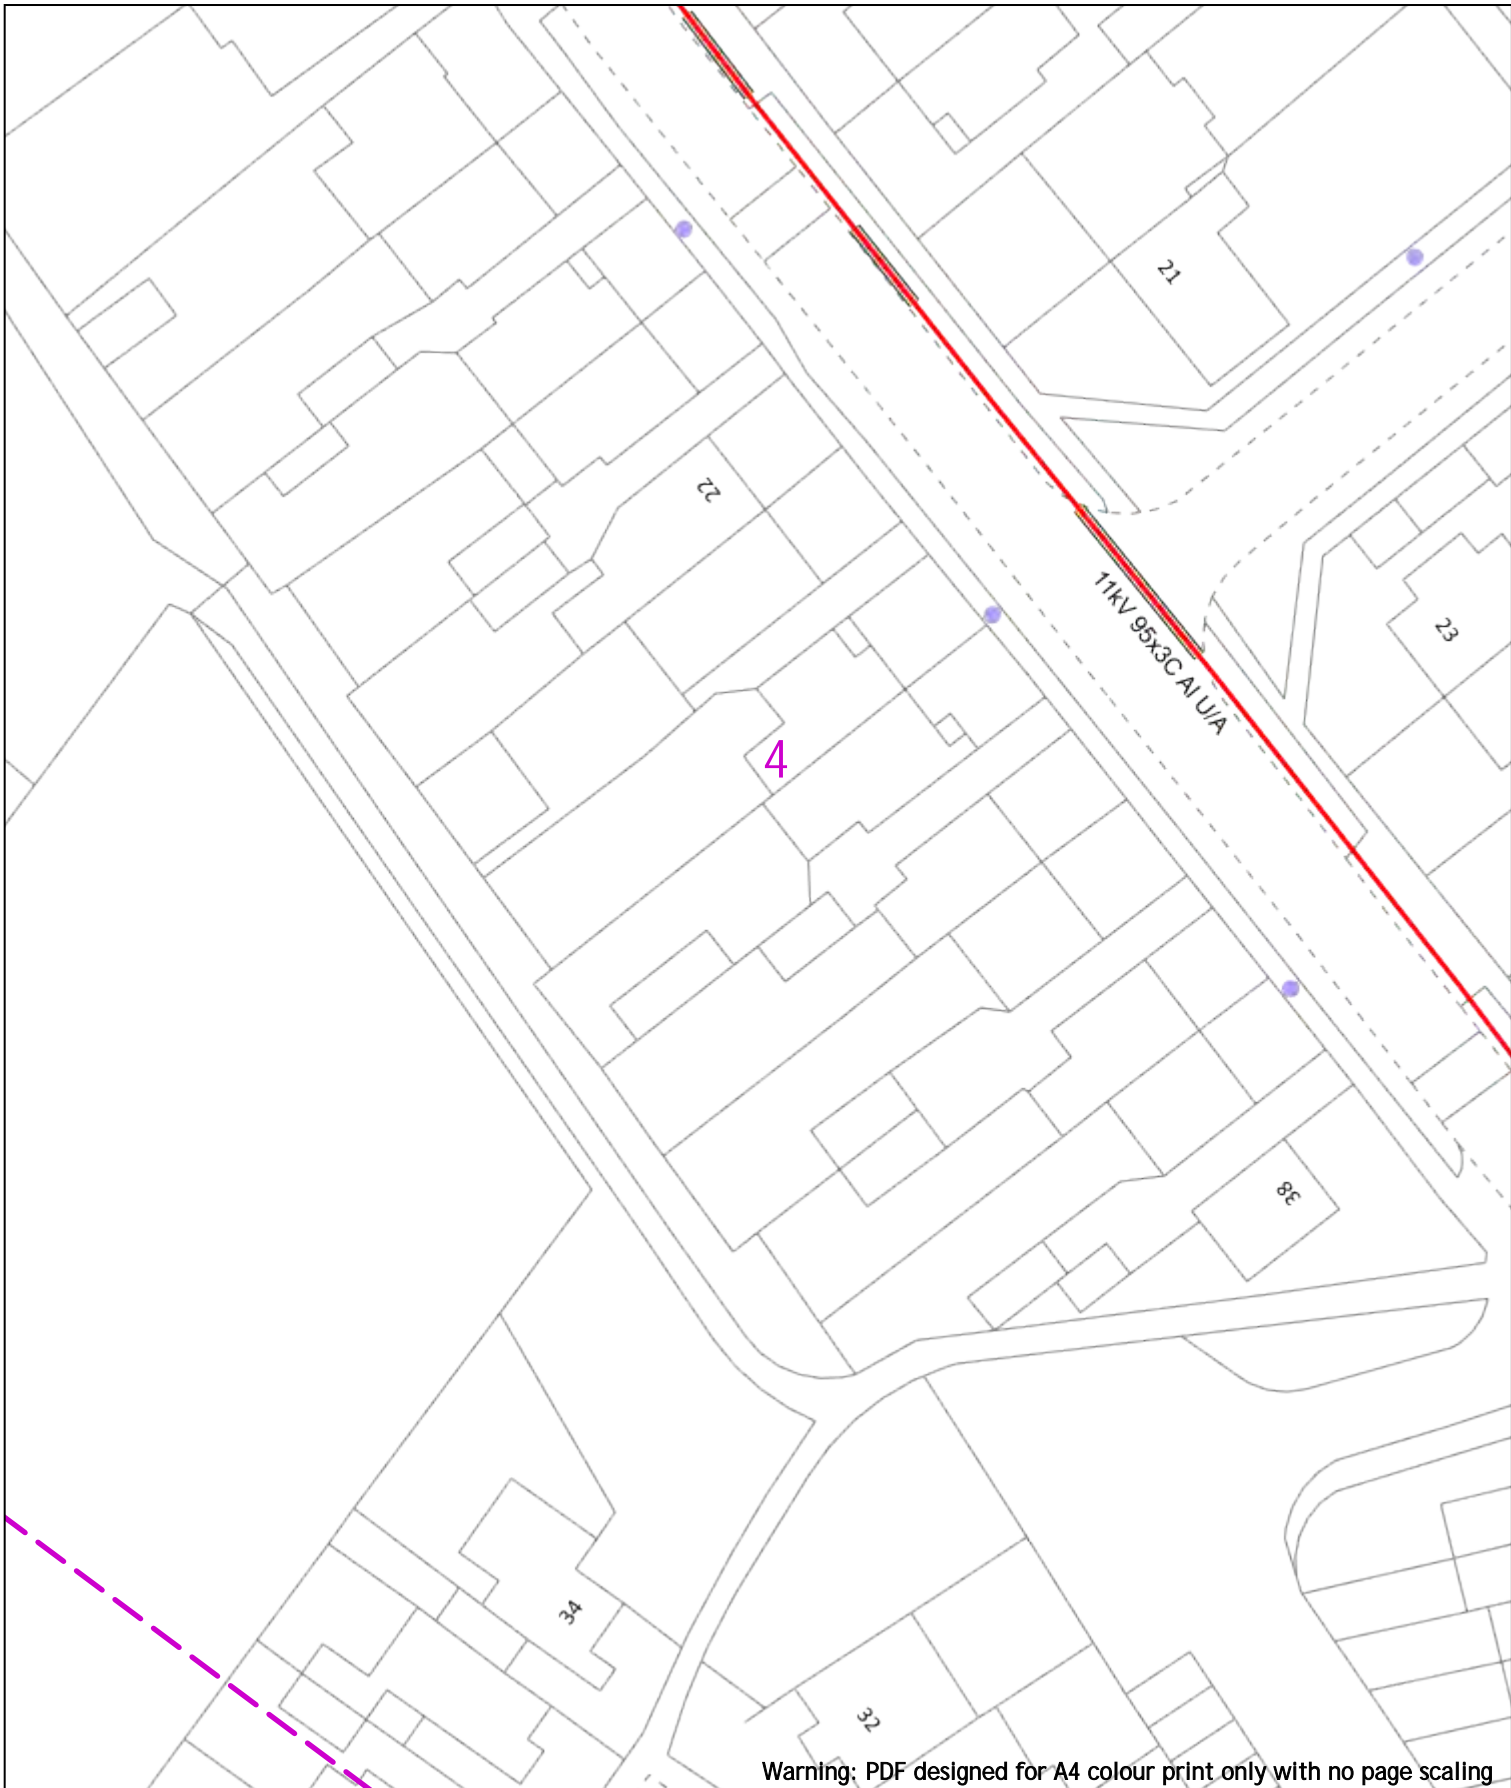

Warning: PDF designed for A4 colour print only with no page scaling

<p>0  20m</p>	<p>Dig Sites Area:  Line: </p>	<p><b>Extra High Voltage cables in vicinity</b></p>																									
<p>Date Requested: 24/06/2022          Job Reference: 25881037          Site Location: 448662 213014          Requested by: Mr Joe Shawyer          Your Scheme/Reference: 31188_003</p>	<p><b>Voltages (V)</b></p> <table border="1"> <tr> <td>LV (Low Voltage) and Services</td> <td>Up to 1,000V</td> </tr> <tr> <td>HV (High Voltage)</td> <td>Over 1,000V to 11,000V</td> </tr> <tr> <td>EHV (Extra High Voltage)</td> <td>22,000V to 132,000V</td> </tr> <tr> <td>Transmission</td> <td>275,000V and 400,000V</td> </tr> </table> <p><b>NORMAL DEPTH TO THE TOP OF THE CABLE WHEN LAID</b></p> <table border="1"> <thead> <tr> <th>Services</th> <th>LV</th> <th>HV</th> <th>EHV</th> </tr> </thead> <tbody> <tr> <td>Footpath/Unmade</td> <td>0.45m</td> <td>0.45m</td> <td>0.6m</td> </tr> <tr> <td>Road Crossing</td> <td>0.6m</td> <td>0.6m</td> <td>0.75m</td> </tr> <tr> <td>Agricultural</td> <td>1m</td> <td>1m</td> <td>1.1m</td> </tr> </tbody> </table>	LV (Low Voltage) and Services	Up to 1,000V	HV (High Voltage)	Over 1,000V to 11,000V	EHV (Extra High Voltage)	22,000V to 132,000V	Transmission	275,000V and 400,000V	Services	LV	HV	EHV	Footpath/Unmade	0.45m	0.45m	0.6m	Road Crossing	0.6m	0.6m	0.75m	Agricultural	1m	1m	1.1m	<p><b>Legend</b></p> <ul style="list-style-type: none"> <li>Service Cable</li> <li>LV Mains</li> <li>2 - 11kV</li> <li>66kV</li> <li>11kV</li> <li>22kV</li> <li>33kV</li> <li>66kV</li> <li>132kV</li> <li>275kV</li> <li>400kV</li> <li>Fibre Optic</li> <li>Pipe Cable</li> </ul> <p><b>Distribution Structures (Electric)</b></p> <ul style="list-style-type: none"> <li>Pole, Existing Location</li> <li>Pole Structure, Existing Location - Single</li> <li>Pole Structure, Existing Location - H</li> <li>Duct Route</li> <li>Cross Section Route</li> </ul>	<p><b>Southern Electric Power Distribution plc</b>          Registered Office: No.1 Forbury Place          43 Forbury Road Reading RG1 3JH          Registered In England &amp; Wales No.04094290</p> <p>If you're unsure &amp; need to seek advice before commencing excavations, please contact:          General Enquiries: 0800 048 3516</p> <p>Subject to revision – Master held by SSEN Asset Data Team:  <a href="mailto:Asset.Data@sse.com">Asset.Data@sse.com</a>          01256 337 294</p>
LV (Low Voltage) and Services	Up to 1,000V																										
HV (High Voltage)	Over 1,000V to 11,000V																										
EHV (Extra High Voltage)	22,000V to 132,000V																										
Transmission	275,000V and 400,000V																										
Services	LV	HV	EHV																								
Footpath/Unmade	0.45m	0.45m	0.6m																								
Road Crossing	0.6m	0.6m	0.75m																								
Agricultural	1m	1m	1.1m																								
<p>Scale: 1:500 (When plotted at A4)</p> <p><b>WARNING</b>          There may have been subsequent alteration to the surface levels. Trial holes must be undertaken to determine position and depths of cables. HS (G) 47 Booklet from the Health and Safety Executive – Avoiding Danger from Buried Cables – should be consulted before commencing excavation work.  <b>WHEN WORKING IN THE VICINITY OF OVERHEAD LINES THE HEALTH AND SAFETY GUIDANCE NOTES G56 SHOULD BE CONSULTED (AVAILABLE FROM THE HSE WEBSITE)</b></p> <p><small>BASED UPON THE ORDNANCE SURVEY MAP WITH THE SANCTION OF THE CONTROLLER OF HM STATIONERY OFFICE CROWN COPYRIGHT RESERVED.          This copy has been made by or with the authority of Scottish and Southern Energy Power Distribution Ltd. Pursuant to section 47 of the Copyright, Designs and Patents Act 1988 ("The Act"). Unless the Act provides a relevant exception to copyright the copy must not be copied without prior permission of the copyright owner.          Plans generated by DigSAFE Pro™ software provided by LinesearchbeforeDig.</small></p>																											

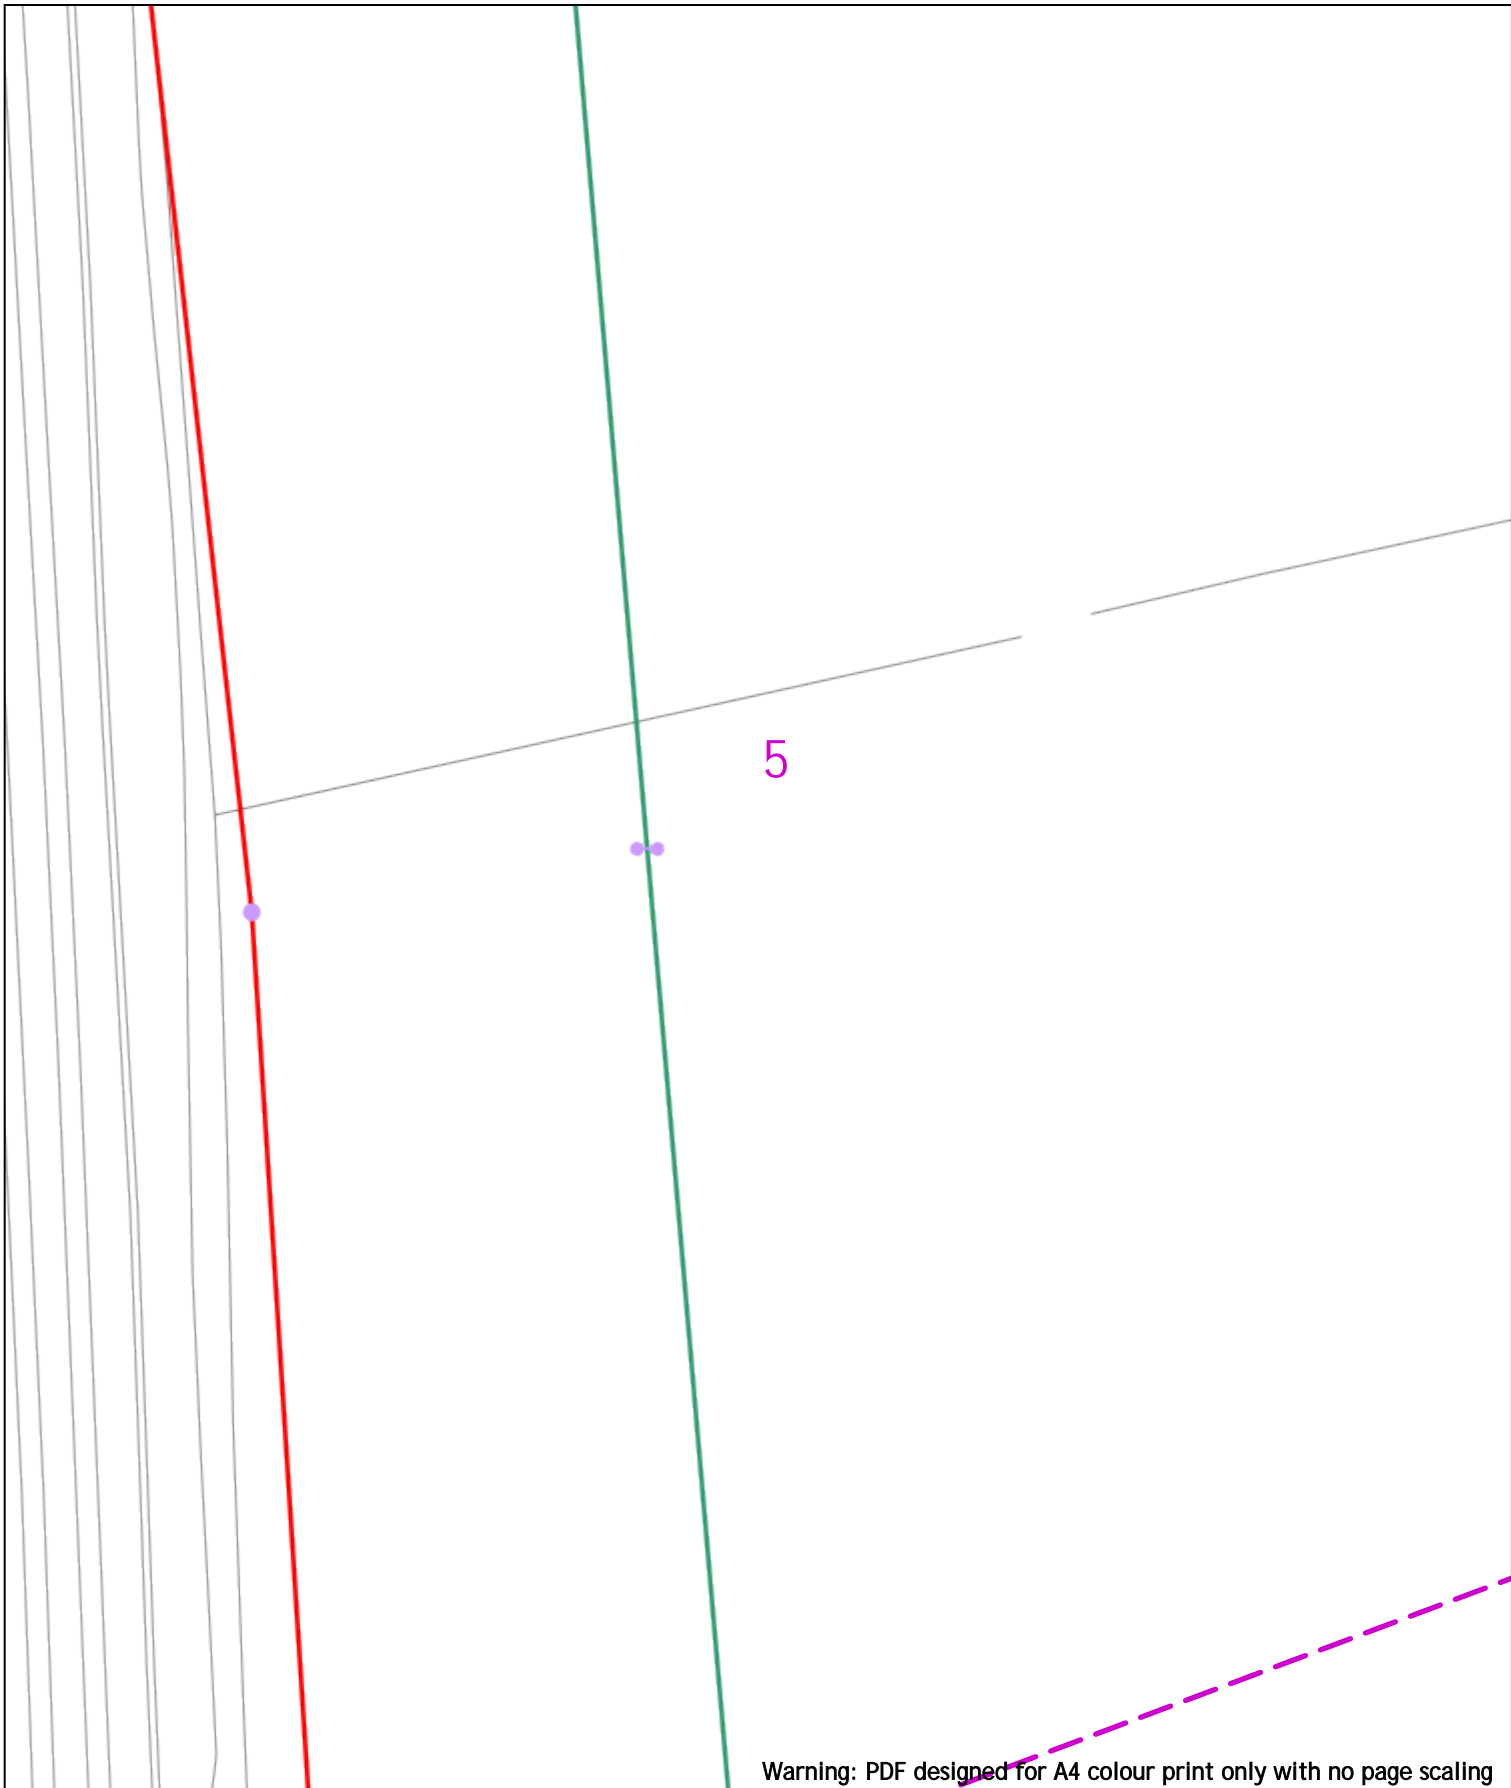

Warning: PDF designed for A4 colour print only with no page scaling

<p>0  20m Dig Sites Area:  Line: </p>	<p><b>Extra High Voltage cables in vicinity</b></p>																																		
<p>Date Requested: 24/06/2022          Job Reference: 25881037          Site Location: 448662 213014          Requested by: Mr Joe Shawyer          Your Scheme/Reference: 31188_003</p>	<p><b>Voltages (V)</b></p> <table border="1"> <tr> <td>LV (Low Voltage) and Services</td> <td colspan="3">Up to 1,000V</td> </tr> <tr> <td>HV (High Voltage)</td> <td colspan="3">Over 1,000V to 11,000V</td> </tr> <tr> <td>EHV (Extra High Voltage)</td> <td colspan="3">22,000V to 132,000V</td> </tr> <tr> <td>Transmission</td> <td colspan="3">275,000V and 400,000V</td> </tr> </table> <p><b>NORMAL DEPTH TO THE TOP OF THE CABLE WHEN LAID</b></p> <table border="1"> <thead> <tr> <th>Services</th> <th>LV</th> <th>HV</th> <th>EHV</th> </tr> </thead> <tbody> <tr> <td>Footpath/Unmade</td> <td>0.45m</td> <td>0.45m</td> <td>0.6m</td> </tr> <tr> <td>Road Crossing</td> <td>0.6m</td> <td>0.6m</td> <td>0.75m</td> </tr> <tr> <td>Agricultural</td> <td>1m</td> <td>1m</td> <td>1.1m</td> </tr> </tbody> </table>	LV (Low Voltage) and Services	Up to 1,000V			HV (High Voltage)	Over 1,000V to 11,000V			EHV (Extra High Voltage)	22,000V to 132,000V			Transmission	275,000V and 400,000V			Services	LV	HV	EHV	Footpath/Unmade	0.45m	0.45m	0.6m	Road Crossing	0.6m	0.6m	0.75m	Agricultural	1m	1m	1.1m	<p><b>Legend</b></p> <ul style="list-style-type: none"> <li>Service Cable</li> <li>LV Mains</li> <li>66kV</li> <li>11kV</li> <li>22kV</li> <li>33kV</li> <li>66kV</li> <li>132kV</li> <li>275kV</li> <li>400kV</li> <li>Fibre Optic</li> <li>Pipe Cable</li> </ul> <p><b>Distribution Structures (Electric)</b></p> <ul style="list-style-type: none"> <li>Pole, Existing Location</li> <li>Pole Structure, Existing Location - Single</li> <li>Pole Structure, Existing Location - H</li> <li>Duct Route</li> <li>Cross Section Route</li> </ul> <p><b>WARNING</b></p> <p>There may have been subsequent alteration to the surface levels. Trial holes must be undertaken to determine position and depths of cables. HS (G) 47 Booklet from the Health and Safety Executive - Avoiding Danger from Buried Cables - should be consulted before commencing excavation work.</p> <p><b>WHEN WORKING IN THE VICINITY OF OVERHEAD LINES THE HEALTH AND SAFETY GUIDANCE NOTES G56 SHOULD BE CONSULTED (AVAILABLE FROM THE HSE WEBSITE)</b></p>	<p><b>Southern Electric Power Distribution plc</b>          Registered Office: No.1 Forbury Place          43 Forbury Road Reading RG1 3JH          Registered In England &amp; Wales No.04094290</p> <p>If you're unsure &amp; need to seek advice before commencing excavations, please contact:          General Enquiries: 0800 048 3516</p> <p>Subject to revision - Master held by SSEN Asset Data Team:  <a href="mailto:Asset.Data@sse.com">Asset.Data@sse.com</a>          01256 337 294</p>
LV (Low Voltage) and Services	Up to 1,000V																																		
HV (High Voltage)	Over 1,000V to 11,000V																																		
EHV (Extra High Voltage)	22,000V to 132,000V																																		
Transmission	275,000V and 400,000V																																		
Services	LV	HV	EHV																																
Footpath/Unmade	0.45m	0.45m	0.6m																																
Road Crossing	0.6m	0.6m	0.75m																																
Agricultural	1m	1m	1.1m																																
<p>Scale: 1:500 (When plotted at A4)</p> <p>BASED UPON THE ORDNANCE SURVEY MAP WITH THE SANCTION OF THE CONTROLLER OF H.M. STATIONERY OFFICE CROWN COPYRIGHT RESERVED.          This copy has been made by or with the authority of Scottish and Southern Energy Power Distribution Ltd. Pursuant to section 47 of the Copyright, Designs and Patents Act 1988 ("The Act"). Unless the Act provides a relevant exception to copyright the copy must not be copied without prior permission of the copyright owner.          Plans generated by DigSAFE Pro™ software provided by LinesearchbeforeDig.</p>																																			

Drain

6

Warning: PDF designed for A4 colour print only with no page scaling

0  20m Dig Sites Area:  Line: 




**Extra High Voltage  
cables in vicinity**








Date Requested: 24/06/2022  
Job Reference: 25881037  
Site Location: 448662 213014  
Requested by: Mr Joe Shawyer

Your Scheme/Reference: 31188\_003

Voltages (V)			
LV (Low Voltage) and Services	Up to 1,000V		
HV (High Voltage)	Over 1,000V to 11,000V		
EHV (Extra High Voltage)	22,000V to 132,000V		
Transmission	275,000V and 400,000V		
NORMAL DEPTH TO THE TOP OF THE CABLE WHEN LAID			
Services	LV	HV	EHV
Footpath/Unmade	0.45m	0.45m	0.6m
Road Crossing	0.6m	0.6m	0.75m
Agricultural	1m	1m	1.1m

Legend	
	Service Cable
	LV Mains
	2 - 11kV
	66kV
	11kV
	22kV
	33kV
	66kV
	132kV
	275kV
	400kV
	Fibre Optic
	Pipe Cable

Distribution Structures (Electric)	
	Pole, Existing Location
	Pole Structure, Existing Location - Single
	Pole Structure, Existing Location - H
	Duct Route
	Cross Section Route

**WARNING**


There may have been subsequent alteration to the surface levels. Trial holes must be undertaken to determine position and depths of cables. HS (G) 47 Booklet from the Health and Safety Executive - Avoiding Danger from Buried Cables - should be consulted before commencing excavation work.  
WHEN WORKING IN THE VICINITY OF OVERHEAD LINES THE HEALTH AND SAFETY GUIDANCE NOTES G56 SHOULD BE CONSULTED (AVAILABLE FROM THE HSE WEBSITE)

**Southern Electric Power Distribution plc**  
Registered Office: No.1 Forbury Place  
43 Forbury Road Reading RG1 3JH  
Registered In England & Wales No.04094290

If you're unsure & need to seek advice before commencing excavations, please contact:  
General Enquiries: 0800 048 3516

Subject to revision - Master held by SSEN Asset Data Team:  
[Asset.Data@sse.com](mailto:Asset.Data@sse.com)  
01256 337 294


Scale: 1:500 (When plotted at A4)

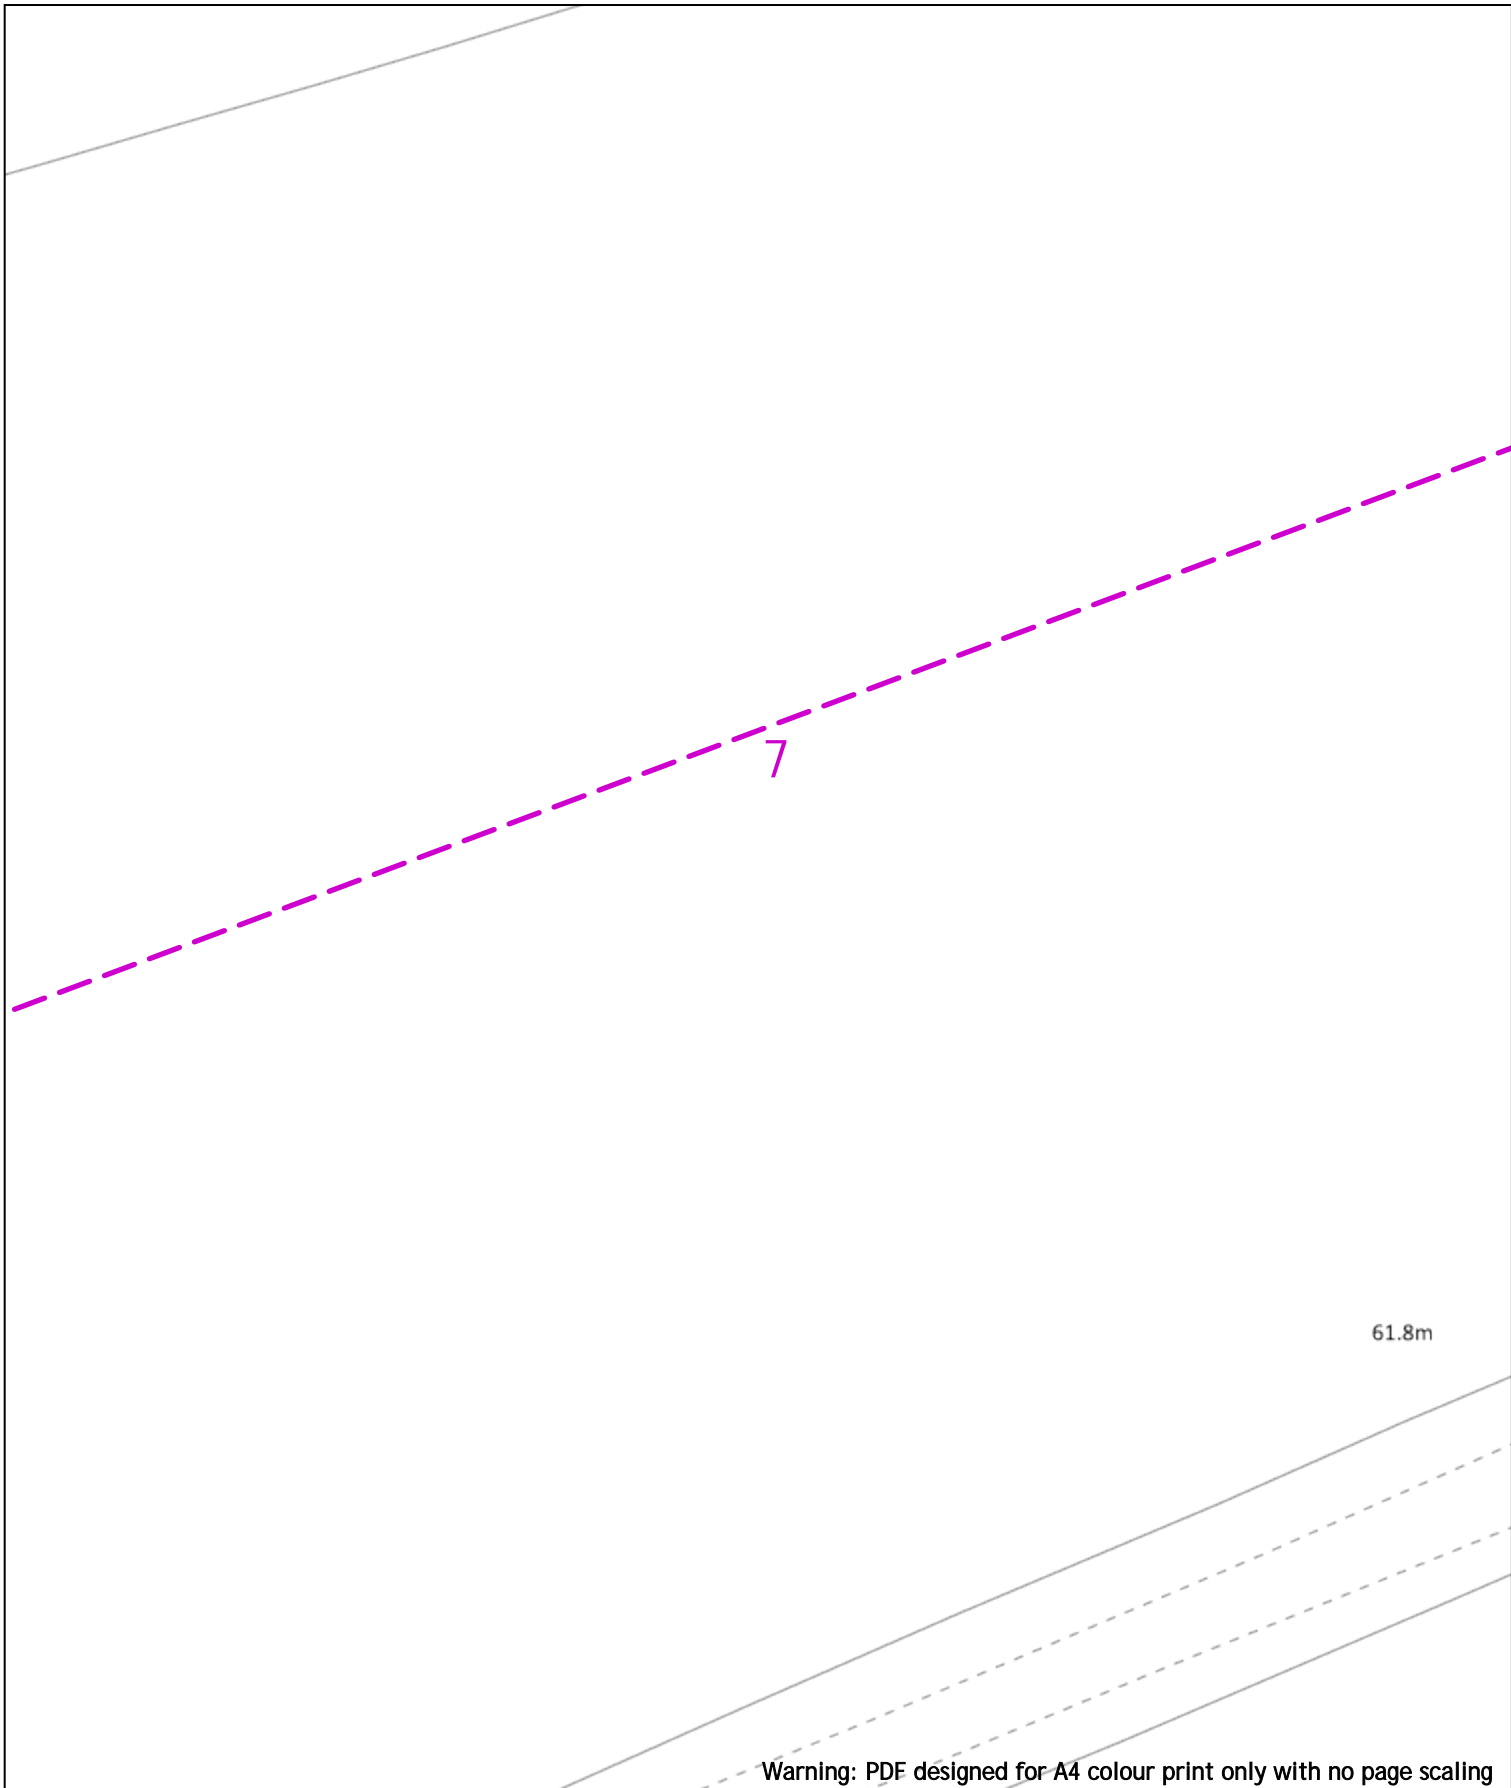

Warning: PDF designed for A4 colour print only with no page scaling

<p>0  20m</p>	<p>Dig Sites Area:  Line: </p>	<p>Extra High Voltage cables in vicinity</p>	
<p>Date Requested: 24/06/2022 Job Reference: 25881037 Site Location: 448662 213014 Requested by: Mr Joe Shawyer Your Scheme/Reference: 31188_003</p>	<table border="1" style="width: 100%; border-collapse: collapse;"> <thead> <tr> <th colspan="4">Voltages (V)</th> </tr> </thead> <tbody> <tr> <td>LV (Low Voltage) and Services</td> <td colspan="3">Up to 1,000V</td> </tr> <tr> <td>HV (High Voltage)</td> <td colspan="3">Over 1,000V to 11,000V</td> </tr> <tr> <td>EHV (Extra High Voltage)</td> <td colspan="3">22,000V to 132,000V</td> </tr> <tr> <td>Transmission</td> <td colspan="3">275,000V and 400,000V</td> </tr> </tbody> </table> <table border="1" style="width: 100%; border-collapse: collapse; margin-top: 5px;"> <thead> <tr> <th colspan="5">NORMAL DEPTH TO THE TOP OF THE CABLE WHEN LAID</th> </tr> <tr> <th>Services</th> <th>LV</th> <th>HV</th> <th>EHV</th> <th></th> </tr> </tbody> </table>	Voltages (V)				LV (Low Voltage) and Services	Up to 1,000V			HV (High Voltage)	Over 1,000V to 11,000V			EHV (Extra High Voltage)	22,000V to 132,000V			Transmission	275,000V and 400,000V			NORMAL DEPTH TO THE TOP OF THE CABLE WHEN LAID					Services	LV	HV	EHV		Footpath/Unmade	0.45m	0.45m	0.6m	0.8m	Road Crossing	0.6m	0.6m	0.75m	0.9m	Agricultural	1m	1m	1m	1.1m	<table border="1" style="width: 100%; border-collapse: collapse;"> <thead> <tr> <th colspan="2">Legend</th> </tr> </thead> <tbody> <tr> <td></td> <td>Service Cable</td> </tr> <tr> <td></td> <td>LV Mains</td> </tr> <tr> <td></td> <td>2 - 11kV</td> </tr> <tr> <td></td> <td>66kV</td> </tr> <tr> <td></td> <td>275kV</td> </tr> <tr> <td></td> <td>400kV</td> </tr> <tr> <td></td> <td>Fibre Optic</td> </tr> <tr> <td></td> <td>Pipe Cable</td> </tr> </tbody> </table> <table border="1" style="width: 100%; border-collapse: collapse; margin-top: 5px;"> <thead> <tr> <th colspan="2">Distribution Structures (Electric)</th> </tr> </thead> <tbody> <tr> <td></td> <td>Pole, Existing Location</td> </tr> <tr> <td></td> <td>Pole Structure, Existing Location - Single</td> </tr> <tr> <td></td> <td>Pole Structure, Existing Location - H</td> </tr> <tr> <td></td> <td>Duct Route</td> </tr> <tr> <td></td> <td>Cross Section Route</td> </tr> </tbody> </table>	Legend			Service Cable		LV Mains		2 - 11kV		66kV		110kV		220kV		330kV		660kV		1320kV		275kV		400kV		Fibre Optic		Pipe Cable	Distribution Structures (Electric)			Pole, Existing Location		Pole Structure, Existing Location - Single		Pole Structure, Existing Location - H		Duct Route		Cross Section Route	<p><b>Southern Electric Power Distribution plc</b> Registered Office: No.1 Forbury Place 43 Forbury Road Reading RG1 3JH Registered In England &amp; Wales No.04094290</p> <p>If you're unsure &amp; need to seek advice before commencing excavations, please contact: General Enquiries: 0800 048 3516</p> <p>Subject to revision – Master held by SSEN Asset Data Team: <a href="mailto:Asset.Data@sse.com">Asset.Data@sse.com</a> 01256 337 294</p>
Voltages (V)	
LV (Low Voltage) and Services	Up to 1,000V	
HV (High Voltage)	Over 1,000V to 11,000V	
EHV (Extra High Voltage)	22,000V to 132,000V	
Transmission	275,000V and 400,000V	
NORMAL DEPTH TO THE TOP OF THE CABLE WHEN LAID	
Services	LV	HV	EHV	
Legend	
	Service Cable	
	LV Mains	
	2 - 11kV	
	66kV	
	275kV	
	400kV	
	Fibre Optic	
	Pipe Cable	
Distribution Structures (Electric)	
	Pole, Existing Location	
	Pole Structure, Existing Location - Single	
	Pole Structure, Existing Location - H	
	Duct Route	
	Cross Section Route	
<p>Scale: 1:500 (When plotted at A4)</p>		<p><b>WARNING</b></p> <p>There may have been subsequent alteration to the surface levels. Trial holes must be undertaken to determine position and depths of cables. HS (G) 47 Booklet from the Health and Safety Executive – Avoiding Danger from Buried Cables – should be consulted before commencing excavation work.</p> <p><b>WHEN WORKING IN THE VICINITY OF OVERHEAD LINES THE HEALTH AND SAFETY GUIDANCE NOTES G56 SHOULD BE CONSULTED (AVAILABLE FROM THE HSE WEBSITE)</b></p>	


BASED UPON THE ORDNANCE SURVEY MAP WITH THE SANCTION OF THE CONTROLLER OF HM STATIONERY OFFICE CROWN COPYRIGHT RESERVED.  
This copy has been made by or with the authority of Scottish and Southern Energy Power Distribution Ltd. Pursuant to section 47 of the Copyright, Designs and Patents Act 1988 ("The Act"). Unless the Act provides a relevant exception to copyright the copy must not be copied without prior permission of the copyright owner.  
Plans generated by DigSAFE Pro™ software provided by LinesearchbeforeUdig.

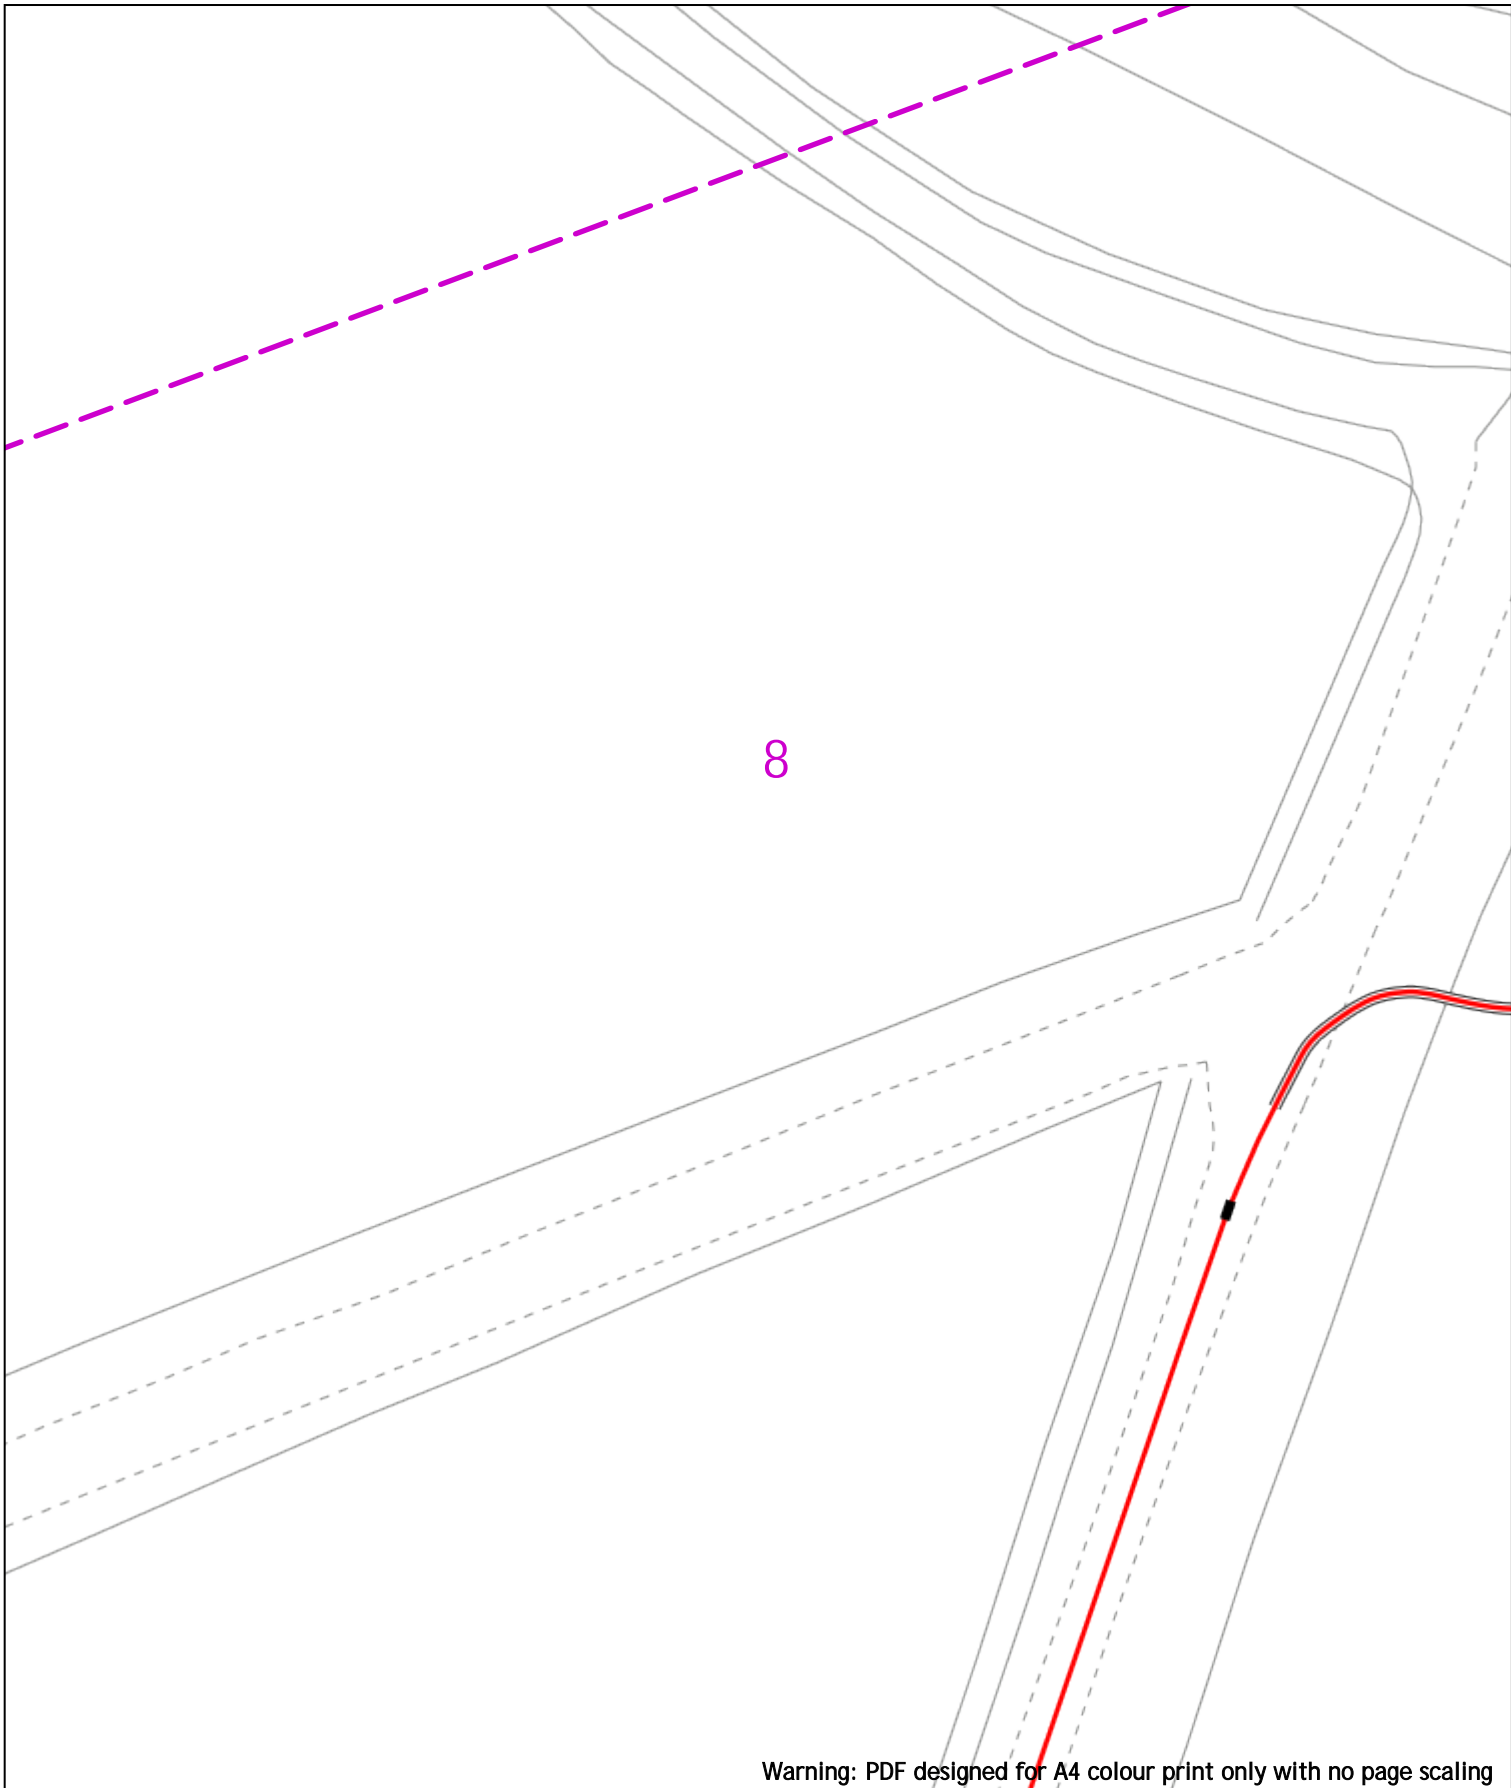

Warning: PDF designed for A4 colour print only with no page scaling

<p>0  20m</p> <p>Date Requested: 24/06/2022          Job Reference: 25881037          Site Location: 448662 213014          Requested by: Mr Joe Shawyer          Your Scheme/Reference: 31188_003</p>	<p>Dig Sites Area:  Line: </p>	<p><b>Extra High Voltage cables in vicinity</b></p>	
<table border="1" style="width: 100%; border-collapse: collapse;"> <thead> <tr> <th colspan="4">Voltages (V)</th> </tr> </thead> <tbody> <tr> <td>LV (Low Voltage) and Services</td> <td colspan="3">Up to 1,000V</td> </tr> <tr> <td>HV (High Voltage)</td> <td colspan="3">Over 1,000V to 11,000V</td> </tr> <tr> <td>EHV (Extra High Voltage)</td> <td colspan="3">22,000V to 132,000V</td> </tr> <tr> <td>Transmission</td> <td colspan="3">275,000V and 400,000V</td> </tr> </tbody> </table> <table border="1" style="width: 100%; border-collapse: collapse; margin-top: 5px;"> <thead> <tr> <th colspan="5">NORMAL DEPTH TO THE TOP OF THE CABLE WHEN LAID</th> </tr> <tr> <th>Services</th> <th>LV</th> <th>HV</th> <th>EHV</th> <th></th> </tr> </thead> <tbody> <tr> <td>Footpath/Unmade</td> <td>0.45m</td> <td>0.45m</td> <td>0.6m</td> <td>0.8m</td> </tr> <tr> <td>Road Crossing</td> <td>0.6m</td> <td>0.6m</td> <td>0.75m</td> <td>0.9m</td> </tr> <tr> <td>Agricultural</td> <td>1m</td> <td>1m</td> <td>1m</td> <td>1.1m</td> </tr> </tbody> </table>		Voltages (V)				LV (Low Voltage) and Services	Up to 1,000V			HV (High Voltage)	Over 1,000V to 11,000V			EHV (Extra High Voltage)	22,000V to 132,000V			Transmission	275,000V and 400,000V			NORMAL DEPTH TO THE TOP OF THE CABLE WHEN LAID					Services	LV	HV	EHV		Footpath/Unmade	0.45m	0.45m	0.6m	0.8m	Road Crossing	0.6m	0.6m	0.75m	0.9m	Agricultural	1m	1m	1m	1.1m	<table border="1" style="width: 100%; border-collapse: collapse;"> <thead> <tr> <th colspan="2">Legend</th> <th colspan="2">Distribution Structures (Electric)</th> </tr> </thead> <tbody> <tr> <td></td> <td>Service Cable</td> <td></td> <td>Pole, Existing Location</td> </tr> <tr> <td></td> <td>LV Mains</td> <td></td> <td>Pole Structure, Existing Location - Single</td> </tr> <tr> <td></td> <td>66kV</td> <td></td> <td>Pole Structure, Existing Location - H</td> </tr> <tr> <td></td> <td>11kV</td> <td></td> <td>Duct Route</td> </tr> <tr> <td></td> <td>22kV</td> <td></td> <td>Cross Section Route</td> </tr> <tr> <td></td> <td>33kV</td> <td></td> <td></td> </tr> <tr> <td></td> <td>66kV</td> <td></td> <td></td> </tr> <tr> <td></td> <td>132kV</td> <td></td> <td></td> </tr> <tr> <td></td> <td>275kV</td> <td></td> <td></td> </tr> <tr> <td></td> <td>400kV</td> <td></td> <td></td> </tr> <tr> <td></td> <td>Fibre Optic</td> <td></td> <td></td> </tr> <tr> <td></td> <td>Pipe Cable</td> <td></td> <td></td> </tr> </tbody> </table>		Legend		Distribution Structures (Electric)			Service Cable		Pole, Existing Location		LV Mains		Pole Structure, Existing Location - Single		66kV		Pole Structure, Existing Location - H		11kV		Duct Route		22kV		Cross Section Route		33kV				66kV				132kV				275kV				400kV				Fibre Optic				Pipe Cable		
Voltages (V)	
LV (Low Voltage) and Services	Up to 1,000V	
HV (High Voltage)	Over 1,000V to 11,000V	
EHV (Extra High Voltage)	22,000V to 132,000V	
Transmission	275,000V and 400,000V	
NORMAL DEPTH TO THE TOP OF THE CABLE WHEN LAID	
Services	LV	HV	EHV	
Footpath/Unmade	0.45m	0.45m	0.6m	0.8m	
Road Crossing	0.6m	0.6m	0.75m	0.9m	
Agricultural	1m	1m	1m	1.1m	
Legend		Distribution Structures (Electric)	
	Service Cable		Pole, Existing Location	
	LV Mains		Pole Structure, Existing Location - Single	
	66kV		Pole Structure, Existing Location - H	
	11kV		Duct Route	
	22kV		Cross Section Route	
	33kV	
	66kV	
	132kV	
	275kV	
	400kV	
	Fibre Optic	
	Pipe Cable	
<p>Scale: 1:500 (When plotted at A4)</p>		<p><b>WARNING</b></p> <p>There may have been subsequent alteration to the surface levels. Trial holes must be undertaken to determine position and depths of cables. HS (G) 47 Booklet from the Health and Safety Executive - Avoiding Danger from Buried Cables - should be consulted before commencing excavation work.</p> <p><b>WHEN WORKING IN THE VICINITY OF OVERHEAD LINES THE HEALTH AND SAFETY GUIDANCE NOTES G56 SHOULD BE CONSULTED (AVAILABLE FROM THE HSE WEBSITE)</b></p>	

BASED UPON THE ORDNANCE SURVEY MAP WITH THE SANCTION OF THE CONTROLLER OF HM STATIONERY OFFICE CROWN COPYRIGHT RESERVED.  
 This copy has been made by or with the authority of Scottish and Southern Energy Power Distribution Ltd. Pursuant to section 47 of the Copyright, Designs and Patents Act 1988 ("The Act"). Unless the Act provides a relevant exception to copyright the copy must not be copied without prior permission of the copyright owner.  
 Plans generated by DigSAFE Pro™ software provided by LinesearchbeforeUdig.

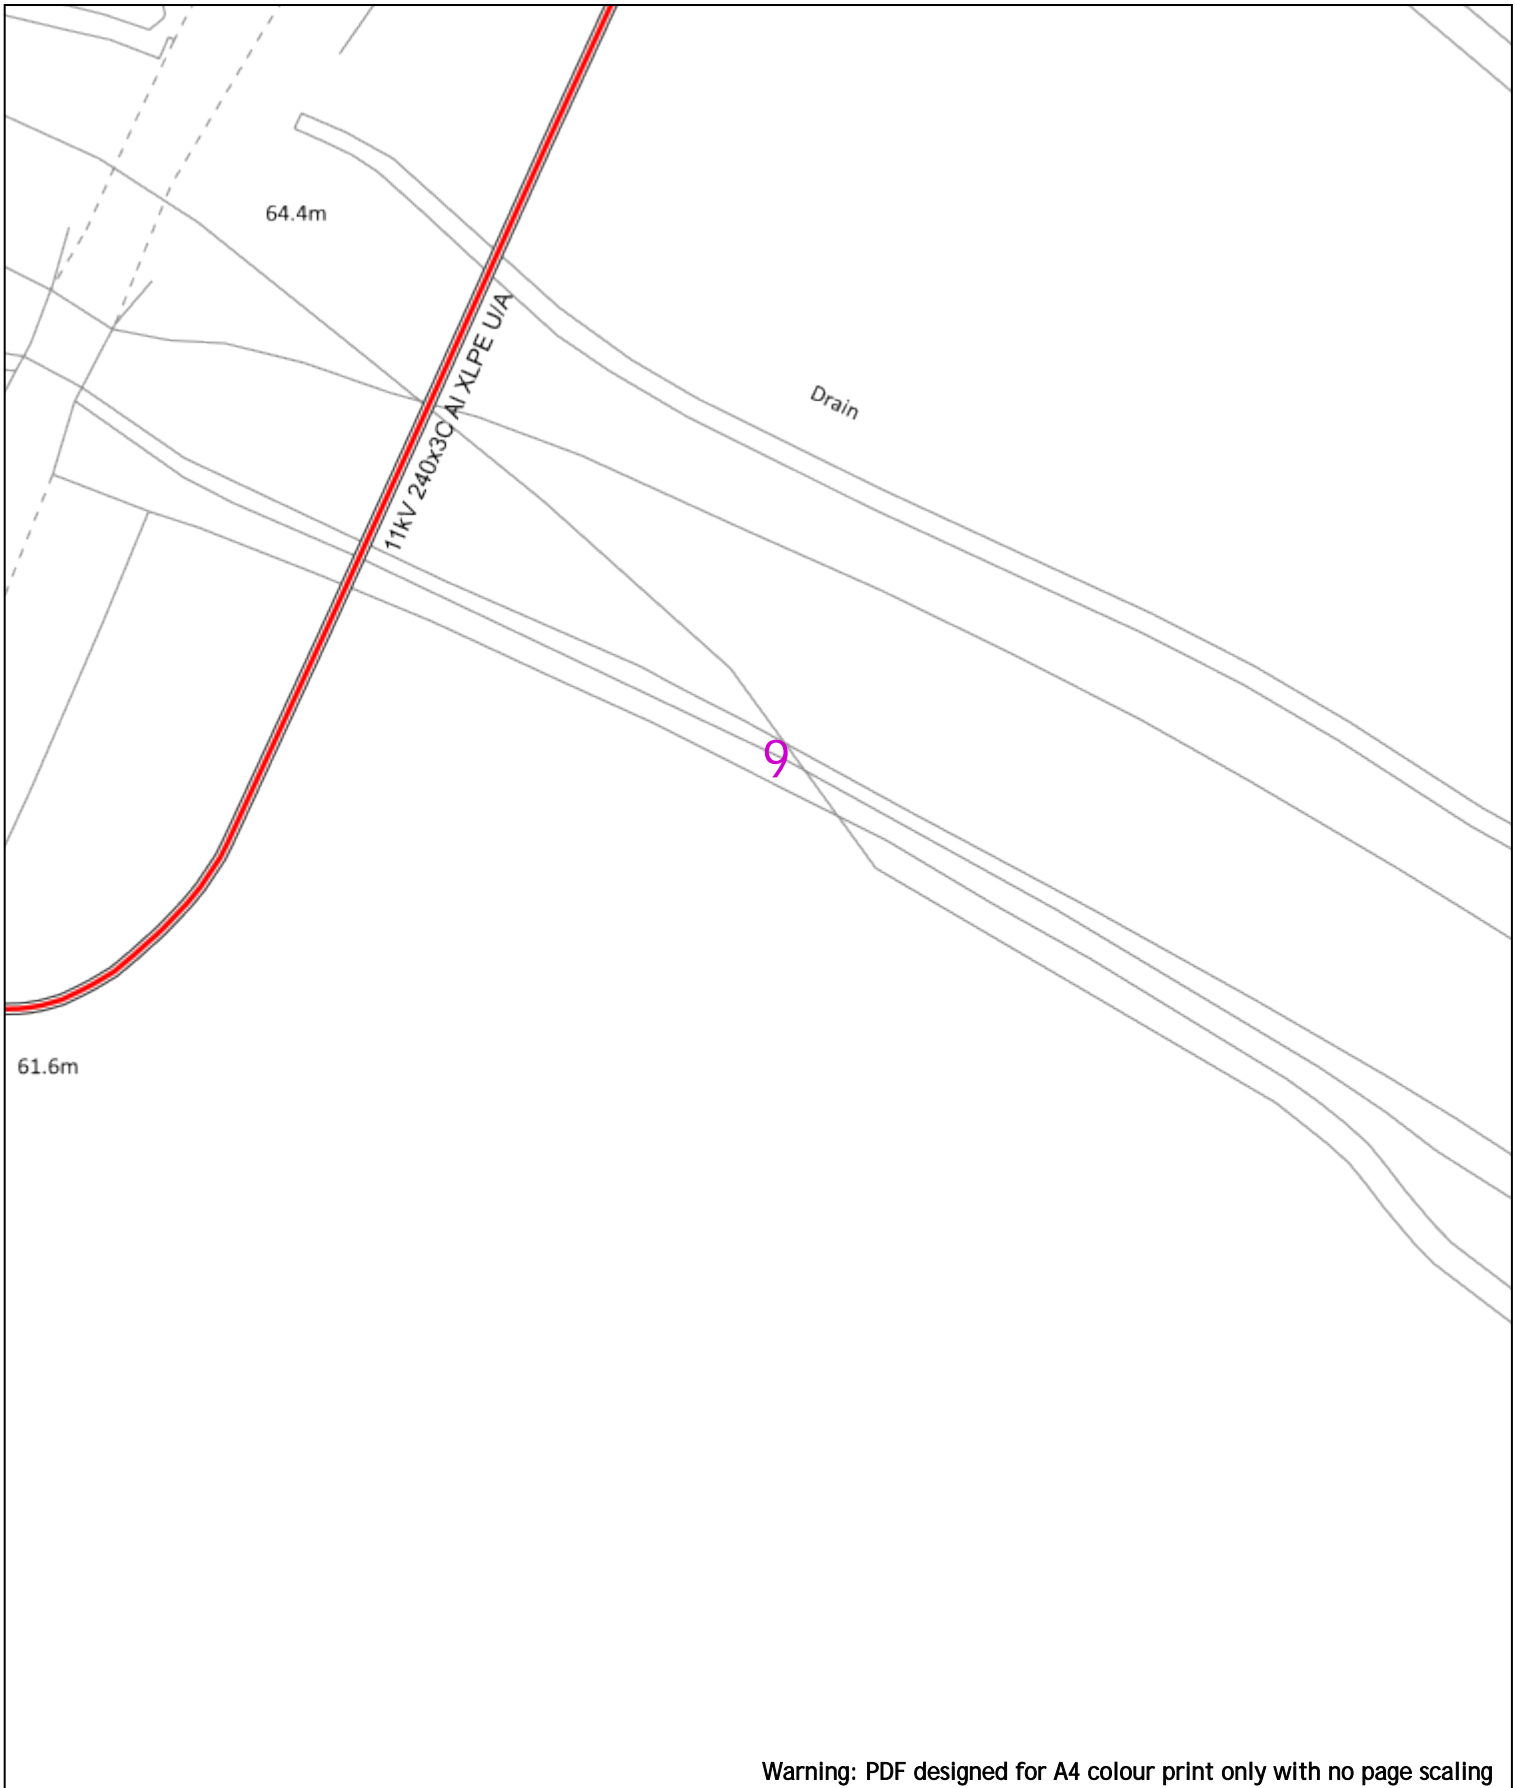

Warning: PDF designed for A4 colour print only with no page scaling

<p>0  20m</p> <p>Date Requested: 24/06/2022          Job Reference: 25881037          Site Location: 448662 213014          Requested by: Mr Joe Shawyer          Your Scheme/Reference: 31188_003</p>	<p>Dig Sites:  Area:  Line: </p> <p style="text-align: center; background-color: red; color: white; padding: 5px;"><b>Extra High Voltage cables in vicinity</b></p>	<p></p> <p></p>	<p style="text-align: center;"><b>Legend</b></p> <table style="width: 100%; font-size: small;"> <tr> <td style="width: 50%;"> <p>Service Cable</p> <p>LV Mains</p> <p>2 - 11kV</p> <p>6.6kV</p> <p>11kV</p> <p>22kV</p> <p>33kV</p> <p>66kV</p> <p>132kV</p> <p>275kV</p> <p>400kV</p> <p>Fibre Optic</p> <p>Pipe Cable</p> </td> <td style="width: 50%;"> <p><b>Distribution Structures (Electric)</b></p> <p>Pole, Existing Location</p> <p>Pole Structure, Existing Location - Single</p> <p>Pole Structure, Existing Location - H</p> <p>Duct Route</p> <p>Cross Section Route</p> </td> </tr> </table> <p style="text-align: center; font-weight: bold; font-size: x-small;">WARNING</p> <p style="font-size: x-small;">There may have been subsequent alteration to the surface levels. Trial holes must be undertaken to determine position and depths of cables. HS (G) 47 Booklet from the Health and Safety Executive - Avoiding Danger from Buried Cables - should be consulted before commencing excavation work.</p> <p style="font-size: x-small; text-align: center;">WHEN WORKING IN THE VICINITY OF OVERHEAD LINES THE HEALTH AND SAFETY GUIDANCE NOTES G56 SHOULD BE CONSULTED (AVAILABLE FROM THE HSE WEBSITE)</p>	<p>Service Cable</p> <p>LV Mains</p> <p>2 - 11kV</p> <p>6.6kV</p> <p>11kV</p> <p>22kV</p> <p>33kV</p> <p>66kV</p> <p>132kV</p> <p>275kV</p> <p>400kV</p> <p>Fibre Optic</p> <p>Pipe Cable</p>	<p><b>Distribution Structures (Electric)</b></p> <p>Pole, Existing Location</p> <p>Pole Structure, Existing Location - Single</p> <p>Pole Structure, Existing Location - H</p> <p>Duct Route</p> <p>Cross Section Route</p>
<p>Service Cable</p> <p>LV Mains</p> <p>2 - 11kV</p> <p>6.6kV</p> <p>11kV</p> <p>22kV</p> <p>33kV</p> <p>66kV</p> <p>132kV</p> <p>275kV</p> <p>400kV</p> <p>Fibre Optic</p> <p>Pipe Cable</p>	<p><b>Distribution Structures (Electric)</b></p> <p>Pole, Existing Location</p> <p>Pole Structure, Existing Location - Single</p> <p>Pole Structure, Existing Location - H</p> <p>Duct Route</p> <p>Cross Section Route</p>				
<p>Scale: 1:500 (When plotted at A4)</p>	<p style="text-align: center; font-weight: bold;">Southern Electric Power Distribution plc</p> <p style="text-align: center; font-size: x-small;">Registered Office: No.1 Forbury Place          43 Forbury Road Reading RG1 3JH          Registered In England &amp; Wales No.04094290</p> <p style="font-size: x-small;">If you're unsure &amp; need to seek advice before commencing excavations, please contact:          General Enquiries: 0800 048 3516</p> <p style="font-size: x-small;">Subject to revision - Master held by SSEN Asset Data Team:  <a href="mailto:Asset.Data@sse.com">Asset.Data@sse.com</a>          01256 337 294</p>				



10

74

80

Warning: PDF designed for A4 colour print only with no page scaling

0 20m Dig Sites Area: Line:

**Extra High Voltage cables in vicinity**



Date Requested: 24/06/2022  
 Job Reference: 25881037  
 Site Location: 448662 213014  
 Requested by: Mr Joe Shawyer  
 Your Scheme/Reference: 31188\_003

Voltages (V)				
LV (Low Voltage) and Services	Up to 1,000V			
HV (High Voltage)	Over 1,000V to 11,000V			
EHV (Extra High Voltage)	22,000V to 132,000V			
Transmission	275,000V and 400,000V			
NORMAL DEPTH TO THE TOP OF THE CABLE WHEN LAID				
Services	LV	HV	EHV	
Footpath/Unmade	0.45m	0.45m	0.6m	0.8m
Road Crossing	0.6m	0.6m	0.75m	0.9m
Agricultural	1m	1m	1m	1.1m

Legend	
	Service Cable
	LV Mains
	2 - 11kV
	66kV
	11kV
	22kV
	33kV
	66kV
	132kV
	275kV
	400kV
	Fibre Optic
	Pipe Cable

Distribution Structures (Electric)	
	Pole, Existing Location
	Pole Structure, Existing Location - Single
	Pole Structure, Existing Location - H
	Duct Route
	Cross Section Route


**Southern Electric Power Distribution plc**  
 Registered Office: No.1 Forbury Place  
 43 Forbury Road Reading RG1 3JH  
 Registered In England & Wales No.04094290

If you're unsure & need to seek advice before commencing excavations, please contact:  
 General Enquiries: 0800 048 3516

Subject to revision – Master held by SSEN Asset Data Team:  
[Asset.Data@sse.com](mailto:Asset.Data@sse.com)  
 01256 337 294


Scale: 1:500 (When plotted at A4)

**WARNING**  
 There may have been subsequent alteration to the surface levels. Trial holes must be undertaken to determine position and depths of cables. HS (G) 47 Booklet from the Health and Safety Executive – Avoiding Danger from Buried Cables – should be consulted before commencing excavation work.  
**WHEN WORKING IN THE VICINITY OF OVERHEAD LINES THE HEALTH AND SAFETY GUIDANCE NOTES G56 SHOULD BE CONSULTED (AVAILABLE FROM THE HSE WEBSITE)**

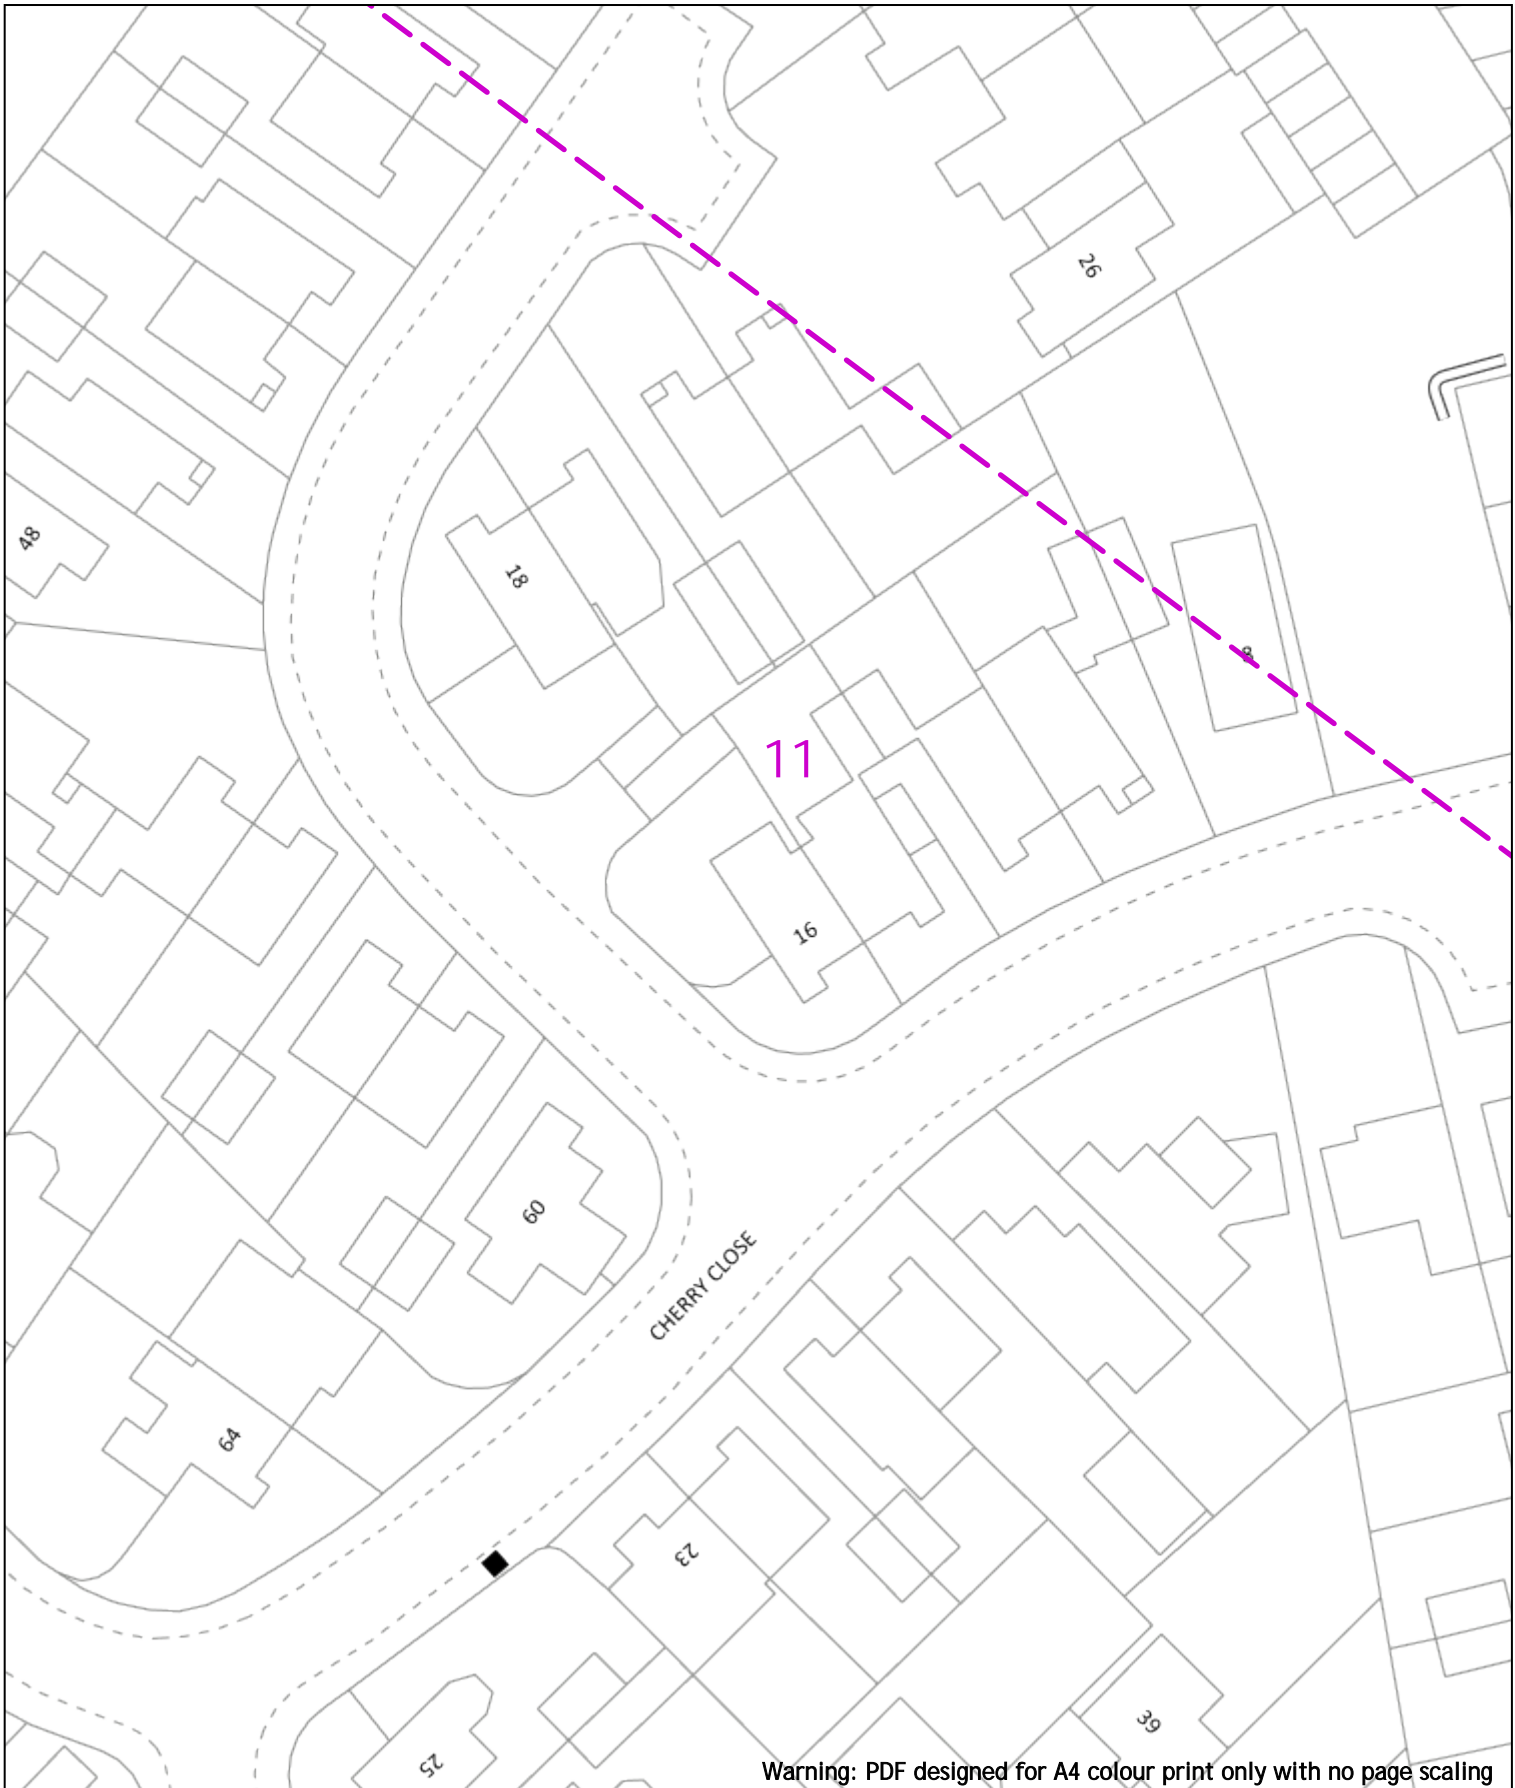

Warning: PDF designed for A4 colour print only with no page scaling

<p>0  20m Dig Sites Area:  Line: </p>	<p><b>Extra High Voltage cables in vicinity</b></p>																																		
<p>Date Requested: 24/06/2022          Job Reference: 25881037          Site Location: 448662 213014          Requested by: Mr Joe Shawyer          Your Scheme/Reference: 31188_003</p>	<p><b>Voltages (V)</b></p> <table border="1"> <tr> <td>LV (Low Voltage) and Services</td> <td colspan="3">Up to 1,000V</td> </tr> <tr> <td>HV (High Voltage)</td> <td colspan="3">Over 1,000V to 11,000V</td> </tr> <tr> <td>EHV (Extra High Voltage)</td> <td colspan="3">22,000V to 132,000V</td> </tr> <tr> <td>Transmission</td> <td colspan="3">275,000V and 400,000V</td> </tr> </table> <p><b>NORMAL DEPTH TO THE TOP OF THE CABLE WHEN LAID</b></p> <table border="1"> <thead> <tr> <th>Services</th> <th>LV</th> <th>HV</th> <th>EHV</th> </tr> </thead> <tbody> <tr> <td>Footpath/Unmade</td> <td>0.45m</td> <td>0.45m</td> <td>0.6m</td> </tr> <tr> <td>Road Crossing</td> <td>0.6m</td> <td>0.6m</td> <td>0.75m</td> </tr> <tr> <td>Agricultural</td> <td>1m</td> <td>1m</td> <td>1.1m</td> </tr> </tbody> </table>	LV (Low Voltage) and Services	Up to 1,000V			HV (High Voltage)	Over 1,000V to 11,000V			EHV (Extra High Voltage)	22,000V to 132,000V			Transmission	275,000V and 400,000V			Services	LV	HV	EHV	Footpath/Unmade	0.45m	0.45m	0.6m	Road Crossing	0.6m	0.6m	0.75m	Agricultural	1m	1m	1.1m	<p><b>Legend</b></p> <ul style="list-style-type: none"> <li>Service Cable</li> <li>LV Mains</li> <li>66kV</li> <li>11kV</li> <li>22kV</li> <li>33kV</li> <li>66kV</li> <li>132kV</li> <li>275kV</li> <li>400kV</li> <li>Fibre Optic</li> <li>Pipe Cable</li> </ul> <p><b>Distribution Structures (Electric)</b></p> <ul style="list-style-type: none"> <li>Pole, Existing Location</li> <li>Pole Structure, Existing Location - Single</li> <li>Pole Structure, Existing Location - H</li> <li>Duct Route</li> <li>Cross Section Route</li> </ul>	<p><b>Southern Electric Power Distribution plc</b>          Registered Office: No.1 Forbury Place          43 Forbury Road Reading RG1 3JH          Registered In England &amp; Wales No.04094290</p> <p>If you're unsure &amp; need to seek advice before commencing excavations, please contact:          General Enquiries: 0800 048 3516</p> <p>Subject to revision – Master held by SSEN Asset Data Team:  <a href="mailto:Asset.Data@sse.com">Asset.Data@sse.com</a>          01256 337 294</p>
LV (Low Voltage) and Services	Up to 1,000V																																		
HV (High Voltage)	Over 1,000V to 11,000V																																		
EHV (Extra High Voltage)	22,000V to 132,000V																																		
Transmission	275,000V and 400,000V																																		
Services	LV	HV	EHV																																
Footpath/Unmade	0.45m	0.45m	0.6m																																
Road Crossing	0.6m	0.6m	0.75m																																
Agricultural	1m	1m	1.1m																																
<p>Scale: 1:500 (When plotted at A4)</p> <p><small>BASED UPON THE ORDNANCE SURVEY MAP WITH THE SANCTION OF THE CONTROLLER OF HM STATIONERY OFFICE CROWN COPYRIGHT RESERVED.          This copy has been made by or with the authority of Scottish and Southern Energy Power Distribution Ltd. Pursuant to section 47 of the Copyright, Designs and Patents Act 1988 ("The Act"). Unless the Act provides a relevant exception to copyright the copy must not be copied without prior permission of the copyright owner.          Plans generated by DigSAFE Pro™ software provided by Lineworkbefore066.</small></p>																																			

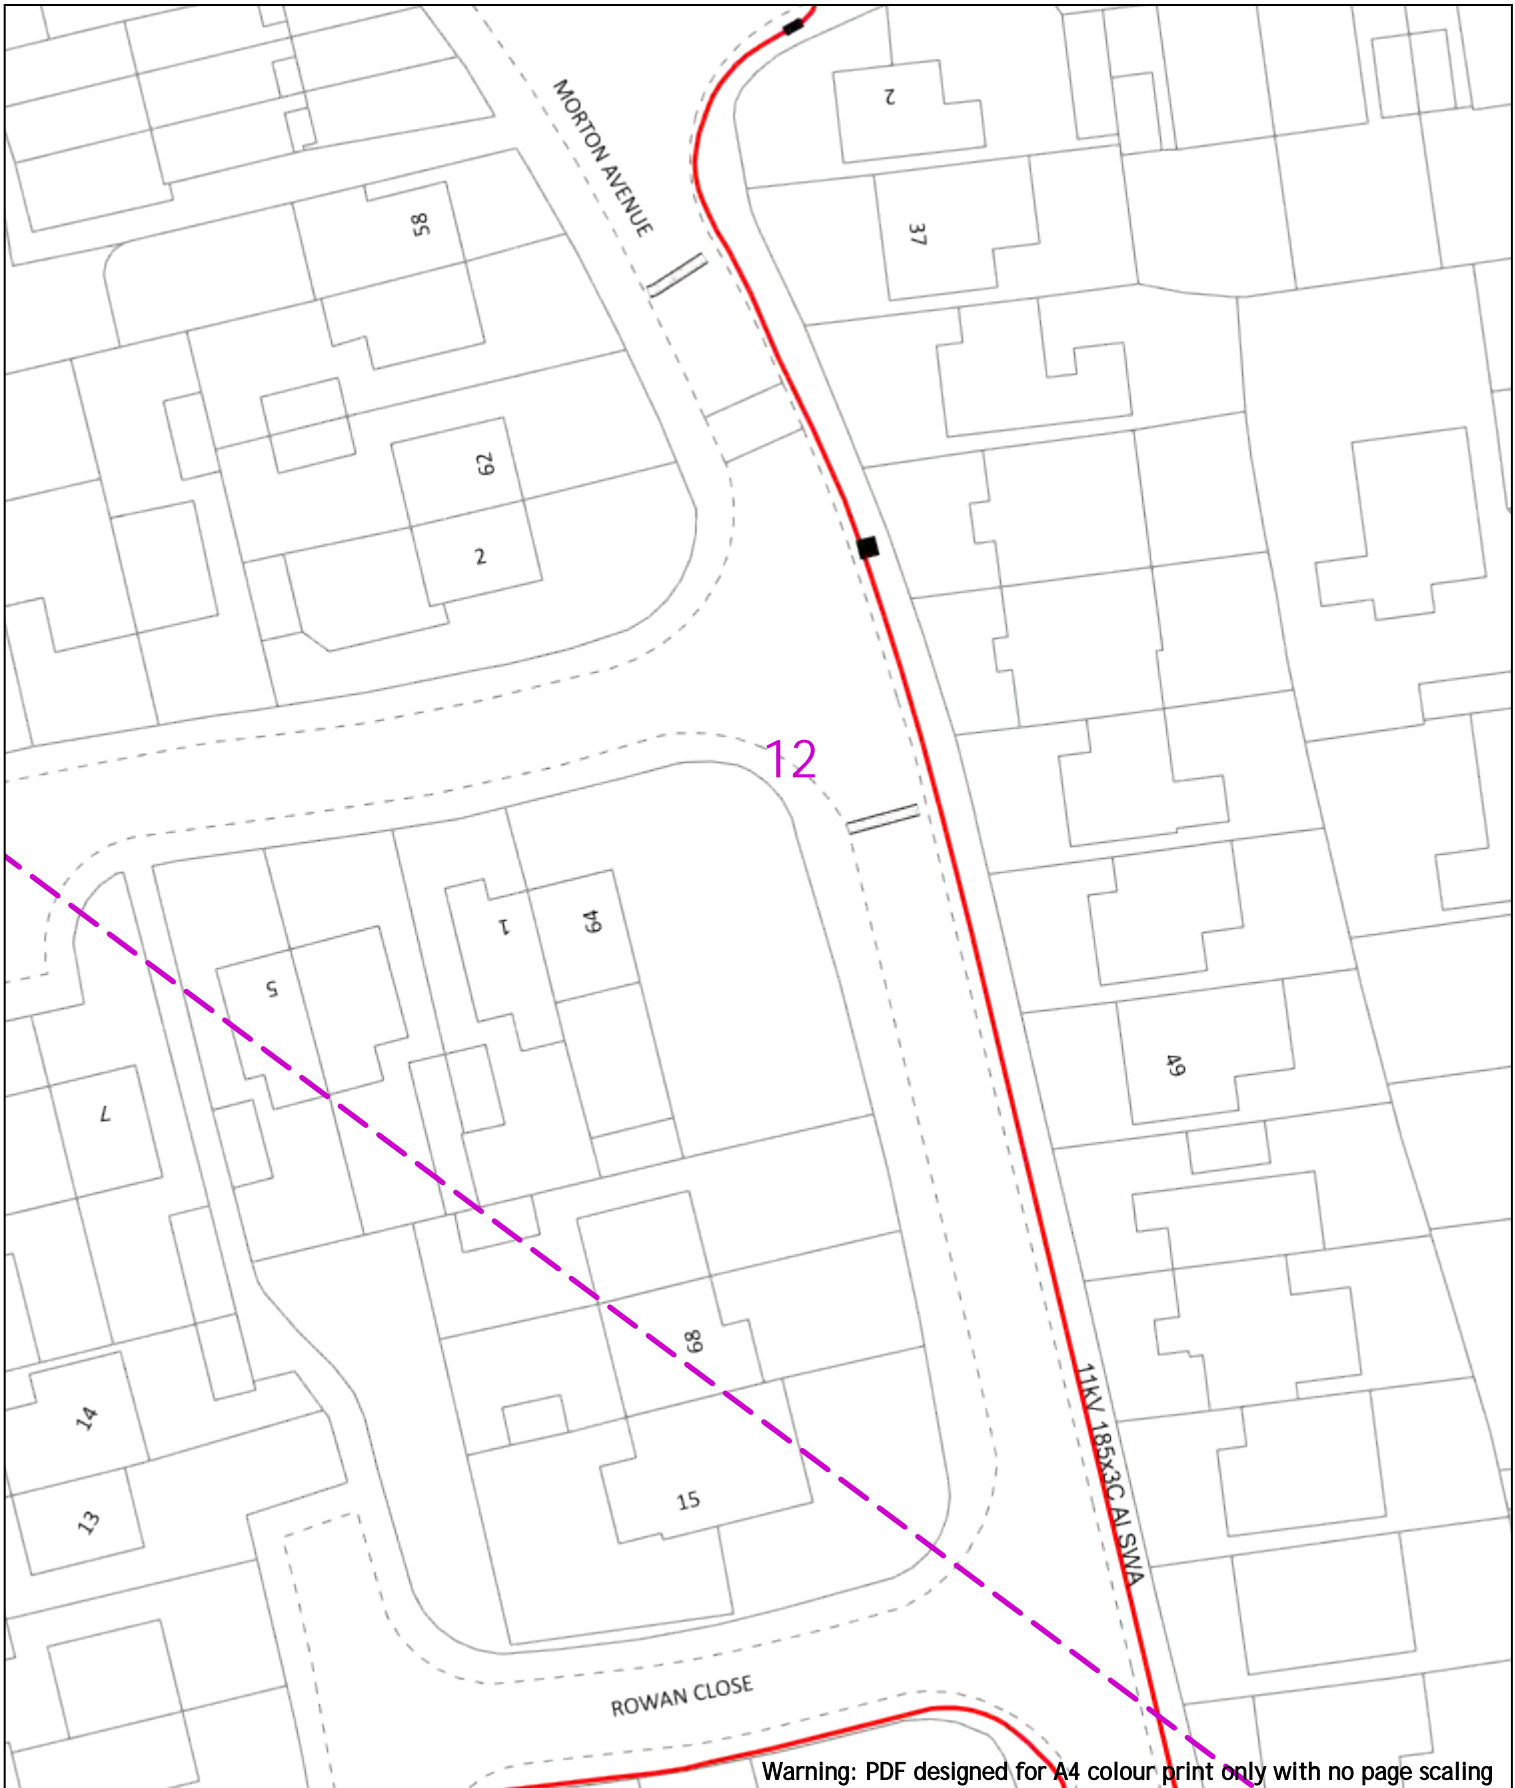

0 20m Dig Sites Area: Line: **Extra High Voltage cables in vicinity**

Date Requested: 24/06/2022  
 Job Reference: 25881037  
 Site Location: 448662 213014  
 Requested by: Mr Joe Shawyer  
 Your Scheme/Reference: 31188\_003

Voltages (V)				
LV (Low Voltage) and Services	Up to 1,000V			
HV (High Voltage)	Over 1,000V to 11,000V			
EHV (Extra High Voltage)	22,000V to 132,000V			
Transmission	275,000V and 400,000V			

NORMAL DEPTH TO THE TOP OF THE CABLE WHEN LAID				
Services	LV	HV	EHV	
Footpath/Unmade	0.45m	0.45m	0.6m	0.8m
Road Crossing	0.6m	0.6m	0.75m	0.9m
Agricultural	1m	1m	1m	1.1m

Legend		Distribution Structures (Electric)	
	Service Cable		Pole, Existing Location
	LV Mains		Pole Structure, Existing Location - Single
	6kV		Pole Structure, Existing Location - H
	11kV		Duct Route
	22kV		Cross Section Route
	33kV		
	66kV		
	132kV		
	275kV		
	400kV		
	Fibre Optic		
	Pipe Cable		

**WARNING**  
 There may have been subsequent alteration to the surface levels. Trial holes must be undertaken to determine position and depths of cables. HS (G) 47 Booklet from the Health and Safety Executive - Avoiding Danger from Buried Cables - should be consulted before commencing excavation work.  
 WHEN WORKING IN THE VICINITY OF OVERHEAD LINES THE HEALTH AND SAFETY GUIDANCE NOTES G56 SHOULD BE CONSULTED (AVAILABLE FROM THE HSE WEBSITE)


Scale: 1:500 (When plotted at A4)

**Southern Electric Power Distribution plc**  
 Registered Office: No.1 Forbury Place  
 43 Forbury Road Reading RG1 3JH  
 Registered In England & Wales No.04094290

If you're unsure & need to seek advice before commencing excavations, please contact:  
 General Enquiries: 0800 048 3516

Subject to revision - Master held by SSEN Asset Data Team:  
[Asset.Data@sse.com](mailto:Asset.Data@sse.com)  
 01256 337 294

BASED UPON THE ORDNANCE SURVEY MAP WITH THE SANCTION OF THE CONTROLLER OF HM STATIONERY OFFICE CROWN COPYRIGHT RESERVED.  
 This copy has been made by or with the authority of Scottish and Southern Energy Power Distribution Ltd. Pursuant to section 47 of the Copyright, Designs and Patents Act 1988 ("The Act"). Unless the Act provides a relevant exception to copyright the copy must not be copied without prior permission of the copyright owner.  
 Plans generated by DigSAFE Pro™ software provided by Lineworksbefore.co.uk.

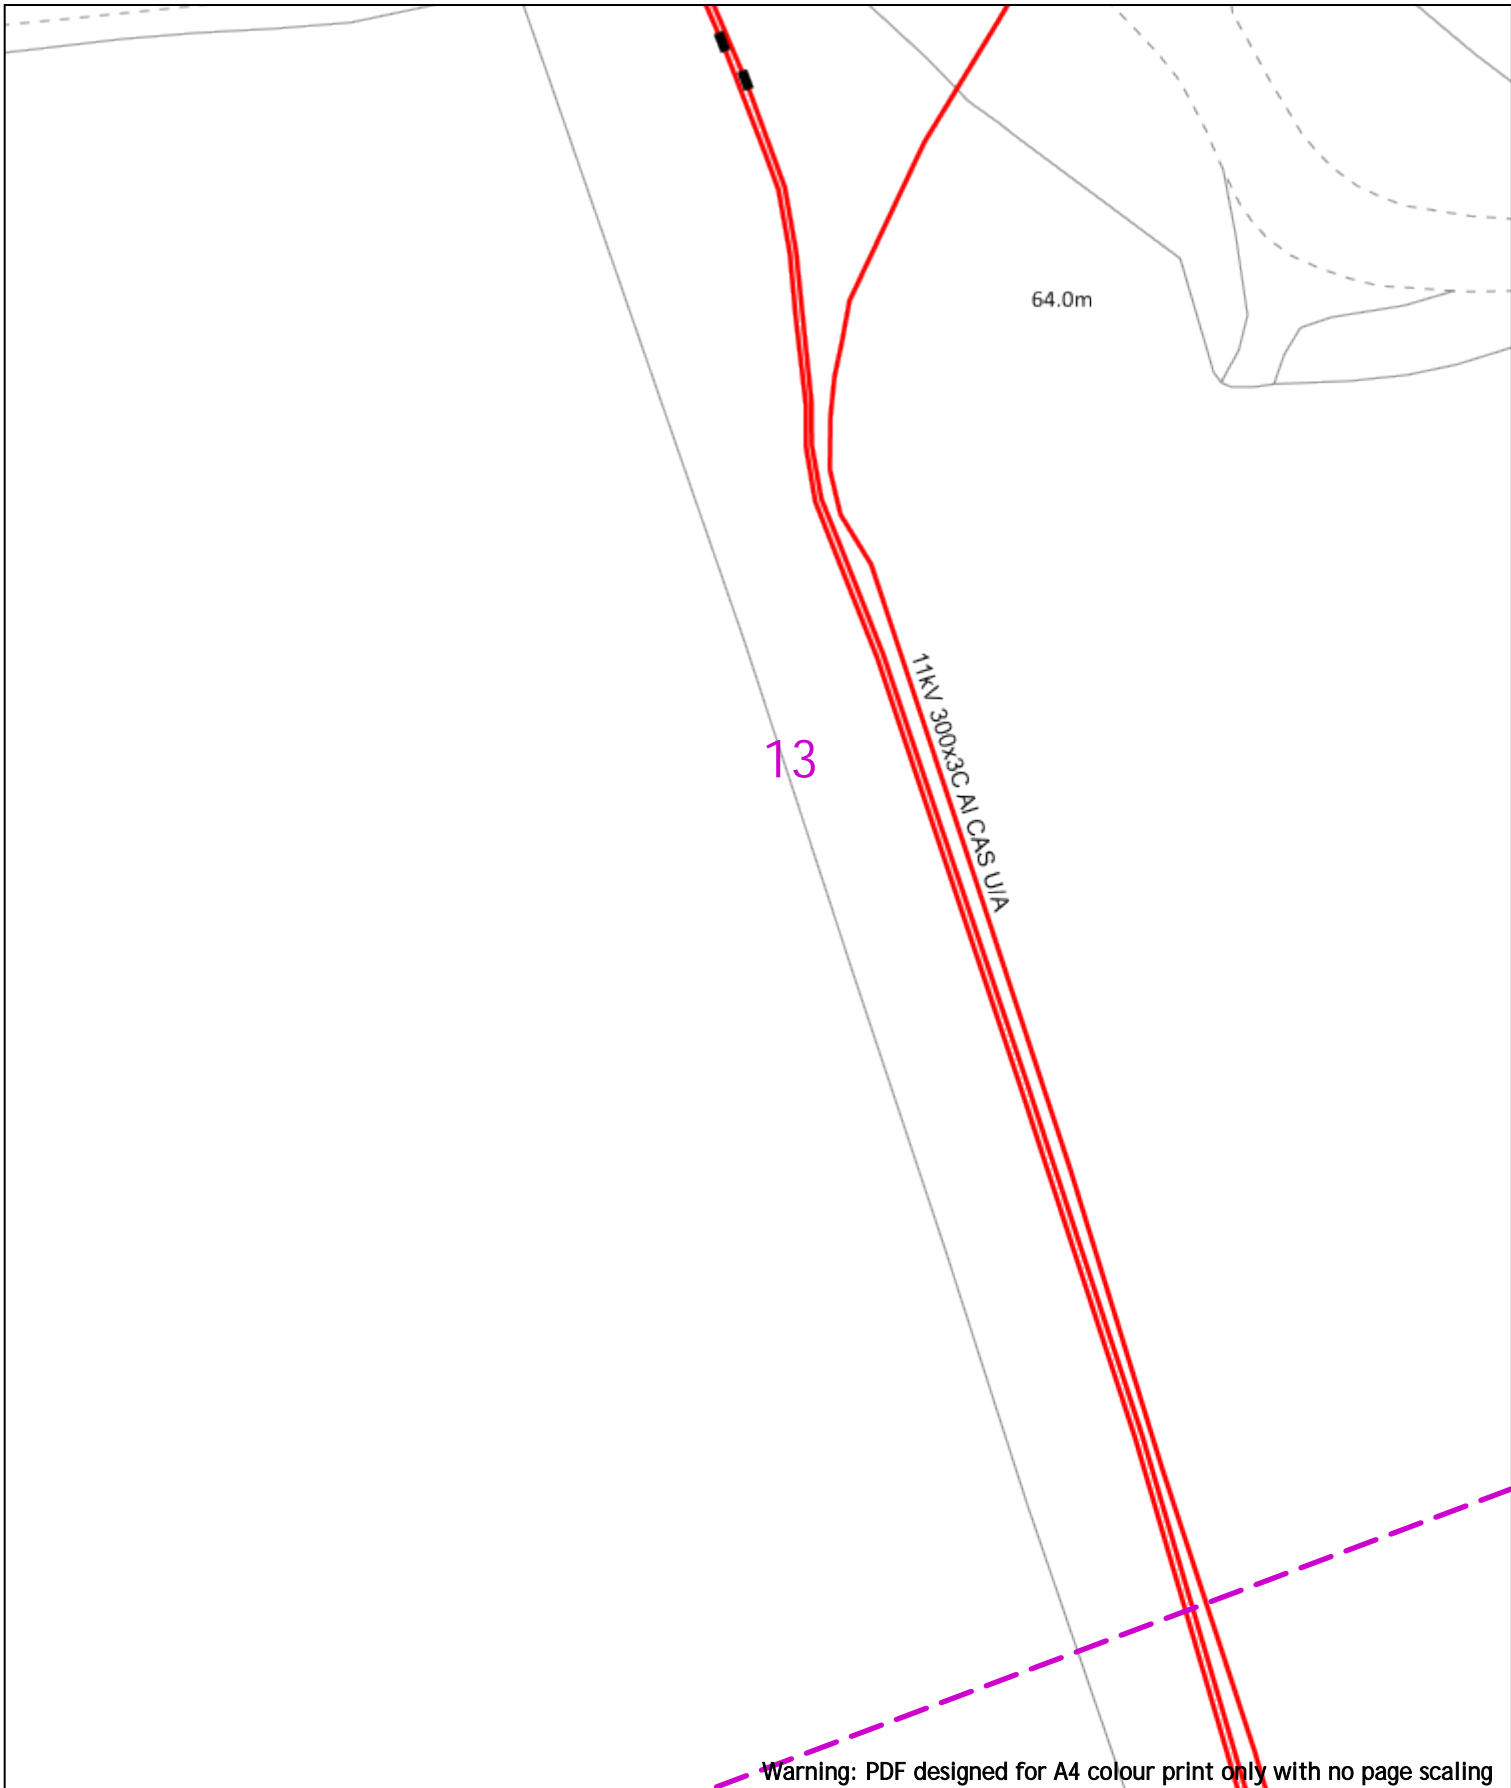

0 20m Dig Sites Area: Line: **Extra High Voltage cables in vicinity**

Date Requested: 24/06/2022  
 Job Reference: 25881037  
 Site Location: 448662 213014  
 Requested by: Mr Joe Shawyer  
 Your Scheme/Reference: 31188\_003

Voltages (V)				
LV (Low Voltage) and Services	Up to 1,000V			
HV (High Voltage)	Over 1,000V to 11,000V			
EHV (Extra High Voltage)	22,000V to 132,000V			
Transmission	275,000V and 400,000V			

Services	NORMAL DEPTH TO THE TOP OF THE CABLE WHEN LAID			
	LV	HV	EHV	
Footpath/Unmade	0.45m	0.45m	0.6m	0.8m
Road Crossing	0.6m	0.6m	0.75m	0.9m
Agricultural	1m	1m	1m	1.1m

Legend		Distribution Structures (Electric)	
	Service Cable		Pole, Existing Location
	LV Mains		Pole Structure, Existing Location - Single
	2 - 11kV		Pole Structure, Existing Location - H
	66kV		Duct Route
	11kV		Cross Section Route
	22kV		
	33kV		
	66kV		
	132kV		
	275kV		
	400kV		
	Fibre Optic		
	Pipe Cable		

**WARNING**  
 There may have been subsequent alteration to the surface levels. Trial holes must be undertaken to determine position and depths of cables. HS (G) 47 Booklet from the Health and Safety Executive - Avoiding Danger from Buried Cables - should be consulted before commencing excavation work.  
 WHEN WORKING IN THE VICINITY OF OVERHEAD LINES THE HEALTH AND SAFETY GUIDANCE NOTES G56 SHOULD BE CONSULTED (AVAILABLE FROM THE HSE WEBSITE)

Scale: 1:500 (When plotted at A4)

**Southern Electric Power Distribution plc**  
 Registered Office: No.1 Forbury Place  
 43 Forbury Road Reading RG1 3JH  
 Registered In England & Wales No.04094290

If you're unsure & need to seek advice before commencing excavations, please contact:  
 General Enquiries: 0800 048 3516

Subject to revision - Master held by SSEN Asset Data Team:  
[Asset.Data@sse.com](mailto:Asset.Data@sse.com)  
 01256 337 294

33kV - 175 AAAC

Warning: PDF designed for A4 colour print only with no page scaling

0 20m Dig Sites Area: Line:

**Extra High Voltage cables in vicinity**



Date Requested: 24/06/2022  
 Job Reference: 25881037  
 Site Location: 448662 213014  
 Requested by: Mr Joe Shawyer  
 Your Scheme/Reference: 31188\_003

Voltages (V)			
LV (Low Voltage) and Services	Up to 1,000V		
HV (High Voltage)	Over 1,000V to 11,000V		
EHV (Extra High Voltage)	22,000V to 132,000V		
Transmission	275,000V and 400,000V		
NORMAL DEPTH TO THE TOP OF THE CABLE WHEN LAID			
Services	LV	HV	EHV
Footpath/Unmade	0.45m	0.45m	0.6m 0.8m
Road Crossing	0.6m	0.6m	0.75m 0.9m
Agricultural	1m	1m	1m 1.1m

Legend	
	Service Cable
	LV Mains
	2 - 11kV
	66kV
	11kV
	22kV
	33kV
	66kV
	132kV
	275kV
	400kV
	Fibre Optic
	Pipe Cable

Distribution Structures (Electric)	
	Pole, Existing Location
	Pole Structure, Existing Location - Single
	Pole Structure, Existing Location - H
	Duct Route
	Cross Section Route


**Southern Electric Power Distribution plc**  
 Registered Office: No.1 Forbury Place  
 43 Forbury Road Reading RG1 3JH  
 Registered In England & Wales No.04094290

If you're unsure & need to seek advice before commencing excavations, please contact:  
 General Enquiries: 0800 048 3516

Subject to revision – Master held by SSEN Asset Data Team:  
[Asset.Data@sse.com](mailto:Asset.Data@sse.com)  
 01256 337 294

Scale: 1:500 (When plotted at A4)

**WARNING**  
 There may have been subsequent alteration to the surface levels. Trial holes must be undertaken to determine position and depths of cables. HS (G) 47 Booklet from the Health and Safety Executive – Avoiding Danger from Buried Cables – should be consulted before commencing excavation work.  
**WHEN WORKING IN THE VICINITY OF OVERHEAD LINES THE HEALTH AND SAFETY GUIDANCE NOTES G66 SHOULD BE CONSULTED (AVAILABLE FROM THE HSE WEBSITE)**

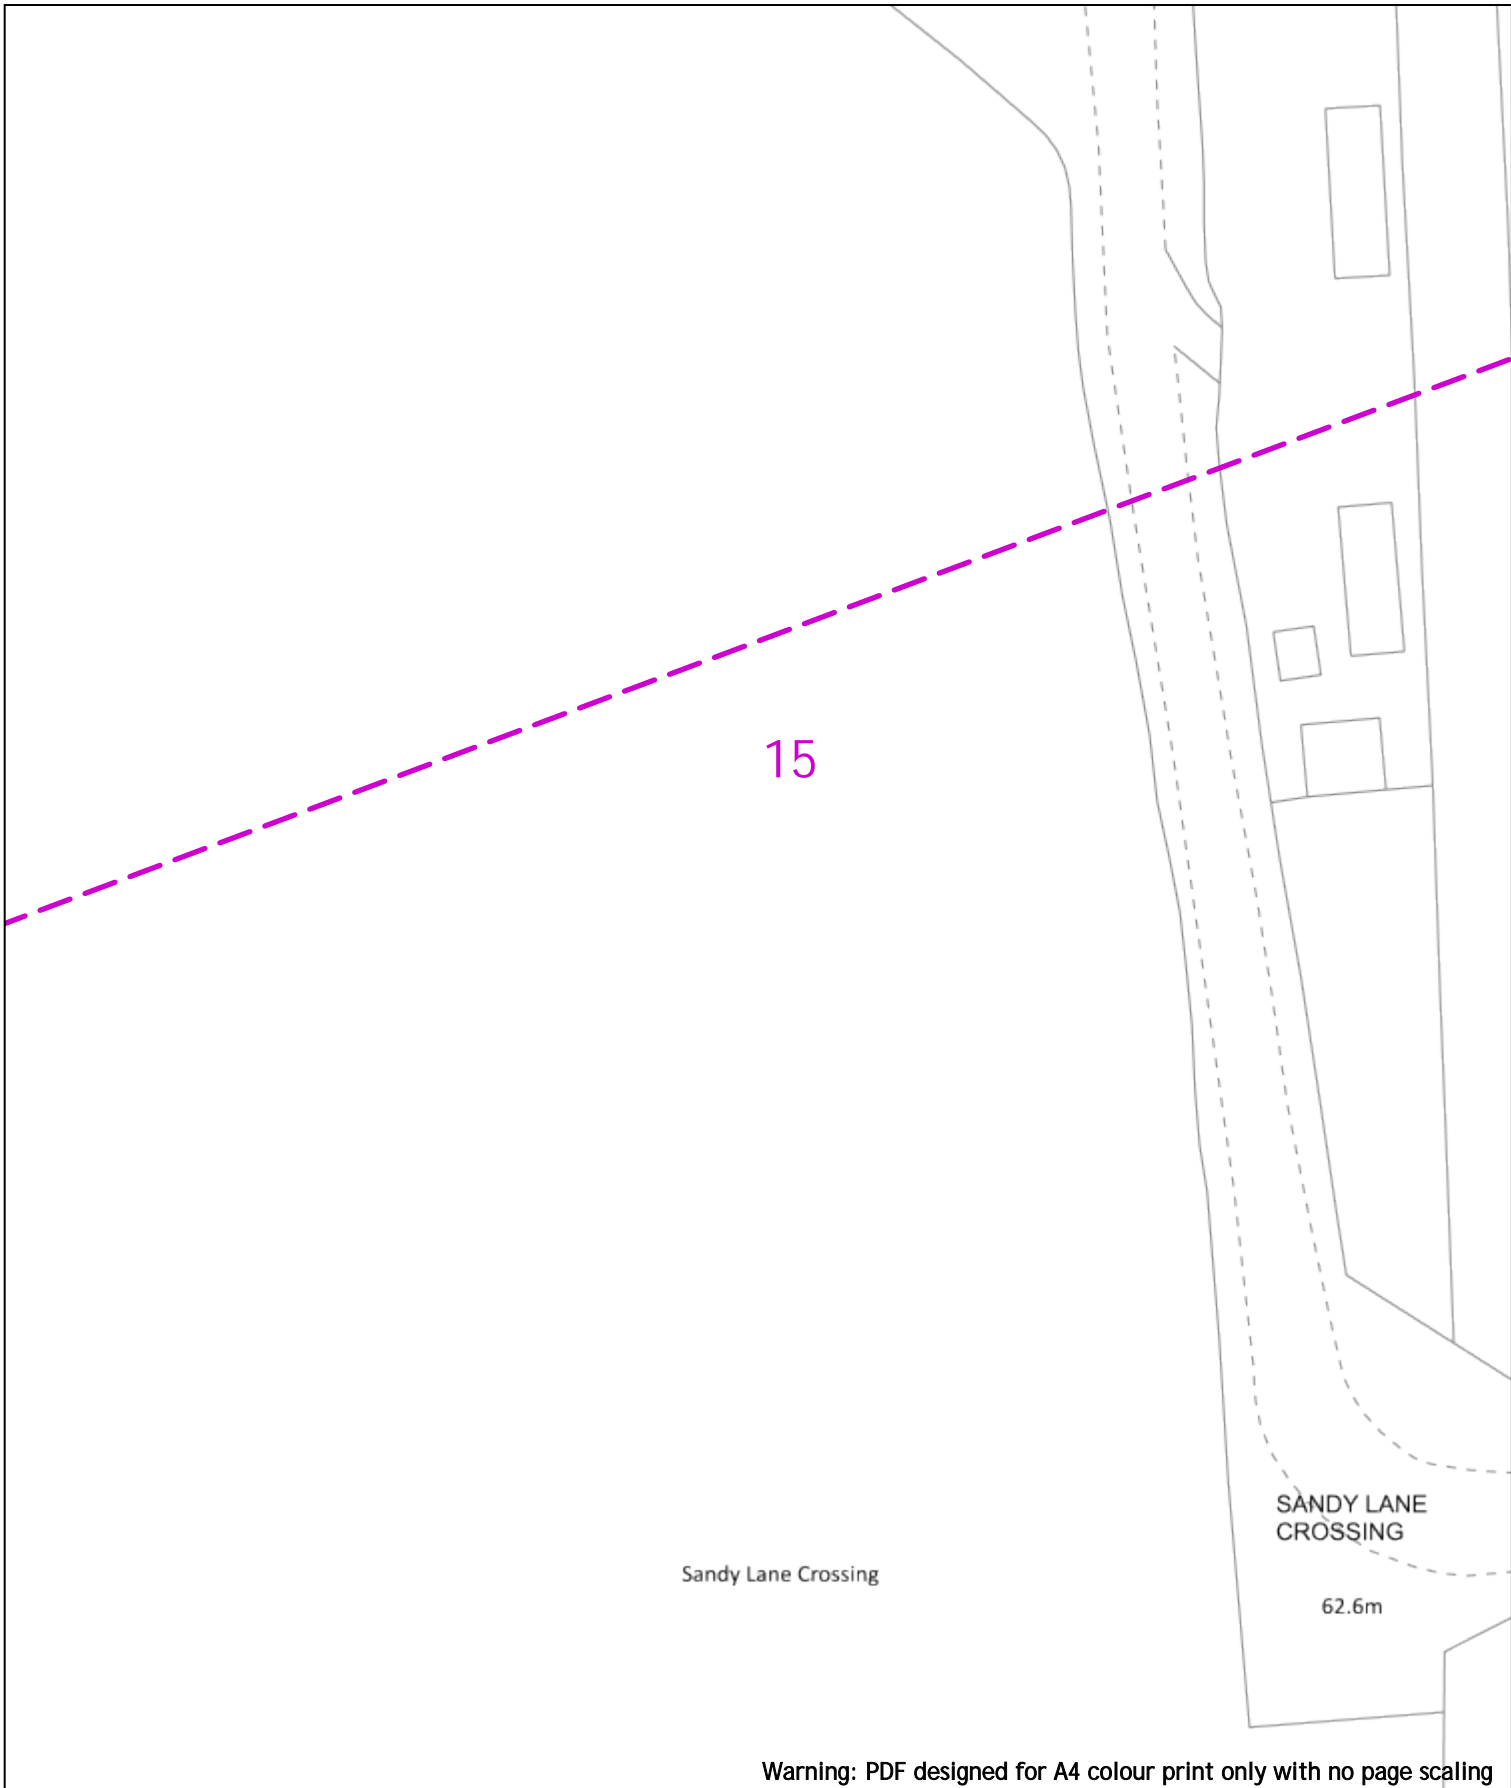

Warning: PDF designed for A4 colour print only with no page scaling

20m Dig Sites Area:   Line:

**Extra High Voltage  
cables in vicinity**

Date Requested: 24/06/2022  
Job Reference: 25881037  
Site Location: 448662 213014  
Requested by: Mr Joe Shawyer  
Your Scheme/Reference: 31188\_003

Voltages (V)				
LV (Low Voltage) and Services	Up to 1,000V			
HV (High Voltage)	Over 1,000V to 11,000V			
EHV (Extra High Voltage)	22,000V to 132,000V			
Transmission	275,000V and 400,000V			
NORMAL DEPTH TO THE TOP OF THE CABLE WHEN LAID				
Services	LV	HV	EHV	
Footpath/Unmade	0.45m	0.45m	0.6m	0.8m
Road Crossing	0.6m	0.6m	0.75m	0.9m
Agricultural	1m	1m	1m	1.1m

Legend		Distribution Structures (Electric)	
<span style="border-bottom: 1px solid yellow; width: 20px; display: inline-block;"></span>	Service Cable	<span style="border: 1px solid purple; border-radius: 50%; width: 10px; height: 10px; display: inline-block;"></span>	Pole, Existing Location
<span style="border-bottom: 1px solid blue; width: 20px; display: inline-block;"></span>	LV Mains	<span style="border: 1px solid purple; border-radius: 50%; width: 10px; height: 10px; display: inline-block;"></span>	Pole Structure, Existing Location - Single
<span style="border-bottom: 1px solid red; width: 20px; display: inline-block;"></span>	2 - 11kV	<span style="border: 1px solid purple; border-radius: 50%; width: 10px; height: 10px; display: inline-block;"></span>	Pole Structure, Existing Location - H
<span style="border-bottom: 1px solid green; width: 20px; display: inline-block;"></span>	66kV	<span style="border-bottom: 1px solid black; width: 20px; display: inline-block;"></span>	Duct Route
<span style="border-bottom: 1px solid orange; width: 20px; display: inline-block;"></span>	11kV	<span style="border-bottom: 1px solid black; width: 20px; display: inline-block;"></span>	Cross Section Route
<span style="border-bottom: 1px solid purple; width: 20px; display: inline-block;"></span>	22kV		
<span style="border-bottom: 1px solid brown; width: 20px; display: inline-block;"></span>	33kV		
<span style="border-bottom: 1px solid pink; width: 20px; display: inline-block;"></span>	66kV		
<span style="border-bottom: 1px solid lightblue; width: 20px; display: inline-block;"></span>	132kV		
<span style="border-bottom: 1px solid lightgreen; width: 20px; display: inline-block;"></span>	275kV		
<span style="border-bottom: 1px solid lightyellow; width: 20px; display: inline-block;"></span>	400kV		
<span style="border-bottom: 1px solid cyan; width: 20px; display: inline-block;"></span>	Fibre Optic		
<span style="border-bottom: 1px solid magenta; width: 20px; display: inline-block;"></span>	Pipe Cable		

**WARNING**


There may have been subsequent alteration to the surface levels. Trial holes must be undertaken to determine position and depths of cables. HS (G) 47 Booklet from the Health and Safety Executive - Avoiding Danger from Buried Cables - should be consulted before commencing excavation work.

WHEN WORKING IN THE VICINITY OF OVERHEAD LINES THE HEALTH AND SAFETY GUIDANCE NOTES G56 SHOULD BE CONSULTED (AVAILABLE FROM THE HSE WEBSITE)

**Southern Electric Power Distribution plc**  
Registered Office: No.1 Forbury Place  
43 Forbury Road Reading RG1 3JH  
Registered In England & Wales No.04094290

If you're unsure & need to seek advice before commencing excavations, please contact:  
General Enquiries: 0800 048 3516

Subject to revision - Master held by SSEN Asset Data Team:  
[Asset.Data@sse.com](mailto:Asset.Data@sse.com)  
01256 337 294

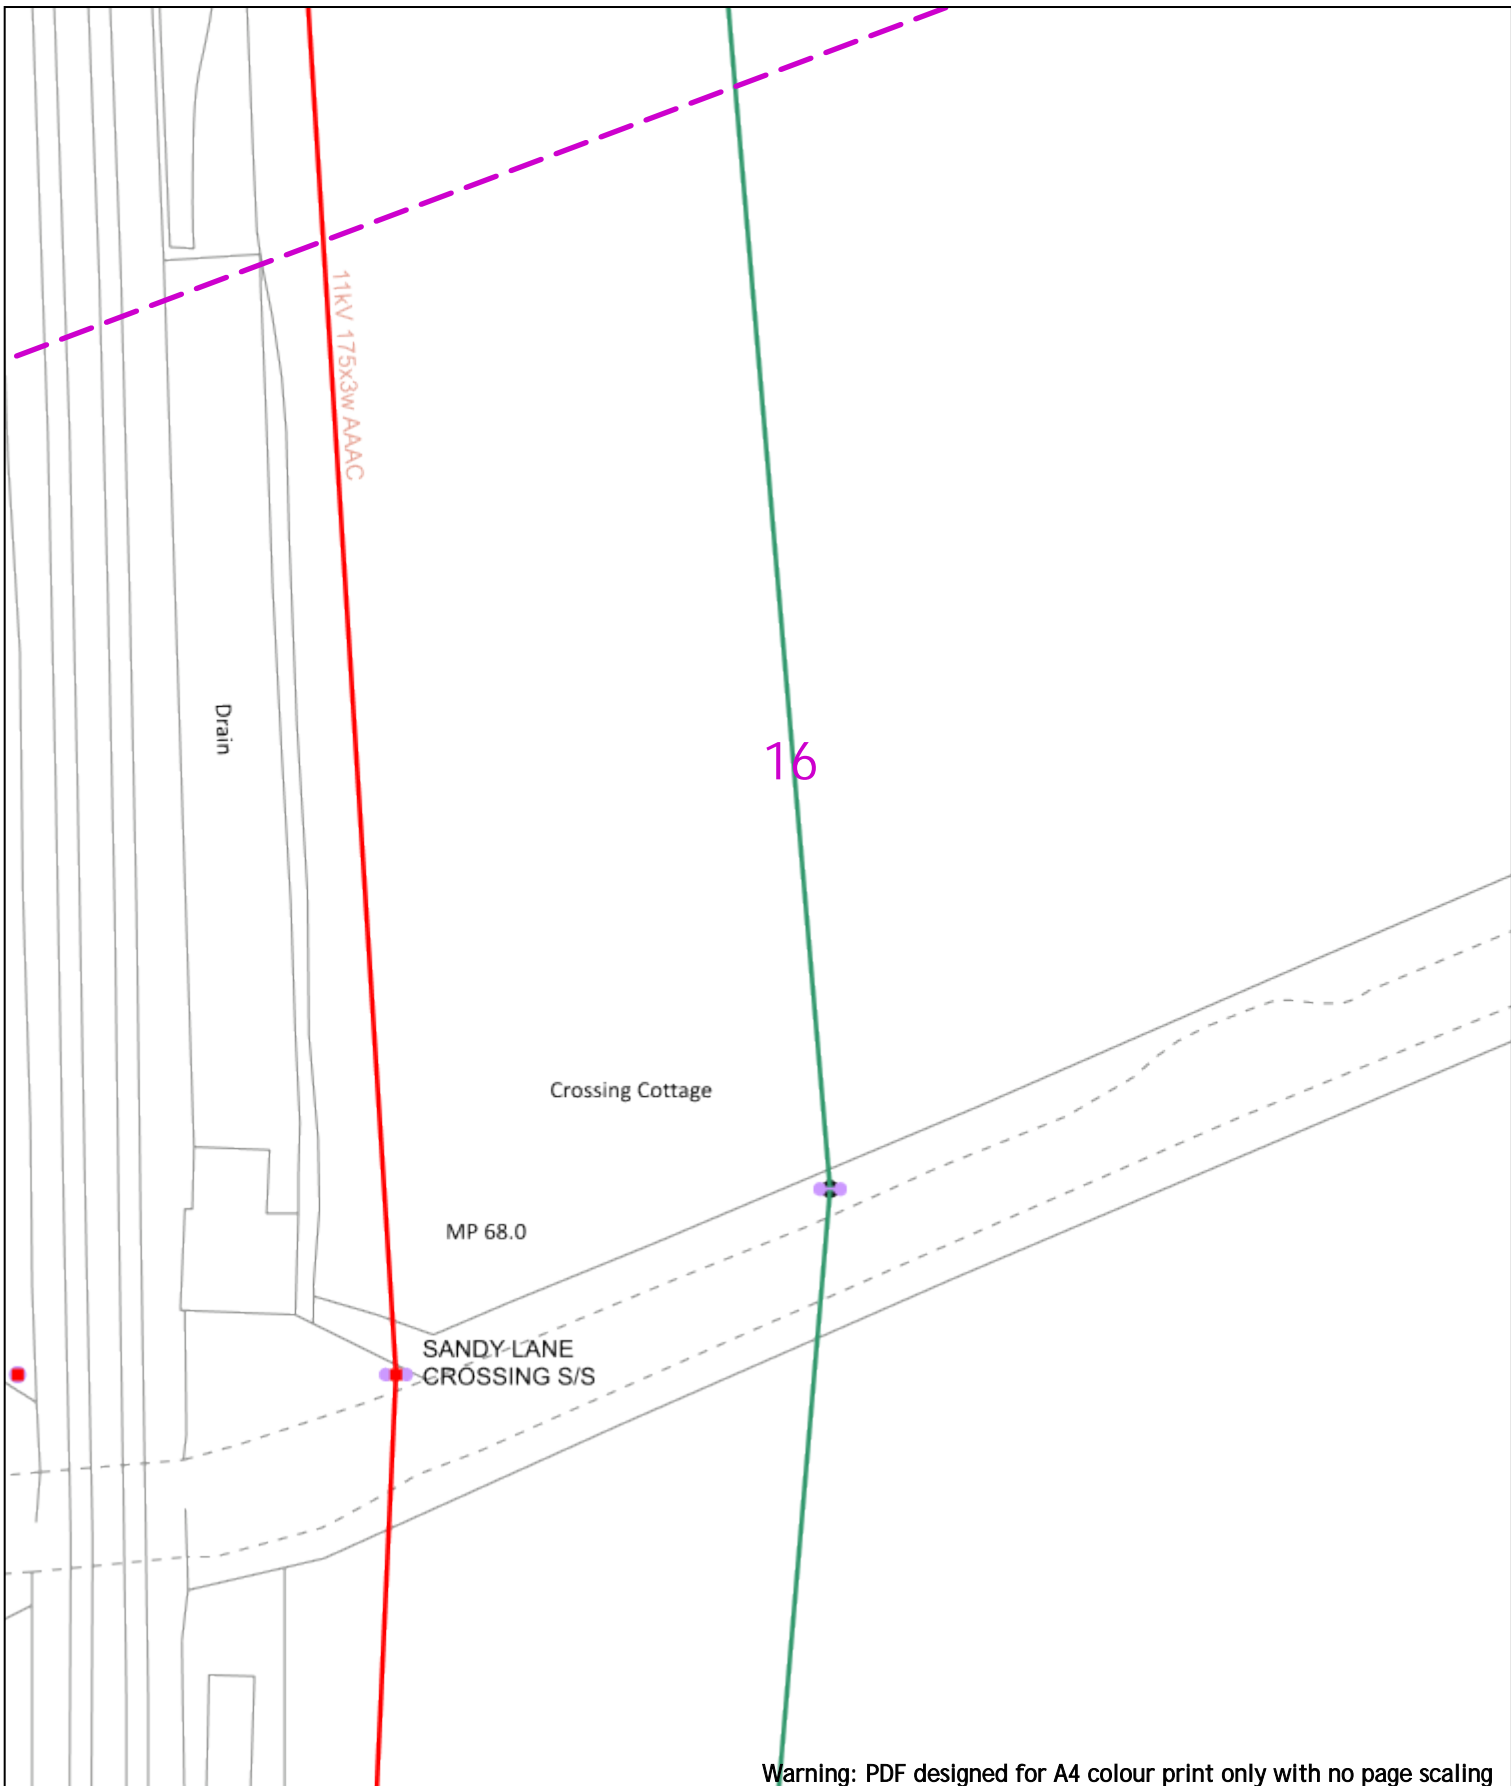

Warning: PDF designed for A4 colour print only with no page scaling



20m Dig Sites Area: [Dashed Purple Box] Line: [Dashed Purple Line]

**Extra High Voltage cables in vicinity**



Date Requested: 24/06/2022  
 Job Reference: 25881037  
 Site Location: 448662 213014  
 Requested by: Mr Joe Shawyer  
 Your Scheme/Reference: 31188\_003

Voltages (V)			
LV (Low Voltage) and Services	Up to 1,000V		
HV (High Voltage)	Over 1,000V to 11,000V		
EHV (Extra High Voltage)	22,000V to 132,000V		
Transmission	275,000V and 400,000V		
NORMAL DEPTH TO THE TOP OF THE CABLE WHEN LAID			
Services	LV	HV	EHV
Footpath/Unmade	0.45m	0.45m	0.6m 0.8m
Road Crossing	0.6m	0.6m	0.75m 0.9m
Agricultural	1m	1m	1m 1.1m

Legend	
[Yellow Line]	Service Cable
[Blue Line]	LV Mains
[Red Line]	2 - 11kV
[Green Line]	66kV
[Orange Line]	11kV
[Purple Line]	22kV
[Light Blue Line]	33kV
[Dark Blue Line]	66kV
[Light Green Line]	132kV
[Dark Green Line]	275kV
[Light Purple Line]	400kV
[Light Blue Dashed Line]	Fibre Optic
[Light Green Dashed Line]	Pipe Cable

Distribution Structures (Electric)	
[Purple Circle]	Pole, Existing Location
[Purple Circle]	Pole Structure, Existing Location - Single
[Purple Circle]	Pole Structure, Existing Location - H
[Purple Circle]	Duct Route
[Purple Circle]	Cross Section Route


**Southern Electric Power Distribution plc**  
 Registered Office: No.1 Forbury Place  
 43 Forbury Road Reading RG1 3JH  
 Registered In England & Wales No.04094290

If you're unsure & need to seek advice before commencing excavations, please contact:  
 General Enquiries: 0800 048 3516

Scale: 1:500 (When plotted at A4)

**WARNING**  
 There may have been subsequent alteration to the surface levels. Trial holes must be undertaken to determine position and depths of cables. HS (G) 47 Booklet from the Health and Safety Executive - Avoiding Danger from Buried Cables - should be consulted before commencing excavation work.  
 WHEN WORKING IN THE VICINITY OF OVERHEAD LINES THE HEALTH AND SAFETY GUIDANCE NOTES G56 SHOULD BE CONSULTED (AVAILABLE FROM THE HSE WEBSITE)

Subject to revision - Master held by SSEN Asset Data Team:  
[Asset.Data@sse.com](mailto:Asset.Data@sse.com)  
 01256 337 294

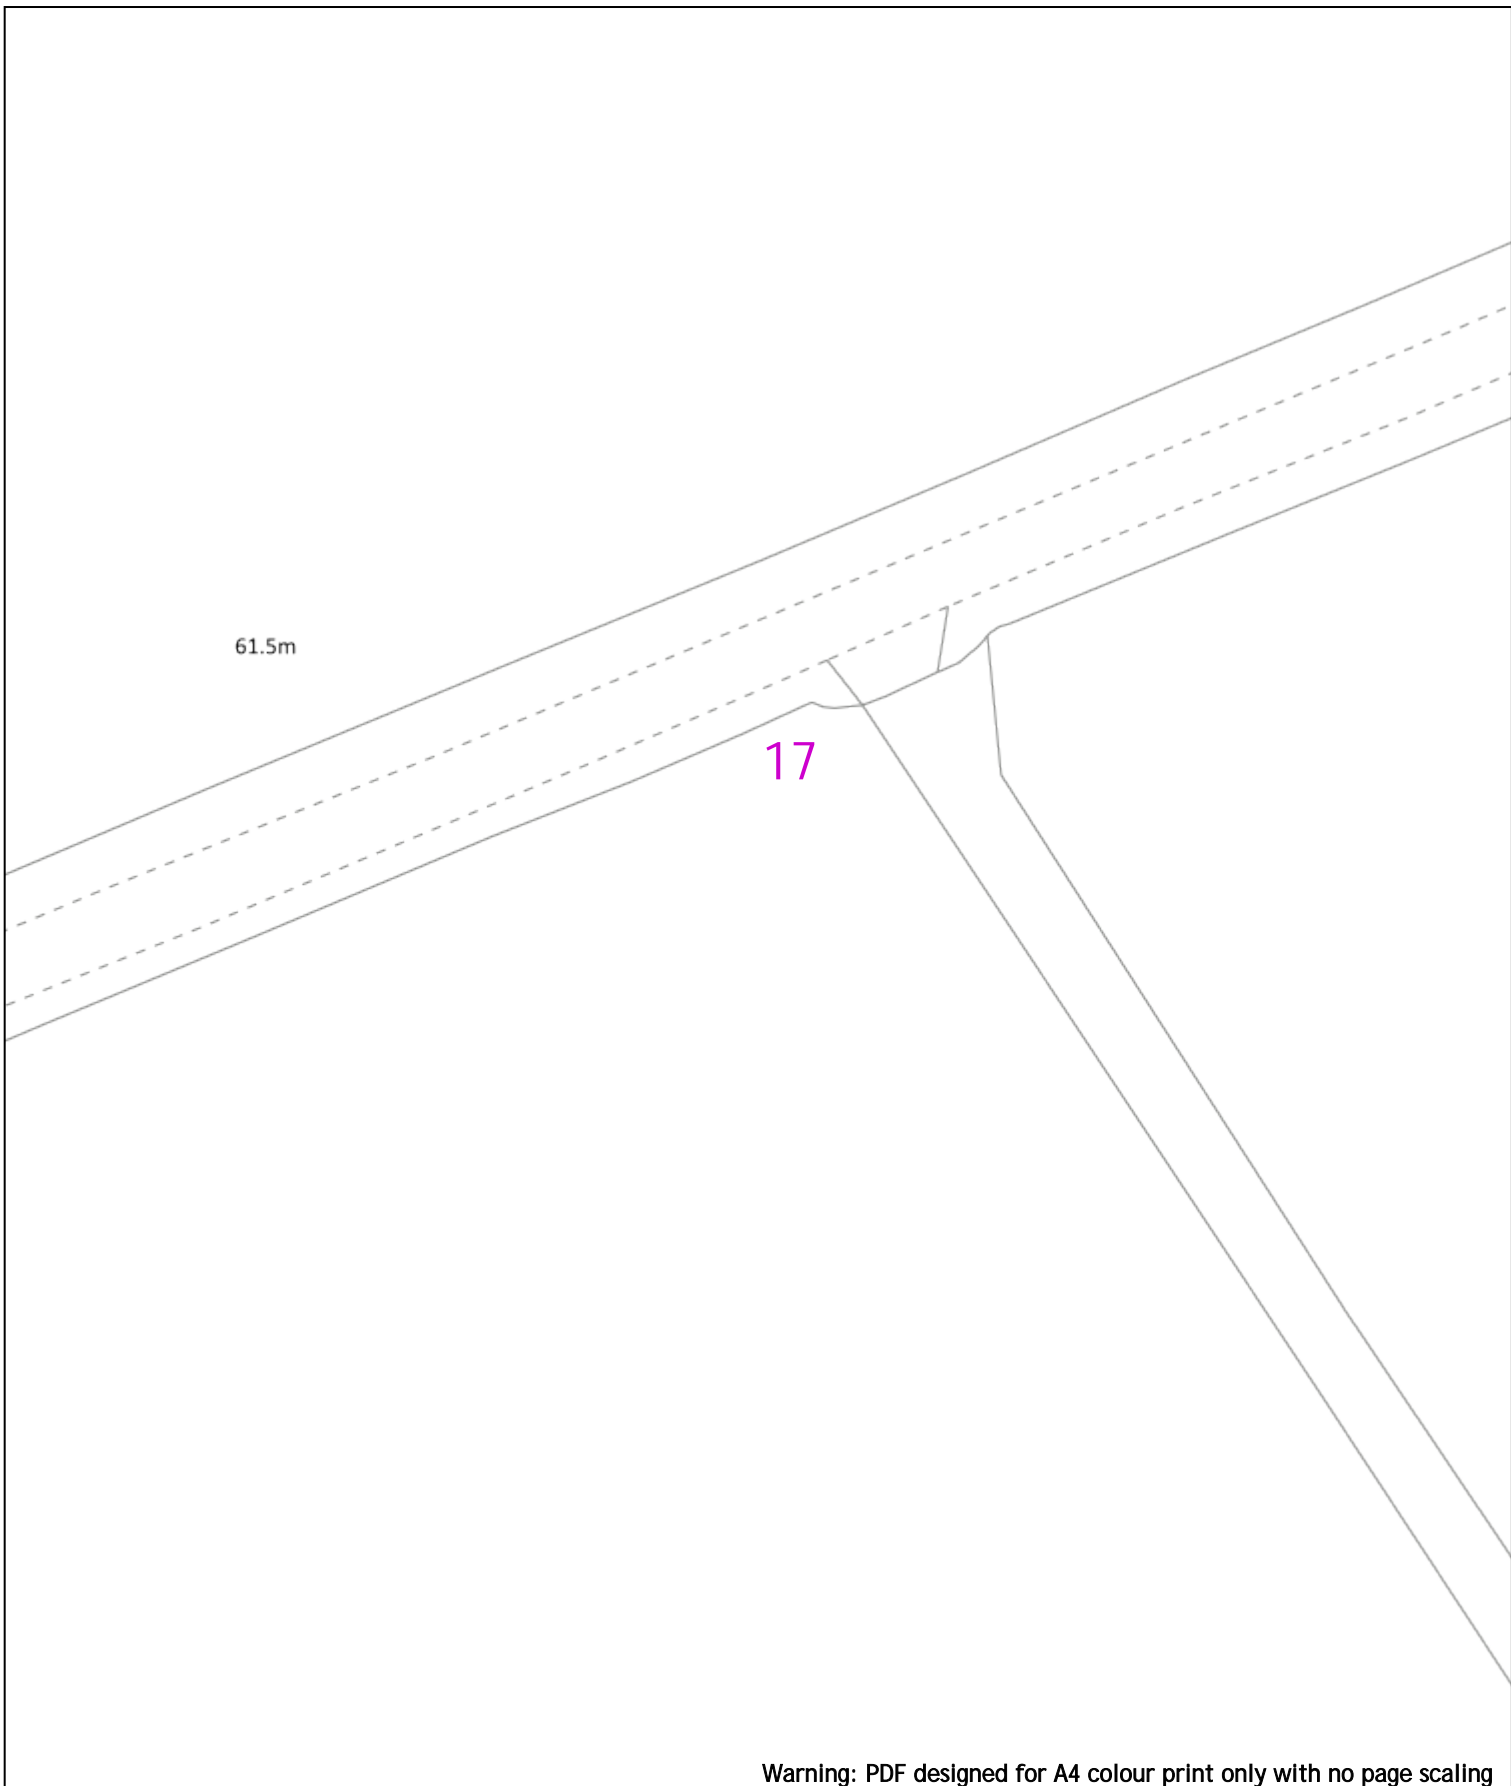

Warning: PDF designed for A4 colour print only with no page scaling



20m Dig Sites Area: Line:

**Extra High Voltage cables in vicinity**



Date Requested: 24/06/2022  
 Job Reference: 25881037  
 Site Location: 448662 213014  
 Requested by: Mr Joe Shawyer  
 Your Scheme/Reference: 31188\_003

Voltages (V)			
LV (Low Voltage) and Services	Up to 1,000V		
HV (High Voltage)	Over 1,000V to 11,000V		
EHV (Extra High Voltage)	22,000V to 132,000V		
Transmission	275,000V and 400,000V		
NORMAL DEPTH TO THE TOP OF THE CABLE WHEN LAID			
Services	LV	HV	EHV
Footpath/Unmade	0.45m	0.45m	0.8m
Road Crossing	0.6m	0.6m	0.9m
Agricultural	1m	1m	1.1m

Legend	
	Service Cable
	LV Mains
	2 - 11kV
	66kV
	275kV
	400kV
	Fibre Optic
	Pipe Cable

Distribution Structures (Electric)	
	Pole, Existing Location
	Pole Structure, Existing Location - Single
	Pole Structure, Existing Location - H
	Duct Route
	Cross Section Route

**Southern Electric Power Distribution plc**  
 Registered Office: No.1 Forbury Place  
 43 Forbury Road Reading RG1 3JH  
 Registered In England & Wales No.04094290

If you're unsure & need to seek advice before commencing excavations, please contact:  
 General Enquiries: 0800 048 3516

Scale: 1:500 (When plotted at A4)

**WARNING**  
 There may have been subsequent alteration to the surface levels. Trial holes must be undertaken to determine position and depths of cables. HS (G) 47 Booklet from the Health and Safety Executive - Avoiding Danger from Buried Cables - should be consulted before commencing excavation work.  
**WHEN WORKING IN THE VICINITY OF OVERHEAD LINES THE HEALTH AND SAFETY GUIDANCE NOTES G56 SHOULD BE CONSULTED (AVAILABLE FROM THE HSE WEBSITE)**

Subject to revision - Master held by SSEN Asset Data Team:  
[Asset.Data@sse.com](mailto:Asset.Data@sse.com)  
 01256 337 294



Warning: PDF designed for A4 colour print only with no page scaling

0 20m Dig Sites Area: Line:

**Extra High Voltage  
cables in vicinity**



Date Requested: 24/06/2022  
 Job Reference: 25881037  
 Site Location: 448662 213014  
 Requested by: Mr Joe Shawyer  
 Your Scheme/Reference: 31188\_003

Voltages (V)			
LV (Low Voltage) and Services	Up to 1,000V		
HV (High Voltage)	Over 1,000V to 11,000V		
EHV (Extra High Voltage)	22,000V to 132,000V		
Transmission	275,000V and 400,000V		
NORMAL DEPTH TO THE TOP OF THE CABLE WHEN LAID			
Services	LV	HV	EHV
Footpath/Unmade	0.45m	0.45m	0.6m
Road Crossing	0.6m	0.6m	0.75m
Agricultural	1m	1m	1.1m

Legend	
	Service Cable
	LV Mains
	2 - 11kV
	66kV
	275kV
	400kV
	Fibre Optic
	Pipe Cable

Distribution Structures (Electric)	
	Pole, Existing Location
	Pole Structure, Existing Location - Single
	Pole Structure, Existing Location - H
	Duct Route
	Cross Section Route


**WARNING**  
 There may have been subsequent alteration to the surface levels. Trial holes must be undertaken to determine position and depths of cables. HS (G) 47 Booklet from the Health and Safety Executive - Avoiding Danger from Buried Cables - should be consulted before commencing excavation work.  
**WHEN WORKING IN THE VICINITY OF OVERHEAD LINES THE HEALTH AND SAFETY GUIDANCE NOTES G56 SHOULD BE CONSULTED (AVAILABLE FROM THE HSE WEBSITE)**

**Southern Electric Power Distribution plc**  
 Registered Office: No.1 Forbury Place  
 43 Forbury Road Reading RG1 3JH  
 Registered In England & Wales No.04094290

If you're unsure & need to seek advice before commencing excavations, please contact:  
 General Enquiries: 0800 048 3516

Subject to revision - Master held by SSEN Asset Data Team:  
[Asset.Data@sse.com](mailto:Asset.Data@sse.com)  
 01256 337 294

Scale: 1:500 (When plotted at A4)

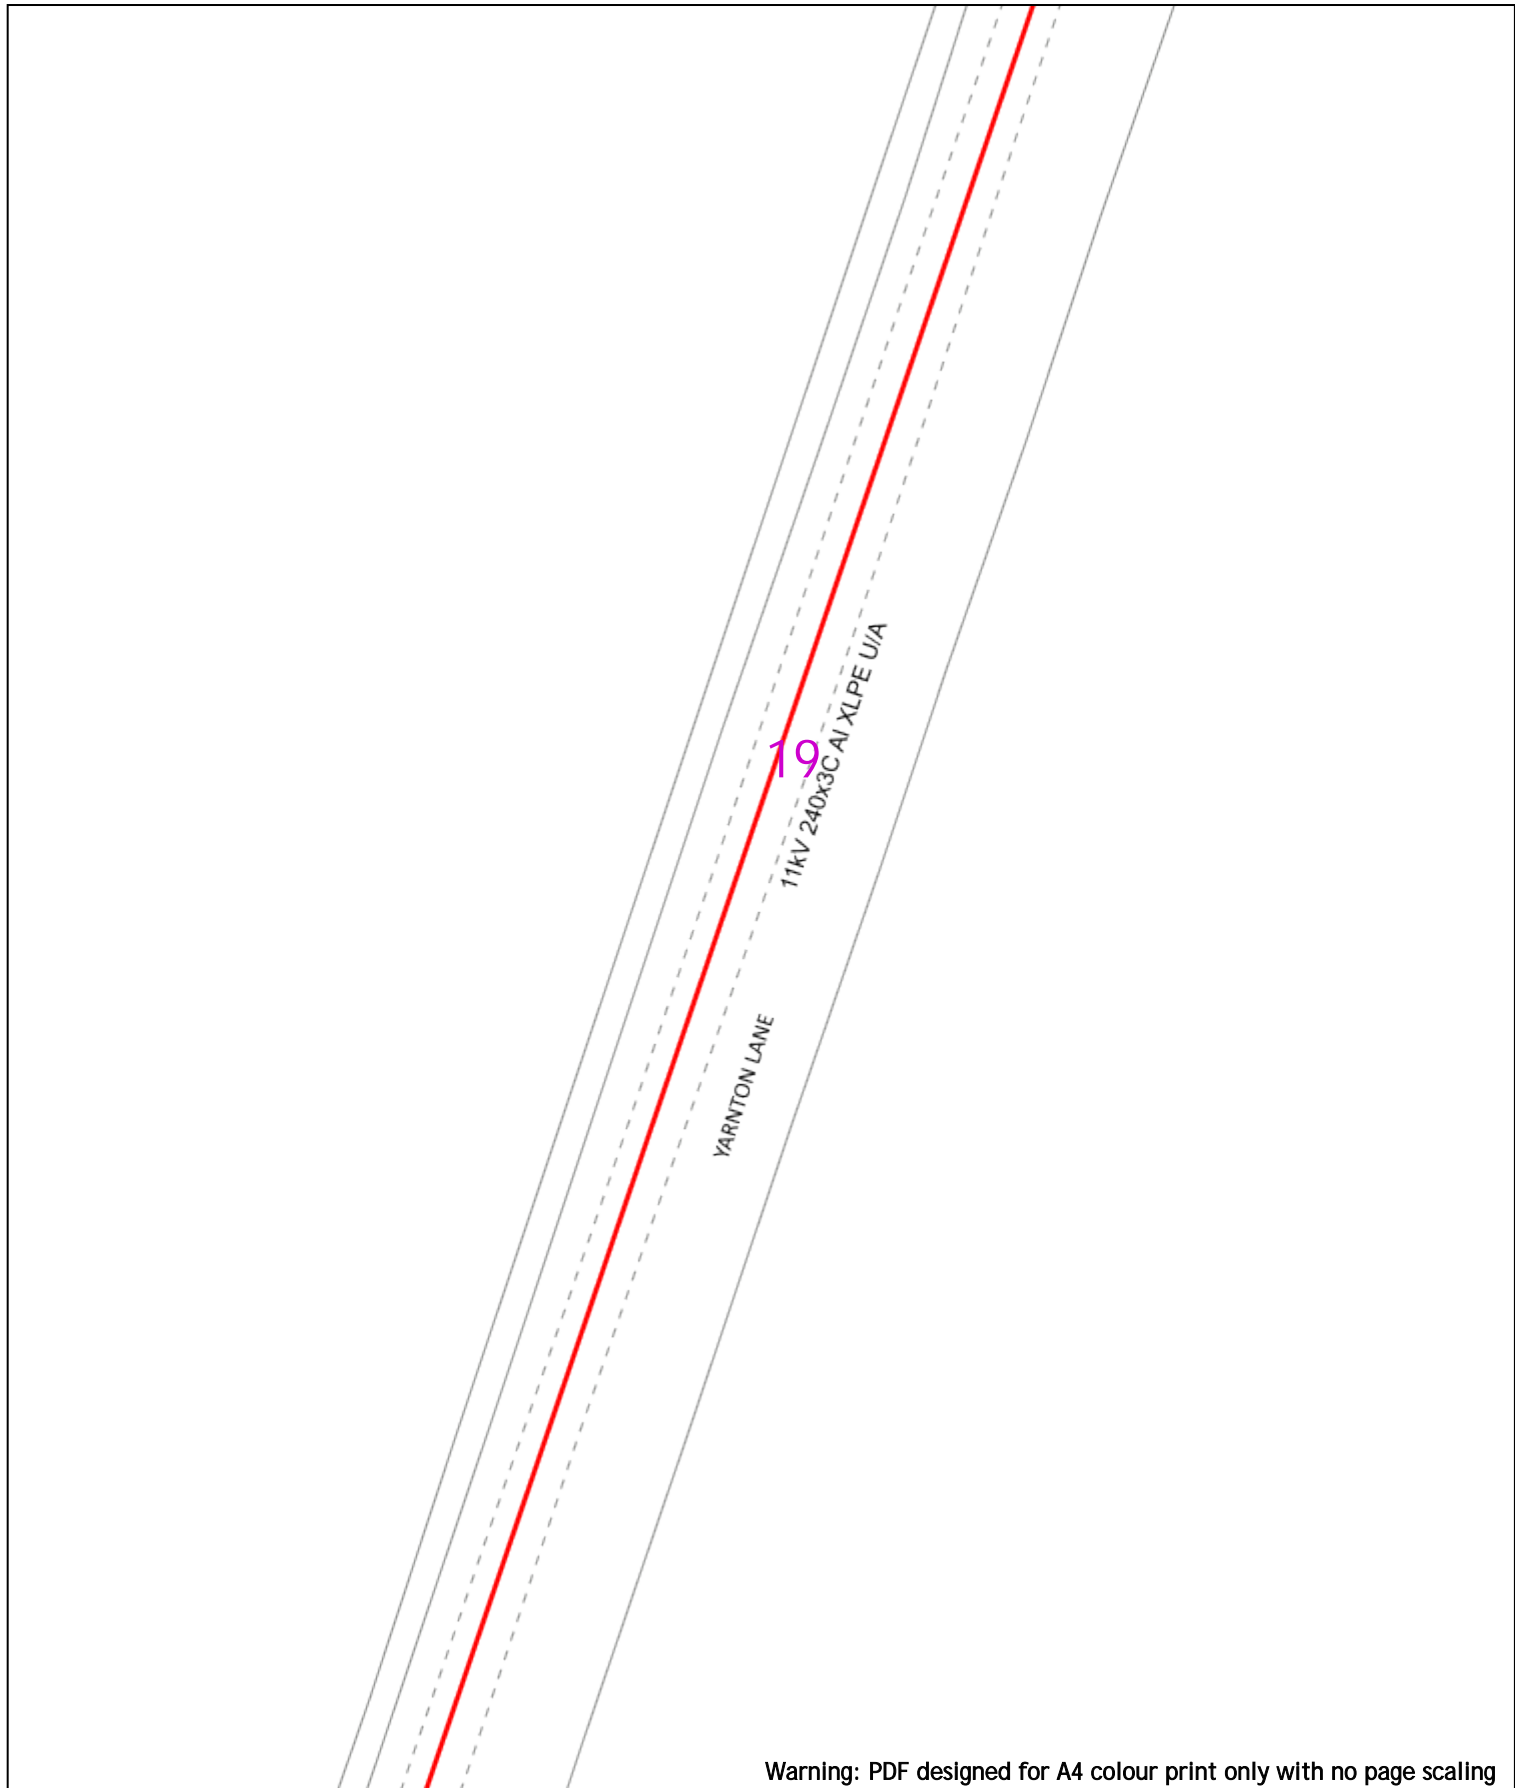

Warning: PDF designed for A4 colour print only with no page scaling



20m Dig Sites Area: Line:

**Extra High Voltage cables in vicinity**



Date Requested: 24/06/2022  
 Job Reference: 25881037  
 Site Location: 448662 213014  
 Requested by: Mr Joe Shawyer  
 Your Scheme/Reference: 31188\_003

Voltages (V)			
LV (Low Voltage) and Services	Up to 1,000V		
HV (High Voltage)	Over 1,000V to 11,000V		
EHV (Extra High Voltage)	22,000V to 132,000V		
Transmission	275,000V and 400,000V		
NORMAL DEPTH TO THE TOP OF THE CABLE WHEN LAID			
Services	LV	HV	EHV
Footpath/Unmade	0.45m	0.45m	0.6m 0.8m
Road Crossing	0.6m	0.6m	0.75m 0.9m
Agricultural	1m	1m	1m 1.1m

Legend	
	Service Cable
	LV Mains
	2 - 11kV
	66kV
	132kV
	275kV
	400kV
	Fibre Optic
	Pilot Cable

Distribution Structures (Electric)	
	Pole, Existing Location
	Pole Structure, Existing Location - Single
	Pole Structure, Existing Location - H
	Duct Route
	Cross Section Route

**WARNING**  
 There may have been subsequent alteration to the surface levels. Trial holes must be undertaken to determine position and depths of cables. HS (G) 47 Booklet from the Health and Safety Executive - Avoiding Danger from Buried Cables - should be consulted before commencing excavation work.  
**WHEN WORKING IN THE VICINITY OF OVERHEAD LINES THE HEALTH AND SAFETY GUIDANCE NOTES G56 SHOULD BE CONSULTED (AVAILABLE FROM THE HSE WEBSITE)**

**Southern Electric Power Distribution plc**  
 Registered Office: No.1 Forbury Place  
 43 Forbury Road Reading RG1 3JH  
 Registered In England & Wales No.04094290

If you're unsure & need to seek advice before commencing excavations, please contact:  
 General Enquiries: 0800 048 3516

Subject to revision - Master held by SSEN Asset Data Team:  
[Asset.Data@sse.com](mailto:Asset.Data@sse.com)  
 01256 337 294


Scale: 1:500 (When plotted at A4)

Warning: PDF designed for A4 colour print only with no page scaling

0  20m





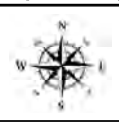








Dig Sites Area:  Line: 





**Extra High Voltage cables in vicinity**



Date Requested: 24/06/2022  
 Job Reference: 25881037  
 Site Location: 448662 213014  
 Requested by: Mr Joe Shawyer  
 Your Scheme/Reference: 31188\_003

Voltages (V)			
LV (Low Voltage) and Services	Up to 1,000V		
HV (High Voltage)	Over 1,000V to 11,000V		
EHV (Extra High Voltage)	22,000V to 132,000V		
Transmission	275,000V and 400,000V		
NORMAL DEPTH TO THE TOP OF THE CABLE WHEN LAID			
Services	LV	HV	EHV
Footpath/Unmade	0.45m	0.45m	0.6m 0.8m
Road Crossing	0.6m	0.6m	0.75m 0.9m
Agricultural	1m	1m	1m 1.1m

Legend	
	Service Cable
	LV Mains
	2 - 11kV
	66kV
	11kV
	22kV
	33kV
	66kV
	132kV
	275kV
	400kV
	Fibre Optic
	Pipe Cable

Distribution Structures (Electric)	
	Pole, Existing Location
	Pole Structure, Existing Location - Single
	Pole Structure, Existing Location - H
	Duct Route
	Cross Section Route


**Southern Electric Power Distribution plc**  
 Registered Office: No.1 Forbury Place  
 43 Forbury Road Reading RG1 3JH  
 Registered In England & Wales No.04094290

If you're unsure & need to seek advice before commencing excavations, please contact:  
 General Enquiries: 0800 048 3516

Subject to revision – Master held by SSEN Asset Data Team:  
[Asset.Data@sse.com](mailto:Asset.Data@sse.com)  
 01256 337 294


Scale: 1:500 (When plotted at A4)

**WARNING**  
 There may have been subsequent alteration to the surface levels. Trial holes must be undertaken to determine position and depths of cables. HS (G) 47 Booklet from the Health and Safety Executive – Avoiding Danger from Buried Cables – should be consulted before commencing excavation work.  
**WHEN WORKING IN THE VICINITY OF OVERHEAD LINES THE HEALTH AND SAFETY GUIDANCE NOTES G56 SHOULD BE CONSULTED (AVAILABLE FROM THE HSE WEBSITE)**

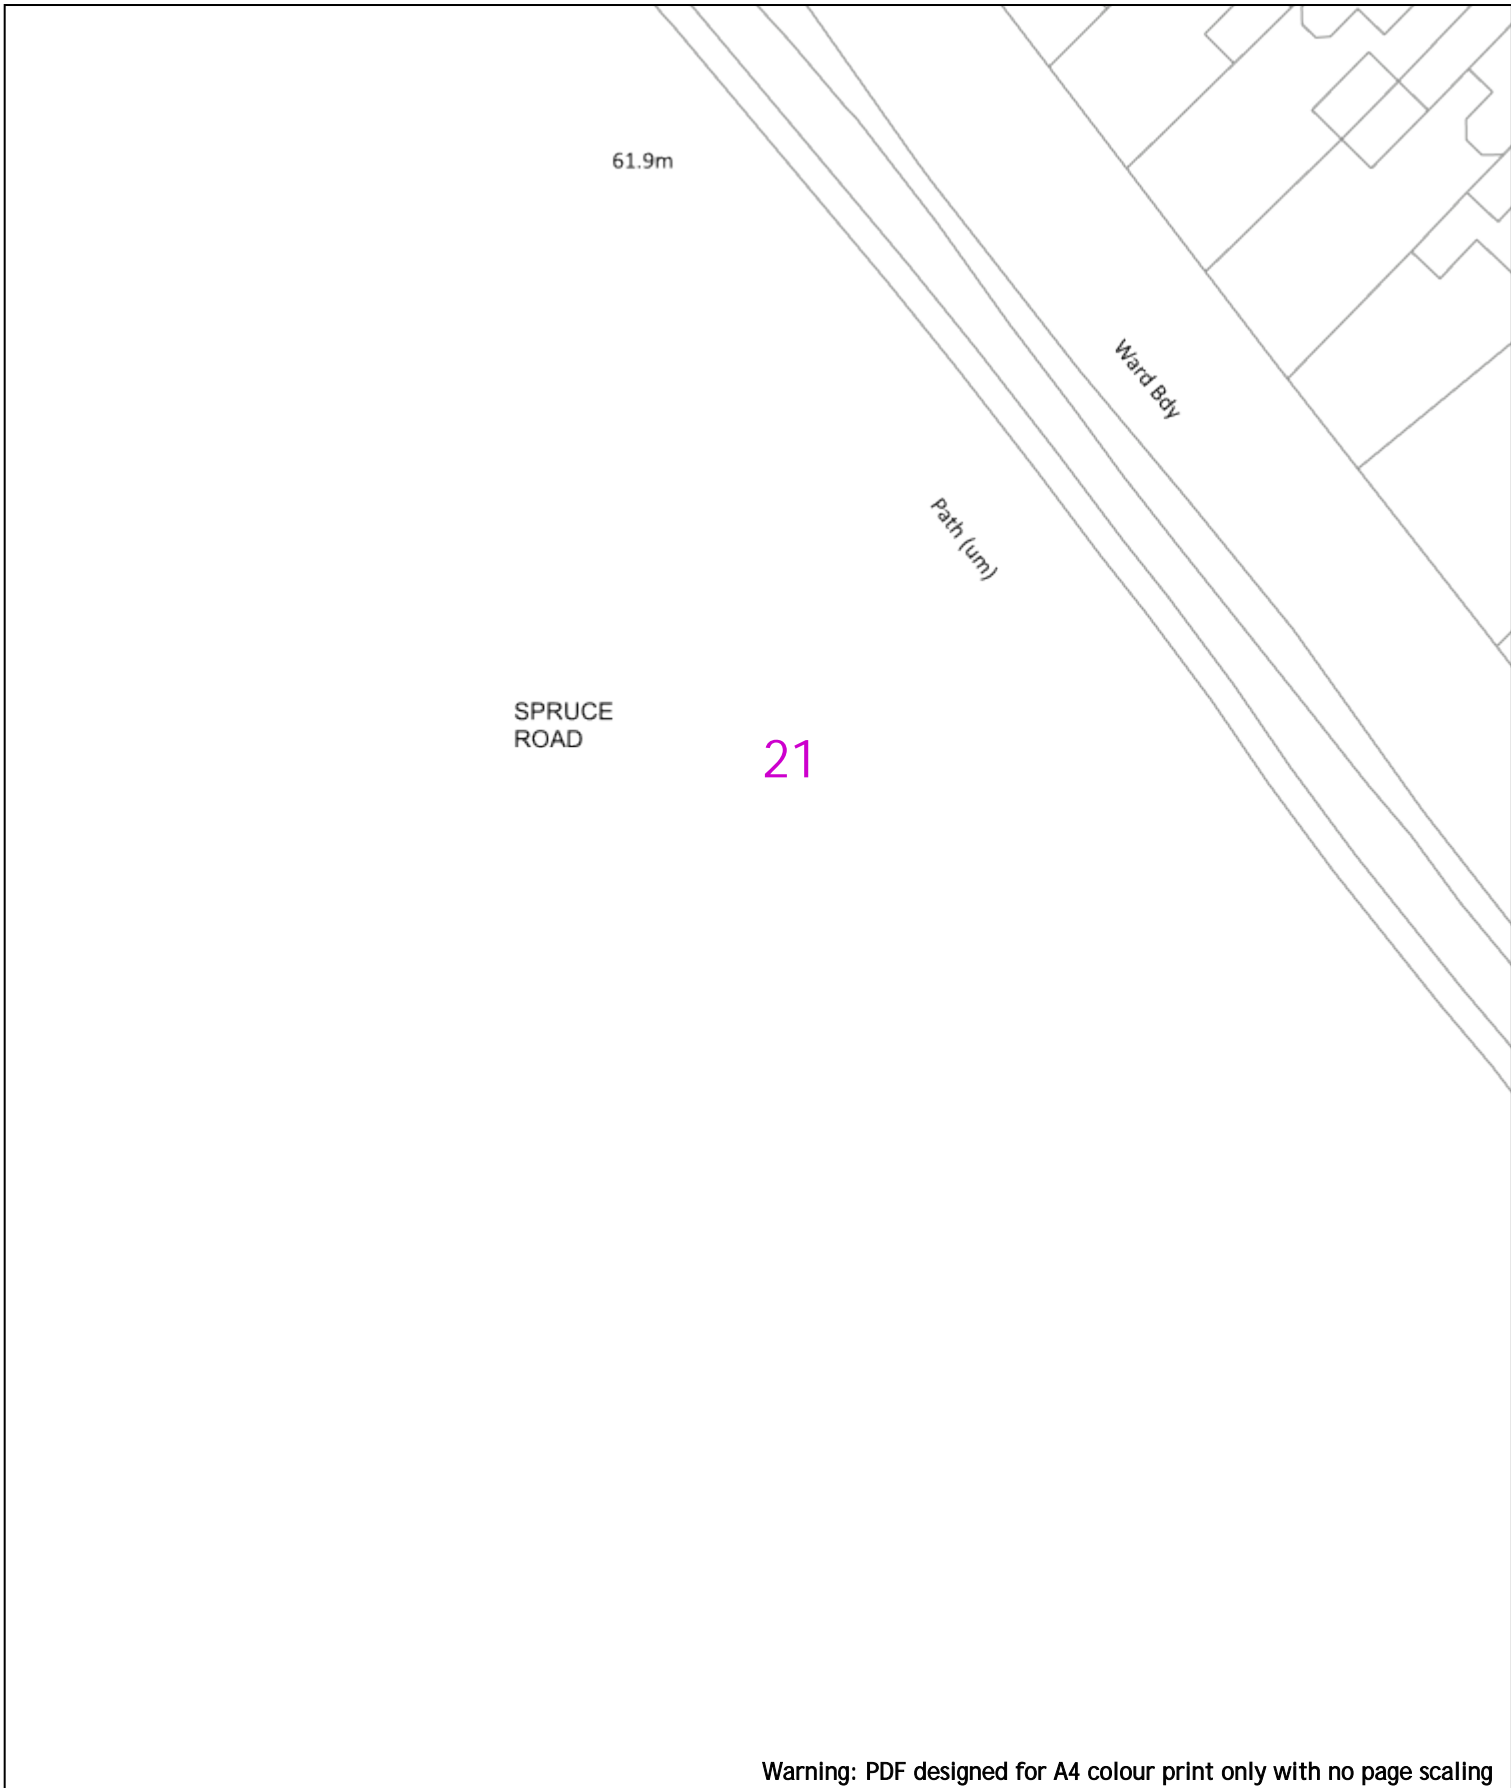


Warning: PDF designed for A4 colour print only with no page scaling

<p>0  20m Dig Sites Area:  Line: </p>	<p style="text-align: center;"><b>Extra High Voltage cables in vicinity</b></p>	
<p>Date Requested: 24/06/2022          Job Reference: 25881037          Site Location: 448662 213014          Requested by: Mr Joe Shawyer          Your Scheme/Reference: 31188_003</p>		<table border="1"> <thead> <tr> <th colspan="4">Voltages (V)</th> </tr> </thead> <tbody> <tr> <td>LV (Low Voltage) and Services</td> <td colspan="3">Up to 1,000V</td> </tr> <tr> <td>HV (High Voltage)</td> <td colspan="3">Over 1,000V to 11,000V</td> </tr> <tr> <td>EHV (Extra High Voltage)</td> <td colspan="3">22,000V to 132,000V</td> </tr> <tr> <td>Transmission</td> <td colspan="3">275,000V and 400,000V</td> </tr> <tr> <th colspan="4">NORMAL DEPTH TO THE TOP OF THE CABLE WHEN LAID</th> </tr> <tr> <th>Services</th> <th>LV</th> <th>HV</th> <th>EHV</th> </tr> <tr> <td>Footpath/Unmade</td> <td>0.45m</td> <td>0.45m</td> <td>0.6m</td> </tr> <tr> <td>Road Crossing</td> <td>0.6m</td> <td>0.6m</td> <td>0.75m</td> </tr> <tr> <td>Agricultural</td> <td>1m</td> <td>1m</td> <td>1.1m</td> </tr> </tbody> </table> <p style="text-align: center;"><b>WARNING</b></p> <p>There may have been subsequent alteration to the surface levels. Trial holes must be undertaken to determine position and depths of cables. HS (G) 47 Booklet from the Health and Safety Executive – Avoiding Danger from Buried Cables – should be consulted before commencing excavation work.</p> <p><b>WHEN WORKING IN THE VICINITY OF OVERHEAD LINES THE HEALTH AND SAFETY GUIDANCE NOTES G56 SHOULD BE CONSULTED (AVAILABLE FROM THE HSE WEBSITE)</b></p>	Voltages (V)				LV (Low Voltage) and Services	Up to 1,000V			HV (High Voltage)	Over 1,000V to 11,000V			EHV (Extra High Voltage)	22,000V to 132,000V			Transmission	275,000V and 400,000V			NORMAL DEPTH TO THE TOP OF THE CABLE WHEN LAID				Services	LV	HV	EHV	Footpath/Unmade	0.45m	0.45m	0.6m	Road Crossing	0.6m	0.6m	0.75m	Agricultural	1m	1m	1.1m	<table border="1"> <thead> <tr> <th colspan="2">Legend</th> </tr> </thead> <tbody> <tr><td></td><td>Service Cable</td></tr> <tr><td></td><td>LV Mains</td></tr> <tr><td></td><td>2 – 11kV</td></tr> <tr><td></td><td>66kV</td></tr> <tr><td></td><td>11kV</td></tr> <tr><td></td><td>22kV</td></tr> <tr><td></td><td>33kV</td></tr> <tr><td></td><td>66kV</td></tr> <tr><td></td><td>132kV</td></tr> <tr><td></td><td>275kV</td></tr> <tr><td></td><td>400kV</td></tr> <tr><td></td><td>Fibre Optic</td></tr> <tr><td></td><td>Pipe Cable</td></tr> </tbody> </table> <table border="1"> <thead> <tr> <th colspan="2">Distribution Structures (Electric)</th> </tr> </thead> <tbody> <tr><td></td><td>Pole, Existing Location</td></tr> <tr><td></td><td>Pole Structure, Existing Location – Single</td></tr> <tr><td></td><td>Pole Structure, Existing Location – H</td></tr> <tr><td></td><td>Duct Route</td></tr> <tr><td></td><td>Cross Section Route</td></tr> </tbody> </table>	Legend			Service Cable		LV Mains		2 – 11kV		66kV		11kV		22kV		33kV		66kV		132kV		275kV		400kV		Fibre Optic		Pipe Cable	Distribution Structures (Electric)			Pole, Existing Location		Pole Structure, Existing Location – Single		Pole Structure, Existing Location – H		Duct Route		Cross Section Route
Voltages (V)	
LV (Low Voltage) and Services	Up to 1,000V	
HV (High Voltage)	Over 1,000V to 11,000V	
EHV (Extra High Voltage)	22,000V to 132,000V	
Transmission	275,000V and 400,000V	
NORMAL DEPTH TO THE TOP OF THE CABLE WHEN LAID	
Services	LV	HV	EHV	
Footpath/Unmade	0.45m	0.45m	0.6m	
Road Crossing	0.6m	0.6m	0.75m	
Agricultural	1m	1m	1.1m	
Legend	
	Service Cable	
	LV Mains	
	2 – 11kV	
	66kV	
	11kV	
	22kV	
	33kV	
	66kV	
	132kV	
	275kV	
	400kV	
	Fibre Optic	
	Pipe Cable	
Distribution Structures (Electric)	
	Pole, Existing Location	
	Pole Structure, Existing Location – Single	
	Pole Structure, Existing Location – H	
	Duct Route	
	Cross Section Route	
<p style="font-size: small;">BASED UPON THE ORDNANCE SURVEY MAP WITH THE SANCTION OF THE CONTROLLER OF HM STATIONERY OFFICE CROWN COPYRIGHT RESERVED.          This copy has been made by or with the authority of Scottish and Southern Energy Power Distribution Ltd. Pursuant to section 47 of the Copyright, Designs and Patents Act 1988 ("The Act"). Unless the Act provides a relevant exception to copyright the copy must not be copied without prior permission of the copyright owner.          Plans generated by DigSAFE Pro™ software provided by LinesearchbeforeDigs.</p>	

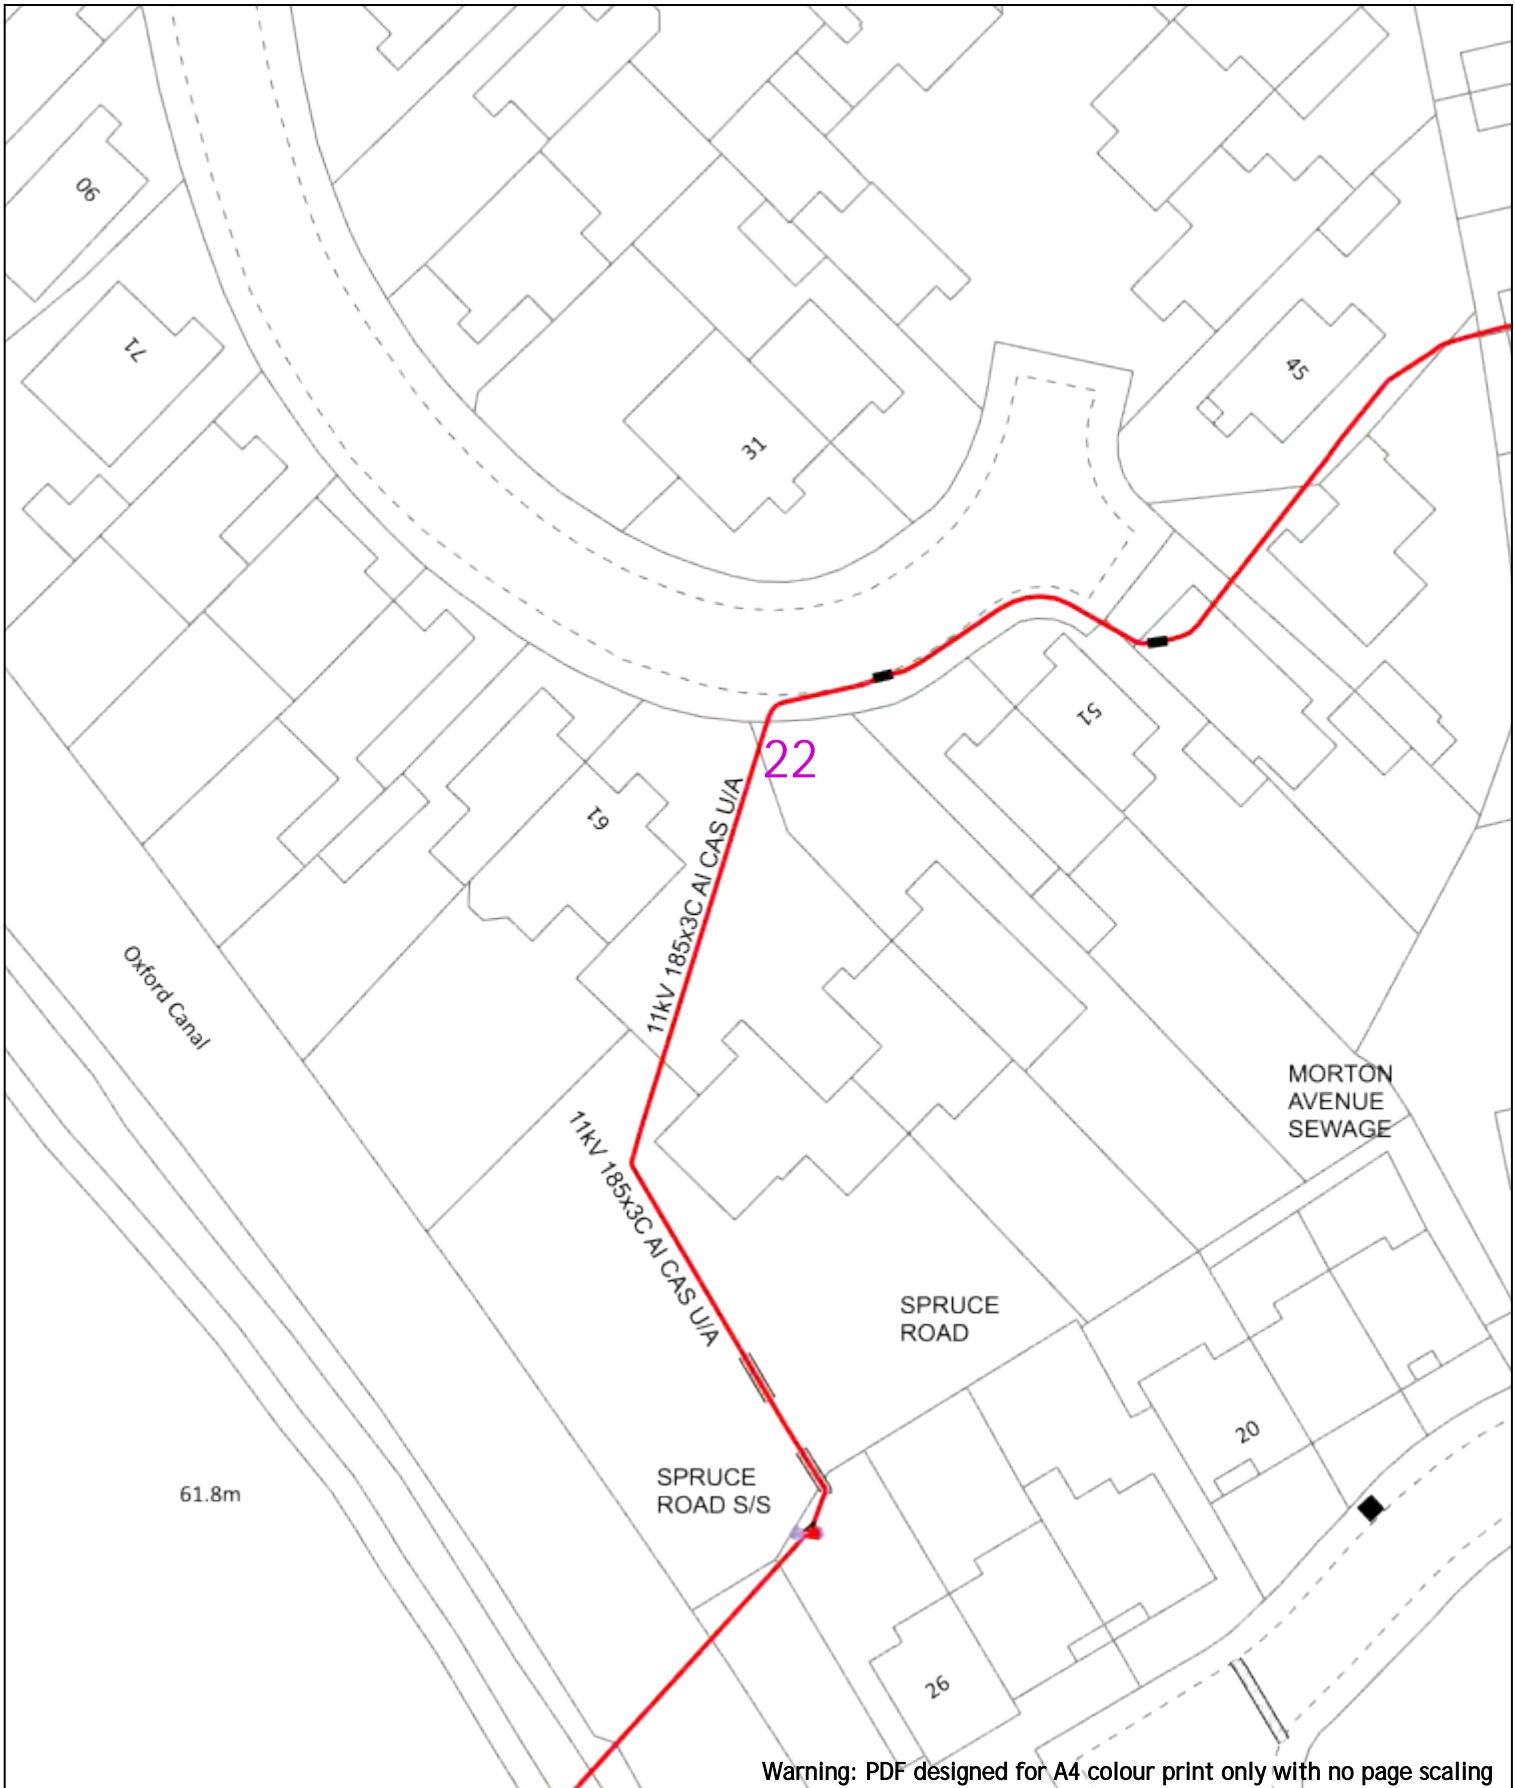

Warning: PDF designed for A4 colour print only with no page scaling

<p>0  20m Dig Sites Area:  Line:  <b>Extra High Voltage cables in vicinity</b></p>																										
<p>Date Requested: 24/06/2022          Job Reference: 25881037          Site Location: 448662 213014          Requested by: Mr Joe Shawyer          Your Scheme/Reference: 31188_003</p>	<p><b>Legend</b></p> <ul style="list-style-type: none"> <li>Service Cable</li> <li>LV Mains</li> <li>7-11kV</li> <li>66kV</li> <li>11kV</li> <li>22kV</li> <li>33kV</li> <li>66kV</li> <li>132kV</li> <li>275kV</li> <li>400kV</li> <li>Fibre Optic</li> <li>Pipe Cable</li> </ul> <p><b>Distribution Structures (Electric)</b></p> <ul style="list-style-type: none"> <li>Pole, Existing Location</li> <li>Pole Structure, Existing Location - Single</li> <li>Pole Structure, Existing Location - H</li> <li>Duct Route</li> <li>Cross Section Route</li> </ul>																									
<p><b>Voltagess (V)</b></p> <table border="1"> <tr> <td>LV (Low Voltage) and Services</td> <td>Up to 1,000V</td> </tr> <tr> <td>HV (High Voltage)</td> <td>Over 1,000V to 11,000V</td> </tr> <tr> <td>EHV (Extra High Voltage)</td> <td>22,000V to 132,000V</td> </tr> <tr> <td>Transmission</td> <td>275,000V and 400,000V</td> </tr> </table> <p><b>NORMAL DEPTH TO THE TOP OF THE CABLE WHEN LAID</b></p> <table border="1"> <thead> <tr> <th>Services</th> <th>LV</th> <th>HV</th> <th>EHV</th> </tr> </thead> <tbody> <tr> <td>Footpath/Unmade</td> <td>0.45m</td> <td>0.45m</td> <td>0.6m</td> </tr> <tr> <td>Road Crossing</td> <td>0.6m</td> <td>0.6m</td> <td>0.75m</td> </tr> <tr> <td>Agricultural</td> <td>1m</td> <td>1m</td> <td>1.1m</td> </tr> </tbody> </table>		LV (Low Voltage) and Services	Up to 1,000V	HV (High Voltage)	Over 1,000V to 11,000V	EHV (Extra High Voltage)	22,000V to 132,000V	Transmission	275,000V and 400,000V	Services	LV	HV	EHV	Footpath/Unmade	0.45m	0.45m	0.6m	Road Crossing	0.6m	0.6m	0.75m	Agricultural	1m	1m	1.1m	<p><b>WARNING</b></p> <p>There may have been subsequent alteration to the surface levels. Trial holes must be undertaken to determine position and depths of cables. HS (G) 47 Booklet from the Health and Safety Executive - Avoiding Danger from Buried Cables - should be consulted before commencing excavation work.</p> <p><b>WHEN WORKING IN THE VICINITY OF OVERHEAD LINES THE HEALTH AND SAFETY GUIDANCE NOTES G56 SHOULD BE CONSULTED (AVAILABLE FROM THE HSE WEBSITE)</b></p>
LV (Low Voltage) and Services	Up to 1,000V																									
HV (High Voltage)	Over 1,000V to 11,000V																									
EHV (Extra High Voltage)	22,000V to 132,000V																									
Transmission	275,000V and 400,000V																									
Services	LV	HV	EHV																							
Footpath/Unmade	0.45m	0.45m	0.6m																							
Road Crossing	0.6m	0.6m	0.75m																							
Agricultural	1m	1m	1.1m																							
<p>Scale: 1:500 (When plotted at A4)</p>		<p><b>Southern Electric Power Distribution plc</b>          Registered Office: No.1 Forbury Place          43 Forbury Road Reading RG1 3JH          Registered In England &amp; Wales No.04094290</p> <p>If you're unsure &amp; need to seek advice before commencing excavations, please contact:          General Enquiries: 0800 048 3516</p> <p>Subject to revision - Master held by SSEN Asset Data Team:  <a href="mailto:Asset.Data@sse.com">Asset.Data@sse.com</a>          01256 337 294</p>																								

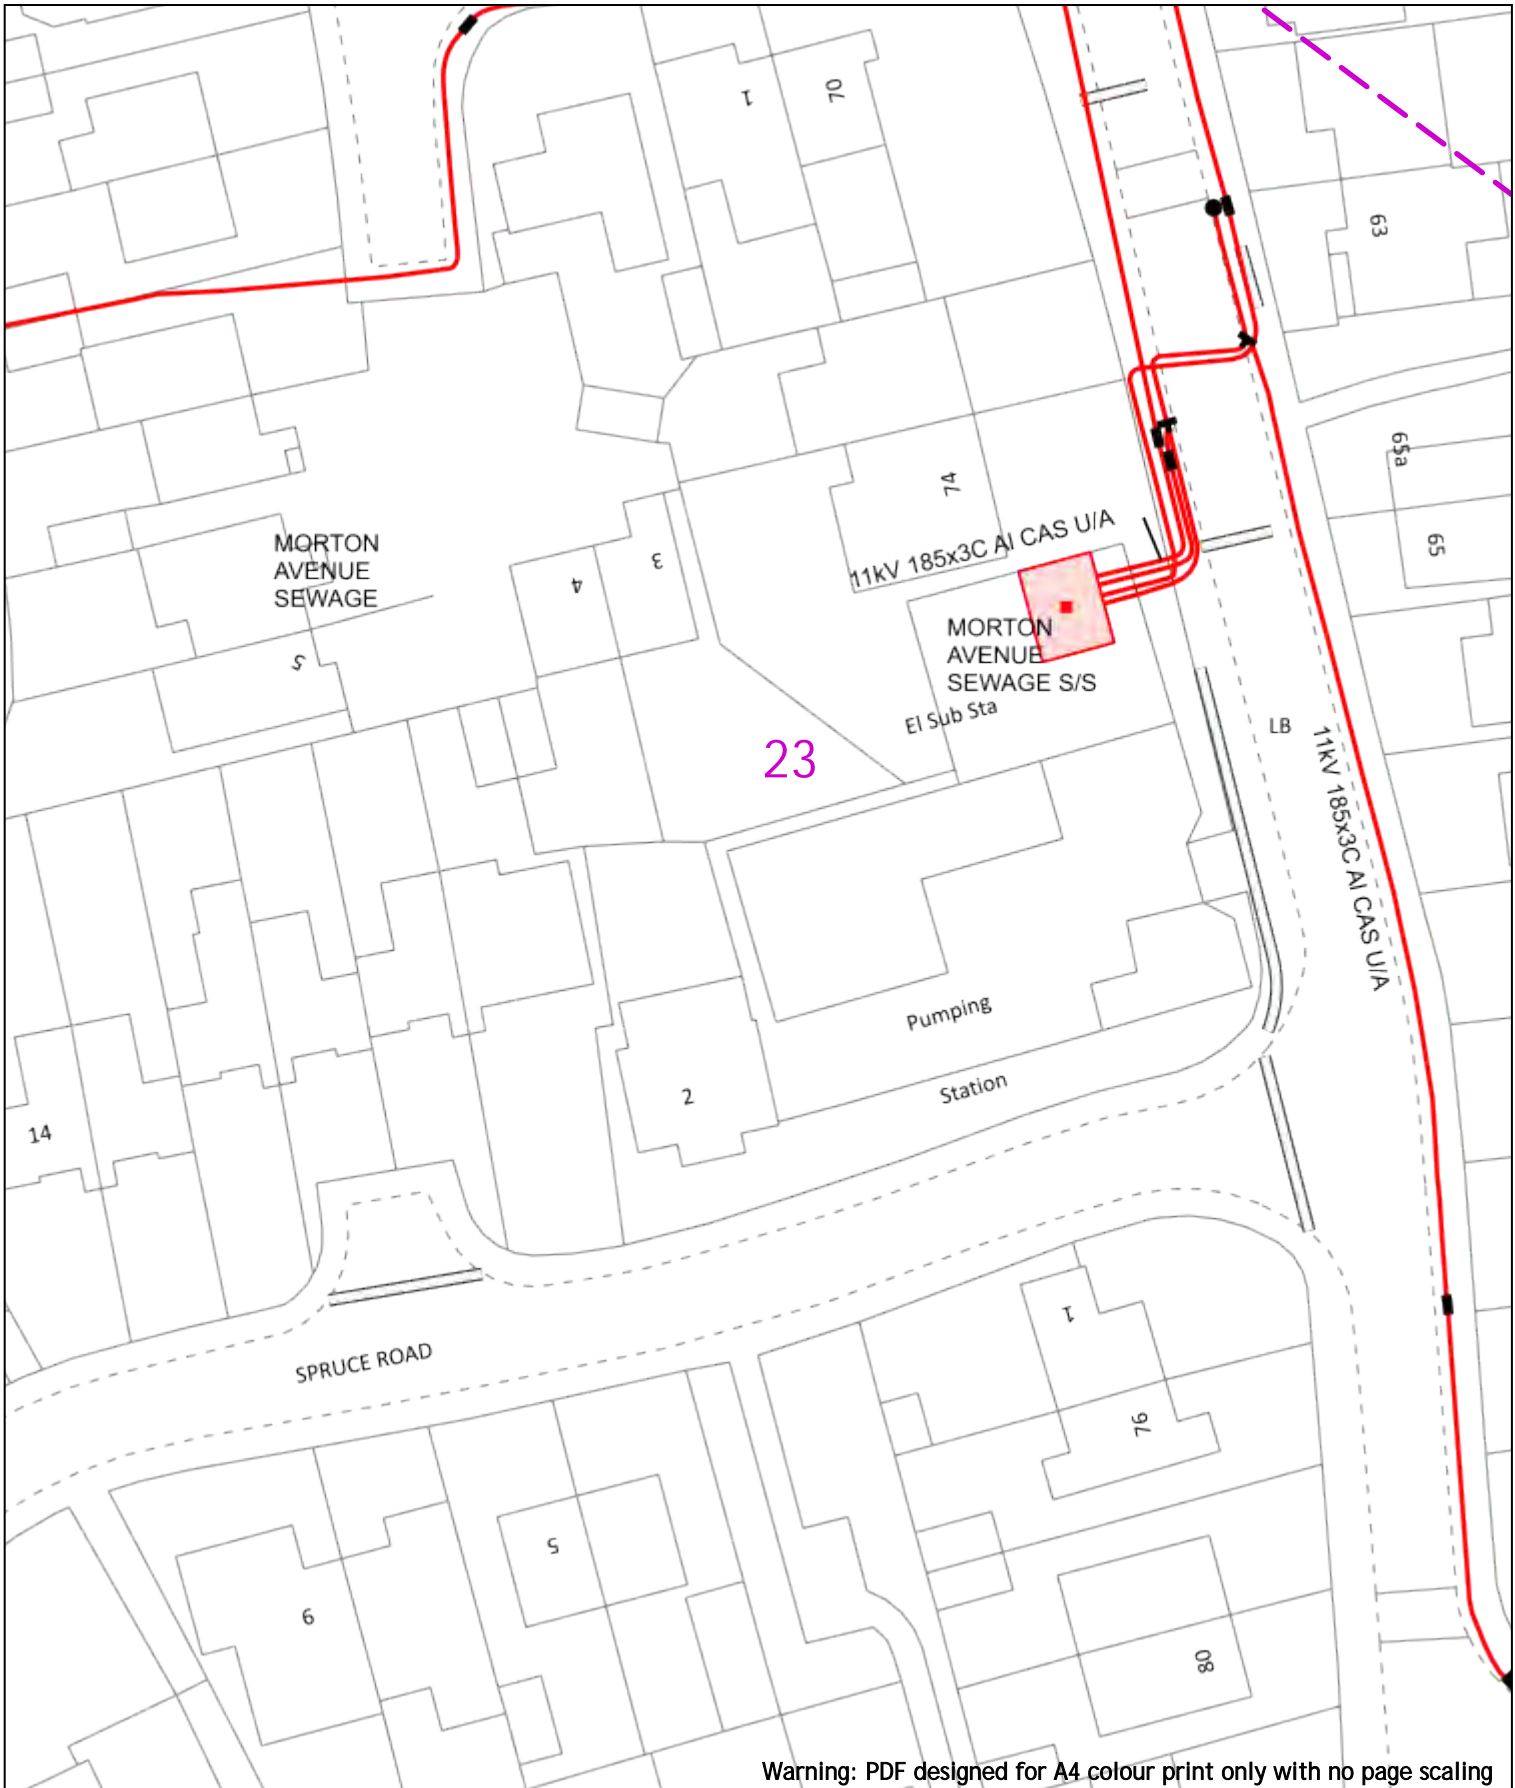

Warning: PDF designed for A4 colour print only with no page scaling

0 20m

Dig Sites Area: Line:

**Extra High Voltage  
cables in vicinity**

Date Requested: 24/06/2022  
 Job Reference: 25881037  
 Site Location: 448662 213014  
 Requested by: Mr Joe Shawyer  
 Your Scheme/Reference: 31188\_003

Voltages (V)			
LV (Low Voltage) and Services	Up to 1,000V		
HV (High Voltage)	Over 1,000V to 11,000V		
EHV (Extra High Voltage)	22,000V to 132,000V		
Transmission	275,000V and 400,000V		
NORMAL DEPTH TO THE TOP OF THE CABLE WHEN LAID			
Services	LV	HV	EHV
Footpath/Unmade	0.45m	0.45m	0.6m
Road Crossing	0.6m	0.6m	0.75m
Agricultural	1m	1m	1.1m

<p><b>Legend</b></p> <ul style="list-style-type: none"> <li> Service Cable</li> <li> LV Mains</li> <li> 6kV</li> <li> 11kV</li> <li> 22kV</li> <li> 33kV</li> <li> 66kV</li> <li> 132kV</li> <li> 275kV</li> <li> 400kV</li> <li> Fibre Optic</li> <li> Pipit Cable</li> </ul>	<p><b>Distribution Structures (Electric)</b></p> <ul style="list-style-type: none"> <li> Pole, Existing Location</li> <li> Pole Structure, Existing Location - Single</li> <li> Pole Structure, Existing Location - H</li> <li> Duct Route</li> <li> Cross Section Route</li> </ul>
--	---

**WARNING**

There may have been subsequent alteration to the surface levels. Trial holes must be undertaken to determine position and depths of cables. HS (G) 47 Booklet from the Health and Safety Executive - Avoiding Danger from Buried Cables - should be consulted before commencing excavation work.

WHEN WORKING IN THE VICINITY OF OVERHEAD LINES THE HEALTH AND SAFETY GUIDANCE NOTES G56 SHOULD BE CONSULTED (AVAILABLE FROM THE HSE WEBSITE)


Scale: 1:500 (When plotted at A4)

BASED UPON THE ORDNANCE SURVEY MAP WITH THE SANCTION OF THE CONTROLLER OF HM STATIONERY OFFICE CROWN COPYRIGHT RESERVED.  
 This copy has been made by or with the authority of Scottish and Southern Energy Power Distribution Ltd. Pursuant to section 47 of the Copyright, Designs and Patents Act 1988 ('The Act'). Unless the Act provides a relevant exception to copyright the copy must not be copied without prior permission of the copyright owner.  
 Plans generated by DigSAFE Pro™ software provided by LinesearchbeforeUdig.

**Southern Electric Power Distribution plc**  
 Registered Office: No.1 Forbury Place  
 43 Forbury Road Reading RG1 3JH  
 Registered In England & Wales No.04094290

If you're unsure & need to seek advice before commencing excavations, please contact:  
 General Enquiries: 0800 048 3516

Subject to revision – Master held by SSEN Asset Data Team:  
[Asset.Data@sse.com](mailto:Asset.Data@sse.com)  
 01256 337 294

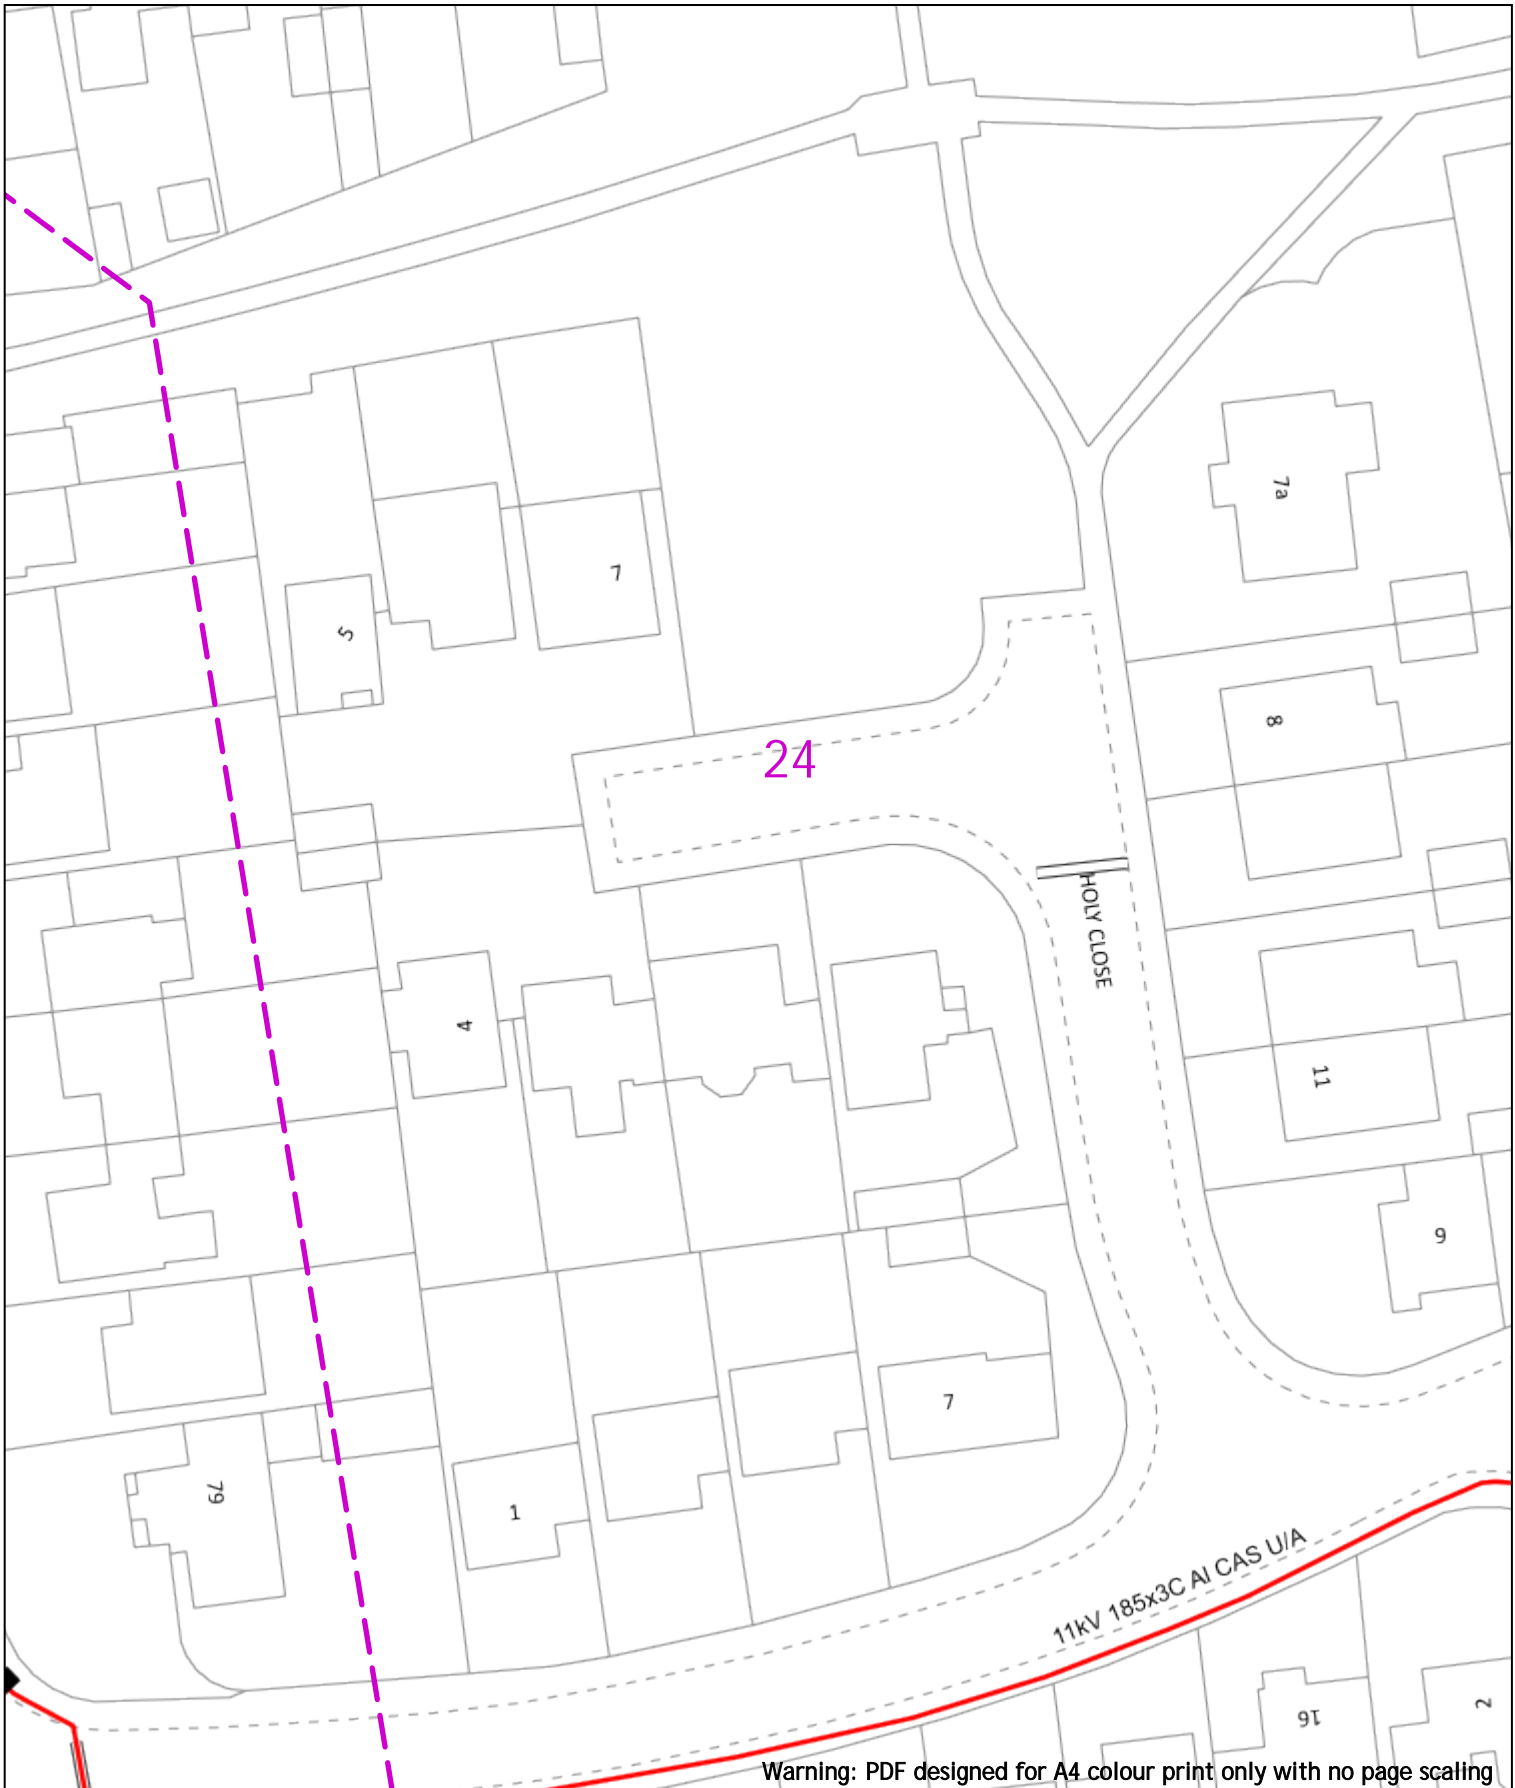

11kV 185x3C Al CAS U/A

Warning: PDF designed for A4 colour print only with no page scaling



20m Dig Sites Area: Line:

**Extra High Voltage cables in vicinity**



Date Requested: 24/06/2022  
 Job Reference: 25881037  
 Site Location: 448662 213014  
 Requested by: Mr Joe Shawyer  
 Your Scheme/Reference: 31188\_003

Voltages (V)			
LV (Low Voltage) and Services	Up to 1,000V		
HV (High Voltage)	Over 1,000V to 11,000V		
EHV (Extra High Voltage)	22,000V to 132,000V		
Transmission	275,000V and 400,000V		
NORMAL DEPTH TO THE TOP OF THE CABLE WHEN LAID			
Services	LV	HV	EHV
Footpath/Unmade	0.45m	0.45m	0.6m
Road Crossing	0.6m	0.6m	0.75m
Agricultural	1m	1m	1.1m

Legend	
	Service Cable
	LV Mains
	2 - 11kV
	6.6kV
	11kV
	22kV
	33kV
	66kV
	132kV
	275kV
	400kV
	Fibre Optic
	Pipe Cable

Distribution Structures (Electric)	
	Pole, Existing Location
	Pole Structure, Existing Location - Single
	Pole Structure, Existing Location - H
	Duct Route
	Cross Section Route


**Southern Electric Power Distribution plc**  
 Registered Office: No.1 Forbury Place  
 43 Forbury Road Reading RG1 3JH  
 Registered In England & Wales No.04094290

If you're unsure & need to seek advice before commencing excavations, please contact:  
 General Enquiries: 0800 048 3516

Subject to revision - Master held by SSEN Asset Data Team:  
[Asset.Data@sse.com](mailto:Asset.Data@sse.com)  
 01256 337 294

Scale: 1:500 (When plotted at A4)


**WARNING**  
 There may have been subsequent alteration to the surface levels. Trial holes must be undertaken to determine position and depths of cables. HS (G) 47 Booklet from the Health and Safety Executive - Avoiding Danger from Buried Cables - should be consulted before commencing excavation work.  
**WHEN WORKING IN THE VICINITY OF OVERHEAD LINES THE HEALTH AND SAFETY GUIDANCE NOTES G56 SHOULD BE CONSULTED (AVAILABLE FROM THE HSE WEBSITE)**

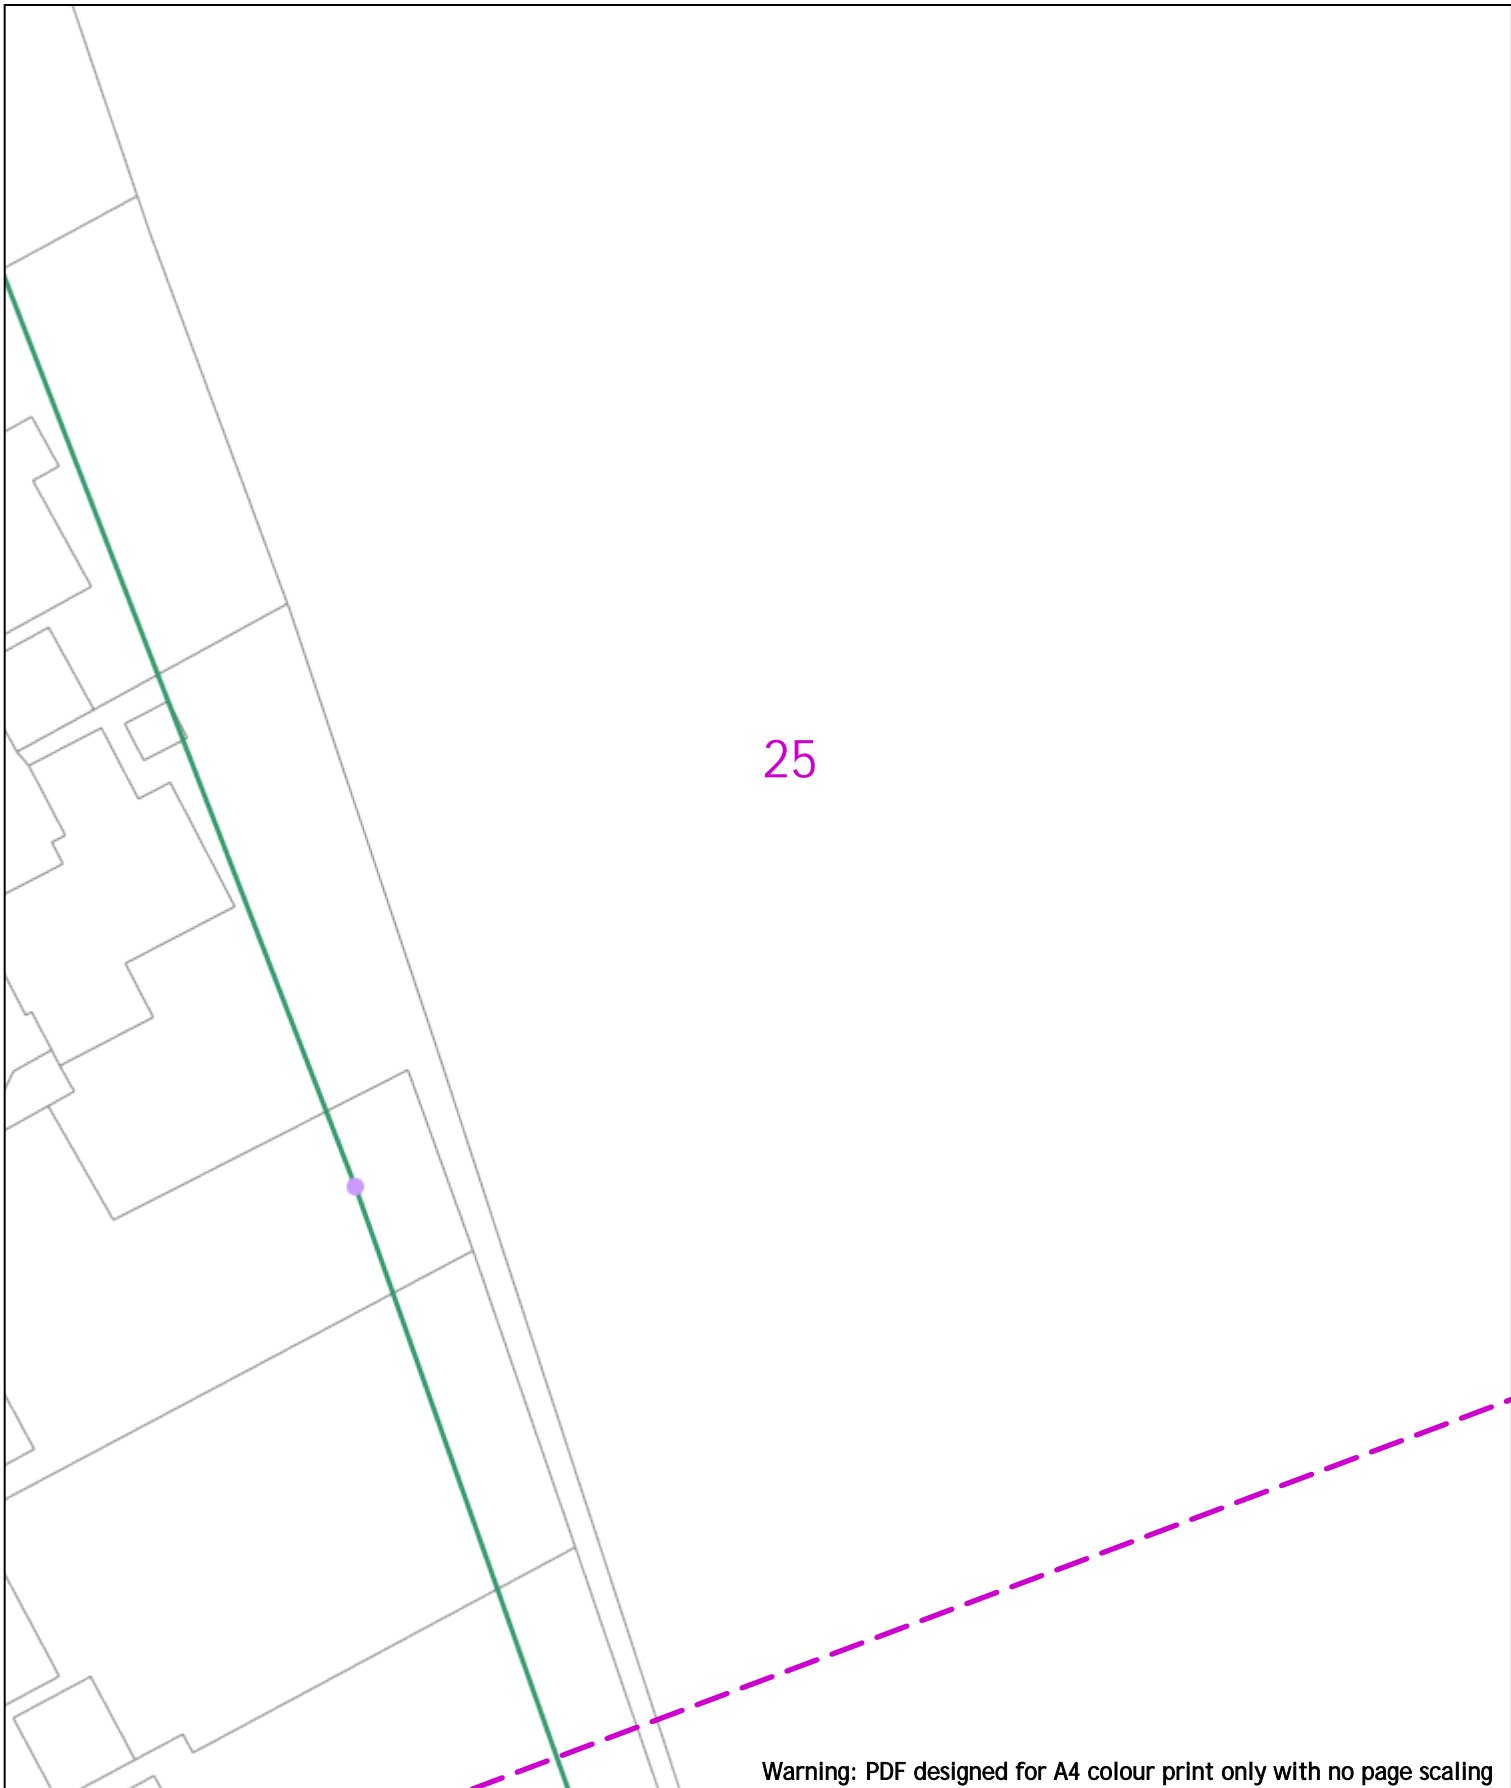

Warning: PDF designed for A4 colour print only with no page scaling

<p>0  20m</p> <p>Date Requested: 24/06/2022          Job Reference: 25881037          Site Location: 448662 213014          Requested by: Mr Joe Shawyer          Your Scheme/Reference: 31188_003</p>	<p>Dig Sites Area:  Line: </p> <p style="text-align: center; background-color: red; color: white; padding: 5px;"><b>Extra High Voltage cables in vicinity</b></p>	<p> </p> <p style="text-align: center;"><b>Southern Electric Power Distribution plc</b>          Registered Office: No.1 Forbury Place          43 Forbury Road Reading RG1 3JH          Registered In England &amp; Wales No.04094290</p> <p style="font-size: small;">If you're unsure &amp; need to seek advice before commencing excavations, please contact:          General Enquiries: 0800 048 3516</p> <p style="font-size: small;">Subject to revision – Master held by SSEN Asset Data Team:  <a href="mailto:Asset.Data@sse.com">Asset.Data@sse.com</a>          01256 337 294</p>	
<p>Scale: 1:500 (When plotted at A4)</p>	<table border="1" style="width: 100%; border-collapse: collapse; font-size: x-small;"> <thead> <tr> <th colspan="4">Voltages (V)</th> </tr> </thead> <tbody> <tr> <td>LV (Low Voltage) and Services</td> <td colspan="3">Up to 1,000V</td> </tr> <tr> <td>HV (High Voltage)</td> <td colspan="3">Over 1,000V to 11,000V</td> </tr> <tr> <td>EHV (Extra High Voltage)</td> <td colspan="3">22,000V to 132,000V</td> </tr> <tr> <td>Transmission</td> <td colspan="3">275,000V and 400,000V</td> </tr> <tr> <th colspan="4">NORMAL DEPTH TO THE TOP OF THE CABLE WHEN LAID</th> </tr> <tr> <td>Services</td> <td>LV</td> <td>HV</td> <td>EHV</td> </tr> <tr> <td>Footpath/Unmade</td> <td>0.45m</td> <td>0.45m</td> <td>0.6m</td> </tr> <tr> <td>Road Crossing</td> <td>0.6m</td> <td>0.6m</td> <td>0.75m</td> </tr> <tr> <td>Agricultural</td> <td>1m</td> <td>1m</td> <td>1.1m</td> </tr> </tbody> </table> <p style="font-size: x-small; text-align: center;"><b>WARNING</b>          There may have been subsequent alteration to the surface levels. Trial holes must be undertaken to determine position and depths of cables. HS (G) 47 Booklet from the Health and Safety Executive – Avoiding Danger from Buried Cables – should be consulted before commencing excavation work.  <b>WHEN WORKING IN THE VICINITY OF OVERHEAD LINES THE HEALTH AND SAFETY GUIDANCE NOTES G66 SHOULD BE CONSULTED (AVAILABLE FROM THE HSE WEBSITE)</b></p>	Voltages (V)				LV (Low Voltage) and Services	Up to 1,000V			HV (High Voltage)	Over 1,000V to 11,000V			EHV (Extra High Voltage)	22,000V to 132,000V			Transmission	275,000V and 400,000V			NORMAL DEPTH TO THE TOP OF THE CABLE WHEN LAID				Services	LV	HV	EHV	Footpath/Unmade	0.45m	0.45m	0.6m	Road Crossing	0.6m	0.6m	0.75m	Agricultural	1m	1m	1.1m	<table border="1" style="width: 100%; border-collapse: collapse; font-size: x-small;"> <thead> <tr> <th colspan="2">Legend</th> <th colspan="2">Distribution Structures (Electric)</th> </tr> </thead> <tbody> <tr> <td></td> <td>Service Cable</td> <td></td> <td>Pole, Existing Location</td> </tr> <tr> <td></td> <td>LV Mains</td> <td></td> <td>Pole Structure, Existing Location - Single</td> </tr> <tr> <td></td> <td>2 - 11kV</td> <td></td> <td>Pole Structure, Existing Location - H</td> </tr> <tr> <td></td> <td>66kV</td> <td></td> <td>Duct Route</td> </tr> <tr> <td></td> <td>11kV</td> <td></td> <td>Cross Section Route</td> </tr> <tr> <td></td> <td>22kV</td> <td></td> <td></td> </tr> <tr> <td></td> <td>33kV</td> <td></td> <td></td> </tr> <tr> <td></td> <td>66kV</td> <td></td> <td></td> </tr> <tr> <td></td> <td>132kV</td> <td></td> <td></td> </tr> <tr> <td></td> <td>275kV</td> <td></td> <td></td> </tr> <tr> <td></td> <td>400kV</td> <td></td> <td></td> </tr> <tr> <td></td> <td>Fibre Optic</td> <td></td> <td></td> </tr> <tr> <td></td> <td>Pilot Cable</td> <td></td> <td></td> </tr> </tbody> </table>	Legend		Distribution Structures (Electric)			Service Cable		Pole, Existing Location		LV Mains		Pole Structure, Existing Location - Single		2 - 11kV		Pole Structure, Existing Location - H		66kV		Duct Route		11kV		Cross Section Route		22kV				33kV				66kV				132kV				275kV				400kV				Fibre Optic				Pilot Cable		
Voltages (V)	
LV (Low Voltage) and Services	Up to 1,000V	
HV (High Voltage)	Over 1,000V to 11,000V	
EHV (Extra High Voltage)	22,000V to 132,000V	
Transmission	275,000V and 400,000V	
NORMAL DEPTH TO THE TOP OF THE CABLE WHEN LAID	
Services	LV	HV	EHV	
Footpath/Unmade	0.45m	0.45m	0.6m	
Road Crossing	0.6m	0.6m	0.75m	
Agricultural	1m	1m	1.1m	
Legend		Distribution Structures (Electric)	
	Service Cable		Pole, Existing Location	
	LV Mains		Pole Structure, Existing Location - Single	
	2 - 11kV		Pole Structure, Existing Location - H	
	66kV		Duct Route	
	11kV		Cross Section Route	
	22kV	
	33kV	
	66kV	
	132kV	
	275kV	
	400kV	
	Fibre Optic	
	Pilot Cable	



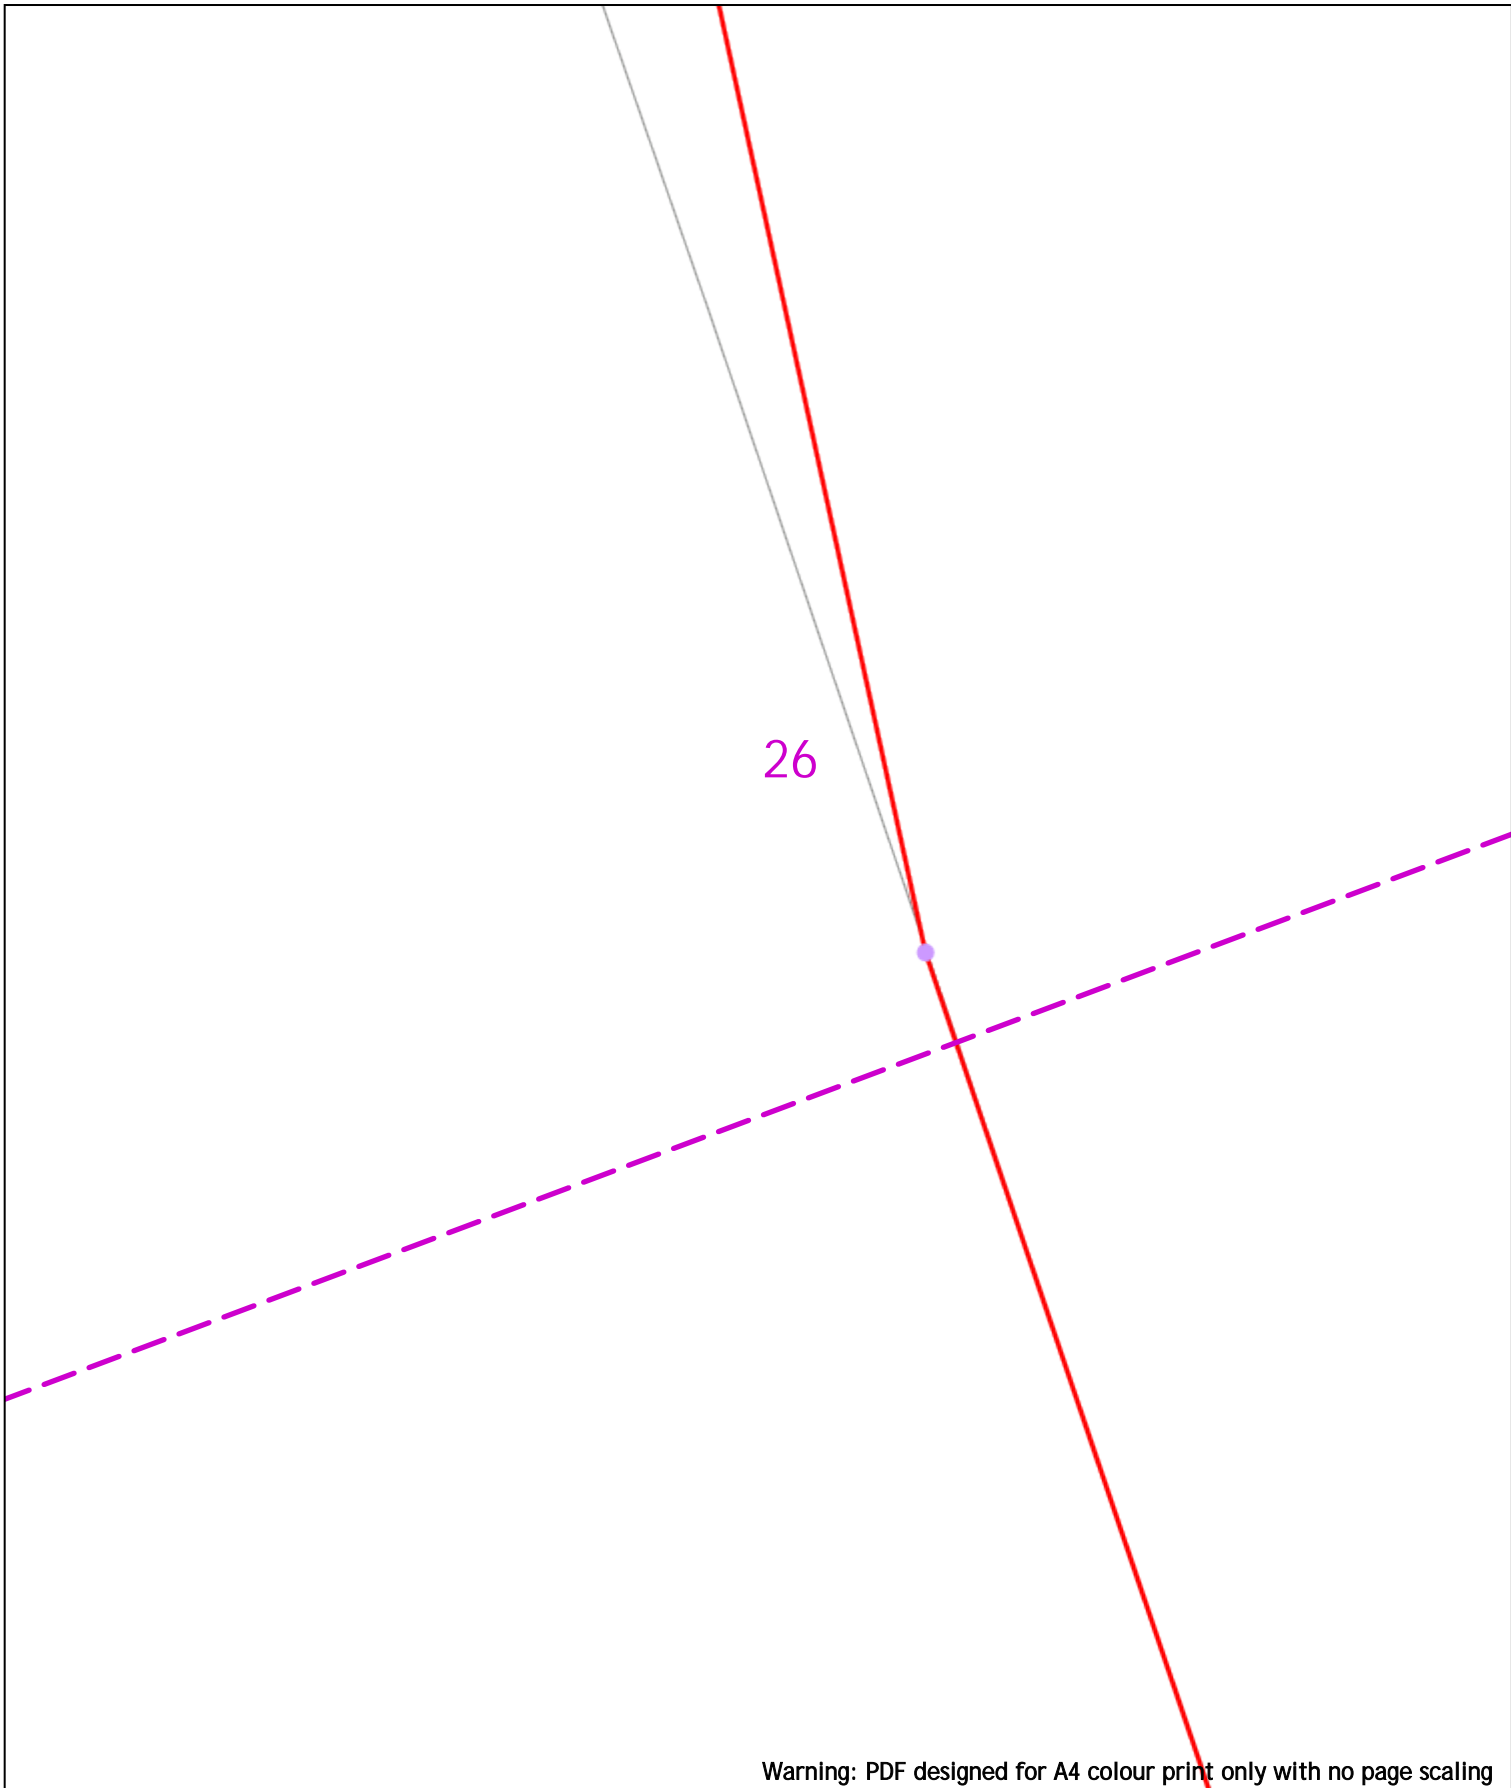

Warning: PDF designed for A4 colour print only with no page scaling

<p>0  20m</p> <p>Date Requested: 24/06/2022          Job Reference: 25881037          Site Location: 448662 213014          Requested by: Mr Joe Shawyer          Your Scheme/Reference: 31188_003</p>	<p>Dig Sites Area:  Line: </p> <p style="text-align: center; background-color: red; color: white; padding: 5px;"><b>Extra High Voltage cables in vicinity</b></p>		<p style="text-align: center;"><b>Southern Electric Power Distribution plc</b>          Registered Office: No.1 Forbury Place          43 Forbury Road Reading RG1 3JH          Registered In England &amp; Wales No.04094290</p> <p style="font-size: small;">If you're unsure &amp; need to seek advice before commencing excavations, please contact:          General Enquiries: 0800 048 3516</p> <p style="font-size: small;">Subject to revision – Master held by SSEN Asset Data Team:  <a href="mailto:Asset.Data@sse.com">Asset.Data@sse.com</a>          01256 337 294</p>	
<table border="1" style="width: 100%; border-collapse: collapse;"> <thead> <tr> <th colspan="4" style="text-align: center;">Voltages (V)</th> </tr> </thead> <tbody> <tr> <td>LV (Low Voltage) and Services</td> <td colspan="3">Up to 1,000V</td> </tr> <tr> <td>HV (High Voltage)</td> <td colspan="3">Over 1,000V to 11,000V</td> </tr> <tr> <td>EHV (Extra High Voltage)</td> <td colspan="3">22,000V to 132,000V</td> </tr> <tr> <td>Transmission</td> <td colspan="3">275,000V and 400,000V</td> </tr> </tbody> </table> <table border="1" style="width: 100%; border-collapse: collapse; font-size: x-small;"> <thead> <tr> <th colspan="5" style="text-align: center;">NORMAL DEPTH TO THE TOP OF THE CABLE WHEN LAID</th> </tr> <tr> <th>Services</th> <th>LV</th> <th>HV</th> <th>EHV</th> <th></th> </tr> </thead> <tbody> <tr> <td>Footpath/Unmade</td> <td>0.45m</td> <td>0.45m</td> <td>0.6m</td> <td>0.8m</td> </tr> <tr> <td>Road Crossing</td> <td>0.6m</td> <td>0.6m</td> <td>0.75m</td> <td>0.9m</td> </tr> <tr> <td>Agricultural</td> <td>1m</td> <td>1m</td> <td>1m</td> <td>1.1m</td> </tr> </tbody> </table>		Voltages (V)				LV (Low Voltage) and Services	Up to 1,000V			HV (High Voltage)	Over 1,000V to 11,000V			EHV (Extra High Voltage)	22,000V to 132,000V			Transmission	275,000V and 400,000V			NORMAL DEPTH TO THE TOP OF THE CABLE WHEN LAID					Services	LV	HV	EHV		Footpath/Unmade	0.45m	0.45m	0.6m	0.8m	Road Crossing	0.6m	0.6m	0.75m	0.9m	Agricultural	1m	1m	1m	1.1m	<table border="1" style="width: 100%; border-collapse: collapse; font-size: x-small;"> <thead> <tr> <th colspan="2" style="text-align: center;">Legend</th> </tr> </thead> <tbody> <tr> <td></td> <td>Service Cable</td> </tr> <tr> <td></td> <td>LV Mains</td> </tr> <tr> <td></td> <td>2 – 11kV</td> </tr> <tr> <td></td> <td>66kV</td> </tr> <tr> <td></td> <td>11kV</td> </tr> <tr> <td></td> <td>22kV</td> </tr> <tr> <td></td> <td>33kV</td> </tr> <tr> <td></td> <td>66kV</td> </tr> <tr> <td></td> <td>132kV</td> </tr> <tr> <td></td> <td>275kV</td> </tr> <tr> <td></td> <td>400kV</td> </tr> <tr> <td></td> <td>Fibre Optic</td> </tr> <tr> <td></td> <td>Pipe Cable</td> </tr> </tbody> </table> <table border="1" style="width: 100%; border-collapse: collapse; font-size: x-small;"> <thead> <tr> <th colspan="2" style="text-align: center;">Distribution Structures (Electric)</th> </tr> </thead> <tbody> <tr> <td></td> <td>Pole, Existing Location</td> </tr> <tr> <td></td> <td>Pole Structure, Existing Location – Single</td> </tr> <tr> <td></td> <td>Pole Structure, Existing Location – H</td> </tr> <tr> <td></td> <td>Duct Route</td> </tr> <tr> <td></td> <td>Cross Section Route</td> </tr> </tbody> </table> <p style="font-size: x-small; text-align: center;"><b>WARNING</b>          There may have been subsequent alteration to the surface levels. Trial holes must be undertaken to determine position and depths of cables. HS (G) 47 Booklet from the Health and Safety Executive – Avoiding Danger from Buried Cables – should be consulted before commencing excavation work.  <b>WHEN WORKING IN THE VICINITY OF OVERHEAD LINES THE HEALTH AND SAFETY GUIDANCE NOTES G66 SHOULD BE CONSULTED (AVAILABLE FROM THE HSE WEBSITE)</b></p>	Legend			Service Cable		LV Mains		2 – 11kV		66kV		11kV		22kV		33kV		66kV		132kV		275kV		400kV		Fibre Optic		Pipe Cable	Distribution Structures (Electric)			Pole, Existing Location		Pole Structure, Existing Location – Single		Pole Structure, Existing Location – H		Duct Route		Cross Section Route
Voltages (V)	
LV (Low Voltage) and Services	Up to 1,000V	
HV (High Voltage)	Over 1,000V to 11,000V	
EHV (Extra High Voltage)	22,000V to 132,000V	
Transmission	275,000V and 400,000V	
NORMAL DEPTH TO THE TOP OF THE CABLE WHEN LAID	
Services	LV	HV	EHV	
Footpath/Unmade	0.45m	0.45m	0.6m	0.8m	
Road Crossing	0.6m	0.6m	0.75m	0.9m	
Agricultural	1m	1m	1m	1.1m	
Legend	
	Service Cable	
	LV Mains	
	2 – 11kV	
	66kV	
	11kV	
	22kV	
	33kV	
	66kV	
	132kV	
	275kV	
	400kV	
	Fibre Optic	
	Pipe Cable	
Distribution Structures (Electric)	
	Pole, Existing Location	
	Pole Structure, Existing Location – Single	
	Pole Structure, Existing Location – H	
	Duct Route	
	Cross Section Route	
<p>BASED UPON THE ORDNANCE SURVEY MAP WITH THE SANCTION OF THE CONTROLLER OF HM STATIONERY OFFICE CROWN COPYRIGHT RESERVED.          This copy has been made by or with the authority of Scottish and Southern Energy Power Distribution Ltd. Pursuant to section 47 of the Copyright, Designs and Patents Act 1988 ("The Act"). Unless the Act provides a relevant exception to copyright the copy must not be copied without prior permission of the copyright owner.          Plans generated by DigSAFE Pro™ software provided by Linesearchbeforedig.</p>	

Warning: PDF designed for A4 colour print only with no page scaling

0  20m Dig Sites Area:  Line: 


**Extra High Voltage  
cables in vicinity**



Date Requested: 24/06/2022  
 Job Reference: 25881037  
 Site Location: 448662 213014  
 Requested by: Mr Joe Shawyer  
 Your Scheme/Reference: 31188\_003

Voltages (V)			
LV (Low Voltage) and Services	Up to 1,000V		
HV (High Voltage)	Over 1,000V to 11,000V		
EHV (Extra High Voltage)	22,000V to 132,000V		
Transmission	275,000V and 400,000V		
NORMAL DEPTH TO THE TOP OF THE CABLE WHEN LAID			
Services	LV	HV	EHV
Footpath/Unmade	0.45m	0.45m	0.6m 0.8m
Road Crossing	0.6m	0.6m	0.75m 0.9m
Agricultural	1m	1m	1m 1.1m

**Legend**

-  Service Cable
-  LV Mains
-  2 - 11kV
-  66kV
-  11kV
-  22kV
-  33kV
-  66kV
-  132kV
-  275kV
-  400kV
-  Fibre Optic
-  Pilot Cable

**Distribution Structures (Electric)**

-  Pole, Existing Location
-  Pole Structure, Existing Location - Single
-  Pole Structure, Existing Location - H
-  Duct Route
-  Cross Section Route

WARNING

There may have been subsequent alteration to the surface levels. Trial holes must be undertaken to determine position and depths of cables. HS (G) 47 Booklet from the Health and Safety Executive - Avoiding Danger from Buried Cables - should be consulted before commencing excavation work.


WHEN WORKING IN THE VICINITY OF OVERHEAD LINES THE HEALTH AND SAFETY GUIDANCE NOTES G56 SHOULD BE CONSULTED (AVAILABLE FROM THE HSE WEBSITE)

**Southern Electric Power Distribution plc**  
 Registered Office: No.1 Forbury Place  
 43 Forbury Road Reading RG1 3JH  
 Registered In England & Wales No.04094290

If you're unsure & need to seek advice before commencing excavations, please contact:  
 General Enquiries: 0800 048 3516

Subject to revision - Master held by SSEN Asset Data Team:  
[Asset.Data@sse.com](mailto:Asset.Data@sse.com)  
 01256 337 294

Scale: 1:500 (When plotted at A4)

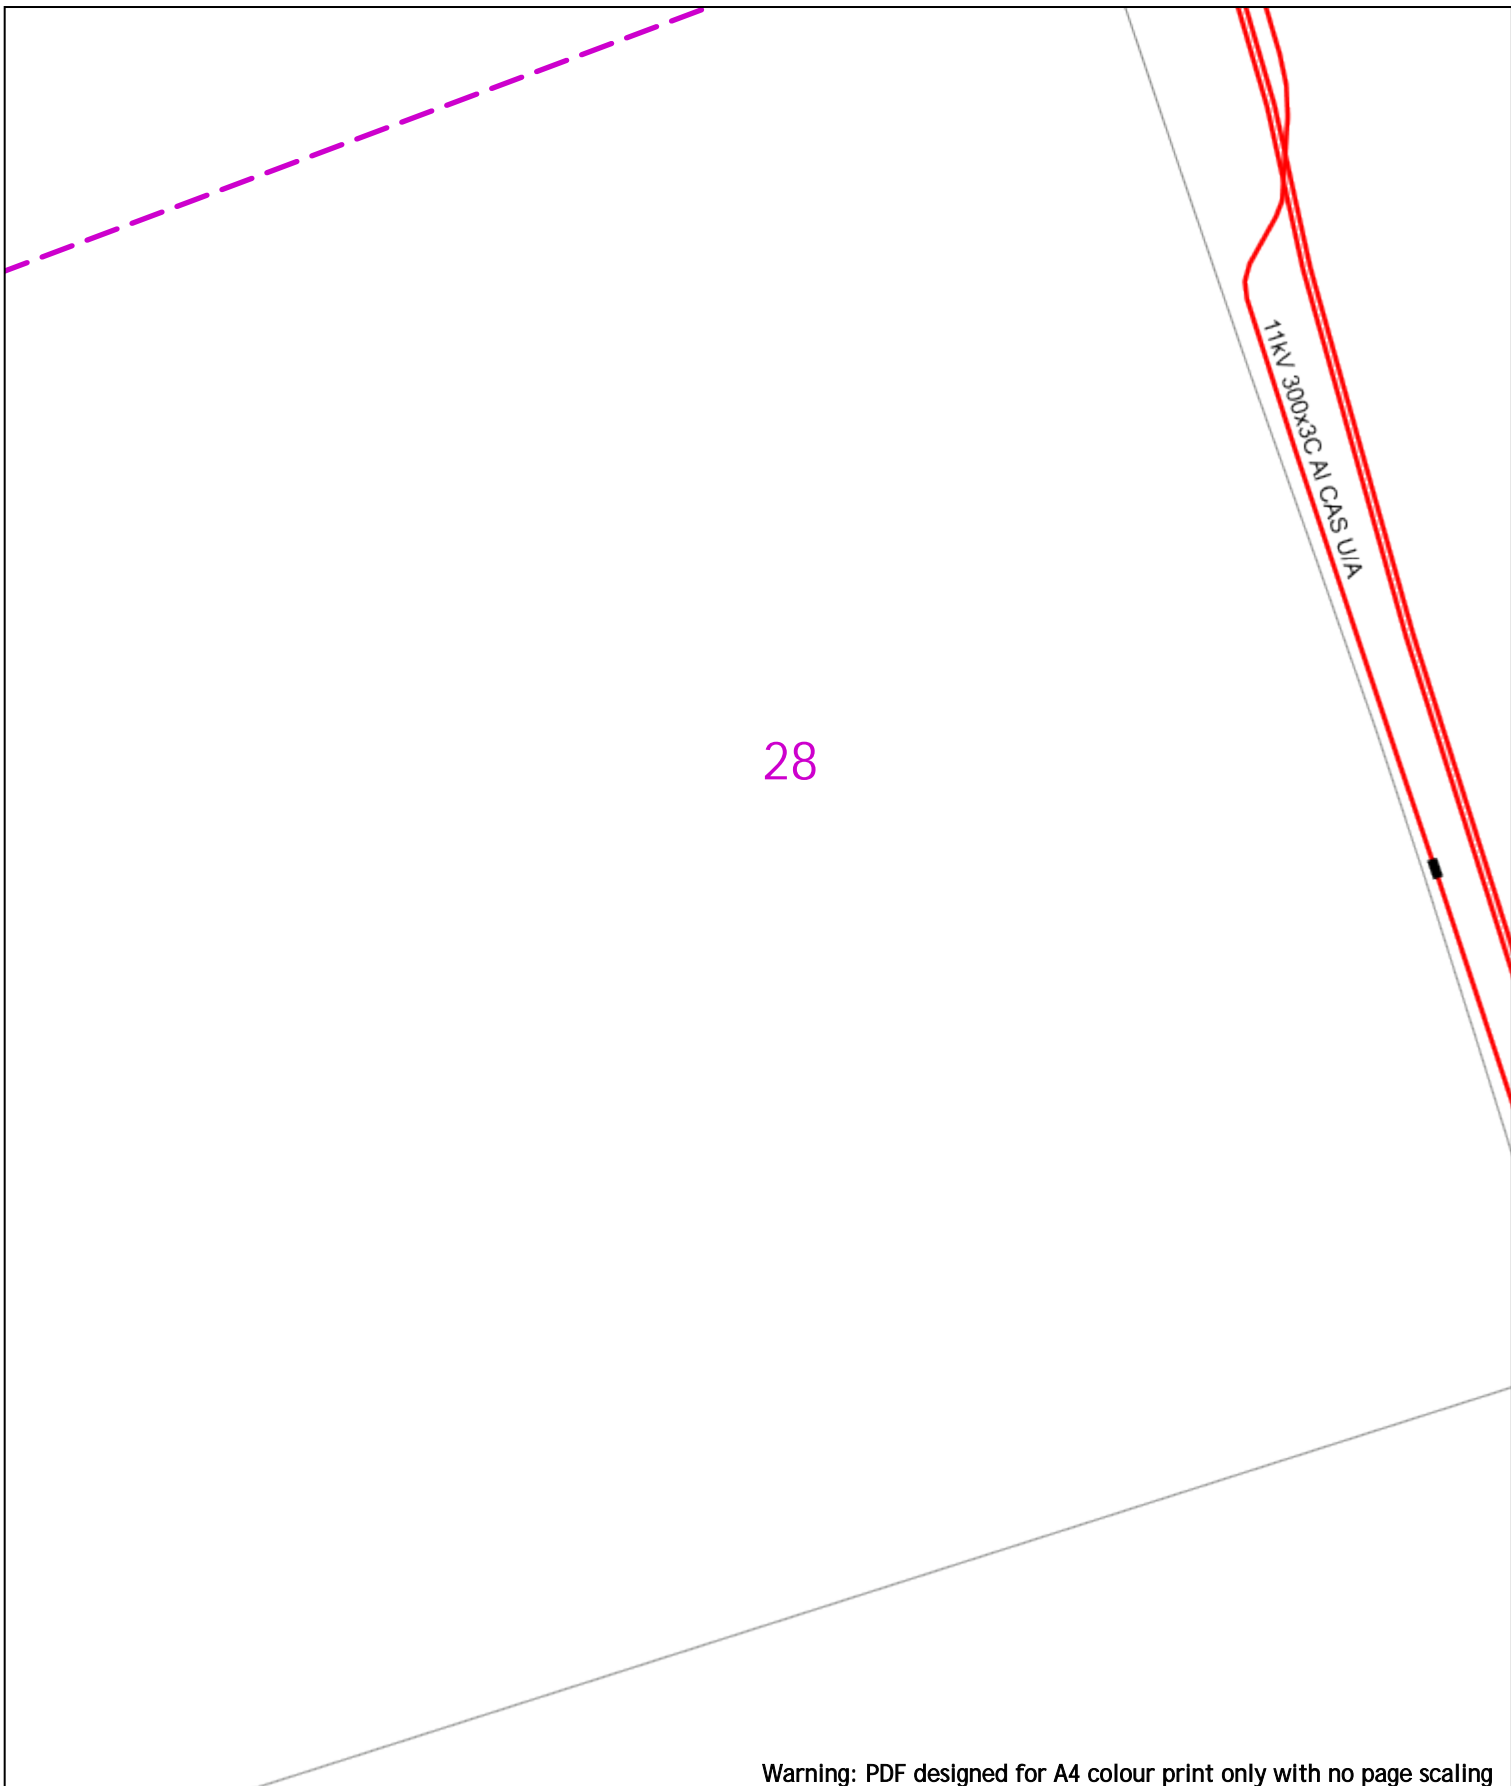

Warning: PDF designed for A4 colour print only with no page scaling



Dig Sites Area: Line:

**Extra High Voltage cables in vicinity**



Date Requested: 24/06/2022  
 Job Reference: 25881037  
 Site Location: 448662 213014  
 Requested by: Mr Joe Shawyer  
 Your Scheme/Reference: 31188\_003

Voltages (V)			
LV (Low Voltage) and Services	Up to 1,000V		
HV (High Voltage)	Over 1,000V to 11,000V		
EHV (Extra High Voltage)	22,000V to 132,000V		
Transmission	275,000V and 400,000V		
NORMAL DEPTH TO THE TOP OF THE CABLE WHEN LAID			
Services	LV	HV	EHV
Footpath/Unmade	0.45m	0.45m	0.6m 0.8m
Road Crossing	0.6m	0.6m	0.75m 0.9m
Agricultural	1m	1m	1m 1.1m

Legend	
	Service Cable
	LV Mains
	2 - 11kV
	66kV
	11kV
	22kV
	33kV
	66kV
	132kV
	275kV
	400kV
	Fibre Optic
	Pipe Cable

Distribution Structures (Electric)	
	Pole, Existing Location
	Pole Structure, Existing Location - Single
	Pole Structure, Existing Location - H
	Duct Route
	Cross Section Route


**Southern Electric Power Distribution plc**  
 Registered Office: No.1 Forbury Place  
 43 Forbury Road Reading RG1 3JH  
 Registered In England & Wales No.04094290

If you're unsure & need to seek advice before commencing excavations, please contact:  
 General Enquiries: 0800 048 3516

Subject to revision – Master held by SSEN Asset Data Team:  
[Asset.Data@sse.com](mailto:Asset.Data@sse.com)  
 01256 337 294

Scale: 1:500 (When plotted at A4)

**WARNING**  
 There may have been subsequent alteration to the surface levels. Trial holes must be undertaken to determine position and depths of cables. HS (G) 47 Booklet from the Health and Safety Executive – Avoiding Danger from Buried Cables – should be consulted before commencing excavation work.  
**WHEN WORKING IN THE VICINITY OF OVERHEAD LINES THE HEALTH AND SAFETY GUIDANCE NOTES G56 SHOULD BE CONSULTED (AVAILABLE FROM THE HSE WEBSITE)**

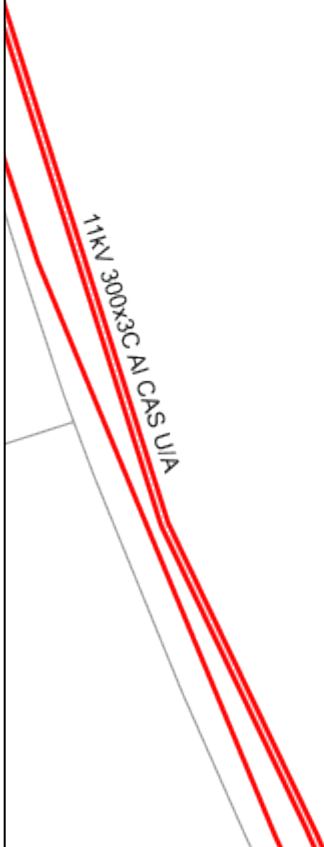

Warning: PDF designed for A4 colour print only with no page scaling



20m Dig Sites Area: [dashed box] Line: [dashed line]

**Extra High Voltage cables in vicinity**



Date Requested: 24/06/2022  
 Job Reference: 25881037  
 Site Location: 448662 213014  
 Requested by: Mr Joe Shawyer  
 Your Scheme/Reference: 31188\_003

Voltages (V)			
LV (Low Voltage) and Services	Up to 1,000V		
HV (High Voltage)	Over 1,000V to 11,000V		
EHV (Extra High Voltage)	22,000V to 132,000V		
Transmission	275,000V and 400,000V		
NORMAL DEPTH TO THE TOP OF THE CABLE WHEN LAID			
Services	LV	HV	EHV
Footpath/Unmade	0.45m	0.45m	0.6m
Road Crossing	0.6m	0.6m	0.75m
Agricultural	1m	1m	1.1m

**Legend**

- Service Cable
- LV Mains
- 2 - 11kV
- 66kV
- 11kV
- 22kV
- 33kV
- 66kV
- 132kV
- 275kV
- 400kV
- Fibre Optic
- Pipe Cable

**Distribution Structures (Electric)**

- Pole, Existing Location
- Pole Structure, Existing Location - Single
- Pole Structure, Existing Location - M
- Duct Route
- Cross Section Route

**WARNING**  
 There may have been subsequent alteration to the surface levels. Trial holes must be undertaken to determine position and depths of cables. HS (G) 47 Booklet from the Health and Safety Executive - Avoiding Danger from Buried Cables - should be consulted before commencing excavation work.  
**WHEN WORKING IN THE VICINITY OF OVERHEAD LINES THE HEALTH AND SAFETY GUIDANCE NOTES G56 SHOULD BE CONSULTED (AVAILABLE FROM THE HSE WEBSITE)**

**Southern Electric Power Distribution plc**  
 Registered Office: No.1 Forbury Place  
 43 Forbury Road Reading RG1 3JH  
 Registered In England & Wales No.04094290

If you're unsure & need to seek advice before commencing excavations, please contact:  
 General Enquiries: 0800 048 3516

Subject to revision - Master held by SSEN Asset Data Team:  
[Asset.Data@sse.com](mailto:Asset.Data@sse.com)  
 01256 337 294

Scale: 1:500 (When plotted at A4)

Warning: PDF designed for A4 colour print only with no page scaling

0  20m Dig Sites Area:  Line: 

**Extra High Voltage  
cables in vicinity**



Date Requested: 24/06/2022  
 Job Reference: 25881037  
 Site Location: 448662 213014  
 Requested by: Mr Joe Shawyer  
 Your Scheme/Reference: 31188\_003

Voltages (V)			
LV (Low Voltage) and Services	Up to 1,000V		
HV (High Voltage)	Over 1,000V to 11,000V		
EHV (Extra High Voltage)	22,000V to 132,000V		
Transmission	275,000V and 400,000V		
NORMAL DEPTH TO THE TOP OF THE CABLE WHEN LAID			
Services	LV	HV	EHV
Footpath/Unmade	0.45m	0.45m	0.6m 0.8m
Road Crossing	0.6m	0.6m	0.75m 0.9m
Agricultural	1m	1m	1m 1.1m

Legend	
	Service Cable
	LV Mains
	2 - 11kV
	66kV
	11kV
	22kV
	33kV
	66kV
	132kV
	275kV
	400kV
	Fibre Optic
	Pipe Cable

Distribution Structures (Electric)	
	Pole, Existing Location
	Pole Structure, Existing Location - Single
	Pole Structure, Existing Location - H
	Duct Route
	Cross Section Route

**Southern Electric Power Distribution plc**  
 Registered Office: No.1 Forbury Place  
 43 Forbury Road Reading RG1 3JH  
 Registered In England & Wales No.04094290

If you're unsure & need to seek advice before commencing excavations, please contact:  
 General Enquiries: 0800 048 3516

Subject to revision – Master held by SSEN Asset Data Team:  
[Asset.Data@sse.com](mailto:Asset.Data@sse.com)  
 01256 337 294

Scale: 1:500 (When plotted at A4)

**WARNING**  
 There may have been subsequent alteration to the surface levels. Trial holes must be undertaken to determine position and depths of cables. HS (G) 47 Booklet from the Health and Safety Executive – Avoiding Danger from Buried Cables – should be consulted before commencing excavation work.  
**WHEN WORKING IN THE VICINITY OF OVERHEAD LINES THE HEALTH AND SAFETY GUIDANCE NOTES G56 SHOULD BE CONSULTED (AVAILABLE FROM THE HSE WEBSITE)**

SANDY LANE  
CROSSING

31

Warning: PDF designed for A4 colour print only with no page scaling

0 20m

Dig Sites

Area:



Line:



**Extra High Voltage  
cables in vicinity**



Date Requested: 24/06/2022  
Job Reference: 25881037  
Site Location: 448662 213014  
Requested by: Mr Joe Shawyer

Your Scheme/Reference: 31188\_003

Voltages (V)				
LV (Low Voltage) and Services	Up to 1,000V			
HV (High Voltage)	Over 1,000V to 11,000V			
EHV (Extra High Voltage)	22,000V to 132,000V			
Transmission	275,000V and 400,000V			
NORMAL DEPTH TO THE TOP OF THE CABLE WHEN LAID				
Services	LV	HV	EHV	
Footpath/Unmade	0.45m	0.45m	0.6m	0.8m
Road Crossing	0.6m	0.6m	0.75m	0.9m
Agricultural	1m	1m	1m	1.1m

Legend	
	Service Cable
	LV Mains
	2 - 11kV
	66kV
	11kV
	22kV
	33kV
	66kV
	132kV
	275kV
	400kV
	Fibre Optic
	Pipe Cable

Distribution Structures (Electric)	
	Pole, Existing Location
	Pole Structure, Existing Location - Single
	Pole Structure, Existing Location - H
	Duct Route
	Cross Section Route

**WARNING**

There may have been subsequent alteration to the surface levels. Trial holes must be undertaken to determine position and depths of cables. HS (G) 47 Booklet from the Health and Safety Executive - Avoiding Danger from Buried Cables - should be consulted before commencing excavation work.  
WHEN WORKING IN THE VICINITY OF OVERHEAD LINES THE HEALTH AND SAFETY GUIDANCE NOTES G56 SHOULD BE CONSULTED (AVAILABLE FROM THE HSE WEBSITE)

Scale: 1:500 (When plotted at A4)

**Southern Electric Power Distribution plc**  
Registered Office: No.1 Forbury Place  
43 Forbury Road Reading RG1 3JH  
Registered In England & Wales No.04094290

If you're unsure & need to seek advice before commencing excavations, please contact:  
General Enquiries: 0800 048 3516

Subject to revision - Master held by SSEN Asset Data Team:  
[Asset.Data@sse.com](mailto:Asset.Data@sse.com)  
01256 337 294

Warning: PDF designed for A4 colour print only with no page scaling

0 20m Dig Sites Area: Line:

**Extra High Voltage  
cables in vicinity**



Date Requested: 24/06/2022  
 Job Reference: 25881037  
 Site Location: 448662 213014  
 Requested by: Mr Joe Shawyer  
 Your Scheme/Reference: 31188\_003

Voltages (V)			
LV (Low Voltage) and Services	Up to 1,000V		
HV (High Voltage)	Over 1,000V to 11,000V		
EHV (Extra High Voltage)	22,000V to 132,000V		
Transmission	275,000V and 400,000V		
NORMAL DEPTH TO THE TOP OF THE CABLE WHEN LAID			
Services	LV	HV	EHV
Footpath/Unmade	0.45m	0.45m	0.6m 0.8m
Road Crossing	0.6m	0.6m	0.75m 0.9m
Agricultural	1m	1m	1m 1.1m

<p><b>Legend</b></p> <ul style="list-style-type: none"> <li> Service Cable</li> <li> LV Mains</li> <li> 2 - 11kV</li> <li> 66kV</li> <li> 11kV</li> <li> 22kV</li> <li> 33kV</li> <li> 66kV</li> <li> 132kV</li> <li> 275kV</li> <li> 400kV</li> <li> Fibre Optic</li> <li> Pipit Cable</li> </ul>	<p><b>Distribution Structures (Electric)</b></p> <ul style="list-style-type: none"> <li> Pole, Existing Location</li> <li> Pole Structure, Existing Location - Single</li> <li> Pole Structure, Existing Location - H</li> <li> Duct Route</li> <li> Cross Section Route</li> </ul>
--	---

**WARNING**

There may have been subsequent alteration to the surface levels. Trial holes must be undertaken to determine position and depths of cables. HS (G) 47 Booklet from the Health and Safety Executive - Avoiding Danger from Buried Cables - should be consulted before commencing excavation work.


**WHEN WORKING IN THE VICINITY OF OVERHEAD LINES THE HEALTH AND SAFETY GUIDANCE NOTES G56 SHOULD BE CONSULTED (AVAILABLE FROM THE HSE WEBSITE)**

**Southern Electric Power Distribution plc**  
 Registered Office: No.1 Forbury Place  
 43 Forbury Road Reading RG1 3JH  
 Registered In England & Wales No.04094290

If you're unsure & need to seek advice before commencing excavations, please contact:  
 General Enquiries: 0800 048 3516

Subject to revision - Master held by SSEN Asset Data Team:  
[Asset.Data@sse.com](mailto:Asset.Data@sse.com)  
 01256 337 294

Scale: 1:500 (When plotted at A4)

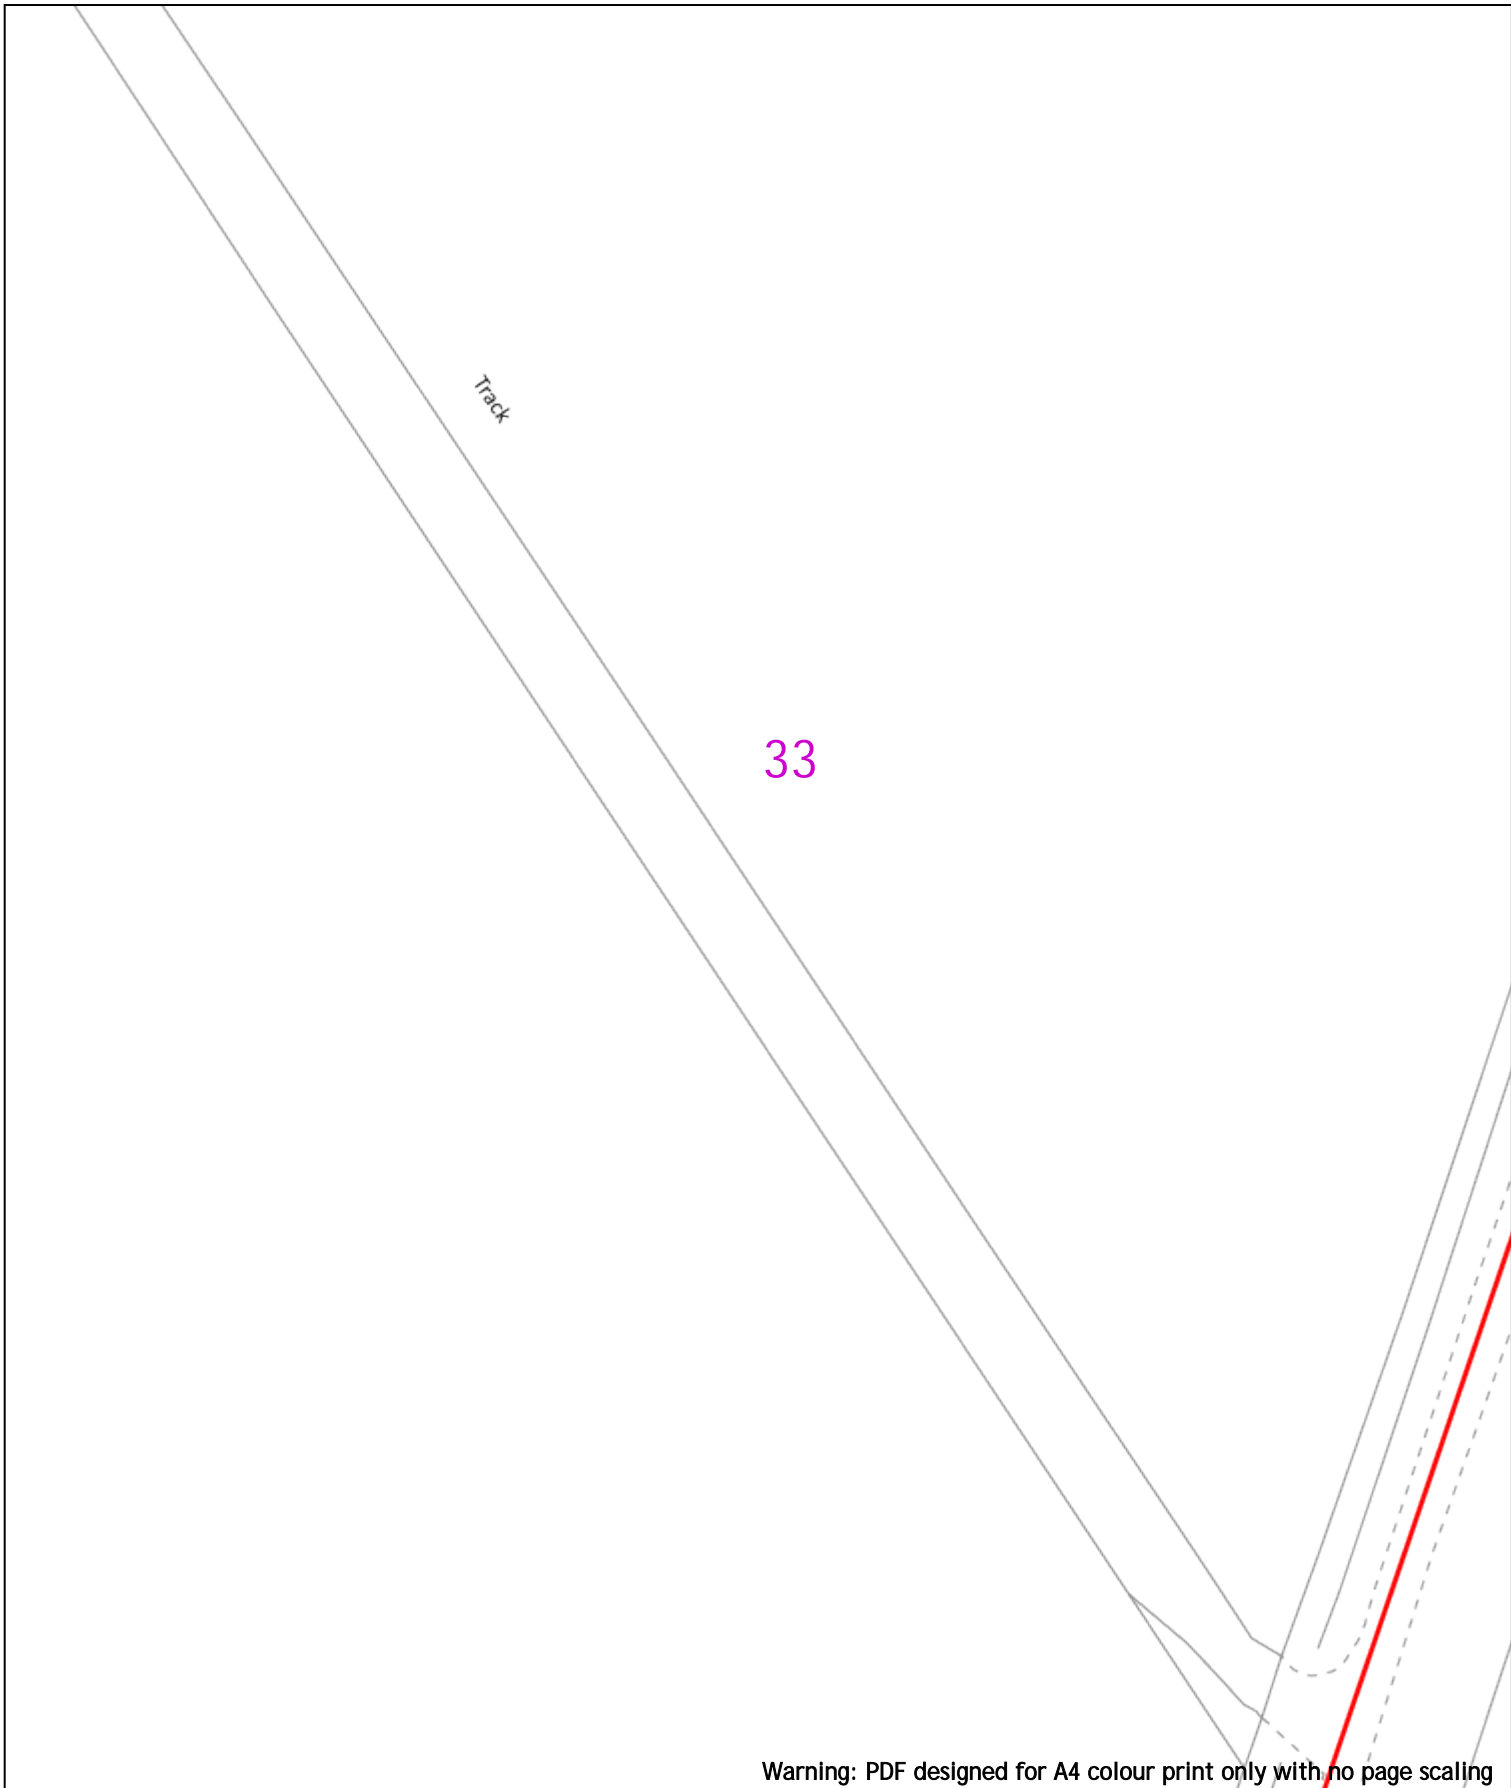


Warning: PDF designed for A4 colour print only with no page scaling

<p>0  20m</p> <p>Date Requested: 24/06/2022          Job Reference: 25881037          Site Location: 448662 213014          Requested by: Mr Joe Shawyer          Your Scheme/Reference: 31188_003</p>	<p>Dig Sites Area:  Line: </p> <p style="text-align: center; background-color: red; color: white; padding: 2px;"><b>Extra High Voltage cables in vicinity</b></p>	<p> </p> <p style="text-align: center;"><b>Southern Electric Power Distribution plc</b>          Registered Office: No.1 Forbury Place          43 Forbury Road Reading RG1 3JH          Registered In England &amp; Wales No.04094290</p> <p style="font-size: small;">If you're unsure &amp; need to seek advice before commencing excavations, please contact:          General Enquiries: 0800 048 3516</p> <p style="font-size: small;">Subject to revision – Master held by SSEN Asset Data Team:  <a href="mailto:Asset.Data@sse.com">Asset.Data@sse.com</a>          01256 337 294</p>	
<p>Scale: 1:500 (When plotted at A4)</p>	<table border="1" style="width: 100%; border-collapse: collapse; font-size: x-small;"> <thead> <tr> <th colspan="4">Voltages (V)</th> </tr> </thead> <tbody> <tr> <td>LV (Low Voltage) and Services</td> <td colspan="3">Up to 1,000V</td> </tr> <tr> <td>HV (High Voltage)</td> <td colspan="3">Over 1,000V to 11,000V</td> </tr> <tr> <td>EHV (Extra High Voltage)</td> <td colspan="3">22,000V to 132,000V</td> </tr> <tr> <td>Transmission</td> <td colspan="3">275,000V and 400,000V</td> </tr> <tr> <th colspan="4">NORMAL DEPTH TO THE TOP OF THE CABLE WHEN LAID</th> </tr> <tr> <td>Services</td> <td>LV</td> <td>HV</td> <td>EHV</td> </tr> <tr> <td>Footpath/Unmade</td> <td>0.45m</td> <td>0.45m</td> <td>0.6m 0.8m</td> </tr> <tr> <td>Road Crossing</td> <td>0.6m</td> <td>0.6m</td> <td>0.75m 0.9m</td> </tr> <tr> <td>Agricultural</td> <td>1m</td> <td>1m</td> <td>1m 1.1m</td> </tr> </tbody> </table> <p style="font-size: x-small; text-align: center;"><b>WARNING</b>          There may have been subsequent alteration to the surface levels. Trial holes must be undertaken to determine position and depths of cables. HS (G) 47 Booklet from the Health and Safety Executive – Avoiding Danger from Buried Cables – should be consulted before commencing excavation work.  <b>WHEN WORKING IN THE VICINITY OF OVERHEAD LINES THE HEALTH AND SAFETY GUIDANCE NOTES G56 SHOULD BE CONSULTED (AVAILABLE FROM THE HSE WEBSITE)</b></p>	Voltages (V)				LV (Low Voltage) and Services	Up to 1,000V			HV (High Voltage)	Over 1,000V to 11,000V			EHV (Extra High Voltage)	22,000V to 132,000V			Transmission	275,000V and 400,000V			NORMAL DEPTH TO THE TOP OF THE CABLE WHEN LAID				Services	LV	HV	EHV	Footpath/Unmade	0.45m	0.45m	0.6m 0.8m	Road Crossing	0.6m	0.6m	0.75m 0.9m	Agricultural	1m	1m	1m 1.1m	<table border="1" style="width: 100%; border-collapse: collapse; font-size: x-small;"> <thead> <tr> <th colspan="2">Legend</th> <th colspan="2">Distribution Structures (Electric)</th> </tr> </thead> <tbody> <tr> <td></td> <td>Service Cable</td> <td></td> <td>Pole, Existing Location</td> </tr> <tr> <td></td> <td>LV Mains</td> <td></td> <td>Pole Structure, Existing Location - Single</td> </tr> <tr> <td></td> <td>2 - 11kV</td> <td></td> <td>Pole Structure, Existing Location - H</td> </tr> <tr> <td></td> <td>66kV</td> <td></td> <td>Duct Route</td> </tr> <tr> <td></td> <td>11kV</td> <td></td> <td>Cross Section Route</td> </tr> <tr> <td></td> <td>22kV</td> <td></td> <td></td> </tr> <tr> <td></td> <td>33kV</td> <td></td> <td></td> </tr> <tr> <td></td> <td>66kV</td> <td></td> <td></td> </tr> <tr> <td></td> <td>132kV</td> <td></td> <td></td> </tr> <tr> <td></td> <td>275kV</td> <td></td> <td></td> </tr> <tr> <td></td> <td>400kV</td> <td></td> <td></td> </tr> <tr> <td></td> <td>Fibre Optic</td> <td></td> <td></td> </tr> <tr> <td></td> <td>Pipe Cable</td> <td></td> <td></td> </tr> </tbody> </table>	Legend		Distribution Structures (Electric)			Service Cable		Pole, Existing Location		LV Mains		Pole Structure, Existing Location - Single		2 - 11kV		Pole Structure, Existing Location - H		66kV		Duct Route		11kV		Cross Section Route		22kV				33kV				66kV				132kV				275kV				400kV				Fibre Optic				Pipe Cable		
Voltages (V)	
LV (Low Voltage) and Services	Up to 1,000V	
HV (High Voltage)	Over 1,000V to 11,000V	
EHV (Extra High Voltage)	22,000V to 132,000V	
Transmission	275,000V and 400,000V	
NORMAL DEPTH TO THE TOP OF THE CABLE WHEN LAID	
Services	LV	HV	EHV	
Footpath/Unmade	0.45m	0.45m	0.6m 0.8m	
Road Crossing	0.6m	0.6m	0.75m 0.9m	
Agricultural	1m	1m	1m 1.1m	
Legend		Distribution Structures (Electric)	
	Service Cable		Pole, Existing Location	
	LV Mains		Pole Structure, Existing Location - Single	
	2 - 11kV		Pole Structure, Existing Location - H	
	66kV		Duct Route	
	11kV		Cross Section Route	
	22kV	
	33kV	
	66kV	
	132kV	
	275kV	
	400kV	
	Fibre Optic	
	Pipe Cable	

BASED UPON THE ORDNANCE SURVEY MAP WITH THE SANCTION OF THE CONTROLLER OF HM STATIONERY OFFICE CROWN COPYRIGHT RESERVED.  
 This copy has been made by or with the authority of Scottish and Southern Energy Power Distribution Ltd. Pursuant to section 47 of the Copyright, Designs and Patents Act 1988 ("The Act"). Unless the Act provides a relevant exception to copyright the copy must not be copied without prior permission of the copyright owner.  
 Plans generated by DigSAFE Pro™ software provided by LinesearchbeforeDig.



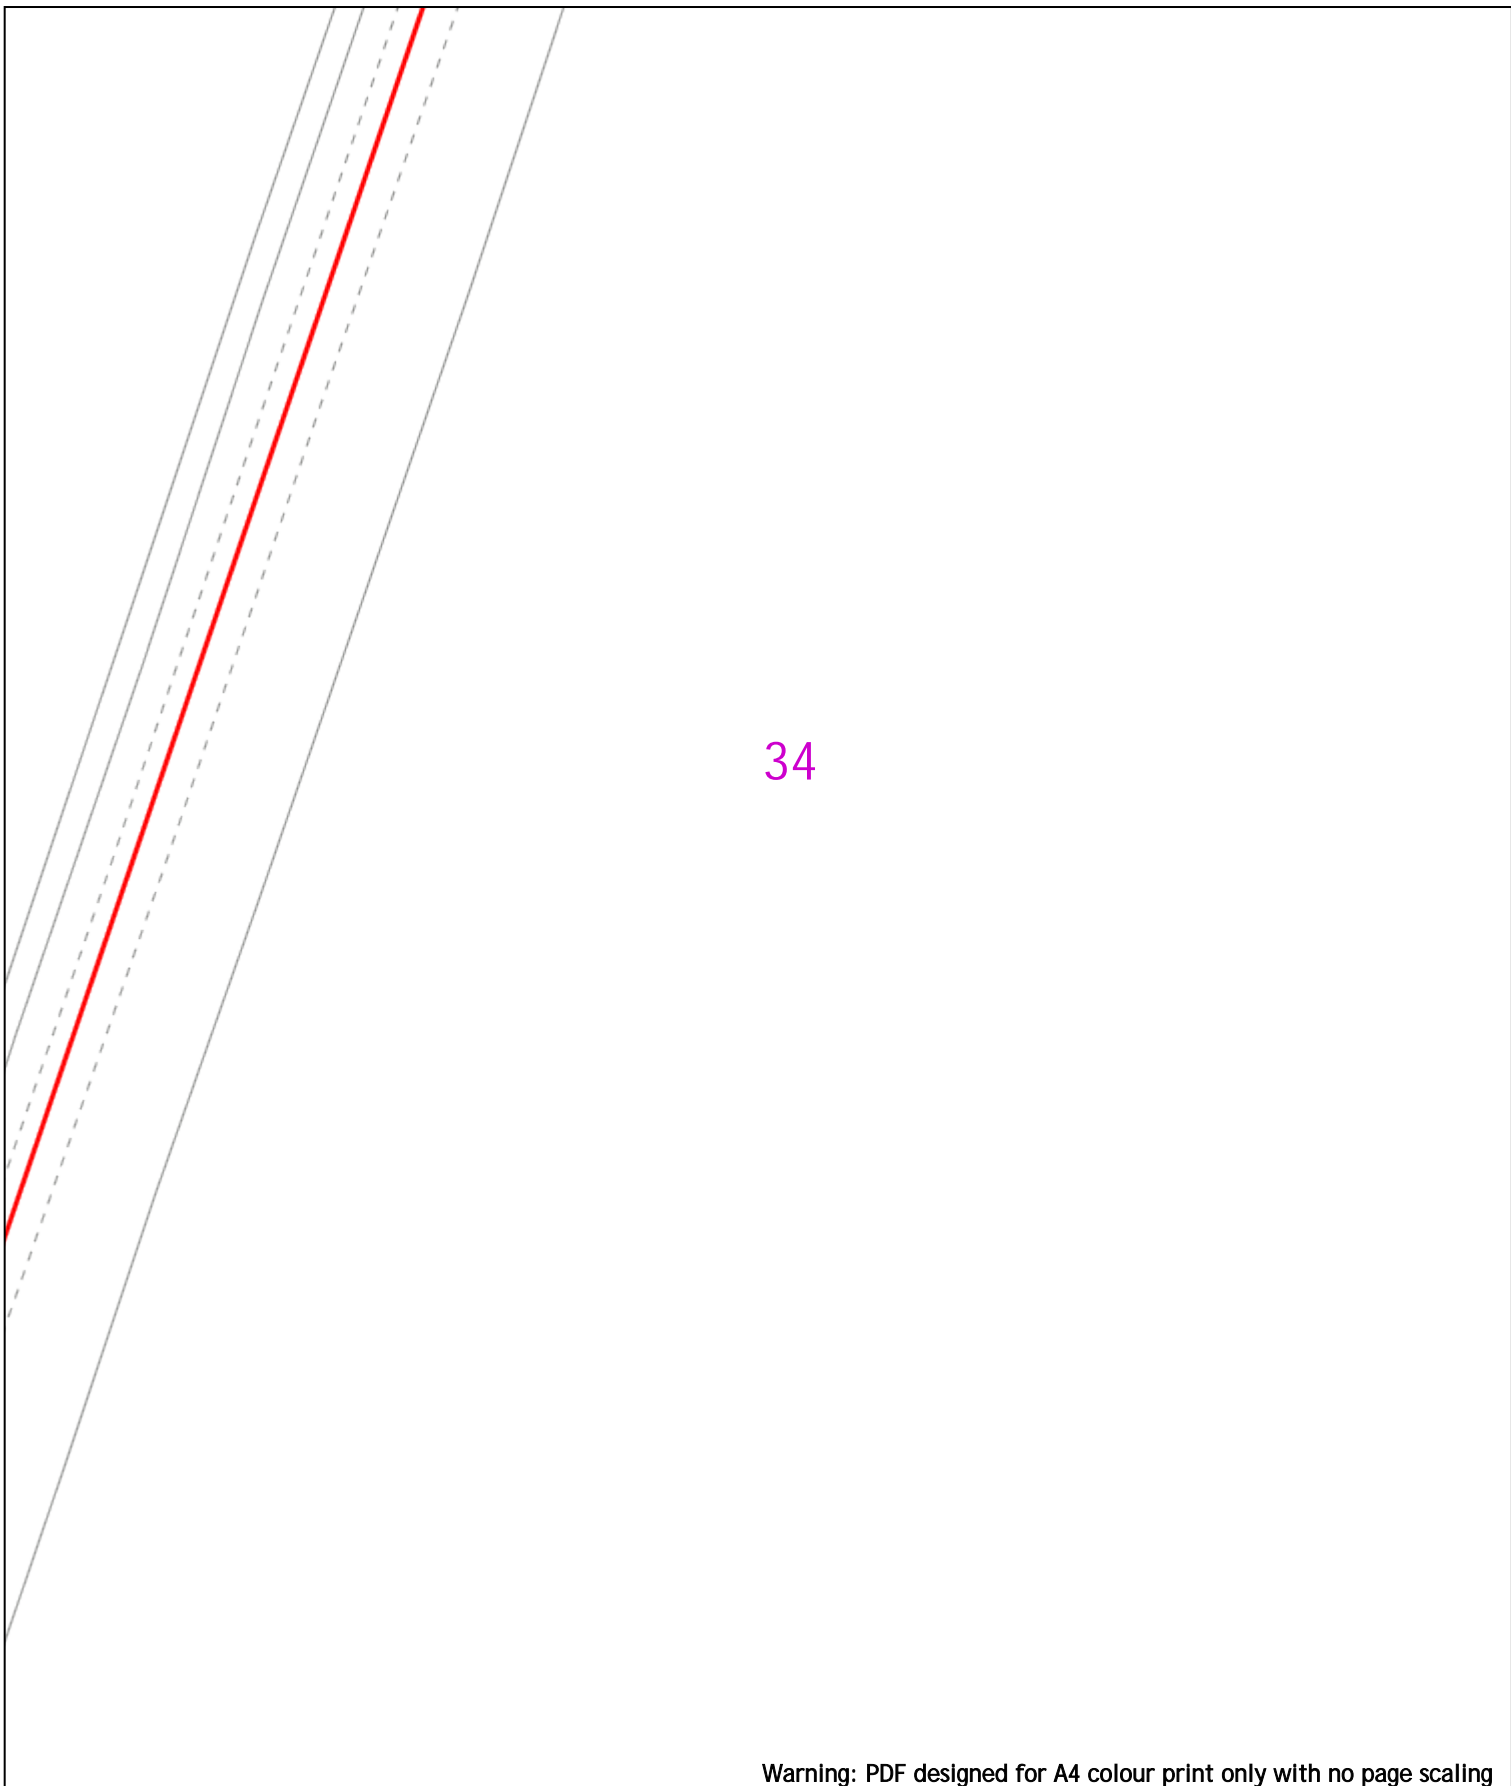

34

Warning: PDF designed for A4 colour print only with no page scaling



20m Dig Sites Area: Line:

**Extra High Voltage cables in vicinity**



Date Requested: 24/06/2022  
 Job Reference: 25881037  
 Site Location: 448662 213014  
 Requested by: Mr Joe Shawyer  
 Your Scheme/Reference: 31188\_003

Voltages (V)			
LV (Low Voltage) and Services	Up to 1,000V		
HV (High Voltage)	Over 1,000V to 11,000V		
EHV (Extra High Voltage)	22,000V to 132,000V		
Transmission	275,000V and 400,000V		
NORMAL DEPTH TO THE TOP OF THE CABLE WHEN LAID			
Services	LV	HV	EHV
Footpath/Unmade	0.45m	0.45m	0.6m 0.8m
Road Crossing	0.6m	0.6m	0.75m 0.9m
Agricultural	1m	1m	1m 1.1m

Legend	
	Service Cable
	LV Mains
	2 - 11kV
	66kV
	11kV
	22kV
	33kV
	66kV
	132kV
	275kV
	400kV
	Fibre Optic
	Pilot Cable

Distribution Structures (Electric)	
	Pole, Existing Location
	Pole Structure, Existing Location - Single
	Pole Structure, Existing Location - H
	Duct Route
	Cross Section Route

**Southern Electric Power Distribution plc**  
 Registered Office: No.1 Forbury Place  
 43 Forbury Road Reading RG1 3JH  
 Registered In England & Wales No.04094290

If you're unsure & need to seek advice before commencing excavations, please contact:  
 General Enquiries: 0800 048 3516

Subject to revision – Master held by SSEN Asset Data Team:  
[Asset.Data@sse.com](mailto:Asset.Data@sse.com)  
 01256 337 294

Scale: 1:500 (When plotted at A4)

**WARNING**  
 There may have been subsequent alteration to the surface levels. Trial holes must be undertaken to determine position and depths of cables. HS (G) 47 Booklet from the Health and Safety Executive – Avoiding Danger from Buried Cables – should be consulted before commencing excavation work.  
**WHEN WORKING IN THE VICINITY OF OVERHEAD LINES THE HEALTH AND SAFETY GUIDANCE NOTES G56 SHOULD BE CONSULTED (AVAILABLE FROM THE HSE WEBSITE)**

Warning: PDF designed for A4 colour print only with no page scaling

0  20m Dig Sites Area:  Line: 

**Extra High Voltage  
cables in vicinity**



Date Requested: 24/06/2022  
 Job Reference: 25881037  
 Site Location: 448662 213014  
 Requested by: Mr Joe Shawyer  
 Your Scheme/Reference: 31188\_003

Voltages (V)			
LV (Low Voltage) and Services	Up to 1,000V		
HV (High Voltage)	Over 1,000V to 11,000V		
EHV (Extra High Voltage)	22,000V to 132,000V		
Transmission	275,000V and 400,000V		
NORMAL DEPTH TO THE TOP OF THE CABLE WHEN LAID			
Services	LV	HV	EHV
Footpath/Unmade	0.45m	0.45m	0.6m 0.8m
Road Crossing	0.6m	0.6m	0.75m 0.9m
Agricultural	1m	1m	1m 1.1m

Legend	Distribution Structures (Electric)
Service Cable	Pole, Existing Location
LV Mains	Pole Structure, Existing Location - Single
2 - 11kV	Pole Structure, Existing Location - H
66kV	Duct Route
11kV	Cross Section Route
22kV	
33kV	
66kV	
132kV	
275kV	
400kV	
Fibre Optic	
Pipit Cable	

**WARNING**  
 There may have been subsequent alteration to the surface levels. Trial holes must be undertaken to determine position and depths of cables. HS (G) 47 Booklet from the Health and Safety Executive - Avoiding Danger from Buried Cables - should be consulted before commencing excavation work.  
**WHEN WORKING IN THE VICINITY OF OVERHEAD LINES THE HEALTH AND SAFETY GUIDANCE NOTES G56 SHOULD BE CONSULTED (AVAILABLE FROM THE HSE WEBSITE)**


**Southern Electric Power Distribution plc**  
 Registered Office: No.1 Forbury Place  
 43 Forbury Road Reading RG1 3JH  
 Registered In England & Wales No.04094290

If you're unsure & need to seek advice before commencing excavations, please contact:  
 General Enquiries: 0800 048 3516

Subject to revision - Master held by SSEN Asset Data Team:  
[Asset.Data@sse.com](mailto:Asset.Data@sse.com)  
 01256 337 294

Scale: 1:500 (When plotted at A4)

36

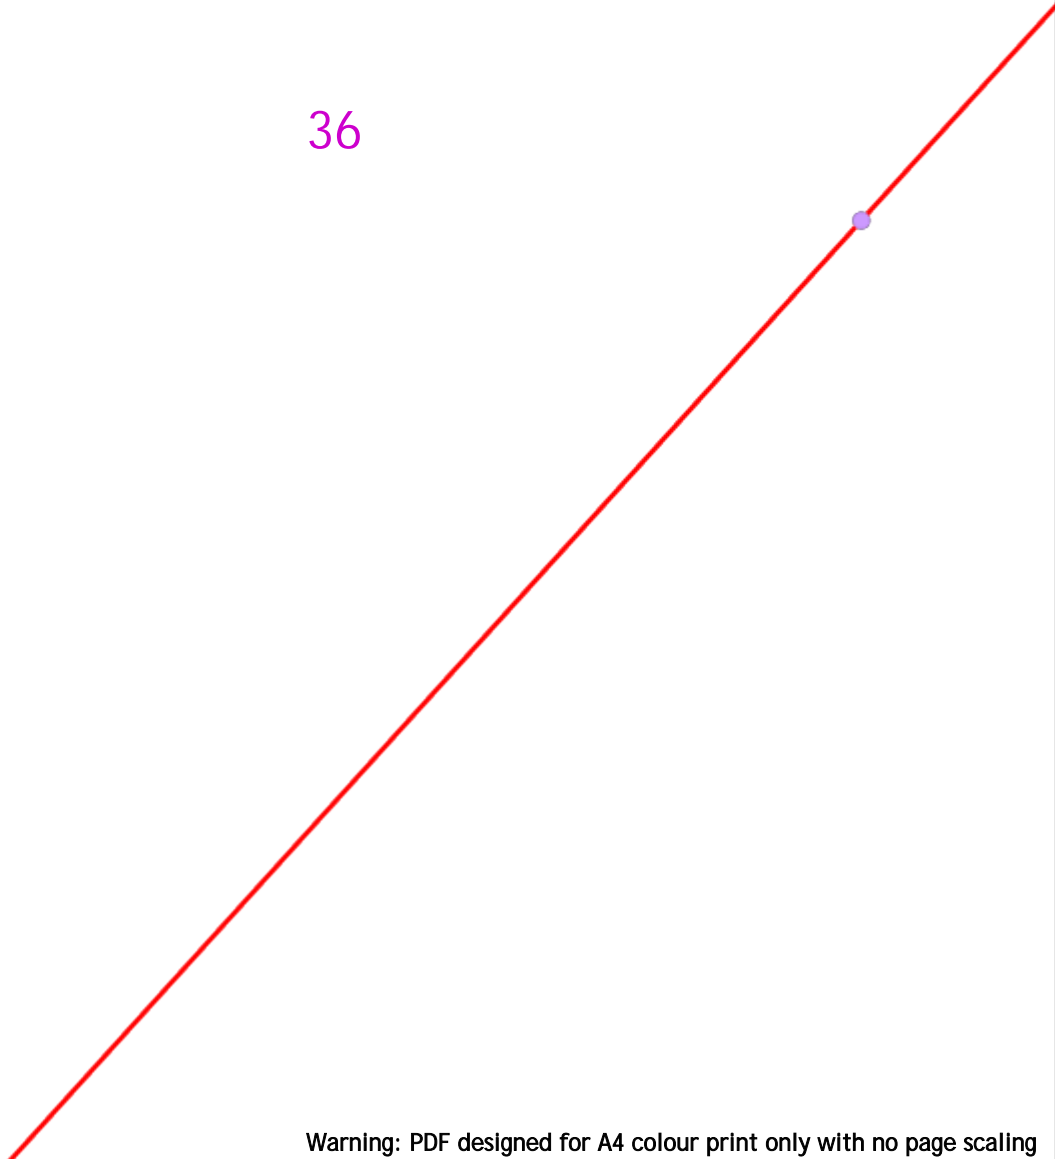

Warning: PDF designed for A4 colour print only with no page scaling

0 20m Dig Sites Area: Line:

**Extra High Voltage  
cables in vicinity**



Date Requested: 24/06/2022  
 Job Reference: 25881037  
 Site Location: 448662 213014  
 Requested by: Mr Joe Shawyer  
 Your Scheme/Reference: 31188\_003

Voltages (V)			
LV (Low Voltage) and Services	Up to 1,000V		
HV (High Voltage)	Over 1,000V to 11,000V		
EHV (Extra High Voltage)	22,000V to 132,000V		
Transmission	275,000V and 400,000V		
NORMAL DEPTH TO THE TOP OF THE CABLE WHEN LAID			
Services	LV	HV	EHV
Footpath/Unmade	0.45m	0.45m	0.6m
Road Crossing	0.6m	0.6m	0.75m
Agricultural	1m	1m	1.1m

Legend	
	Service Cable
	LV Mains
	2 - 11kV
	66kV
	275kV
	400kV
	Fibre Optic
	Pipe Cable

Distribution Structures (Electric)	
	Pole, Existing Location
	Pole Structure, Existing Location - Single
	Pole Structure, Existing Location - H
	Duct Route
	Cross Section Route


**Southern Electric Power Distribution plc**  
 Registered Office: No.1 Forbury Place  
 43 Forbury Road Reading RG1 3JH  
 Registered In England & Wales No.04094290

If you're unsure & need to seek advice before commencing excavations, please contact:  
 General Enquiries: 0800 048 3516

Subject to revision – Master held by SSEN Asset Data Team:  
[Asset.Data@sse.com](mailto:Asset.Data@sse.com)  
 01256 337 294

Scale: 1:500 (When plotted at A4)

**WARNING**  
 There may have been subsequent alteration to the surface levels. Trial holes must be undertaken to determine position and depths of cables. HS (G) 47 Booklet from the Health and Safety Executive – Avoiding Danger from Buried Cables – should be consulted before commencing excavation work.  
**WHEN WORKING IN THE VICINITY OF OVERHEAD LINES THE HEALTH AND SAFETY GUIDANCE NOTES G56 SHOULD BE CONSULTED (AVAILABLE FROM THE HSE WEBSITE)**

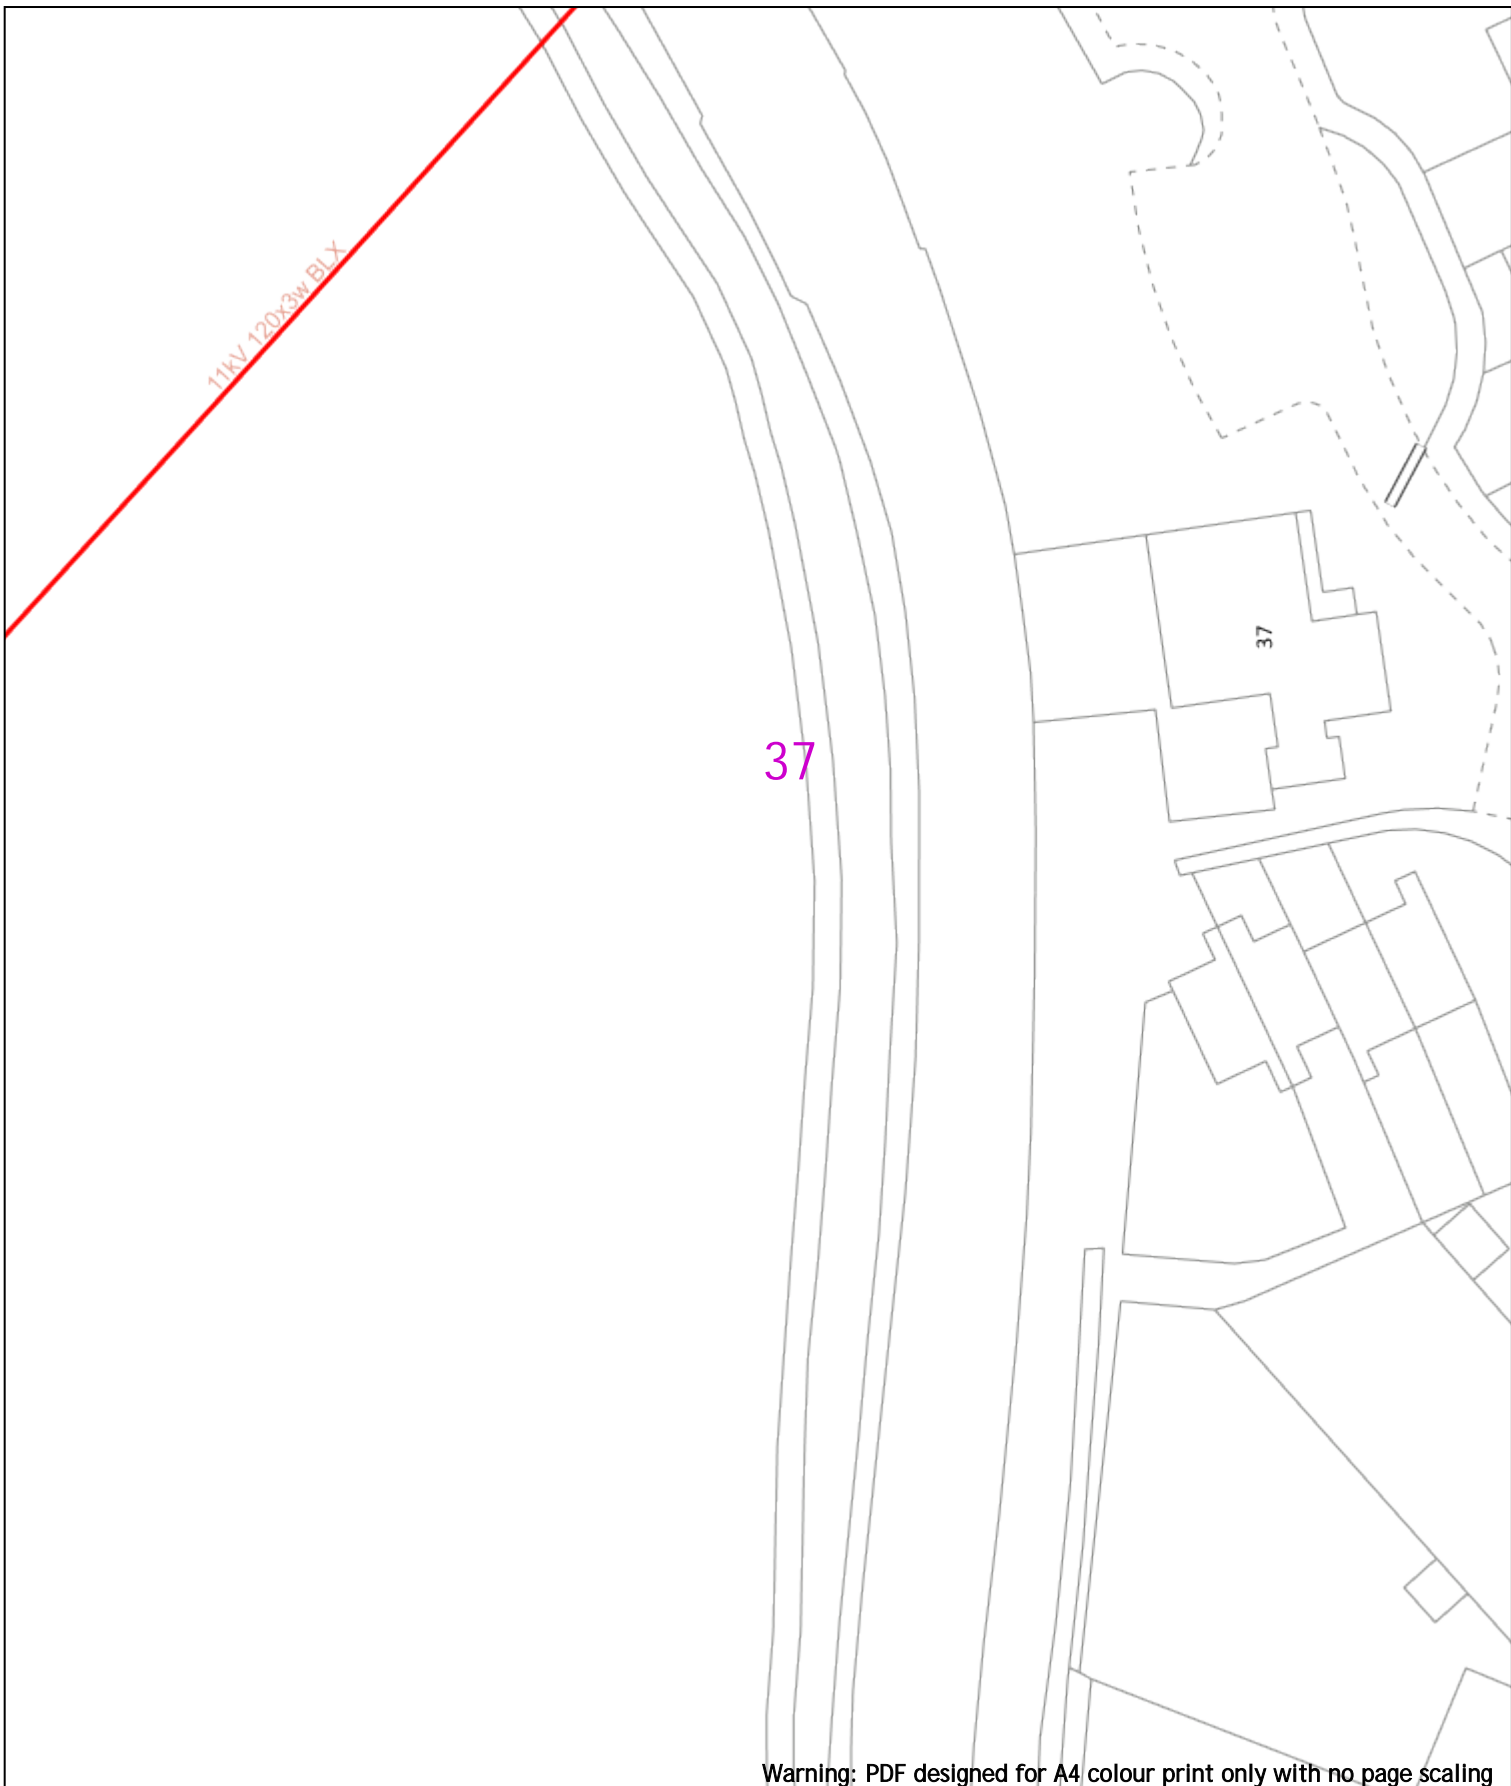

Warning: PDF designed for A4 colour print only with no page scaling



20m Dig Sites Area: Line:

**Extra High Voltage cables in vicinity**



Date Requested: 24/06/2022  
 Job Reference: 25881037  
 Site Location: 448662 213014  
 Requested by: Mr Joe Shawyer  
 Your Scheme/Reference: 31188\_003

Voltages (V)			
LV (Low Voltage) and Services	Up to 1,000V		
HV (High Voltage)	Over 1,000V to 11,000V		
EHV (Extra High Voltage)	22,000V to 132,000V		
Transmission	275,000V and 400,000V		
NORMAL DEPTH TO THE TOP OF THE CABLE WHEN LAID			
Services	LV	HV	EHV
Footpath/Unmade	0.45m	0.45m	0.6m
Road Crossing	0.6m	0.6m	0.75m
Agricultural	1m	1m	1.1m

Legend	
	Service Cable
	LV Mains
	2 - 11kV
	66kV
	11kV
	22kV
	33kV
	66kV
	132kV
	275kV
	400kV
	Fibre Optic
	Pipe Cable

Distribution Structures (Electric)	
	Pole, Existing Location
	Pole Structure, Existing Location - Single
	Pole Structure, Existing Location - H
	Duct Route
	Cross Section Route


**Southern Electric Power Distribution plc**  
 Registered Office: No.1 Forbury Place  
 43 Forbury Road Reading RG1 3JH  
 Registered In England & Wales No.04094290

If you're unsure & need to seek advice before commencing excavations, please contact:  
 General Enquiries: 0800 048 3516

Subject to revision – Master held by SSEN Asset Data Team:  
[Asset.Data@sse.com](mailto:Asset.Data@sse.com)  
 01256 337 294

Scale: 1:500 (When plotted at A4)

**WARNING**  
 There may have been subsequent alteration to the surface levels. Trial holes must be undertaken to determine position and depths of cables. HS (G) 47 Booklet from the Health and Safety Executive – Avoiding Danger from Buried Cables – should be consulted before commencing excavation work.  
**WHEN WORKING IN THE VICINITY OF OVERHEAD LINES THE HEALTH AND SAFETY GUIDANCE NOTES G56 SHOULD BE CONSULTED (AVAILABLE FROM THE HSE WEBSITE)**

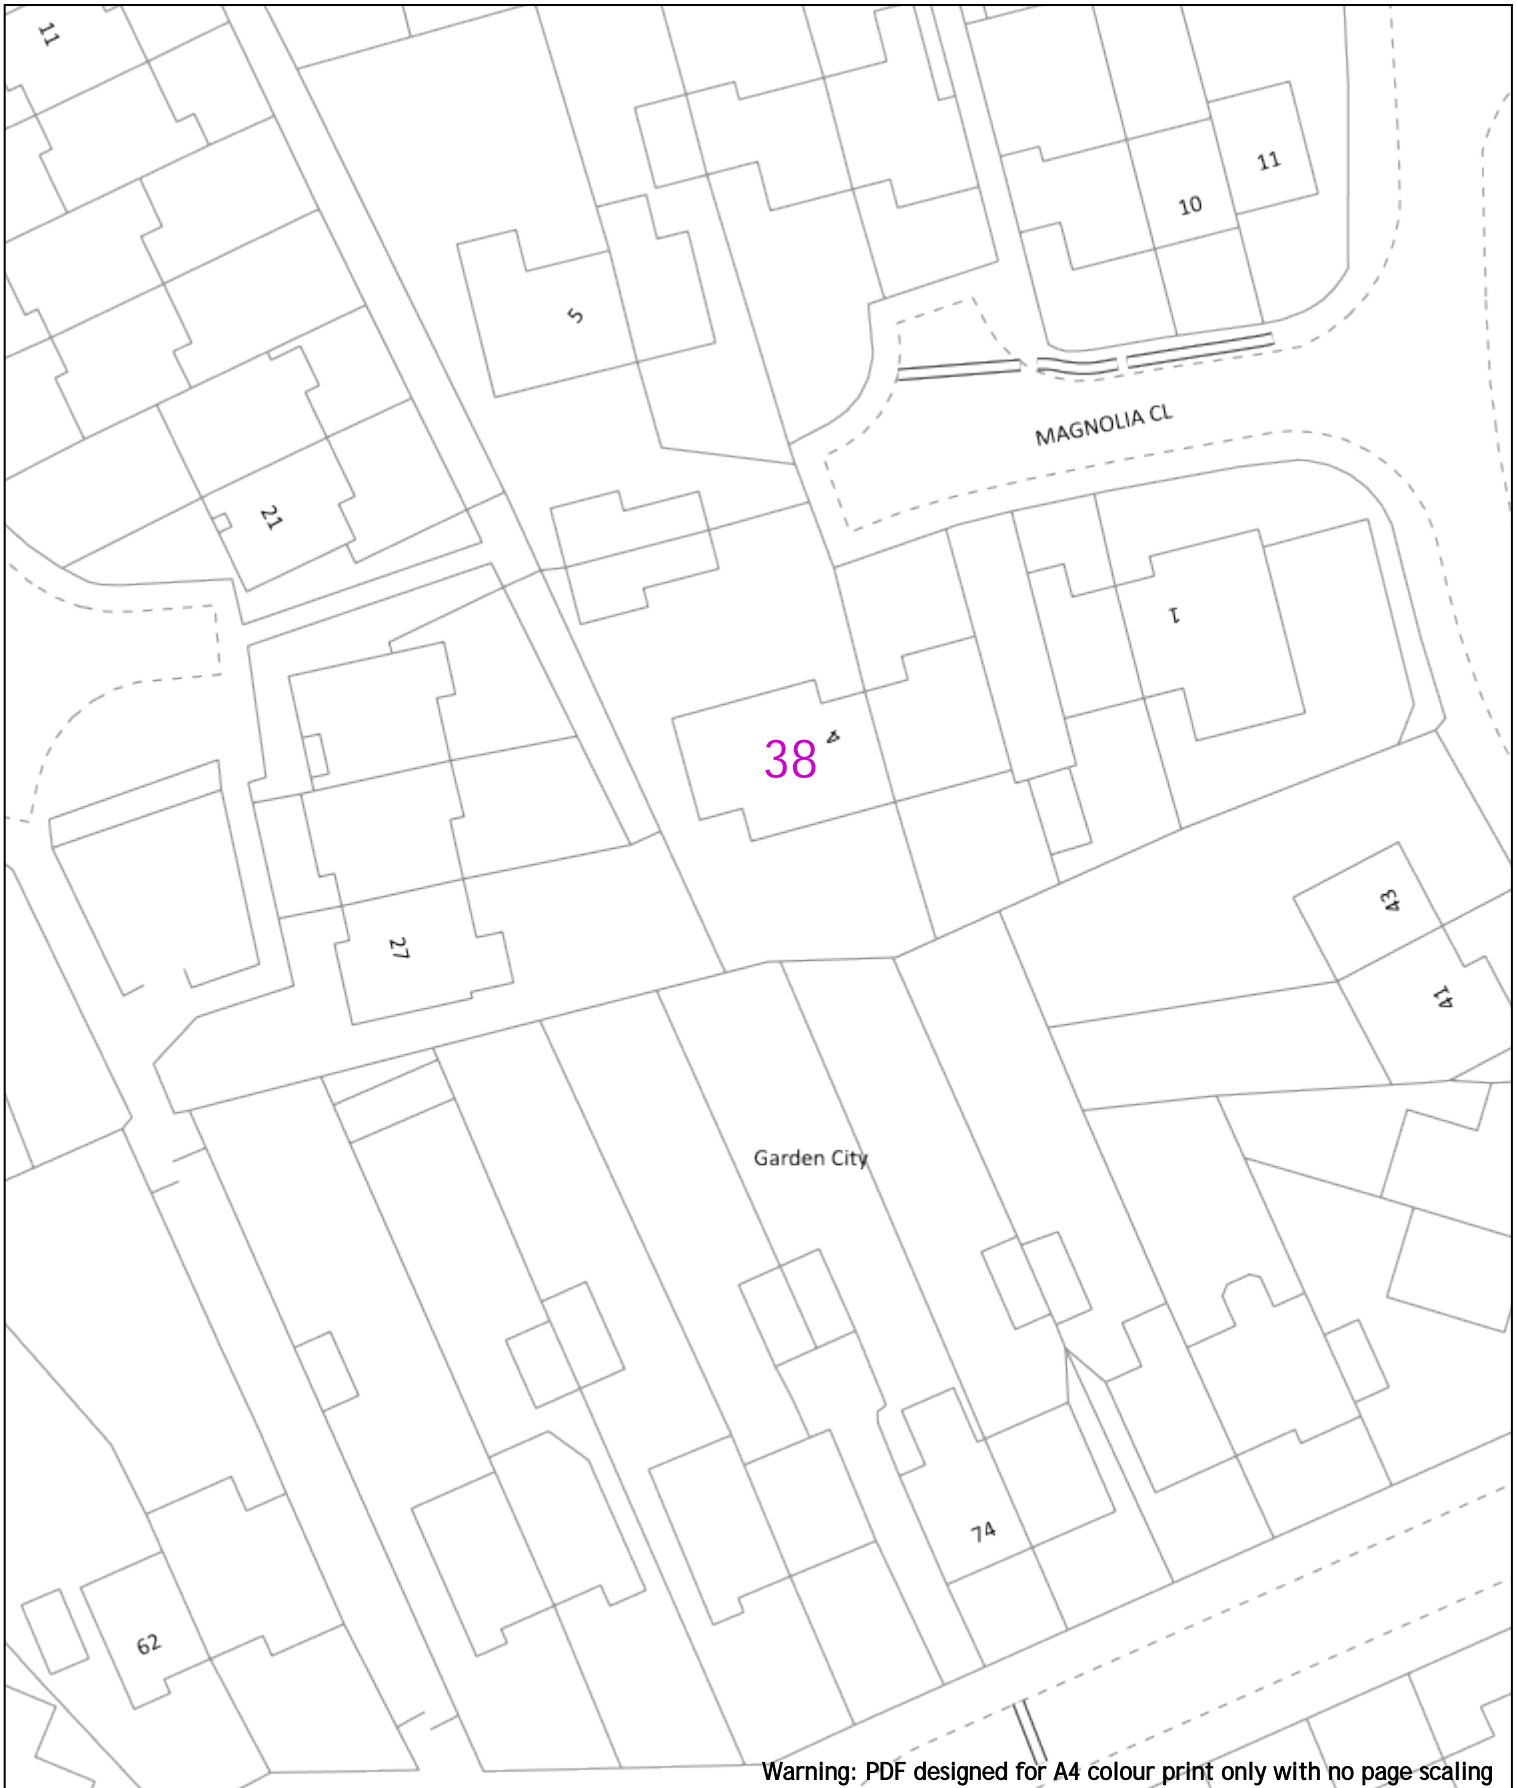

Warning: PDF designed for A4 colour print only with no page scaling

0 20m

Dig Sites Area: Line:

**Extra High Voltage  
cables in vicinity**

Date Requested: 24/06/2022  
 Job Reference: 25881037  
 Site Location: 448662 213014  
 Requested by: Mr Joe Shawyer  
 Your Scheme/Reference: 31188\_003

Voltages (V)			
LV (Low Voltage) and Services	Up to 1,000V		
HV (High Voltage)	Over 1,000V to 11,000V		
EHV (Extra High Voltage)	22,000V to 132,000V		
Transmission	275,000V and 400,000V		
NORMAL DEPTH TO THE TOP OF THE CABLE WHEN LAID			
Services	LV	HV	EHV
Footpath/Unmade	0.45m	0.45m	0.6m
Road Crossing	0.6m	0.6m	0.75m
Agricultural	1m	1m	1.1m

<p><b>Legend</b></p> <ul style="list-style-type: none"> <li> Service Cable</li> <li> LV Mains</li> <li> 2 - 3.3kV</li> <li> 6.6kV</li> <li> 11kV</li> <li> 22kV</li> <li> 33kV</li> <li> 66kV</li> <li> 132kV</li> <li> 275kV</li> <li> 400kV</li> <li> Fibre Optic</li> <li> Pilot Cable</li> </ul>	<p><b>Distribution Structures (Electric)</b></p> <ul style="list-style-type: none"> <li> Pole, Existing Location</li> <li> Pole Structure, Existing Location - Single</li> <li> Pole Structure, Existing Location - H</li> <li> Duct Route</li> <li> Cross Section Route</li> </ul>
--	---

**WARNING**

There may have been subsequent alteration to the surface levels. Trial holes must be undertaken to determine position and depths of cables. HS (G) 47 Booklet from the Health and Safety Executive - Avoiding Danger from Buried Cables - should be consulted before commencing excavation work.

**WHEN WORKING IN THE VICINITY OF OVERHEAD LINES THE HEALTH AND SAFETY GUIDANCE NOTES G56 SHOULD BE CONSULTED (AVAILABLE FROM THE HSE WEBSITE)**

BASED UPON THE ORDNANCE SURVEY MAP WITH THE SANCTION OF THE CONTROLLER OF HM STATIONERY OFFICE CROWN COPYRIGHT RESERVED.


This copy has been made by or with the authority of Scottish and Southern Energy Power Distribution Ltd. Pursuant to section 47 of the Copyright, Designs and Patents Act 1988 ("The Act"). Unless the Act provides a relevant exception to copyright the copy must not be copied without prior permission of the copyright owner.

Plans generated by DigSAFE Pro™ software provided by LinesearchbeforeUdig.

**Southern Electric Power Distribution plc**  
 Registered Office: No.1 Forbury Place  
 43 Forbury Road Reading RG1 3JH  
 Registered In England & Wales No.04094290

If you're unsure & need to seek advice before commencing excavations, please contact:  
 General Enquiries: 0800 048 3516

Subject to revision – Master held by SSEN Asset Data Team:  
[Asset.Data@sse.com](mailto:Asset.Data@sse.com)  
 01256 337 294

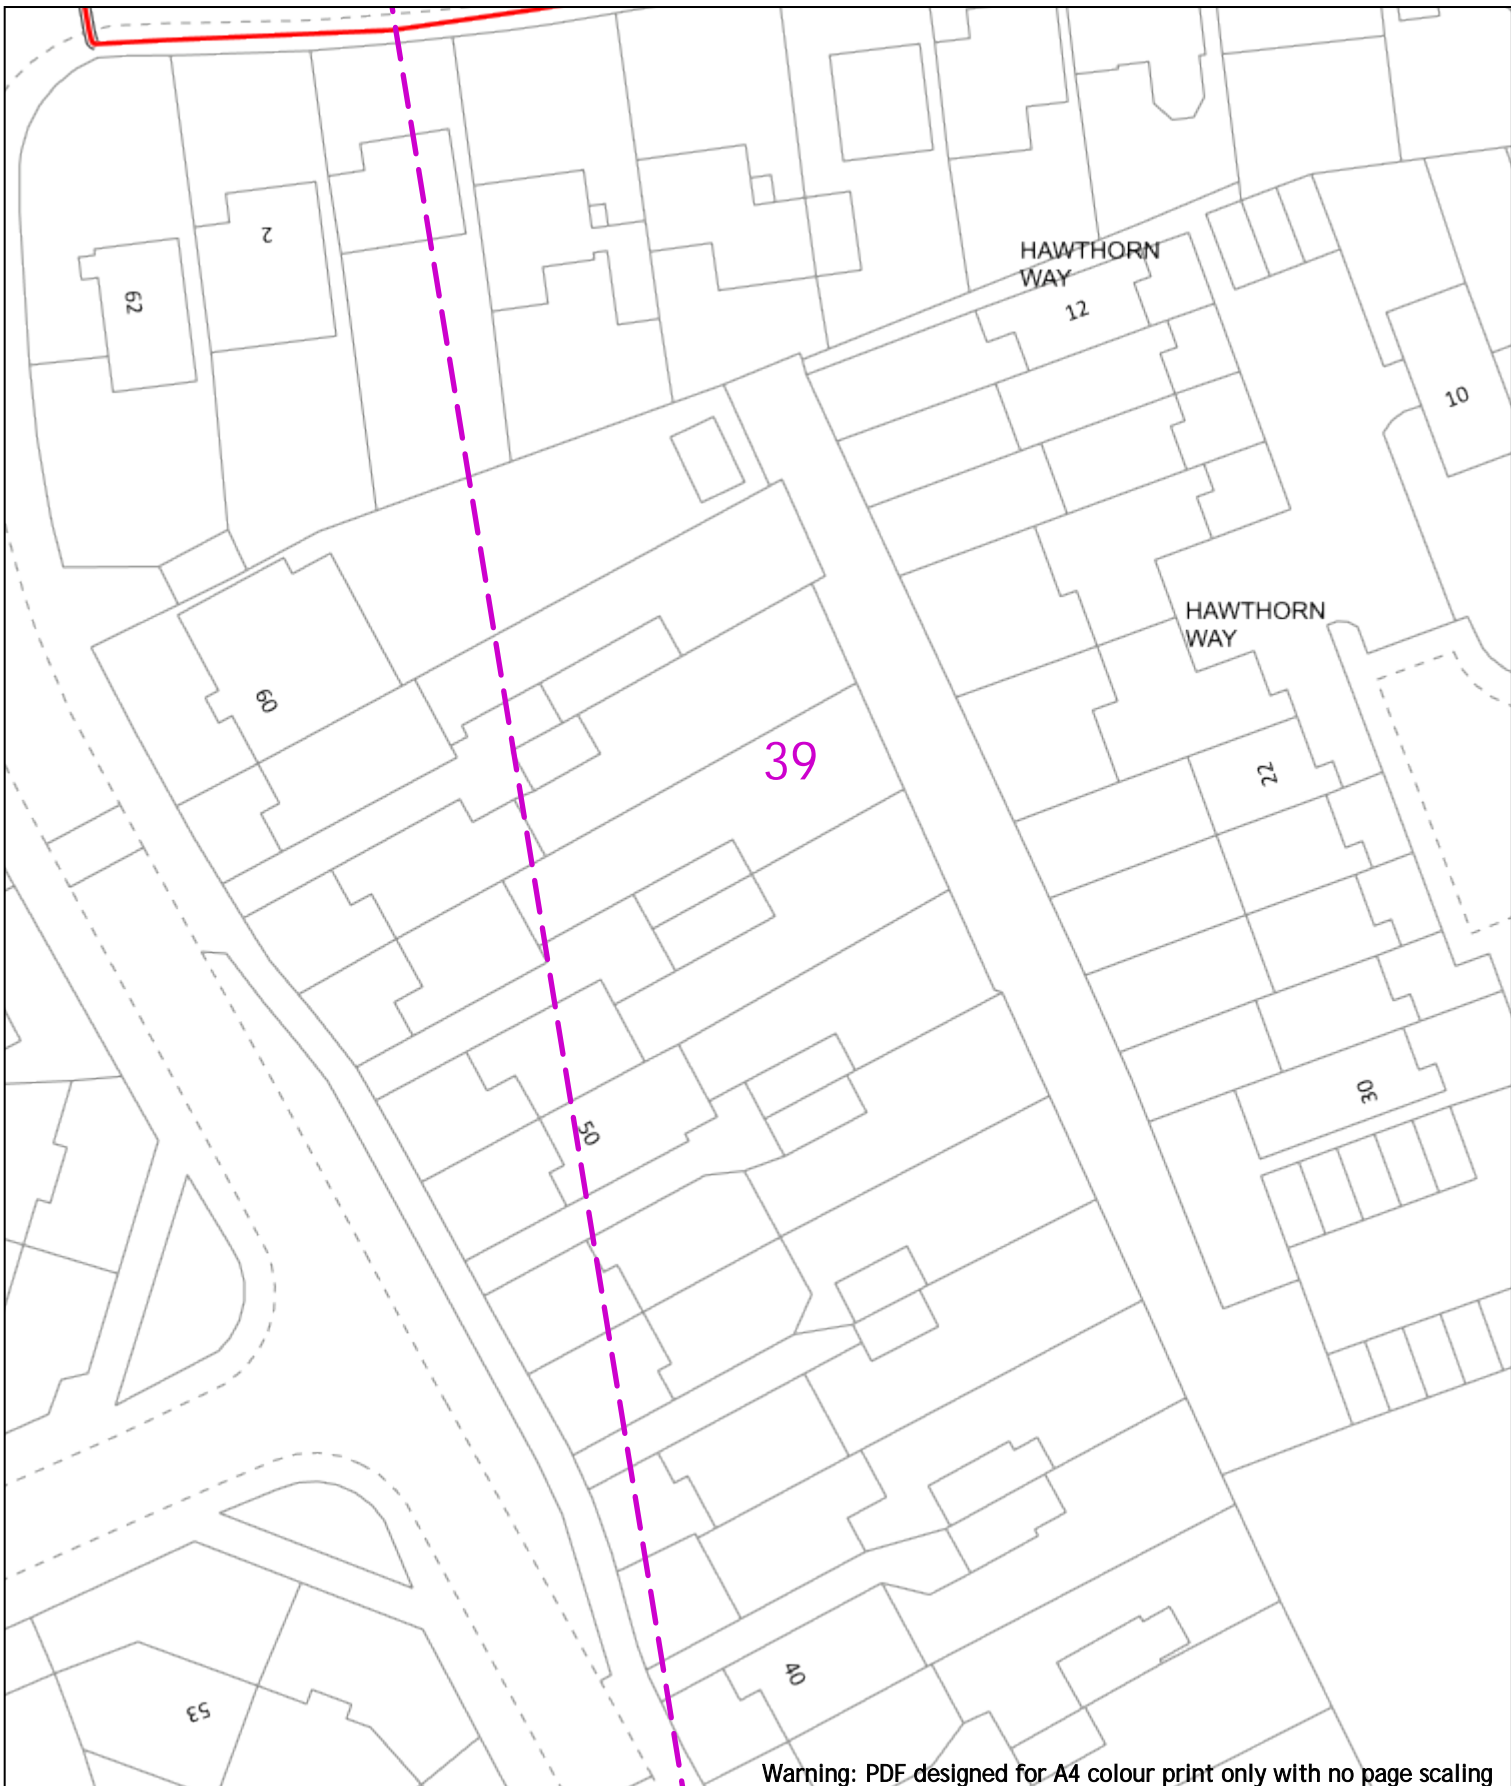

Warning: PDF designed for A4 colour print only with no page scaling



20m Dig Sites Area: Line:

**Extra High Voltage cables in vicinity**



Date Requested: 24/06/2022  
 Job Reference: 25881037  
 Site Location: 448662 213014  
 Requested by: Mr Joe Shawyer  
 Your Scheme/Reference: 31188\_003

Voltages (V)			
LV (Low Voltage) and Services	Up to 1,000V		
HV (High Voltage)	Over 1,000V to 11,000V		
EHV (Extra High Voltage)	22,000V to 132,000V		
Transmission	275,000V and 400,000V		
NORMAL DEPTH TO THE TOP OF THE CABLE WHEN LAID			
Services	LV	HV	EHV
Footpath/Unmade	0.45m	0.45m	0.6m
Road Crossing	0.6m	0.6m	0.75m
Agricultural	1m	1m	1.1m

Legend	
	Service Cable
	LV Mains
	2 - 3.3kV
	6.6kV
	11kV
	22kV
	33kV
	66kV
	132kV
	275kV
	400kV
	Fibre Optic
	Pilot Cable

Distribution Structures (Electric)	
	Pole, Existing Location
	Pole Structure, Existing Location - Single
	Pole Structure, Existing Location - H
	Duct Route
	Cross Section Route


**Southern Electric Power Distribution plc**  
 Registered Office: No.1 Forbury Place  
 43 Forbury Road Reading RG1 3JH  
 Registered In England & Wales No.04094290

If you're unsure & need to seek advice before commencing excavations, please contact:  
 General Enquiries: 0800 048 3516

Scale: 1:500 (When plotted at A4)

**WARNING**  
 There may have been subsequent alteration to the surface levels. Trial holes must be undertaken to determine position and depths of cables. HS (G) 47 Booklet from the Health and Safety Executive - Avoiding Danger from Buried Cables - should be consulted before commencing excavation work.  
**WHEN WORKING IN THE VICINITY OF OVERHEAD LINES THE HEALTH AND SAFETY GUIDANCE NOTES G56 SHOULD BE CONSULTED (AVAILABLE FROM THE HSE WEBSITE)**

Subject to revision - Master held by SSEN Asset Data Team:  
[Asset.Data@sse.com](mailto:Asset.Data@sse.com)  
 01256 337 294

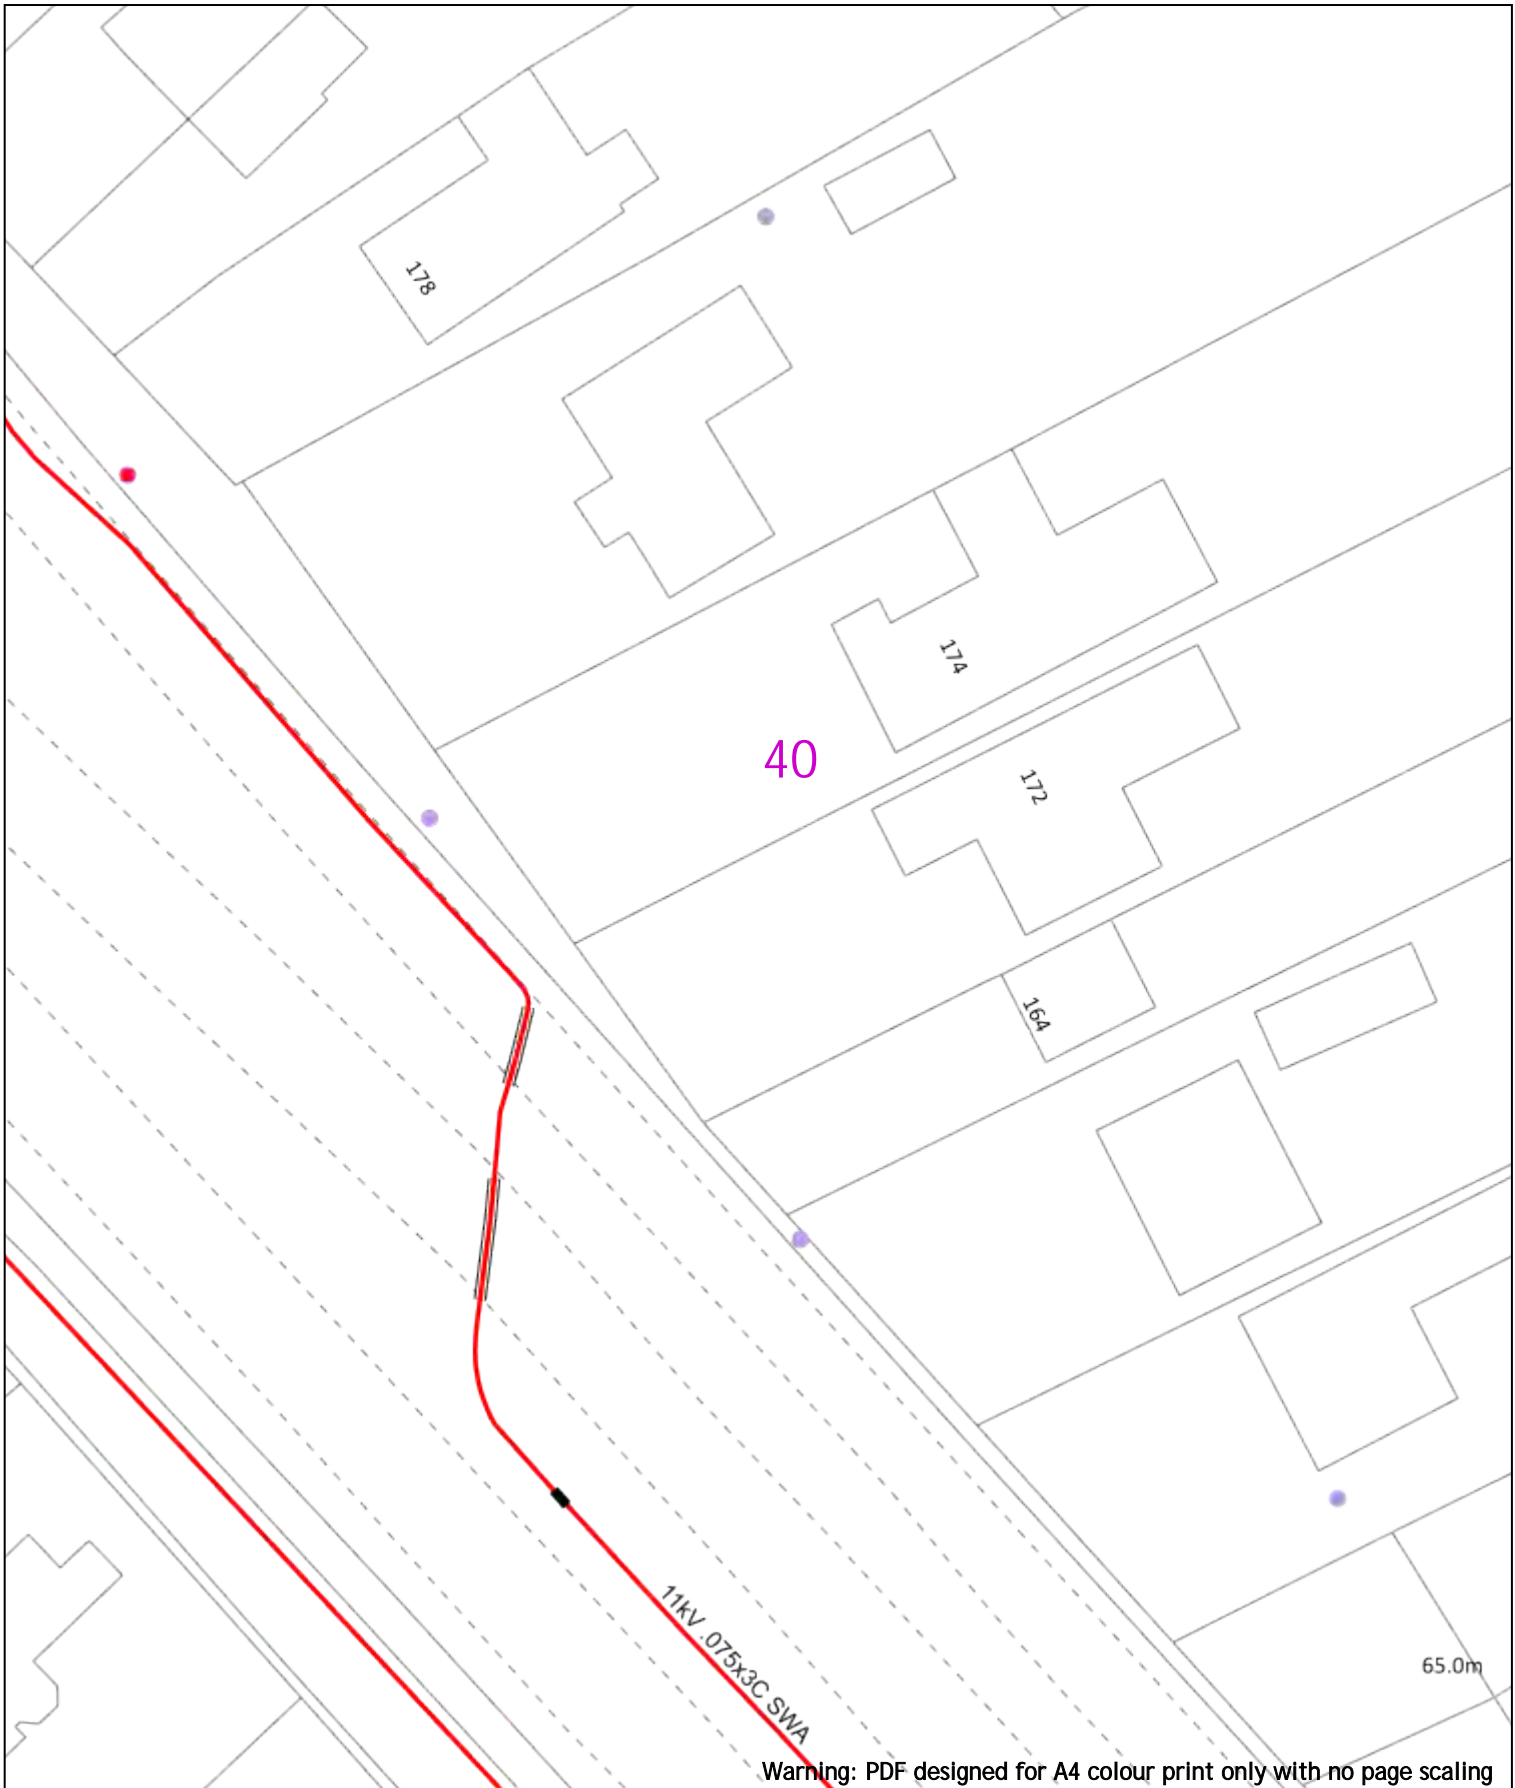

0 20m Dig Sites Area: Line: **Extra High Voltage cables in vicinity**

Date Requested: 24/06/2022  
 Job Reference: 25881037  
 Site Location: 448662 213014  
 Requested by: Mr Joe Shawyer  
 Your Scheme/Reference: 31188\_003

Voltages (V)	
LV (Low Voltage) and Services	Up to 1,000V
HV (High Voltage)	Over 1,000V to 11,000V
EHV (Extra High Voltage)	22,000V to 132,000V
Transmission	275,000V and 400,000V

NORMAL DEPTH TO THE TOP OF THE CABLE WHEN LAID				
Services	LV	HV	EHV	

**Legend**

- Service Cable
- LV Mains
- 6.6kV
- 11kV
- 22kV
- 33kV
- 66kV
- 132kV
- 275kV
- 400kV
- Fibre Optic
- Pipe Cable

**Distribution Structures (Electric)**

- Pole, Existing Location
- Pole Structure, Existing Location - Single
- Pole Structure, Existing Location - H
- Duct Route
- Cross Section Route


**WARNING**  
 There may have been subsequent alteration to the surface levels. Trial holes must be undertaken to determine position and depths of cables. HS (G) 47 Booklet from the Health and Safety Executive - Avoiding Danger from Buried Cables - should be consulted before commencing excavation work.  
**WHEN WORKING IN THE VICINITY OF OVERHEAD LINES THE HEALTH AND SAFETY GUIDANCE NOTES G56 SHOULD BE CONSULTED (AVAILABLE FROM THE HSE WEBSITE)**

Scale: 1:500 (When plotted at A4)

**Southern Electric Power Distribution plc**  
 Registered Office: No.1 Forbury Place  
 43 Forbury Road Reading RG1 3JH  
 Registered In England & Wales No.04094290

If you're unsure & need to seek advice before commencing excavations, please contact:  
 General Enquiries: 0800 048 3516


Subject to revision - Master held by SSEN Asset Data Team:  
[Asset.Data@sse.com](mailto:Asset.Data@sse.com)  
 01256 337 294

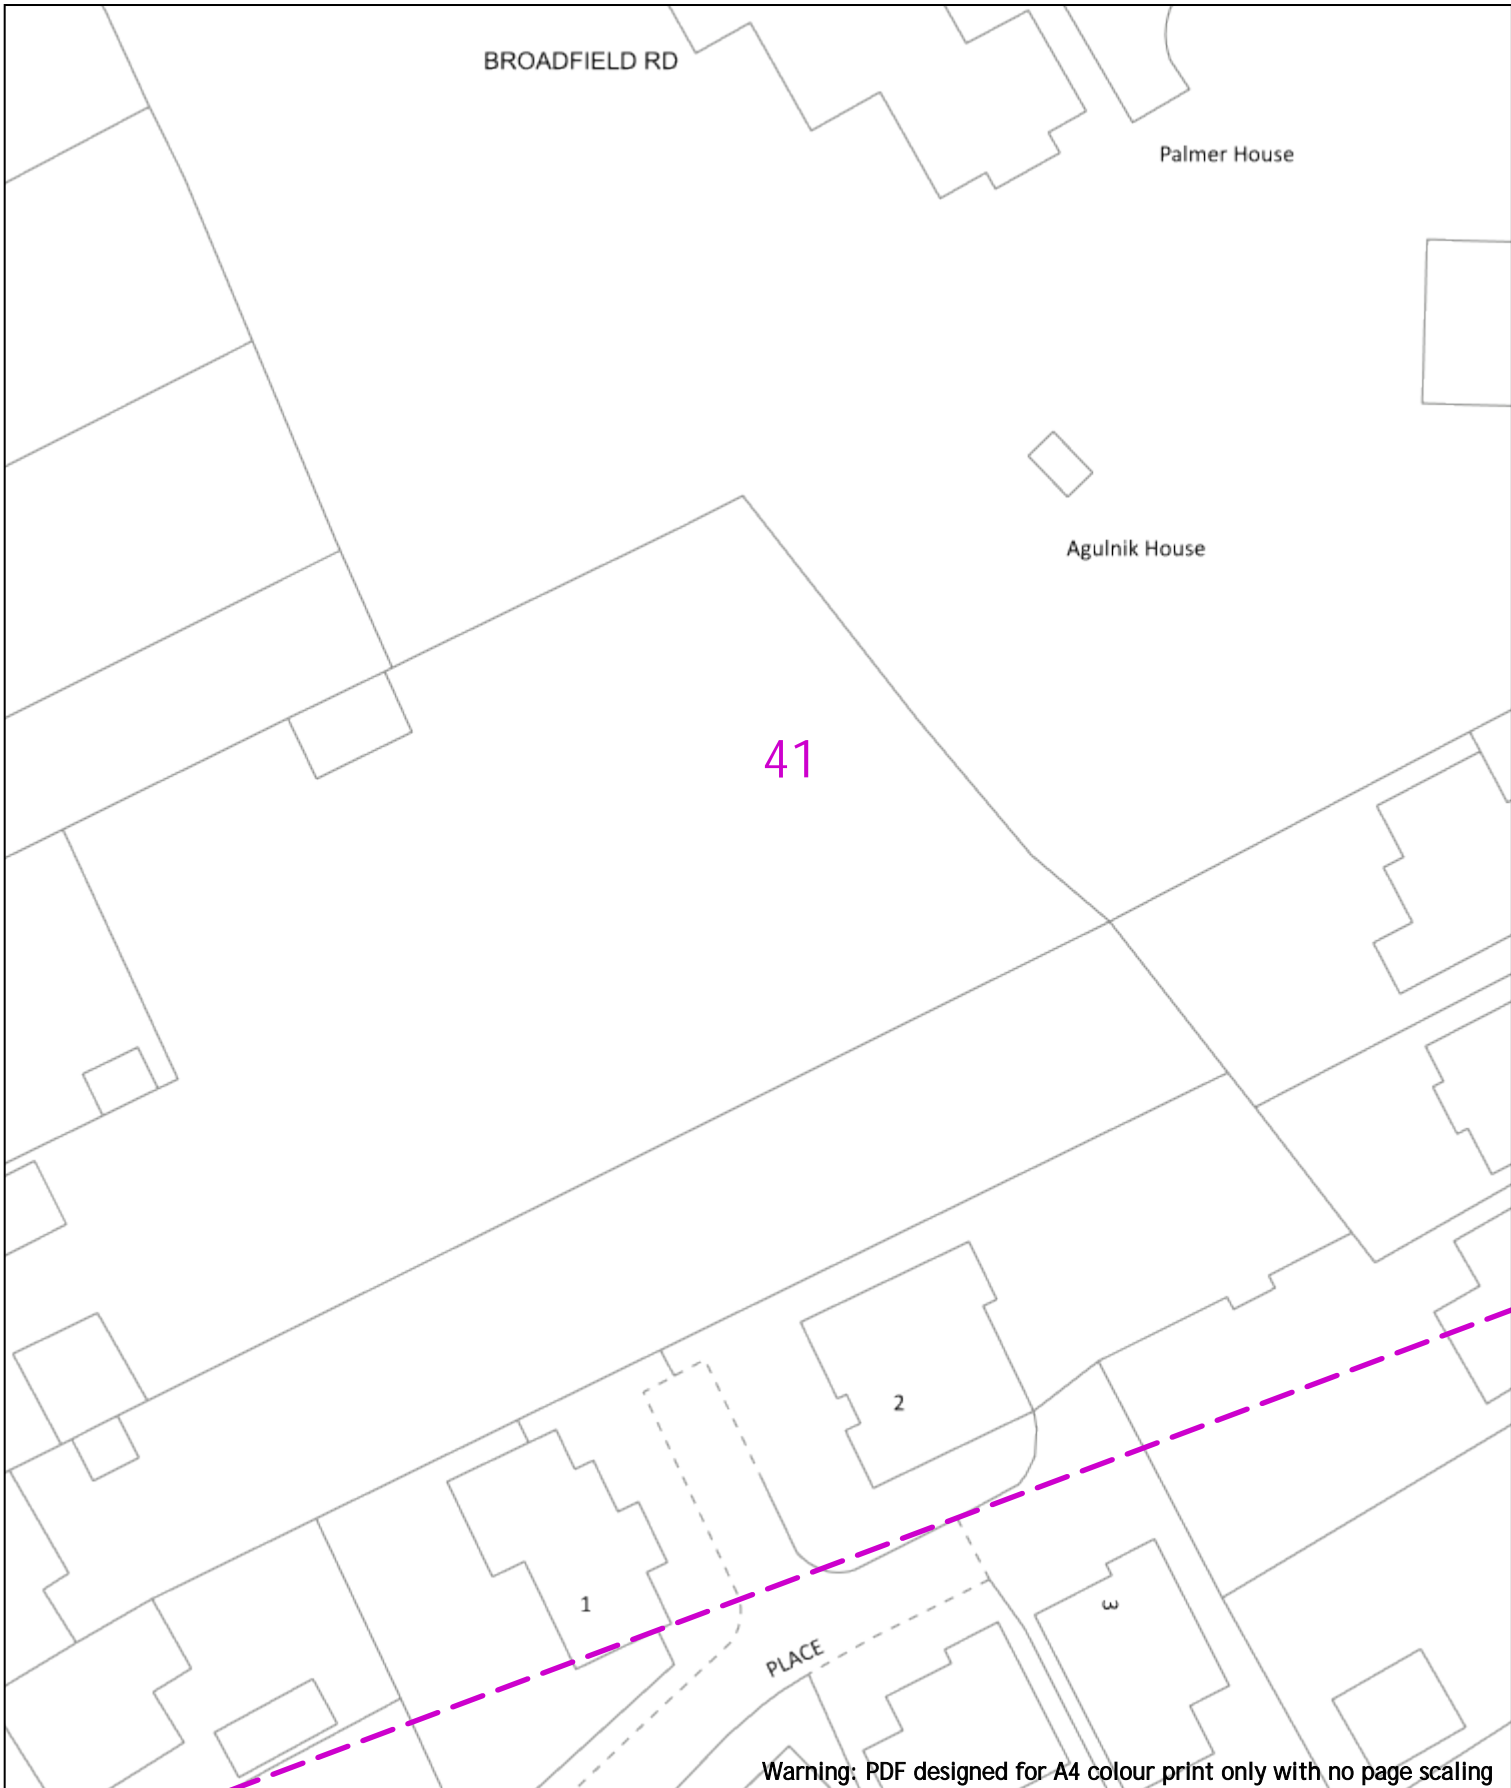

Warning: PDF designed for A4 colour print only with no page scaling


<p>0  20m Dig Sites Area:  Line: </p>	<p><b>Extra High Voltage cables in vicinity</b></p>	
<p>Date Requested: 24/06/2022          Job Reference: 25881037          Site Location: 448662 213014          Requested by: Mr Joe Shawyer          Your Scheme/Reference: 31188_003</p>	<table border="1"> <thead> <tr> <th colspan="4">Voltages (V)</th> </tr> </thead> <tbody> <tr> <td>LV (Low Voltage) and Services</td> <td colspan="3">Up to 1,000V</td> </tr> <tr> <td>HV (High Voltage)</td> <td colspan="3">Over 1,000V to 11,000V</td> </tr> <tr> <td>EHV (Extra High Voltage)</td> <td colspan="3">22,000V to 132,000V</td> </tr> <tr> <td>Transmission</td> <td colspan="3">275,000V and 400,000V</td> </tr> </tbody> </table> <table border="1"> <thead> <tr> <th colspan="4">NORMAL DEPTH TO THE TOP OF THE CABLE WHEN LAID</th> </tr> <tr> <th>Services</th> <th>LV</th> <th>HV</th> <th>EHV</th> </tr> </thead> <tbody> <tr> <td>Footpath/Unmade</td> <td>0.45m</td> <td>0.45m</td> <td>0.6m</td> </tr> <tr> <td>Road Crossing</td> <td>0.6m</td> <td>0.6m</td> <td>0.75m</td> </tr> <tr> <td>Agricultural</td> <td>1m</td> <td>1m</td> <td>1.1m</td> </tr> </tbody> </table>	Voltages (V)				LV (Low Voltage) and Services	Up to 1,000V			HV (High Voltage)	Over 1,000V to 11,000V			EHV (Extra High Voltage)	22,000V to 132,000V			Transmission	275,000V and 400,000V			NORMAL DEPTH TO THE TOP OF THE CABLE WHEN LAID				Services	LV	HV	EHV	Footpath/Unmade	0.45m	0.45m	0.6m	Road Crossing	0.6m	0.6m	0.75m	Agricultural	1m	1m	1.1m	<table border="1"> <thead> <tr> <th colspan="2">Legend</th> <th colspan="2">Distribution Structures (Electric)</th> </tr> </thead> <tbody> <tr> <td></td> <td>Service Cable</td> <td></td> <td>Pole, Existing Location</td> </tr> <tr> <td></td> <td>LV Mains</td> <td></td> <td>Pole Structure, Existing Location - Single</td> </tr> <tr> <td></td> <td>6.6kV</td> <td></td> <td>Pole Structure, Existing Location - H</td> </tr> <tr> <td></td> <td>11kV</td> <td></td> <td>Duct Route</td> </tr> <tr> <td></td> <td>22kV</td> <td></td> <td>Cross Section Route</td> </tr> <tr> <td></td> <td>33kV</td> <td></td> <td></td> </tr> <tr> <td></td> <td>66kV</td> <td></td> <td></td> </tr> <tr> <td></td> <td>132kV</td> <td></td> <td></td> </tr> <tr> <td></td> <td>275kV</td> <td></td> <td></td> </tr> <tr> <td></td> <td>400kV</td> <td></td> <td></td> </tr> <tr> <td></td> <td>Fibre Optic</td> <td></td> <td></td> </tr> <tr> <td></td> <td>Pilot Cable</td> <td></td> <td></td> </tr> </tbody> </table> <p><b>WARNING</b>          There may have been subsequent alteration to the surface levels. Trial holes must be undertaken to determine position and depths of cables. HS (G) 47 Booklet from the Health and Safety Executive - Avoiding Danger from Buried Cables - should be consulted before commencing excavation work.  <b>WHEN WORKING IN THE VICINITY OF OVERHEAD LINES THE HEALTH AND SAFETY GUIDANCE NOTES G56 SHOULD BE CONSULTED (AVAILABLE FROM THE HSE WEBSITE)</b></p>	Legend		Distribution Structures (Electric)			Service Cable		Pole, Existing Location		LV Mains		Pole Structure, Existing Location - Single		6.6kV		Pole Structure, Existing Location - H		11kV		Duct Route		22kV		Cross Section Route		33kV				66kV				132kV				275kV				400kV				Fibre Optic				Pilot Cable			<p><b>Southern Electric Power Distribution plc</b>          Registered Office: No.1 Forbury Place          43 Forbury Road Reading RG1 3JH          Registered In England &amp; Wales No.04094290</p> <p>If you're unsure &amp; need to seek advice before commencing excavations, please contact:          General Enquiries: 0800 048 3516</p> <p>Subject to revision - Master held by SSEN Asset Data Team:  <a href="mailto:Asset.Data@sse.com">Asset.Data@sse.com</a>          01256 337 294</p>
Voltages (V)	
LV (Low Voltage) and Services	Up to 1,000V	
HV (High Voltage)	Over 1,000V to 11,000V	
EHV (Extra High Voltage)	22,000V to 132,000V	
Transmission	275,000V and 400,000V	
NORMAL DEPTH TO THE TOP OF THE CABLE WHEN LAID	
Services	LV	HV	EHV	
Footpath/Unmade	0.45m	0.45m	0.6m	
Road Crossing	0.6m	0.6m	0.75m	
Agricultural	1m	1m	1.1m	
Legend		Distribution Structures (Electric)	
	Service Cable		Pole, Existing Location	
	LV Mains		Pole Structure, Existing Location - Single	
	6.6kV		Pole Structure, Existing Location - H	
	11kV		Duct Route	
	22kV		Cross Section Route	
	33kV	
	66kV	
	132kV	
	275kV	
	400kV	
	Fibre Optic	
	Pilot Cable	
<p>Scale: 1:500 (When plotted at A4)</p> <p><small>BASED UPON THE ORDNANCE SURVEY MAP WITH THE SANCTION OF THE CONTROLLER OF HM STATIONERY OFFICE CROWN COPYRIGHT RESERVED.          This copy has been made by or with the authority of Scottish and Southern Energy Power Distribution Ltd. Pursuant to section 47 of the Copyright, Designs and Patents Act 1988 ('The Act'). Unless the Act provides a relevant exception to copyright the copy must not be copied without prior permission of the copyright owner.          Plans generated by DigSAFE Pro™ software provided by LinesearchbeforeUdig.</small></p>	



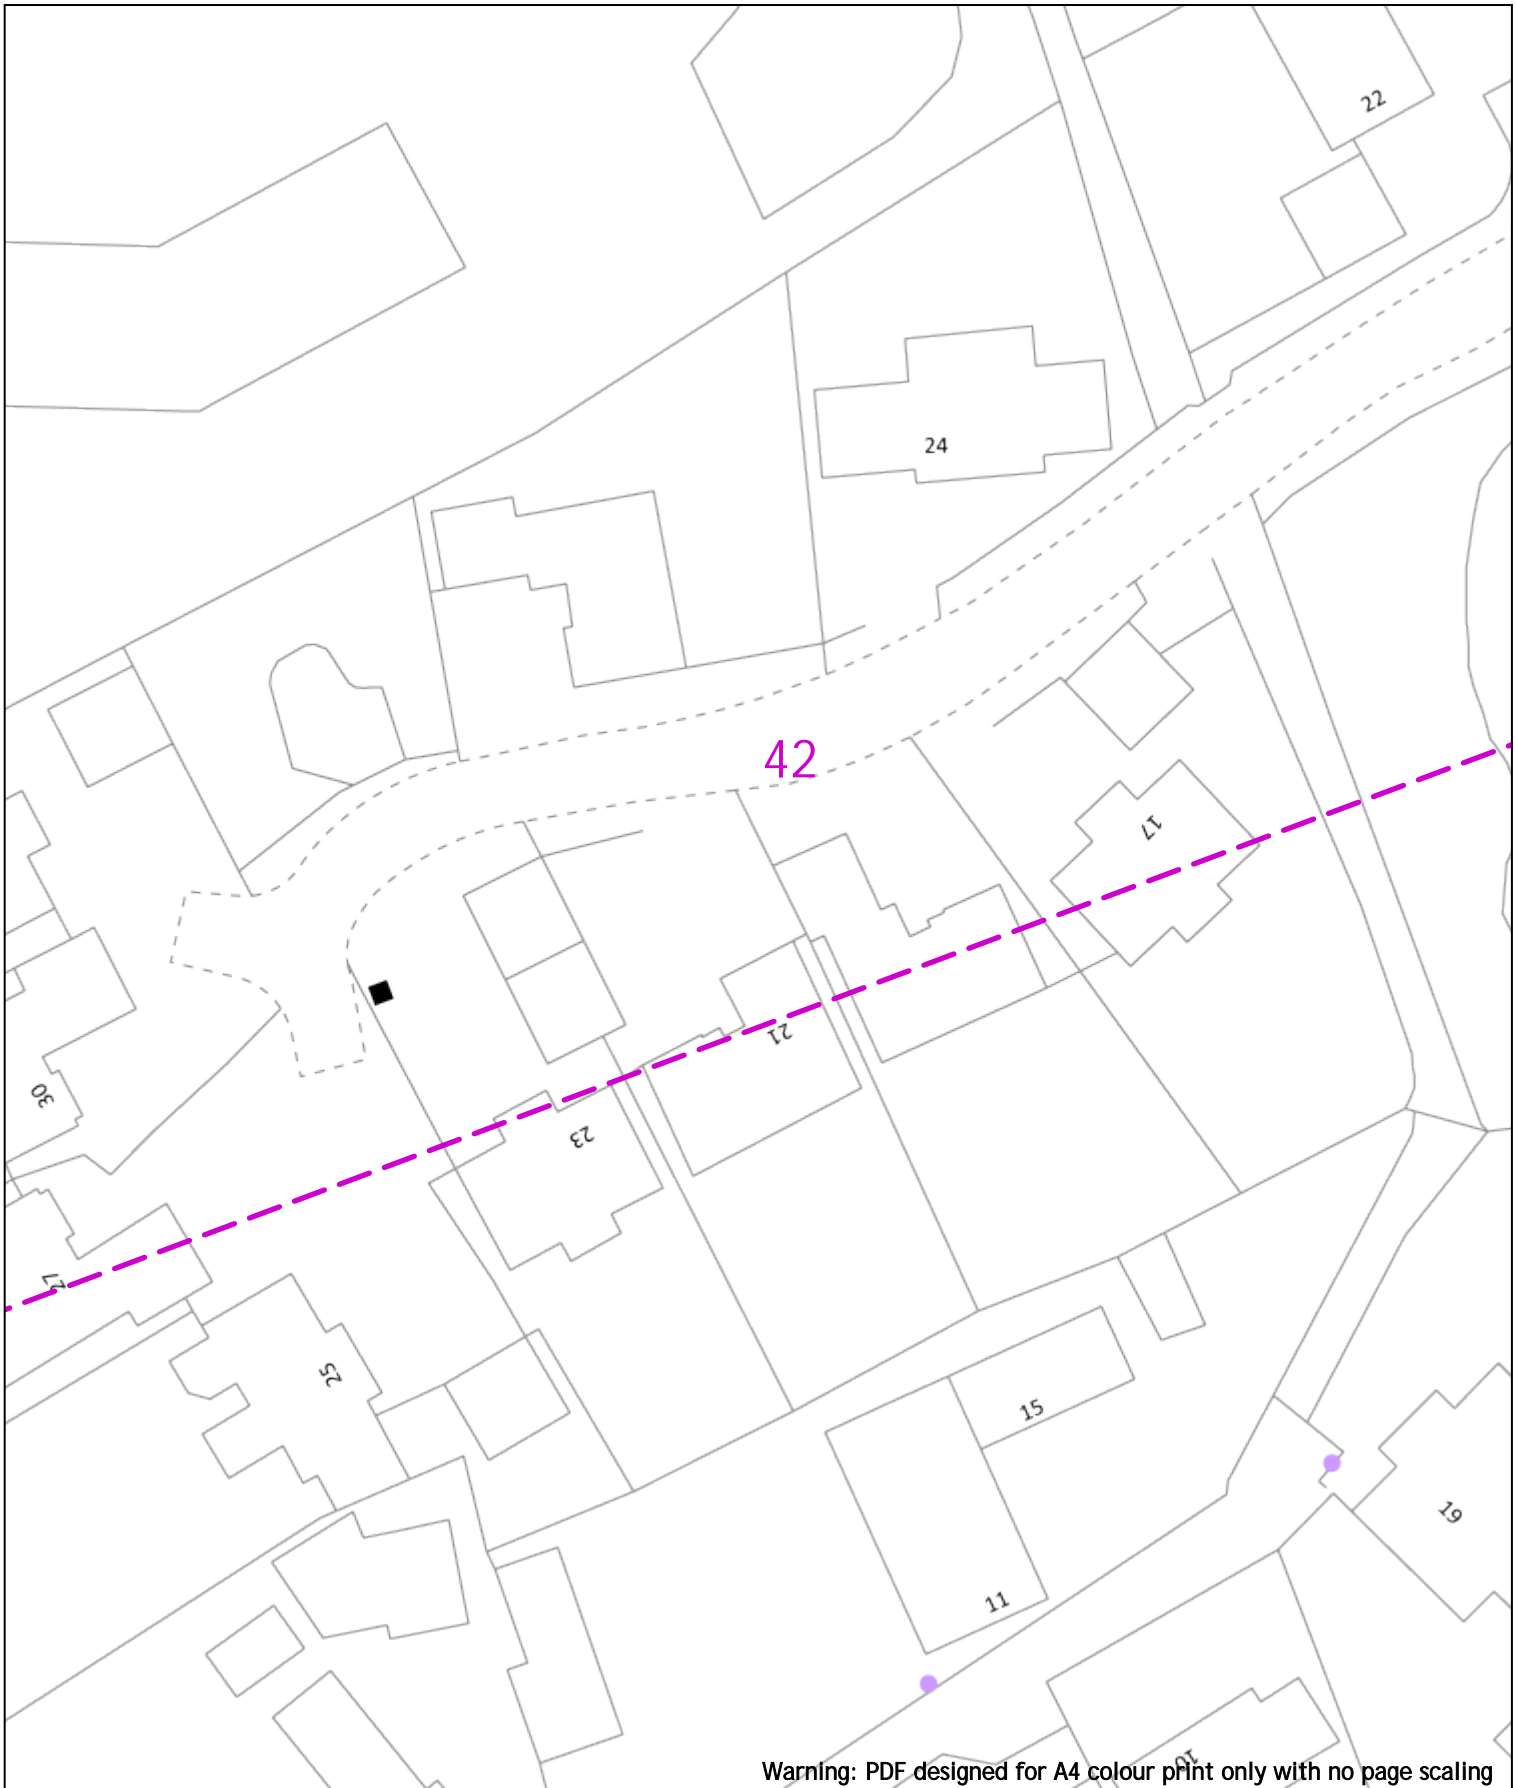

Warning: PDF designed for A4 colour print only with no page scaling

<p>0  20m Dig Sites Area:  Line:  <b>Extra High Voltage cables in vicinity</b></p>	
<p>Date Requested: 24/06/2022          Job Reference: 25881037          Site Location: 448662 213014          Requested by: Mr Joe Shawyer          Your Scheme/Reference: 31188_003</p>	<table border="1"> <thead> <tr> <th colspan="4">Voltages (V)</th> </tr> </thead> <tbody> <tr> <td>LV (Low Voltage) and Services</td> <td colspan="3">Up to 1,000V</td> </tr> <tr> <td>HV (High Voltage)</td> <td colspan="3">Over 1,000V to 11,000V</td> </tr> <tr> <td>EHV (Extra High Voltage)</td> <td colspan="3">22,000V to 132,000V</td> </tr> <tr> <td>Transmission</td> <td colspan="3">275,000V and 400,000V</td> </tr> </tbody> </table> <table border="1"> <thead> <tr> <th colspan="4">NORMAL DEPTH TO THE TOP OF THE CABLE WHEN LAID</th> </tr> <tr> <th>Services</th> <th>LV</th> <th>HV</th> <th>EHV</th> </tr> </thead> <tbody> <tr> <td>Footpath/Unmade</td> <td>0.45m</td> <td>0.45m</td> <td>0.6m</td> </tr> <tr> <td>Road Crossing</td> <td>0.6m</td> <td>0.6m</td> <td>0.75m</td> </tr> <tr> <td>Agricultural</td> <td>1m</td> <td>1m</td> <td>1.1m</td> </tr> </tbody> </table>	Voltages (V)				LV (Low Voltage) and Services	Up to 1,000V			HV (High Voltage)	Over 1,000V to 11,000V			EHV (Extra High Voltage)	22,000V to 132,000V			Transmission	275,000V and 400,000V			NORMAL DEPTH TO THE TOP OF THE CABLE WHEN LAID				Services	LV	HV	EHV	Footpath/Unmade	0.45m	0.45m	0.6m	Road Crossing	0.6m	0.6m	0.75m	Agricultural	1m	1m	1.1m												
Voltages (V)	
LV (Low Voltage) and Services	Up to 1,000V	
HV (High Voltage)	Over 1,000V to 11,000V	
EHV (Extra High Voltage)	22,000V to 132,000V	
Transmission	275,000V and 400,000V	
NORMAL DEPTH TO THE TOP OF THE CABLE WHEN LAID	
Services	LV	HV	EHV	
Footpath/Unmade	0.45m	0.45m	0.6m	
Road Crossing	0.6m	0.6m	0.75m	
Agricultural	1m	1m	1.1m	
<table border="1"> <thead> <tr> <th colspan="2">Legend</th> <th colspan="2">Distribution Structures (Electric)</th> </tr> </thead> <tbody> <tr> <td></td> <td>Service Cable</td> <td></td> <td>Pole, Existing Location</td> </tr> <tr> <td></td> <td>LV Mains</td> <td></td> <td>Pole Structure, Existing Location - Single</td> </tr> <tr> <td></td> <td>6.6kV</td> <td></td> <td>Pole Structure, Existing Location - H</td> </tr> <tr> <td></td> <td>11kV</td> <td></td> <td>Duct Route</td> </tr> <tr> <td></td> <td>22kV</td> <td></td> <td>Cross Section Route</td> </tr> <tr> <td></td> <td>33kV</td> <td></td> <td></td> </tr> <tr> <td></td> <td>66kV</td> <td></td> <td></td> </tr> <tr> <td></td> <td>132kV</td> <td></td> <td></td> </tr> <tr> <td></td> <td>275kV</td> <td></td> <td></td> </tr> <tr> <td></td> <td>400kV</td> <td></td> <td></td> </tr> <tr> <td></td> <td>Fibre Optic</td> <td></td> <td></td> </tr> <tr> <td></td> <td>Pilot Cable</td> <td></td> <td></td> </tr> </tbody> </table> <p><b>WARNING</b>          There may have been subsequent alteration to the surface levels. Trial holes must be undertaken to determine position and depths of cables. HS (G) 47 Booklet from the Health and Safety Executive - Avoiding Danger from Buried Cables - should be consulted before commencing excavation work.  <b>WHEN WORKING IN THE VICINITY OF OVERHEAD LINES THE HEALTH AND SAFETY GUIDANCE NOTES G56 SHOULD BE CONSULTED (AVAILABLE FROM THE HSE WEBSITE)</b></p>	Legend		Distribution Structures (Electric)			Service Cable		Pole, Existing Location		LV Mains		Pole Structure, Existing Location - Single		6.6kV		Pole Structure, Existing Location - H		11kV		Duct Route		22kV		Cross Section Route		33kV				66kV				132kV				275kV				400kV				Fibre Optic				Pilot Cable			<p><b>Southern Electric Power Distribution plc</b>          Registered Office: No.1 Forbury Place          43 Forbury Road Reading RG1 3JH          Registered In England &amp; Wales No.04094290</p> <p>If you're unsure &amp; need to seek advice before commencing excavations, please contact:          General Enquiries: 0800 048 3516</p> <p>Subject to revision - Master held by SSEN Asset Data Team:  <a href="mailto:Asset.Data@sse.com">Asset.Data@sse.com</a>          01256 337 294</p>
Legend		Distribution Structures (Electric)	
	Service Cable		Pole, Existing Location	
	LV Mains		Pole Structure, Existing Location - Single	
	6.6kV		Pole Structure, Existing Location - H	
	11kV		Duct Route	
	22kV		Cross Section Route	
	33kV	
	66kV	
	132kV	
	275kV	
	400kV	
	Fibre Optic	
	Pilot Cable	

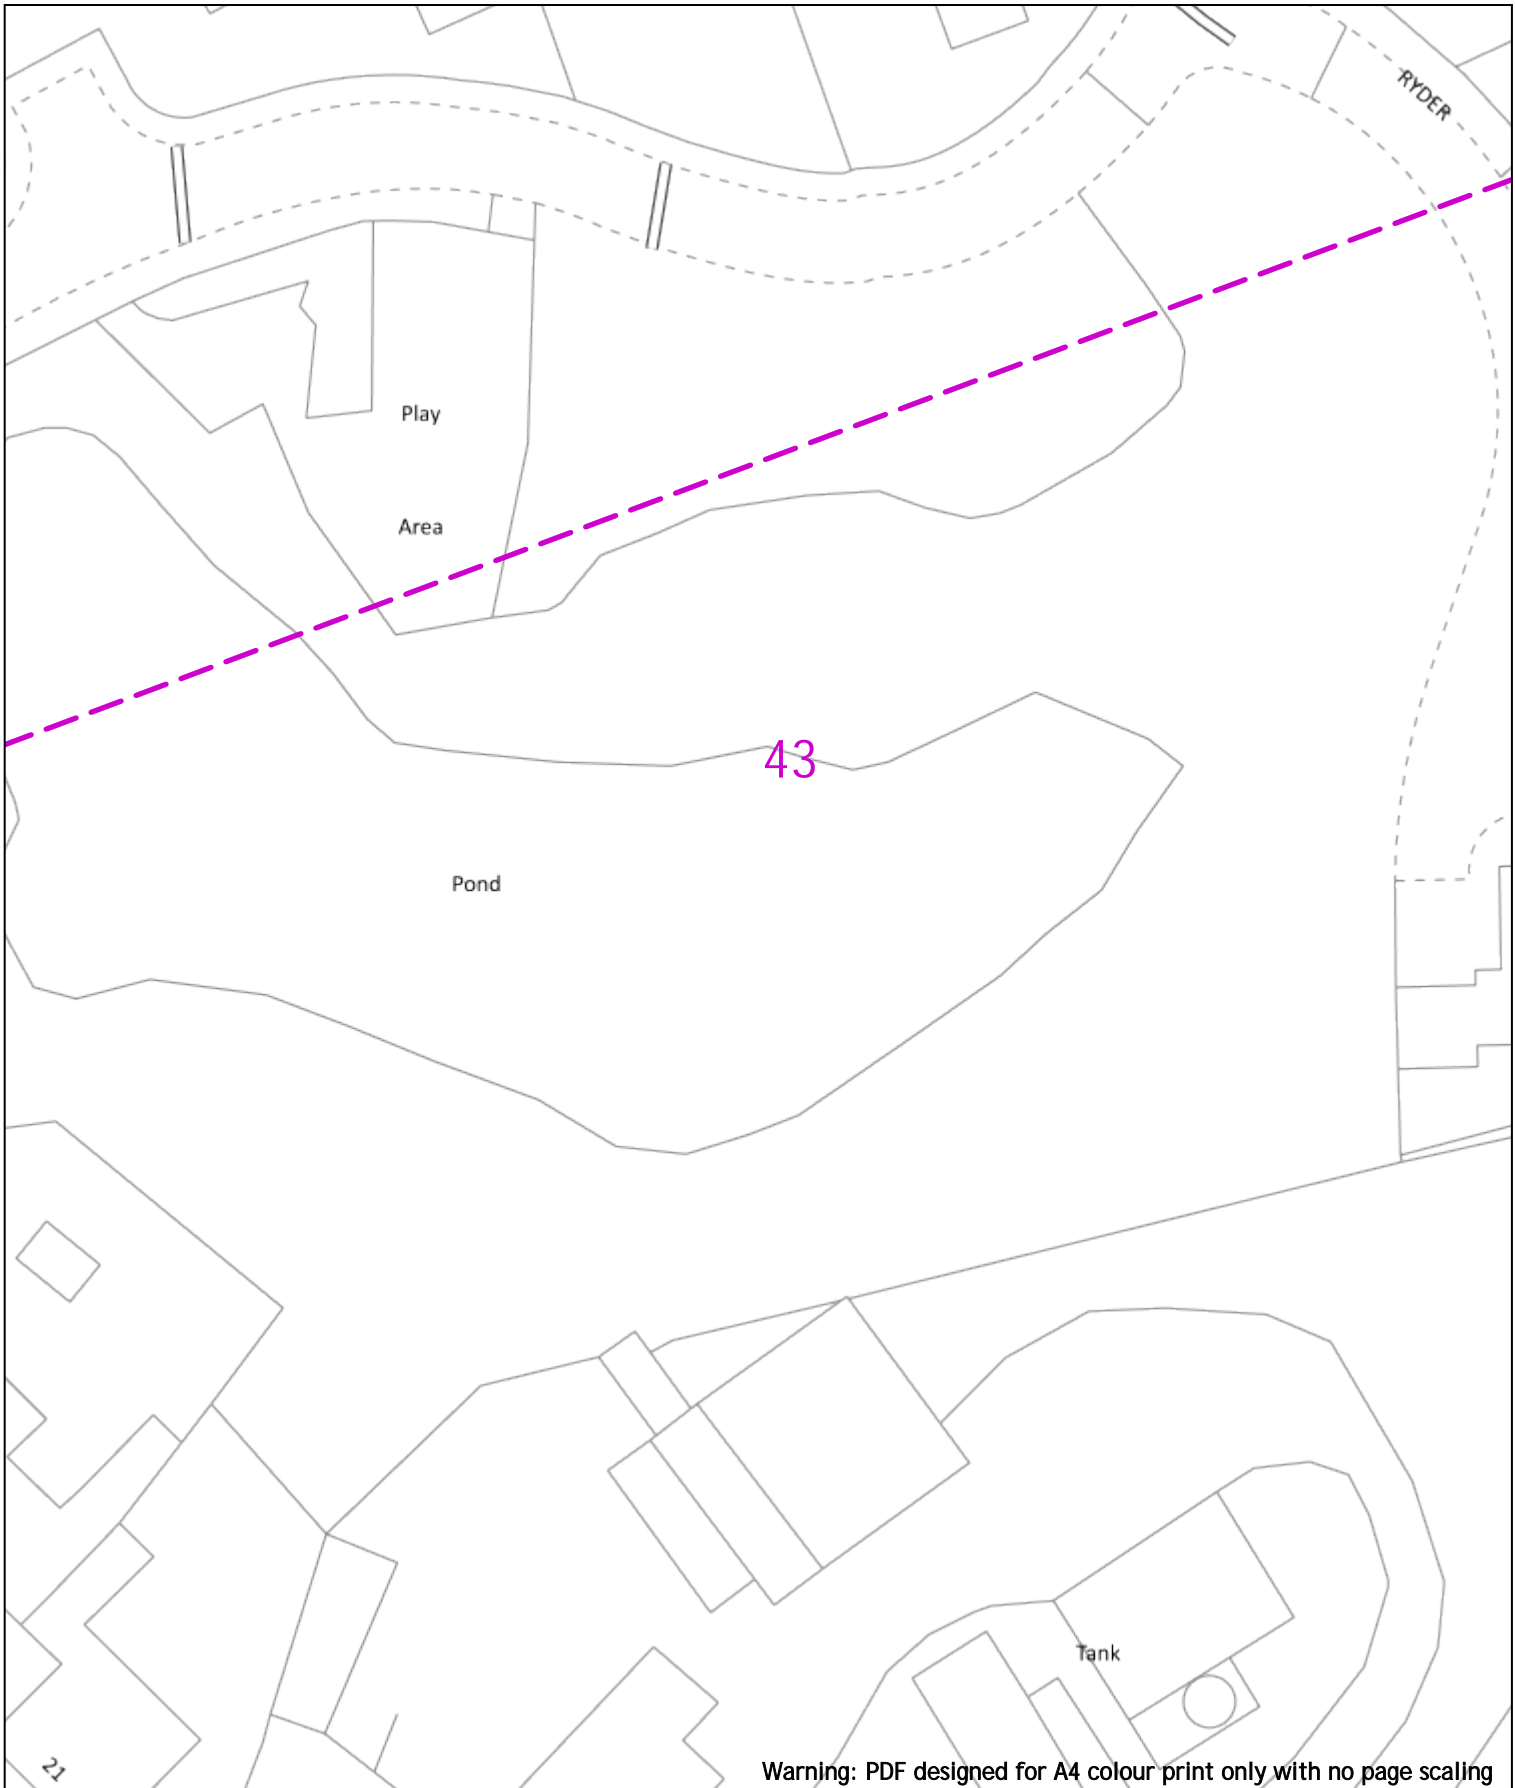


Warning: PDF designed for A4 colour print only with no page scaling

<p>0  20m Dig Sites Area:  Line:  <b>Extra High Voltage cables in vicinity</b></p>	<p> </p>	
<p>Date Requested: 24/06/2022          Job Reference: 25881037          Site Location: 448662 213014          Requested by: Mr Joe Shawyer          Your Scheme/Reference: 31188_003</p>	<table border="1"> <thead> <tr> <th colspan="4">Voltages (V)</th> </tr> </thead> <tbody> <tr> <td>LV (Low Voltage) and Services</td> <td colspan="3">Up to 1,000V</td> </tr> <tr> <td>HV (High Voltage)</td> <td colspan="3">Over 1,000V to 11,000V</td> </tr> <tr> <td>EHV (Extra High Voltage)</td> <td colspan="3">22,000V to 132,000V</td> </tr> <tr> <td>Transmission</td> <td colspan="3">275,000V and 400,000V</td> </tr> </tbody> </table> <table border="1"> <thead> <tr> <th colspan="4">NORMAL DEPTH TO THE TOP OF THE CABLE WHEN LAID</th> </tr> <tr> <th>Services</th> <th>LV</th> <th>HV</th> <th>EHV</th> </tr> </thead> <tbody> <tr> <td>Footpath/Unmade</td> <td>0.45m</td> <td>0.45m</td> <td>0.6m</td> </tr> <tr> <td>Road Crossing</td> <td>0.6m</td> <td>0.6m</td> <td>0.75m</td> </tr> <tr> <td>Agricultural</td> <td>1m</td> <td>1m</td> <td>1.1m</td> </tr> </tbody> </table> <p><b>Legend</b></p> <ul style="list-style-type: none"> <li>Service Cable</li> <li>LV Mains</li> <li>2 - 11kV</li> <li>6.6kV</li> <li>11kV</li> <li>22kV</li> <li>33kV</li> <li>66kV</li> <li>132kV</li> <li>275kV</li> <li>400kV</li> <li>Fibre Optic</li> <li>Pipe Cable</li> </ul> <p><b>Distribution Structures (Electric)</b></p> <ul style="list-style-type: none"> <li>Pole, Existing Location</li> <li>Pole Structure, Existing Location - Single</li> <li>Pole Structure, Existing Location - H</li> <li>Duct Route</li> <li>Cross Section Route</li> </ul> <p><b>WARNING</b></p> <p>There may have been subsequent alteration to the surface levels. Trial holes must be undertaken to determine position and depths of cables. HS (G) 47 Booklet from the Health and Safety Executive - Avoiding Danger from Buried Cables - should be consulted before commencing excavation work.</p> <p><b>WHEN WORKING IN THE VICINITY OF OVERHEAD LINES THE HEALTH AND SAFETY GUIDANCE NOTES G56 SHOULD BE CONSULTED (AVAILABLE FROM THE HSE WEBSITE)</b></p>	Voltages (V)				LV (Low Voltage) and Services	Up to 1,000V			HV (High Voltage)	Over 1,000V to 11,000V			EHV (Extra High Voltage)	22,000V to 132,000V			Transmission	275,000V and 400,000V			NORMAL DEPTH TO THE TOP OF THE CABLE WHEN LAID				Services	LV	HV	EHV	Footpath/Unmade	0.45m	0.45m	0.6m	Road Crossing	0.6m	0.6m	0.75m	Agricultural	1m	1m	1.1m
Voltages (V)	
LV (Low Voltage) and Services	Up to 1,000V	
HV (High Voltage)	Over 1,000V to 11,000V	
EHV (Extra High Voltage)	22,000V to 132,000V	
Transmission	275,000V and 400,000V	
NORMAL DEPTH TO THE TOP OF THE CABLE WHEN LAID	
Services	LV	HV	EHV																																						
Footpath/Unmade	0.45m	0.45m	0.6m																																						
Road Crossing	0.6m	0.6m	0.75m																																						
Agricultural	1m	1m	1.1m																																						
<p>Scale: 1:500 (When plotted at A4)</p>	<p>BASED UPON THE ORDNANCE SURVEY MAP WITH THE SANCTION OF THE CONTROLLER OF HM STATIONERY OFFICE CROWN COPYRIGHT RESERVED.          This copy has been made by or with the authority of Scottish and Southern Energy Power Distribution Ltd. Pursuant to section 47 of the Copyright, Designs and Patents Act 1988 ("The Act"). Unless the Act provides a relevant exception to copyright the copy must not be copied without prior permission of the copyright owner.          Plans generated by DigSAFE Pro™ software provided by LinesearchbeforeUdig.</p>	

**Southern Electric Power Distribution plc**  
 Registered Office: No.1 Forbury Place  
 43 Forbury Road Reading RG1 3JH  
 Registered In England & Wales No.04094290

If you're unsure & need to seek advice before commencing excavations, please contact:  
 General Enquiries: 0800 048 3516

Subject to revision - Master held by SSEN Asset Data Team:  
[Asset.Data@sse.com](mailto:Asset.Data@sse.com)  
 01256 337 294

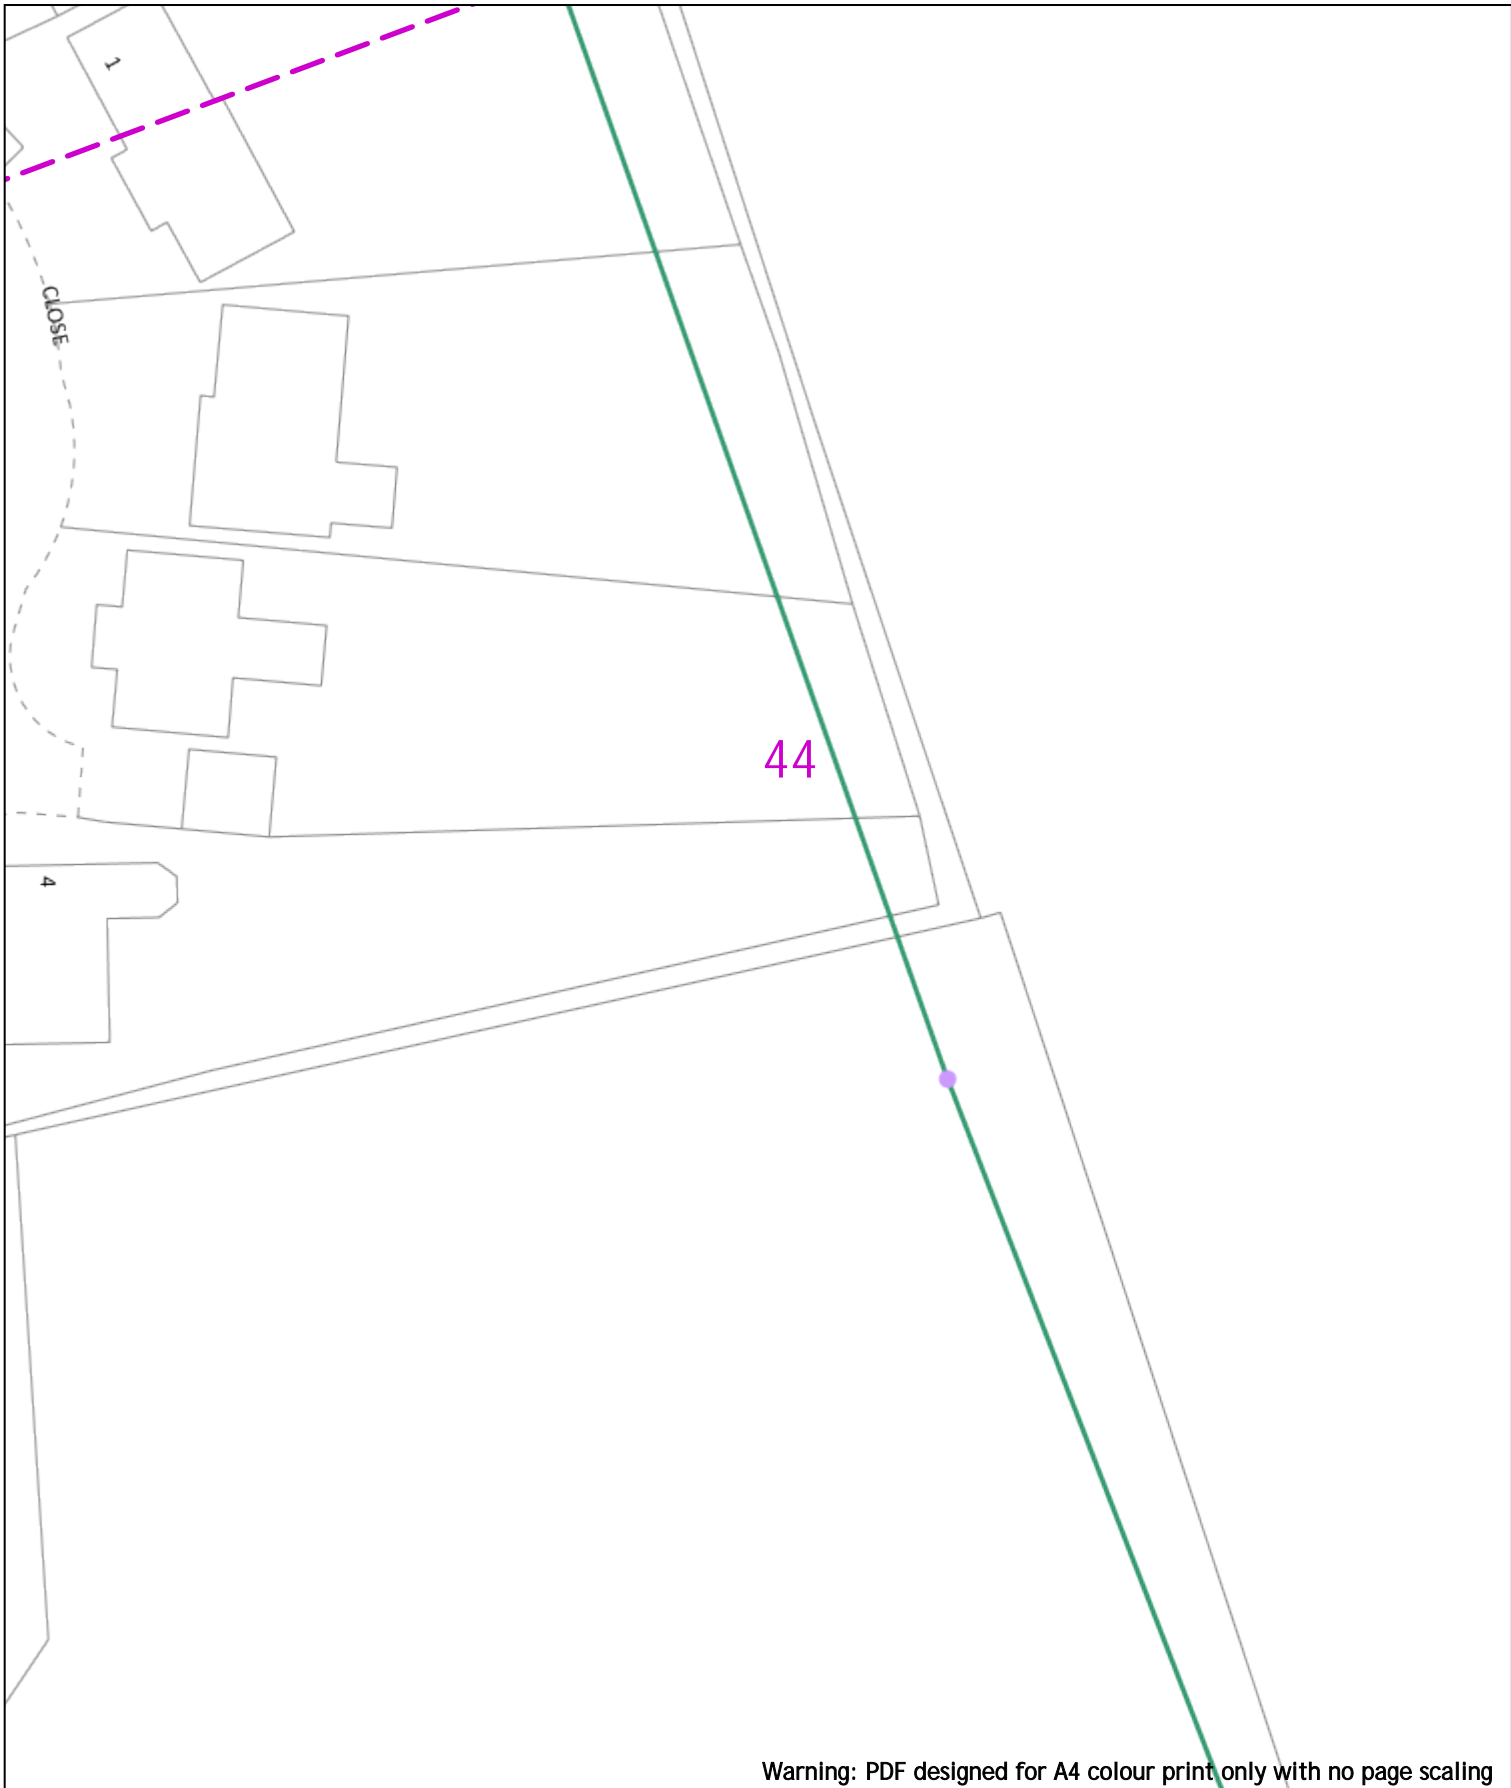

Warning: PDF designed for A4 colour print only with no page scaling

0 20m Dig Sites Area: Line: **Extra High Voltage cables in vicinity**

Date Requested: 24/06/2022  
 Job Reference: 25881037  
 Site Location: 448662 213014  
 Requested by: Mr Joe Shawyer  
 Your Scheme/Reference: 31188\_003

Voltages (V)			
LV (Low Voltage) and Services	Up to 1,000V		
HV (High Voltage)	Over 1,000V to 11,000V		
EHV (Extra High Voltage)	22,000V to 132,000V		
Transmission	275,000V and 400,000V		
NORMAL DEPTH TO THE TOP OF THE CABLE WHEN LAID			
Services	LV	HV	EHV
Footpath/Unmade	0.45m	0.45m	0.6m
Road Crossing	0.6m	0.6m	0.75m
Agricultural	1m	1m	1.1m

Legend	
	Service Cable
	LV Mains
	2 - 11kV
	66kV
	11kV
	22kV
	33kV
	66kV
	132kV
	275kV
	400kV
	Fibre Optic
	Pilot Cable

Distribution Structures (Electric)	
	Pole, Existing Location
	Pole Structure, Existing Location - Single
	Pole Structure, Existing Location - H
	Duct Route
	Cross Section Route

**Southern Electric Power Distribution plc**  
 Registered Office: No.1 Forbury Place  
 43 Forbury Road Reading RG1 3JH  
 Registered In England & Wales No.04094290


If you're unsure & need to seek advice before commencing excavations, please contact:  
 General Enquiries: 0800 048 3516

Subject to revision – Master held by SSEN Asset Data Team:  
[Asset.Data@sse.com](mailto:Asset.Data@sse.com)  
 01256 337 294

Scale: 1:500 (When plotted at A4)

BASED UPON THE ORDNANCE SURVEY MAP WITH THE SANCTION OF THE CONTROLLER OF HM STATIONERY OFFICE CROWN COPYRIGHT RESERVED.  
 This copy has been made by or with the authority of Scottish and Southern Energy Power Distribution Ltd. Pursuant to section 47 of the Copyright, Designs and Patents Act 1988 ("The Act"). Unless the Act provides a relevant exception to copyright the copy must not be copied without prior permission of the copyright owner.  
 Plans generated by DigSAFE Pro™ software provided by Linesearchbeforedig.

45

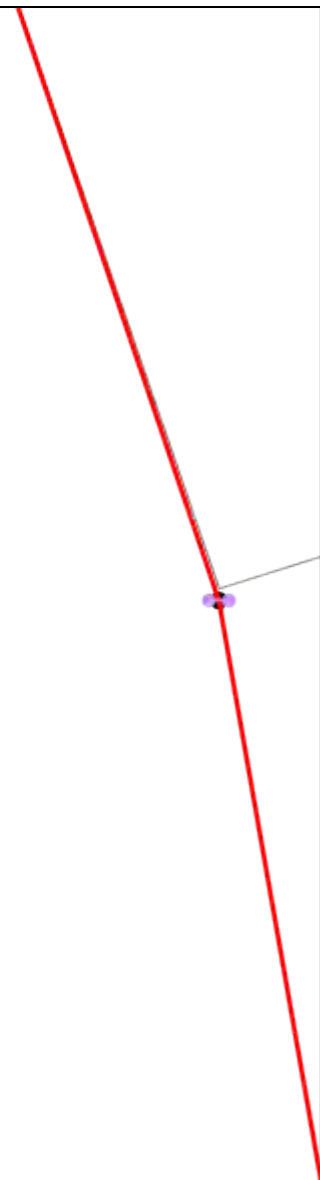

Warning: PDF designed for A4 colour print only with no page scaling

0 20m Dig Sites Area: Line:

**Extra High Voltage  
cables in vicinity**



Date Requested: 24/06/2022  
 Job Reference: 25881037  
 Site Location: 448662 213014  
 Requested by: Mr Joe Shawyer  
 Your Scheme/Reference: 31188\_003

Voltages (V)			
LV (Low Voltage) and Services	Up to 1,000V		
HV (High Voltage)	Over 1,000V to 11,000V		
EHV (Extra High Voltage)	22,000V to 132,000V		
Transmission	275,000V and 400,000V		
NORMAL DEPTH TO THE TOP OF THE CABLE WHEN LAID			
Services	LV	HV	EHV
Footpath/Unmade	0.45m	0.45m	0.6m 0.8m
Road Crossing	0.6m	0.6m	0.75m 0.9m
Agricultural	1m	1m	1m 1.1m

Legend	
	Service Cable
	LV Mains
	2 - 11kV
	66kV
	11kV
	22kV
	33kV
	66kV
	132kV
	275kV
	400kV
	Fibre Optic
	Pipe Cable

Distribution Structures (Electric)	
	Pole, Existing Location
	Pole Structure, Existing Location - Single
	Pole Structure, Existing Location - H
	Duct Route
	Cross Section Route

**WARNING**

There may have been subsequent alteration to the surface levels. Trial holes must be undertaken to determine position and depths of cables. HS (G) 47 Booklet from the Health and Safety Executive - Avoiding Danger from Buried Cables - should be consulted before commencing excavation work.  
 WHEN WORKING IN THE VICINITY OF OVERHEAD LINES THE HEALTH AND SAFETY GUIDANCE NOTES G56 SHOULD BE CONSULTED (AVAILABLE FROM THE HSE WEBSITE)

**Southern Electric Power Distribution plc**  
 Registered Office: No.1 Forbury Place  
 43 Forbury Road Reading RG1 3JH  
 Registered In England & Wales No.04094290

If you're unsure & need to seek advice before commencing excavations, please contact:  
 General Enquiries: 0800 048 3516

Subject to revision - Master held by SSEN Asset Data Team:  
[Asset.Data@sse.com](mailto:Asset.Data@sse.com)  
 01256 337 294

Scale: 1:500 (When plotted at A4)

Warning: PDF designed for A4 colour print only with no page scaling

0 20m Dig Sites Area: Line:

**Extra High Voltage  
cables in vicinity**



Date Requested: 24/06/2022  
 Job Reference: 25881037  
 Site Location: 448662 213014  
 Requested by: Mr Joe Shawyer  
 Your Scheme/Reference: 31188\_003

Voltages (V)			
LV (Low Voltage) and Services	Up to 1,000V		
HV (High Voltage)	Over 1,000V to 11,000V		
EHV (Extra High Voltage)	22,000V to 132,000V		
Transmission	275,000V and 400,000V		
NORMAL DEPTH TO THE TOP OF THE CABLE WHEN LAID			
Services	LV	HV	EHV
Footpath/Unmade	0.45m	0.45m	0.6m 0.8m
Road Crossing	0.6m	0.6m	0.75m 0.9m
Agricultural	1m	1m	1m 1.1m

Legend	
	Service Cable
	LV Mains
	2 - 11kV
	66kV
	275kV
	400kV
	Fibre Optic
	Pipe Cable

Distribution Structures (Electric)	
	Pole, Existing Location
	Pole Structure, Existing Location - Single
	Pole Structure, Existing Location - H
	Duct Route
	Cross Section Route

**Southern Electric Power Distribution plc**  
 Registered Office: No.1 Forbury Place  
 43 Forbury Road Reading RG1 3JH  
 Registered In England & Wales No.04094290

If you're unsure & need to seek advice before commencing excavations, please contact:  
 General Enquiries: 0800 048 3516

Subject to revision – Master held by SSEN Asset Data Team:  
[Asset.Data@sse.com](mailto:Asset.Data@sse.com)  
 01256 337 294

Scale: 1:500 (When plotted at A4)

**WARNING**  
 There may have been subsequent alteration to the surface levels. Trial holes must be undertaken to determine position and depths of cables. HS (G) 47 Booklet from the Health and Safety Executive – Avoiding Danger from Buried Cables – should be consulted before commencing excavation work.  
**WHEN WORKING IN THE VICINITY OF OVERHEAD LINES THE HEALTH AND SAFETY GUIDANCE NOTES G56 SHOULD BE CONSULTED (AVAILABLE FROM THE HSE WEBSITE)**

Warning: PDF designed for A4 colour print only with no page scaling

0 20m Dig Sites Area: Line:

**Extra High Voltage  
cables in vicinity**



Date Requested: 24/06/2022  
 Job Reference: 25881037  
 Site Location: 448662 213014  
 Requested by: Mr Joe Shawyer  
 Your Scheme/Reference: 31188\_003

Voltages (V)			
LV (Low Voltage) and Services	Up to 1,000V		
HV (High Voltage)	Over 1,000V to 11,000V		
EHV (Extra High Voltage)	22,000V to 132,000V		
Transmission	275,000V and 400,000V		
NORMAL DEPTH TO THE TOP OF THE CABLE WHEN LAID			
Services	LV	HV	EHV
Footpath/Unmade	0.45m	0.45m	0.6m 0.8m
Road Crossing	0.6m	0.6m	0.75m 0.9m
Agricultural	1m	1m	1m 1.1m

Legend	Distribution Structures (Electric)
Service Cable	Pole, Existing Location
LV Mains	Pole Structure, Existing Location - Single
2 - 11kV	Pole Structure, Existing Location - H
66kV	Duct Route
11kV	Cross Section Route
22kV	
33kV	
66kV	
132kV	
275kV	
400kV	
Fibre Optic	
Pipit Cable	

**WARNING**  
 There may have been subsequent alteration to the surface levels. Trial holes must be undertaken to determine position and depths of cables. HS (G) 47 Booklet from the Health and Safety Executive - Avoiding Danger from Buried Cables - should be consulted before commencing excavation work.  
**WHEN WORKING IN THE VICINITY OF OVERHEAD LINES THE HEALTH AND SAFETY GUIDANCE NOTES G56 SHOULD BE CONSULTED (AVAILABLE FROM THE HSE WEBSITE)**

**Southern Electric Power Distribution plc**  
 Registered Office: No.1 Forbury Place  
 43 Forbury Road Reading RG1 3JH  
 Registered In England & Wales No.04094290

If you're unsure & need to seek advice before commencing excavations, please contact:  
 General Enquiries: 0800 048 3516

Subject to revision - Master held by SSEN Asset Data Team:  
[Asset.Data@sse.com](mailto:Asset.Data@sse.com)  
 01256 337 294

Scale: 1:500 (When plotted at A4)

2x 11kV 240x3C Al XLPE U/A

48

Warning: PDF designed for A4 colour print only with no page scaling

0 20m

Dig Sites

Area:

Line:

Extra High Voltage cables in vicinity



Date Requested: 24/06/2022  
 Job Reference: 25881037  
 Site Location: 448662 213014  
 Requested by: Mr Joe Shawyer  
 Your Scheme/Reference: 31188\_003

Voltages (V)			
LV (Low Voltage) and Services	Up to 1,000V		
HV (High Voltage)	Over 1,000V to 11,000V		
EHV (Extra High Voltage)	22,000V to 132,000V		
Transmission	275,000V and 400,000V		
NORMAL DEPTH TO THE TOP OF THE CABLE WHEN LAID			
Services	LV	HV	EHV
Footpath/Unmade	0.45m	0.45m	0.6m 0.8m
Road Crossing	0.6m	0.6m	0.75m 0.9m
Agricultural	1m	1m	1m 1.1m

Legend	
	Service Cable
	LV Mains
	2 - 11kV
	66kV
	11kV
	22kV
	33kV
	66kV
	132kV
	275kV
	400kV
	Fibre Optic
	Pipe Cable

Distribution Structures (Electric)	
	Pole, Existing Location
	Pole Structure, Existing Location - Single
	Pole Structure, Existing Location - H
	Duct Route
	Cross Section Route

**Southern Electric Power Distribution plc**  
 Registered Office: No.1 Forbury Place  
 43 Forbury Road Reading RG1 3JH  
 Registered In England & Wales No.04094290

If you're unsure & need to seek advice before commencing excavations, please contact:  
 General Enquiries: 0800 048 3516

Subject to revision – Master held by SSEN Asset Data Team:  
[Asset.Data@sse.com](mailto:Asset.Data@sse.com)  
 01256 337 294

Scale: 1:500 (When plotted at A4)

**WARNING**  
 There may have been subsequent alteration to the surface levels. Trial holes must be undertaken to determine position and depths of cables. HS (G) 47 Booklet from the Health and Safety Executive – Avoiding Danger from Buried Cables – should be consulted before commencing excavation work.  
**WHEN WORKING IN THE VICINITY OF OVERHEAD LINES THE HEALTH AND SAFETY GUIDANCE NOTES G56 SHOULD BE CONSULTED (AVAILABLE FROM THE HSE WEBSITE)**

Warning: PDF designed for A4 colour print only with no page scaling

0  20m Dig Sites Area:  Line: 

**Extra High Voltage  
cables in vicinity**



Date Requested: 24/06/2022  
 Job Reference: 25881037  
 Site Location: 448662 213014  
 Requested by: Mr Joe Shawyer  
 Your Scheme/Reference: 31188\_003

Voltages (V)			
LV (Low Voltage) and Services	Up to 1,000V		
HV (High Voltage)	Over 1,000V to 11,000V		
EHV (Extra High Voltage)	22,000V to 132,000V		
Transmission	275,000V and 400,000V		
NORMAL DEPTH TO THE TOP OF THE CABLE WHEN LAID			
Services	LV	HV	EHV
Footpath/Unmade	0.45m	0.45m	0.6m 0.8m
Road Crossing	0.6m	0.6m	0.75m 0.9m
Agricultural	1m	1m	1m 1.1m

Legend	Distribution Structures (Electric)
Service Cable	Pole, Existing Location
LV Mains	Pole Structure, Existing Location - Single
2 - 11kV	Pole Structure, Existing Location - H
66kV	Duct Route
11kV	Cross Section Route
22kV	
33kV	
66kV	
132kV	
275kV	
400kV	
Fibre Optic	
Pipit Cable	

**WARNING**  
 There may have been subsequent alteration to the surface levels. Trial holes must be undertaken to determine position and depths of cables. HS (G) 47 Booklet from the Health and Safety Executive - Avoiding Danger from Buried Cables - should be consulted before commencing excavation work.  
**WHEN WORKING IN THE VICINITY OF OVERHEAD LINES THE HEALTH AND SAFETY GUIDANCE NOTES G56 SHOULD BE CONSULTED (AVAILABLE FROM THE HSE WEBSITE)**


**Southern Electric Power Distribution plc**  
 Registered Office: No.1 Forbury Place  
 43 Forbury Road Reading RG1 3JH  
 Registered In England & Wales No.04094290

If you're unsure & need to seek advice before commencing excavations, please contact:  
 General Enquiries: 0800 048 3516

Subject to revision - Master held by SSEN Asset Data Team:  
[Asset.Data@sse.com](mailto:Asset.Data@sse.com)  
 01256 337 294

Scale: 1:500 (When plotted at A4)



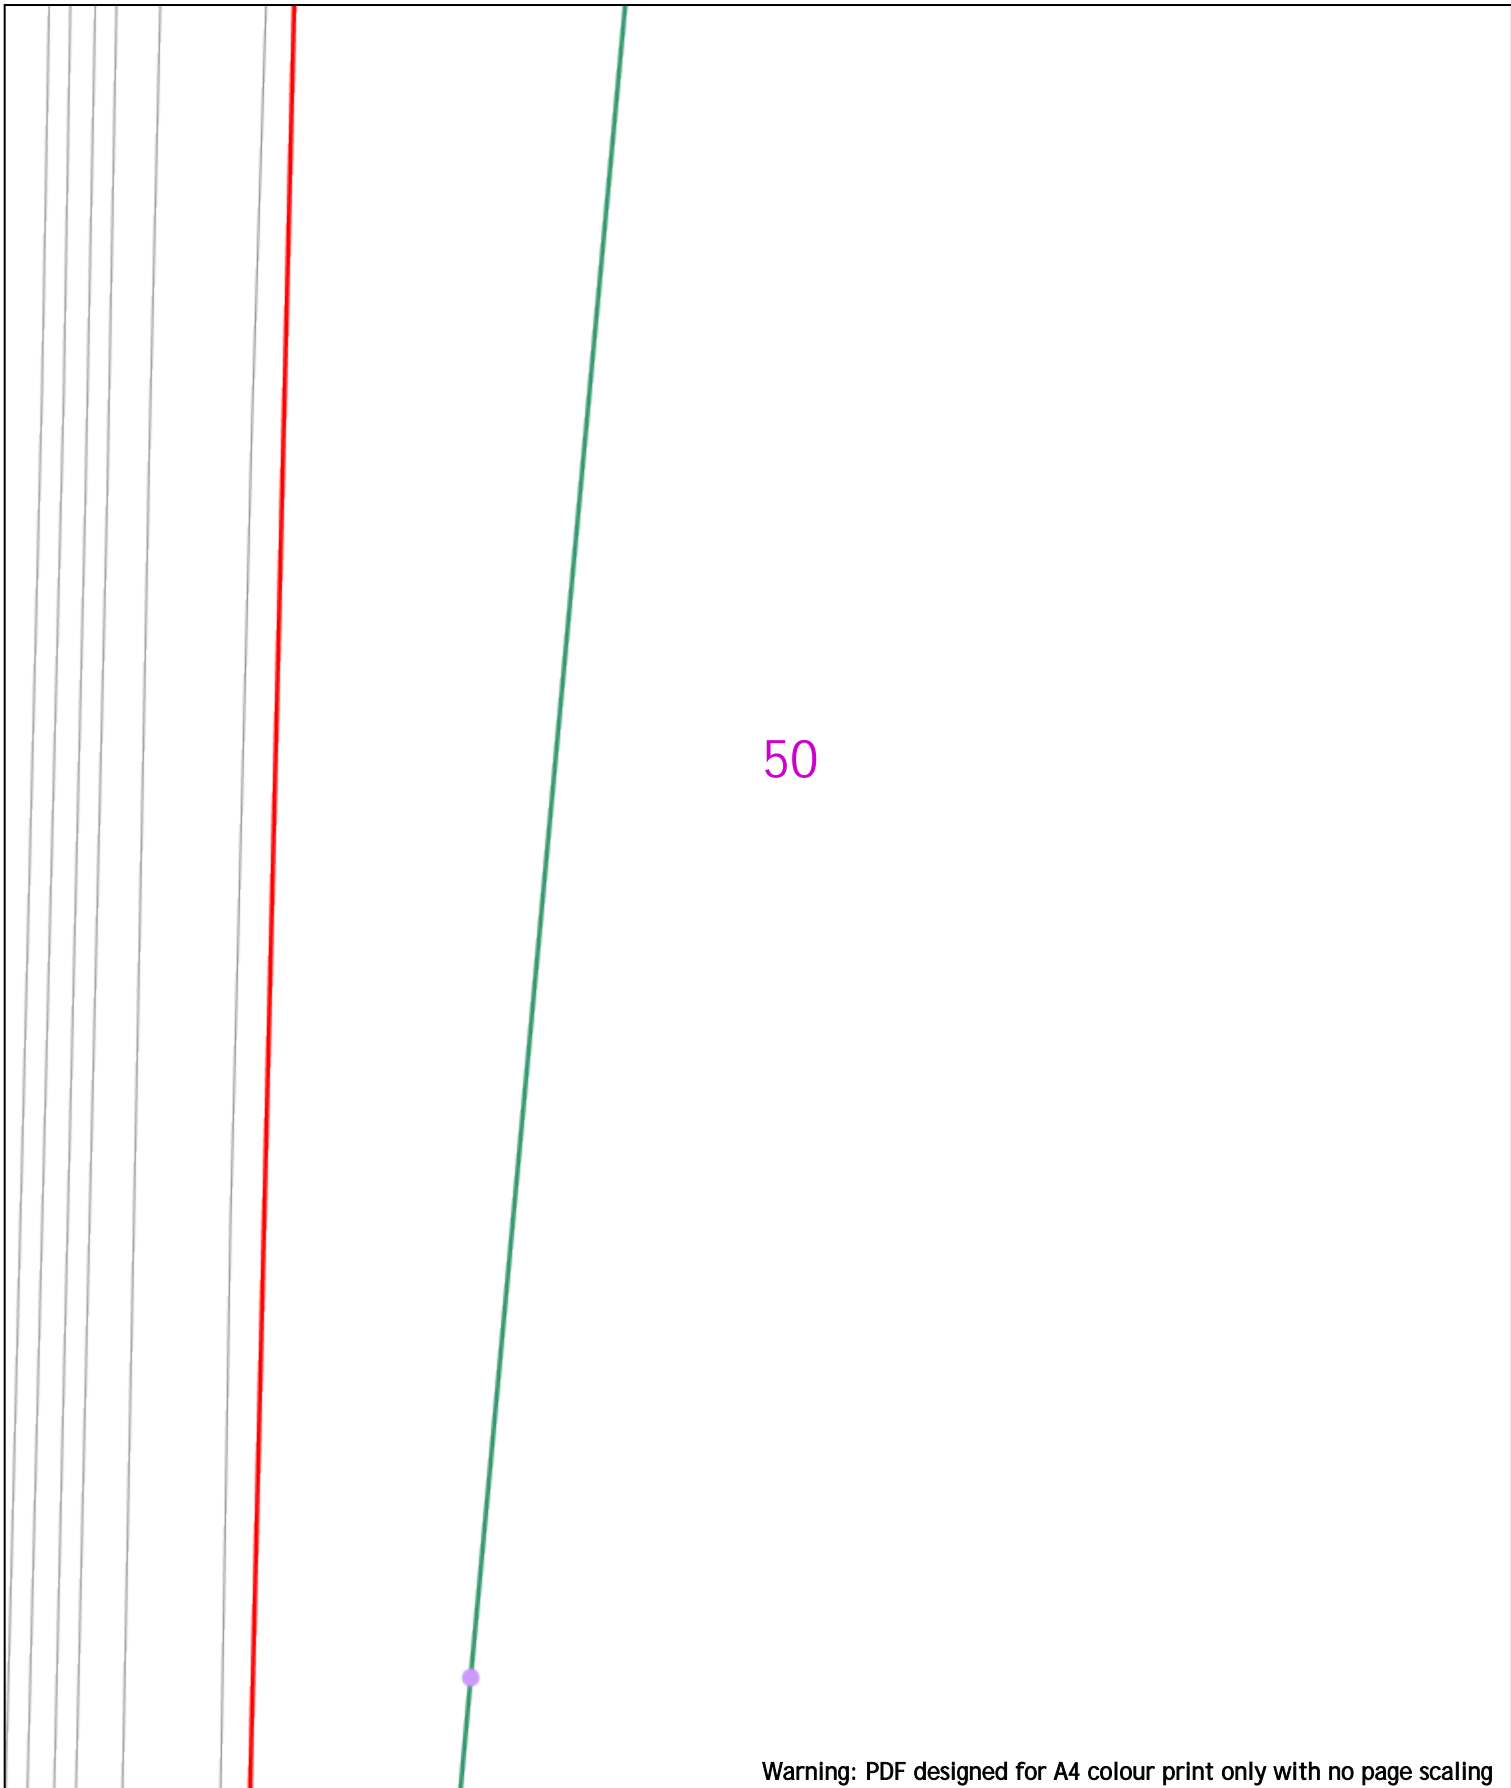

Warning: PDF designed for A4 colour print only with no page scaling

0 20m Dig Sites Area: Line: **Extra High Voltage cables in vicinity**

Date Requested: 24/06/2022  
 Job Reference: 25881037  
 Site Location: 448662 213014  
 Requested by: Mr Joe Shawyer  
 Your Scheme/Reference: 31188\_003

**Voltages (V)**

LV (Low Voltage) and Services	Up to 1,000V		
HV (High Voltage)	Over 1,000V to 11,000V		
EHV (Extra High Voltage)	22,000V to 132,000V		
Transmission	275,000V and 400,000V		

**NORMAL DEPTH TO THE TOP OF THE CABLE WHEN LAID**

Services	LV	HV	EHV
Footpath/Unmade	0.45m	0.45m	0.6m
Road Crossing	0.6m	0.6m	0.75m
Agricultural	1m	1m	1.1m

**Legend**

- Service Cable
- LV Mains
- 2 - 11kV
- 66kV
- 11kV
- 22kV
- 33kV
- 66kV
- 132kV
- 275kV
- 400kV
- Fibre Optic
- Pipe Cable

**Distribution Structures (Electric)**

- Pole, Existing Location
- Pole Structure, Existing Location - Single
- Pole Structure, Existing Location - H
- Duct Route
- Cross Section Route

**WARNING**

There may have been subsequent alteration to the surface levels. Trial holes must be undertaken to determine position and depths of cables. HS (G) 47 Booklet from the Health and Safety Executive - Avoiding Danger from Buried Cables - should be consulted before commencing excavation work.

**WHEN WORKING IN THE VICINITY OF OVERHEAD LINES THE HEALTH AND SAFETY GUIDANCE NOTES G56 SHOULD BE CONSULTED (AVAILABLE FROM THE HSE WEBSITE)**

**Southern Electric Power Distribution plc**  
 Registered Office: No.1 Forbury Place  
 43 Forbury Road Reading RG1 3JH  
 Registered In England & Wales No.04094290

If you're unsure & need to seek advice before commencing excavations, please contact:  
 General Enquiries: 0800 048 3516

Subject to revision - Master held by SSEN Asset Data Team:  
[Asset.Data@sse.com](mailto:Asset.Data@sse.com)  
 01256 337 294

Warning: PDF designed for A4 colour print only with no page scaling

0  20m Dig Sites Area:  Line: 

**Extra High Voltage  
cables in vicinity**



Date Requested: 24/06/2022  
 Job Reference: 25881037  
 Site Location: 448662 213014  
 Requested by: Mr Joe Shawyer  
 Your Scheme/Reference: 31188\_003

Voltages (V)			
LV (Low Voltage) and Services	Up to 1,000V		
HV (High Voltage)	Over 1,000V to 11,000V		
EHV (Extra High Voltage)	22,000V to 132,000V		
Transmission	275,000V and 400,000V		
NORMAL DEPTH TO THE TOP OF THE CABLE WHEN LAID			
Services	LV	HV	EHV
Footpath/Unmade	0.45m	0.45m	0.6m 0.8m
Road Crossing	0.6m	0.6m	0.75m 0.9m
Agricultural	1m	1m	1m 1.1m

**Legend**

- Service Cable
- LV Mains
- 2 - 11kV
- 66kV
- 11kV
- 22kV
- 33kV
- 66kV
- 132kV
- 275kV
- 400kV
- Fibre Optic
- Pipit Cable

**Distribution Structures (Electric)**

- Pole, Existing Location
- Pole Structure, Existing Location - Single
- Pole Structure, Existing Location - H
- Duct Route
- Cross Section Route

WARNING

There may have been subsequent alteration to the surface levels. Trial holes must be undertaken to determine position and depths of cables. HS (G) 47 Booklet from the Health and Safety Executive - Avoiding Danger from Buried Cables - should be consulted before commencing excavation work.

WHEN WORKING IN THE VICINITY OF OVERHEAD LINES THE HEALTH AND SAFETY GUIDANCE NOTES G56 SHOULD BE CONSULTED (AVAILABLE FROM THE HSE WEBSITE)

**Southern Electric Power Distribution plc**  
 Registered Office: No.1 Forbury Place  
 43 Forbury Road Reading RG1 3JH  
 Registered In England & Wales No.04094290

If you're unsure & need to seek advice before commencing excavations, please contact:  
 General Enquiries: 0800 048 3516

Subject to revision - Master held by SSEN Asset Data Team:  
[Asset.Data@sse.com](mailto:Asset.Data@sse.com)  
 01256 337 294

Scale: 1:500 (When plotted at A4)

52

Warning: PDF designed for A4 colour print only with no page scaling

0  20m Dig Sites Area:  Line: 

**Extra High Voltage  
cables in vicinity**



Date Requested: 24/06/2022  
 Job Reference: 25881037  
 Site Location: 448662 213014  
 Requested by: Mr Joe Shawyer  
 Your Scheme/Reference: 31188\_003

Voltages (V)			
LV (Low Voltage) and Services	Up to 1,000V		
HV (High Voltage)	Over 1,000V to 11,000V		
EHV (Extra High Voltage)	22,000V to 132,000V		
Transmission	275,000V and 400,000V		
NORMAL DEPTH TO THE TOP OF THE CABLE WHEN LAID			
Services	LV	HV	EHV
Footpath/Unmade	0.45m	0.45m	0.6m
Road Crossing	0.6m	0.6m	0.75m
Agricultural	1m	1m	1.1m

Legend	
	Service Cable
	LV Mains
	2 - 11kV
	66kV
	11kV
	22kV
	33kV
	66kV
	132kV
	275kV
	400kV
	Fibre Optic
	Pipe Cable

Distribution Structures (Electric)	
	Pole, Existing Location
	Pole Structure, Existing Location - Single
	Pole Structure, Existing Location - H
	Duct Route
	Cross Section Route

**Southern Electric Power Distribution plc**  
 Registered Office: No.1 Forbury Place  
 43 Forbury Road Reading RG1 3JH  
 Registered In England & Wales No.04094290

If you're unsure & need to seek advice before commencing excavations, please contact:  
 General Enquiries: 0800 048 3516

Subject to revision - Master held by SSEN Asset Data Team:  
[Asset.Data@sse.com](mailto:Asset.Data@sse.com)  
 01256 337 294

Scale: 1:500 (When plotted at A4)

**WARNING**  
 There may have been subsequent alteration to the surface levels. Trial holes must be undertaken to determine position and depths of cables. HS (G) 47 Booklet from the Health and Safety Executive - Avoiding Danger from Buried Cables - should be consulted before commencing excavation work.  
**WHEN WORKING IN THE VICINITY OF OVERHEAD LINES THE HEALTH AND SAFETY GUIDANCE NOTES G56 SHOULD BE CONSULTED (AVAILABLE FROM THE HSE WEBSITE)**

53

Warning: PDF designed for A4 colour print only with no page scaling

0  20m Dig Sites Area:  Line: 

**Extra High Voltage  
cables in vicinity**



Date Requested: 24/06/2022  
Job Reference: 25881037  
Site Location: 448662 213014  
Requested by: Mr Joe Shawyer

Your Scheme/Reference: 31188\_003

Voltages (V)			
LV (Low Voltage) and Services	Up to 1,000V		
HV (High Voltage)	Over 1,000V to 11,000V		
EHV (Extra High Voltage)	22,000V to 132,000V		
Transmission	275,000V and 400,000V		
NORMAL DEPTH TO THE TOP OF THE CABLE WHEN LAID			
Services	LV	HV	EHV
Footpath/Unmade	0.45m	0.45m	0.6m 0.8m
Road Crossing	0.6m	0.6m	0.75m 0.9m
Agricultural	1m	1m	1m 1.1m

Legend	
	Service Cable
	LV Mains
	2 - 11kV
	66kV
	11kV
	22kV
	33kV
	66kV
	132kV
	275kV
	400kV
	Fibre Optic
	Pipe Cable

Distribution Structures (Electric)	
	Pole, Existing Location
	Pole Structure, Existing Location - Single
	Pole Structure, Existing Location - H
	Duct Route
	Cross Section Route

**WARNING**

There may have been subsequent alteration to the surface levels. Trial holes must be undertaken to determine position and depths of cables. HS (G) 47 Booklet from the Health and Safety Executive - Avoiding Danger from Buried Cables - should be consulted before commencing excavation work.

WHEN WORKING IN THE VICINITY OF OVERHEAD LINES THE HEALTH AND SAFETY GUIDANCE NOTES G56 SHOULD BE CONSULTED (AVAILABLE FROM THE HSE WEBSITE)


**Southern Electric Power Distribution plc**  
Registered Office: No.1 Forbury Place  
43 Forbury Road Reading RG1 3JH  
Registered In England & Wales No.04094290

If you're unsure & need to seek advice before commencing excavations, please contact:  
General Enquiries: 0800 048 3516

Subject to revision - Master held by SSEN Asset Data Team:  
[Asset.Data@sse.com](mailto:Asset.Data@sse.com)  
01256 337 294

Scale: 1:500 (When plotted at A4)

54

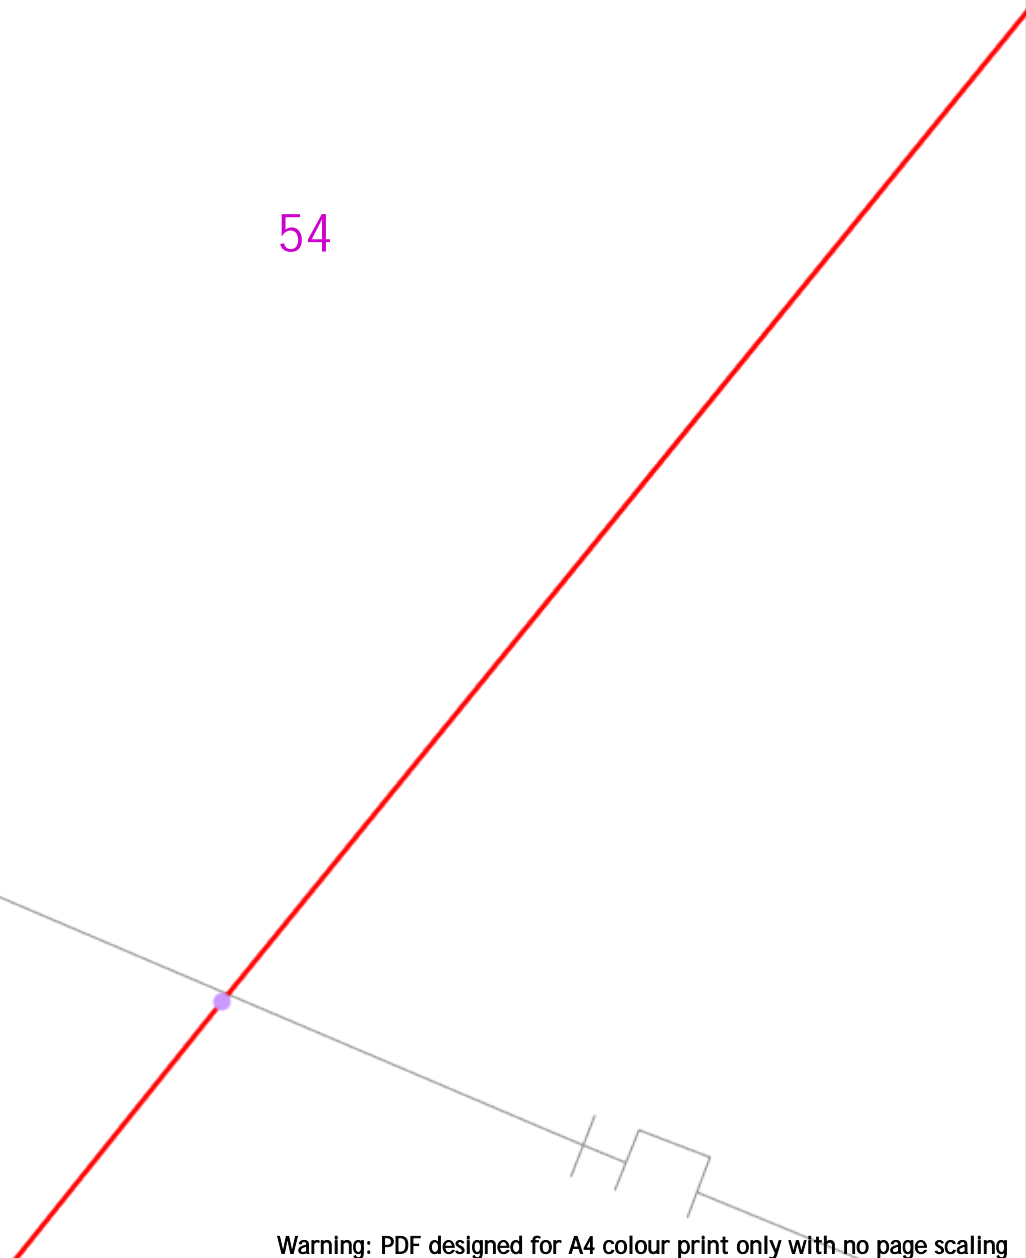

Warning: PDF designed for A4 colour print only with no page scaling



20m Dig Sites Area: [dashed purple box] Line: [dashed purple line]

**Extra High Voltage cables in vicinity**



Date Requested: 24/06/2022  
 Job Reference: 25881037  
 Site Location: 448662 213014  
 Requested by: Mr Joe Shawyer  
 Your Scheme/Reference: 31188\_003

Voltages (V)			
LV (Low Voltage) and Services	Up to 1,000V		
HV (High Voltage)	Over 1,000V to 11,000V		
EHV (Extra High Voltage)	22,000V to 132,000V		
Transmission	275,000V and 400,000V		
NORMAL DEPTH TO THE TOP OF THE CABLE WHEN LAID			
Services	LV	HV	EHV
Footpath/Unmade	0.45m	0.45m	0.6m
Road Crossing	0.6m	0.6m	0.75m
Agricultural	1m	1m	1.1m

Legend	
[Yellow line]	Service Cable
[Red line]	LV Mains
[Green line]	2 - 11kV
[Blue line]	66kV
[Light Purple line]	275kV
[Light Orange line]	400kV
[Light Yellow line]	Fibre Optic
[Light Red line]	Pipe Cable

Distribution Structures (Electric)	
[Purple dot]	Pole, Existing Location
[Purple dot]	Pole Structure, Existing Location - Single
[Purple dot]	Pole Structure, Existing Location - H
[Purple line]	Duct Route
[Purple line]	Cross Section Route


**Southern Electric Power Distribution plc**  
 Registered Office: No.1 Forbury Place  
 43 Forbury Road Reading RG1 3JH  
 Registered In England & Wales No.04094290

If you're unsure & need to seek advice before commencing excavations, please contact:  
 General Enquiries: 0800 048 3516

Subject to revision - Master held by SSEN Asset Data Team:  
[Asset.Data@sse.com](mailto:Asset.Data@sse.com)  
 01256 337 294

Scale: 1:500 (When plotted at A4)

**WARNING**  
 There may have been subsequent alteration to the surface levels. Trial holes must be undertaken to determine position and depths of cables. HS (G) 47 Booklet from the Health and Safety Executive - Avoiding Danger from Buried Cables - should be consulted before commencing excavation work.  
**WHEN WORKING IN THE VICINITY OF OVERHEAD LINES THE HEALTH AND SAFETY GUIDANCE NOTES G56 SHOULD BE CONSULTED (AVAILABLE FROM THE HSE WEBSITE)**

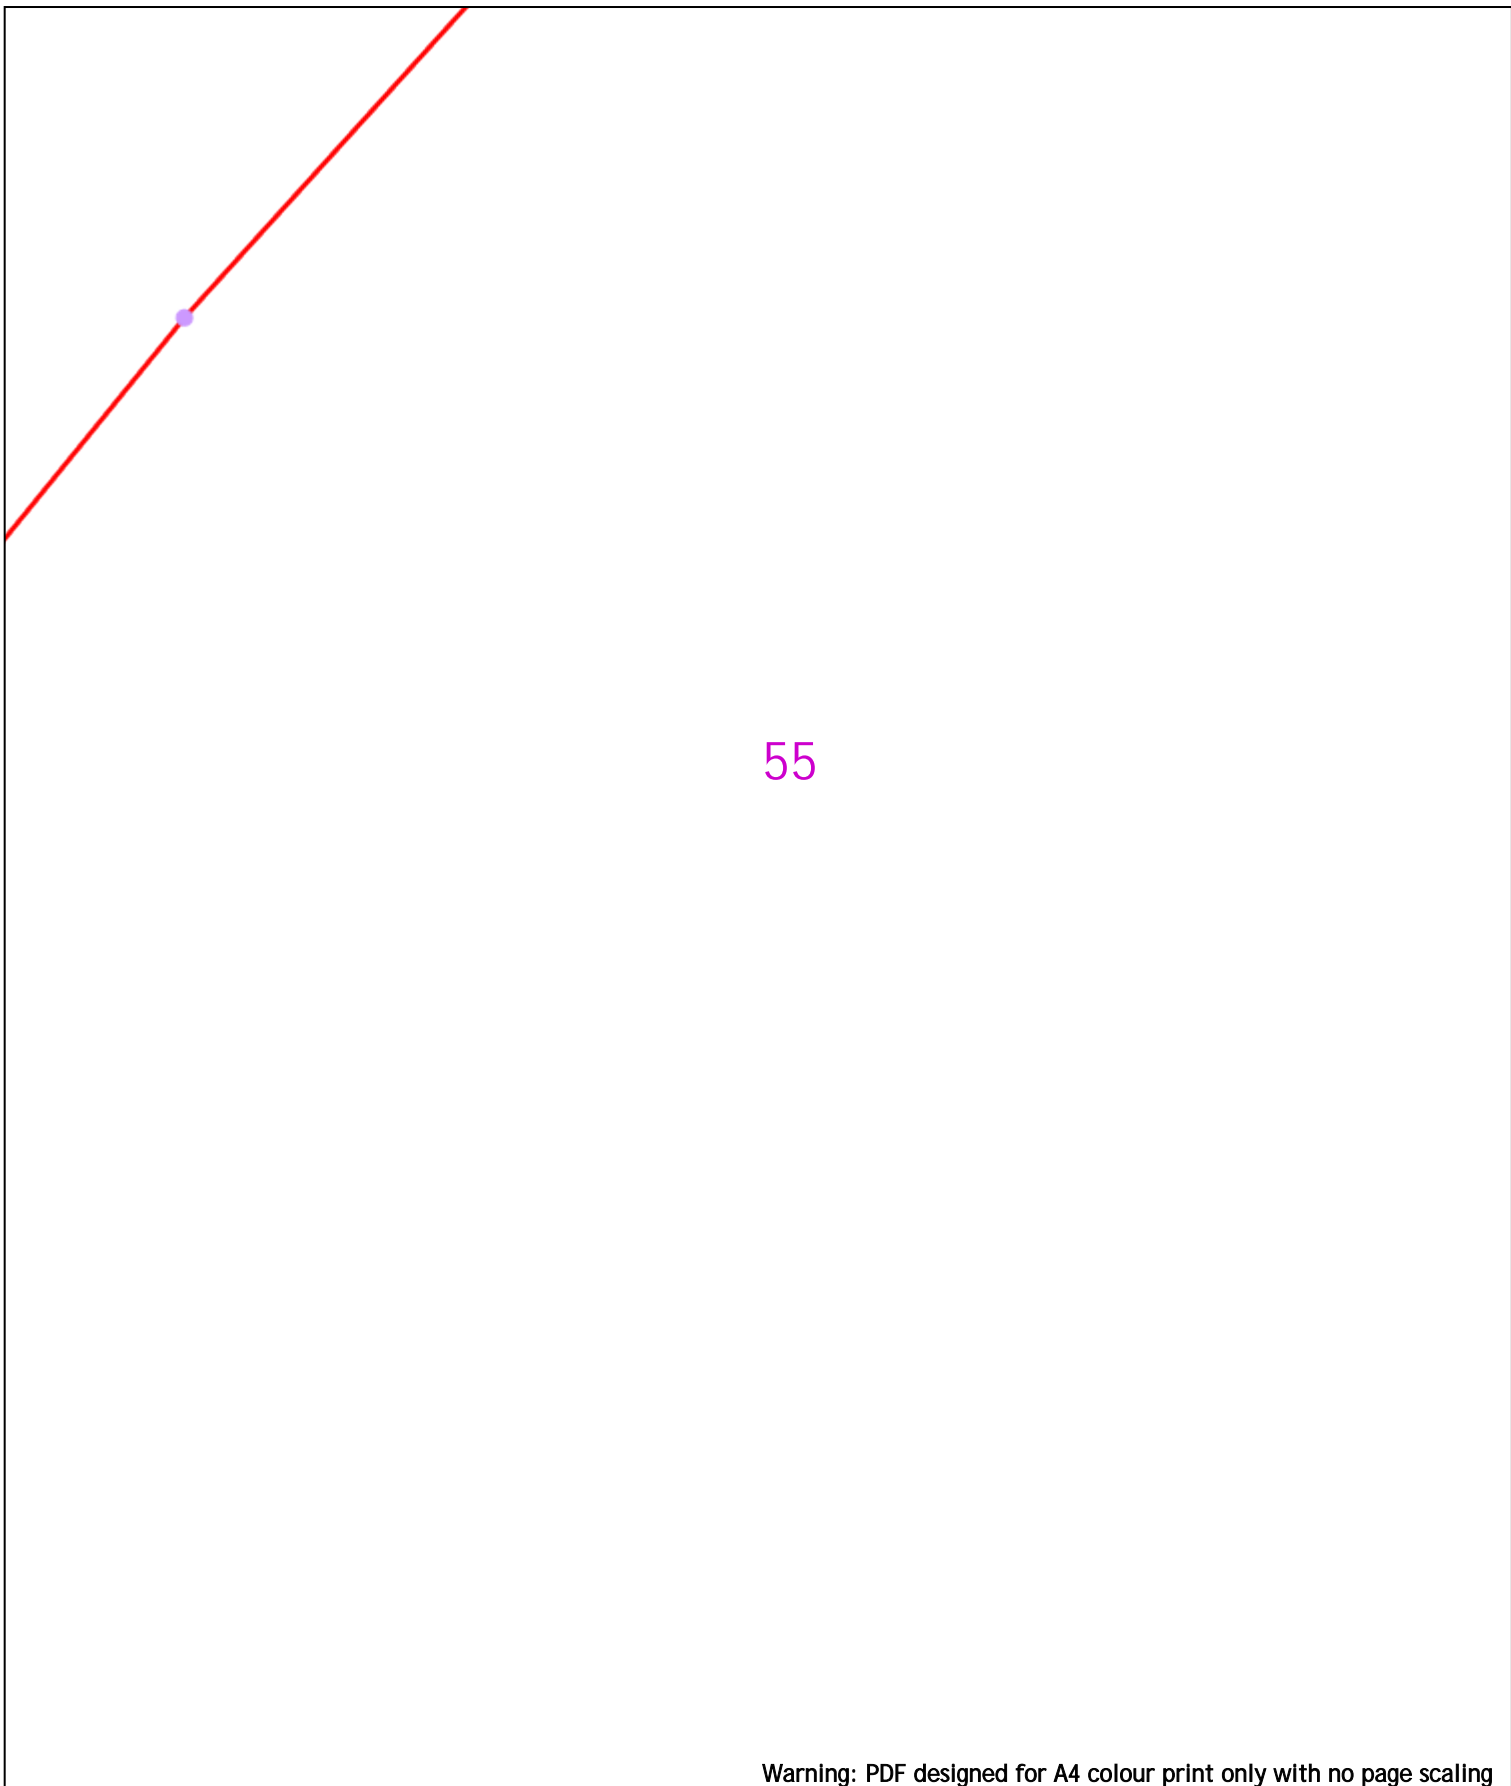

55

Warning: PDF designed for A4 colour print only with no page scaling



20m Dig Sites Area: [Dashed Purple Box] Line: [Dashed Purple Line]

**Extra High Voltage cables in vicinity**



Date Requested: 24/06/2022  
 Job Reference: 25881037  
 Site Location: 448662 213014  
 Requested by: Mr Joe Shawyer  
 Your Scheme/Reference: 31188\_003

Voltages (V)			
LV (Low Voltage) and Services	Up to 1,000V		
HV (High Voltage)	Over 1,000V to 11,000V		
EHV (Extra High Voltage)	22,000V to 132,000V		
Transmission	275,000V and 400,000V		
NORMAL DEPTH TO THE TOP OF THE CABLE WHEN LAID			
Services	LV	HV	EHV
Footpath/Unmade	0.45m	0.45m	0.6m
Road Crossing	0.6m	0.6m	0.75m
Agricultural	1m	1m	1.1m

**Legend**

- Service Cable
- LV Mains
- 2 - 11kV
- 66kV
- 11kV
- 22kV
- 33kV
- 66kV
- 132kV
- 275kV
- 400kV
- Fibre Optic
- Pipe Cable

**Distribution Structures (Electric)**


- Pole, Existing Location
- Pole Structure, Existing Location - Single
- Pole Structure, Existing Location - H
- Duct Route
- Cross Section Route

**WARNING**  
 There may have been subsequent alteration to the surface levels. Trial holes must be undertaken to determine position and depths of cables. HS (G) 47 Booklet from the Health and Safety Executive - Avoiding Danger from Buried Cables - should be consulted before commencing excavation work.  
**WHEN WORKING IN THE VICINITY OF OVERHEAD LINES THE HEALTH AND SAFETY GUIDANCE NOTES G56 SHOULD BE CONSULTED (AVAILABLE FROM THE HSE WEBSITE)**

**Southern Electric Power Distribution plc**  
 Registered Office: No.1 Forbury Place  
 43 Forbury Road Reading RG1 3JH  
 Registered In England & Wales No.04094290

If you're unsure & need to seek advice before commencing excavations, please contact:  
 General Enquiries: 0800 048 3516

Subject to revision - Master held by SSEN Asset Data Team:  
[Asset.Data@sse.com](mailto:Asset.Data@sse.com)  
 01256 337 294

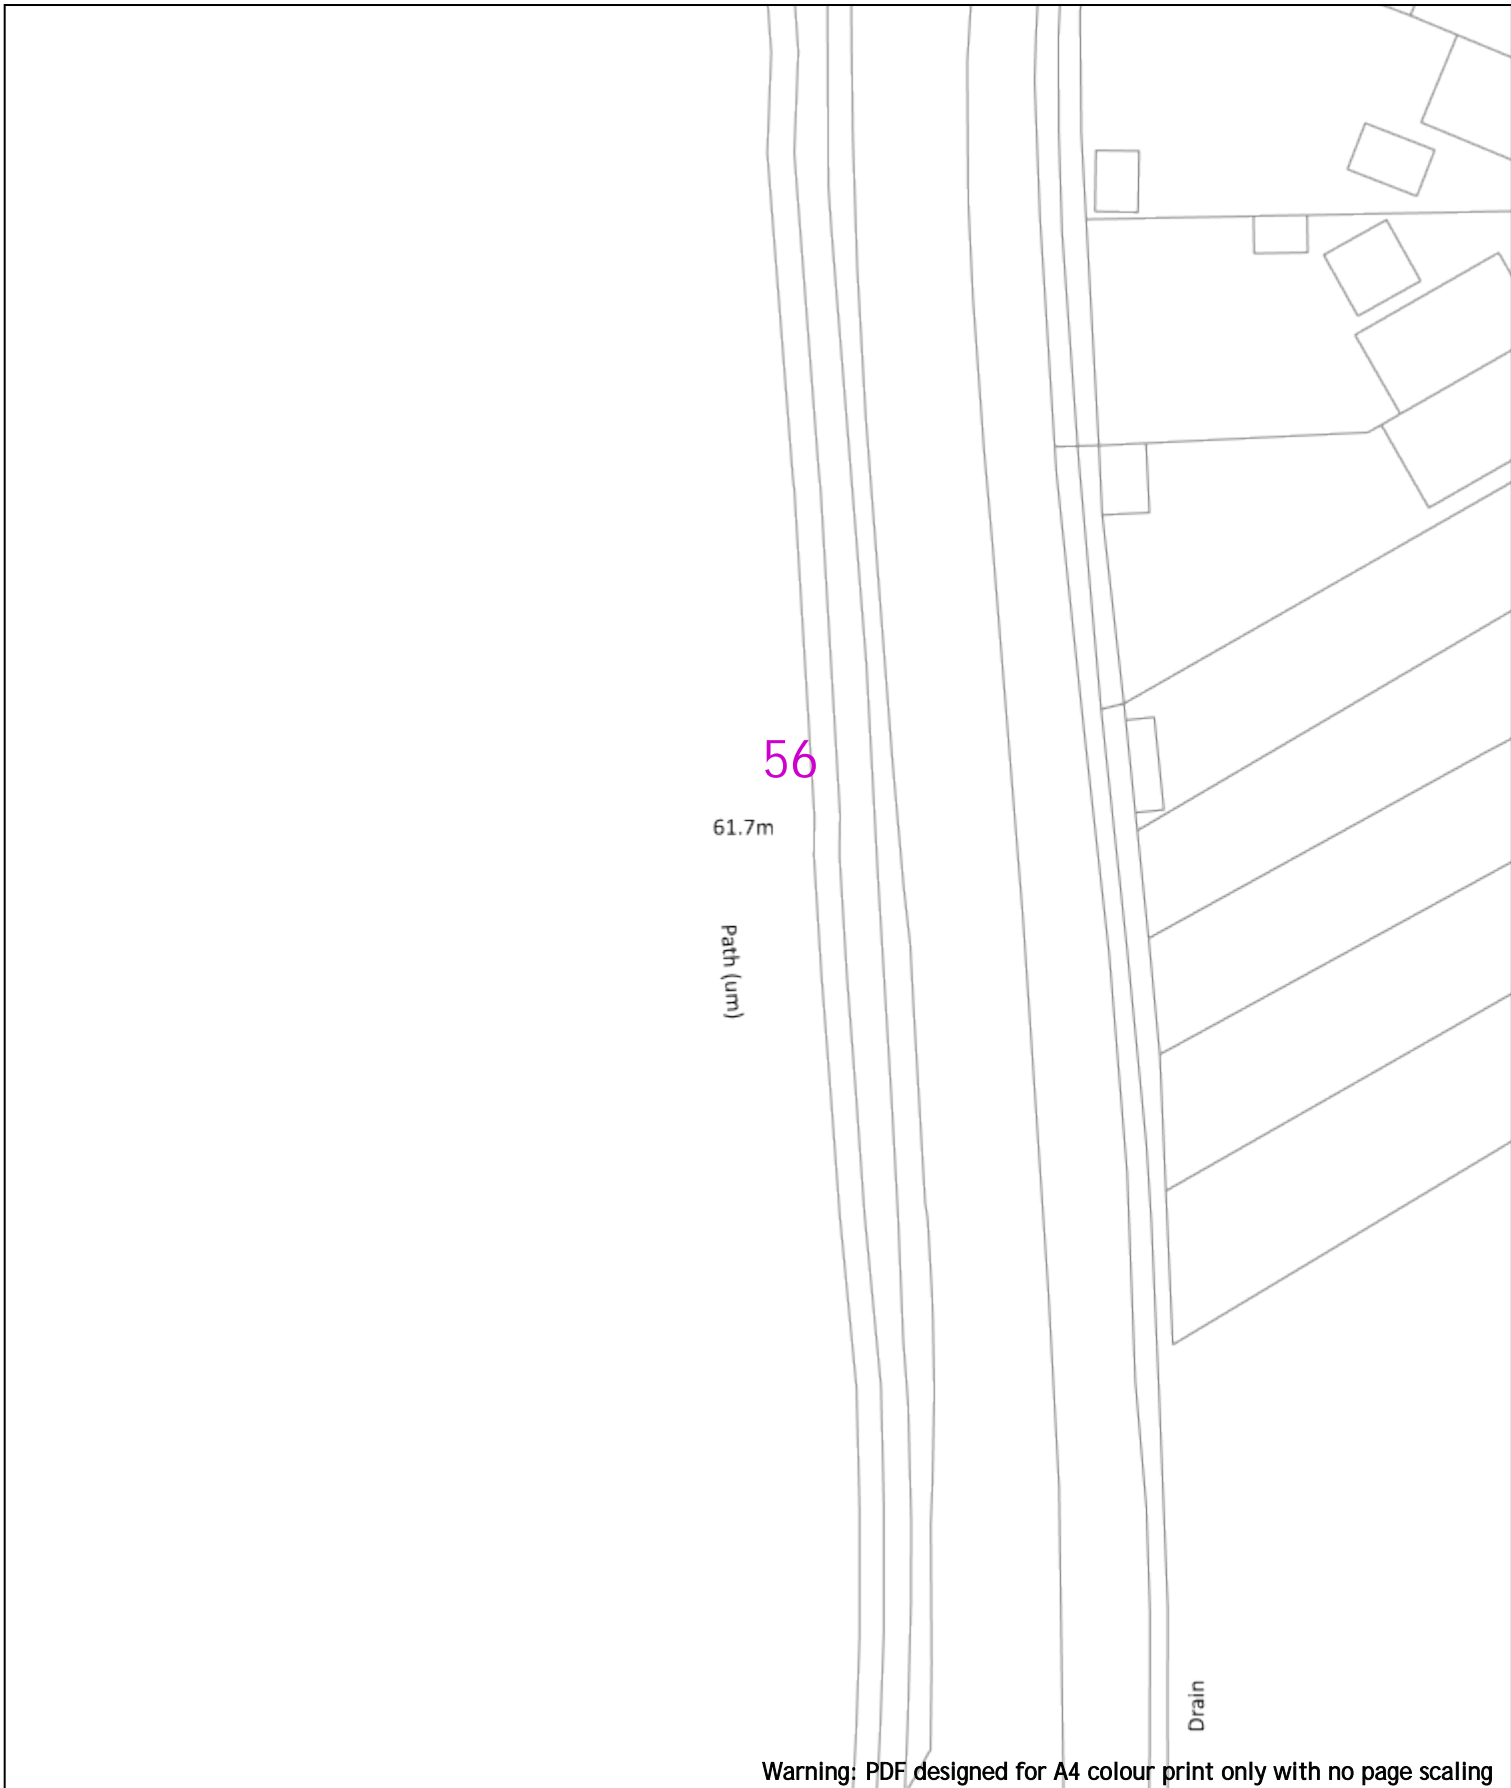

0 20m Dig Sites Area: Line: **Extra High Voltage cables in vicinity**

Voltages (V)				
LV (Low Voltage) and Services	Up to 1,000V			
HV (High Voltage)	Over 1,000V to 11,000V			
EHV (Extra High Voltage)	22,000V to 132,000V			
Transmission	275,000V and 400,000V			

NORMAL DEPTH TO THE TOP OF THE CABLE WHEN LAID				
Services	LV	HV	EHV	
Footpath/Unmade	0.45m	0.45m	0.6m	0.8m
Road Crossing	0.6m	0.6m	0.75m	0.9m
Agricultural	1m	1m	1m	1.1m

Legend		Distribution Structures (Electric)	
	Service Cable		Pole, Existing Location
	LV Mains		Pole Structure, Existing Location - Single
	66kV		Pole Structure, Existing Location - H
	11kV		Duct Route
	22kV		Cross Section Route
	33kV		
	66kV		
	132kV		
	275kV		
	400kV		
	Fibre Optic		
	Pipe Cable		

**WARNING**  
 There may have been subsequent alteration to the surface levels. Trial holes must be undertaken to determine position and depths of cables. HS (G) 47 Booklet from the Health and Safety Executive - Avoiding Danger from Buried Cables - should be consulted before commencing excavation work.  
**WHEN WORKING IN THE VICINITY OF OVERHEAD LINES THE HEALTH AND SAFETY GUIDANCE NOTES G56 SHOULD BE CONSULTED (AVAILABLE FROM THE HSE WEBSITE)**

**Southern Electric Power Distribution plc**  
 Registered Office: No.1 Forbury Place  
 43 Forbury Road Reading RG1 3JH  
 Registered In England & Wales No.04094290


If you're unsure & need to seek advice before commencing excavations, please contact:  
 General Enquiries: 0800 048 3516

Subject to revision - Master held by SSEN Asset Data Team:  
[Asset.Data@sse.com](mailto:Asset.Data@sse.com)  
 01256 337 294

Date Requested: 24/06/2022  
 Job Reference: 25881037  
 Site Location: 448662 213014  
 Requested by: Mr Joe Shawyer  
 Your Scheme/Reference: 31188\_003

Scale: 1:500 (When plotted at A4)

Based upon the Ordnance Survey map with the sanction of the Controller of Her Majesty's Stationery Office Crown Copyright Reserved.  
 This copy has been made by or with the authority of Scottish and Southern Energy Power Distribution Ltd. Pursuant to section 47 of the Copyright, Designs and Patents Act 1988 ("The Act"). Unless the Act provides a relevant exception to copyright the copy must not be copied without prior permission of the copyright owner.  
 Plans generated by DigSAFE Pro™ software provided by LinesearchbeforeUdig.

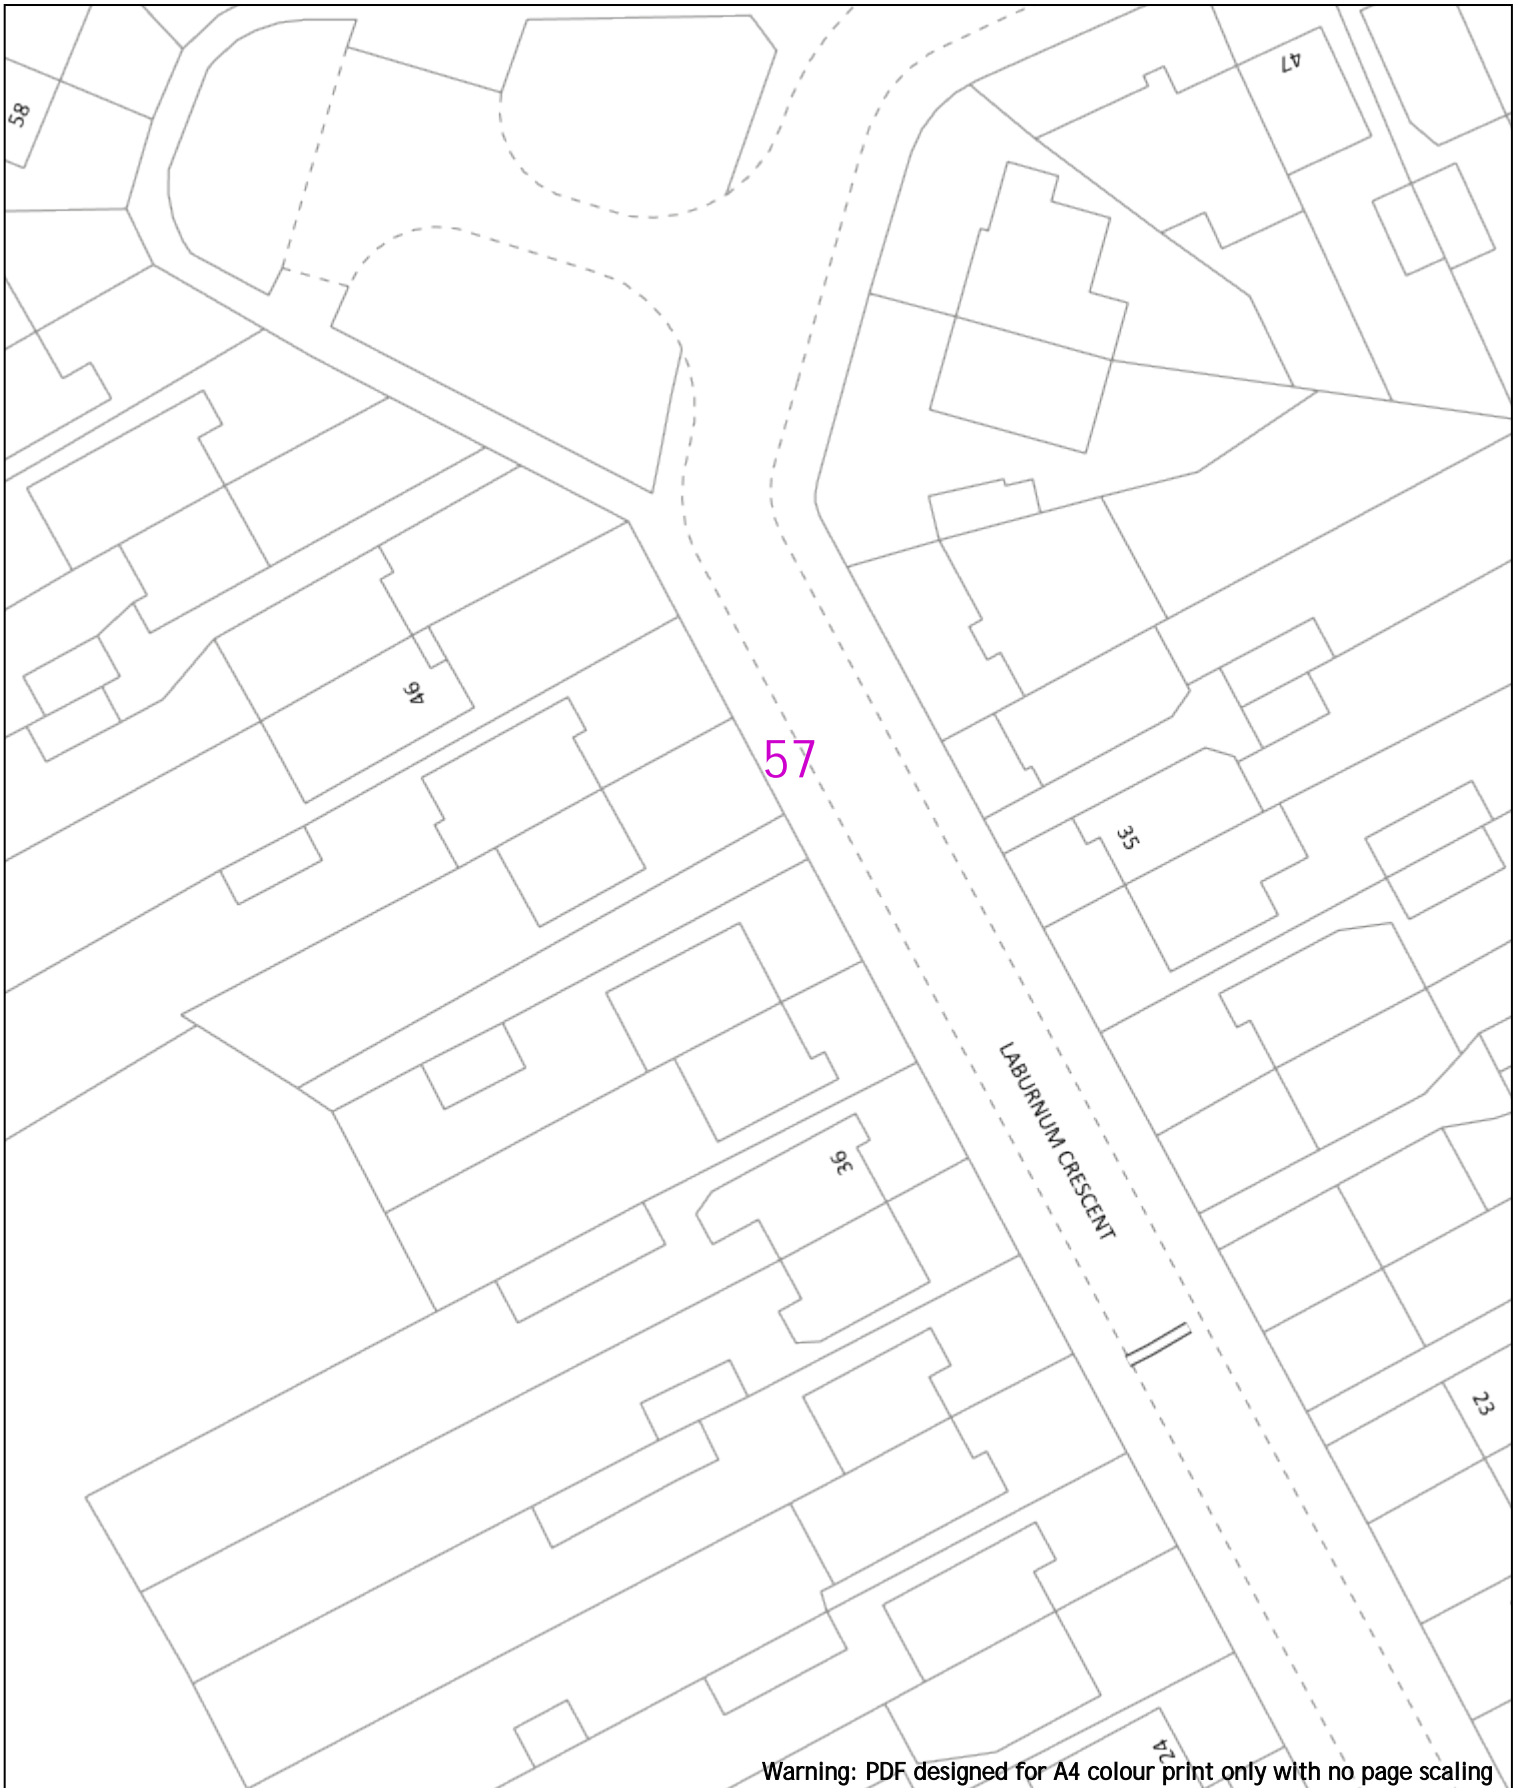

Warning: PDF designed for A4 colour print only with no page scaling


<p>0  20m Dig Sites Area:  Line:  <b>Extra High Voltage cables in vicinity</b></p>	
<p>Date Requested: 24/06/2022          Job Reference: 25881037          Site Location: 448662 213014          Requested by: Mr Joe Shawyer          Your Scheme/Reference: 31188_003</p>	<table border="1"> <thead> <tr> <th colspan="4">Voltages (V)</th> </tr> </thead> <tbody> <tr> <td>LV (Low Voltage) and Services</td> <td colspan="3">Up to 1,000V</td> </tr> <tr> <td>HV (High Voltage)</td> <td colspan="3">Over 1,000V to 11,000V</td> </tr> <tr> <td>EHV (Extra High Voltage)</td> <td colspan="3">22,000V to 132,000V</td> </tr> <tr> <td>Transmission</td> <td colspan="3">275,000V and 400,000V</td> </tr> </tbody> </table> <table border="1"> <thead> <tr> <th colspan="4">NORMAL DEPTH TO THE TOP OF THE CABLE WHEN LAID</th> </tr> <tr> <th>Services</th> <th>LV</th> <th>HV</th> <th>EHV</th> </tr> </thead> <tbody> <tr> <td>Footpath/Unmade</td> <td>0.45m</td> <td>0.45m</td> <td>0.6m</td> </tr> <tr> <td>Road Crossing</td> <td>0.6m</td> <td>0.6m</td> <td>0.75m</td> </tr> <tr> <td>Agricultural</td> <td>1m</td> <td>1m</td> <td>1.1m</td> </tr> </tbody> </table> <table border="1"> <thead> <tr> <th colspan="2">Legend</th> </tr> </thead> <tbody> <tr><td></td><td>Service Cable</td></tr> <tr><td></td><td>LV Mains</td></tr> <tr><td></td><td>2 - 11kV</td></tr> <tr><td></td><td>66kV</td></tr> <tr><td></td><td>11kV</td></tr> <tr><td></td><td>22kV</td></tr> <tr><td></td><td>33kV</td></tr> <tr><td></td><td>66kV</td></tr> <tr><td></td><td>132kV</td></tr> <tr><td></td><td>275kV</td></tr> <tr><td></td><td>400kV</td></tr> <tr><td></td><td>Fibre Optic</td></tr> <tr><td></td><td>Pilot Cable</td></tr> </tbody> </table> <table border="1"> <thead> <tr> <th colspan="2">Distribution Structures (Electric)</th> </tr> </thead> <tbody> <tr><td></td><td>Pole, Existing Location</td></tr> <tr><td></td><td>Pole Structure, Existing Location - Single</td></tr> <tr><td></td><td>Pole Structure, Existing Location - H</td></tr> <tr><td></td><td>Duct Route</td></tr> <tr><td></td><td>Cross Section Route</td></tr> </tbody> </table> <p><b>WARNING</b>          There may have been subsequent alteration to the surface levels. Trial holes must be undertaken to determine position and depths of cables. HS (G) 47 Booklet from the Health and Safety Executive - Avoiding Danger from Buried Cables - should be consulted before commencing excavation work.  <b>WHEN WORKING IN THE VICINITY OF OVERHEAD LINES THE HEALTH AND SAFETY GUIDANCE NOTES G56 SHOULD BE CONSULTED (AVAILABLE FROM THE HSE WEBSITE)</b></p>	Voltages (V)				LV (Low Voltage) and Services	Up to 1,000V			HV (High Voltage)	Over 1,000V to 11,000V			EHV (Extra High Voltage)	22,000V to 132,000V			Transmission	275,000V and 400,000V			NORMAL DEPTH TO THE TOP OF THE CABLE WHEN LAID				Services	LV	HV	EHV	Footpath/Unmade	0.45m	0.45m	0.6m	Road Crossing	0.6m	0.6m	0.75m	Agricultural	1m	1m	1.1m	Legend			Service Cable		LV Mains		2 - 11kV		66kV		11kV		22kV		33kV		66kV		132kV		275kV		400kV		Fibre Optic		Pilot Cable	Distribution Structures (Electric)			Pole, Existing Location		Pole Structure, Existing Location - Single		Pole Structure, Existing Location - H		Duct Route		Cross Section Route
Voltages (V)	
LV (Low Voltage) and Services	Up to 1,000V	
HV (High Voltage)	Over 1,000V to 11,000V	
EHV (Extra High Voltage)	22,000V to 132,000V	
Transmission	275,000V and 400,000V	
NORMAL DEPTH TO THE TOP OF THE CABLE WHEN LAID	
Services	LV	HV	EHV	
Footpath/Unmade	0.45m	0.45m	0.6m	
Road Crossing	0.6m	0.6m	0.75m	
Agricultural	1m	1m	1.1m	
Legend	
	Service Cable	
	LV Mains	
	2 - 11kV	
	66kV	
	11kV	
	22kV	
	33kV	
	66kV	
	132kV	
	275kV	
	400kV	
	Fibre Optic	
	Pilot Cable	
Distribution Structures (Electric)	
	Pole, Existing Location	
	Pole Structure, Existing Location - Single	
	Pole Structure, Existing Location - H	
	Duct Route	
	Cross Section Route	
<p>Scale: 1:500 (When plotted at A4)</p>	<p>BASED UPON THE ORDNANCE SURVEY MAP WITH THE SANCTION OF THE CONTROLLER OF HM STATIONERY OFFICE CROWN COPYRIGHT RESERVED.          This copy has been made by or with the authority of Scottish and Southern Energy Power Distribution Ltd. Pursuant to section 47 of the Copyright, Designs and Patents Act 1988 ("The Act"). Unless the Act provides a relevant exception to copyright the copy must not be copied without prior permission of the copyright owner.          Plans generated by DigSAFE Pro™ software provided by LinesearchbeforeDig.</p>	
<p><b>Southern Electric Power Distribution plc</b>          Registered Office: No.1 Forbury Place          43 Forbury Road Reading RG1 3JH          Registered In England &amp; Wales No.04094290</p> <p>If you're unsure &amp; need to seek advice before commencing excavations, please contact:          General Enquiries: 0800 048 3516</p> <p>Subject to revision - Master held by SSEN Asset Data Team:  <a href="mailto:Asset.Data@sse.com">Asset.Data@sse.com</a>          01256 337 294</p>	





Warning: PDF designed for A4 colour print only with no page scaling

<p>0  20m</p> <p>Date Requested: 24/06/2022          Job Reference: 25881037          Site Location: 448662 213014          Requested by: Mr Joe Shawyer          Your Scheme/Reference: 31188_003</p>	<p>Dig Sites Area:  Line: </p> <p style="text-align: center; background-color: red; color: white; padding: 2px;"><b>Extra High Voltage cables in vicinity</b></p>	<p></p> <p><b>Legend</b></p> <p>Service Cable</p> <p>LV Mains</p> <p>6kV</p> <p>11kV</p> <p>22kV</p> <p>33kV</p> <p>66kV</p> <p>132kV</p> <p>275kV</p> <p>400kV</p> <p>Fibre Optic</p> <p>Pilot Cable</p> <p><b>Distribution Structures (Electric)</b></p> <p>Pole, Existing Location</p> <p>Pole Structure, Existing Location - Single</p> <p>Pole Structure, Existing Location - H</p> <p>Duct Route</p> <p>Cross Section Route</p>	<p> <b>Scottish &amp; Southern Electricity Networks</b></p> <p style="text-align: center;"><b>Southern Electric Power Distribution plc</b>          Registered Office: No.1 Forbury Place          43 Forbury Road Reading RG1 3JH          Registered In England &amp; Wales No.04094290</p> <p>If you're unsure &amp; need to seek advice before commencing excavations, please contact:          General Enquiries: 0800 048 3516</p> <p>Subject to revision – Master held by SSEN Asset Data Team:  <a href="mailto:Asset.Data@sse.com">Asset.Data@sse.com</a>          01256 337 294</p>																								
<p>Scale: 1:500 (When plotted at A4)</p>		<p><b>Voltages (V)</b></p> <table border="1" style="width: 100%; border-collapse: collapse;"> <tr> <td>LV (Low Voltage) and Services</td> <td>Up to 1,000V</td> </tr> <tr> <td>HV (High Voltage)</td> <td>Over 1,000V to 11,000V</td> </tr> <tr> <td>EHV (Extra High Voltage)</td> <td>22,000V to 132,000V</td> </tr> <tr> <td>Transmission</td> <td>275,000V and 400,000V</td> </tr> </table> <p><b>NORMAL DEPTH TO THE TOP OF THE CABLE WHEN LAID</b></p> <table border="1" style="width: 100%; border-collapse: collapse;"> <thead> <tr> <th>Services</th> <th>LV</th> <th>HV</th> <th>EHV</th> </tr> </thead> <tbody> <tr> <td>Footpath/Unmade</td> <td>0.45m</td> <td>0.45m</td> <td>0.6m</td> </tr> <tr> <td>Road Crossing</td> <td>0.6m</td> <td>0.6m</td> <td>0.75m</td> </tr> <tr> <td>Agricultural</td> <td>1m</td> <td>1m</td> <td>1.1m</td> </tr> </tbody> </table> <p style="text-align: center; color: red; font-weight: bold; font-size: small;">WARNING</p> <p style="text-align: center; color: red; font-size: x-small;">There may have been subsequent alteration to the surface levels. Trial holes must be undertaken to determine position and depths of cables. HS (G) 47 Booklet from the Health and Safety Executive – Avoiding Danger from Buried Cables – should be consulted before commencing excavation work.</p> <p style="text-align: center; color: red; font-size: x-small;">WHEN WORKING IN THE VICINITY OF OVERHEAD LINES THE HEALTH AND SAFETY GUIDANCE NOTES G56 SHOULD BE CONSULTED (AVAILABLE FROM THE HSE WEBSITE)</p>		LV (Low Voltage) and Services	Up to 1,000V	HV (High Voltage)	Over 1,000V to 11,000V	EHV (Extra High Voltage)	22,000V to 132,000V	Transmission	275,000V and 400,000V	Services	LV	HV	EHV	Footpath/Unmade	0.45m	0.45m	0.6m	Road Crossing	0.6m	0.6m	0.75m	Agricultural	1m	1m	1.1m
LV (Low Voltage) and Services	Up to 1,000V																										
HV (High Voltage)	Over 1,000V to 11,000V																										
EHV (Extra High Voltage)	22,000V to 132,000V																										
Transmission	275,000V and 400,000V																										
Services	LV	HV	EHV																								
Footpath/Unmade	0.45m	0.45m	0.6m																								
Road Crossing	0.6m	0.6m	0.75m																								
Agricultural	1m	1m	1.1m																								
<p>BASED UPON THE ORDNANCE SURVEY MAP WITH THE SANCTION OF THE CONTROLLER OF HM STATIONERY OFFICE CROWN COPYRIGHT RESERVED.</p> <p>This copy has been made by or with the authority of Scottish and Southern Energy Power Distribution Ltd. Pursuant to section 47 of the Copyright, Designs and Patents Act 1988 ("The Act"). Unless the Act provides a relevant exception to copyright the copy must not be copied without prior permission of the copyright owner.</p> <p>Plans generated by DigSAFE Pro™ software provided by Lineworkbefore066.</p>																											

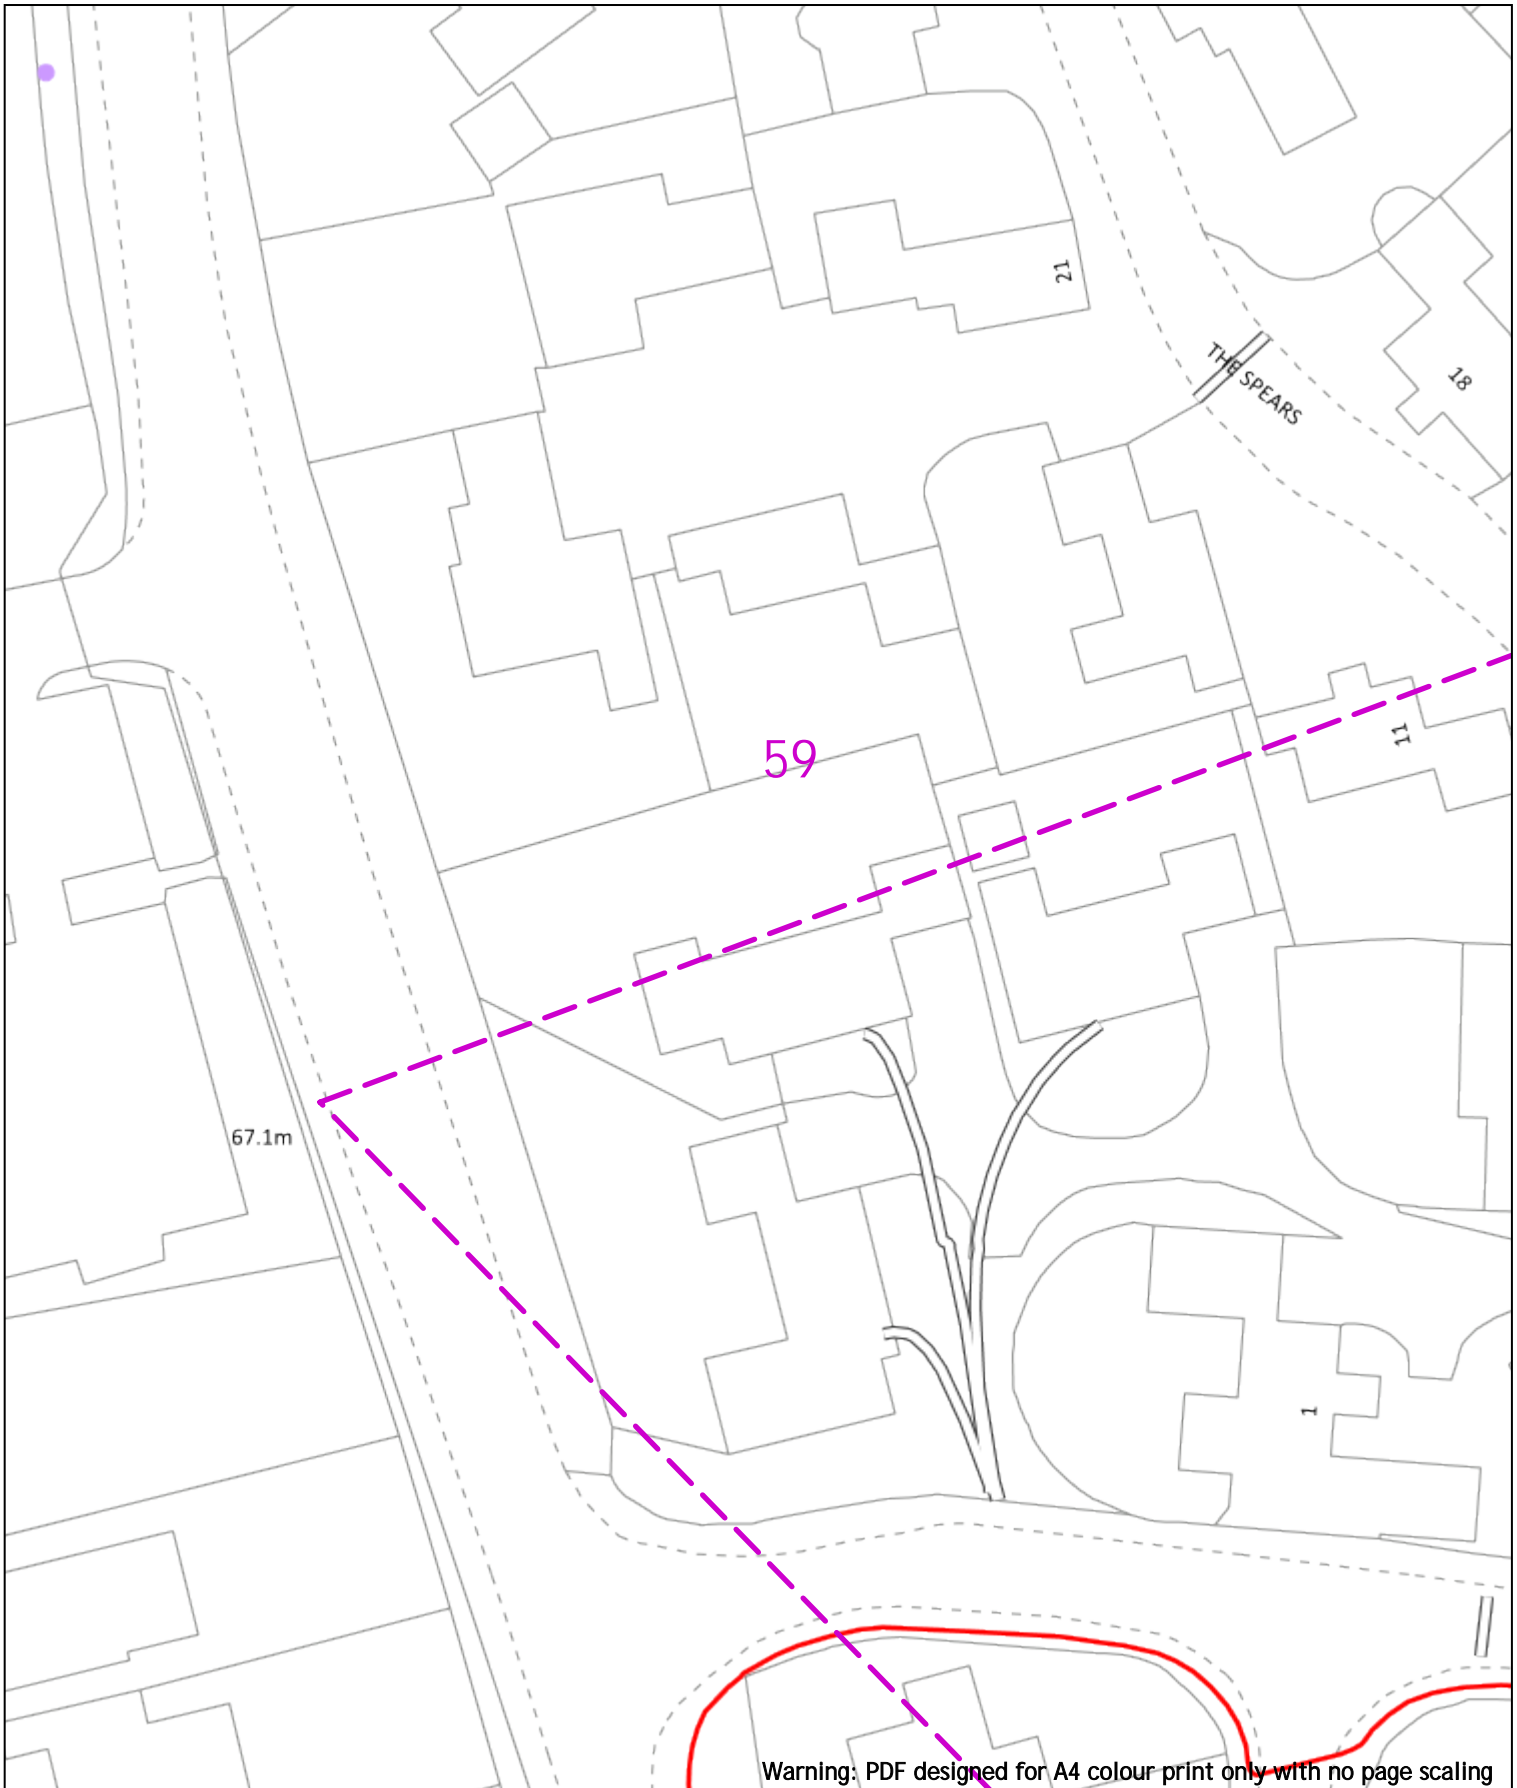

0 20m Dig Sites Area: Line: **Extra High Voltage cables in vicinity**

Date Requested: 24/06/2022  
 Job Reference: 25881037  
 Site Location: 448662 213014  
 Requested by: Mr Joe Shawyer  
 Your Scheme/Reference: 31188\_003

Voltages (V)				
LV (Low Voltage) and Services	Up to 1,000V			
HV (High Voltage)	Over 1,000V to 11,000V			
EHV (Extra High Voltage)	22,000V to 132,000V			
Transmission	275,000V and 400,000V			
NORMAL DEPTH TO THE TOP OF THE CABLE WHEN LAID				
Services	LV	HV	EHV	

Legend		Distribution Structures (Electric)	
	Service Cable		Pole, Existing Location
	LV Mains		Pole Structure, Existing Location - Single
	6.6kV		Pole Structure, Existing Location - H
	11kV		Duct Route
	22kV		Cross Section Route
	33kV		
	66kV		
	132kV		
	275kV		
	400kV		
	Fibre Optic		
	Pilot Cable		

**WARNING**  
 There may have been subsequent alteration to the surface levels. Trial holes must be undertaken to determine position and depths of cables. HS (G) 47 Booklet from the Health and Safety Executive - Avoiding Danger from Buried Cables - should be consulted before commencing excavation work.  
**WHEN WORKING IN THE VICINITY OF OVERHEAD LINES THE HEALTH AND SAFETY GUIDANCE NOTES G56 SHOULD BE CONSULTED (AVAILABLE FROM THE HSE WEBSITE)**


Scale: 1:500 (When plotted at A4)

**Southern Electric Power Distribution plc**  
 Registered Office: No.1 Forbury Place  
 43 Forbury Road Reading RG1 3JH  
 Registered In England & Wales No.04094290

If you're unsure & need to seek advice before commencing excavations, please contact:  
 General Enquiries: 0800 048 3516

Subject to revision - Master held by SSEN Asset Data Team:  
[Asset.Data@sse.com](mailto:Asset.Data@sse.com)  
 01256 337 294

BASED UPON THE ORDNANCE SURVEY MAP WITH THE SANCTION OF THE CONTROLLER OF HM STATIONERY OFFICE CROWN COPYRIGHT RESERVED.  
 This copy has been made by or with the authority of Scottish and Southern Energy Power Distribution Ltd. Pursuant to section 47 of the Copyright, Designs and Patents Act 1988 ('The Act'). Unless the Act provides a relevant exception to copyright the copy must not be copied without prior permission of the copyright owner.  
 Plans generated by DigSAFE Pro™ software provided by Linesearchbeforedig.

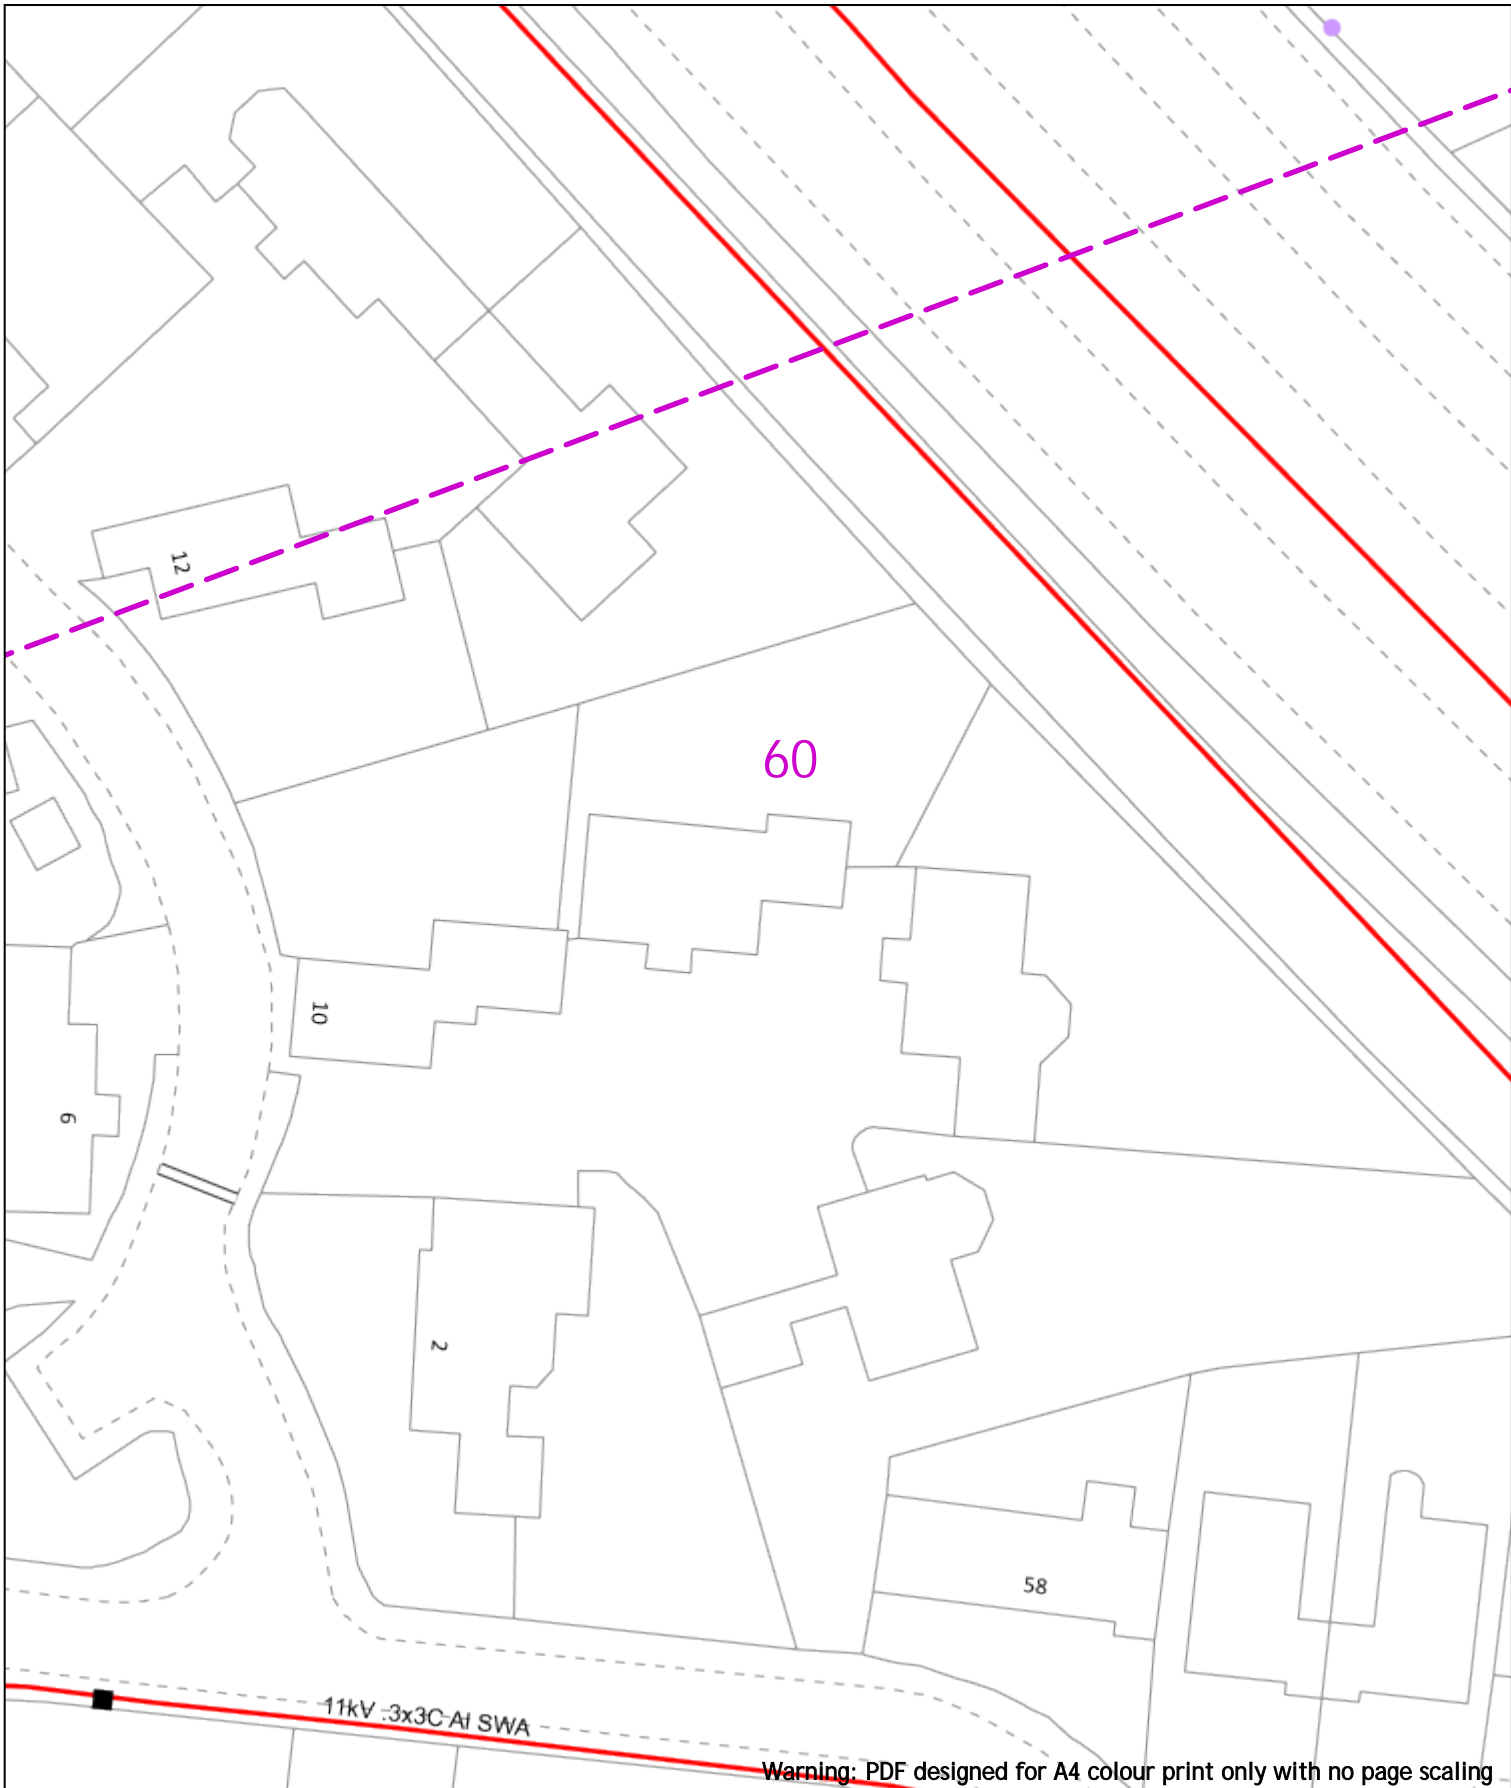

Warning: PDF designed for A4 colour print only with no page scaling

0 20m Dig Sites Area: Line: **Extra High Voltage cables in vicinity**

Date Requested: 24/06/2022  
 Job Reference: 25881037  
 Site Location: 448662 213014  
 Requested by: Mr Joe Shawyer  
 Your Scheme/Reference: 31188\_003

Voltages (V)			
LV (Low Voltage) and Services	Up to 1,000V		
HV (High Voltage)	Over 1,000V to 11,000V		
EHV (Extra High Voltage)	22,000V to 132,000V		
Transmission	275,000V and 400,000V		
NORMAL DEPTH TO THE TOP OF THE CABLE WHEN LAID			
Services	LV	HV	EHV
Footpath/Unmade	0.45m	0.45m	0.6m
Road Crossing	0.6m	0.6m	0.75m
Agricultural	1m	1m	1.1m

Legend	
	Service Cable
	LV Mains
	2 - 11kV
	66kV
	11kV
	22kV
	33kV
	66kV
	132kV
	275kV
	400kV
	Fibre Optic
	Pipe Cable

Distribution Structures (Electric)	
	Pole, Existing Location
	Pole Structure, Existing Location - Single
	Pole Structure, Existing Location - H
	Duct Route
	Cross Section Route


Scale: 1:500 (When plotted at A4)

**WARNING**  
 There may have been subsequent alteration to the surface levels. Trial holes must be undertaken to determine position and depths of cables. HS (G) 47 Booklet from the Health and Safety Executive - Avoiding Danger from Buried Cables - should be consulted before commencing excavation work.  
 WHEN WORKING IN THE VICINITY OF OVERHEAD LINES THE HEALTH AND SAFETY GUIDANCE NOTES G56 SHOULD BE CONSULTED (AVAILABLE FROM THE HSE WEBSITE)

**Southern Electric Power Distribution plc**  
 Registered Office: No.1 Forbury Place  
 43 Forbury Road Reading RG1 3JH  
 Registered In England & Wales No.04094290

If you're unsure & need to seek advice before commencing excavations, please contact:  
 General Enquiries: 0800 048 3516

Subject to revision - Master held by SSEN Asset Data Team:  
[Asset.Data@sse.com](mailto:Asset.Data@sse.com)  
 01256 337 294

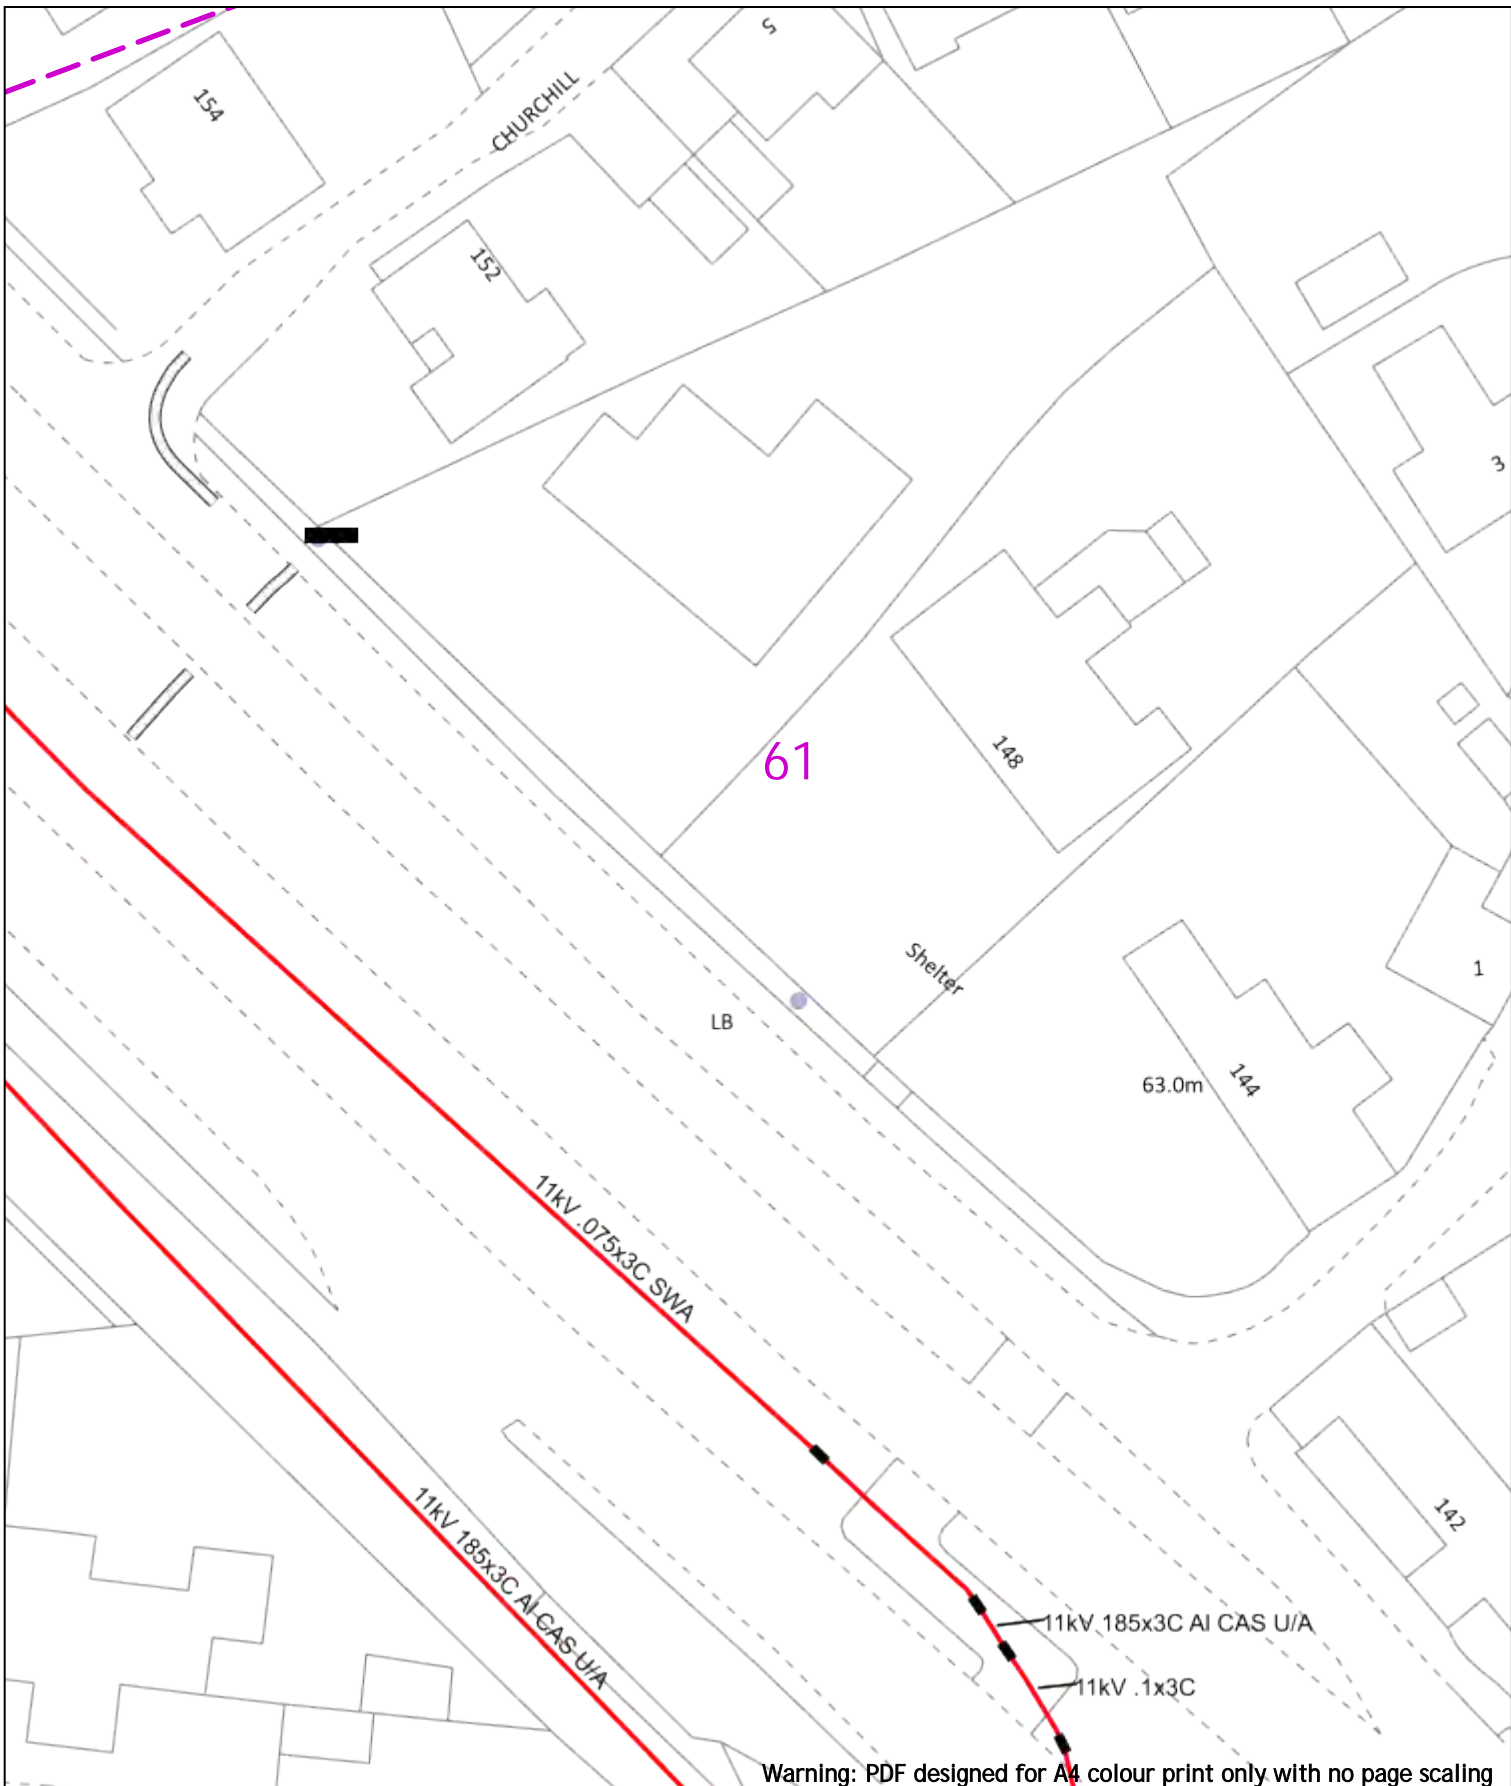

Warning: PDF designed for A4 colour print only with no page scaling



20m Dig Sites Area: [Dashed Purple Box] Line: [Dashed Purple Line]

**Extra High Voltage cables in vicinity**



Date Requested: 24/06/2022  
 Job Reference: 25881037  
 Site Location: 448662 213014  
 Requested by: Mr Joe Shawyer  
 Your Scheme/Reference: 31188\_003

Voltages (V)			
LV (Low Voltage) and Services	Up to 1,000V		
HV (High Voltage)	Over 1,000V to 11,000V		
EHV (Extra High Voltage)	22,000V to 132,000V		
Transmission	275,000V and 400,000V		
NORMAL DEPTH TO THE TOP OF THE CABLE WHEN LAID			
Services	LV	HV	EHV
Footpath/Unmade	0.45m	0.45m	0.6m
Road Crossing	0.6m	0.6m	0.75m
Agricultural	1m	1m	1.1m

Legend	
[Red Line]	Service Cable
[Blue Line]	LV Mains
[Green Line]	7 - 11kV
[Orange Line]	6.6kV
[Yellow Line]	11kV
[Light Blue Line]	22kV
[Light Green Line]	33kV
[Light Orange Line]	66kV
[Light Yellow Line]	132kV
[Light Blue Line]	275kV
[Light Green Line]	400kV
[Light Orange Line]	Fibre Optic
[Light Yellow Line]	Pipe Cable

Distribution Structures (Electric)	
[Purple Circle]	Pole, Existing Location
[Purple Square]	Pole Structure, Existing Location - Single
[Purple Triangle]	Pole Structure, Existing Location - H
[Blue Line]	Duct Route
[Red Line]	Cross Section Route

**Southern Electric Power Distribution plc**  
 Registered Office: No.1 Forbury Place  
 43 Forbury Road Reading RG1 3JH  
 Registered In England & Wales No.04094290

If you're unsure & need to seek advice before commencing excavations, please contact:  
 General Enquiries: 0800 048 3516

Scale: 1:500 (When plotted at A4)


**WARNING**  
 There may have been subsequent alteration to the surface levels. Trial holes must be undertaken to determine position and depths of cables. HS (G) 47 Booklet from the Health and Safety Executive - Avoiding Danger from Buried Cables - should be consulted before commencing excavation work.  
**WHEN WORKING IN THE VICINITY OF OVERHEAD LINES THE HEALTH AND SAFETY GUIDANCE NOTES G56 SHOULD BE CONSULTED (AVAILABLE FROM THE HSE WEBSITE)**

Subject to revision - Master held by SSEN Asset Data Team:  
[Asset.Data@sse.com](mailto:Asset.Data@sse.com)  
 01256 337 294



Warning: PDF designed for A4 colour print only with no page scaling

<p>0  20m</p>	<p>Dig Sites Area:  Line: </p>	<p><b>Extra High Voltage cables in vicinity</b></p>																																	
<p>Date Requested: 24/06/2022          Job Reference: 25881037          Site Location: 448662 213014          Requested by: Mr Joe Shawyer          Your Scheme/Reference: 31188_003</p>	<p><b>Voltages (V)</b></p> <table border="1" style="width: 100%; border-collapse: collapse;"> <tr> <td>LV (Low Voltage) and Services</td> <td colspan="3">Up to 1,000V</td> </tr> <tr> <td>HV (High Voltage)</td> <td colspan="3">Over 1,000V to 11,000V</td> </tr> <tr> <td>EHV (Extra High Voltage)</td> <td colspan="3">22,000V to 132,000V</td> </tr> <tr> <td>Transmission</td> <td colspan="3">275,000V and 400,000V</td> </tr> </table> <p><b>NORMAL DEPTH TO THE TOP OF THE CABLE WHEN LAID</b></p> <table border="1" style="width: 100%; border-collapse: collapse;"> <thead> <tr> <th>Services</th> <th>LV</th> <th>HV</th> <th>EHV</th> </tr> </thead> <tbody> <tr> <td>Footpath/Unmade</td> <td>0.45m</td> <td>0.45m</td> <td>0.6m</td> </tr> <tr> <td>Road Crossing</td> <td>0.6m</td> <td>0.6m</td> <td>0.75m</td> </tr> <tr> <td>Agricultural</td> <td>1m</td> <td>1m</td> <td>1.1m</td> </tr> </tbody> </table>	LV (Low Voltage) and Services	Up to 1,000V			HV (High Voltage)	Over 1,000V to 11,000V			EHV (Extra High Voltage)	22,000V to 132,000V			Transmission	275,000V and 400,000V			Services	LV	HV	EHV	Footpath/Unmade	0.45m	0.45m	0.6m	Road Crossing	0.6m	0.6m	0.75m	Agricultural	1m	1m	1.1m	<p><b>Legend</b></p> <ul style="list-style-type: none"> <li> Service Cable</li> <li> LV Mains</li> <li> 66kV</li> <li> 11kV</li> <li> 22kV</li> <li> 33kV</li> <li> 66kV</li> <li> 132kV</li> <li> 275kV</li> <li> 400kV</li> <li> Fibre Optic</li> <li> Pilot Cable</li> </ul> <p><b>Distribution Structures (Electric)</b></p> <ul style="list-style-type: none"> <li> Pole, Existing Location</li> <li> Pole Structure, Existing Location - Single</li> <li> Pole Structure, Existing Location - H</li> <li> Duct Route</li> <li> Cross Section Route</li> </ul>	<p><b>Southern Electric Power Distribution plc</b>          Registered Office: No.1 Forbury Place          43 Forbury Road Reading RG1 3JH          Registered In England &amp; Wales No.04094290</p> <p>If you're unsure &amp; need to seek advice before commencing excavations, please contact:          General Enquiries: 0800 048 3516</p> <p>Subject to revision – Master held by SSEN Asset Data Team:  <a href="mailto:Asset.Data@sse.com">Asset.Data@sse.com</a>          01256 337 294</p>
<p>Scale: 1:500 (When plotted at A4)</p> <p><b>WARNING</b>          There may have been subsequent alteration to the surface levels. Trial holes must be undertaken to determine position and depths of cables. HS (G) 47 Booklet from the Health and Safety Executive – Avoiding Danger from Buried Cables – should be consulted before commencing excavation work.  <b>WHEN WORKING IN THE VICINITY OF OVERHEAD LINES THE HEALTH AND SAFETY GUIDANCE NOTES G56 SHOULD BE CONSULTED (AVAILABLE FROM THE HSE WEBSITE)</b></p> <p style="font-size: x-small;">BASED UPON THE ORDNANCE SURVEY MAP WITH THE SANCTION OF THE CONTROLLER OF HM STATIONERY OFFICE CROWN COPYRIGHT RESERVED.          This copy has been made by or with the authority of Scottish and Southern Energy Power Distribution Ltd. Pursuant to section 47 of the Copyright, Designs and Patents Act 1988 ("The Act"). Unless the Act provides a relevant exception to copyright the copy must not be copied without prior permission of the copyright owner.          Plans generated by DigSAFE Pro™ software provided by LinesearchbeforeDig.</p>																																			

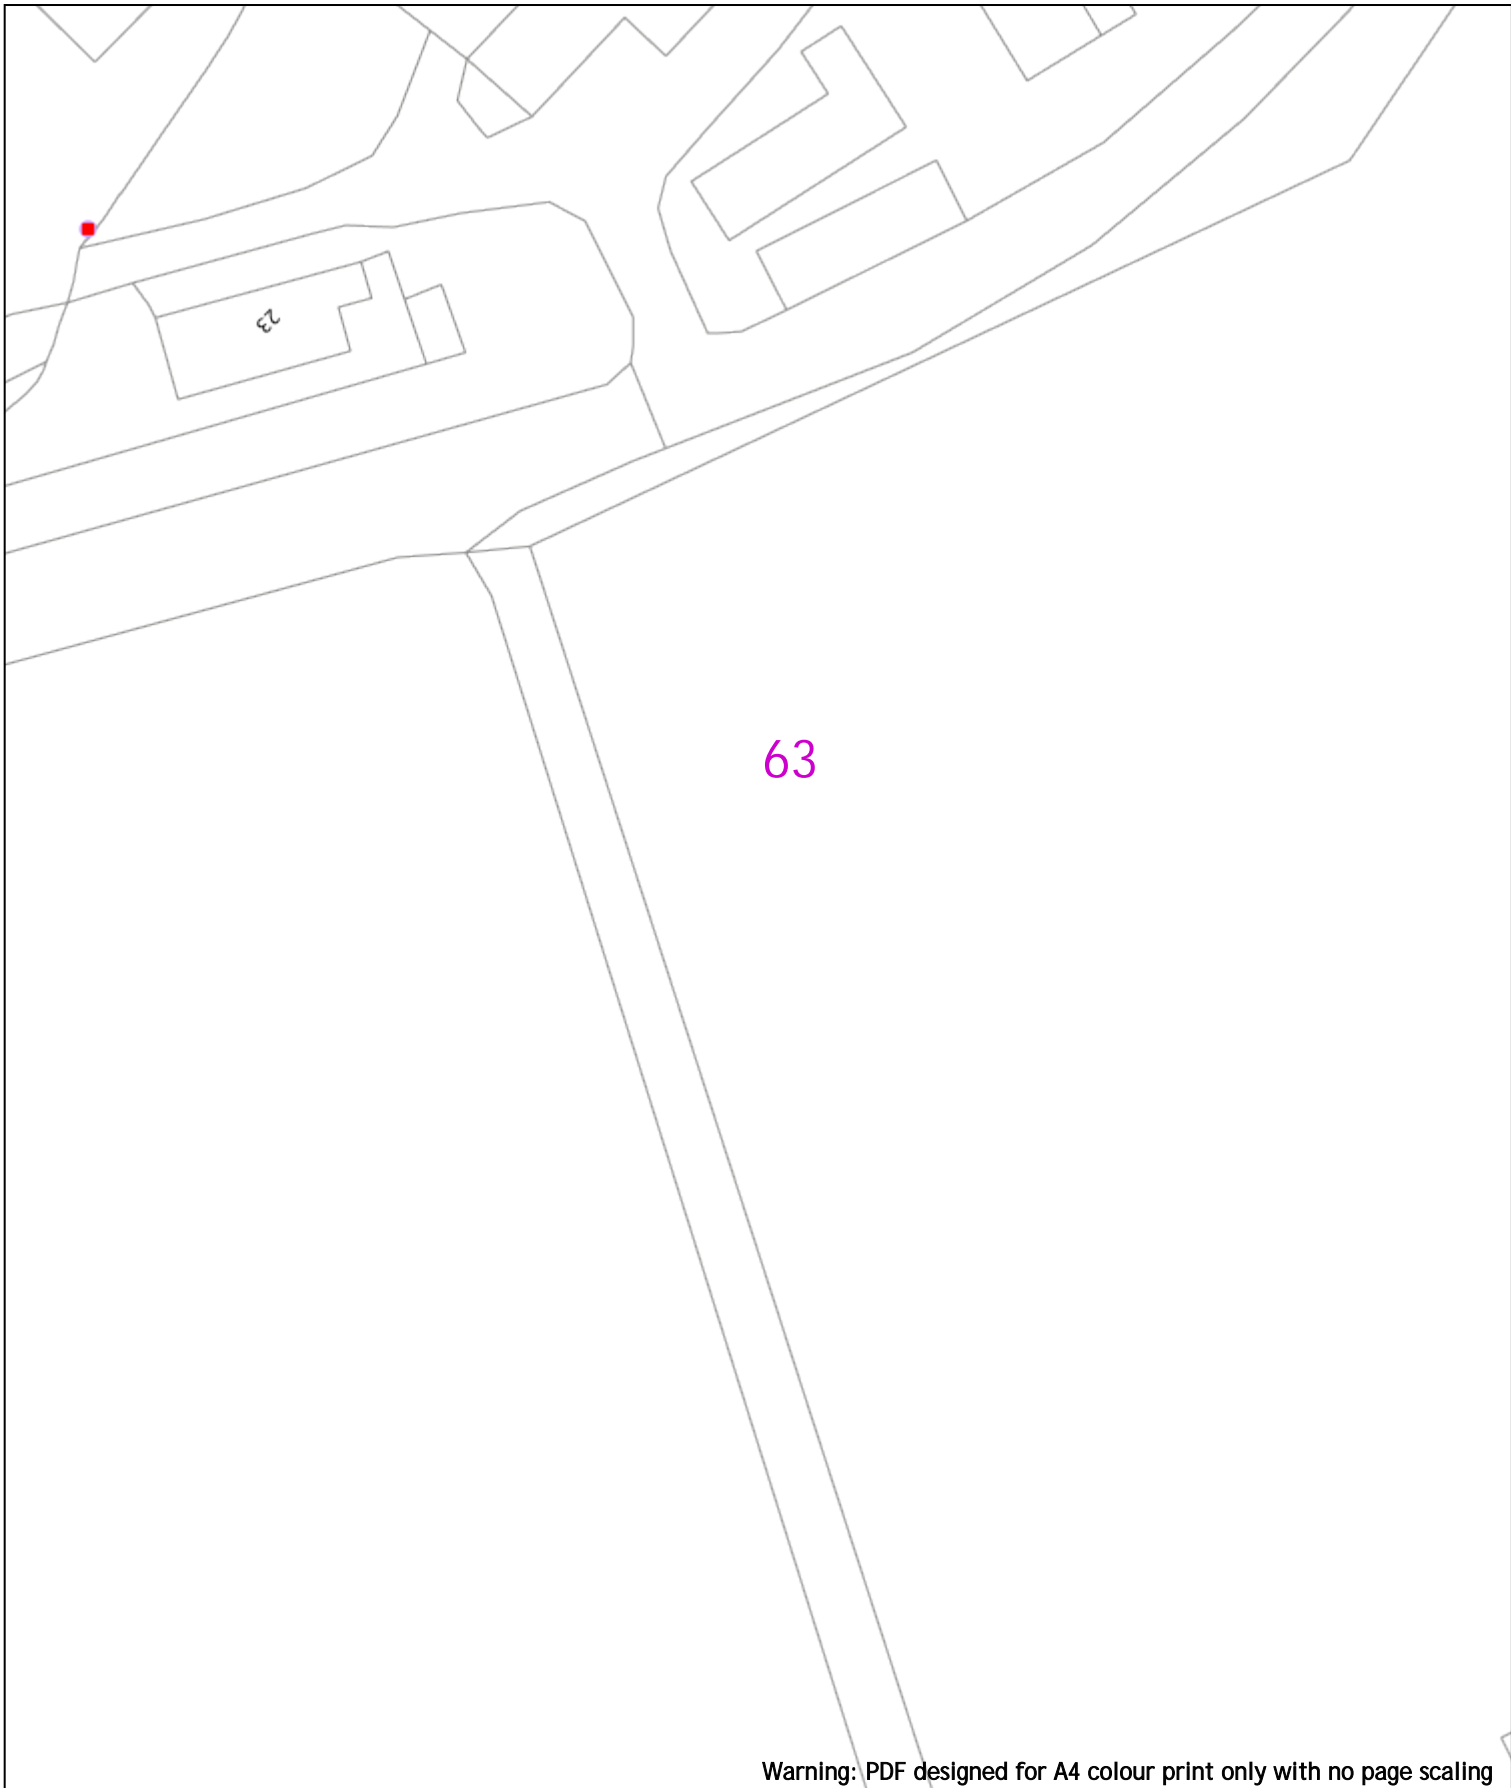

Warning: PDF designed for A4 colour print only with no page scaling

<p>0  20m Dig Sites Area:  Line: </p>	<p style="text-align: center;"><b>Extra High Voltage cables in vicinity</b></p>	
<p>Date Requested: 24/06/2022          Job Reference: 25881037          Site Location: 448662 213014          Requested by: Mr Joe Shawyer          Your Scheme/Reference: 31188_003</p>			<table border="1"> <thead> <tr> <th colspan="4">Voltages (V)</th> </tr> </thead> <tbody> <tr> <td>LV (Low Voltage) and Services</td> <td colspan="3">Up to 1,000V</td> </tr> <tr> <td>HV (High Voltage)</td> <td colspan="3">Over 1,000V to 11,000V</td> </tr> <tr> <td>EHV (Extra High Voltage)</td> <td colspan="3">22,000V to 132,000V</td> </tr> <tr> <td>Transmission</td> <td colspan="3">275,000V and 400,000V</td> </tr> <tr> <th colspan="4">NORMAL DEPTH TO THE TOP OF THE CABLE WHEN LAID</th> </tr> <tr> <td>Services</td> <td>LV</td> <td>HV</td> <td>EHV</td> </tr> <tr> <td>Footpath/Unmade</td> <td>0.45m</td> <td>0.45m</td> <td>0.6m 0.8m</td> </tr> <tr> <td>Road Crossing</td> <td>0.6m</td> <td>0.6m</td> <td>0.75m 0.9m</td> </tr> <tr> <td>Agricultural</td> <td>1m</td> <td>1m</td> <td>1m 1.1m</td> </tr> </tbody> </table> <p style="text-align: center;"><b>WARNING</b></p> <p>There may have been subsequent alteration to the surface levels. Trial holes must be undertaken to determine position and depths of cables. HS (G) 47 Booklet from the Health and Safety Executive – Avoiding Danger from Buried Cables – should be consulted before commencing excavation work.</p> <p><b>WHEN WORKING IN THE VICINITY OF OVERHEAD LINES THE HEALTH AND SAFETY GUIDANCE NOTES G56 SHOULD BE CONSULTED (AVAILABLE FROM THE HSE WEBSITE)</b></p>	Voltages (V)				LV (Low Voltage) and Services	Up to 1,000V			HV (High Voltage)	Over 1,000V 
Footpath/Unmade	0.45m	0.45m	0.6m 0.8m																																							
Road Crossing	0.6m	0.6m	0.75m 0.9m																																							
Agricultural	1m	1m	1m 1.1m																																							

BASED UPON THE ORDNANCE SURVEY MAP WITH THE SANCTION OF THE CONTROLLER OF HM STATIONERY OFFICE CROWN COPYRIGHT RESERVED.  
 This copy has been made by or with the authority of Scottish and Southern Energy Power Distribution Ltd. Pursuant to section 47 of the Copyright, Designs and Patents Act 1988 ("The Act"). Unless the Act provides a relevant exception to copyright the copy must not be copied without prior permission of the copyright owner.  
 Plans generated by DigSAFE Pro™ software provided by LinesearchbeforeUdig.

Warning: PDF designed for A4 colour print only with no page scaling

0 20m Dig Sites Area: Line:

**Extra High Voltage  
cables in vicinity**



Date Requested: 24/06/2022  
 Job Reference: 25881037  
 Site Location: 448662 213014  
 Requested by: Mr Joe Shawyer  
 Your Scheme/Reference: 31188\_003

Voltages (V)			
LV (Low Voltage) and Services	Up to 1,000V		
HV (High Voltage)	Over 1,000V to 11,000V		
EHV (Extra High Voltage)	22,000V to 132,000V		
Transmission	275,000V and 400,000V		
NORMAL DEPTH TO THE TOP OF THE CABLE WHEN LAID			
Services	LV	HV	EHV
Footpath/Unmade	0.45m	0.45m	0.6m 0.8m
Road Crossing	0.6m	0.6m	0.75m 0.9m
Agricultural	1m	1m	1m 1.1m

Legend	Distribution Structures (Electric)
Service Cable	Pole, Existing Location
LV Mains	Pole Structure, Existing Location - Single
2 - 11kV	Pole Structure, Existing Location - H
66kV	Duct Route
11kV	Cross Section Route
22kV	
33kV	
66kV	
132kV	
275kV	
400kV	
Fibre Optic	
Pipit Cable	

**WARNING**  
 There may have been subsequent alteration to the surface levels. Trial holes must be undertaken to determine position and depths of cables. HS (G) 47 Booklet from the Health and Safety Executive - Avoiding Danger from Buried Cables - should be consulted before commencing excavation work.  
**WHEN WORKING IN THE VICINITY OF OVERHEAD LINES THE HEALTH AND SAFETY GUIDANCE NOTES G56 SHOULD BE CONSULTED (AVAILABLE FROM THE HSE WEBSITE)**


**Southern Electric Power Distribution plc**  
 Registered Office: No.1 Forbury Place  
 43 Forbury Road Reading RG1 3JH  
 Registered In England & Wales No.04094290

If you're unsure & need to seek advice before commencing excavations, please contact:  
 General Enquiries: 0800 048 3516

Subject to revision - Master held by SSEN Asset Data Team:  
[Asset.Data@sse.com](mailto:Asset.Data@sse.com)  
 01256 337 294

Scale: 1:500 (When plotted at A4)

65

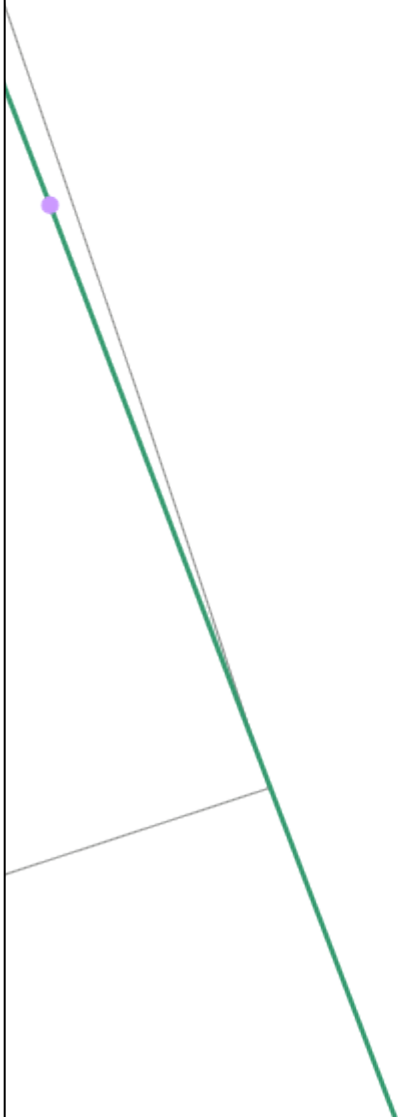

Warning: PDF designed for A4 colour print only with no page scaling

<p>0  20m</p> <p>Date Requested: 24/06/2022          Job Reference: 25881037          Site Location: 448662 213014          Requested by: Mr Joe Shawyer          Your Scheme/Reference: 31188_003</p>	<p>Dig Sites Area:  Line: </p> <p style="text-align: center; background-color: red; color: white; padding: 5px;"><b>Extra High Voltage cables in vicinity</b></p>		<p style="text-align: center;"><b>Southern Electric Power Distribution plc</b>          Registered Office: No.1 Forbury Place          43 Forbury Road Reading RG1 3JH          Registered In England &amp; Wales No.04094290</p> <p style="font-size: small;">If you're unsure &amp; need to seek advice before commencing excavations, please contact:          General Enquiries: 0800 048 3516</p> <p style="font-size: small;">Subject to revision – Master held by SSEN Asset Data Team:  <a href="mailto:Asset.Data@sse.com">Asset.Data@sse.com</a>          01256 337 294</p>	
<table border="1" style="width: 100%; border-collapse: collapse;"> <thead> <tr> <th colspan="4" style="text-align: center;">Voltages (V)</th> </tr> </thead> <tbody> <tr> <td>LV (Low Voltage) and Services</td> <td colspan="3">Up to 1,000V</td> </tr> <tr> <td>HV (High Voltage)</td> <td colspan="3">Over 1,000V to 11,000V</td> </tr> <tr> <td>EHV (Extra High Voltage)</td> <td colspan="3">22,000V to 132,000V</td> </tr> <tr> <td>Transmission</td> <td colspan="3">275,000V and 400,000V</td> </tr> </tbody> </table> <table border="1" style="width: 100%; border-collapse: collapse; font-size: x-small;"> <thead> <tr> <th colspan="5" style="text-align: left;">NORMAL DEPTH TO THE TOP OF THE CABLE WHEN LAID</th> </tr> <tr> <th>Services</th> <th>LV</th> <th>HV</th> <th>EHV</th> <th></th> </tr> </thead> <tbody> <tr> <td>Footpath/Unmade</td> <td>0.45m</td> <td>0.45m</td> <td>0.6m</td> <td>0.8m</td> </tr> <tr> <td>Road Crossing</td> <td>0.6m</td> <td>0.6m</td> <td>0.75m</td> <td>0.9m</td> </tr> <tr> <td>Agricultural</td> <td>1m</td> <td>1m</td> <td>1m</td> <td>1.1m</td> </tr> </tbody> </table>		Voltages (V)				LV (Low Voltage) and Services	Up to 1,000V			HV (High Voltage)	Over 1,000V to 11,000V			EHV (Extra High Voltage)	22,000V to 132,000V			Transmission	275,000V and 400,000V			NORMAL DEPTH TO THE TOP OF THE CABLE WHEN LAID					Services	LV	HV	EHV		Footpath/Unmade	0.45m	0.45m	0.6m	0.8m	Road Crossing	0.6m	0.6m	0.75m	0.9m	Agricultural	1m	1m	1m	1.1m	<table border="1" style="width: 100%; border-collapse: collapse; font-size: x-small;"> <thead> <tr> <th colspan="2" style="text-align: left;">Legend</th> </tr> </thead> <tbody> <tr> <td></td> <td>Service Cable</td> </tr> <tr> <td></td> <td>LV Mains</td> </tr> <tr> <td></td> <td>2 – 11kV</td> </tr> <tr> <td></td> <td>66kV</td> </tr> <tr> <td></td> <td>11kV</td> </tr> <tr> <td></td> <td>22kV</td> </tr> <tr> <td></td> <td>33kV</td> </tr> <tr> <td></td> <td>66kV</td> </tr> <tr> <td></td> <td>132kV</td> </tr> <tr> <td></td> <td>275kV</td> </tr> <tr> <td></td> <td>400kV</td> </tr> <tr> <td></td> <td>Fibre Optic</td> </tr> <tr> <td></td> <td>Pipe Cable</td> </tr> </tbody> </table> <table border="1" style="width: 100%; border-collapse: collapse; font-size: x-small;"> <thead> <tr> <th colspan="2" style="text-align: left;">Distribution Structures (Electric)</th> </tr> </thead> <tbody> <tr> <td></td> <td>Pole, Existing Location</td> </tr> <tr> <td></td> <td>Pole Structure, Existing Location – Single</td> </tr> <tr> <td></td> <td>Pole Structure, Existing Location – H</td> </tr> <tr> <td></td> <td>Duct Route</td> </tr> <tr> <td></td> <td>Cross Section Route</td> </tr> </tbody> </table> <p style="font-size: x-small; text-align: center;"><b>WARNING</b>          There may have been subsequent alteration to the surface levels. Trial holes must be undertaken to determine position and depths of cables. HS (G) 47 Booklet from the Health and Safety Executive – Avoiding Danger from Buried Cables – should be consulted before commencing excavation work.  <b>WHEN WORKING IN THE VICINITY OF OVERHEAD LINES THE HEALTH AND SAFETY GUIDANCE NOTES G56 SHOULD BE CONSULTED (AVAILABLE FROM THE HSE WEBSITE)</b></p>	Legend			Service Cable		LV Mains		2 – 11kV		66kV		11kV		22kV		33kV		66kV		132kV		275kV		400kV		
<p>BASED UPON THE ORDNANCE SURVEY MAP WITH THE SANCTION OF THE CONTROLLER OF H.M. STATIONERY OFFICE CROWN COPYRIGHT RESERVED.          This copy has been made by or with the authority of Scottish and Southern Energy Power Distribution Ltd. Pursuant to section 47 of the Copyright, Designs and Patents Act 1988 ("The Act"). Unless the Act provides a relevant exception to copyright the copy must not be copied without prior permission of the copyright owner.          Plans generated by DigSAFE Pro™ software provided by LinesearchbeforeUdig.</p>	



66

Warning: PDF designed for A4 colour print only with no page scaling

0  20m

Dig Sites


Area:



Line:



**Extra High Voltage  
cables in vicinity**

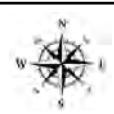

Date Requested: 24/06/2022  
Job Reference: 25881037  
Site Location: 448662 213014  
Requested by: Mr Joe Shawyer

Your Scheme/Reference: 31188\_003

Voltages (V)			
LV (Low Voltage) and Services	Up to 1,000V		
HV (High Voltage)	Over 1,000V to 11,000V		
EHV (Extra High Voltage)	22,000V to 132,000V		
Transmission	275,000V and 400,000V		
NORMAL DEPTH TO THE TOP OF THE CABLE WHEN LAID			
Services	LV	HV	EHV
Footpath/Unmade	0.45m	0.45m	0.6m
Road Crossing	0.6m	0.6m	0.75m
Agricultural	1m	1m	1.1m

Legend	
	Service Cable
	LV Mains
	2 - 11kV
	66kV
	11kV
	22kV
	33kV
	66kV
	132kV
	275kV
	400kV
	Fibre Optic
	Pilot Cable

Distribution Structures (Electric)	
	Pole, Existing Location
	Pole Structure, Existing Location - Single
	Pole Structure, Existing Location - H
	Duct Route
	Cross Section Route


**Southern Electric Power Distribution plc**  
Registered Office: No.1 Forbury Place  
43 Forbury Road Reading RG1 3JH  
Registered In England & Wales No.04094290

If you're unsure & need to seek advice before commencing excavations, please contact:  
General Enquiries: 0800 048 3516

Subject to revision - Master held by SSEN Asset Data Team:  
[Asset.Data@sse.com](mailto:Asset.Data@sse.com)  
01256 337 294

Scale: 1:500 (When plotted at A4)

**WARNING**  
There may have been subsequent alteration to the surface levels. Trial holes must be undertaken to determine position and depths of cables. HS (G) 47 Booklet from the Health and Safety Executive - Avoiding Danger from Buried Cables - should be consulted before commencing excavation work.  
**WHEN WORKING IN THE VICINITY OF OVERHEAD LINES THE HEALTH AND SAFETY GUIDANCE NOTES G56 SHOULD BE CONSULTED (AVAILABLE FROM THE HSE WEBSITE)**

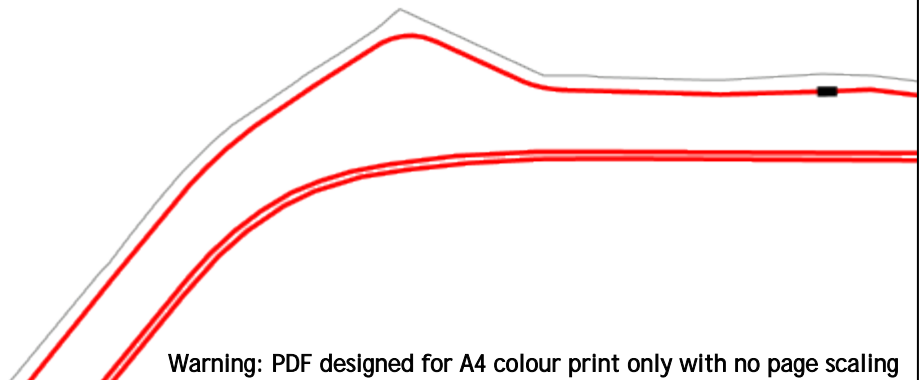

Warning: PDF designed for A4 colour print only with no page scaling

0 20m Dig Sites Area: Line:

**Extra High Voltage  
cables in vicinity**



Date Requested: 24/06/2022  
 Job Reference: 25881037  
 Site Location: 448662 213014  
 Requested by: Mr Joe Shawyer  
 Your Scheme/Reference: 31188\_003

Voltages (V)			
LV (Low Voltage) and Services	Up to 1,000V		
HV (High Voltage)	Over 1,000V to 11,000V		
EHV (Extra High Voltage)	22,000V to 132,000V		
Transmission	275,000V and 400,000V		
NORMAL DEPTH TO THE TOP OF THE CABLE WHEN LAID			
Services	LV	HV	EHV
Footpath/Unmade	0.45m	0.45m	0.6m 0.8m
Road Crossing	0.6m	0.6m	0.75m 0.9m
Agricultural	1m	1m	1m 1.1m

Legend	
	Service Cable
	LV Mains
	2 - 11kV
	66kV
	275kV
	400kV
	Fibre Optic
	Pipe Cable

Distribution Structures (Electric)	
	Pole, Existing Location
	Pole Structure, Existing Location - Single
	Pole Structure, Existing Location - H
	Duct Route
	Cross Section Route

**Southern Electric Power Distribution plc**  
 Registered Office: No.1 Forbury Place  
 43 Forbury Road Reading RG1 3JH  
 Registered In England & Wales No.04094290

If you're unsure & need to seek advice before commencing excavations, please contact:  
 General Enquiries: 0800 048 3516

Subject to revision – Master held by SSEN Asset Data Team:  
[Asset.Data@sse.com](mailto:Asset.Data@sse.com)  
 01256 337 294

Scale: 1:500 (When plotted at A4)

**WARNING**  
 There may have been subsequent alteration to the surface levels. Trial holes must be undertaken to determine position and depths of cables. HS (G) 47 Booklet from the Health and Safety Executive – Avoiding Danger from Buried Cables – should be consulted before commencing excavation work.  
**WHEN WORKING IN THE VICINITY OF OVERHEAD LINES THE HEALTH AND SAFETY GUIDANCE NOTES G56 SHOULD BE CONSULTED (AVAILABLE FROM THE HSE WEBSITE)**

68

11kV 300x3C Al CAS U/A

11kV 300x3C Al CAS U/A

Warning: PDF designed for A4 colour print only with no page scaling

0 20m

Dig Sites

Area:



Line:



Extra High Voltage  
cables in vicinity



Date Requested: 24/06/2022  
 Job Reference: 25881037  
 Site Location: 448662 213014  
 Requested by: Mr Joe Shawyer  
 Your Scheme/Reference: 31188\_003

Voltages (V)				
LV (Low Voltage) and Services	Up to 1,000V			
HV (High Voltage)	Over 1,000V to 11,000V			
EHV (Extra High Voltage)	22,000V to 132,000V			
Transmission	275,000V and 400,000V			
NORMAL DEPTH TO THE TOP OF THE CABLE WHEN LAID				
Services	LV	HV	EHV	
Footpath/Unmade	0.45m	0.45m	0.6m	0.8m
Road Crossing	0.6m	0.6m	0.75m	0.9m
Agricultural	1m	1m	1m	1.1m

Legend	
	Service Cable
	LV Mains
	2 - 11kV
	66kV
	11kV
	22kV
	33kV
	66kV
	132kV
	275kV
	400kV
	Fibre Optic
	Pilot Cable

Distribution Structures (Electric)	
	Pole, Existing Location
	Pole Structure, Existing Location - Single
	Pole Structure, Existing Location - H
	Duct Route
	Cross Section Route


**Southern Electric Power Distribution plc**  
 Registered Office: No.1 Forbury Place  
 43 Forbury Road Reading RG1 3JH  
 Registered In England & Wales No.04094290

If you're unsure & need to seek advice before commencing excavations, please contact:  
 General Enquiries: 0800 048 3516

Subject to revision – Master held by SSEN Asset Data Team:  
[Asset.Data@sse.com](mailto:Asset.Data@sse.com)  
 01256 337 294

Scale: 1:500 (When plotted at A4)

**WARNING**  
 There may have been subsequent alteration to the surface levels. Trial holes must be undertaken to determine position and depths of cables. HS (G) 47 Booklet from the Health and Safety Executive – Avoiding Danger from Buried Cables – should be consulted before commencing excavation work.  
**WHEN WORKING IN THE VICINITY OF OVERHEAD LINES THE HEALTH AND SAFETY GUIDANCE NOTES G66 SHOULD BE CONSULTED (AVAILABLE FROM THE HSE WEBSITE)**

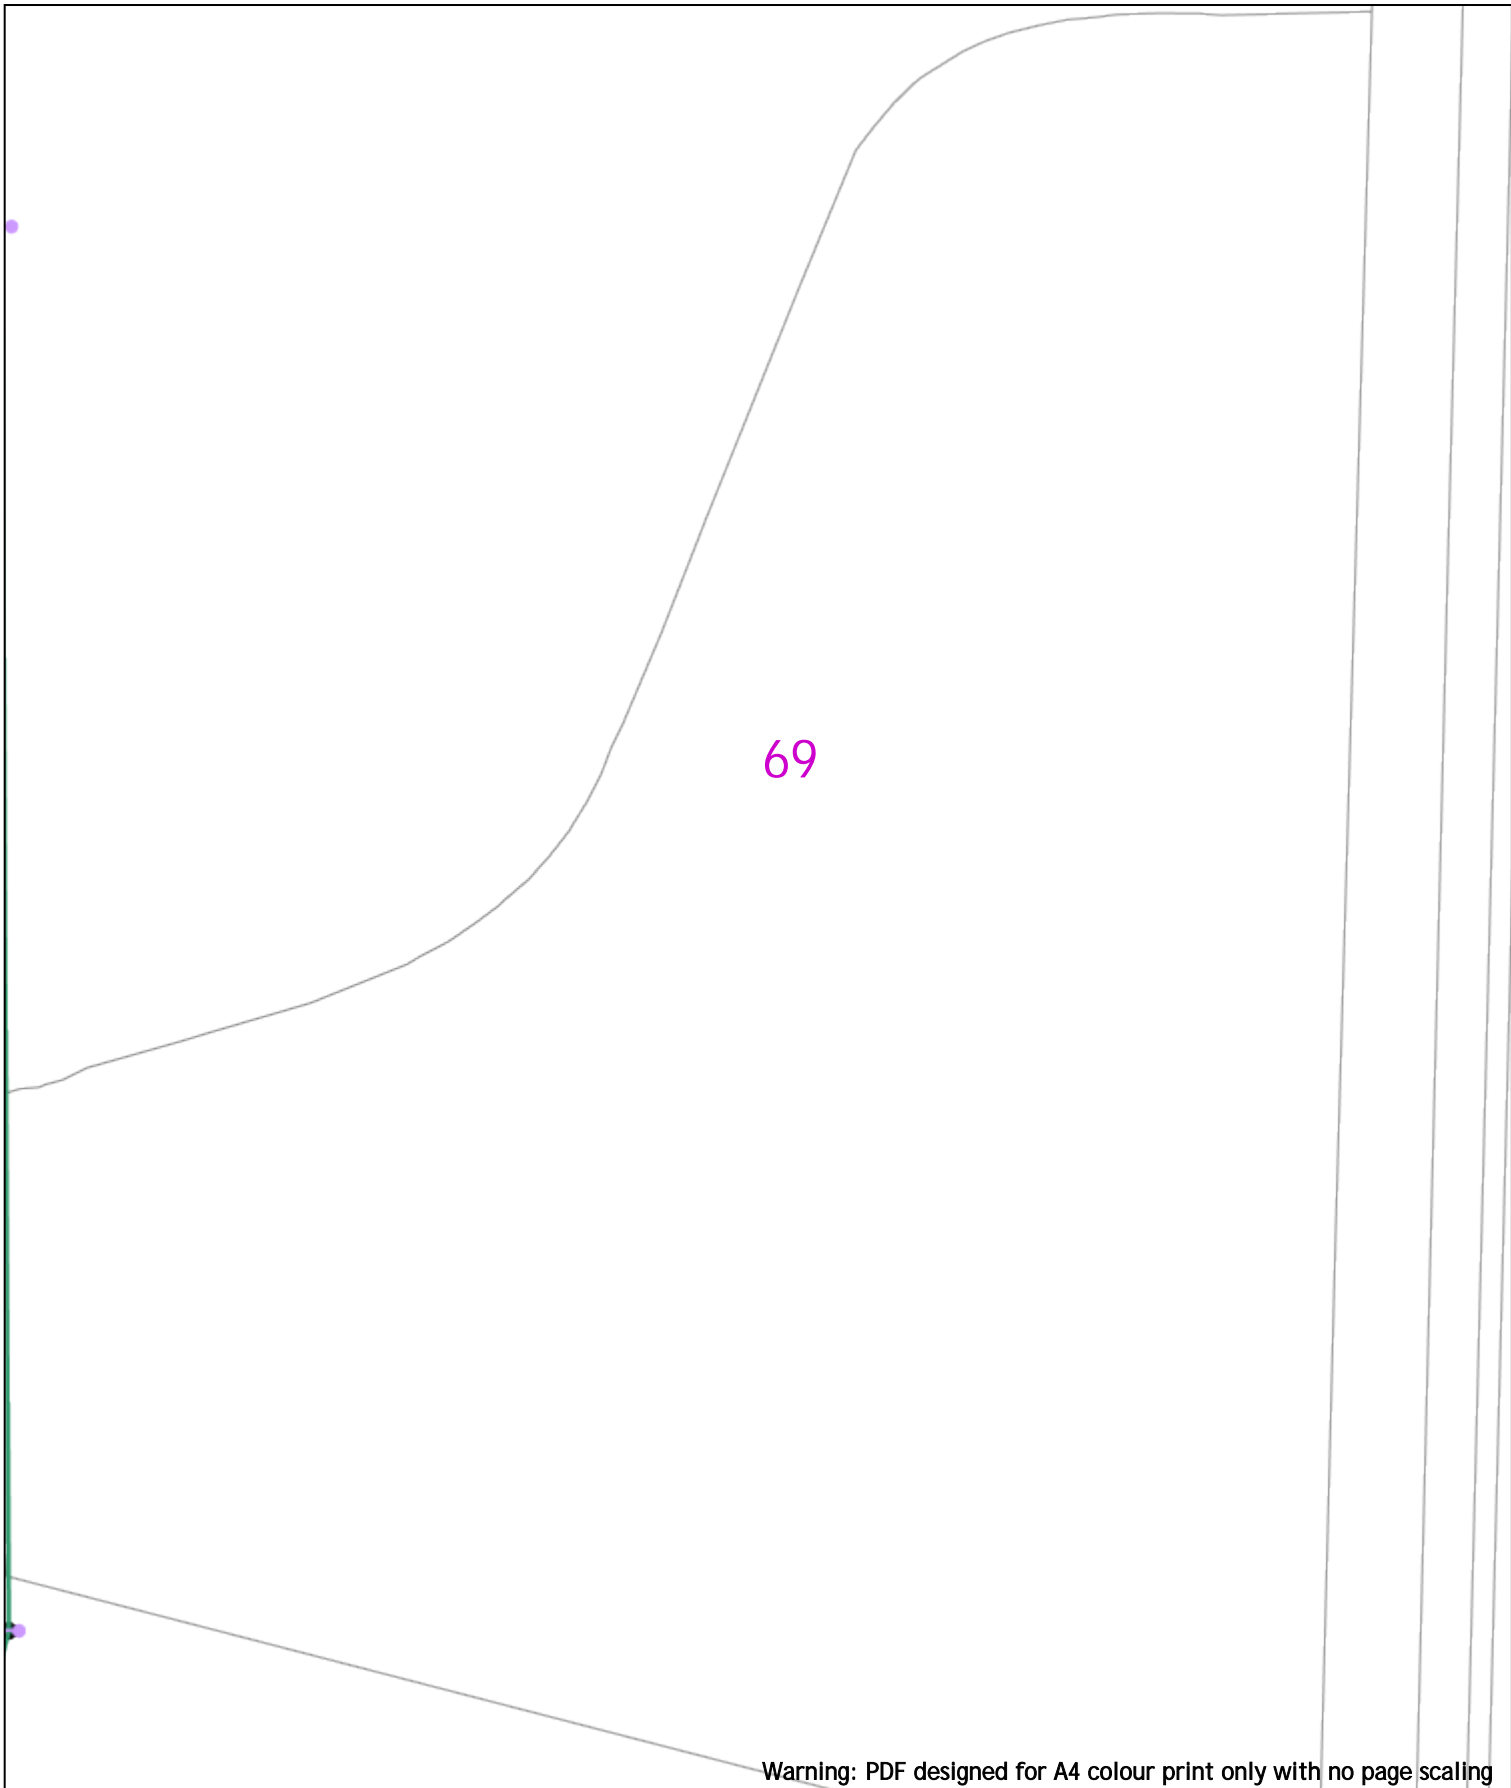

Warning: PDF designed for A4 colour print only with no page scaling

20m Dig Sites Area:   Line:  **Extra High Voltage cables in vicinity**

Date Requested: 24/06/2022  
 Job Reference: 25881037  
 Site Location: 448662 213014  
 Requested by: Mr Joe Shawyer  
 Your Scheme/Reference: 31188\_003

Voltages (V)			
LV (Low Voltage) and Services	Up to 1,000V		
HV (High Voltage)	Over 1,000V to 11,000V		
EHV (Extra High Voltage)	22,000V to 132,000V		
Transmission	275,000V and 400,000V		
NORMAL DEPTH TO THE TOP OF THE CABLE WHEN LAID			
Services	LV	HV	EHV
Footpath/Unmade	0.45m	0.45m	0.6m
Road Crossing	0.6m	0.6m	0.75m
Agricultural	1m	1m	1.1m


Legend		Distribution Structures (Electric)	
<span style="border-bottom: 1px solid yellow; width: 15px; display: inline-block;"></span>	Service Cable		Pole, Existing Location
<span style="border-bottom: 1px solid red; width: 15px; display: inline-block;"></span>	LV Mains		Pole Structure, Existing Location - Single
<span style="border-bottom: 1px solid blue; width: 15px; display: inline-block;"></span>	2 - 11kV		Pole Structure, Existing Location - H
<span style="border-bottom: 1px solid green; width: 15px; display: inline-block;"></span>	66kV		Duct Route
<span style="border-bottom: 1px solid orange; width: 15px; display: inline-block;"></span>	11kV		Cross Section Route
<span style="border-bottom: 1px solid purple; width: 15px; display: inline-block;"></span>	22kV		
<span style="border-bottom: 1px solid brown; width: 15px; display: inline-block;"></span>	33kV		
<span style="border-bottom: 1px solid pink; width: 15px; display: inline-block;"></span>	66kV		
<span style="border-bottom: 1px solid grey; width: 15px; display: inline-block;"></span>	132kV		
<span style="border-bottom: 1px solid black; width: 15px; display: inline-block;"></span>	275kV		
<span style="border-bottom: 1px solid lightblue; width: 15px; display: inline-block;"></span>	400kV		
<span style="border-bottom: 1px solid lightgreen; width: 15px; display: inline-block;"></span>	Fibre Optic		
<span style="border-bottom: 1px solid lightyellow; width: 15px; display: inline-block;"></span>	Pipe Cable		

**WARNING**  
 There may have been subsequent alteration to the surface levels. Trial holes must be undertaken to determine position and depths of cables. HS (G) 47 Booklet from the Health and Safety Executive - Avoiding Danger from Buried Cables - should be consulted before commencing excavation work.  
**WHEN WORKING IN THE VICINITY OF OVERHEAD LINES THE HEALTH AND SAFETY GUIDANCE NOTES G56 SHOULD BE CONSULTED (AVAILABLE FROM THE HSE WEBSITE)**

**Southern Electric Power Distribution plc**  
 Registered Office: No.1 Forbury Place  
 43 Forbury Road Reading RG1 3JH  
 Registered In England & Wales No.04094290

If you're unsure & need to seek advice before commencing excavations, please contact:  
 General Enquiries: 0800 048 3516

Subject to revision - Master held by SSEN Asset Data Team:  
[Asset.Data@sse.com](mailto:Asset.Data@sse.com)  
 01256 337 294

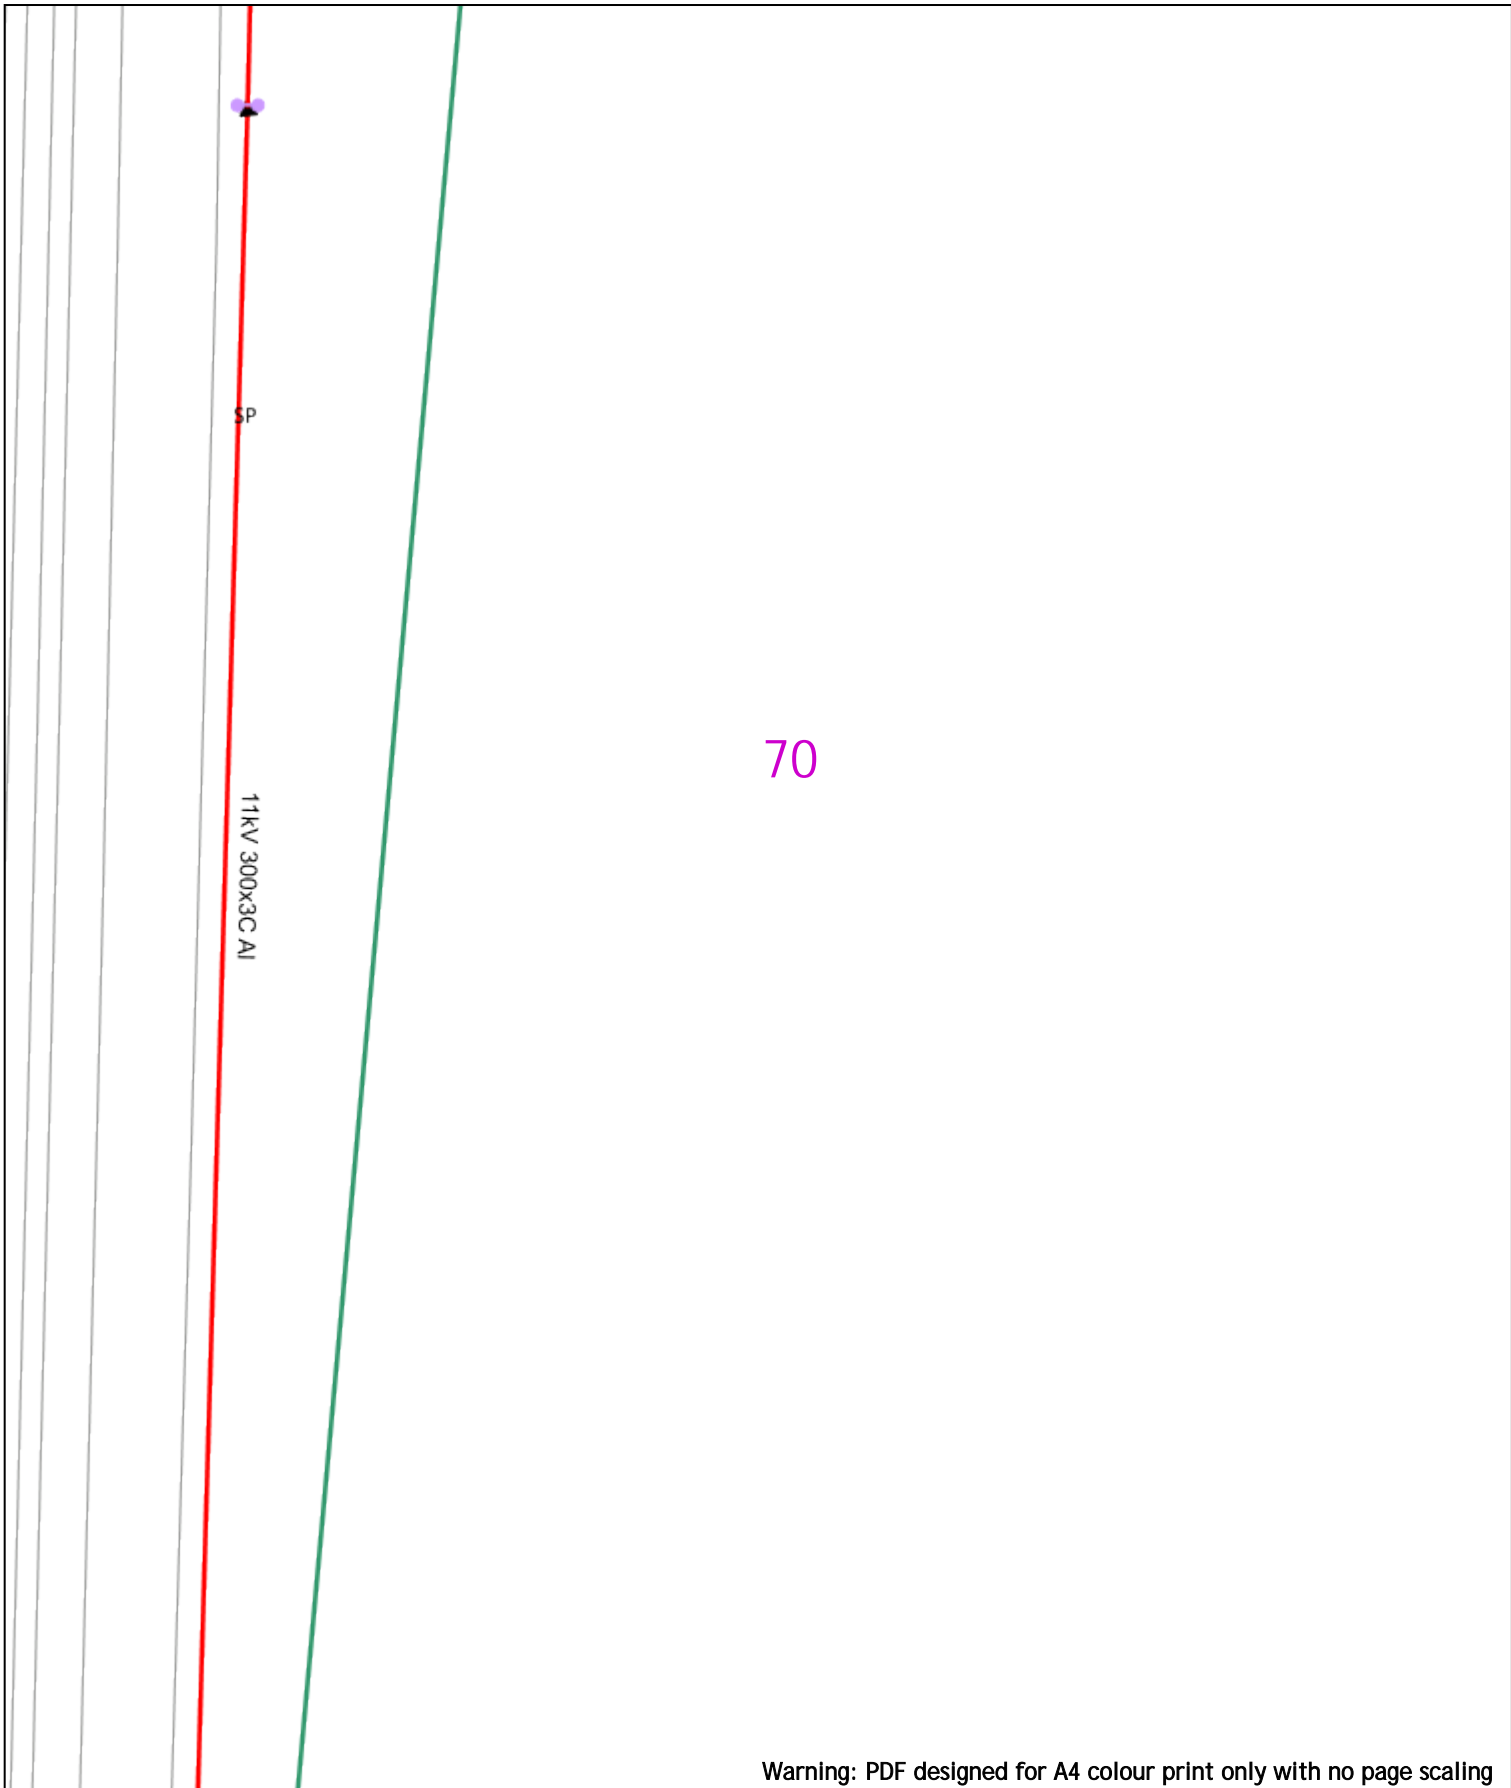

Warning: PDF designed for A4 colour print only with no page scaling


<p>0  20m Dig Sites Area:  Line: </p>	<p><b>Extra High Voltage cables in vicinity</b></p>																																		
<p>Date Requested: 24/06/2022          Job Reference: 25881037          Site Location: 448662 213014          Requested by: Mr Joe Shawyer          Your Scheme/Reference: 31188_003</p>	<p><b>Voltages (V)</b></p> <table border="1"> <tr> <td>LV (Low Voltage) and Services</td> <td colspan="3">Up to 1,000V</td> </tr> <tr> <td>HV (High Voltage)</td> <td colspan="3">Over 1,000V to 11,000V</td> </tr> <tr> <td>EHV (Extra High Voltage)</td> <td colspan="3">22,000V to 132,000V</td> </tr> <tr> <td>Transmission</td> <td colspan="3">275,000V and 400,000V</td> </tr> </table> <p><b>NORMAL DEPTH TO THE TOP OF THE CABLE WHEN LAID</b></p> <table border="1"> <thead> <tr> <th>Services</th> <th>LV</th> <th>HV</th> <th>EHV</th> </tr> </thead> <tbody> <tr> <td>Footpath/Unmade</td> <td>0.45m</td> <td>0.45m</td> <td>0.6m 0.8m</td> </tr> <tr> <td>Road Crossing</td> <td>0.6m</td> <td>0.6m</td> <td>0.75m 0.9m</td> </tr> <tr> <td>Agricultural</td> <td>1m</td> <td>1m</td> <td>1m 1.1m</td> </tr> </tbody> </table>	LV (Low Voltage) and Services	Up to 1,000V			HV (High Voltage)	Over 1,000V to 11,000V			EHV (Extra High Voltage)	22,000V to 132,000V			Transmission	275,000V and 400,000V			Services	LV	HV	EHV	Footpath/Unmade	0.45m	0.45m	0.6m 0.8m	Road Crossing	0.6m	0.6m	0.75m 0.9m	Agricultural	1m	1m	1m 1.1m	<p><b>Legend</b></p> <ul style="list-style-type: none"> <li>Service Cable</li> <li>LV Mains</li> <li>2 - 11kV</li> <li>66kV</li> <li>11kV</li> <li>22kV</li> <li>33kV</li> <li>66kV</li> <li>132kV</li> <li>275kV</li> <li>400kV</li> <li>Fibre Optic</li> <li>Pipe Cable</li> </ul> <p><b>Distribution Structures (Electric)</b></p> <ul style="list-style-type: none"> <li>Pole, Existing Location</li> <li>Pole Structure, Existing Location - Single</li> <li>Pole Structure, Existing Location - H</li> <li>Duct Route</li> <li>Cross Section Route</li> </ul> <p><b>WARNING</b></p> <p>There may have been subsequent alteration to the surface levels. Trial holes must be undertaken to determine position and depths of cables. HS (G) 47 Booklet from the Health and Safety Executive - Avoiding Danger from Buried Cables - should be consulted before commencing excavation work.</p> <p><b>WHEN WORKING IN THE VICINITY OF OVERHEAD LINES THE HEALTH AND SAFETY GUIDANCE NOTES G56 SHOULD BE CONSULTED (AVAILABLE FROM THE HSE WEBSITE)</b></p>	<p><b>Southern Electric Power Distribution plc</b>          Registered Office: No.1 Forbury Place          43 Forbury Road Reading RG1 3JH          Registered In England &amp; Wales No.04094290</p> <p>If you're unsure &amp; need to seek advice before commencing excavations, please contact:          General Enquiries: 0800 048 3516</p> <p>Subject to revision - Master held by SSEN Asset Data Team:  <a href="mailto:Asset.Data@sse.com">Asset.Data@sse.com</a>          01256 337 294</p>
LV (Low Voltage) and Services	Up to 1,000V																																		
HV (High Voltage)	Over 1,000V to 11,000V																																		
EHV (Extra High Voltage)	22,000V to 132,000V																																		
Transmission	275,000V and 400,000V																																		
Services	LV	HV	EHV																																
Footpath/Unmade	0.45m	0.45m	0.6m 0.8m																																
Road Crossing	0.6m	0.6m	0.75m 0.9m																																
Agricultural	1m	1m	1m 1.1m																																
<p>Scale: 1:500 (When plotted at A4)</p> <p>BASED UPON THE ORDNANCE SURVEY MAP WITH THE SANCTION OF THE CONTROLLER OF HM STATIONERY OFFICE CROWN COPYRIGHT RESERVED.          This copy has been made by or with the authority of Scottish and Southern Energy Power Distribution Ltd. Pursuant to section 47 of the Copyright, Designs and Patents Act 1988 ("The Act"). Unless the Act provides a relevant exception to copyright the copy must not be copied without prior permission of the copyright owner.          Plans generated by DigSAFE Pro™ software provided by LinesearchbeforeUdig.</p>																																			

Warning: PDF designed for A4 colour print only with no page scaling

0  20m





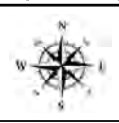








Dig Sites Area:  Line: 




**Extra High Voltage  
cables in vicinity**



Date Requested: 24/06/2022  
 Job Reference: 25881037  
 Site Location: 448662 213014  
 Requested by: Mr Joe Shawyer  
 Your Scheme/Reference: 31188\_003

Voltages (V)			
LV (Low Voltage) and Services	Up to 1,000V		
HV (High Voltage)	Over 1,000V to 11,000V		
EHV (Extra High Voltage)	22,000V to 132,000V		
Transmission	275,000V and 400,000V		
NORMAL DEPTH TO THE TOP OF THE CABLE WHEN LAID			
Services	LV	HV	EHV
Footpath/Unmade	0.45m	0.45m	0.6m 0.8m
Road Crossing	0.6m	0.6m	0.75m 0.9m
Agricultural	1m	1m	1m 1.1m

Legend	
	Service Cable
	LV Mains
	2 - 11kV
	66kV
	11kV
	22kV
	33kV
	66kV
	132kV
	275kV
	400kV
	Fibre Optic
	Pipe Cable

  Distribution Structures (Electric)	
	Pole, Existing Location
	Pole Structure, Existing Location - Single
	Pole Structure, Existing Location - H
	Duct Route
	Cross Section Route


Scale: 1:500 (When plotted at A4)

**WARNING**  
 There may have been subsequent alteration to the surface levels. Trial holes must be undertaken to determine position and depths of cables. HS (G) 47 Booklet from the Health and Safety Executive - Avoiding Danger from Buried Cables - should be consulted before commencing excavation work.  
**WHEN WORKING IN THE VICINITY OF OVERHEAD LINES THE HEALTH AND SAFETY GUIDANCE NOTES G56 SHOULD BE CONSULTED (AVAILABLE FROM THE HSE WEBSITE)**

**Southern Electric Power Distribution plc**  
 Registered Office: No.1 Forbury Place  
 43 Forbury Road Reading RG1 3JH  
 Registered In England & Wales No.04094290

If you're unsure & need to seek advice before commencing excavations, please contact:  
 General Enquiries: 0800 048 3516

Subject to revision - Master held by SSEN Asset Data Team:  
[Asset.Data@sse.com](mailto:Asset.Data@sse.com)  
 01256 337 294

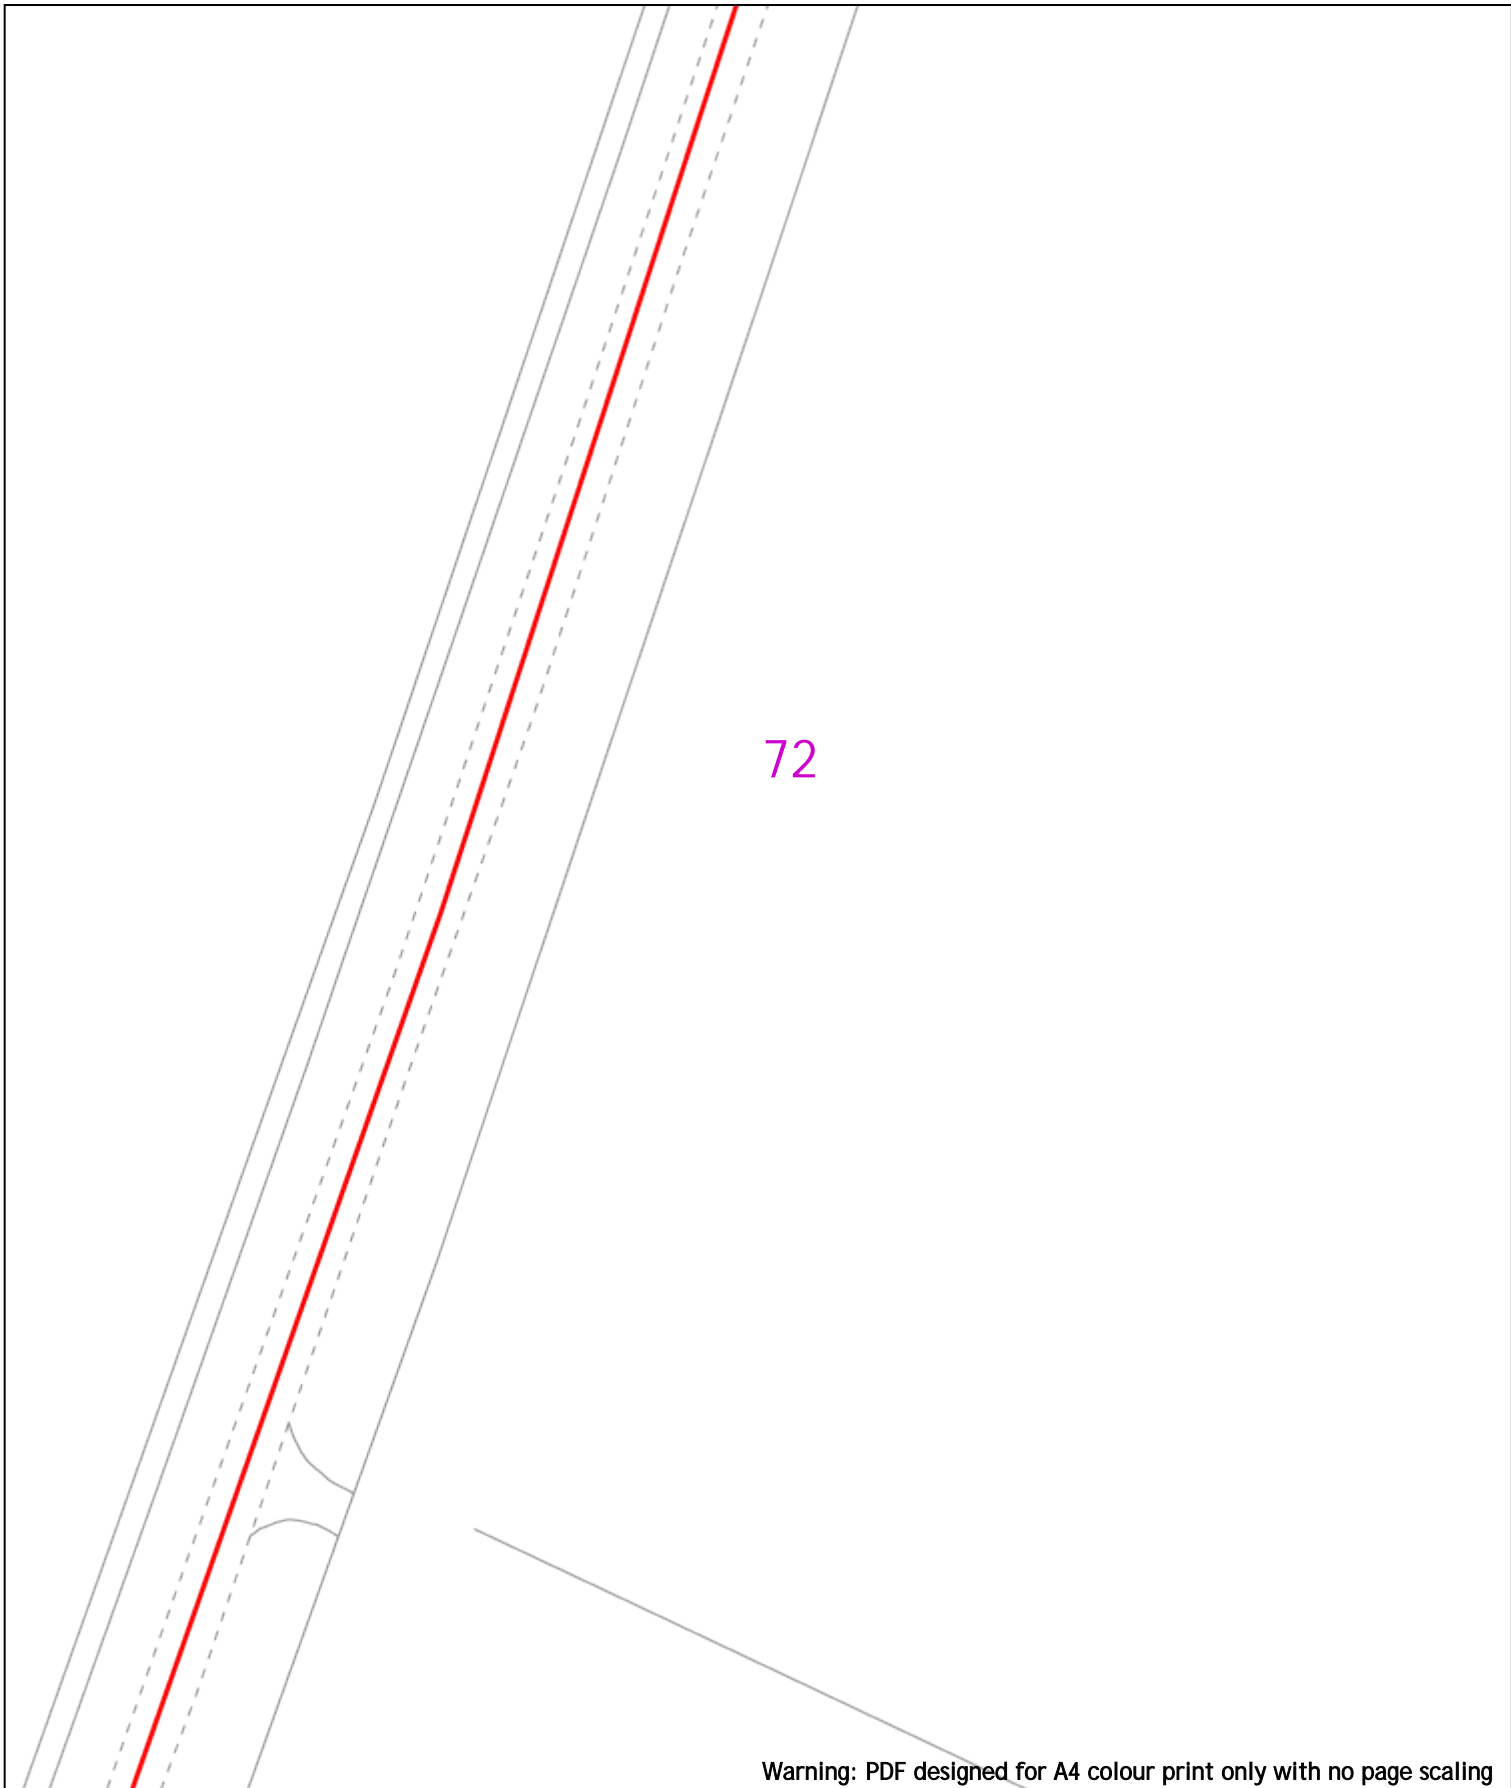

Warning: PDF designed for A4 colour print only with no page scaling

		Dig Sites:  Area:  Line:	<b>Extra High Voltage cables in vicinity</b>	
Date Requested: 24/06/2022 Job Reference: 25881037 Site Location: 448662 213014 Requested by: Mr Joe Shawyer Your Scheme/Reference: 31188_003		<table border="1"> <thead> <tr> <th colspan="4">Voltages (V)</th> </tr> </thead> <tbody> <tr> <td>LV (Low Voltage) and Services</td> <td colspan="3">Up to 1,000V</td> </tr> <tr> <td>HV (High Voltage)</td> <td colspan="3">Over 1,000V to 11,000V</td> </tr> <tr> <td>EHV (Extra High Voltage)</td> <td colspan="3">22,000V to 132,000V</td> </tr> <tr> <td>Transmission</td> <td colspan="3">275,000V and 400,000V</td> </tr> </tbody> </table> <table border="1"> <thead> <tr> <th colspan="4">NORMAL DEPTH TO THE TOP OF THE CABLE WHEN LAID</th> </tr> <tr> <th>Services</th> <th>LV</th> <th>HV</th> <th>EHV</th> </tr> </thead> <tbody> <tr> <td>Footpath/Unmade</td> <td>0.45m</td> <td>0.45m</td> <td>0.6m</td> </tr> <tr> <td>Road Crossing</td> <td>0.6m</td> <td>0.6m</td> <td>0.75m</td> </tr> <tr> <td>Agricultural</td> <td>1m</td> <td>1m</td> <td>1.1m</td> </tr> </tbody> </table>	Voltages (V)				LV (Low Voltage) and Services	Up to 1,000V			HV (High Voltage)	Over 1,000V to 11,000V			EHV (Extra High Voltage)	22,000V to 132,000V			Transmission	275,000V and 400,000V			NORMAL DEPTH TO THE TOP OF THE CABLE WHEN LAID				Services	LV	HV	EHV	Footpath/Unmade	0.45m	0.45m	0.6m	Road Crossing	0.6m	0.6m	0.75m	Agricultural	1m	1m	1.1m	<table border="1"> <thead> <tr> <th colspan="2">Legend</th> </tr> </thead> <tbody> <tr><td></td><td>Service Cable</td></tr> <tr><td></td><td>LV Mains</td></tr> <tr><td></td><td>2 - 11kV</td></tr> <tr><td></td><td>66kV</td></tr> <tr><td></td><td>132kV</td></tr> <tr><td></td><td>275kV</td></tr> <tr><td></td><td>400kV</td></tr> <tr><td></td><td>Fibre Optic</td></tr> <tr><td></td><td>Pilot Cable</td></tr> </tbody> </table> <table border="1"> <thead> <tr> <th colspan="2">Distribution Structures (Electric)</th> </tr> </thead> <tbody> <tr><td></td><td>Pole, Existing Location</td></tr> <tr><td></td><td>Pole Structure, Existing Location - Single</td></tr> <tr><td></td><td>Pole Structure, Existing Location - H</td></tr> <tr><td></td><td>Duct Route</td></tr> <tr><td></td><td>Cross Section Route</td></tr> </tbody> </table>	Legend			Service Cable		LV Mains		2 - 11kV		66kV		110kV		220kV		330kV		660kV		132kV		275kV		400kV		Fibre Optic		Pilot Cable	Distribution Structures (Electric)			Pole, Existing Location		Pole Structure, Existing Location - Single		Pole Structure, Existing Location - H		Duct Route		Cross Section Route	<p style="text-align: center;"><b>Southern Electric Power Distribution plc</b>          Registered Office: No.1 Forbury Place          43 Forbury Road Reading RG1 3JH          Registered In England &amp; Wales No.04094290</p> <p>If you're unsure &amp; need to seek advice before commencing excavations, please contact:          General Enquiries: 0800 048 3516</p> <p>Subject to revision – Master held by SSEN Asset Data Team:  <a href="mailto:Asset.Data@sse.com">Asset.Data@sse.com</a>          01256 337 294</p>
Voltages (V)	
LV (Low Voltage) and Services	Up to 1,000V	
HV (High Voltage)	Over 1,000V to 11,000V	
EHV (Extra High Voltage)	22,000V to 132,000V	
Transmission	275,000V and 400,000V	
NORMAL DEPTH TO THE TOP OF THE CABLE WHEN LAID	
Services	LV	HV	EHV	
Footpath/Unmade	0.45m	0.45m	0.6m	
Road Crossing	0.6m	0.6m	0.75m	
Agricultural	1m	1m	1.1m	
Legend	
	Service Cable	
	LV Mains	
	2 - 11kV	
	66kV	
	132kV	
	275kV	
	400kV	
	Fibre Optic	
	Pilot Cable	
Distribution Structures (Electric)	
	Pole, Existing Location	
	Pole Structure, Existing Location - Single	
	Pole Structure, Existing Location - H	
	Duct Route	
	Cross Section Route	
Scale: 1:500 (When plotted at A4)		<p style="text-align: center;"><b>WARNING</b></p> <p>There may have been subsequent alteration to the surface levels. Trial holes must be undertaken to determine position and depths of cables. HS (G) 47 Booklet from the Health and Safety Executive – Avoiding Danger from Buried Cables – should be consulted before commencing excavation work.</p> <p style="text-align: center;"><b>WHEN WORKING IN THE VICINITY OF OVERHEAD LINES THE HEALTH AND SAFETY GUIDANCE NOTES G56 SHOULD BE CONSULTED (AVAILABLE FROM THE HSE WEBSITE)</b></p>	

73

11kV 120x3w BLX

Warning: PDF designed for A4 colour print only with no page scaling

0  20m Dig Sites Area:  Line: 

Extra High Voltage cables in vicinity



Date Requested: 24/06/2022  
 Job Reference: 25881037  
 Site Location: 448662 213014  
 Requested by: Mr Joe Shawyer  
 Your Scheme/Reference: 31188\_003

Voltages (V)			
LV (Low Voltage) and Services	Up to 1,000V		
HV (High Voltage)	Over 1,000V to 11,000V		
EHV (Extra High Voltage)	22,000V to 132,000V		
Transmission	275,000V and 400,000V		
NORMAL DEPTH TO THE TOP OF THE CABLE WHEN LAID			
Services	LV	HV	EHV
Footpath/Unmade	0.45m	0.45m	0.6m
Road Crossing	0.6m	0.6m	0.75m
Agricultural	1m	1m	1.1m

Legend	
	Service Cable
	LV Mains
	2 - 11kV
	66kV
	11kV
	22kV
	33kV
	66kV
	132kV
	275kV
	400kV
	Fibre Optic
	Pipe Cable

Distribution Structures (Electric)	
	Pole, Existing Location
	Pole Structure, Existing Location - Single
	Pole Structure, Existing Location - H
	Duct Route
	Cross Section Route

**Southern Electric Power Distribution plc**  
 Registered Office: No.1 Forbury Place  
 43 Forbury Road Reading RG1 3JH  
 Registered In England & Wales No.04094290

If you're unsure & need to seek advice before commencing excavations, please contact:  
 General Enquiries: 0800 048 3516

Subject to revision - Master held by SSEN Asset Data Team:  
[Asset.Data@sse.com](mailto:Asset.Data@sse.com)  
 01256 337 294

Scale: 1:500 (When plotted at A4)

**WARNING**  
 There may have been subsequent alteration to the surface levels. Trial holes must be undertaken to determine position and depths of cables. HS (G) 47 Booklet from the Health and Safety Executive - Avoiding Danger from Buried Cables - should be consulted before commencing excavation work.  
**WHEN WORKING IN THE VICINITY OF OVERHEAD LINES THE HEALTH AND SAFETY GUIDANCE NOTES G56 SHOULD BE CONSULTED (AVAILABLE FROM THE HSE WEBSITE)**



Warning: PDF designed for A4 colour print only with no page scaling

0  20m Dig Sites Area:  Line: 

**Extra High Voltage  
cables in vicinity**





Date Requested: 24/06/2022  
Job Reference: 25881037  
Site Location: 448662 213014  
Requested by: Mr Joe Shawyer

Your Scheme/Reference: 31188\_003

Voltages (V)			
LV (Low Voltage) and Services	Up to 1,000V		
HV (High Voltage)	Over 1,000V to 11,000V		
EHV (Extra High Voltage)	22,000V to 132,000V		
Transmission	275,000V and 400,000V		
NORMAL DEPTH TO THE TOP OF THE CABLE WHEN LAID			
Services	LV	HV	EHV
Footpath/Unmade	0.45m	0.45m	0.6m 0.8m
Road Crossing	0.6m	0.6m	0.75m 0.9m
Agricultural	1m	1m	1m 1.1m

Legend	
	Service Cable
	LV Mains
	2 - 11kV
	66kV
	11kV
	22kV
	33kV
	66kV
	132kV
	275kV
	400kV
	Fibre Optic
	Pipe Cable

Distribution Structures (Electric)	
	Pole, Existing Location
	Pole Structure, Existing Location - Single
	Pole Structure, Existing Location - H
	Duct Route
	Cross Section Route

**WARNING**

There may have been subsequent alteration to the surface levels. Trial holes must be undertaken to determine position and depths of cables. HS (G) 47 Booklet from the Health and Safety Executive - Avoiding Danger from Buried Cables - should be consulted before commencing excavation work.  
WHEN WORKING IN THE VICINITY OF OVERHEAD LINES THE HEALTH AND SAFETY GUIDANCE NOTES G56 SHOULD BE CONSULTED (AVAILABLE FROM THE HSE WEBSITE)

**Southern Electric Power Distribution plc**  
Registered Office: No.1 Forbury Place  
43 Forbury Road Reading RG1 3JH  
Registered In England & Wales No.04094290

If you're unsure & need to seek advice before commencing excavations, please contact:  
General Enquiries: 0800 048 3516

Subject to revision - Master held by SSEN Asset Data Team:  
[Asset.Data@sse.com](mailto:Asset.Data@sse.com)  
01256 337 294

Scale: 1:500 (When plotted at A4)

75

Warning: PDF designed for A4 colour print only with no page scaling













0  20m Dig Sites Area:  Line: 






**Extra High Voltage  
cables in vicinity**

 

Date Requested: 24/06/2022  
 Job Reference: 25881037  
 Site Location: 448662 213014  
 Requested by: Mr Joe Shawyer  
 Your Scheme/Reference: 31188\_003

Voltages (V)			
LV (Low Voltage) and Services	Up to 1,000V		
HV (High Voltage)	Over 1,000V to 11,000V		
EHV (Extra High Voltage)	22,000V to 132,000V		
Transmission	275,000V and 400,000V		
NORMAL DEPTH TO THE TOP OF THE CABLE WHEN LAID			
Services	LV	HV	EHV
Footpath/Unmade	0.45m	0.45m	0.6m
Road Crossing	0.6m	0.6m	0.75m
Agricultural	1m	1m	1.1m

Legend	
	Service Cable
	LV Mains
	2 - 11kV
	66kV
	11kV
	22kV
	33kV
	66kV
	132kV
	275kV
	400kV
	Fibre Optic
	Pipe Cable

Distribution Structures (Electric)	
	Pole, Existing Location
	Pole Structure, Existing Location - Single
	Pole Structure, Existing Location - H
	Duct Route
	Cross Section Route

**WARNING**

There may have been subsequent alteration to the surface levels. Trial holes must be undertaken to determine position and depths of cables. HS (G) 47 Booklet from the Health and Safety Executive - Avoiding Danger from Buried Cables - should be consulted before commencing excavation work.


WHEN WORKING IN THE VICINITY OF OVERHEAD LINES THE HEALTH AND SAFETY GUIDANCE NOTES G56 SHOULD BE CONSULTED (AVAILABLE FROM THE HSE WEBSITE)

**Southern Electric Power Distribution plc**  
 Registered Office: No.1 Forbury Place  
 43 Forbury Road Reading RG1 3JH  
 Registered In England & Wales No.04094290

If you're unsure & need to seek advice before commencing excavations, please contact:  
 General Enquiries: 0800 048 3516


Subject to revision - Master held by SSEN Asset Data Team:  
[Asset.Data@sse.com](mailto:Asset.Data@sse.com)  
 01256 337 294

Scale: 1:500 (When plotted at A4)

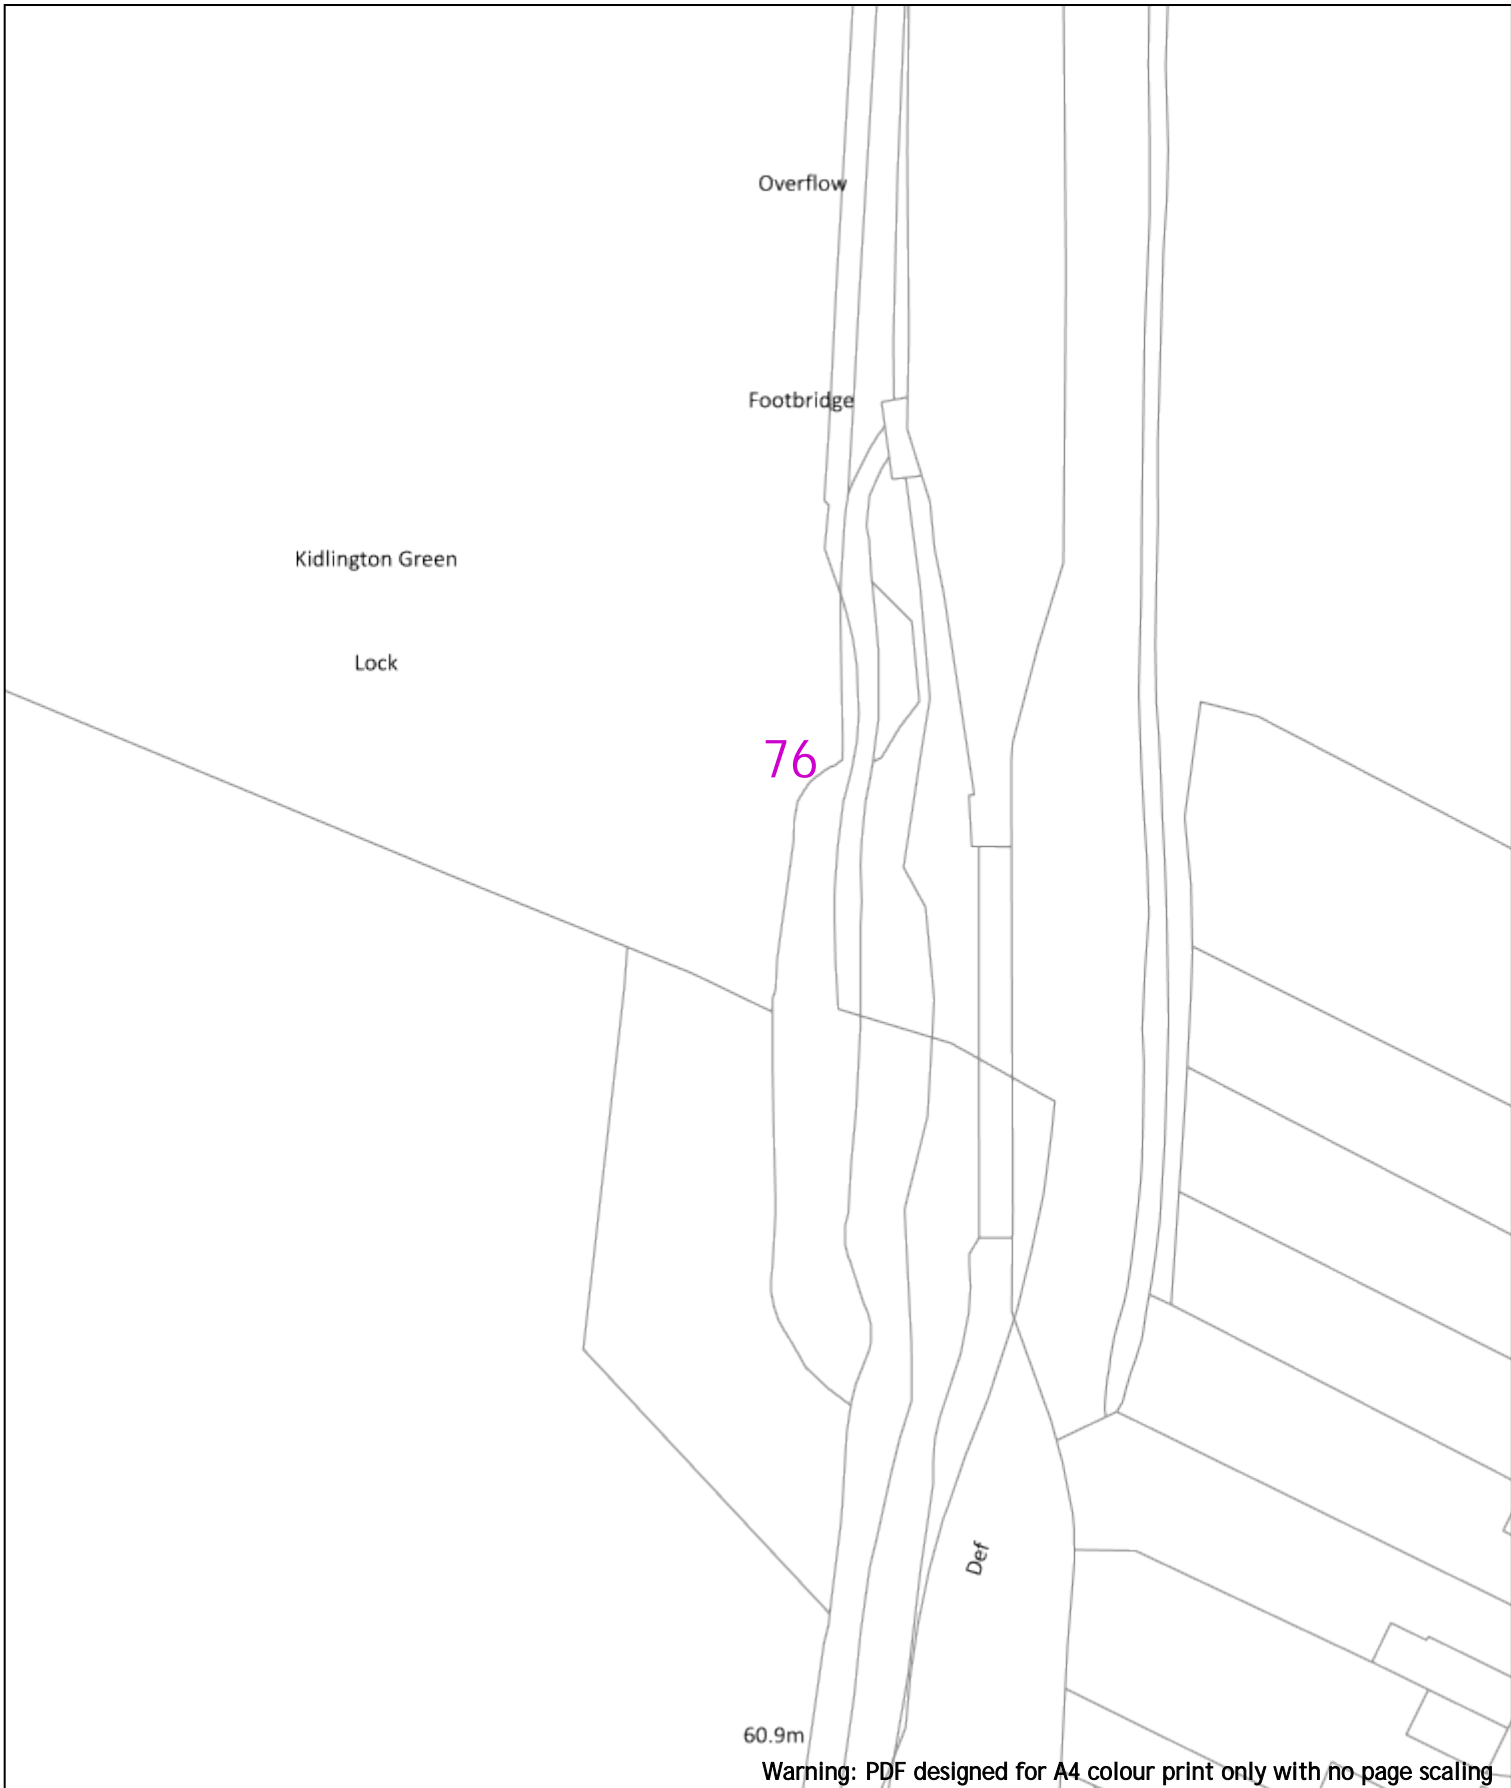

Warning: PDF designed for A4 colour print only with no page scaling

		Dig Sites Area:  Line:		<b>Extra High Voltage cables in vicinity</b>	
Date Requested: 24/06/2022 Job Reference: 25881037 Site Location: 448662 213014 Requested by: Mr Joe Shawyer Your Scheme/Reference: 31188_003		<table border="1"> <thead> <tr> <th colspan="4">Voltages (V)</th> </tr> </thead> <tbody> <tr> <td>LV (Low Voltage) and Services</td> <td colspan="3">Up to 1,000V</td> </tr> <tr> <td>HV (High Voltage)</td> <td colspan="3">Over 1,000V to 11,000V</td> </tr> <tr> <td>EHV (Extra High Voltage)</td> <td colspan="3">22,000V to 132,000V</td> </tr> <tr> <td>Transmission</td> <td colspan="3">275,000V and 400,000V</td> </tr> </tbody> </table> <table border="1"> <thead> <tr> <th colspan="5">NORMAL DEPTH TO THE TOP OF THE CABLE WHEN LAID</th> </tr> <tr> <th>Services</th> <th>LV</th> <th>HV</th> <th>EHV</th> <th></th> </tr> </thead> <tbody> <tr> <td>Footpath/Unmade</td> <td>0.45m</td> <td>0.45m</td> <td>0.6m</td> <td>0.8m</td> </tr> <tr> <td>Road Crossing</td> <td>0.6m</td> <td>0.6m</td> <td>0.75m</td> <td>0.9m</td> </tr> <tr> <td>Agricultural</td> <td>1m</td> <td>1m</td> <td>1m</td> <td>1.1m</td> </tr> </tbody> </table>		Voltages (V)				LV (Low Voltage) and Services	Up to 1,000V			HV (High Voltage)	Over 1,000V to 11,000V			EHV (Extra High Voltage)	22,000V to 132,000V			Transmission	275,000V and 400,000V			NORMAL DEPTH TO THE TOP OF THE CABLE WHEN LAID					Services	LV	HV	EHV		Footpath/Unmade	0.45m	0.45m	0.6m	0.8m	Road Crossing	0.6m	0.6m	0.75m	0.9m	Agricultural	1m	1m	1m	1.1m	<table border="1"> <thead> <tr> <th colspan="2">Legend</th> </tr> </thead> <tbody> <tr><td></td><td>Service Cable</td></tr> <tr><td></td><td>LV Mains</td></tr> <tr><td></td><td>275kV</td></tr> <tr><td></td><td>400kV</td></tr> <tr><td></td><td>Fibre Optic</td></tr> <tr><td></td><td>Pipe Cable</td></tr> </tbody> </table> <table border="1"> <thead> <tr> <th colspan="2">Distribution Structures (Electric)</th> </tr> </thead> <tbody> <tr><td></td><td>Pole, Existing Location</td></tr> <tr><td></td><td>Pole Structure, Existing Location - Single</td></tr> <tr><td></td><td>Pole Structure, Existing Location - H</td></tr> <tr><td></td><td>Duct Route</td></tr> <tr><td></td><td>Cross Section Route</td></tr> </tbody> </table>		Legend			Service Cable		LV Mains		2 - 11kV		66kV		110kV		220kV		330kV		660kV		1320kV		275kV		400kV		Fibre Optic		Pipe Cable	Distribution Structures (Electric)			Pole, Existing Location		Pole Structure, Existing Location - Single		Pole Structure, Existing Location - H		Duct Route		Cross Section Route	<p><b>Southern Electric Power Distribution plc</b>          Registered Office: No.1 Forbury Place          43 Forbury Road Reading RG1 3JH          Registered In England &amp; Wales No.04094290</p> <p>If you're unsure &amp; need to seek advice before commencing excavations, please contact:          General Enquiries: 0800 048 3516</p> <p>Subject to revision – Master held by SSEN Asset Data Team:  <a href="mailto:Asset.Data@sse.com">Asset.Data@sse.com</a>          01256 337 294</p>	
Voltages (V)	
LV (Low Voltage) and Services	Up to 1,000V	
HV (High Voltage)	Over 1,000V to 11,000V	
EHV (Extra High Voltage)	22,000V to 132,000V	
Transmission	275,000V and 400,000V	
NORMAL DEPTH TO THE TOP OF THE CABLE WHEN LAID	
Services	LV	HV	EHV	
Footpath/Unmade	0.45m	0.45m	0.6m	0.8m	
Road Crossing	0.6m	0.6m	0.75m	0.9m	
Agricultural	1m	1m	1m	1.1m	
Legend	
	Service Cable	
	LV Mains	
	275kV	
	400kV	
	Fibre Optic	
	Pipe Cable	
Distribution Structures (Electric)	
	Pole, Existing Location	
	Pole Structure, Existing Location - Single	
	Pole Structure, Existing Location - H	
	Duct Route	
	Cross Section Route	
Scale: 1:500 (When plotted at A4)		<p style="color: red; font-size: small;"> <b>WARNING</b>          There may have been subsequent alteration to the surface levels. Trial holes must be undertaken to determine position and depths of cables. HS (G) 47 Booklet from the Health and Safety Executive – Avoiding Danger from Buried Cables – should be consulted before commencing excavation work.  <b>WHEN WORKING IN THE VICINITY OF OVERHEAD LINES THE HEALTH AND SAFETY GUIDANCE NOTES G56 SHOULD BE CONSULTED (AVAILABLE FROM THE HSE WEBSITE)</b> </p>		BASED UPON THE ORDNANCE SURVEY MAP WITH THE SANCTION OF THE CONTROLLER OF HM STATIONERY OFFICE CROWN COPYRIGHT RESERVED. This copy has been made by or with the authority of Scottish and Southern Energy Power Distribution Ltd. Pursuant to section 47 of the Copyright, Designs and Patents Act 1988 ("The Act"). Unless the Act provides a relevant exception to copyright the copy must not be copied without prior permission of the copyright owner. Plans generated by DigSAFE Pro™ software provided by Linesearchbefore4dig.	

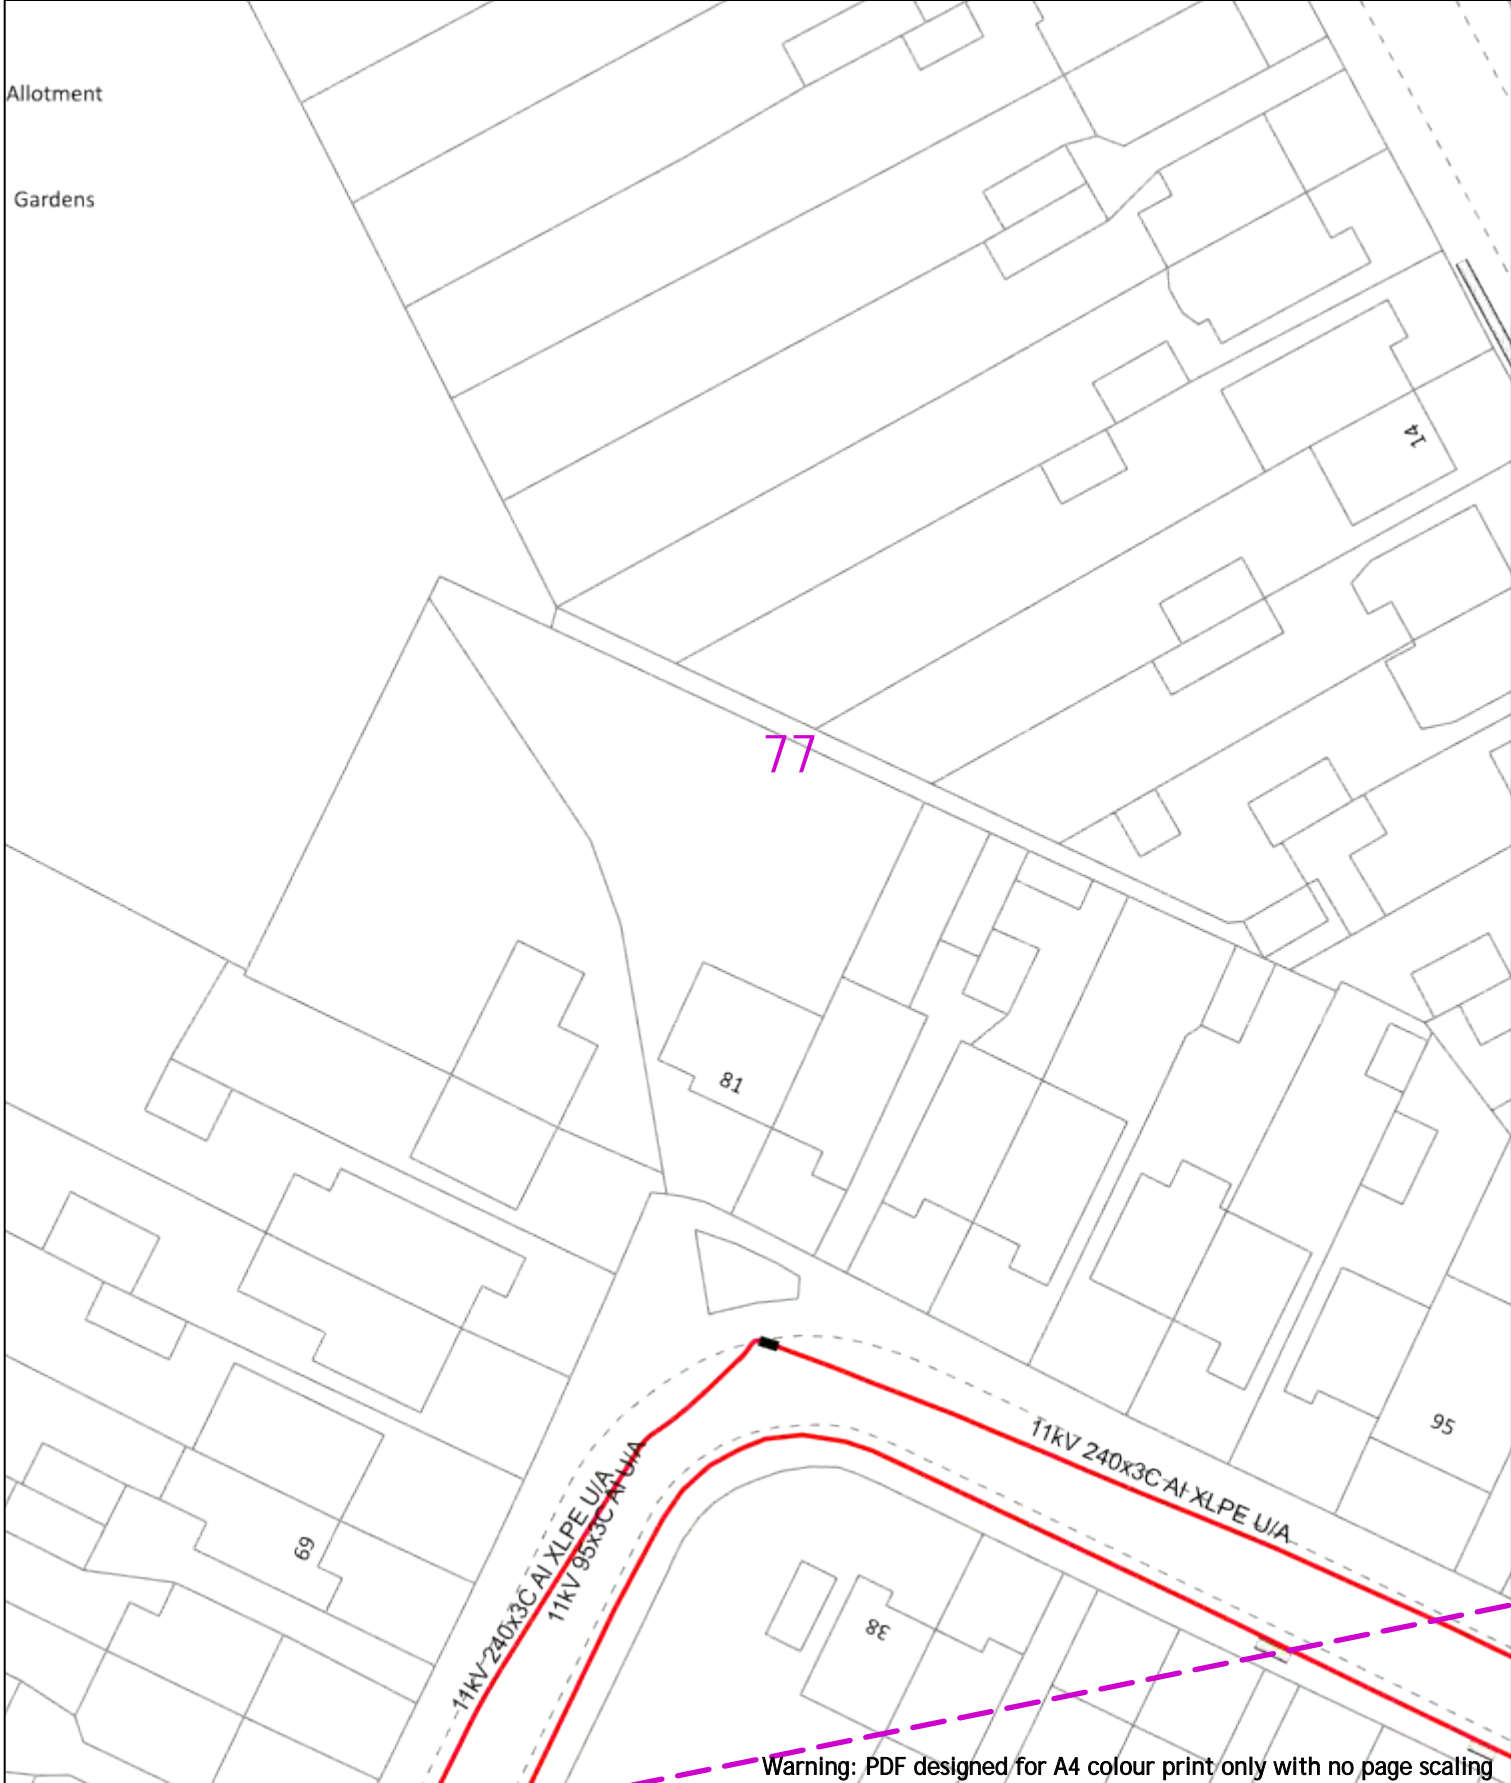

Warning: PDF designed for A4 colour print only with no page scaling



20m Dig Sites Area: Line: **Extra High Voltage cables in vicinity**

Date Requested: 24/06/2022  
 Job Reference: 25881037  
 Site Location: 448662 213014  
 Requested by: Mr Joe Shawyer  
 Your Scheme/Reference: 31188\_003

Voltages (V)			
LV (Low Voltage) and Services	Up to 1,000V		
HV (High Voltage)	Over 1,000V to 11,000V		
EHV (Extra High Voltage)	22,000V to 132,000V		
Transmission	275,000V and 400,000V		
NORMAL DEPTH TO THE TOP OF THE CABLE WHEN LAID			
Services	LV	HV	EHV
Footpath/Unmade	0.45m	0.45m	0.6m
Road Crossing	0.6m	0.6m	0.75m
Agricultural	1m	1m	1.1m

Legend	
	Service Cable
	LV Mains
	66kV
	11kV
	22kV
	33kV
	66kV
	132kV
	275kV
	400kV
	Fibre Optic
	Pilot Cable

Distribution Structures (Electric)	
	Pole, Existing Location
	Pole Structure, Existing Location - Single
	Pole Structure, Existing Location - H
	Duct Route
	Cross Section Route




**Southern Electric Power Distribution plc**  
 Registered Office: No.1 Forbury Place  
 43 Forbury Road Reading RG1 3JH  
 Registered In England & Wales No.04094290

If you're unsure & need to seek advice before commencing excavations, please contact:  
 General Enquiries: 0800 048 3516

Subject to revision – Master held by SSEN Asset Data Team:  
[Asset.Data@sse.com](mailto:Asset.Data@sse.com)  
 01256 337 294


Scale: 1:500 (When plotted at A4)

**WARNING**  
 There may have been subsequent alteration to the surface levels. Trial holes must be undertaken to determine position and depths of cables. HS (G) 47 Booklet from the Health and Safety Executive – Avoiding Danger from Buried Cables – should be consulted before commencing excavation work.  
 WHEN WORKING IN THE VICINITY OF OVERHEAD LINES THE HEALTH AND SAFETY GUIDANCE NOTES G56 SHOULD BE CONSULTED (AVAILABLE FROM THE HSE WEBSITE)

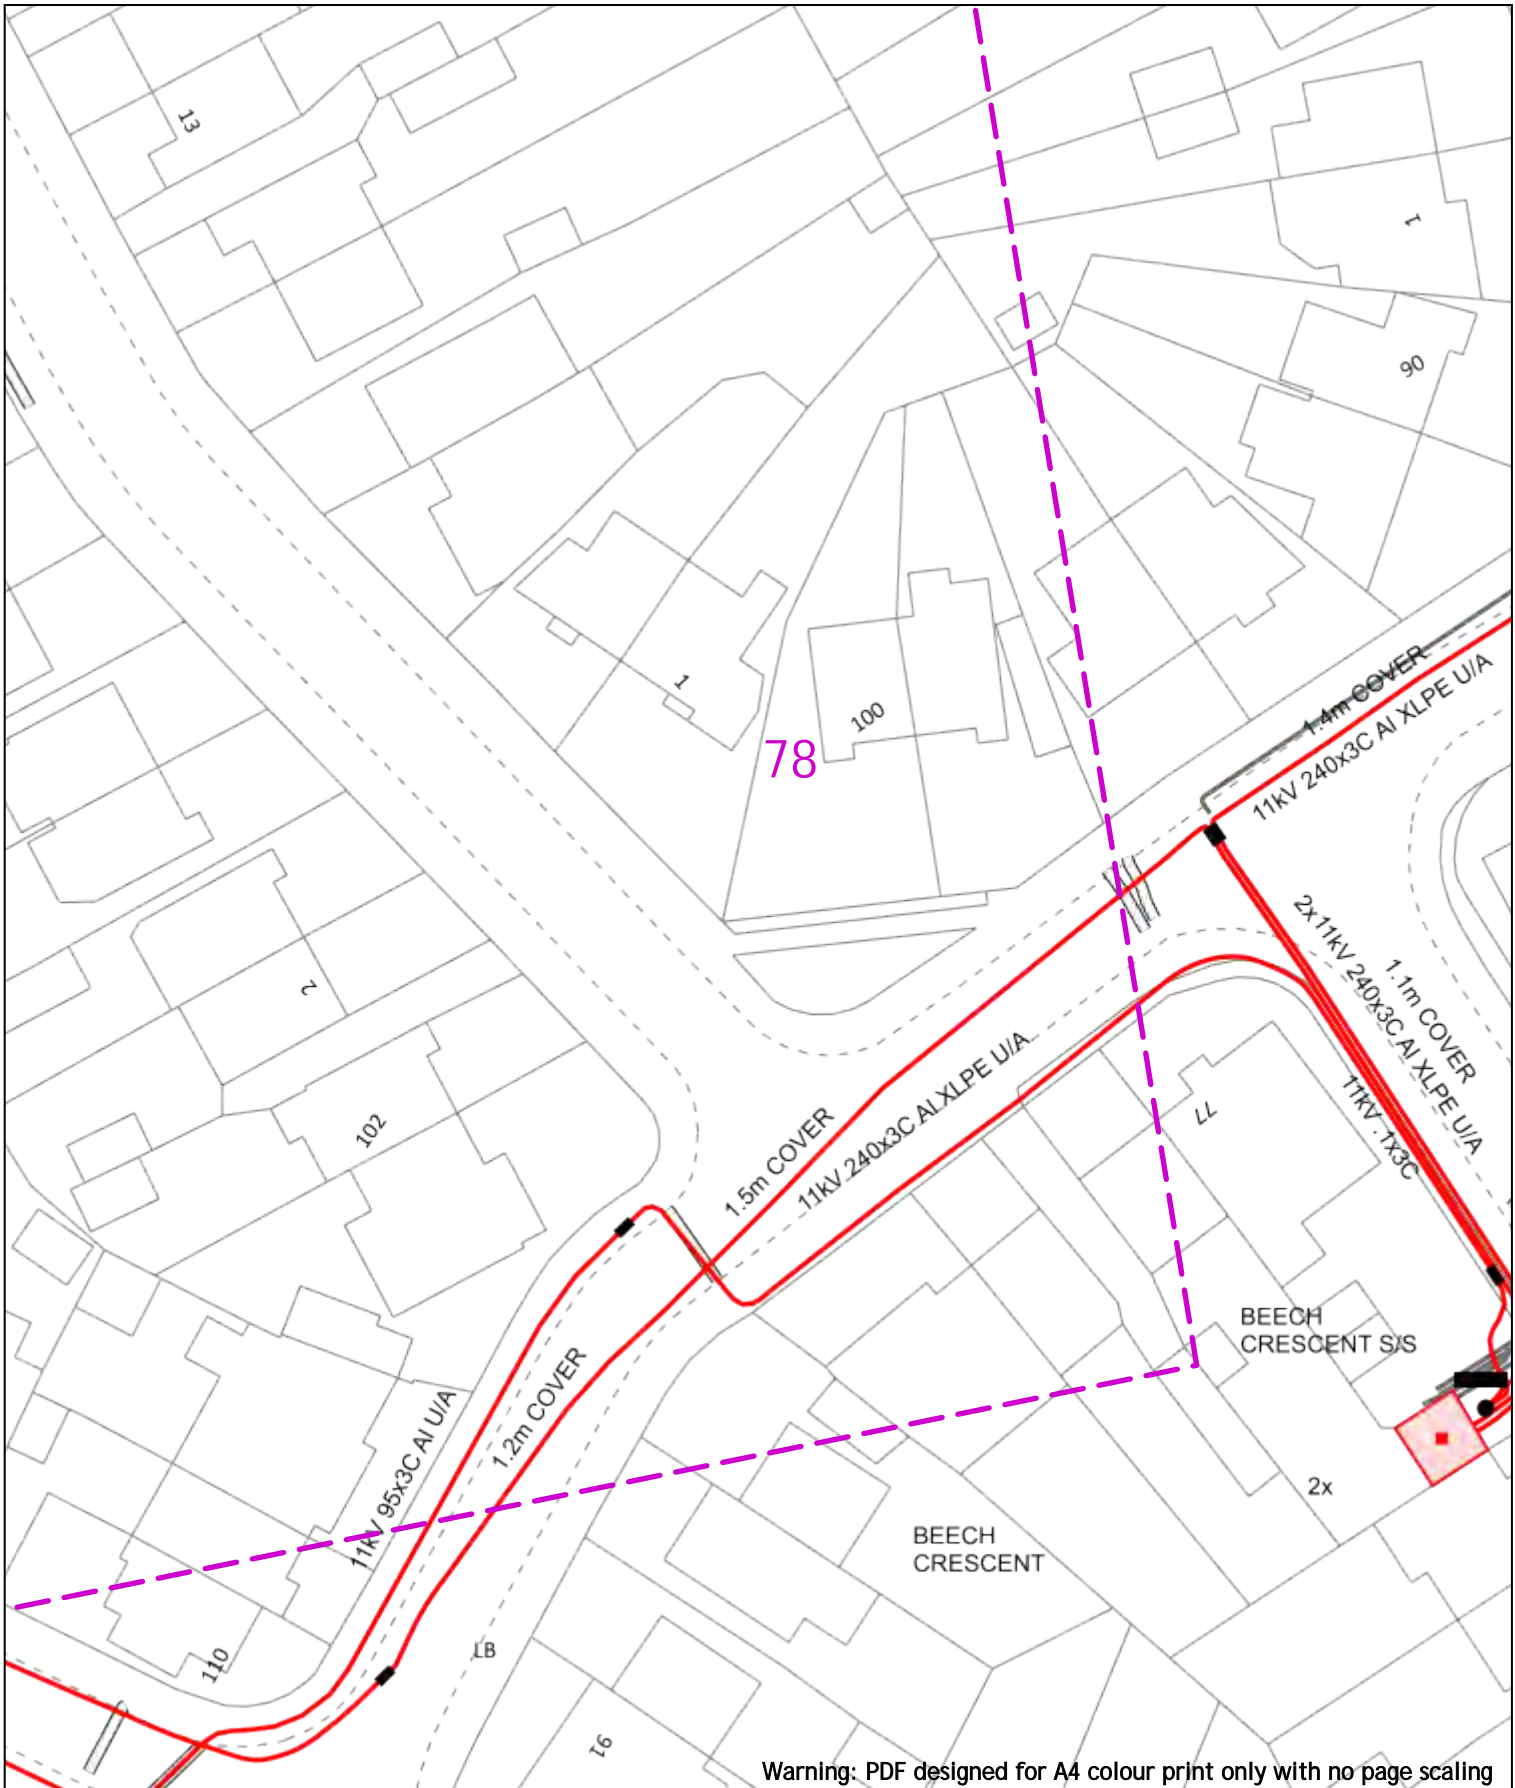

Warning: PDF designed for A4 colour print only with no page scaling

<p>0  20m Dig Sites Area:  Line:  <b>Extra High Voltage cables in vicinity</b></p>																											
<p>Date Requested: 24/06/2022          Job Reference: 25881037          Site Location: 448662 213014          Requested by: Mr Joe Shawyer          Your Scheme/Reference: 31188_003</p>																											
<p><b>Voltages (V)</b></p> <table border="1"> <tr> <td>LV (Low Voltage) and Services</td> <td>Up to 1,000V</td> </tr> <tr> <td>HV (High Voltage)</td> <td>Over 1,000V to 11,000V</td> </tr> <tr> <td>EHV (Extra High Voltage)</td> <td>22,000V to 132,000V</td> </tr> <tr> <td>Transmission</td> <td>275,000V and 400,000V</td> </tr> </table> <p><b>NORMAL DEPTH TO THE TOP OF THE CABLE WHEN LAID</b></p> <table border="1"> <thead> <tr> <th>Services</th> <th>LV</th> <th>HV</th> <th>EHV</th> </tr> </thead> <tbody> <tr> <td>Footpath/Unmade</td> <td>0.45m</td> <td>0.45m</td> <td>0.6m</td> </tr> <tr> <td>Road Crossing</td> <td>0.6m</td> <td>0.6m</td> <td>0.75m</td> </tr> <tr> <td>Agricultural</td> <td>1m</td> <td>1m</td> <td>1.1m</td> </tr> </tbody> </table>		LV (Low Voltage) and Services	Up to 1,000V	HV (High Voltage)	Over 1,000V to 11,000V	EHV (Extra High Voltage)	22,000V to 132,000V	Transmission	275,000V and 400,000V	Services	LV	HV	EHV	Footpath/Unmade	0.45m	0.45m	0.6m	Road Crossing	0.6m	0.6m	0.75m	Agricultural	1m	1m	1.1m	<p><b>Legend</b></p> <ul style="list-style-type: none"> <li>Service Cable</li> <li>LV Mains</li> <li>11kV</li> <li>22kV</li> <li>33kV</li> <li>66kV</li> <li>132kV</li> <li>275kV</li> <li>400kV</li> <li>Fibre Optic</li> <li>Pipe Cable</li> </ul> <p><b>Distribution Structures (Electric)</b></p> <ul style="list-style-type: none"> <li>Pole, Existing Location</li> <li>Pole Structure, Existing Location - Single</li> <li>Pole Structure, Existing Location - H</li> <li>Duct Route</li> <li>Cross Section Route</li> </ul>	
LV (Low Voltage) and Services	Up to 1,000V																										
HV (High Voltage)	Over 1,000V to 11,000V																										
EHV (Extra High Voltage)	22,000V to 132,000V																										
Transmission	275,000V and 400,000V																										
Services	LV	HV	EHV																								
Footpath/Unmade	0.45m	0.45m	0.6m																								
Road Crossing	0.6m	0.6m	0.75m																								
Agricultural	1m	1m	1.1m																								
<p>Scale: 1:500 (When plotted at A4)</p> <p><b>WARNING</b></p> <p>There may have been subsequent alteration to the surface levels. Trial holes must be undertaken to determine position and depths of cables. HS (G) 47 Booklet from the Health and Safety Executive - Avoiding Danger from Buried Cables - should be consulted before commencing excavation work.</p> <p>WHEN WORKING IN THE VICINITY OF OVERHEAD LINES THE HEALTH AND SAFETY GUIDANCE NOTES G56 SHOULD BE CONSULTED (AVAILABLE FROM THE HSE WEBSITE)</p>		<p><b>Southern Electric Power Distribution plc</b>          Registered Office: No.1 Forbury Place          43 Forbury Road Reading RG1 3JH          Registered In England &amp; Wales No.04094290</p> <p>If you're unsure &amp; need to seek advice before commencing excavations, please contact:          General Enquiries: 0800 048 3516</p> <p>Subject to revision - Master held by SSEN Asset Data Team:  <a href="mailto:Asset.Data@sse.com">Asset.Data@sse.com</a>          01256 337 294</p>																									

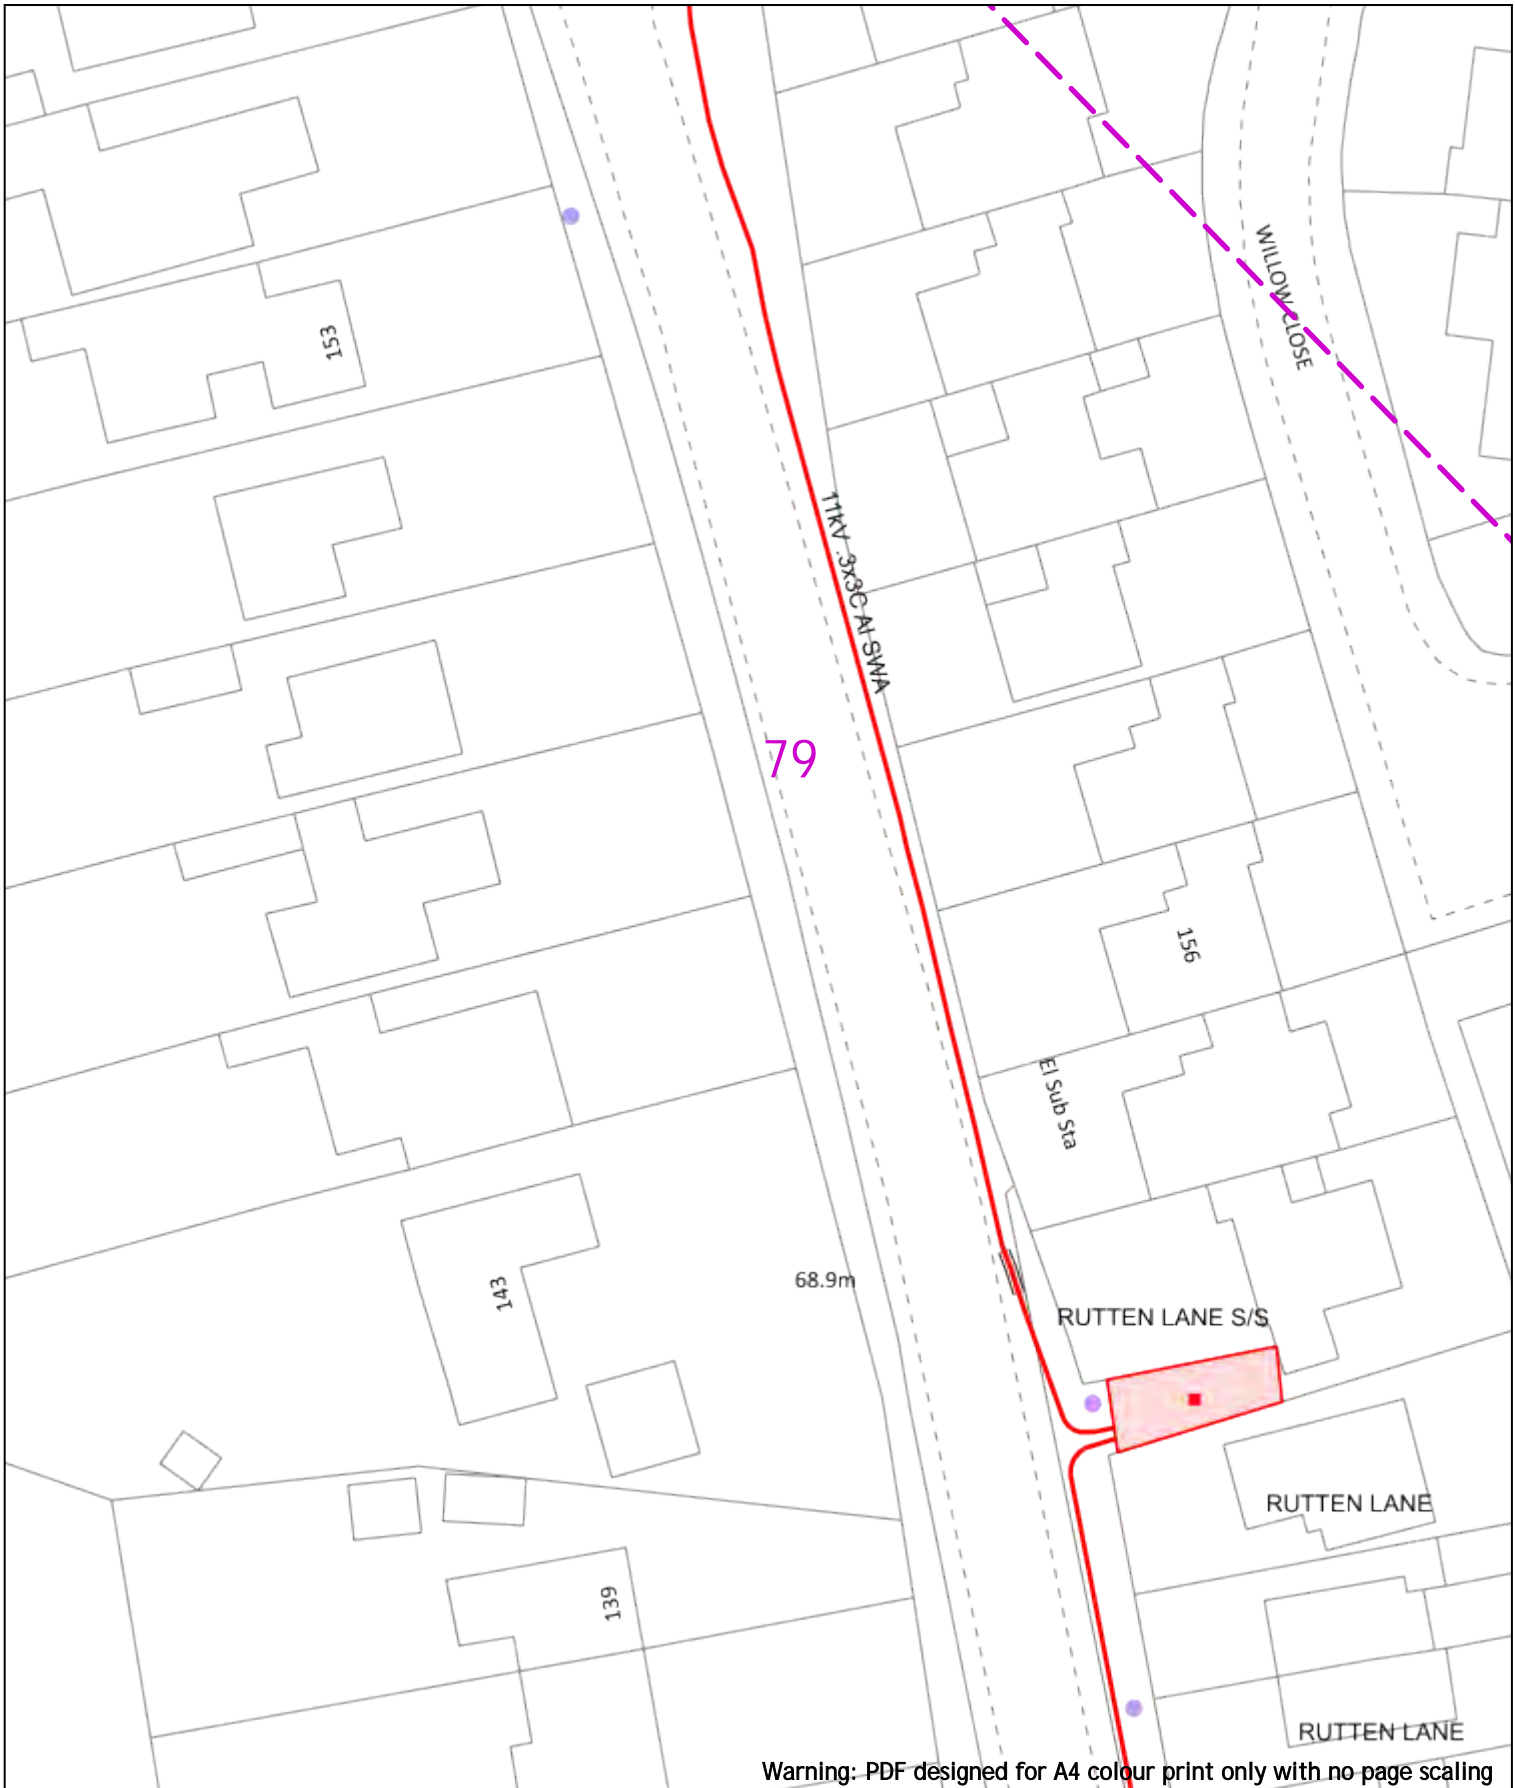

Warning: PDF designed for A4 colour print only with no page scaling



20m Dig Sites Area: Line: Extra High Voltage cables in vicinity

Date Requested: 24/06/2022  
 Job Reference: 25881037  
 Site Location: 448662 213014  
 Requested by: Mr Joe Shawyer  
 Your Scheme/Reference: 31188\_003

Voltages (V)			
LV (Low Voltage) and Services	Up to 1,000V		
HV (High Voltage)	Over 1,000V to 11,000V		
EHV (Extra High Voltage)	22,000V to 132,000V		
Transmission	275,000V and 400,000V		
NORMAL DEPTH TO THE TOP OF THE CABLE WHEN LAID			
Services	LV	HV	EHV
Footpath/Unmade	0.45m	0.45m	0.6m
Road Crossing	0.6m	0.6m	0.75m
Agricultural	1m	1m	1.1m

Legend	
	Service Cable
	LV Mains
	2 - 11kV
	66kV
	11kV
	22kV
	33kV
	66kV
	132kV
	275kV
	400kV
	Fibre Optic
	Pipe Cable


Distribution Structures (Electric)	
	Pole, Existing Location
	Pole Structure, Existing Location - Single
	Pole Structure, Existing Location - H
	Duct Route
	Cross Section Route



**Southern Electric Power Distribution plc**  
 Registered Office: No.1 Forbury Place  
 43 Forbury Road Reading RG1 3JH  
 Registered In England & Wales No.04094290


If you're unsure & need to seek advice before commencing excavations, please contact:  
 General Enquiries: 0800 048 3516

Subject to revision – Master held by SSEN Asset Data Team:  
[Asset.Data@sse.com](mailto:Asset.Data@sse.com)  
 01256 337 294

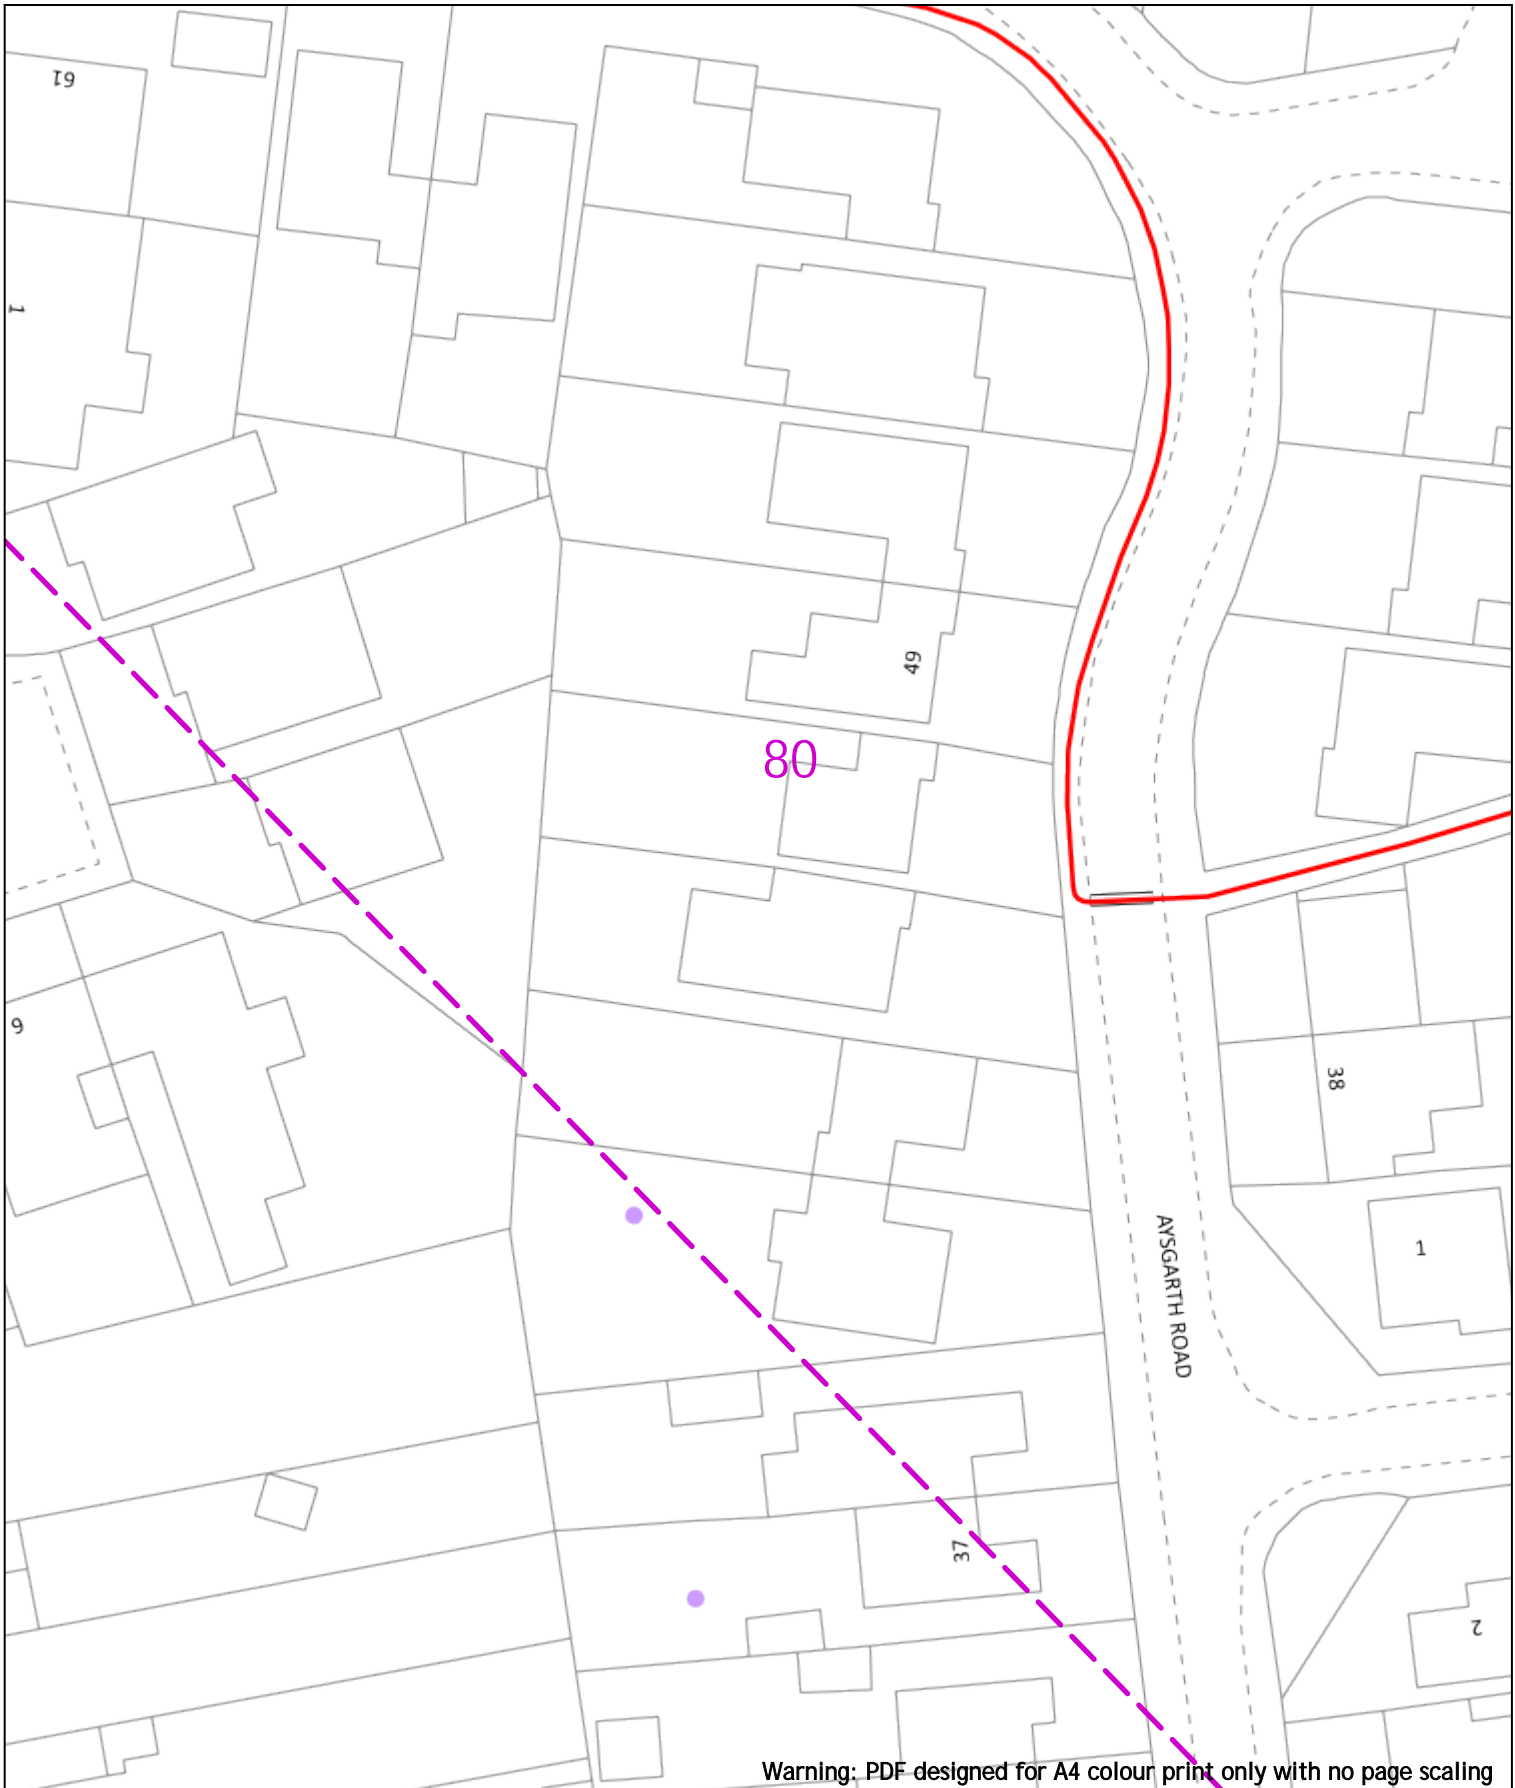

Warning: PDF designed for A4 colour print only with no page scaling

<p>0  20m Dig Sites Area:  Line:  <b>Extra High Voltage cables in vicinity</b></p>	
<p>Date Requested: 24/06/2022          Job Reference: 25881037          Site Location: 448662 213014          Requested by: Mr Joe Shawyer          Your Scheme/Reference: 31188_003</p>	<table border="1"> <thead> <tr> <th colspan="4">Voltages (V)</th> </tr> </thead> <tbody> <tr> <td>LV (Low Voltage) and Services</td> <td colspan="3">Up to 1,000V</td> </tr> <tr> <td>HV (High Voltage)</td> <td colspan="3">Over 1,000V to 11,000V</td> </tr> <tr> <td>EHV (Extra High Voltage)</td> <td colspan="3">22,000V to 132,000V</td> </tr> <tr> <td>Transmission</td> <td colspan="3">275,000V and 400,000V</td> </tr> <tr> <th colspan="4">NORMAL DEPTH TO THE TOP OF THE CABLE WHEN LAID</th> </tr> <tr> <td>Services</td> <td>LV</td> <td>HV</td> <td>EHV</td> </tr> <tr> <td>Footpath/Unmade</td> <td>0.45m</td> <td>0.45m</td> <td>0.6m</td> </tr> <tr> <td>Road Crossing</td> <td>0.6m</td> <td>0.6m</td> <td>0.75m</td> </tr> <tr> <td>Agricultural</td> <td>1m</td> <td>1m</td> <td>1.1m</td> </tr> </tbody> </table>			Voltages (V)				LV (Low Voltage) and Services	Up to 1,000V			HV (High Voltage)	Over 1,000V to 11,000V			EHV (Extra High Voltage)	22,000V to 132,000V			Transmission	275,000V and 400,000V			NORMAL DEPTH TO THE TOP OF THE CABLE WHEN LAID				Services	LV	HV	EHV	Footpath/Unmade	0.45m	0.45m	0.6m	Road Crossing	0.6m	0.6m	0.75m	Agricultural	1m	1m	1.1m	<table border="1"> <thead> <tr> <th colspan="2">Legend</th> <th colspan="2">Distribution Structures (Electric)</th> </tr> </thead> <tbody> <tr> <td></td> <td>Service Cable</td> <td></td> <td>Pole, Existing Location</td> </tr> <tr> <td></td> <td>LV Mains</td> <td></td> <td>Pole Structure, Existing Location - Single</td> </tr> <tr> <td></td> <td>66kV</td> <td></td> <td>Pole Structure, Existing Location - H</td> </tr> <tr> <td></td> <td>11kV</td> <td></td> <td>Duct Route</td> </tr> <tr> <td></td> <td>22kV</td> <td></td> <td>Cross Section Route</td> </tr> <tr> <td></td> <td>33kV</td> <td></td> <td></td> </tr> <tr> <td></td> <td>66kV</td> <td></td> <td></td> </tr> <tr> <td></td> <td>132kV</td> <td></td> <td></td> </tr> <tr> <td></td> <td>275kV</td> <td></td> <td></td> </tr> <tr> <td></td> <td>400kV</td> <td></td> <td></td> </tr> <tr> <td></td> <td>Fibre Optic</td> <td></td> <td></td> </tr> <tr> <td></td> <td>Pipe Cable</td> <td></td> <td></td> </tr> </tbody> </table> <p><b>WARNING</b>          There may have been subsequent alteration to the surface levels. Trial holes must be undertaken to determine position and depths of cables. HS (G) 47 Booklet from the Health and Safety Executive - Avoiding Danger from Buried Cables - should be consulted before commencing excavation work.  <b>WHEN WORKING IN THE VICINITY OF OVERHEAD LINES THE HEALTH AND SAFETY GUIDANCE NOTES G56 SHOULD BE CONSULTED (AVAILABLE FROM THE HSE WEBSITE)</b></p>	Legend		Distribution Structures (Electric)			Service Cable		Pole, Existing Location		LV Mains		Pole Structure, Existing Location - Single		66kV		Pole Structure, Existing Location - H		11kV		Duct Route		22kV		Cross Section Route		33kV				66kV				132kV				275kV				400kV				Fibre Optic				Pipe Cable
<p>Scale: 1:500 (When plotted at A4)</p>		<p><b>Southern Electric Power Distribution plc</b>          Registered Office: No.1 Forbury Place          43 Forbury Road Reading RG1 3JH          Registered In England &amp; Wales No.04094290</p> <p>If you're unsure &amp; need to seek advice before commencing excavations, please contact:          General Enquiries: 0800 048 3516</p> <p>Subject to revision - Master held by SSEN Asset Data Team:  <a href="mailto:Asset.Data@sse.com">Asset.Data@sse.com</a>          01256 337 294</p>	

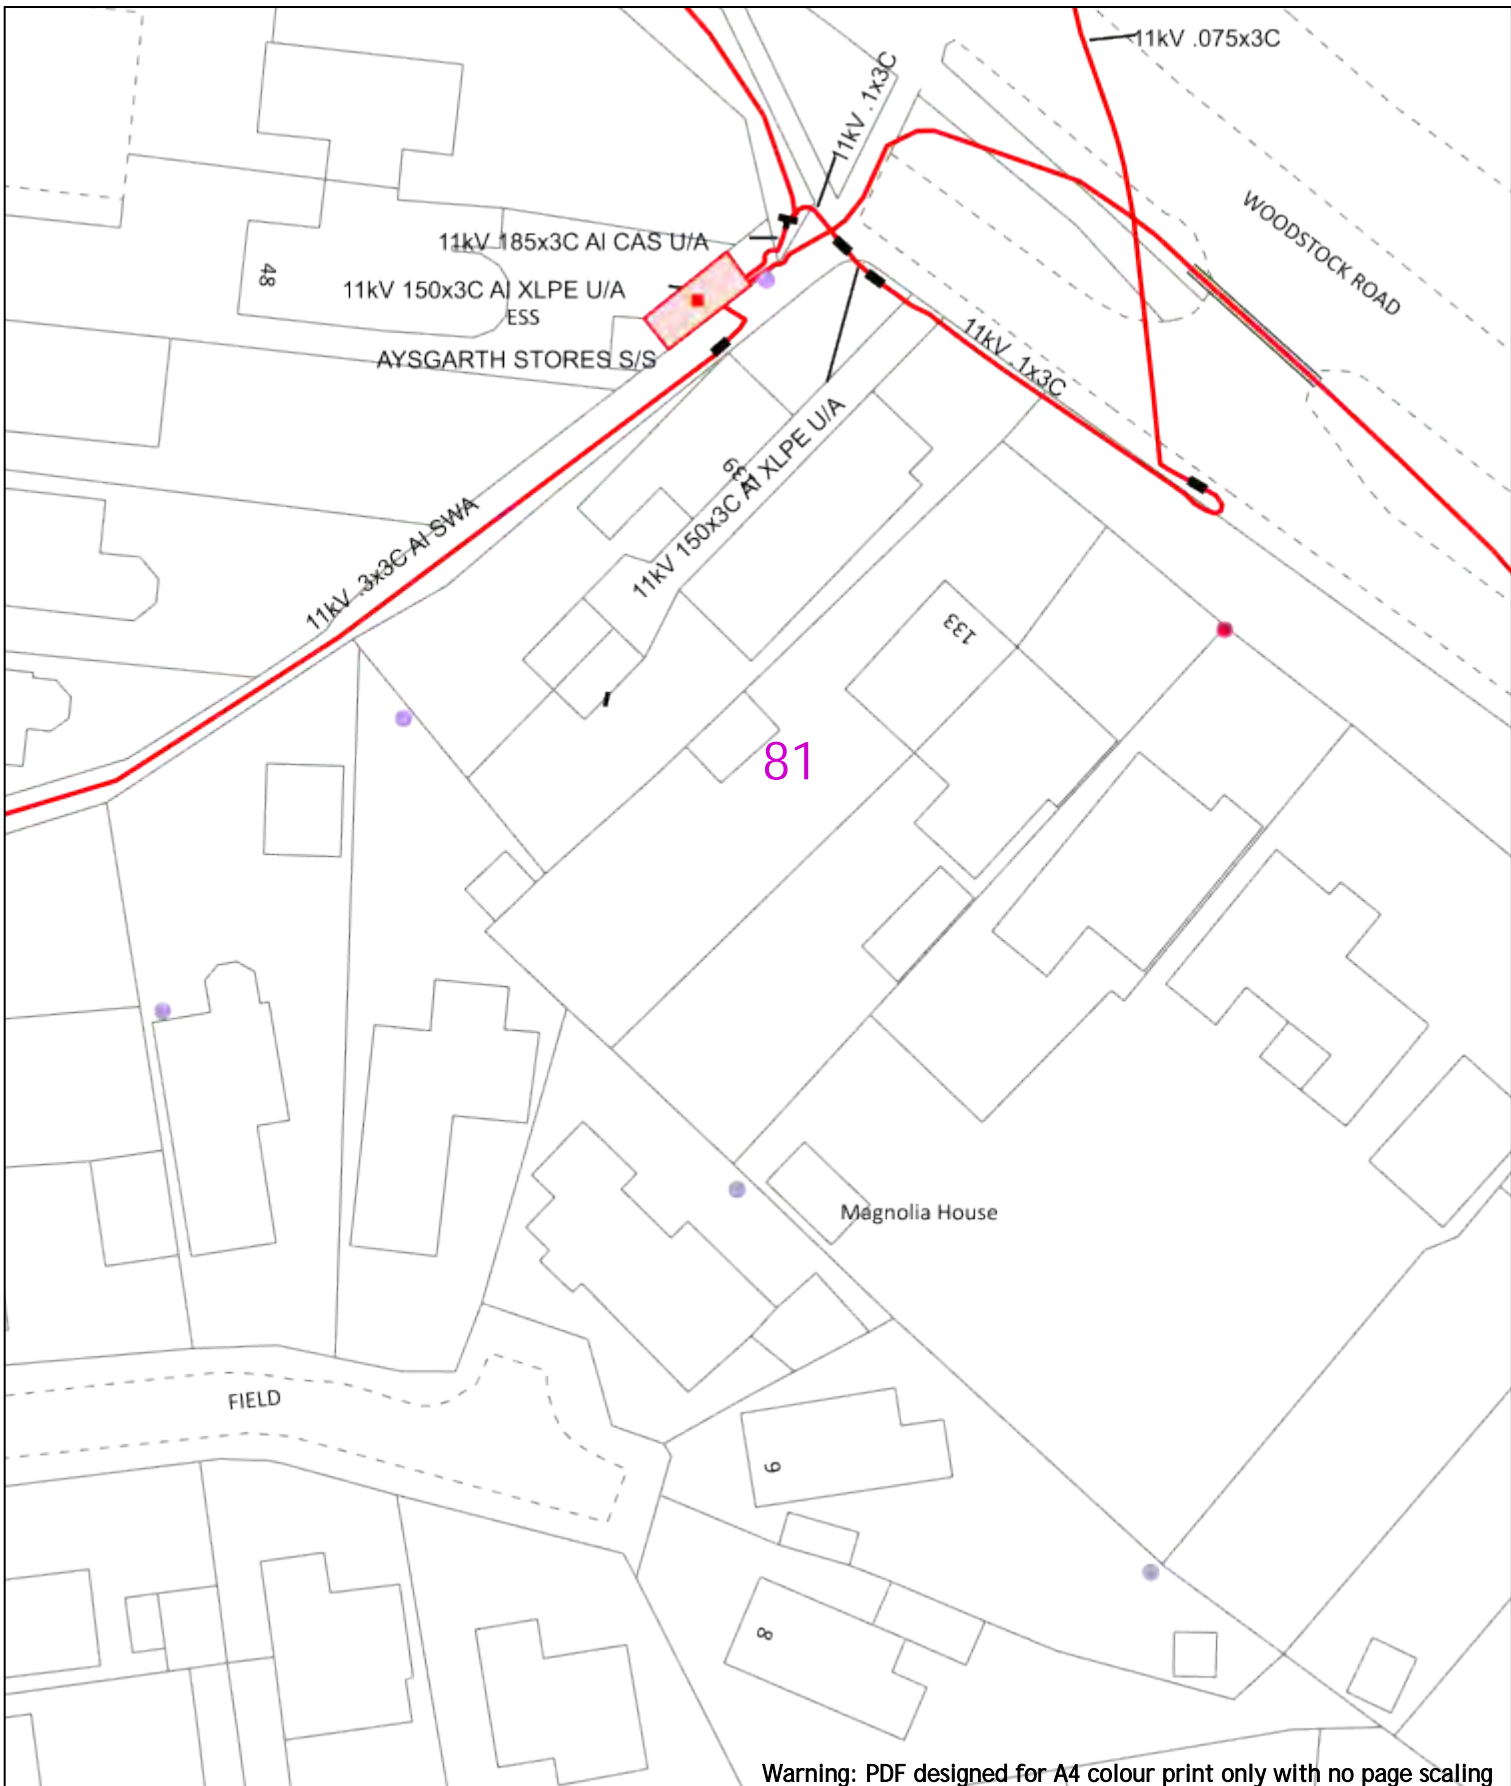

0 20m Dig Sites Area: Line: Extra High Voltage cables in vicinity

Date Requested: 24/06/2022  
 Job Reference: 25881037  
 Site Location: 448662 213014  
 Requested by: Mr Joe Shawyer  
 Your Scheme/Reference: 31188\_003

Voltages (V)			
LV (Low Voltage) and Services	Up to 1,000V		
HV (High Voltage)	Over 1,000V to 11,000V		
EHV (Extra High Voltage)	22,000V to 132,000V		
Transmission	275,000V and 400,000V		
NORMAL DEPTH TO THE TOP OF THE CABLE WHEN LAID			
Services	LV	HV	EHV
Footpath/Unmade	0.45m	0.45m	0.6m
Road Crossing	0.6m	0.6m	0.75m
Agricultural	1m	1m	1.1m

Legend		Distribution Structures (Electric)	
	Service Cable		Pole, Existing Location
	LV Mains		Pole Structure, Existing Location - Single
	66kV		Pole Structure, Existing Location - H
	11kV		Duct Route
	22kV		Cross Section Route
	33kV		
	66kV		
	132kV		
	275kV		
	400kV		
	Fibre Optic		
	Pilot Cable		


**WARNING**  
 There may have been subsequent alteration to the surface levels. Trial holes must be undertaken to determine position and depths of cables. HS (G) 47 Booklet from the Health and Safety Executive - Avoiding Danger from Buried Cables - should be consulted before commencing excavation work.  
 WHEN WORKING IN THE VICINITY OF OVERHEAD LINES THE HEALTH AND SAFETY GUIDANCE NOTES G56 SHOULD BE CONSULTED (AVAILABLE FROM THE HSE WEBSITE)

**Southern Electric Power Distribution plc**  
 Registered Office: No.1 Forbury Place  
 43 Forbury Road Reading RG1 3JH  
 Registered In England & Wales No.04094290

If you're unsure & need to seek advice before commencing excavations, please contact:  
 General Enquiries: 0800 048 3516

Subject to revision - Master held by SSEN Asset Data Team:  
[Asset.Data@sse.com](mailto:Asset.Data@sse.com)  
 01256 337 294



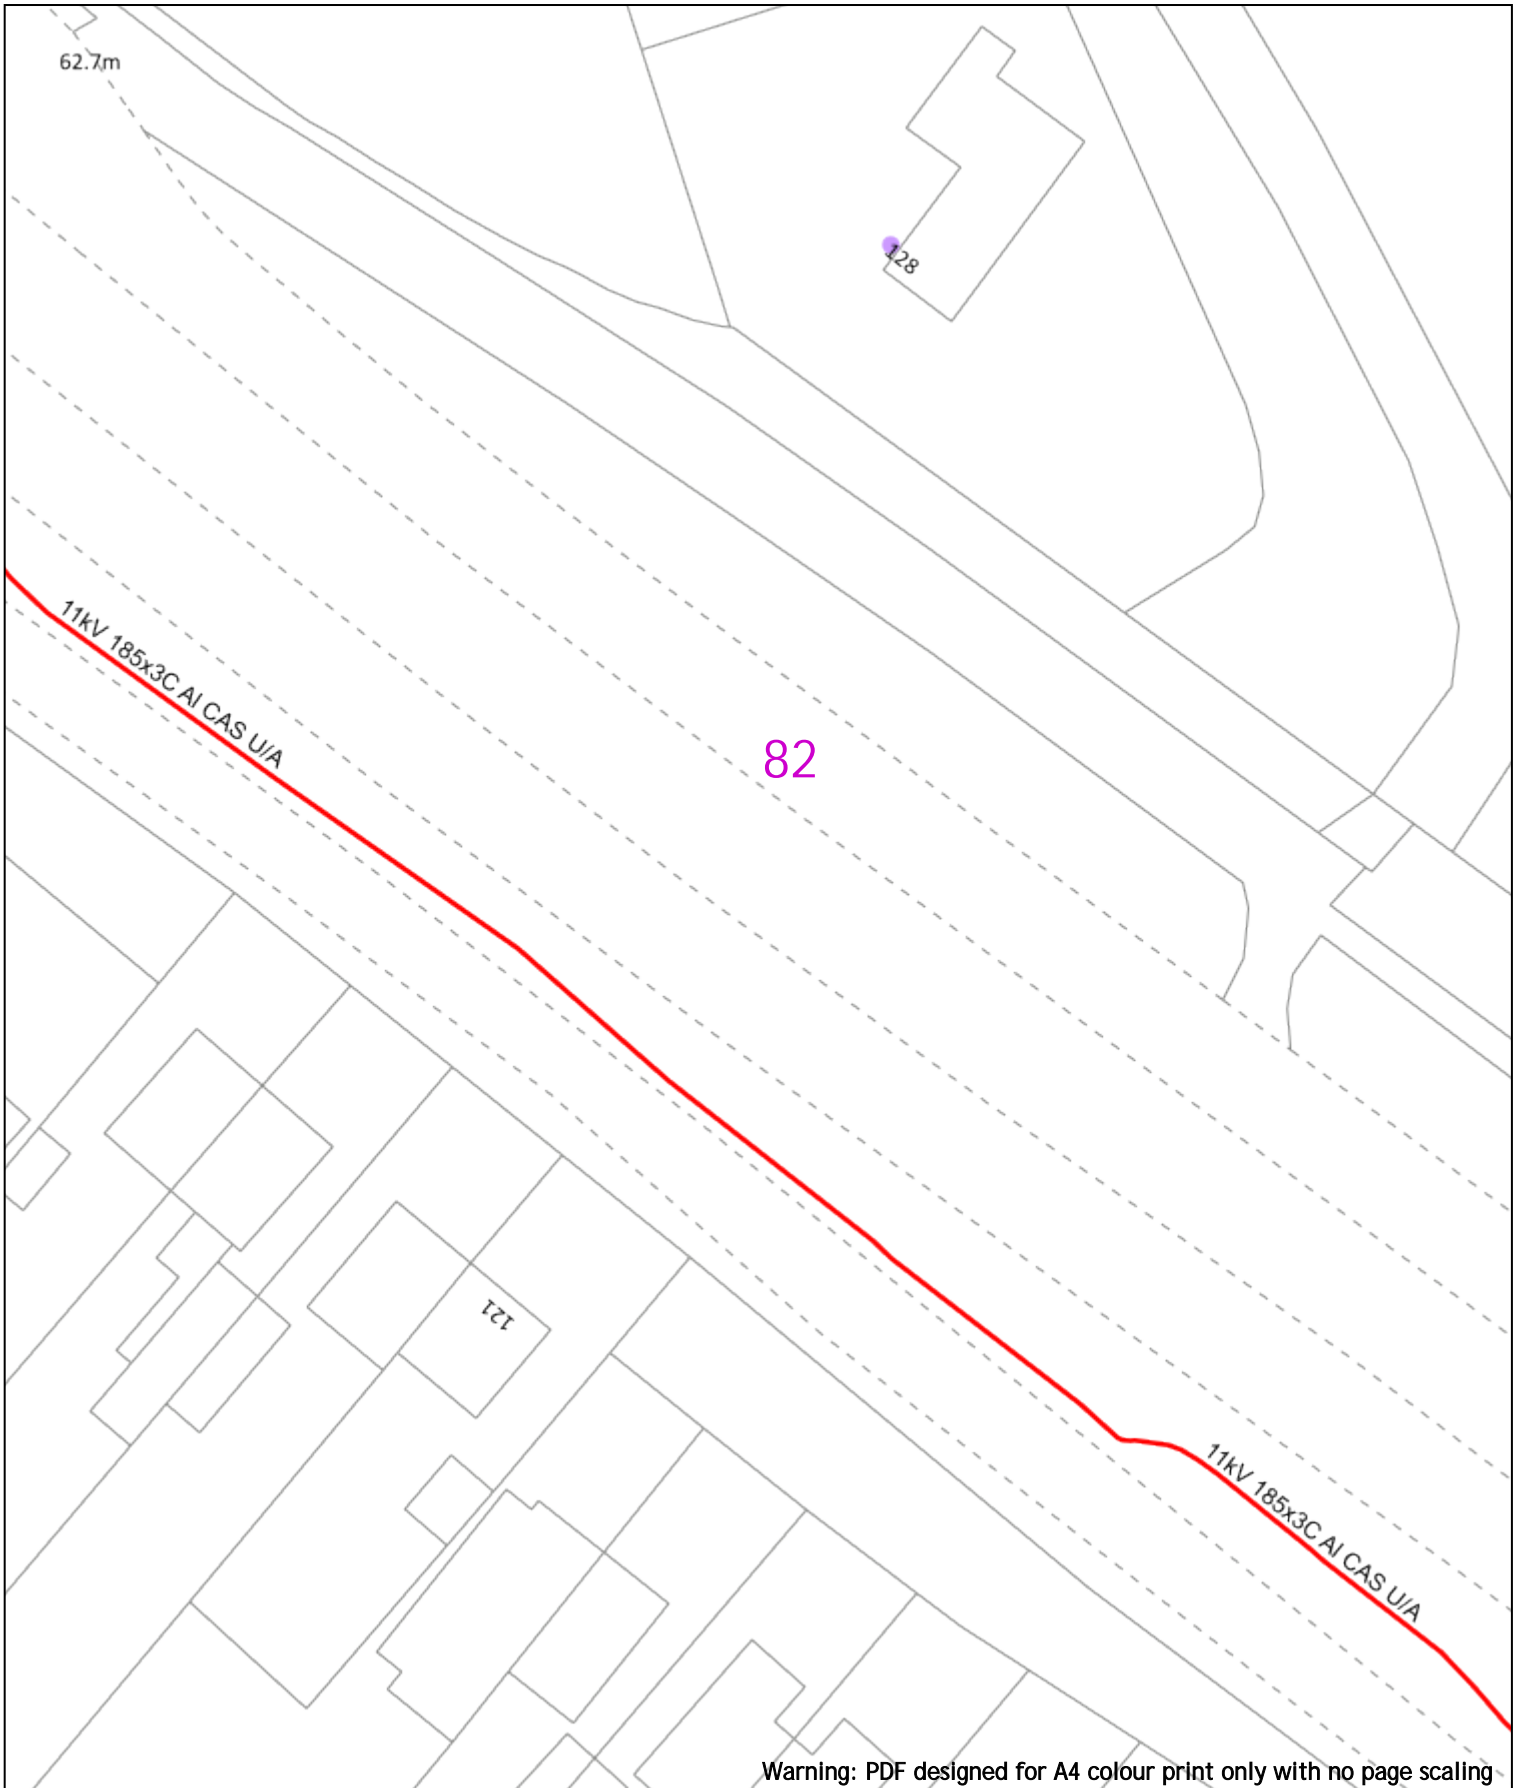

Warning: PDF designed for A4 colour print only with no page scaling

<p>0  20m Dig Sites Area:  Line:  <b>Extra High Voltage cables in vicinity</b></p>	
<p>Date Requested: 24/06/2022          Job Reference: 25881037          Site Location: 448662 213014          Requested by: Mr Joe Shawyer          Your Scheme/Reference: 31188_003</p>	<table border="1"> <thead> <tr> <th colspan="4">Voltages (V)</th> </tr> </thead> <tbody> <tr> <td>LV (Low Voltage) and Services</td> <td colspan="3">Up to 1,000V</td> </tr> <tr> <td>HV (High Voltage)</td> <td colspan="3">Over 1,000V to 11,000V</td> </tr> <tr> <td>EHV (Extra High Voltage)</td> <td colspan="3">22,000V to 132,000V</td> </tr> <tr> <td>Transmission</td> <td colspan="3">275,000V and 400,000V</td> </tr> <tr> <th colspan="4">NORMAL DEPTH TO THE TOP OF THE CABLE WHEN LAID</th> </tr> <tr> <td>Services</td> <td>LV</td> <td>HV</td> <td>EHV</td> </tr> <tr> <td>Footpath/Unmade</td> <td>0.45m</td> <td>0.45m</td> <td>0.6m</td> </tr> <tr> <td>Road Crossing</td> <td>0.6m</td> <td>0.6m</td> <td>0.75m</td> </tr> <tr> <td>Agricultural</td> <td>1m</td> <td>1m</td> <td>1.1m</td> </tr> </tbody> </table>			Voltages (V)				LV (Low Voltage) and Services	Up to 1,000V			HV (High Voltage)	Over 1,000V to 11,000V			EHV (Extra High Voltage)	22,000V to 132,000V			Transmission	275,000V and 400,000V			NORMAL DEPTH TO THE TOP OF THE CABLE WHEN LAID				Services	LV	HV	EHV	Footpath/Unmade	0.45m	0.45m	0.6m	Road Crossing	0.6m	0.6m	0.75m	Agricultural	1m	1m	1.1m	<table border="1"> <thead> <tr> <th colspan="2">Legend</th> <th colspan="2">Distribution Structures (Electric)</th> </tr> </thead> <tbody> <tr> <td></td> <td>Service Cable</td> <td></td> <td>Pole, Existing Location</td> </tr> <tr> <td></td> <td>LV Mains</td> <td></td> <td>Pole Structure, Existing Location - Single</td> </tr> <tr> <td></td> <td>7 - 11kV</td> <td></td> <td>Pole Structure, Existing Location - H</td> </tr> <tr> <td></td> <td>6.6kV</td> <td></td> <td>Duct Route</td> </tr> <tr> <td></td> <td>11kV</td> <td></td> <td>Cross Section Route</td> </tr> <tr> <td></td> <td>22kV</td> <td></td> <td></td> </tr> <tr> <td></td> <td>33kV</td> <td></td> <td></td> </tr> <tr> <td></td> <td>66kV</td> <td></td> <td></td> </tr> <tr> <td></td> <td>132kV</td> <td></td> <td></td> </tr> <tr> <td></td> <td>275kV</td> <td></td> <td></td> </tr> <tr> <td></td> <td>400kV</td> <td></td> <td></td> </tr> <tr> <td></td> <td>Fibre Optic</td> <td></td> <td></td> </tr> <tr> <td></td> <td>Pilot Cable</td> <td></td> <td></td> </tr> </tbody> </table>	Legend		Distribution Structures (Electric)			Service Cable		Pole, Existing Location		LV Mains		Pole Structure, Existing Location - Single		7 - 11kV		Pole Structure, Existing Location - H		6.6kV		Duct Route		11kV		Cross Section Route		22kV				33kV				66kV				132kV				275kV				400kV				Fibre Optic				Pilot Cable
Voltages (V)	
LV (Low Voltage) and Services	Up to 1,000V	
HV (High Voltage)	Over 1,000V to 11,000V	
EHV (Extra High Voltage)	22,000V to 132,000V	
Transmission	275,000V and 400,000V	
NORMAL DEPTH TO THE TOP OF THE CABLE WHEN LAID	
Services	LV	HV	EHV	
Footpath/Unmade	0.45m	0.45m	0.6m	
Road Crossing	0.6m	0.6m	0.75m	
Agricultural	1m	1m	1.1m	
Legend		Distribution Structures (Electric)	
	Service Cable		Pole, Existing Location	
	LV Mains		Pole Structure, Existing Location - Single	
	7 - 11kV		Pole Structure, Existing Location - H	
	6.6kV		Duct Route	
	11kV		Cross Section Route	
	22kV	
	33kV	
	66kV	
	132kV	
	275kV	
	400kV	
	Fibre Optic	
	Pilot Cable	
<p>Scale: 1:500 (When plotted at A4)</p>		<p><b>Southern Electric Power Distribution plc</b>          Registered Office: No.1 Forbury Place          43 Forbury Road Reading RG1 3JH          Registered In England &amp; Wales No.04094290</p> <p>If you're unsure &amp; need to seek advice before commencing excavations, please contact:          General Enquiries: 0800 048 3516</p> <p>Subject to revision – Master held by SSEN Asset Data Team:  <a href="mailto:Asset.Data@sse.com">Asset.Data@sse.com</a>          01256 337 294</p>	

**WARNING**  
 There may have been subsequent alteration to the surface levels. Trial holes must be undertaken to determine position and depths of cables. HS (G) 47 Booklet from the Health and Safety Executive – Avoiding Danger from Buried Cables – should be consulted before commencing excavation work.  
 WHEN WORKING IN THE VICINITY OF OVERHEAD LINES THE HEALTH AND SAFETY GUIDANCE NOTES G56 SHOULD BE CONSULTED (AVAILABLE FROM THE HSE WEBSITE)

BASED UPON THE ORDNANCE SURVEY MAP WITH THE SANCTION OF THE CONTROLLER OF HM STATIONERY OFFICE CROWN COPYRIGHT RESERVED.  
 This copy has been made by or with the authority of Scottish and Southern Energy Power Distribution Ltd. Pursuant to section 47 of the Copyright, Designs and Patents Act 1988 ("The Act"). Unless the Act provides a relevant exception to copyright the copy must not be copied without prior permission of the copyright owner.  
 Plans generated by DigSAFE Pro™ software provided by LinesearchbeforeUdig.

83

Cycle Way

Warning: PDF designed for A4 colour print only with no page scaling

0 20m

Dig Sites

Area:



Line:



Extra High Voltage  
cables in vicinity



Date Requested: 24/06/2022  
Job Reference: 25881037  
Site Location: 448662 213014  
Requested by: Mr Joe Shawyer

Your Scheme/Reference: 31188\_003

Voltages (V)				
LV (Low Voltage) and Services	Up to 1,000V			
HV (High Voltage)	Over 1,000V to 11,000V			
EHV (Extra High Voltage)	22,000V to 132,000V			
Transmission	275,000V and 400,000V			
NORMAL DEPTH TO THE TOP OF THE CABLE WHEN LAID				
Services	LV	HV	EHV	
Footpath/Unmade	0.45m	0.45m	0.6m	0.8m
Road Crossing	0.6m	0.6m	0.75m	0.9m
Agricultural	1m	1m	1m	1.1m

Legend

- Service Cable
- LV Mains
- 2 - 11kV
- 66kV
- 11kV
- 22kV
- 33kV
- 66kV
- 132kV
- 275kV
- 400kV
- Fibre Optic
- Pilot Cable

Distribution Structures (Electric)

- Pole, Existing Location
- Pole Structure, Existing Location - Single
- Pole Structure, Existing Location - H
- Duct Route
- Cross Section Route

**Southern Electric Power Distribution plc**  
Registered Office: No.1 Forbury Place  
43 Forbury Road Reading RG1 3JH  
Registered In England & Wales No.04094290

If you're unsure & need to seek advice before commencing excavations, please contact:  
General Enquiries: 0800 048 3516

Subject to revision - Master held by SSEN Asset Data Team:  
[Asset.Data@sse.com](mailto:Asset.Data@sse.com)  
01256 337 294

Scale: 1:500 (When plotted at A4)

**WARNING**  
There may have been subsequent alteration to the surface levels. Trial holes must be undertaken to determine position and depths of cables. HS (G) 47 Booklet from the Health and Safety Executive - Avoiding Danger from Buried Cables - should be consulted before commencing excavation work.  
**WHEN WORKING IN THE VICINITY OF OVERHEAD LINES THE HEALTH AND SAFETY GUIDANCE NOTES G56 SHOULD BE CONSULTED (AVAILABLE FROM THE HSE WEBSITE)**

Warning: PDF designed for A4 colour print only with no page scaling

0  20m Dig Sites Area:  Line: 

**Extra High Voltage  
cables in vicinity**



Date Requested: 24/06/2022  
 Job Reference: 25881037  
 Site Location: 448662 213014  
 Requested by: Mr Joe Shawyer  
 Your Scheme/Reference: 31188\_003

Voltages (V)			
LV (Low Voltage) and Services	Up to 1,000V		
HV (High Voltage)	Over 1,000V to 11,000V		
EHV (Extra High Voltage)	22,000V to 132,000V		
Transmission	275,000V and 400,000V		
NORMAL DEPTH TO THE TOP OF THE CABLE WHEN LAID			
Services	LV	HV	EHV
Footpath/Unmade	0.45m	0.45m	0.6m 0.8m
Road Crossing	0.6m	0.6m	0.75m 0.9m
Agricultural	1m	1m	1m 1.1m

**Legend**

- Service Cable
- LV Mains
- 2 - 11kV
- 66kV
- 11kV
- 22kV
- 33kV
- 66kV
- 132kV
- 275kV
- 400kV
- Fibre Optic
- Pipit Cable

**Distribution Structures (Electric)**

- Pole, Existing Location
- Pole Structure, Existing Location - Single
- Pole Structure, Existing Location - H
- Duct Route
- Cross Section Route


**WARNING**  
 There may have been subsequent alteration to the surface levels. Trial holes must be undertaken to determine position and depths of cables. HS (G) 47 Booklet from the Health and Safety Executive - Avoiding Danger from Buried Cables - should be consulted before commencing excavation work.  
**WHEN WORKING IN THE VICINITY OF OVERHEAD LINES THE HEALTH AND SAFETY GUIDANCE NOTES G56 SHOULD BE CONSULTED (AVAILABLE FROM THE HSE WEBSITE)**

**Southern Electric Power Distribution plc**  
 Registered Office: No.1 Forbury Place  
 43 Forbury Road Reading RG1 3JH  
 Registered In England & Wales No.04094290

If you're unsure & need to seek advice before commencing excavations, please contact:  
 General Enquiries: 0800 048 3516

Subject to revision - Master held by SSEN Asset Data Team:  
[Asset.Data@sse.com](mailto:Asset.Data@sse.com)  
 01256 337 294

Scale: 1:500 (When plotted at A4)

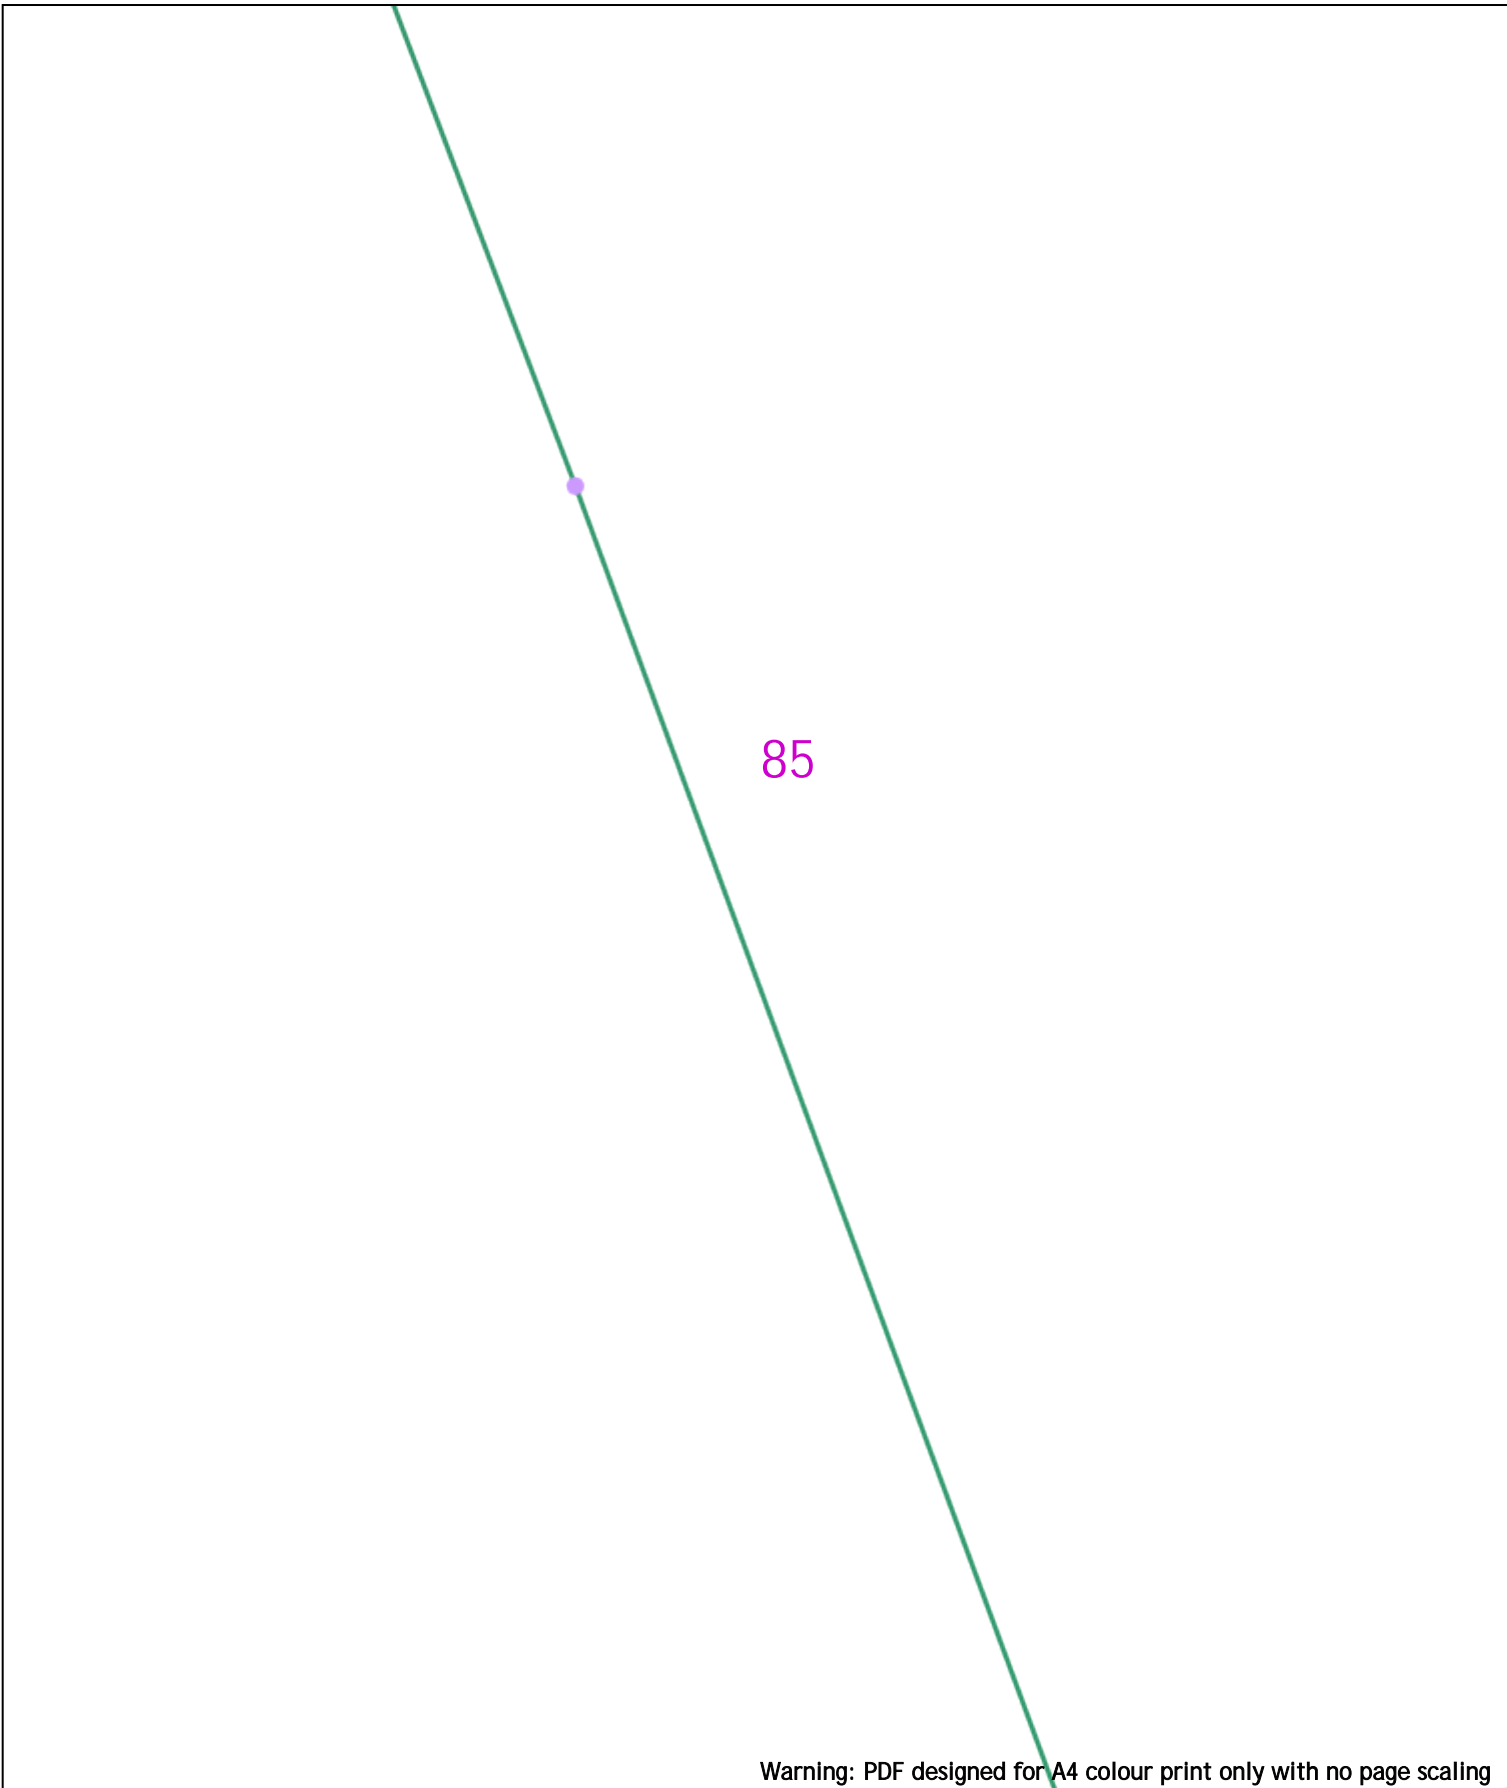

Warning: PDF designed for A4 colour print only with no page scaling

<p>0  20m</p> <p>Date Requested: 24/06/2022          Job Reference: 25881037          Site Location: 448662 213014          Requested by: Mr Joe Shawyer          Your Scheme/Reference: 31188_003</p>	<p>Dig Sites Area:  Line: </p>	<p><b>Extra High Voltage cables in vicinity</b></p>	
<p>Scale: 1:500 (When plotted at A4)</p>	<table border="1" style="width: 100%; border-collapse: collapse;"> <thead> <tr> <th colspan="4">Voltages (V)</th> </tr> </thead> <tbody> <tr> <td>LV (Low Voltage) and Services</td> <td colspan="3">Up to 1,000V</td> </tr> <tr> <td>HV (High Voltage)</td> <td colspan="3">Over 1,000V to 11,000V</td> </tr> <tr> <td>EHV (Extra High Voltage)</td> <td colspan="3">22,000V to 132,000V</td> </tr> <tr> <td>Transmission</td> <td colspan="3">275,000V and 400,000V</td> </tr> </tbody> </table> <table border="1" style="width: 100%; border-collapse: collapse;"> <thead> <tr> <th colspan="5">NORMAL DEPTH TO THE TOP OF THE CABLE WHEN LAID</th> </tr> <tr> <th>Services</th> <th>LV</th> <th>HV</th> <th>EHV</th> <th></th> </tr> </thead> <tbody> <tr> <td>Footpath/Unmade</td> <td>0.45m</td> <td>0.45m</td> <td>0.6m</td> <td>0.8m</td> </tr> <tr> <td>Road Crossing</td> <td>0.6m</td> <td>0.6m</td> <td>0.75m</td> <td>0.9m</td> </tr> <tr> <td>Agricultural</td> <td>1m</td> <td>1m</td> <td>1m</td> <td>1.1m</td> </tr> </tbody> </table>	Voltages (V)				LV (Low Voltage) and Services	Up to 1,000V			HV (High Voltage)	Over 1,000V to 11,000V			EHV (Extra High Voltage)	22,000V to 132,000V			Transmission	275,000V and 400,000V			NORMAL DEPTH TO THE TOP OF THE CABLE WHEN LAID					Services	LV	HV	EHV		Footpath/Unmade	0.45m	0.45m	0.6m	0.8m	Road Crossing	0.6m	0.6m	0.75m	0.9m	Agricultural	1m	1m	1m	1.1m	<table border="1" style="width: 100%; border-collapse: collapse;"> <thead> <tr> <th colspan="2">Legend</th> </tr> </thead> <tbody> <tr><td></td><td>Service Cable</td></tr> <tr><td></td><td>LV Mains</td></tr> <tr><td></td><td>2 - 11kV</td></tr> <tr><td></td><td>66kV</td></tr> <tr><td></td><td>11kV</td></tr> <tr><td></td><td>22kV</td></tr> <tr><td></td><td>33kV</td></tr> <tr><td></td><td>66kV</td></tr> <tr><td></td><td>132kV</td></tr> <tr><td></td><td>275kV</td></tr> <tr><td></td><td>400kV</td></tr> <tr><td></td><td>Fibre Optic</td></tr> <tr><td></td><td>Pipe Cable</td></tr> </tbody> </table> <table border="1" style="width: 100%; border-collapse: collapse;"> <thead> <tr> <th colspan="2">Distribution Structures (Electric)</th> </tr> </thead> <tbody> <tr><td></td><td>Pole, Existing Location</td></tr> <tr><td></td><td>Pole Structure, Existing Location - Single</td></tr> <tr><td></td><td>Pole Structure, Existing Location - H</td></tr> <tr><td></td><td>Duct Route</td></tr> <tr><td></td><td>Cross Section Route</td></tr> </tbody> </table>	Legend			Service Cable		LV Mains		2 - 11kV		66kV		11kV		22kV		33kV		66kV		132kV		275kV		400kV		Fibre Optic		Pipe Cable	Distribution Structures (Electric)			Pole, Existing Location		Pole Structure, Existing Location - Single		Pole Structure, Existing Location - H		Duct Route		Cross Section Route	<p style="text-align: center;"><b>Southern Electric Power Distribution plc</b>          Registered Office: No.1 Forbury Place          43 Forbury Road Reading RG1 3JH          Registered In England &amp; Wales No.04094290</p> <p>If you're unsure &amp; need to seek advice before commencing excavations, please contact:          General Enquiries: 0800 048 3516</p> <p>Subject to revision – Master held by SSEN Asset Data Team:  <a href="mailto:Asset.Data@sse.com">Asset.Data@sse.com</a>          01256 337 294</p>
Voltages (V)	
LV (Low Voltage) and Services	Up to 1,000V	
HV (High Voltage)	Over 1,000V to 11,000V	
EHV (Extra High Voltage)	22,000V to 132,000V	
Transmission	275,000V and 400,000V	
NORMAL DEPTH TO THE TOP OF THE CABLE WHEN LAID	
Services	LV	HV	EHV	
Footpath/Unmade	0.45m	0.45m	0.6m	0.8m	
Road Crossing	0.6m	0.6m	0.75m	0.9m	
Agricultural	1m	1m	1m	1.1m	
Legend	
	Service Cable	
	LV Mains	
	2 - 11kV	
	66kV	
	11kV	
	22kV	
	33kV	
	66kV	
	132kV	
	275kV	
	400kV	
	Fibre Optic	
	Pipe Cable	
Distribution Structures (Electric)	
	Pole, Existing Location	
	Pole Structure, Existing Location - Single	
	Pole Structure, Existing Location - H	
	Duct Route	
	Cross Section Route	
<p>BASED UPON THE ORDNANCE SURVEY MAP WITH THE SANCTION OF THE CONTROLLER OF H.M. STATIONERY OFFICE CROWN COPYRIGHT RESERVED.          This copy has been made by or with the authority of Scottish and Southern Energy Power Distribution Ltd. Pursuant to section 47 of the Copyright, Designs and Patents Act 1988 ("The Act"). Unless the Act provides a relevant exception to copyright the copy must not be copied without prior permission of the copyright owner.          Plans generated by DigSAFE Pro™ software provided by LinesearchbeforeDigs.</p>	

86

Warning: PDF designed for A4 colour print only with no page scaling

0 20m

Dig Sites

Area:



Line:



**Extra High Voltage  
cables in vicinity**



Date Requested: 24/06/2022

Job Reference: 25881037

Site Location: 448662 213014

Requested by: Mr Joe Shawyer

Your Scheme/Reference: 31188\_003

Voltages (V)				
LV (Low Voltage) and Services	Up to 1,000V			
HV (High Voltage)	Over 1,000V to 11,000V			
EHV (Extra High Voltage)	22,000V to 132,000V			
Transmission	275,000V and 400,000V			
NORMAL DEPTH TO THE TOP OF THE CABLE WHEN LAID				
Services	LV	HV	EHV	
Footpath/Unmade	0.45m	0.45m	0.6m	0.8m
Road Crossing	0.6m	0.6m	0.75m	0.9m
Agricultural	1m	1m	1m	1.1m

Legend	
	Service Cable
	LV Mains
	2 - 8.3kV
	6.6kV
	11kV
	22kV
	33kV
	66kV
	132kV
	275kV
	400kV
	Fibre Optic
	Pilot Cable

Distribution Structures (Electric)	
	Pole, Existing Location
	Pole Structure, Existing Location - Single
	Pole Structure, Existing Location - H
	Duct Route
	Cross Section Route


**WARNING**  
There may have been subsequent alteration to the surface levels. Trial holes must be undertaken to determine position and depths of cables. HS (G) 47 Booklet from the Health and Safety Executive - Avoiding Danger from Buried Cables - should be consulted before commencing excavation work.  
**WHEN WORKING IN THE VICINITY OF OVERHEAD LINES THE HEALTH AND SAFETY GUIDANCE NOTES G56 SHOULD BE CONSULTED (AVAILABLE FROM THE HSE WEBSITE)**

**Southern Electric Power Distribution plc**  
Registered Office: No.1 Forbury Place  
43 Forbury Road Reading RG1 3JH  
Registered In England & Wales No.04094290

If you're unsure & need to seek advice before commencing excavations, please contact:  
General Enquiries: 0800 048 3516

Subject to revision - Master held by SSEN Asset Data Team:  
[Asset.Data@sse.com](mailto:Asset.Data@sse.com)  
01256 337 294

Scale: 1:500 (When plotted at A4)

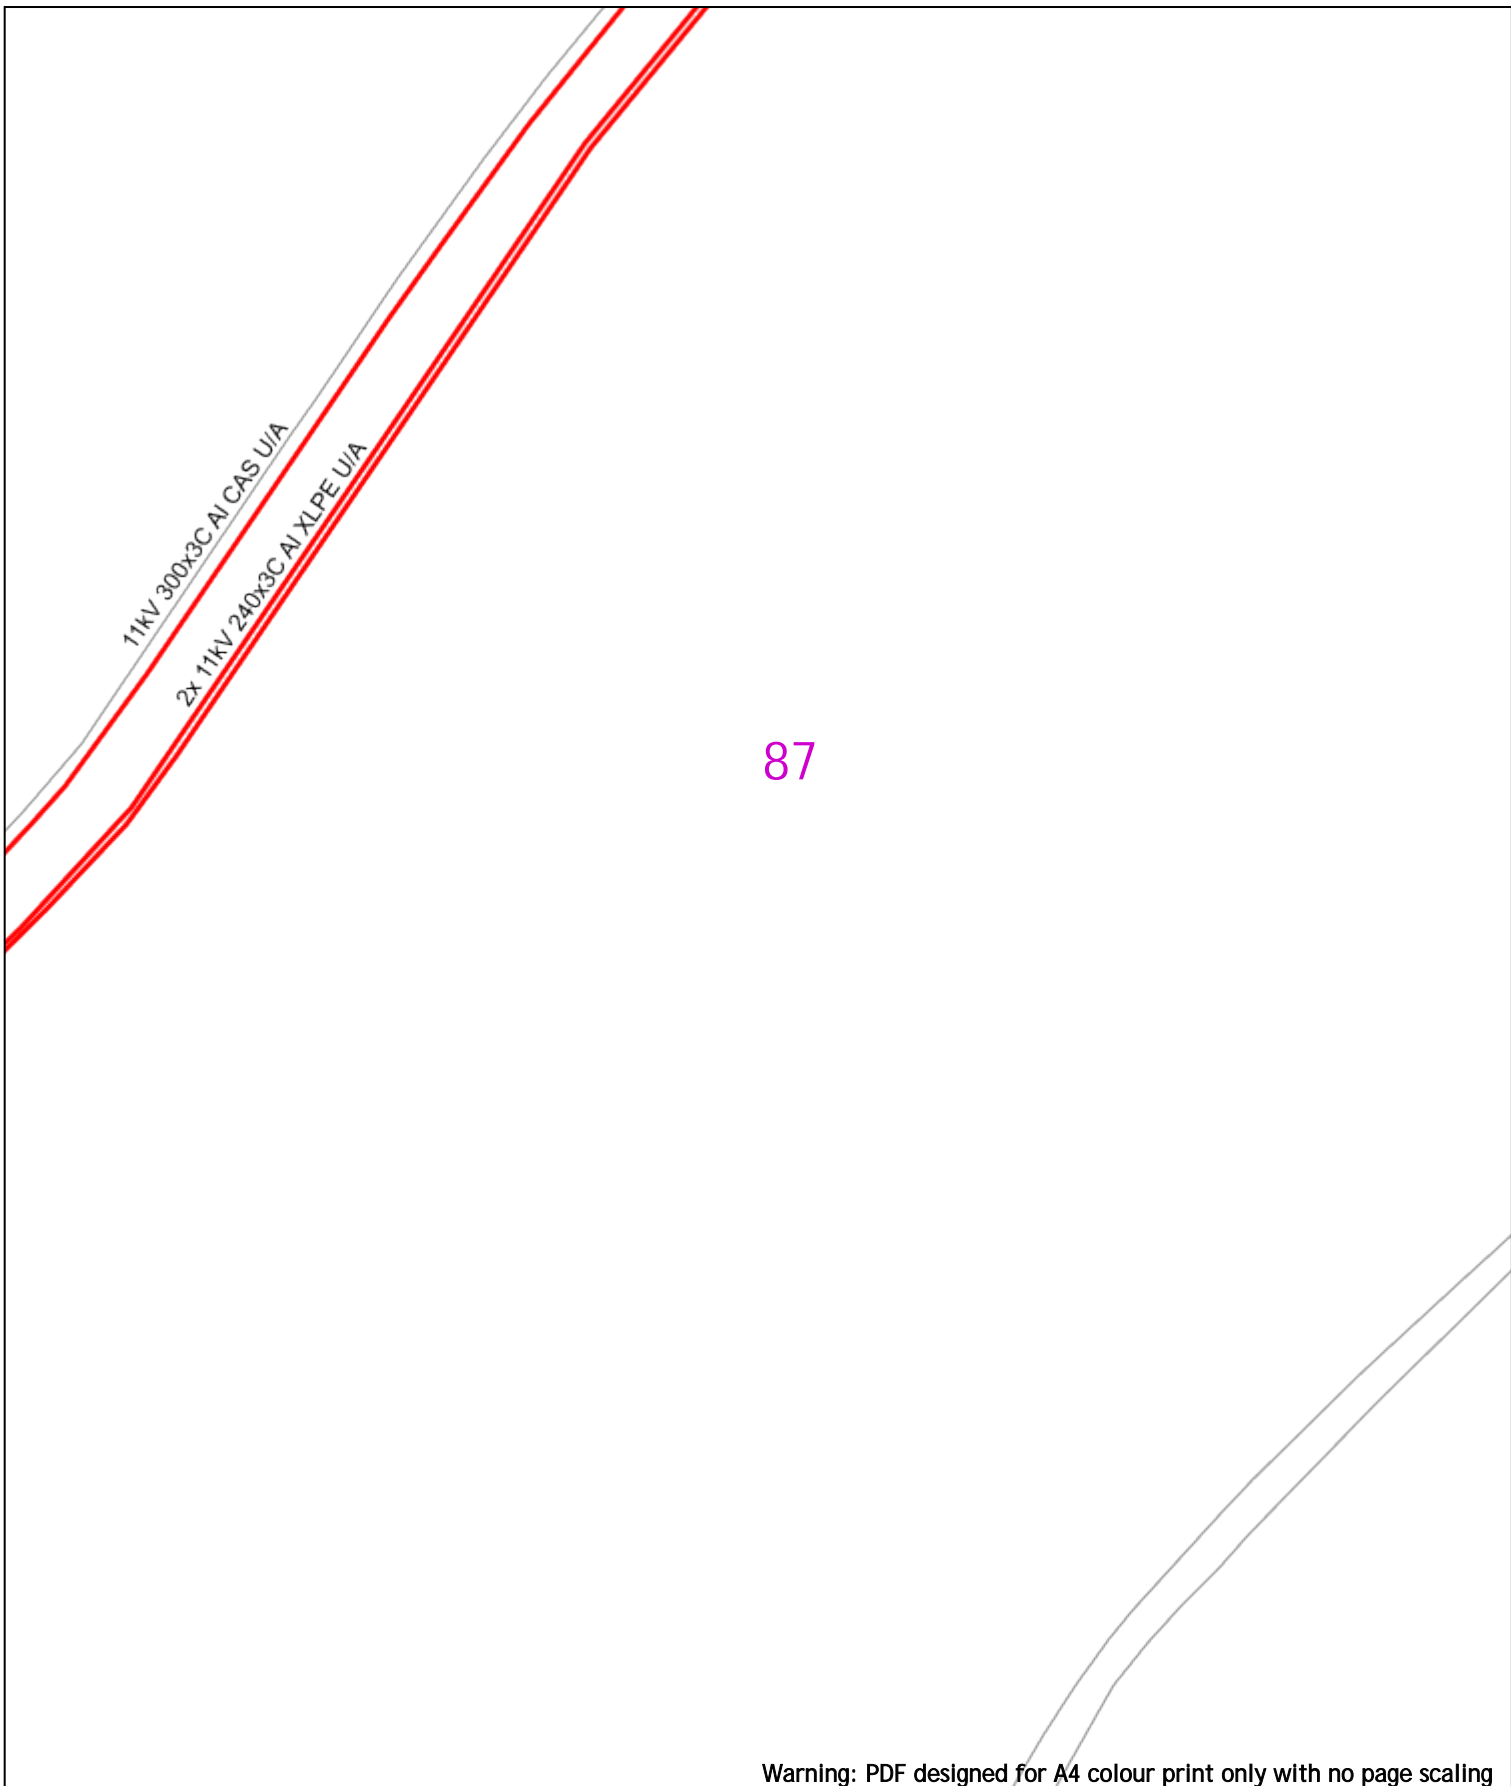

Warning: PDF designed for A4 colour print only with no page scaling



20m Dig Sites Area: Line:

**Extra High Voltage cables in vicinity**



Date Requested: 24/06/2022  
 Job Reference: 25881037  
 Site Location: 448662 213014  
 Requested by: Mr Joe Shawyer  
 Your Scheme/Reference: 31188\_003

Voltages (V)			
LV (Low Voltage) and Services	Up to 1,000V		
HV (High Voltage)	Over 1,000V to 11,000V		
EHV (Extra High Voltage)	22,000V to 132,000V		
Transmission	275,000V and 400,000V		
NORMAL DEPTH TO THE TOP OF THE CABLE WHEN LAID			
Services	LV	HV	EHV
Footpath/Unmade	0.45m	0.45m	0.6m 0.8m
Road Crossing	0.6m	0.6m	0.75m 0.9m
Agricultural	1m	1m	1m 1.1m

Legend	
	Service Cable
	LV Mains
	2 - 11kV
	66kV
	11kV
	22kV
	33kV
	66kV
	132kV
	275kV
	400kV
	Fibre Optic
	Pipe Cable

Distribution Structures (Electric)	
	Pole, Existing Location
	Pole Structure, Existing Location - Single
	Pole Structure, Existing Location - H
	Duct Route
	Cross Section Route


**Southern Electric Power Distribution plc**  
 Registered Office: No.1 Forbury Place  
 43 Forbury Road Reading RG1 3JH  
 Registered In England & Wales No.04094290

If you're unsure & need to seek advice before commencing excavations, please contact:  
 General Enquiries: 0800 048 3516

Subject to revision – Master held by SSEN Asset Data Team:  
[Asset.Data@sse.com](mailto:Asset.Data@sse.com)  
 01256 337 294

Scale: 1:500 (When plotted at A4)

**WARNING**  
 There may have been subsequent alteration to the surface levels. Trial holes must be undertaken to determine position and depths of cables. HS (G) 47 Booklet from the Health and Safety Executive – Avoiding Danger from Buried Cables – should be consulted before commencing excavation work.  
 WHEN WORKING IN THE VICINITY OF OVERHEAD LINES THE HEALTH AND SAFETY GUIDANCE NOTES G56 SHOULD BE CONSULTED (AVAILABLE FROM THE HSE WEBSITE)

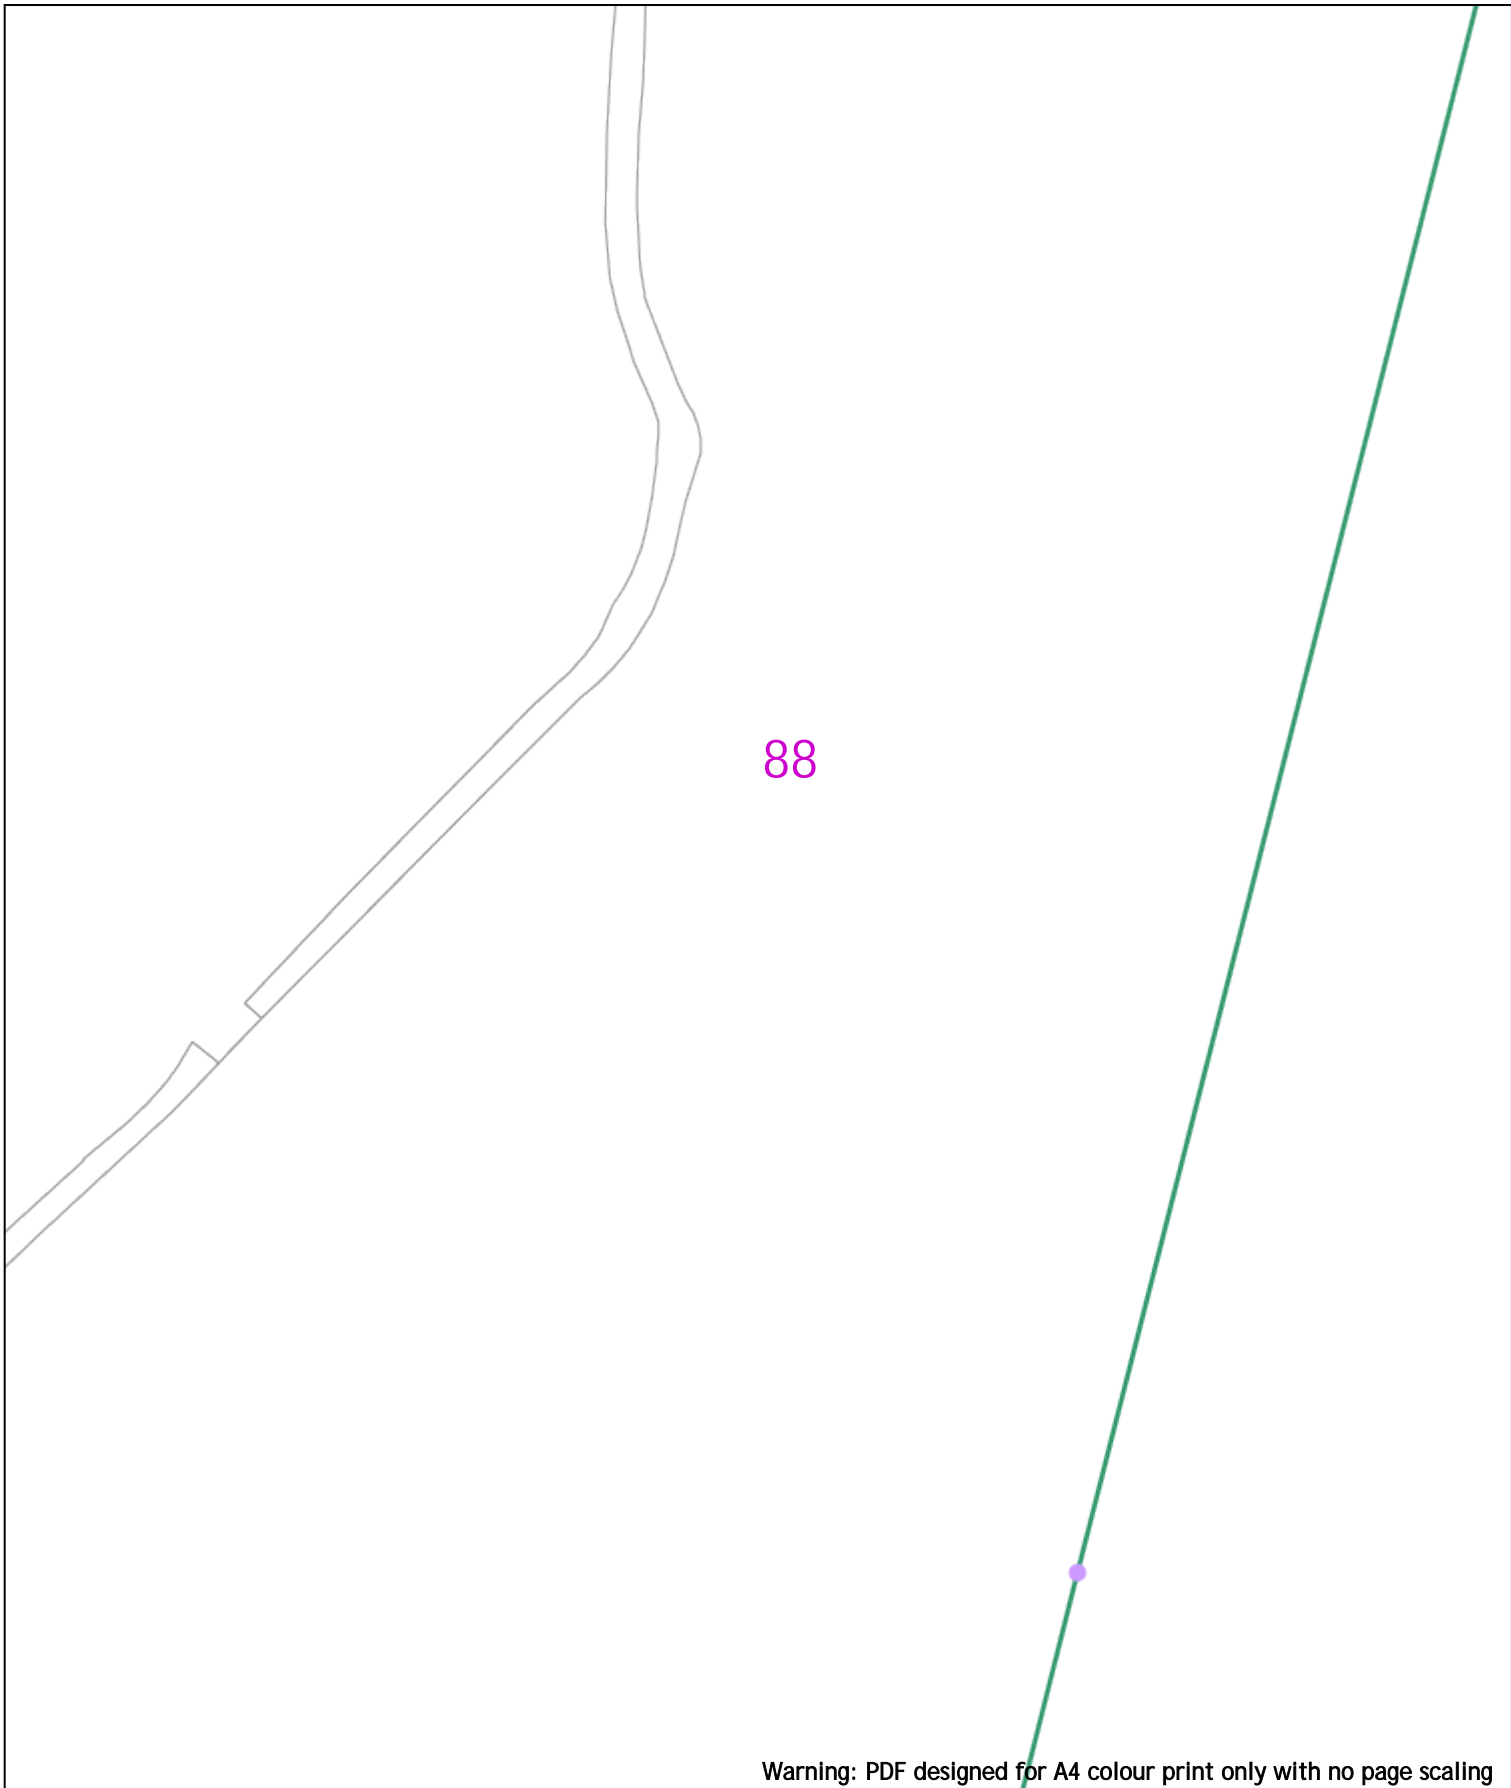

Warning: PDF designed for A4 colour print only with no page scaling

<p>0  20m</p>	<p>Dig Sites Area:  Line: </p>	<p>Extra High Voltage cables in vicinity</p>	
<p>Date Requested: 24/06/2022 Job Reference: 25881037 Site Location: 448662 213014 Requested by: Mr Joe Shawyer Your Scheme/Reference: 31188_003</p>	<table border="1" style="width: 100%; border-collapse: collapse;"> <thead> <tr> <th colspan="4">Voltages (V)</th> </tr> </thead> <tbody> <tr> <td>LV (Low Voltage) and Services</td> <td colspan="3">Up to 1,000V</td> </tr> <tr> <td>HV (High Voltage)</td> <td colspan="3">Over 1,000V to 11,000V</td> </tr> <tr> <td>EHV (Extra High Voltage)</td> <td colspan="3">22,000V to 132,000V</td> </tr> <tr> <td>Transmission</td> <td colspan="3">275,000V and 400,000V</td> </tr> </tbody> </table> <table border="1" style="width: 100%; border-collapse: collapse; margin-top: 5px;"> <thead> <tr> <th colspan="5">NORMAL DEPTH TO THE TOP OF THE CABLE WHEN LAID</th> </tr> <tr> <th>Services</th> <th>LV</th> <th>HV</th> <th>EHV</th> <th></th> </tr> </thead> <tbody> <tr> <td>Footpath/Unmade</td> <td>0.45m</td> <td>0.45m</td> <td>0.6m</td> <td>0.8m</td> </tr> <tr> <td>Road Crossing</td> <td>0.6m</td> <td>0.6m</td> <td>0.75m</td> <td>0.9m</td> </tr> <tr> <td>Agricultural</td> <td>1m</td> <td>1m</td> <td>1m</td> <td>1.1m</td> </tr> </tbody> </table>	Voltages (V)				LV (Low Voltage) and Services	Up to 1,000V			HV (High Voltage)	Over 1,000V to 11,000V			EHV (Extra High Voltage)	22,000V to 132,000V			Transmission	275,000V and 400,000V			NORMAL DEPTH TO THE TOP OF THE CABLE WHEN LAID					Services	LV	HV	EHV		Footpath/Unmade	0.45m	0.45m	0.6m	0.8m	Road Crossing	0.6m	0.6m	0.75m	0.9m	Agricultural	1m	1m	1m	1.1m	<table border="1" style="width: 100%; border-collapse: collapse;"> <thead> <tr> <th colspan="2">Legend</th> </tr> </thead> <tbody> <tr><td></td><td>Service Cable</td></tr> <tr><td></td><td>LV Mains</td></tr> <tr><td></td><td>2 - 11kV</td></tr> <tr><td></td><td>66kV</td></tr> <tr><td></td><td>11kV</td></tr> <tr><td></td><td>22kV</td></tr> <tr><td></td><td>33kV</td></tr> <tr><td></td><td>66kV</td></tr> <tr><td></td><td>132kV</td></tr> <tr><td></td><td>275kV</td></tr> <tr><td></td><td>400kV</td></tr> <tr><td></td><td>Fibre Optic</td></tr> <tr><td></td><td>Pilot Cable</td></tr> </tbody> </table> <table border="1" style="width: 100%; border-collapse: collapse; margin-top: 5px;"> <thead> <tr> <th colspan="2">Distribution Structures (Electric)</th> </tr> </thead> <tbody> <tr><td></td><td>Pole, Existing Location</td></tr> <tr><td></td><td>Pole Structure, Existing Location - Single</td></tr> <tr><td></td><td>Pole Structure, Existing Location - H</td></tr> <tr><td></td><td>Duct Route</td></tr> <tr><td></td><td>Cross Section Route</td></tr> </tbody> </table>	Legend			Service Cable		LV Mains		2 - 11kV		66kV		11kV		22kV		33kV		66kV		132kV		275kV		400kV		Fibre Optic		Pilot Cable	Distribution Structures (Electric)			Pole, Existing Location		Pole Structure, Existing Location - Single		Pole Structure, Existing Location - H		Duct Route		Cross Section Route	<p><b>Southern Electric Power Distribution plc</b> Registered Office: No.1 Forbury Place 43 Forbury Road Reading RG1 3JH Registered In England &amp; Wales No.04094290</p> <p>If you're unsure &amp; need to seek advice before commencing excavations, please contact: General Enquiries: 0800 048 3516</p> <p>Subject to revision – Master held by SSEN Asset Data Team: <a href="mailto:Asset.Data@sse.com">Asset.Data@sse.com</a> 01256 337 294</p>
Voltages (V)	
LV (Low Voltage) and Services	Up to 1,000V	
HV (High Voltage)	Over 1,000V to 11,000V	
EHV (Extra High Voltage)	22,000V to 132,000V	
Transmission	275,000V and 400,000V	
NORMAL DEPTH TO THE TOP OF THE CABLE WHEN LAID	
Services	LV	HV	EHV	
Footpath/Unmade	0.45m	0.45m	0.6m	0.8m	
Road Crossing	0.6m	0.6m	0.75m	0.9m	
Agricultural	1m	1m	1m	1.1m	
Legend	
	Service Cable	
	LV Mains	
	2 - 11kV	
	66kV	
	11kV	
	22kV	
	33kV	
	66kV	
	132kV	
	275kV	
	400kV	
	Fibre Optic	
	Pilot Cable	
Distribution Structures (Electric)	
	Pole, Existing Location	
	Pole Structure, Existing Location - Single	
	Pole Structure, Existing Location - H	
	Duct Route	
	Cross Section Route	
<p>Scale: 1:500 (When plotted at A4)</p> <p style="text-align: center; color: red; font-weight: bold;">WARNING</p> <p style="text-align: center; font-size: x-small;">There may have been subsequent alteration to the surface levels. Trial holes must be undertaken to determine position and depths of cables. HS (G) 47 Booklet from the Health and Safety Executive – Avoiding Danger from Buried Cables – should be consulted before commencing excavation work.</p> <p style="text-align: center; font-size: x-small;">WHEN WORKING IN THE VICINITY OF OVERHEAD LINES THE HEALTH AND SAFETY GUIDANCE NOTES G56 SHOULD BE CONSULTED (AVAILABLE FROM THE HSE WEBSITE)</p> <p style="text-align: center; font-size: x-small;">BASED UPON THE ORDNANCE SURVEY MAP WITH THE SANCTION OF THE CONTROLLER OF HM STATIONERY OFFICE CROWN COPYRIGHT RESERVED. This copy has been made by or with the authority of Scottish and Southern Energy Power Distribution Ltd. Pursuant to section 47 of the Copyright, Designs and Patents Act 1988 ("The Act"). Unless the Act provides a relevant exception to copyright the copy must not be copied without prior permission of the copyright owner. Plans generated by DigSAFE Pro™ software provided by LinesearchbeforeUdig.</p>	

Warning: PDF designed for A4 colour print only with no page scaling

0 20m Dig Sites Area: Line:

**Extra High Voltage cables in vicinity**



Date Requested: 24/06/2022  
 Job Reference: 25881037  
 Site Location: 448662 213014  
 Requested by: Mr Joe Shawyer  
 Your Scheme/Reference: 31188\_003

Voltages (V)			
LV (Low Voltage) and Services	Up to 1,000V		
HV (High Voltage)	Over 1,000V to 11,000V		
EHV (Extra High Voltage)	22,000V to 132,000V		
Transmission	275,000V and 400,000V		
NORMAL DEPTH TO THE TOP OF THE CABLE WHEN LAID			
Services	LV	HV	EHV
Footpath/Unmade	0.45m	0.45m	0.6m 0.8m
Road Crossing	0.6m	0.6m	0.75m 0.9m
Agricultural	1m	1m	1m 1.1m

Legend	Distribution Structures (Electric)
Service Cable	Pole, Existing Location
LV Mains	Pole Structure, Existing Location - Single
2 - 11kV	Pole Structure, Existing Location - H
66kV	Duct Route
11kV	Cross Section Route
22kV	
33kV	
66kV	
132kV	
275kV	
400kV	
Fibre Optic	
Pipe Cable	

**WARNING**  
 There may have been subsequent alteration to the surface levels. Trial holes must be undertaken to determine position and depths of cables. HS (G) 47 Booklet from the Health and Safety Executive - Avoiding Danger from Buried Cables - should be consulted before commencing excavation work.  
**WHEN WORKING IN THE VICINITY OF OVERHEAD LINES THE HEALTH AND SAFETY GUIDANCE NOTES G56 SHOULD BE CONSULTED (AVAILABLE FROM THE HSE WEBSITE)**

**Southern Electric Power Distribution plc**  
 Registered Office: No.1 Forbury Place  
 43 Forbury Road Reading RG1 3JH  
 Registered In England & Wales No.04094290

If you're unsure & need to seek advice before commencing excavations, please contact:  
 General Enquiries: 0800 048 3516

Subject to revision - Master held by SSEN Asset Data Team:  
[Asset.Data@sse.com](mailto:Asset.Data@sse.com)  
 01256 337 294

Scale: 1:500 (When plotted at A4)



MP 67.75

90

33kV .175 AAAC

Water

Storm

Lagoons

Warning: PDF designed for A4 colour print only with no page scaling

0 20m

Dig Sites

Area:

Line:

Extra High Voltage cables in vicinity

Extra High Voltage cables in vicinity



Date Requested: 24/06/2022

Job Reference: 25881037

Site Location: 448662 213014

Requested by: Mr Joe Shawyer

Your Scheme/Reference: 31188\_003

Voltages (V)			
LV (Low Voltage) and Services	Up to 1,000V		
HV (High Voltage)	Over 1,000V to 11,000V		
EHV (Extra High Voltage)	22,000V to 132,000V		
Transmission	275,000V and 400,000V		
NORMAL DEPTH TO THE TOP OF THE CABLE WHEN LAID			
Services	LV	HV	EHV
Footpath/Unmade	0.45m	0.45m	0.6m
Road Crossing	0.6m	0.6m	0.75m
Agricultural	1m	1m	1.1m

Legend

- Service Cable
- LV Mains
- 2 - 11kV
- 66kV
- 11kV
- 22kV
- 33kV
- 66kV
- 132kV
- 275kV
- 400kV
- Fibre Optic
- Pipit Cable

Distribution Structures (Electric)

- Pole, Existing Location
- Pole Structure, Existing Location - Single
- Pole Structure, Existing Location - H
- Duct Route
- Cross Section Route

**Southern Electric Power Distribution plc**  
 Registered Office: No.1 Forbury Place  
 43 Forbury Road Reading RG1 3JH  
 Registered In England & Wales No.04094290

If you're unsure & need to seek advice before commencing excavations, please contact:  
 General Enquiries: 0800 048 3516

Subject to revision - Master held by SSEN Asset Data Team:  
[Asset.Data@sse.com](mailto:Asset.Data@sse.com)  
 01256 337 294

Scale: 1:500 (When plotted at A4)

There may have been subsequent alteration to the surface levels. Trial holes must be undertaken to determine position and depths of cables. HS (G) 47 Booklet from the Health and Safety Executive - Avoiding Danger from Buried Cables - should be consulted before commencing excavation work.  
**WHEN WORKING IN THE VICINITY OF OVERHEAD LINES THE HEALTH AND SAFETY GUIDANCE NOTES G56 SHOULD BE CONSULTED (AVAILABLE FROM THE HSE WEBSITE)**

91

11kV 240x3C Al XLPE U/A

Warning: PDF designed for A4 colour print only with no page scaling



20m Dig Sites Area: [Dashed Purple Box] Line: [Dashed Purple Line]

**Extra High Voltage cables in vicinity**



Date Requested: 24/06/2022  
 Job Reference: 25881037  
 Site Location: 448662 213014  
 Requested by: Mr Joe Shawyer  
 Your Scheme/Reference: 31188\_003

Voltages (V)			
LV (Low Voltage) and Services	Up to 1,000V		
HV (High Voltage)	Over 1,000V to 11,000V		
EHV (Extra High Voltage)	22,000V to 132,000V		
Transmission	275,000V and 400,000V		
NORMAL DEPTH TO THE TOP OF THE CABLE WHEN LAID			
Services	LV	HV	EHV
Footpath/Unmade	0.45m	0.45m	0.6m
Road Crossing	0.6m	0.6m	0.75m
Agricultural	1m	1m	1.1m

Legend	


**Southern Electric Power Distribution plc**  
 Registered Office: No.1 Forbury Place  
 43 Forbury Road Reading RG1 3JH  
 Registered In England & Wales No.04094290

If you're unsure & need to seek advice before commencing excavations, please contact:  
 General Enquiries: 0800 048 3516

Scale: 1:500 (When plotted at A4)

**WARNING**  
 There may have been subsequent alteration to the surface levels. Trial holes must be undertaken to determine position and depths of cables. HS (G) 47 Booklet from the Health and Safety Executive - Avoiding Danger from Buried Cables - should be consulted before commencing excavation work.  
**WHEN WORKING IN THE VICINITY OF OVERHEAD LINES THE HEALTH AND SAFETY GUIDANCE NOTES G56 SHOULD BE CONSULTED (AVAILABLE FROM THE HSE WEBSITE)**


Subject to revision - Master held by SSEN Asset Data Team:  
[Asset.Data@sse.com](mailto:Asset.Data@sse.com)  
 01256 337 294

92

Warning: PDF designed for A4 colour print only with no page scaling

0 20m Dig Sites Area: Line:

**Extra High Voltage  
cables in vicinity**

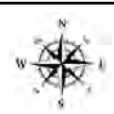

Date Requested: 24/06/2022  
 Job Reference: 25881037  
 Site Location: 448662 213014  
 Requested by: Mr Joe Shawyer  
 Your Scheme/Reference: 31188\_003

Voltages (V)			
LV (Low Voltage) and Services	Up to 1,000V		
HV (High Voltage)	Over 1,000V to 11,000V		
EHV (Extra High Voltage)	22,000V to 132,000V		
Transmission	275,000V and 400,000V		
NORMAL DEPTH TO THE TOP OF THE CABLE WHEN LAID			
Services	LV	HV	EHV
Footpath/Unmade	0.45m	0.45m	0.6m 0.8m
Road Crossing	0.6m	0.6m	0.75m 0.9m
Agricultural	1m	1m	1m 1.1m

Legend	
	Service Cable
	LV Mains
	2 - 11kV
	66kV
	275kV
	400kV
	Fibre Optic
	Pilot Cable

Distribution Structures (Electric)	
	Pole, Existing Location
	Pole Structure, Existing Location - Single
	Pole Structure, Existing Location - H
	Duct Route
	Cross Section Route


**Southern Electric Power Distribution plc**  
 Registered Office: No.1 Forbury Place  
 43 Forbury Road Reading RG1 3JH  
 Registered In England & Wales No.04094290

If you're unsure & need to seek advice before commencing excavations, please contact:  
 General Enquiries: 0800 048 3516

Subject to revision – Master held by SSEN Asset Data Team:  
[Asset.Data@sse.com](mailto:Asset.Data@sse.com)  
 01256 337 294

Scale: 1:500 (When plotted at A4)


**WARNING**  
 There may have been subsequent alteration to the surface levels. Trial holes must be undertaken to determine position and depths of cables. HS (G) 47 Booklet from the Health and Safety Executive – Avoiding Danger from Buried Cables – should be consulted before commencing excavation work.  
**WHEN WORKING IN THE VICINITY OF OVERHEAD LINES THE HEALTH AND SAFETY GUIDANCE NOTES G56 SHOULD BE CONSULTED (AVAILABLE FROM THE HSE WEBSITE)**

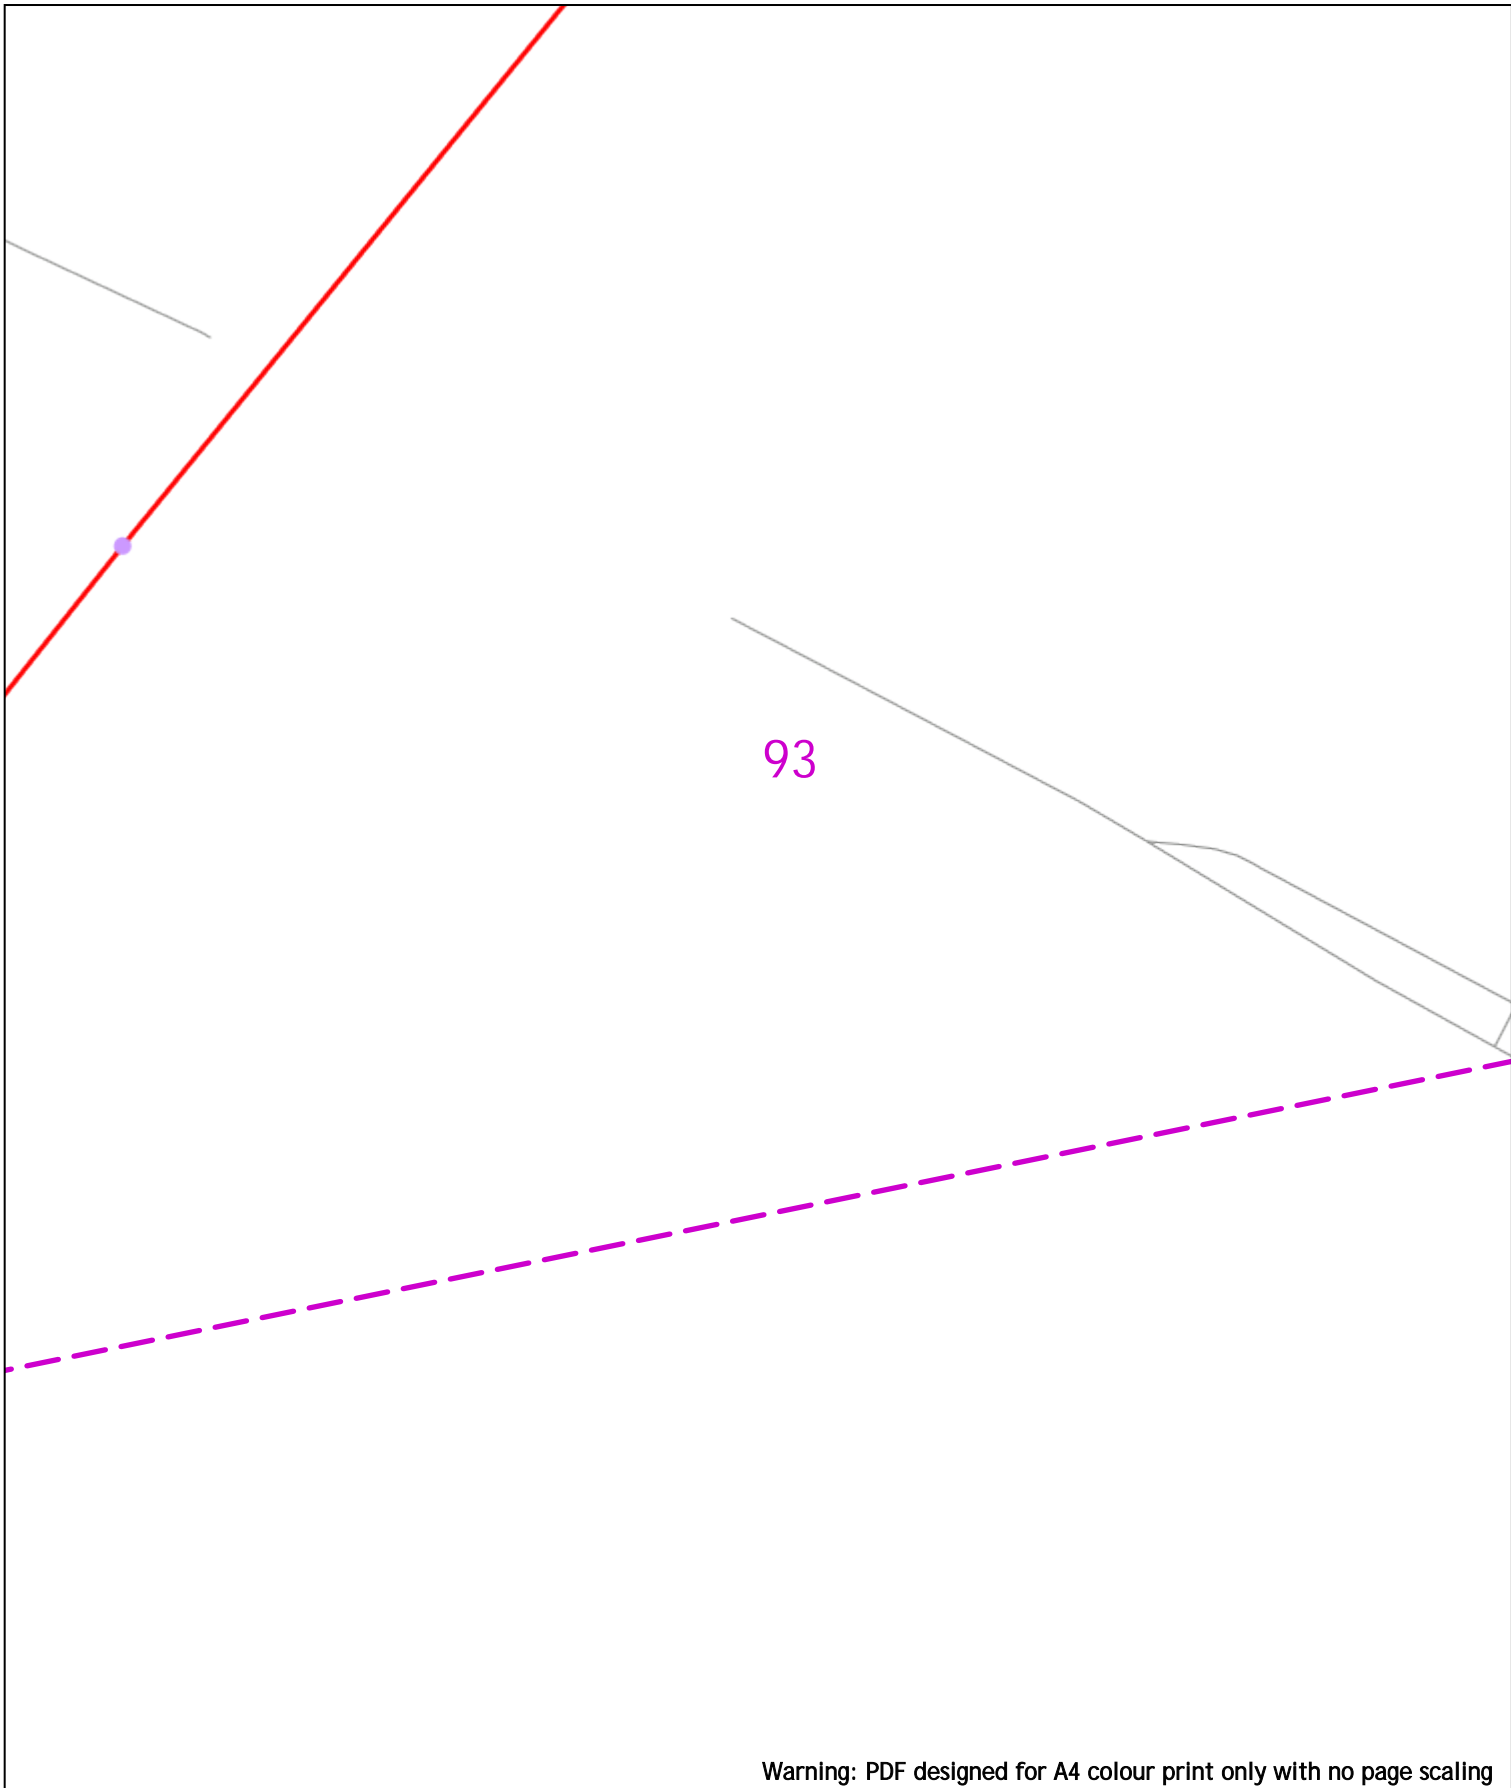

Warning: PDF designed for A4 colour print only with no page scaling

<p>0  20m</p> <p>Date Requested: 24/06/2022          Job Reference: 25881037          Site Location: 448662 213014          Requested by: Mr Joe Shawyer          Your Scheme/Reference: 31188_003</p>	<p>Dig Sites Area:  Line: </p> <p style="text-align: center; background-color: red; color: white; padding: 5px;"><b>Extra High Voltage cables in vicinity</b></p>		<p style="text-align: center;"><b>Southern Electric Power Distribution plc</b>          Registered Office: No.1 Forbury Place          43 Forbury Road Reading RG1 3JH          Registered In England &amp; Wales No.04094290</p> <p style="font-size: small;">If you're unsure &amp; need to seek advice before commencing excavations, please contact:          General Enquiries: 0800 048 3516</p> <p style="font-size: small;">Subject to revision – Master held by SSEN Asset Data Team:  <a href="mailto:Asset.Data@sse.com">Asset.Data@sse.com</a>          01256 337 294</p>	
<table border="1" style="width: 100%; border-collapse: collapse;"> <thead> <tr> <th colspan="4">Voltages (V)</th> </tr> </thead> <tbody> <tr> <td>LV (Low Voltage) and Services</td> <td colspan="3">Up to 1,000V</td> </tr> <tr> <td>HV (High Voltage)</td> <td colspan="3">Over 1,000V to 11,000V</td> </tr> <tr> <td>EHV (Extra High Voltage)</td> <td colspan="3">22,000V to 132,000V</td> </tr> <tr> <td>Transmission</td> <td colspan="3">275,000V and 400,000V</td> </tr> </tbody> </table> <table border="1" style="width: 100%; border-collapse: collapse; font-size: x-small;"> <thead> <tr> <th colspan="5">NORMAL DEPTH TO THE TOP OF THE CABLE WHEN LAID</th> </tr> <tr> <th>Services</th> <th>LV</th> <th>HV</th> <th colspan="2">EHV</th> </tr> </thead> <tbody> <tr> <td>Footpath/Unmade</td> <td>0.45m</td> <td>0.45m</td> <td>0.6m</td> <td>0.8m</td> </tr> <tr> <td>Road Crossing</td> <td>0.6m</td> <td>0.6m</td> <td>0.75m</td> <td>0.9m</td> </tr> <tr> <td>Agricultural</td> <td>1m</td> <td>1m</td> <td>1m</td> <td>1.1m</td> </tr> </tbody> </table>		Voltages (V)				LV (Low Voltage) and Services	Up to 1,000V			HV (High Voltage)	Over 1,000V to 11,000V			EHV (Extra High Voltage)	22,000V to 132,000V			Transmission	275,000V and 400,000V			NORMAL DEPTH TO THE TOP OF THE CABLE WHEN LAID					Services	LV	HV	EHV		Footpath/Unmade	0.45m	0.45m	0.6m	0.8m	Road Crossing	0.6m	0.6m	0.75m	0.9m	Agricultural	1m	1m	1m	1.1m	<table border="1" style="width: 100%; border-collapse: collapse; font-size: x-small;"> <thead> <tr> <th colspan="2">Legend</th> <th colspan="2">Distribution Structures (Electric)</th> </tr> </thead> <tbody> <tr> <td></td> <td>Service Cable</td> <td></td> <td>Pole, Existing Location</td> </tr> <tr> <td></td> <td>LV Mains</td> <td></td> <td>Pole Structure, Existing Location - Single</td> </tr> <tr> <td></td> <td>2 - 11kV</td> <td></td> <td>Pole Structure, Existing Location - H</td> </tr> <tr> <td></td> <td>66kV</td> <td></td> <td>Duct Route</td> </tr> <tr> <td></td> <td>11kV</td> <td></td> <td>Cross Section Route</td> </tr> <tr> <td></td> <td>22kV</td> <td></td> <td></td> </tr> <tr> <td></td> <td>33kV</td> <td></td> <td></td> </tr> <tr> <td></td> <td>66kV</td> <td></td> <td></td> </tr> <tr> <td></td> <td>132kV</td> <td></td> <td></td> </tr> <tr> <td></td> <td>275kV</td> <td></td> <td></td> </tr> <tr> <td></td> <td>400kV</td> <td></td> <td></td> </tr> <tr> <td></td> <td>Fibre Optic</td> <td></td> <td></td> </tr> <tr> <td></td> <td>Pipe Cable</td> <td></td> <td></td> </tr> </tbody> </table> <p style="font-size: x-small; text-align: center;"><b>WARNING</b>          There may have been subsequent alteration to the surface levels. Trial holes must be undertaken to determine position and depths of cables. HS (G) 47 Booklet from the Health and Safety Executive – Avoiding Danger from Buried Cables – should be consulted before commencing excavation work.  <b>WHEN WORKING IN THE VICINITY OF OVERHEAD LINES THE HEALTH AND SAFETY GUIDANCE NOTES G66 SHOULD BE CONSULTED (AVAILABLE FROM THE HSE WEBSITE)</b></p>	Legend		Distribution Structures (Electric)			Service Cable		Pole, Existing Location		LV Mains		Pole Structure, Existing Location - Single		2 - 11kV		Pole Structure, Existing Location - H		66kV		Duct Route		11kV		Cross Section Route		22kV				33kV				66kV				132kV				275kV				400kV				Fibre Optic				Pipe Cable		
Voltages (V)	
LV (Low Voltage) and Services	Up to 1,000V	
HV (High Voltage)	Over 1,000V to 11,000V	
EHV (Extra High Voltage)	22,000V to 132,000V	
Transmission	275,000V and 400,000V	
NORMAL DEPTH TO THE TOP OF THE CABLE WHEN LAID	
Services	LV	HV	EHV	
Footpath/Unmade	0.45m	0.45m	0.6m	0.8m	
Road Crossing	0.6m	0.6m	0.75m	0.9m	
Agricultural	1m	1m	1m	1.1m	
Legend		Distribution Structures (Electric)	
	Service Cable		Pole, Existing Location	
	LV Mains		Pole Structure, Existing Location - Single	
	2 - 11kV		Pole Structure, Existing Location - H	
	66kV		Duct Route	
	11kV		Cross Section Route	
	22kV	
	33kV	
	66kV	
	132kV	
	275kV	
	400kV	
	Fibre Optic	
	Pipe Cable	
<p>Scale: 1:500 (When plotted at A4)</p>		<p style="font-size: x-small;">BASED UPON THE ORDNANCE SURVEY MAP WITH THE SANCTION OF THE CONTROLLER OF HM STATIONERY OFFICE CROWN COPYRIGHT RESERVED.          This copy has been made by or with the authority of Scottish and Southern Energy Power Distribution Ltd. Pursuant to section 47 of the Copyright, Designs and Patents Act 1988 ("The Act"). Unless the Act provides a relevant exception to copyright the copy must not be copied without prior permission of the copyright owner.          Plans generated by DigSAFE Pro™ software provided by LinesearchbeforeDig.</p>	

94

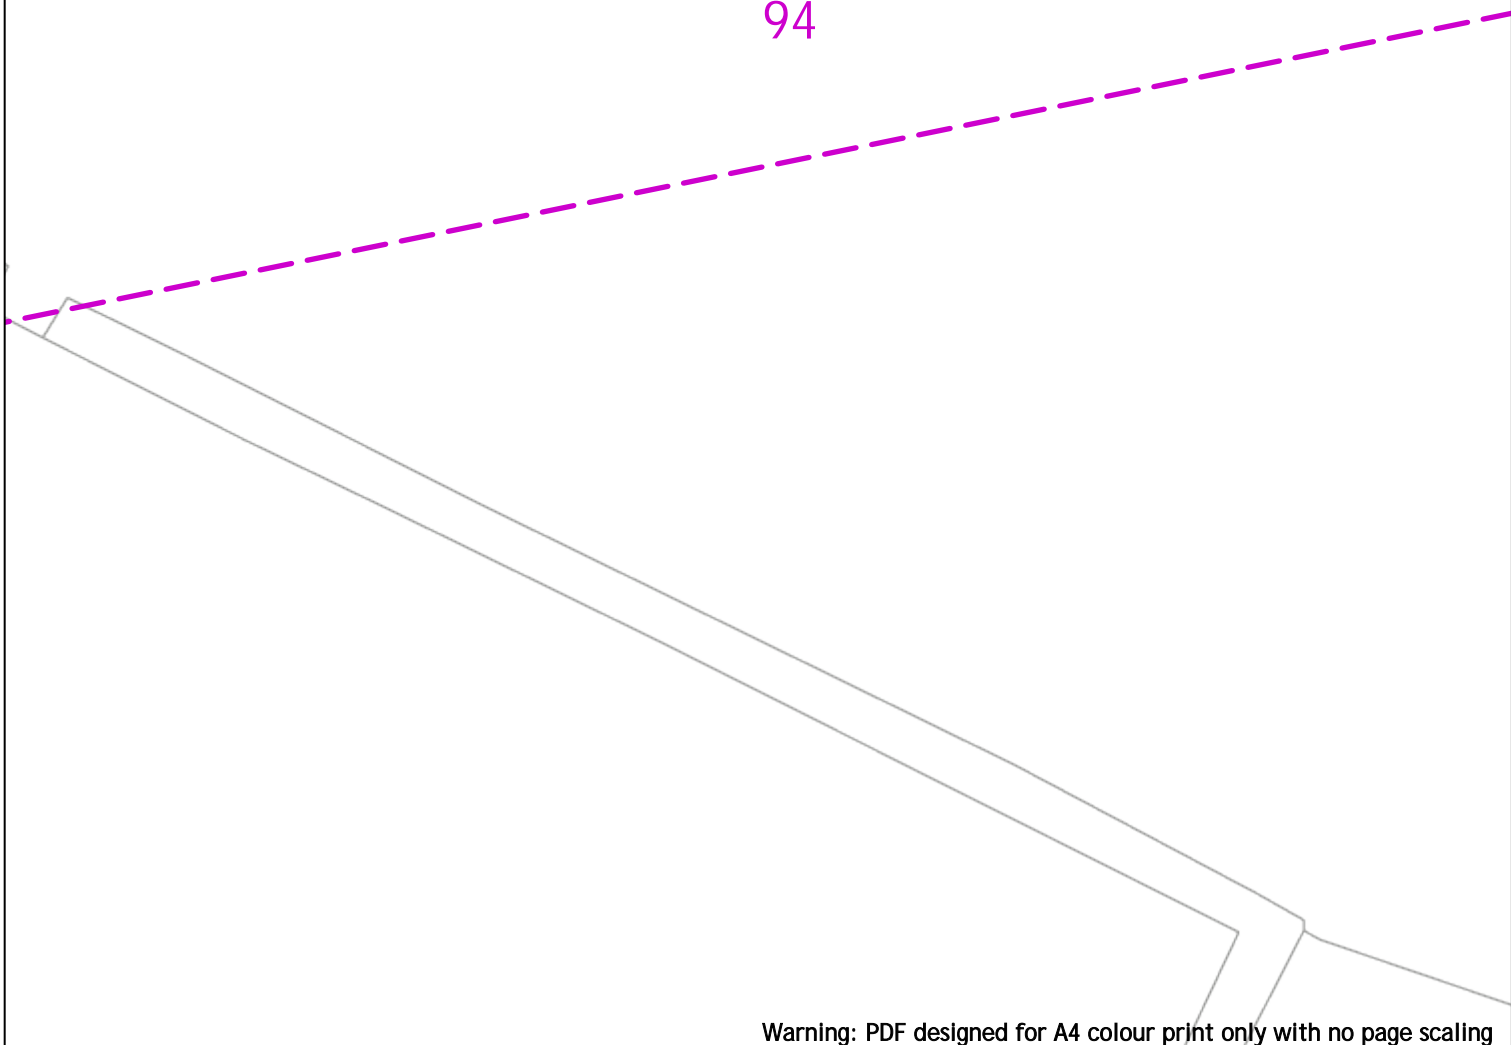

Warning: PDF designed for A4 colour print only with no page scaling















 
Dig Sites Area:  Line: 

 **Extra High Voltage cables in vicinity**



Date Requested: 24/06/2022  
 Job Reference: 25881037  
 Site Location: 448662 213014  
 Requested by: Mr Joe Shawyer  
 Your Scheme/Reference: 31188\_003

Voltages (V)			
LV (Low Voltage) and Services	Up to 1,000V		
HV (High Voltage)	Over 1,000V to 11,000V		
EHV (Extra High Voltage)	22,000V to 132,000V		
Transmission	275,000V and 400,000V		
NORMAL DEPTH TO THE TOP OF THE CABLE WHEN LAID			
Services	LV	HV	EHV
Footpath/Unmade	0.45m	0.45m	0.6m 0.8m
Road Crossing	0.6m	0.6m	0.75m 0.9m
Agricultural	1m	1m	1m 1.1m

Legend	
	Service Cable
	LV Mains
	2 - 11kV
	66kV
	11kV
	22kV
	33kV
	66kV
	132kV
	275kV
	400kV
	Fibre Optic
	Pipe Cable

Distribution Structures (Electric)	
	Pole, Existing Location
	Pole Structure, Existing Location - Single
	Pole Structure, Existing Location - H
	Duct Route
	Cross Section Route


**Southern Electric Power Distribution plc**  
 Registered Office: No.1 Forbury Place  
 43 Forbury Road Reading RG1 3JH  
 Registered In England & Wales No.04094290

If you're unsure & need to seek advice before commencing excavations, please contact:  
 General Enquiries: 0800 048 3516

Subject to revision - Master held by SSEN Asset Data Team:  
[Asset.Data@sse.com](mailto:Asset.Data@sse.com)  
 01256 337 294

Scale: 1:500 (When plotted at A4)

**WARNING**  
 There may have been subsequent alteration to the surface levels. Trial holes must be undertaken to determine position and depths of cables. HS (G) 47 Booklet from the Health and Safety Executive - Avoiding Danger from Buried Cables - should be consulted before commencing excavation work.  
**WHEN WORKING IN THE VICINITY OF OVERHEAD LINES THE HEALTH AND SAFETY GUIDANCE NOTES G56 SHOULD BE CONSULTED (AVAILABLE FROM THE HSE WEBSITE)**

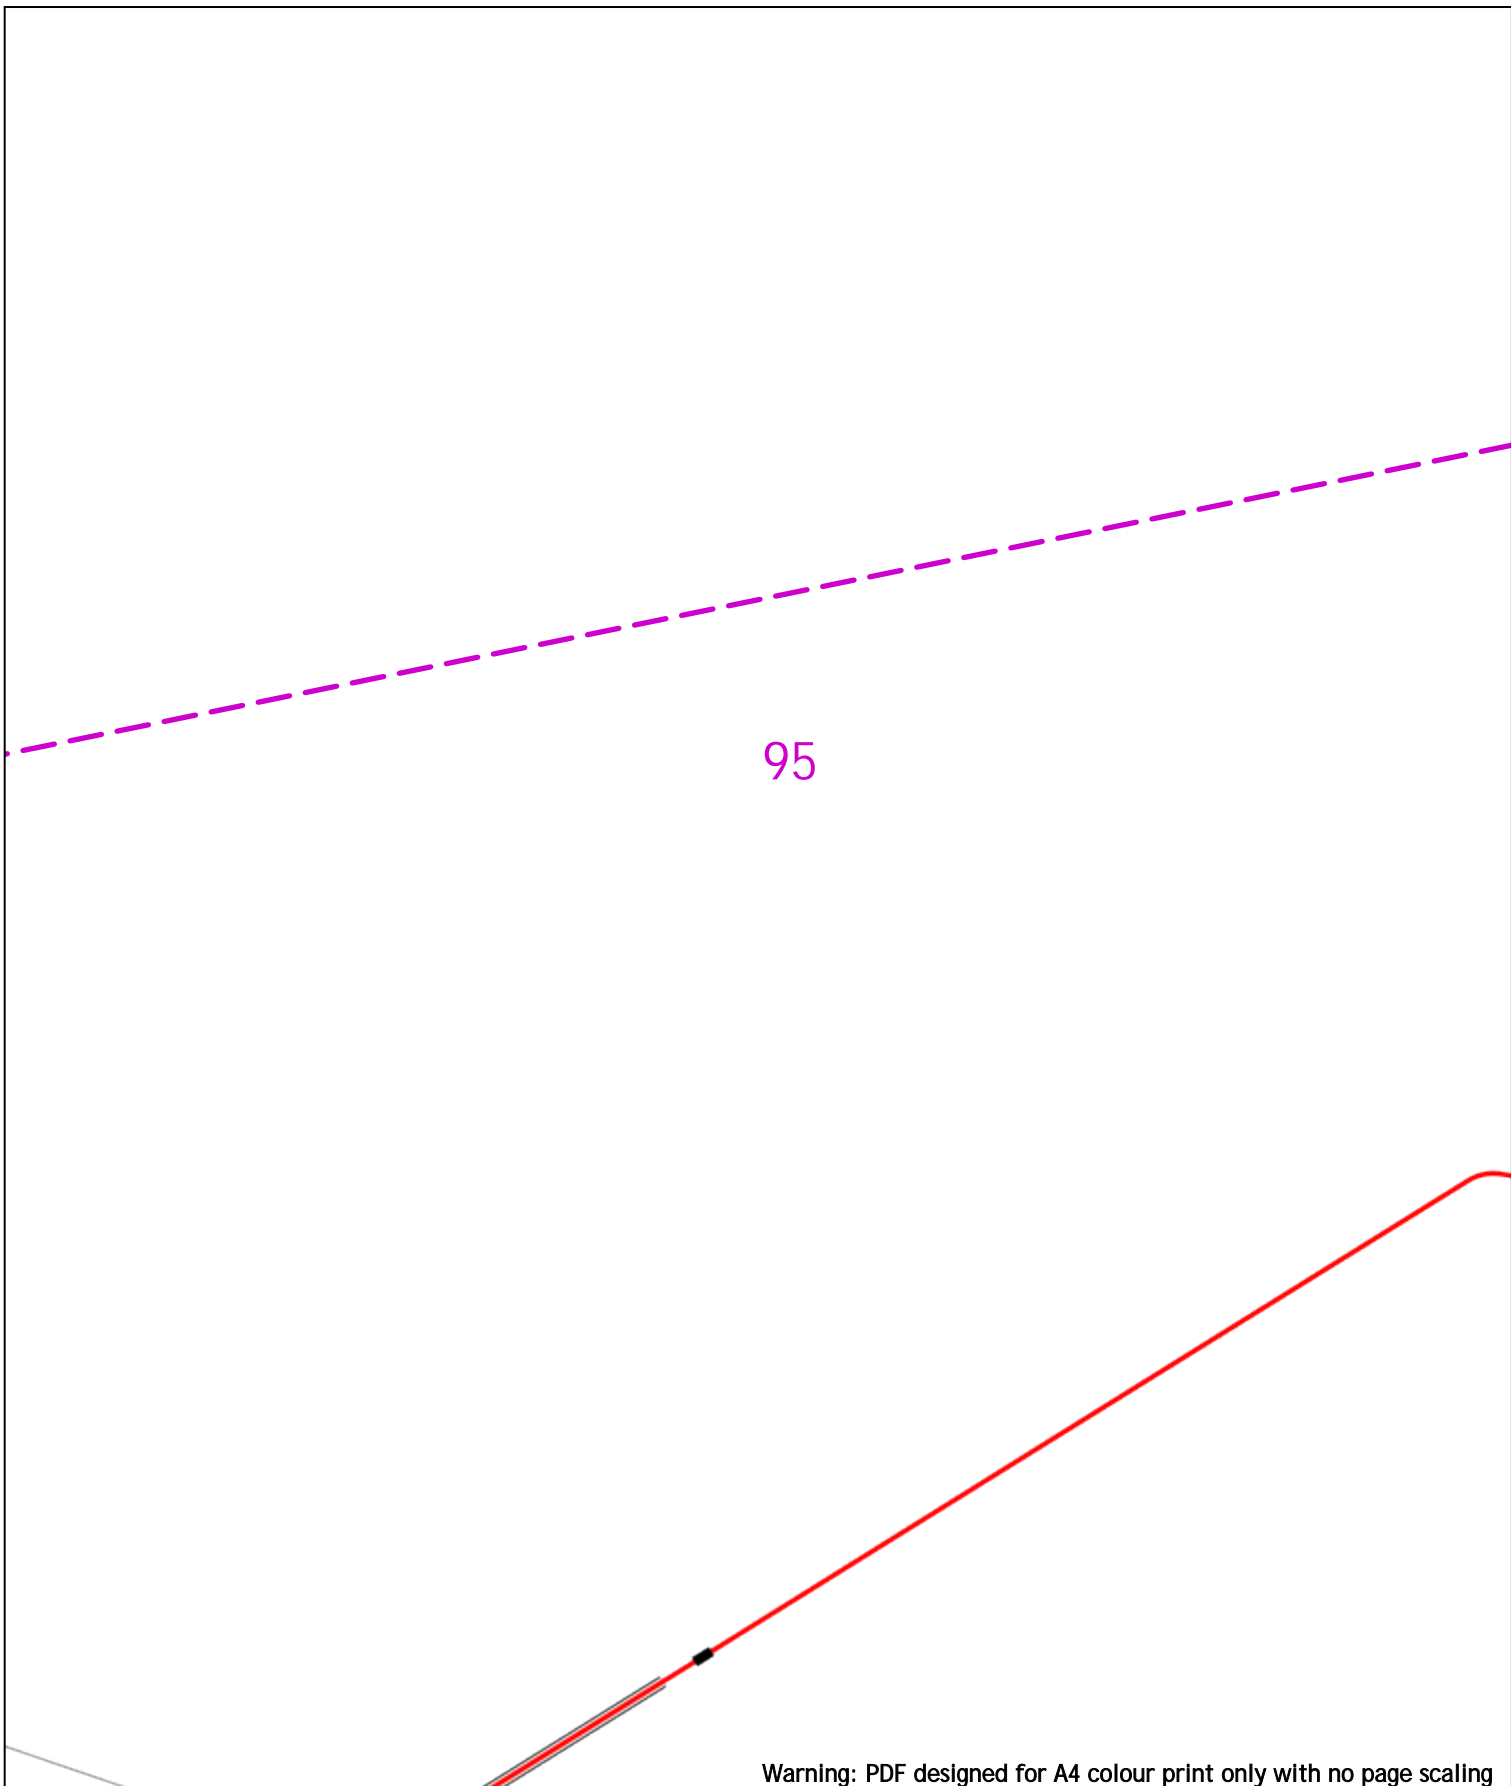

95

Warning: PDF designed for A4 colour print only with no page scaling



Dig Sites Area: Line:

**Extra High Voltage cables in vicinity**



Date Requested: 24/06/2022  
 Job Reference: 25881037  
 Site Location: 448662 213014  
 Requested by: Mr Joe Shawyer  
 Your Scheme/Reference: 31188\_003

Voltages (V)			
LV (Low Voltage) and Services	Up to 1,000V		
HV (High Voltage)	Over 1,000V to 11,000V		
EHV (Extra High Voltage)	22,000V to 132,000V		
Transmission	275,000V and 400,000V		
NORMAL DEPTH TO THE TOP OF THE CABLE WHEN LAID			
Services	LV	HV	EHV
Footpath/Unmade	0.45m	0.45m	0.6m 0.8m
Road Crossing	0.6m	0.6m	0.75m 0.9m
Agricultural	1m	1m	1m 1.1m

Legend	
	Service Cable
	LV Mains
	2 - 11kV
	66kV
	11kV
	22kV
	33kV
	66kV
	132kV
	275kV
	400kV
	Fibre Optic
	Pipe Cable

Distribution Structures (Electric)	
	Pole, Existing Location
	Pole Structure, Existing Location - Single
	Pole Structure, Existing Location - H
	Duct Route
	Cross Section Route


**Southern Electric Power Distribution plc**  
 Registered Office: No.1 Forbury Place  
 43 Forbury Road Reading RG1 3JH  
 Registered In England & Wales No.04094290

If you're unsure & need to seek advice before commencing excavations, please contact:  
 General Enquiries: 0800 048 3516

Scale: 1:500 (When plotted at A4)

**WARNING**  
 There may have been subsequent alteration to the surface levels. Trial holes must be undertaken to determine position and depths of cables. HS (G) 47 Booklet from the Health and Safety Executive - Avoiding Danger from Buried Cables - should be consulted before commencing excavation work.  
**WHEN WORKING IN THE VICINITY OF OVERHEAD LINES THE HEALTH AND SAFETY GUIDANCE NOTES G56 SHOULD BE CONSULTED (AVAILABLE FROM THE HSE WEBSITE)**

Subject to revision - Master held by SSEN Asset Data Team:  
[Asset.Data@sse.com](mailto:Asset.Data@sse.com)  
 01256 337 294

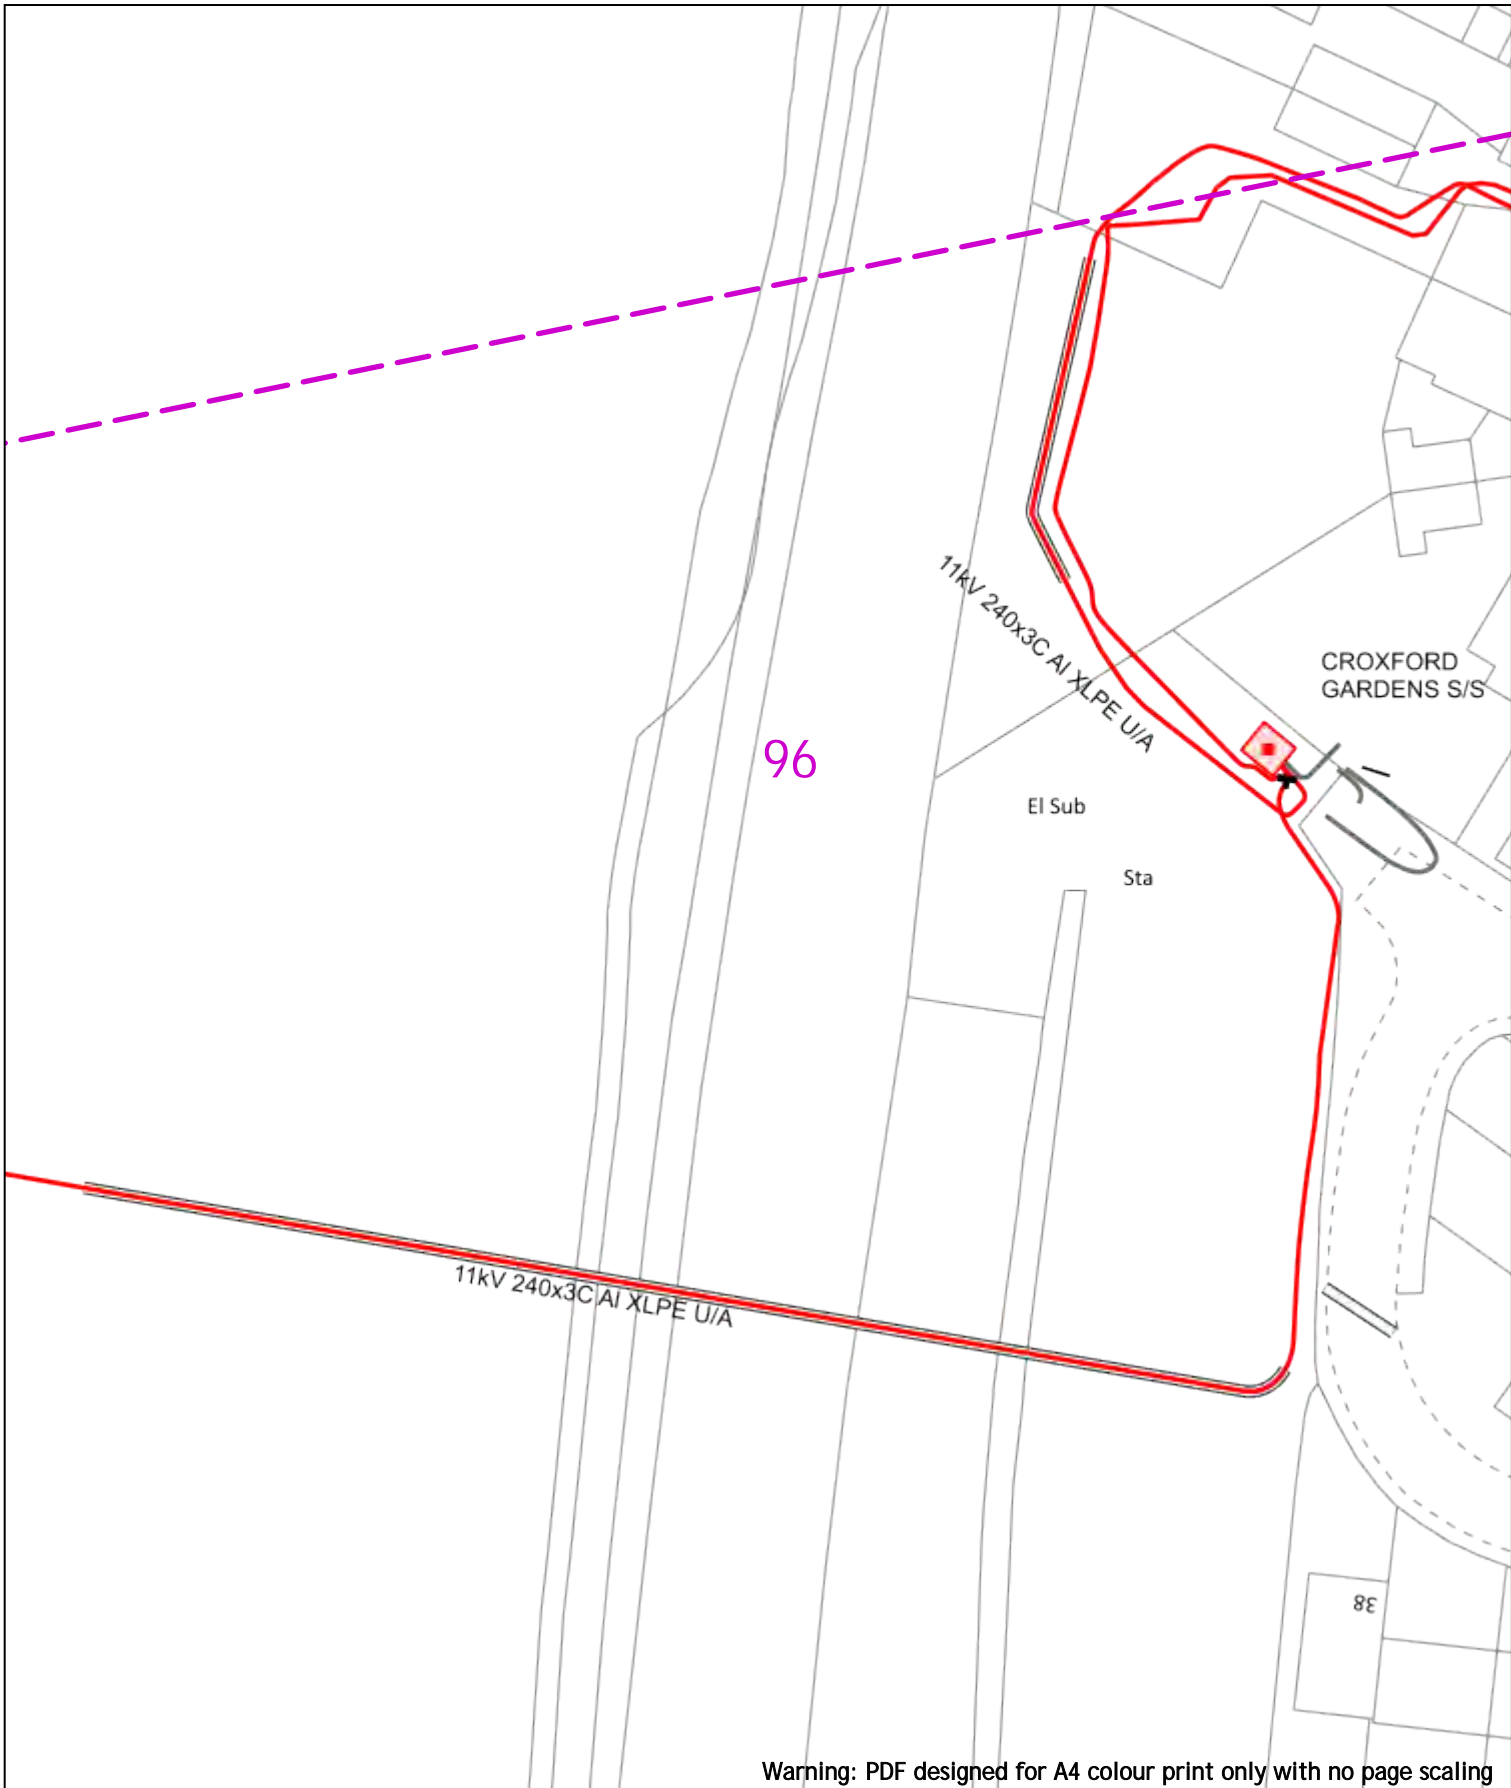

Warning: PDF designed for A4 colour print only with no page scaling

0 20m

Dig Sites: Area: Line:

**Extra High Voltage  
cables in vicinity**

Date Requested: 24/06/2022  
 Job Reference: 25881037  
 Site Location: 448662 213014  
 Requested by: Mr Joe Shawyer  
 Your Scheme/Reference: 31188\_003

Voltages (V)			
LV (Low Voltage) and Services	Up to 1,000V		
HV (High Voltage)	Over 1,000V to 11,000V		
EHV (Extra High Voltage)	22,000V to 132,000V		
Transmission	275,000V and 400,000V		

NORMAL DEPTH TO THE TOP OF THE CABLE WHEN LAID				
Services	LV	HV	EHV	
Footpath/Unmade	0.45m	0.45m	0.6m	0.8m
Road Crossing	0.6m	0.6m	0.75m	0.9m
Agricultural	1m	1m	1m	1.1m

<p><b>Legend</b></p> <ul style="list-style-type: none"> <li> Service Cable</li> <li> LV Mains</li> <li> 2 - 11kV</li> <li> 66kV</li> <li> 11kV</li> <li> 22kV</li> <li> 33kV</li> <li> 66kV</li> <li> 132kV</li> <li> 275kV</li> <li> 400kV</li> <li> Fibre Optic</li> <li> Pilot Cable</li> </ul>	<p><b>Distribution Structures (Electric)</b></p> <ul style="list-style-type: none"> <li> Pole, Existing Location</li> <li> Pole Structure, Existing Location - Single</li> <li> Pole Structure, Existing Location - H</li> <li> Duct Route</li> <li> Cross Section Route</li> </ul>
--	---

**WARNING**

There may have been subsequent alteration to the surface levels. Trial holes must be undertaken to determine position and depths of cables. HS (G) 47 Booklet from the Health and Safety Executive - Avoiding Danger from Buried Cables - should be consulted before commencing excavation work.

WHEN WORKING IN THE VICINITY OF OVERHEAD LINES THE HEALTH AND SAFETY GUIDANCE NOTES G56 SHOULD BE CONSULTED (AVAILABLE FROM THE HSE WEBSITE)


**Southern Electric Power Distribution plc**

Registered Office: No.1 Forbury Place  
 43 Forbury Road Reading RG1 3JH  
 Registered In England & Wales No.04094290

If you're unsure & need to seek advice before commencing excavations, please contact:  
 General Enquiries: 0800 048 3516

Subject to revision - Master held by SSEN Asset Data Team:  
[Asset.Data@sse.com](mailto:Asset.Data@sse.com)  
 01256 337 294


Scale: 1:500 (When plotted at A4)

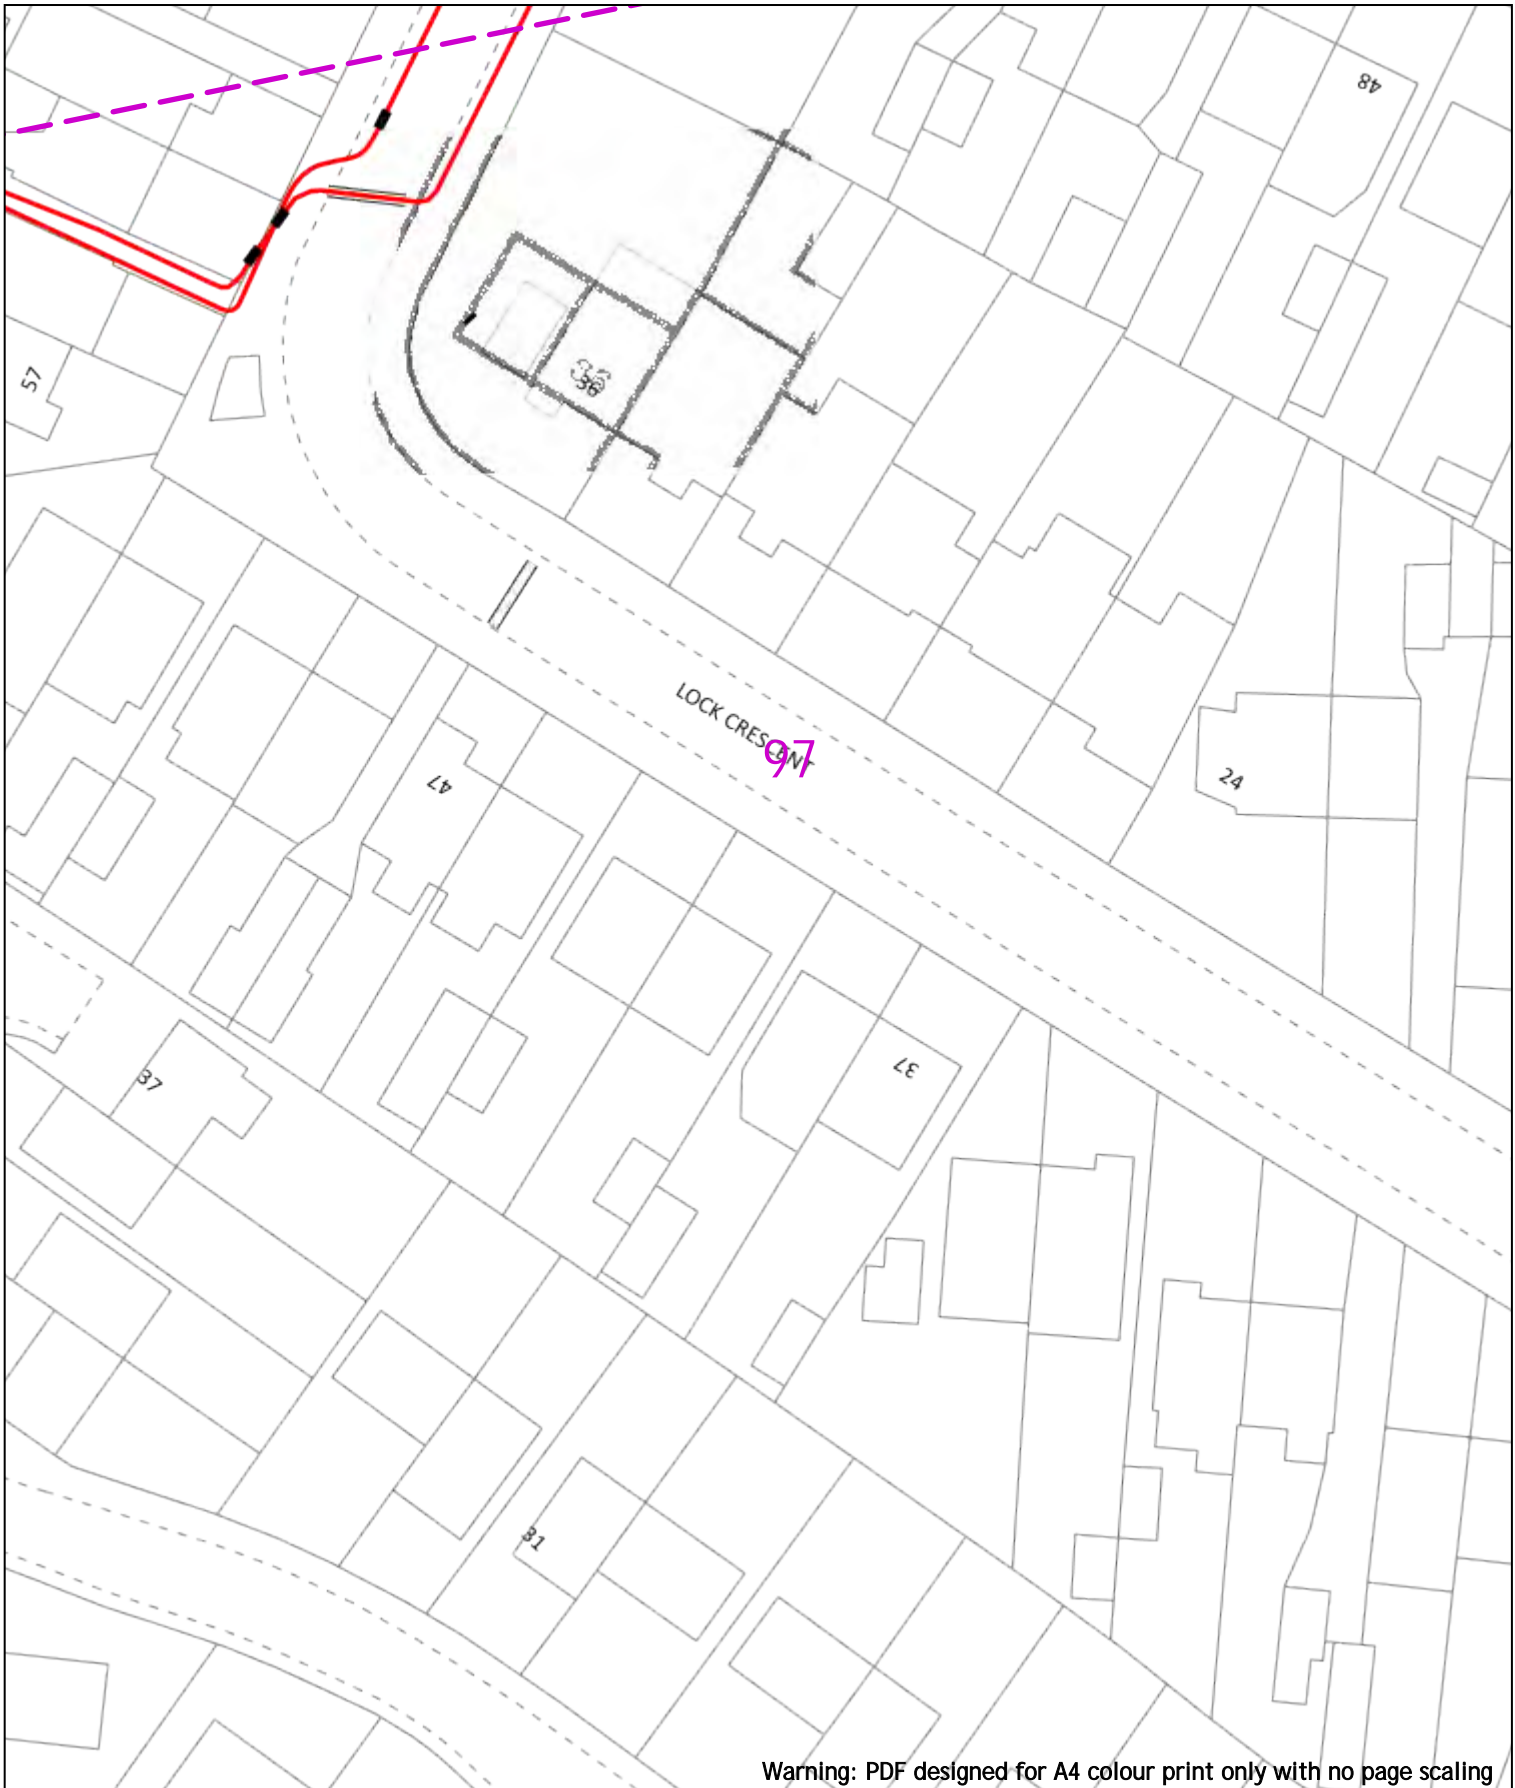

Warning: PDF designed for A4 colour print only with no page scaling

<p>0  20m</p>	<p>Dig Sites Area:  Line: </p>	<p><b>Extra High Voltage cables in vicinity</b></p>																									
<p>Date Requested: 24/06/2022          Job Reference: 25881037          Site Location: 448662 213014          Requested by: Mr Joe Shawyer          Your Scheme/Reference: 31188_003</p>	<p><b>Voltagess (V)</b></p> <table border="1"> <tr> <td>LV (Low Voltage) and Services</td> <td>Up to 1,000V</td> </tr> <tr> <td>HV (High Voltage)</td> <td>Over 1,000V to 11,000V</td> </tr> <tr> <td>EHV (Extra High Voltage)</td> <td>22,000V to 132,000V</td> </tr> <tr> <td>Transmission</td> <td>275,000V and 400,000V</td> </tr> </table> <p><b>NORMAL DEPTH TO THE TOP OF THE CABLE WHEN LAID</b></p> <table border="1"> <thead> <tr> <th>Services</th> <th>LV</th> <th>HV</th> <th>EHV</th> </tr> </thead> <tbody> <tr> <td>Footpath/Unmade</td> <td>0.45m</td> <td>0.45m</td> <td>0.6m</td> </tr> <tr> <td>Road Crossing</td> <td>0.6m</td> <td>0.6m</td> <td>0.75m</td> </tr> <tr> <td>Agricultural</td> <td>1m</td> <td>1m</td> <td>1.1m</td> </tr> </tbody> </table>	LV (Low Voltage) and Services	Up to 1,000V	HV (High Voltage)	Over 1,000V to 11,000V	EHV (Extra High Voltage)	22,000V to 132,000V	Transmission	275,000V and 400,000V	Services	LV	HV	EHV	Footpath/Unmade	0.45m	0.45m	0.6m	Road Crossing	0.6m	0.6m	0.75m	Agricultural	1m	1m	1.1m	<p><b>Legend</b></p> <ul style="list-style-type: none"> <li> Service Cable</li> <li> LV Mains</li> <li> 6.6kV</li> <li> 11kV</li> <li> 22kV</li> <li> 33kV</li> <li> 66kV</li> <li> 132kV</li> <li> 275kV</li> <li> 400kV</li> <li> Fibre Optic</li> <li> Pipit Cable</li> </ul> <p><b>Distribution Structures (Electric)</b></p> <ul style="list-style-type: none"> <li> Pole, Existing Location</li> <li> Pole Structure, Existing Location - Single</li> <li> Pole Structure, Existing Location - H</li> <li> Duct Route</li> <li> Cross Section Route</li> </ul>	<p><b>Southern Electric Power Distribution plc</b>          Registered Office: No.1 Forbury Place          43 Forbury Road Reading RG1 3JH          Registered In England &amp; Wales No.04094290</p> <p>If you're unsure &amp; need to seek advice before commencing excavations, please contact:          General Enquiries: 0800 048 3516</p> <p>Subject to revision – Master held by SSEN Asset Data Team:  <a href="mailto:Asset.Data@sse.com">Asset.Data@sse.com</a>          01256 337 294</p>
<p>Scale: 1:500 (When plotted at A4)</p> <p><b>WARNING</b>          There may have been subsequent alteration to the surface levels. Trial holes must be undertaken to determine position and depths of cables. HS (G) 47 Booklet from the Health and Safety Executive – Avoiding Danger from Buried Cables – should be consulted before commencing excavation work.  <b>WHEN WORKING IN THE VICINITY OF OVERHEAD LINES THE HEALTH AND SAFETY GUIDANCE NOTES G56 SHOULD BE CONSULTED (AVAILABLE FROM THE HSE WEBSITE)</b></p> <p><small>BASED UPON THE ORDNANCE SURVEY MAP WITH THE SANCTION OF THE CONTROLLER OF HM STATIONERY OFFICE CROWN COPYRIGHT RESERVED.          This copy has been made by or with the authority of Scottish and Southern Energy Power Distribution Ltd. Pursuant to section 47 of the Copyright, Designs and Patents Act 1988 ('The Act'). Unless the Act provides a relevant exception to copyright the copy must not be copied without prior permission of the copyright owner.          Plans generated by DigSAFE Pro™ software provided by Lineworkbefore066.</small></p>																											



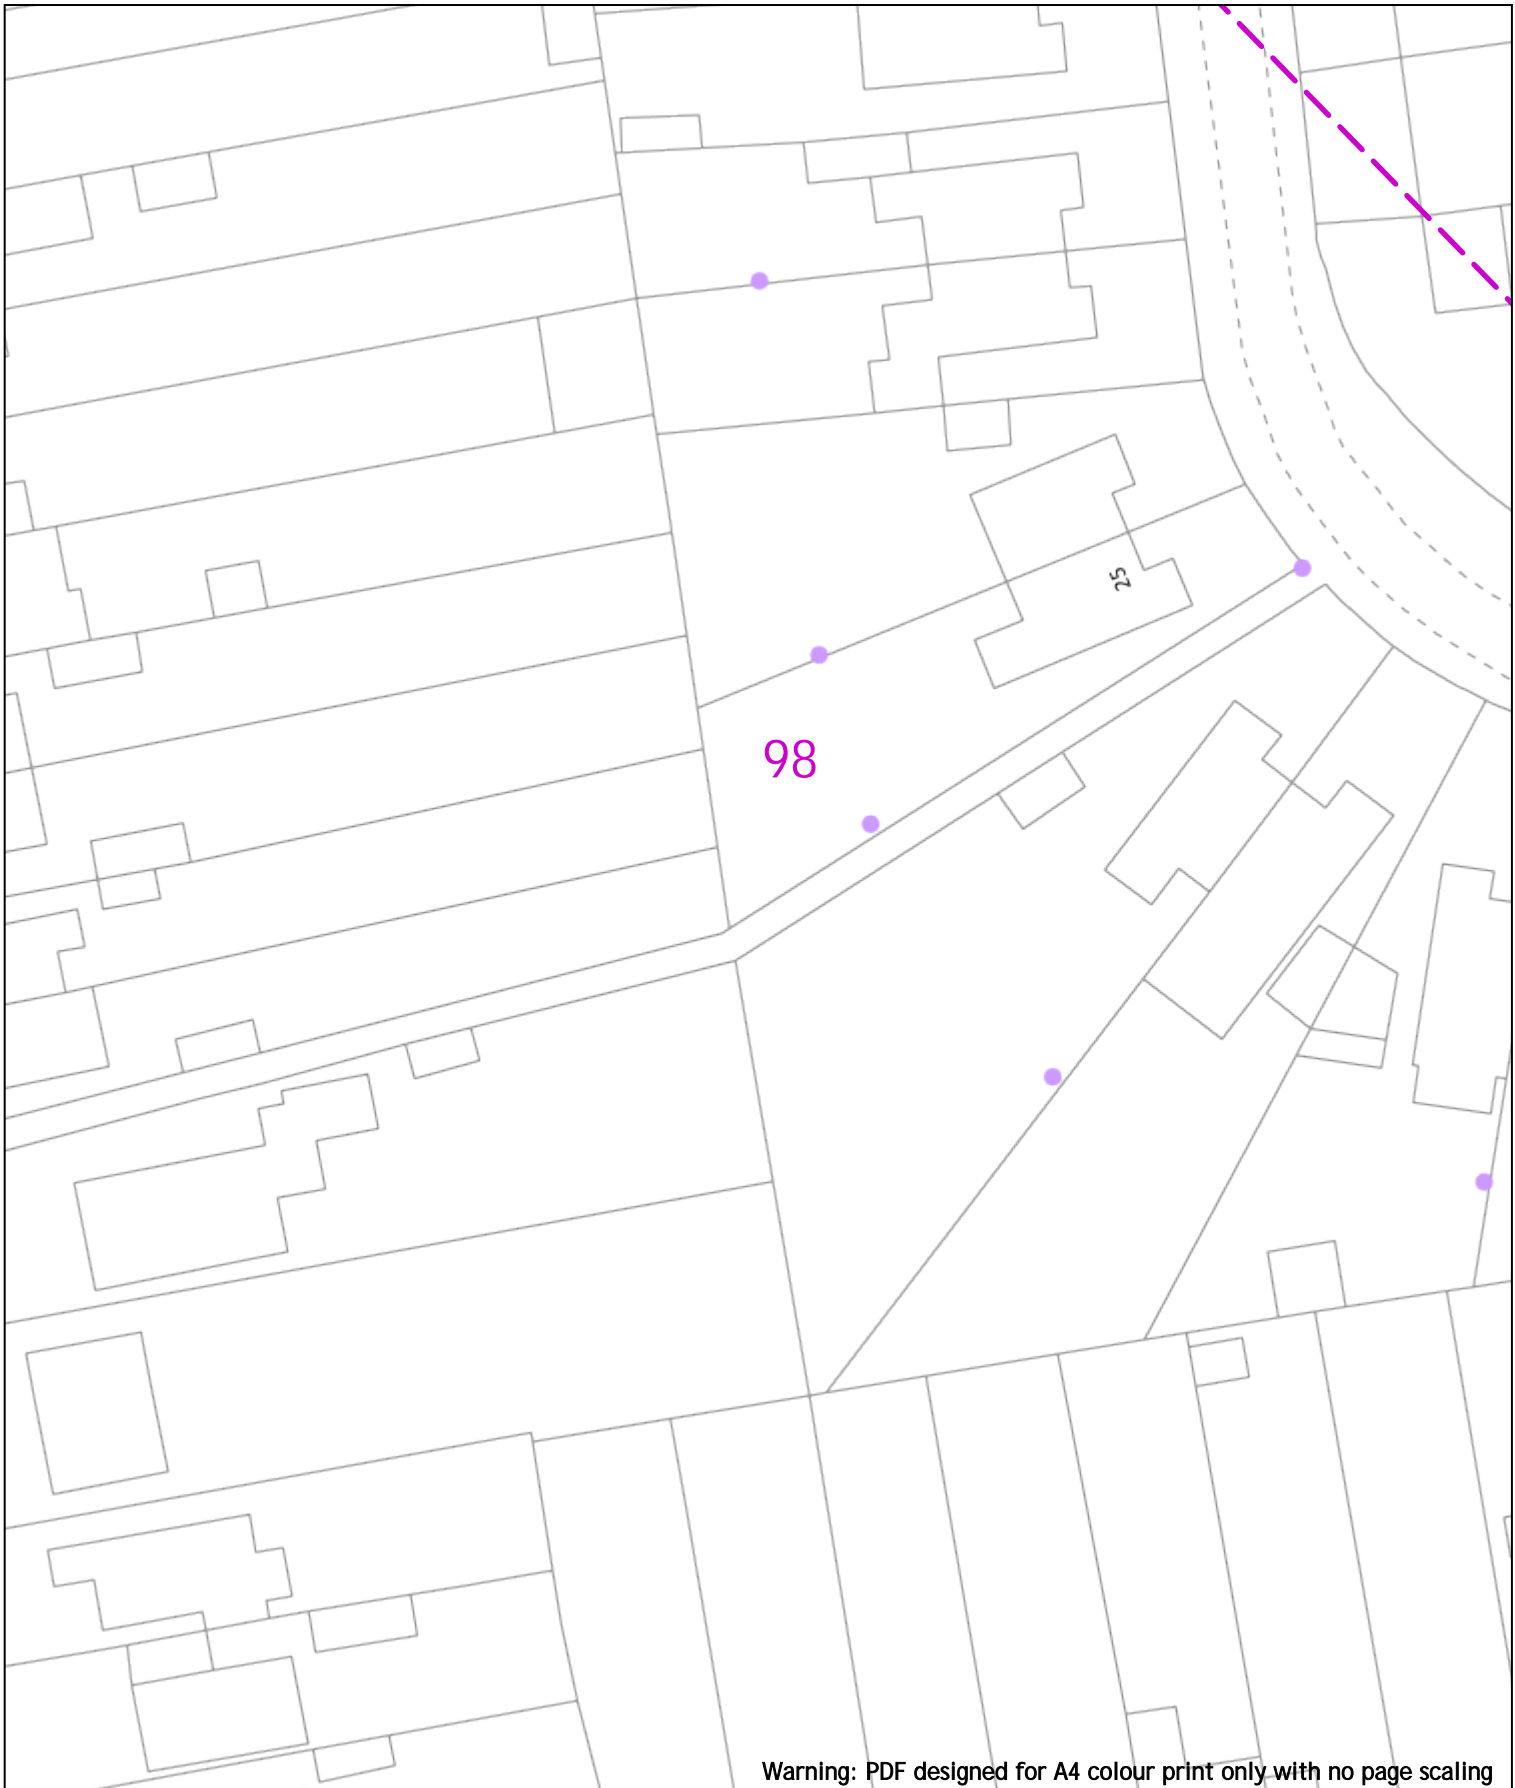

Warning: PDF designed for A4 colour print only with no page scaling

0 20m Dig Sites Area: Line: **Extra High Voltage cables in vicinity**

Date Requested: 24/06/2022  
 Job Reference: 25881037  
 Site Location: 448662 213014  
 Requested by: Mr Joe Shawyer  
 Your Scheme/Reference: 31188\_003

Voltages (V)			
LV (Low Voltage) and Services	Up to 1,000V		
HV (High Voltage)	Over 1,000V to 11,000V		
EHV (Extra High Voltage)	22,000V to 132,000V		
Transmission	275,000V and 400,000V		
NORMAL DEPTH TO THE TOP OF THE CABLE WHEN LAID			
Services	LV	HV	EHV
Footpath/Unmade	0.45m	0.45m	0.6m
Road Crossing	0.6m	0.6m	0.75m
Agricultural	1m	1m	1.1m

Legend	
	Service Cable
	LV Mains
	2 - 11kV
	66kV
	11kV
	22kV
	33kV
	66kV
	132kV
	275kV
	400kV
	Fibre Optic
	Pipe Cable

Distribution Structures (Electric)	
	Pole, Existing Location
	Pole Structure, Existing Location - Single
	Pole Structure, Existing Location - H
	Duct Route
	Cross Section Route

**Southern Electric Power Distribution plc**  
 Registered Office: No.1 Forbury Place  
 43 Forbury Road Reading RG1 3JH  
 Registered In England & Wales No.04094290

If you're unsure & need to seek advice before commencing excavations, please contact:  
 General Enquiries: 0800 048 3516

Subject to revision – Master held by SSEN Asset Data Team:  
[Asset.Data@sse.com](mailto:Asset.Data@sse.com)  
 01256 337 294










**WARNING**  
 There may have been subsequent alteration to the surface levels. Trial holes must be undertaken to determine position and depths of cables. HS (G) 47 Booklet from the Health and Safety Executive - Avoiding Danger from Buried Cables - should be consulted before commencing excavation work.  
**WHEN WORKING IN THE VICINITY OF OVERHEAD LINES THE HEALTH AND SAFETY GUIDANCE NOTES G56 SHOULD BE CONSULTED (AVAILABLE FROM THE HSE WEBSITE)**

Scale: 1:500 (When plotted at A4)





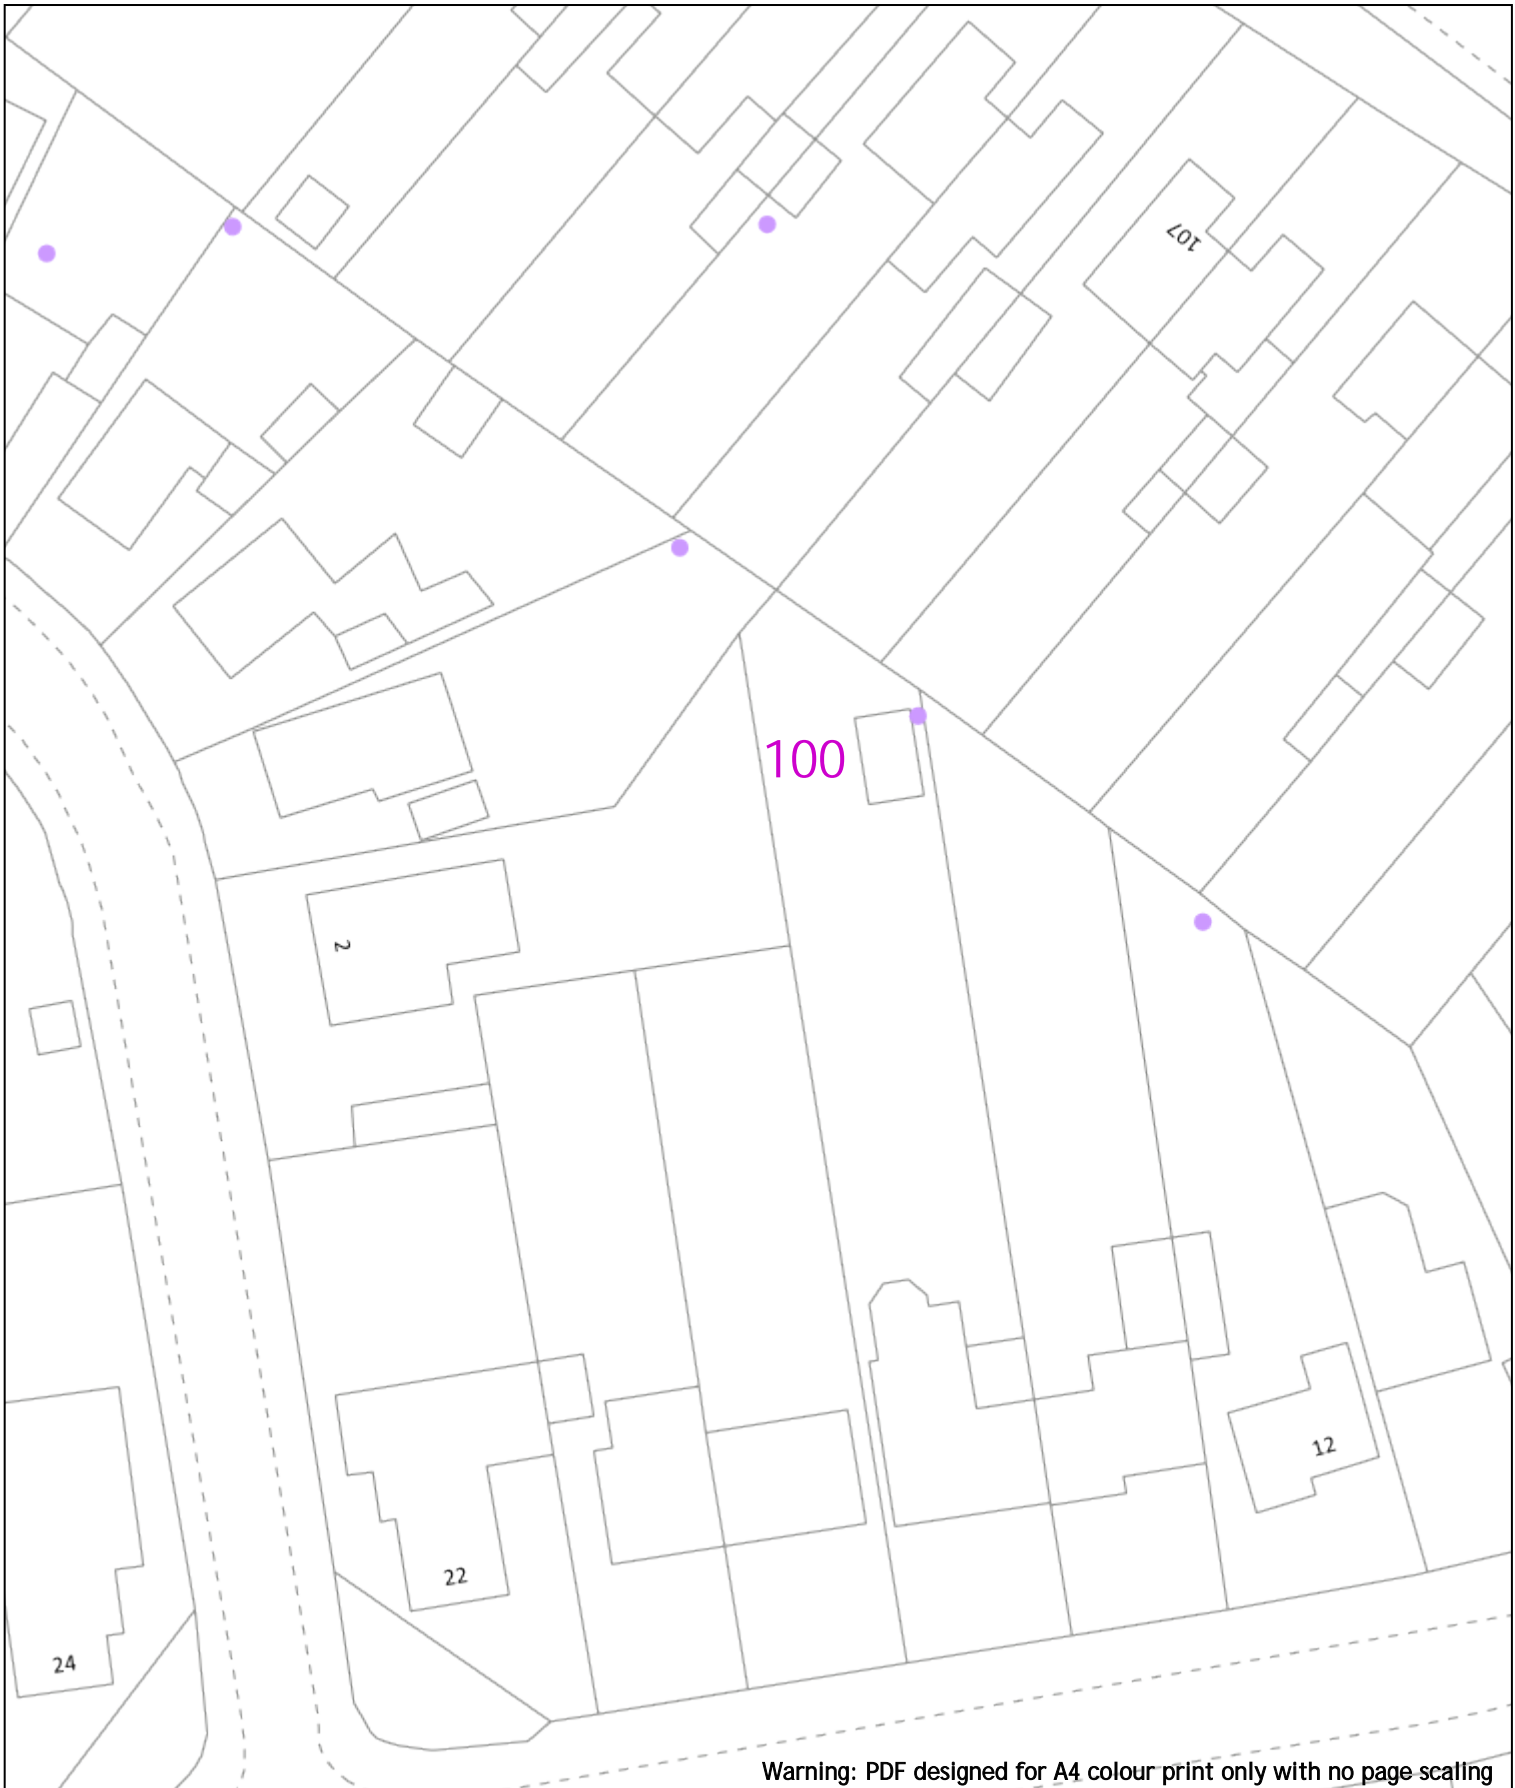

Warning: PDF designed for A4 colour print only with no page scaling

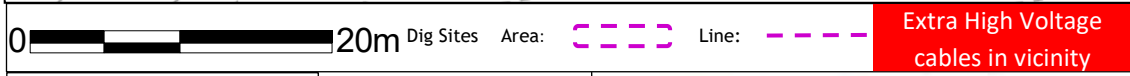

Date Requested: 24/06/2022  
 Job Reference: 25881037  
 Site Location: 448662 213014  
 Requested by: Mr Joe Shawyer  
 Your Scheme/Reference: 31188\_003

Voltages (V)				
LV (Low Voltage) and Services	Up to 1,000V			
HV (High Voltage)	Over 1,000V to 11,000V			
EHV (Extra High Voltage)	22,000V to 132,000V			
Transmission	275,000V and 400,000V			
NORMAL DEPTH TO THE TOP OF THE CABLE WHEN LAID				
Services	LV	HV	EHV	
Footpath/Unmade	0.45m	0.45m	0.6m	0.8m
Road Crossing	0.6m	0.6m	0.75m	0.9m
Agricultural	1m	1m	1m	1.1m

Legend	
Service Cable	—
LV Mains	—
2 - 11kV	—
6kV	—
11kV	—
22kV	—
33kV	—
66kV	—
132kV	—
275kV	—
400kV	—
Fibre Optic	—
Pilot Cable	—


Distribution Structures (Electric)	
Pole, Existing Location	●
Pole Structure, Existing Location - Single	○
Pole Structure, Existing Location - H	○
Duct Route	—
Cross Section Route	—

**WARNING**  
 There may have been subsequent alteration to the surface levels. Trial holes must be undertaken to determine position and depths of cables. HS (G) 47 Booklet from the Health and Safety Executive - Avoiding Danger from Buried Cables - should be consulted before commencing excavation work.  
 WHEN WORKING IN THE VICINITY OF OVERHEAD LINES THE HEALTH AND SAFETY GUIDANCE NOTES G56 SHOULD BE CONSULTED (AVAILABLE FROM THE HSE WEBSITE)

**Southern Electric Power Distribution plc**  
 Registered Office: No.1 Forbury Place  
 43 Forbury Road Reading RG1 3JH  
 Registered In England & Wales No.04094290

If you're unsure & need to seek advice before commencing excavations, please contact:  
 General Enquiries: 0800 048 3516


Subject to revision - Master held by SSEN Asset Data Team:  
[Asset.Data@sse.com](mailto:Asset.Data@sse.com)  
 01256 337 294

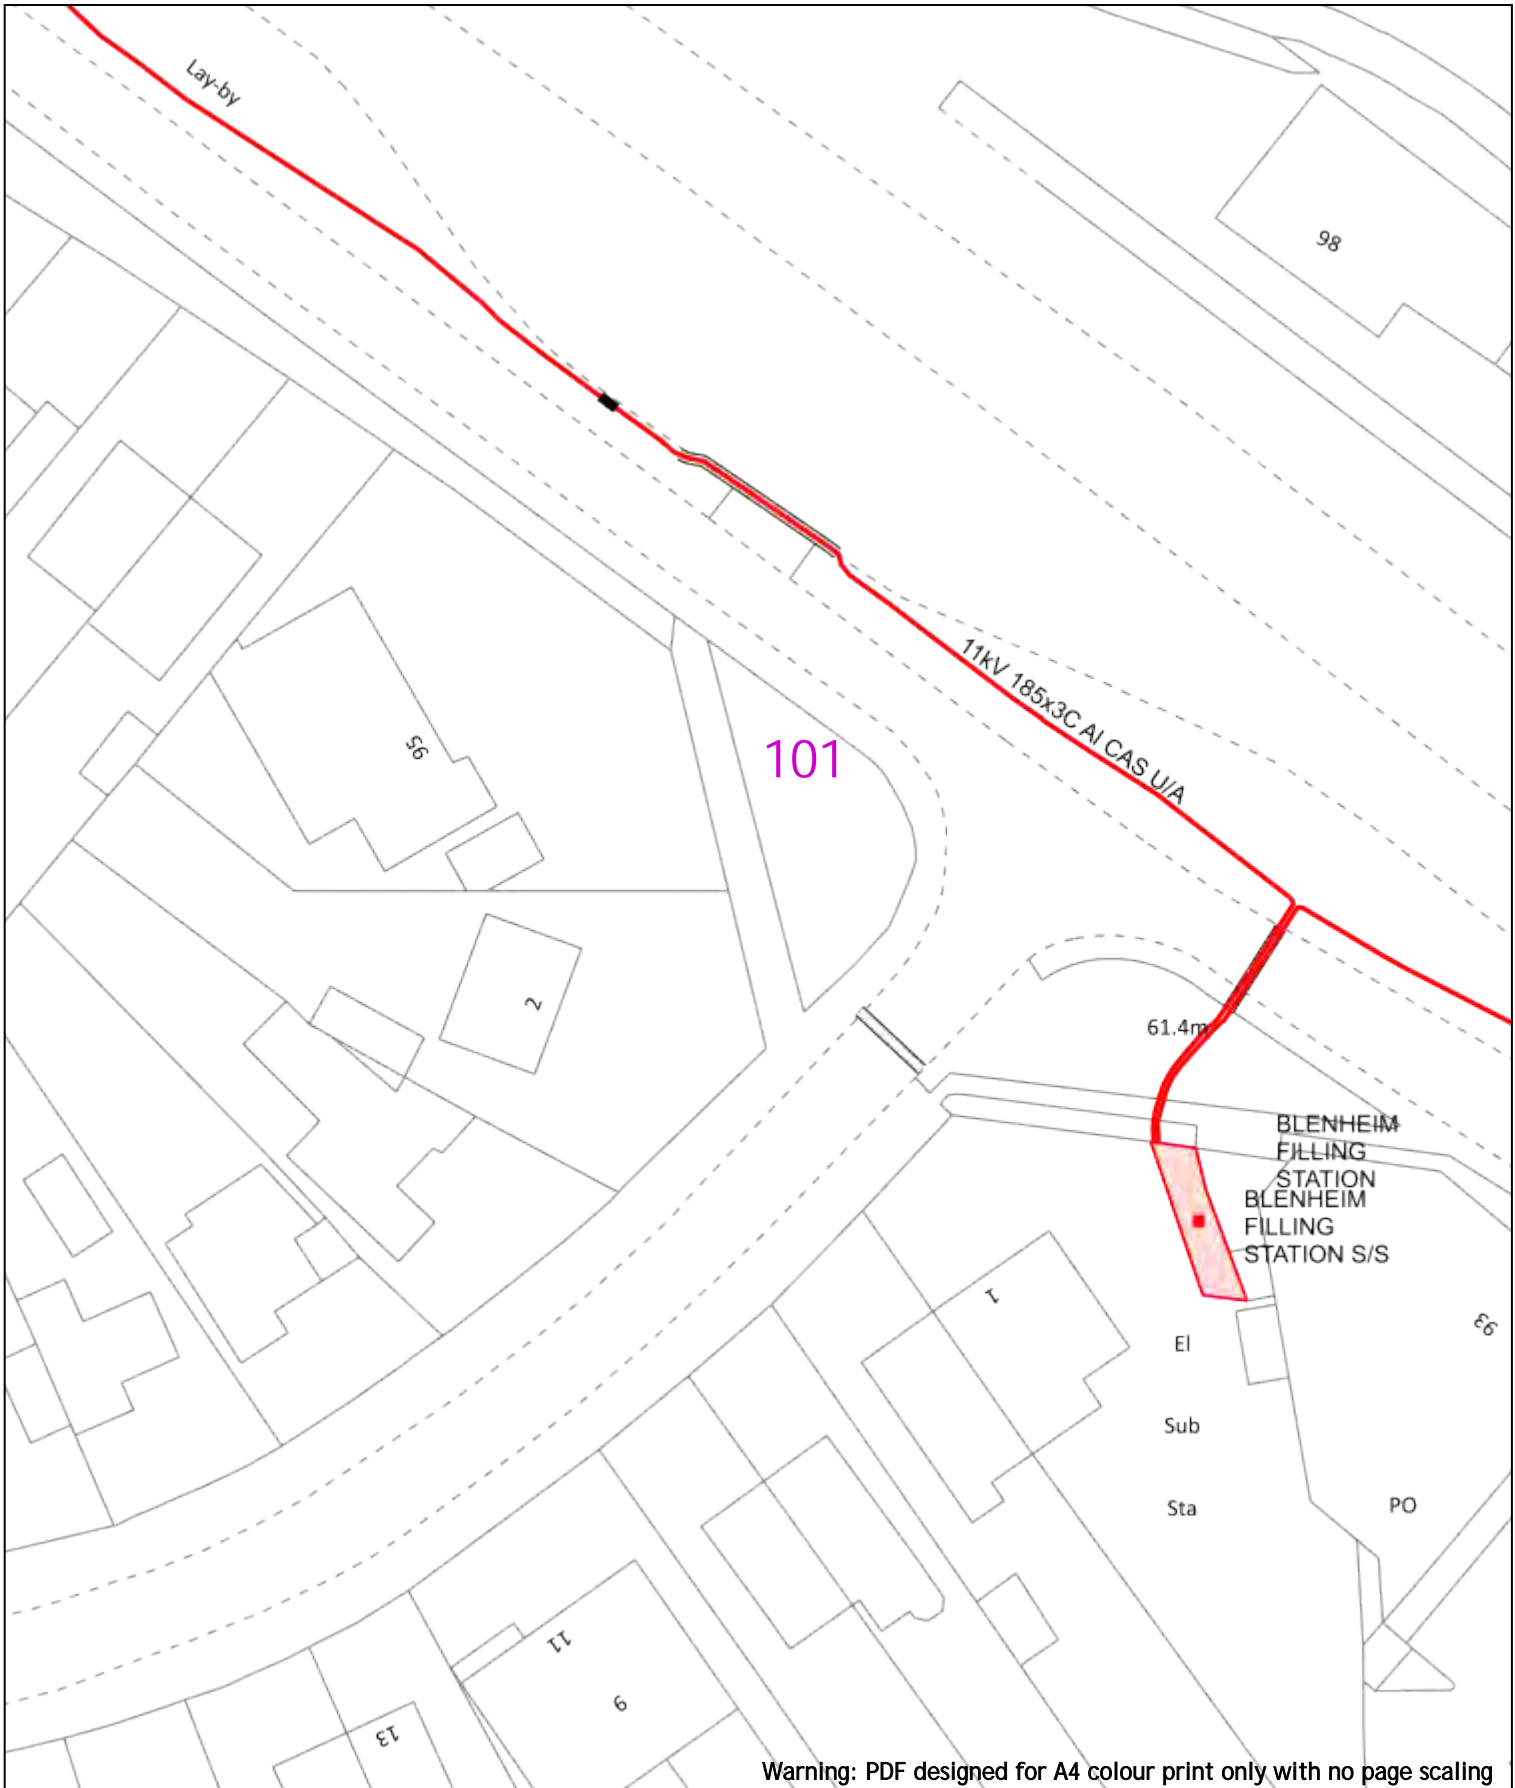

Warning: PDF designed for A4 colour print only with no page scaling


<p>0  20m Dig Sites Area:  Line:  <b>Extra High Voltage cables in vicinity</b></p>																										
<p>Date Requested: 24/06/2022          Job Reference: 25881037          Site Location: 448662 213014          Requested by: Mr Joe Shawyer          Your Scheme/Reference: 31188_003</p>	<p><b>Volts (V)</b></p> <table border="1"> <tr> <td>LV (Low Voltage) and Services</td> <td>Up to 1,000V</td> </tr> <tr> <td>HV (High Voltage)</td> <td>Over 1,000V to 11,000V</td> </tr> <tr> <td>EHV (Extra High Voltage)</td> <td>22,000V to 132,000V</td> </tr> <tr> <td>Transmission</td> <td>275,000V and 400,000V</td> </tr> </table> <p><b>NORMAL DEPTH TO THE TOP OF THE CABLE WHEN LAID</b></p> <table border="1"> <thead> <tr> <th>Services</th> <th>LV</th> <th>HV</th> <th>EHV</th> </tr> </thead> <tbody> <tr> <td>Footpath/Unmade</td> <td>0.45m</td> <td>0.45m</td> <td>0.6m</td> </tr> <tr> <td>Road Crossing</td> <td>0.6m</td> <td>0.6m</td> <td>0.75m</td> </tr> <tr> <td>Agricultural</td> <td>1m</td> <td>1m</td> <td>1.1m</td> </tr>
<p>Scale: 1:500 (When plotted at A4)</p>		<p><b>Southern Electric Power Distribution plc</b>          Registered Office: No.1 Forbury Place          43 Forbury Road Reading RG1 3JH          Registered In England &amp; Wales No.04094290</p> <p>If you're unsure &amp; need to seek advice before commencing excavations, please contact:          General Enquiries: 0800 048 3516</p> <p>Subject to revision – Master held by SSEN Asset Data Team:  <a href="mailto:Asset.Data@sse.com">Asset.Data@sse.com</a>          01256 337 294</p>																								

**WARNING**  
 There may have been subsequent alteration to the surface levels. Trial holes must be undertaken to determine position and depths of cables. HS (G) 47 Booklet from the Health and Safety Executive – Avoiding Danger from Buried Cables – should be consulted before commencing excavation work.  
**WHEN WORKING IN THE VICINITY OF OVERHEAD LINES THE HEALTH AND SAFETY GUIDANCE NOTES G56 SHOULD BE CONSULTED (AVAILABLE FROM THE HSE WEBSITE)**

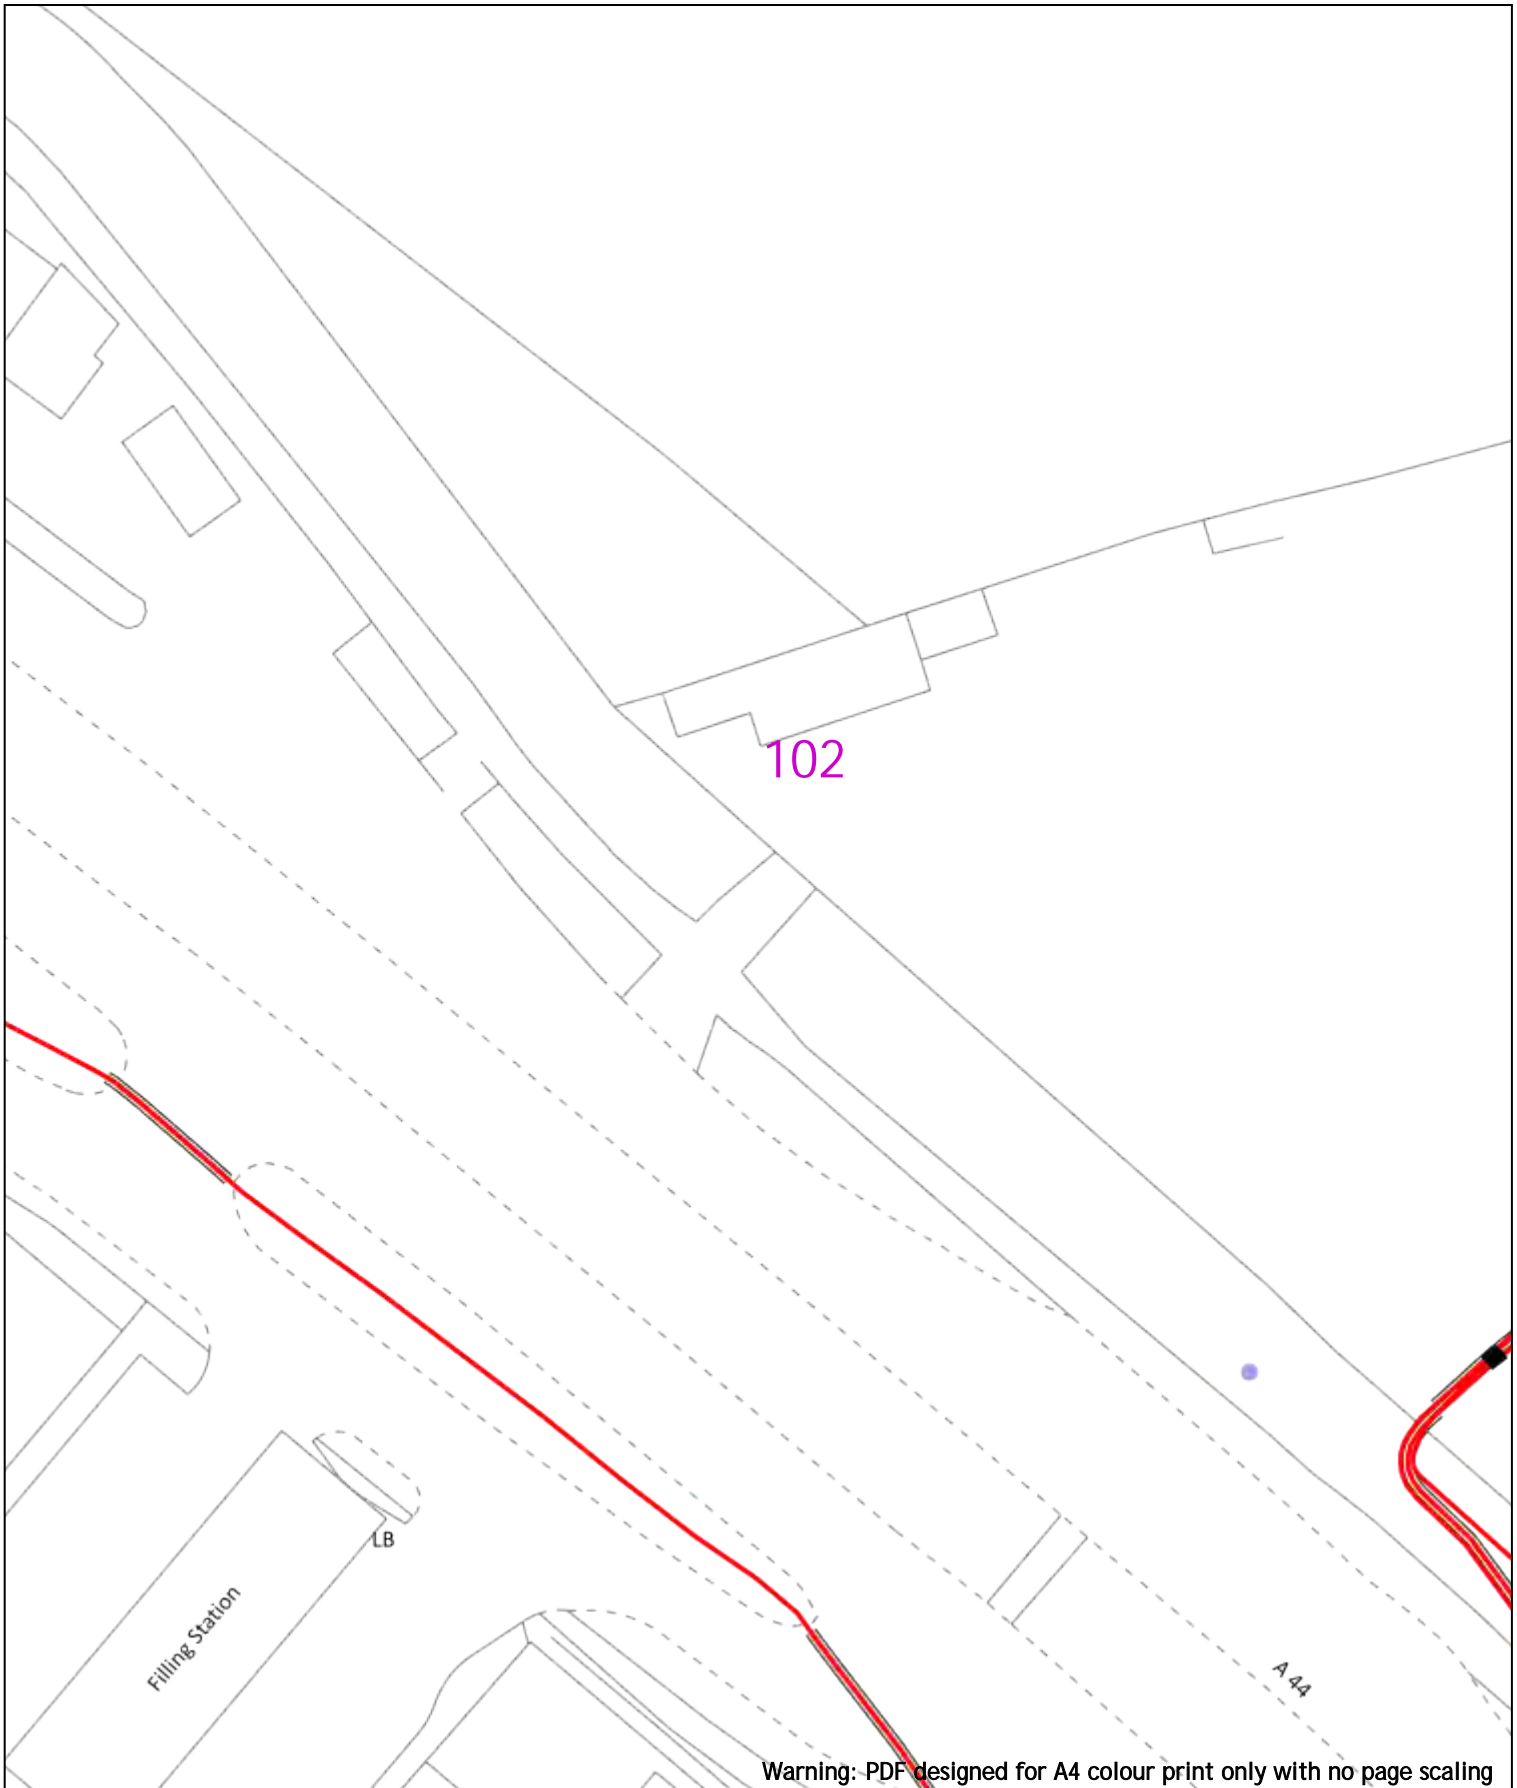


Warning: PDF designed for A4 colour print only with no page scaling

		Dig Sites Area:  Line:		<b>Extra High Voltage cables in vicinity</b>	
Date Requested: 24/06/2022 Job Reference: 25881037 Site Location: 448662 213014 Requested by: Mr Joe Shawyer Your Scheme/Reference: 31188_003		<table border="1"> <thead> <tr> <th colspan="5">Voltages (V)</th> </tr> </thead> <tbody> <tr> <td>LV (Low Voltage) and Services</td> <td colspan="4">Up to 1,000V</td> </tr> <tr> <td>HV (High Voltage)</td> <td colspan="4">Over 1,000V to 11,000V</td> </tr> <tr> <td>EHV (Extra High Voltage)</td> <td colspan="4">22,000V to 132,000V</td> </tr> <tr> <td>Transmission</td> <td colspan="4">275,000V and 400,000V</td> </tr> </tbody> </table> <table border="1"> <thead> <tr> <th colspan="5">NORMAL DEPTH TO THE TOP OF THE CABLE WHEN LAID</th> </tr> <tr> <th>Services</th> <th>LV</th> <th>HV</th> <th>EHV</th> <th></th> </tr> </thead> <tbody> <tr> <td>Footpath/Unmade</td> <td>0.45m</td> <td>0.45m</td> <td>0.6m</td> <td>0.8m</td> </tr> <tr> <td>Road Crossing</td> <td>0.6m</td> <td>0.6m</td> <td>0.75m</td> <td>0.9m</td> </tr> <tr> <td>Agricultural</td> <td>1m</td> <td>1m</td> <td>1m</td> <td>1.1m</td> </tr> </thead> <tbody> <tr><td></td><td>Service Cable</td></tr> <tr><td></td><td>LV Mains</td></tr> <tr><td></td><td>2 - 11kV</td></tr> <tr><td></td><td>66kV</td></tr> <tr><td></td><td>11kV</td></tr> <tr><td></td><td>22kV</td></tr> <tr><td></td><td>33kV</td></tr> <tr><td></td><td>66kV</td></tr> <tr><td></td><td>132kV</td></tr> <tr><td></td><td>275kV</td></tr> <tr><td></td><td>400kV</td></tr> <tr><td></td><td>Fibre Optic</td></tr> <tr><td></td><td>Pipe Cable</td></tr> </tbody> </table> <table border="1"> <thead> <tr> <th colspan="2">Distribution Structures (Electric)</th> </tr> </thead> <tbody> <tr><td></td><td>Pole, Existing Location</td></tr> <tr><td></td><td>Pole Structure, Existing Location - Single</td></tr> <tr><td></td><td>Pole Structure, Existing Location - H</td></tr> <tr><td></td><td>Duct Route</td></tr> <tr><td></td><td>Cross Section Route</td></tr> </tbody> </table>		Legend			Service Cable		LV Mains		2 - 11kV		66kV		11kV		22kV		33kV		66kV		132kV		275kV		400kV		Fibre Optic		Pipe Cable	Distribution Structures (Electric)			Pole, Existing Location		Pole Structure, Existing Location - Single		Pole Structure, Existing Location - H		Duct Route		Cross Section Route	<b>Southern Electric Power Distribution plc</b> Registered Office: No.1 Forbury Place 43 Forbury Road Reading RG1 3JH Registered In England & Wales No.04094290  If you're unsure & need to seek advice before commencing excavations, please contact: General Enquiries: 0800 048 3516  Subject to revision – Master held by SSEN Asset Data Team: <a href="mailto:Asset.Data@sse.com">Asset.Data@sse.com</a> 01256 337 294	
Scale: 1:500 (When plotted at A4)		<p style="font-size: small; text-align: center;"> <b>WARNING</b>          There may have been subsequent alteration to the surface levels. Trial holes must be undertaken to determine position and depths of cables. HS (G) 47 Booklet from the Health and Safety Executive – Avoiding Danger from Buried Cables – should be consulted before commencing excavation work.  <b>WHEN WORKING IN THE VICINITY OF OVERHEAD LINES THE HEALTH AND SAFETY GUIDANCE NOTES G56 SHOULD BE CONSULTED (AVAILABLE FROM THE HSE WEBSITE)</b> </p>		<p style="font-size: x-small; text-align: center;">         BASED UPON THE ORDNANCE SURVEY MAP WITH THE SANCTION OF THE CONTROLLER OF HM STATIONERY OFFICE CROWN COPYRIGHT RESERVED.          This copy has been made by or with the authority of Scottish and Southern Energy Power Distribution Ltd. Pursuant to section 47 of the Copyright, Designs and Patents Act 1988 ("The Act"). Unless the Act provides a relevant exception to copyright the copy must not be copied without prior permission of the copyright owner.          Plans generated by DigSAFE Pro™ software provided by LinesearchbeforeUdig.       </p>	

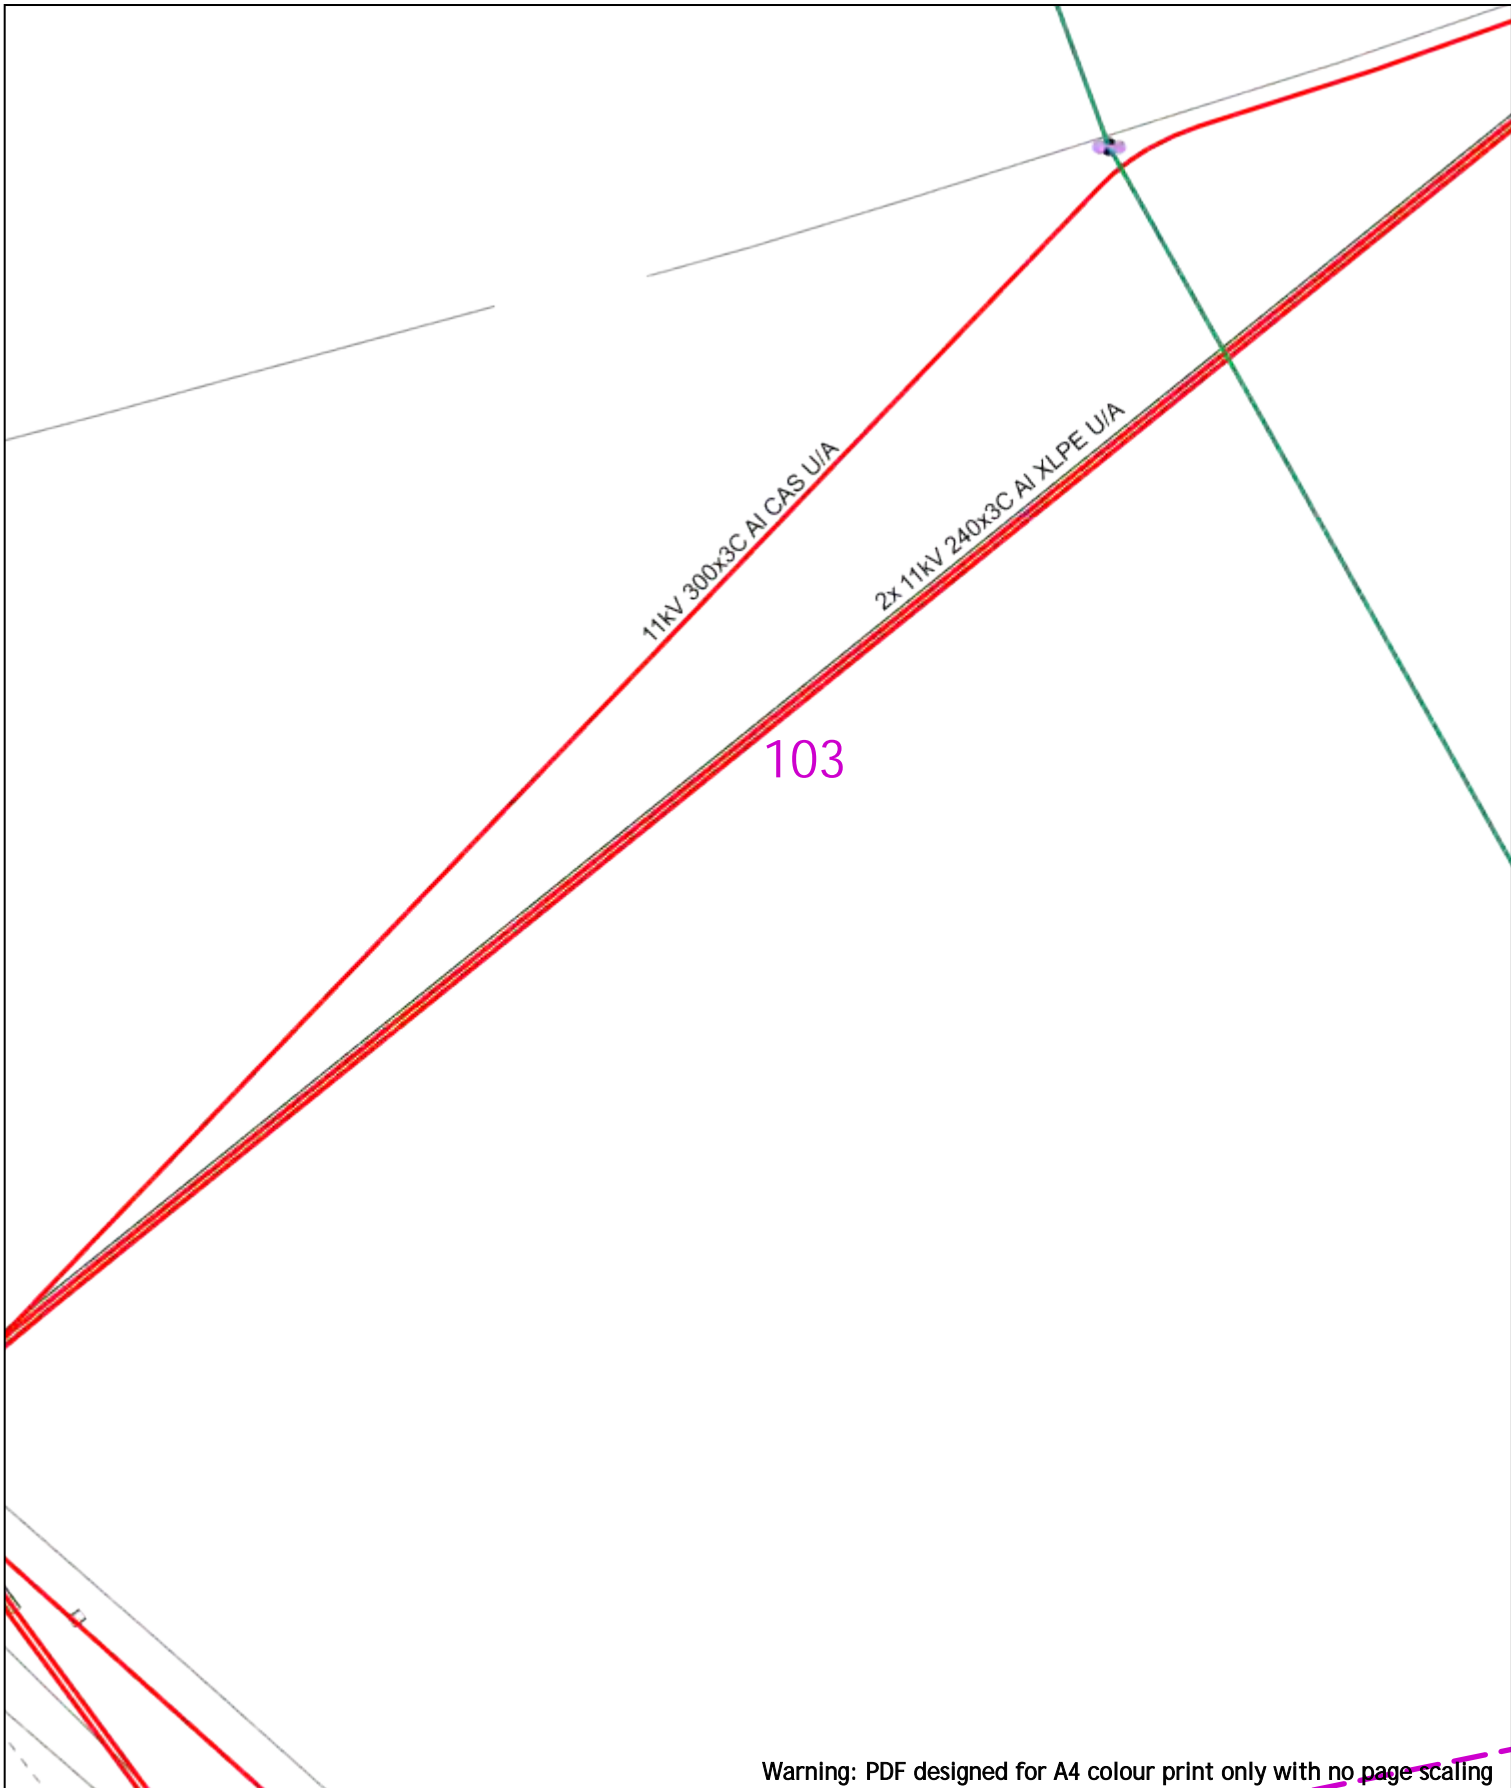

Warning: PDF designed for A4 colour print only with no page scaling

<p>0  20m Dig Sites Area:  Line: </p>	<p><b>Extra High Voltage cables in vicinity</b></p>																																		
<p>Date Requested: 24/06/2022          Job Reference: 25881037          Site Location: 448662 213014          Requested by: Mr Joe Shawyer          Your Scheme/Reference: 31188_003</p>	<p><b>Voltages (V)</b></p> <table border="1"> <tr> <td>LV (Low Voltage) and Services</td> <td colspan="3">Up to 1,000V</td> </tr> <tr> <td>HV (High Voltage)</td> <td colspan="3">Over 1,000V to 11,000V</td> </tr> <tr> <td>EHV (Extra High Voltage)</td> <td colspan="3">22,000V to 132,000V</td> </tr> <tr> <td>Transmission</td> <td colspan="3">275,000V and 400,000V</td> </tr> </table> <p><b>NORMAL DEPTH TO THE TOP OF THE CABLE WHEN LAID</b></p> <table border="1"> <thead> <tr> <th>Services</th> <th>LV</th> <th>HV</th> <th>EHV</th> </tr> </thead> <tbody> <tr> <td>Footpath/Unmade</td> <td>0.45m</td> <td>0.45m</td> <td>0.6m 0.8m</td> </tr> <tr> <td>Road Crossing</td> <td>0.6m</td> <td>0.6m</td> <td>0.75m 0.9m</td> </tr> <tr> <td>Agricultural</td> <td>1m</td> <td>1m</td> <td>1m 1.1m</td> </tr> </tbody> </table>	LV (Low Voltage) and Services	Up to 1,000V			HV (High Voltage)	Over 1,000V to 11,000V			EHV (Extra High Voltage)	22,000V to 132,000V			Transmission	275,000V and 400,000V			Services	LV	HV	EHV	Footpath/Unmade	0.45m	0.45m	0.6m 0.8m	Road Crossing	0.6m	0.6m	0.75m 0.9m	Agricultural	1m	1m	1m 1.1m	<p><b>Legend</b></p> <ul style="list-style-type: none"> <li>Service Cable</li> <li>LV Mains</li> <li>2 - 11kV</li> <li>6.6kV</li> <li>11kV</li> <li>22kV</li> <li>33kV</li> <li>66kV</li> <li>132kV</li> <li>275kV</li> <li>400kV</li> <li>Fibre Optic</li> <li>Pilot Cable</li> </ul> <p><b>Distribution Structures (Electric)</b></p> <ul style="list-style-type: none"> <li>Pole, Existing Location</li> <li>Pole Structure, Existing Location - Single</li> <li>Pole Structure, Existing Location - H</li> <li>Duct Route</li> <li>Cross Section Route</li> </ul> <p><b>WARNING</b></p> <p>There may have been subsequent alteration to the surface levels. Trial holes must be undertaken to determine position and depths of cables. HS (G) 47 Booklet from the Health and Safety Executive - Avoiding Danger from Buried Cables - should be consulted before commencing excavation work.</p> <p><b>WHEN WORKING IN THE VICINITY OF OVERHEAD LINES THE HEALTH AND SAFETY GUIDANCE NOTES G56 SHOULD BE CONSULTED (AVAILABLE FROM THE HSE WEBSITE)</b></p>	<p><b>Southern Electric Power Distribution plc</b>          Registered Office: No.1 Forbury Place          43 Forbury Road Reading RG1 3JH          Registered In England &amp; Wales No.04094290</p> <p>If you're unsure &amp; need to seek advice before commencing excavations, please contact:          General Enquiries: 0800 048 3516</p> <p>Subject to revision - Master held by SSEN Asset Data Team:  <a href="mailto:Asset.Data@sse.com">Asset.Data@sse.com</a>          01256 337 294</p>
LV (Low Voltage) and Services	Up to 1,000V																																		
HV (High Voltage)	Over 1,000V to 11,000V																																		
EHV (Extra High Voltage)	22,000V to 132,000V																																		
Transmission	275,000V and 400,000V																																		
Services	LV	HV	EHV																																
Footpath/Unmade	0.45m	0.45m	0.6m 0.8m																																
Road Crossing	0.6m	0.6m	0.75m 0.9m																																
Agricultural	1m	1m	1m 1.1m																																
<p>Scale: 1:500 (When plotted at A4)</p> <p><small>BASED UPON THE ORDNANCE SURVEY MAP WITH THE SANCTION OF THE CONTROLLER OF HM STATIONERY OFFICE CROWN COPYRIGHT RESERVED.          This copy has been made by or with the authority of Scottish and Southern Energy Power Distribution Ltd. Pursuant to section 47 of the Copyright, Designs and Patents Act 1988 ("The Act"). Unless the Act provides a relevant exception to copyright the copy must not be copied without prior permission of the copyright owner.          Plans generated by DigSAFE Pro™ software provided by LinesearchbeforeUdig.</small></p>																																			

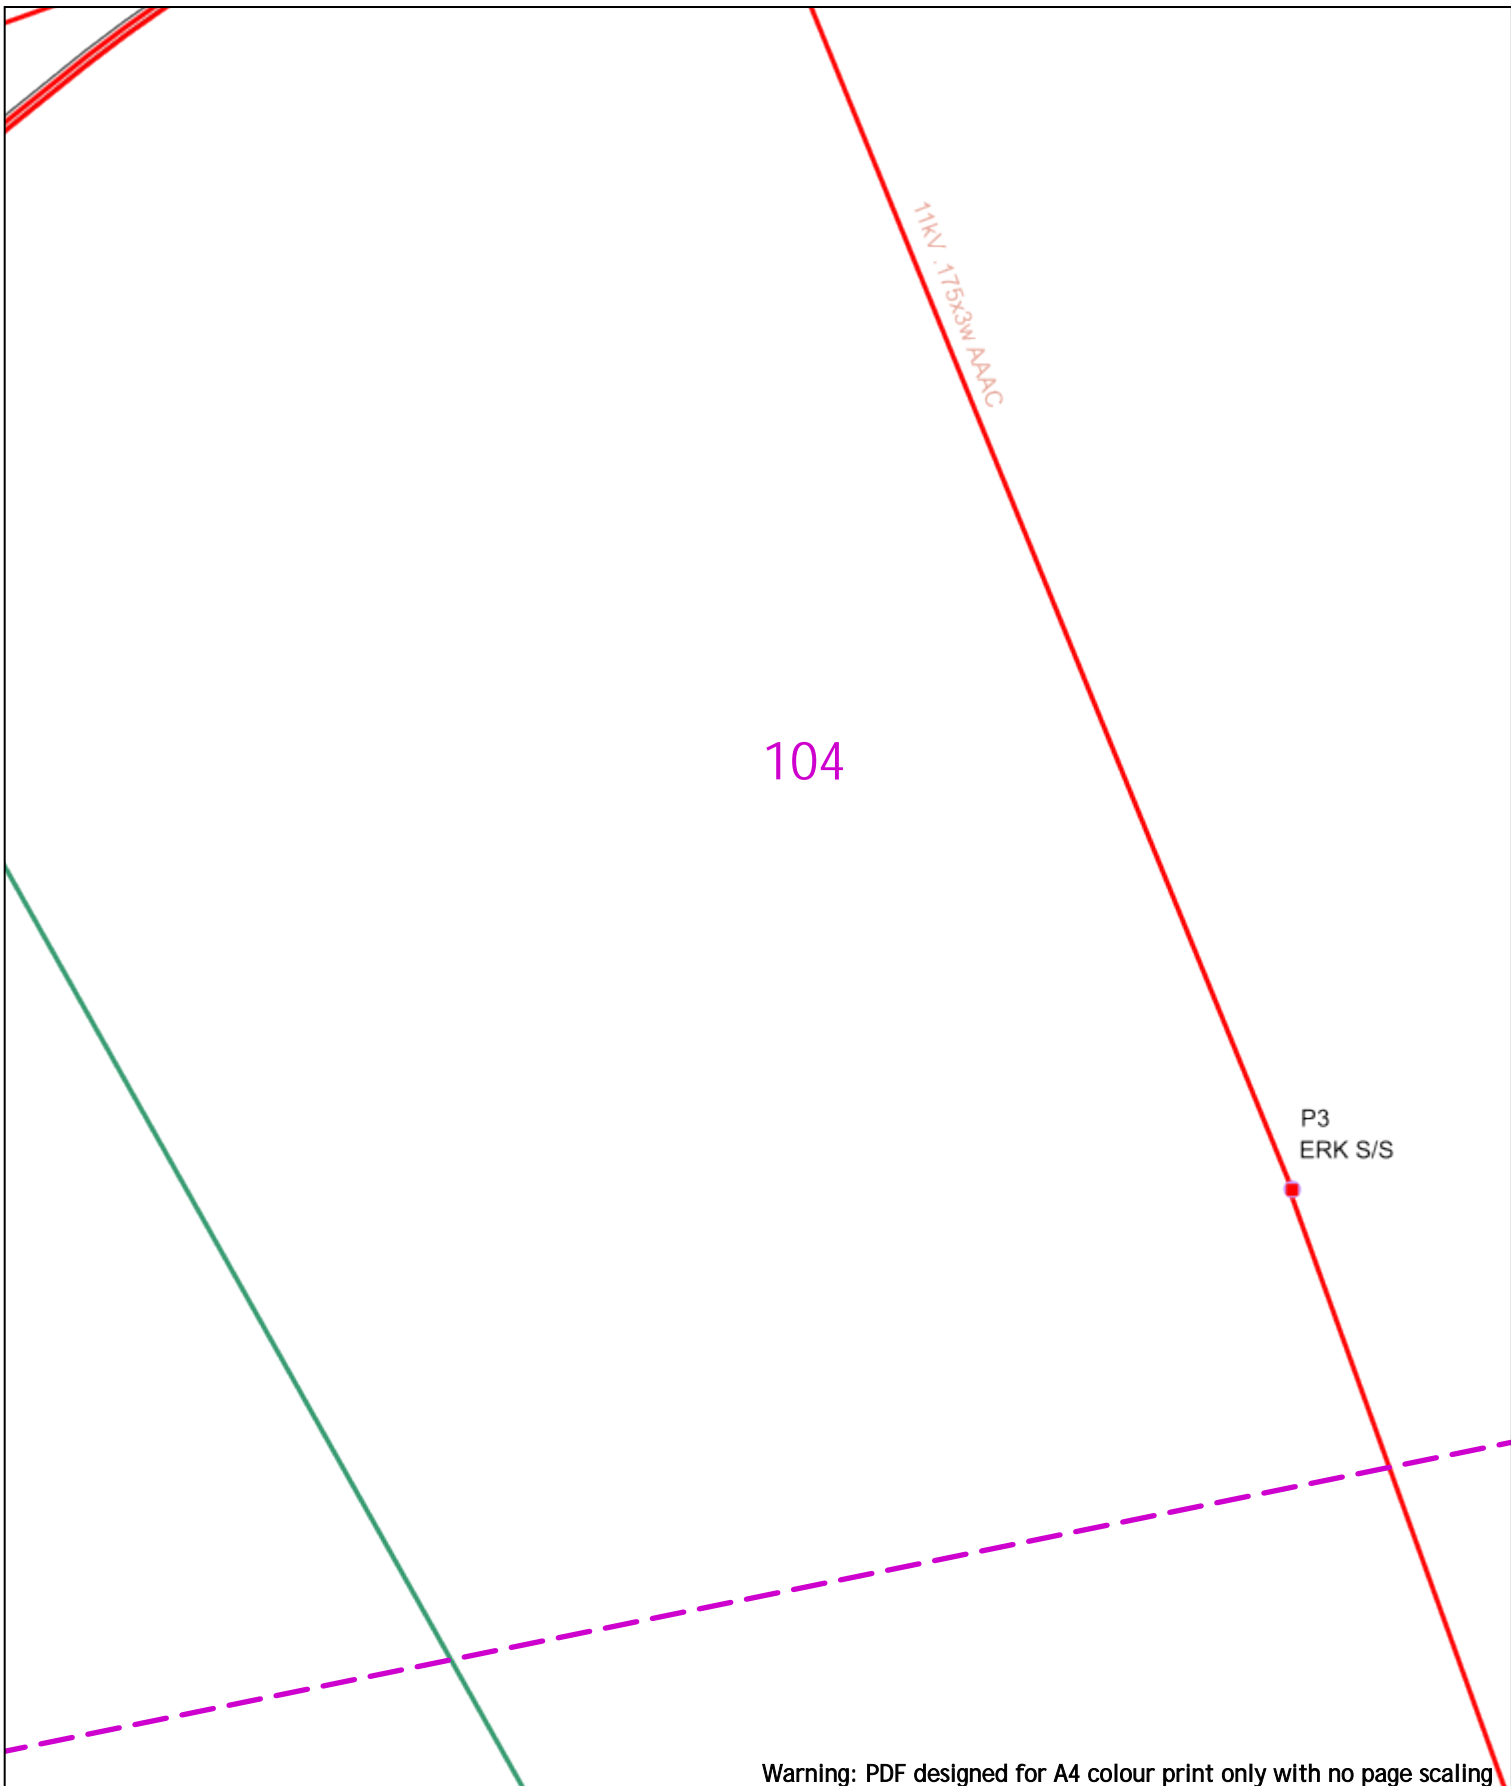

Warning: PDF designed for A4 colour print only with no page scaling



Dig Sites Area: Line:

**Extra High Voltage cables in vicinity**



Date Requested: 24/06/2022  
 Job Reference: 25881037  
 Site Location: 448662 213014  
 Requested by: Mr Joe Shawyer  
 Your Scheme/Reference: 31188\_003

Voltages (V)			
LV (Low Voltage) and Services	Up to 1,000V		
HV (High Voltage)	Over 1,000V to 11,000V		
EHV (Extra High Voltage)	22,000V to 132,000V		
Transmission	275,000V and 400,000V		
NORMAL DEPTH TO THE TOP OF THE CABLE WHEN LAID			
Services	LV	HV	EHV
Footpath/Unmade	0.45m	0.45m	0.6m
Road Crossing	0.6m	0.6m	0.75m
Agricultural	1m	1m	1.1m

Legend	
	Service Cable
	LV Mains
	2 - 8.3kV
	6.6kV
	11kV
	22kV
	33kV
	66kV
	132kV
	275kV
	400kV
	Fibre Optic
	Pipe Cable

Distribution Structures (Electric)	
	Pole, Existing Location
	Pole Structure, Existing Location - Single
	Pole Structure, Existing Location - H
	Duct Route
	Cross Section Route


**Southern Electric Power Distribution plc**  
 Registered Office: No.1 Forbury Place  
 43 Forbury Road Reading RG1 3JH  
 Registered In England & Wales No.04094290

If you're unsure & need to seek advice before commencing excavations, please contact:  
 General Enquiries: 0800 048 3516

Subject to revision - Master held by SSEN Asset Data Team:  
[Asset.Data@sse.com](mailto:Asset.Data@sse.com)  
 01256 337 294

Scale: 1:500 (When plotted at A4)


**WARNING**  
 There may have been subsequent alteration to the surface levels. Trial holes must be undertaken to determine position and depths of cables. HS (G) 47 Booklet from the Health and Safety Executive - Avoiding Danger from Buried Cables - should be consulted before commencing excavation work.  
**WHEN WORKING IN THE VICINITY OF OVERHEAD LINES THE HEALTH AND SAFETY GUIDANCE NOTES G56 SHOULD BE CONSULTED (AVAILABLE FROM THE HSE WEBSITE)**

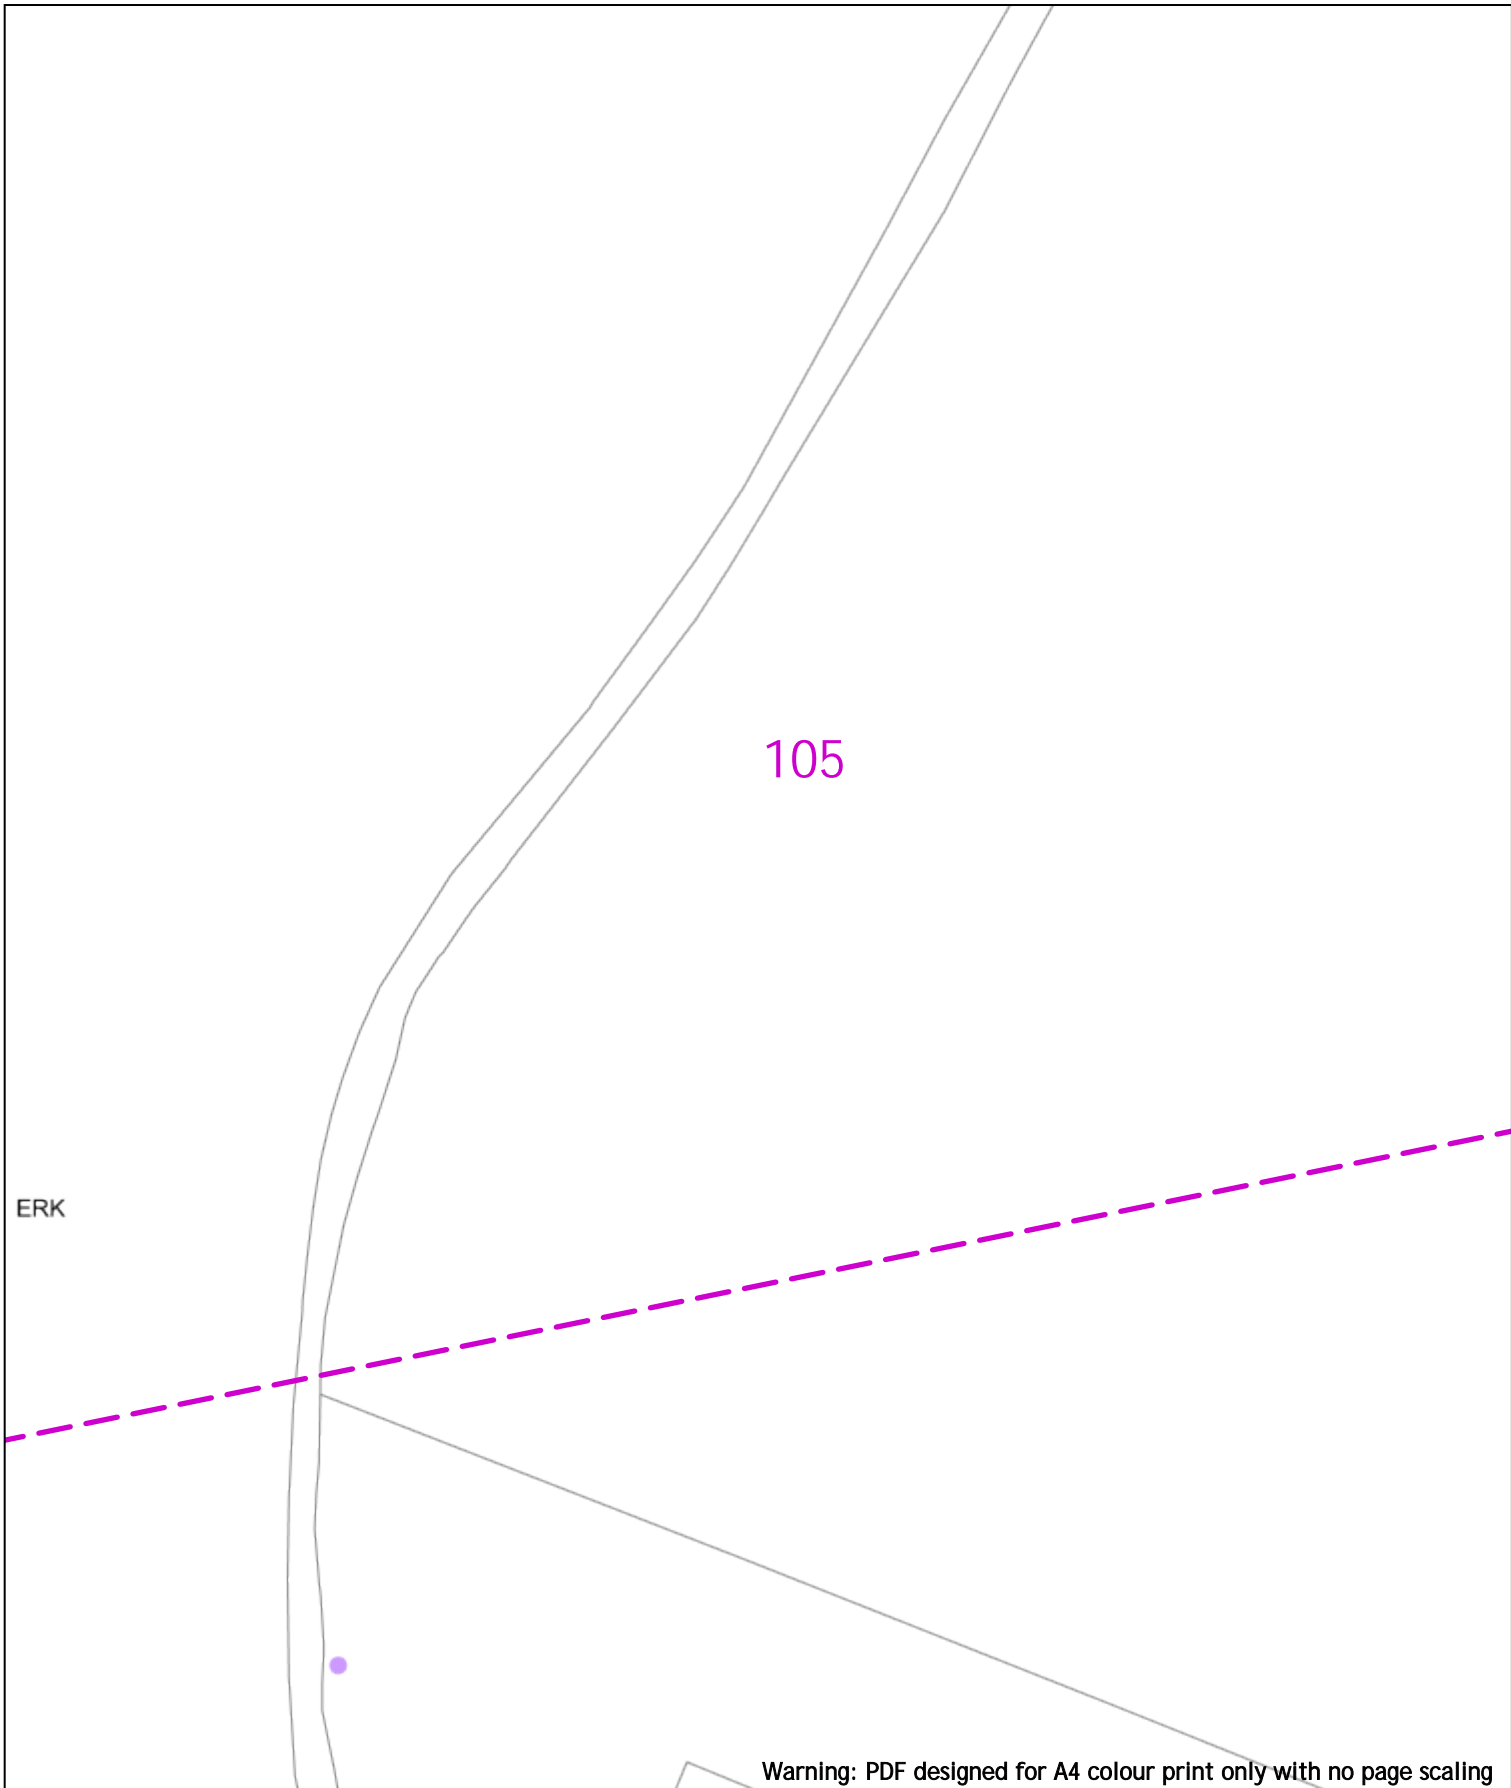

Warning: PDF designed for A4 colour print only with no page scaling


<p>0  20m</p>	<p>Dig Sites  Area:  Line: </p>	<p><b>Extra High Voltage cables in vicinity</b></p>	
<p>Date Requested: 24/06/2022 Job Reference: 25881037 Site Location: 448662 213014 Requested by: Mr Joe Shawyer Your Scheme/Reference: 31188_003</p>	<table border="1" style="width: 100%; border-collapse: collapse;"> <thead> <tr> <th colspan="4">Voltages (V)</th> </tr> </thead> <tbody> <tr> <td>LV (Low Voltage) and Services</td> <td colspan="3">Up to 1,000V</td> </tr> <tr> <td>HV (High Voltage)</td> <td colspan="3">Over 1,000V to 11,000V</td> </tr> <tr> <td>EHV (Extra High Voltage)</td> <td colspan="3">22,000V to 132,000V</td> </tr> <tr> <td>Transmission</td> <td colspan="3">275,000V and 400,000V</td> </tr> </tbody> </table> <table border="1" style="width: 100%; border-collapse: collapse; margin-top: 5px;"> <thead> <tr> <th colspan="5">NORMAL DEPTH TO THE TOP OF THE CABLE WHEN LAID</th> </tr> <tr> <th>Services</th> <th>LV</th> <th>HV</th> <th>EHV</th> <th></th> </tr> </thead> <tbody> <tr> <td>Footpath/Unmade</td> <td>0.45m</td> <td>0.45m</td> <td>0.6m</td> <td>0.8m</td> </tr> <tr> <td>Road Crossing</td> <td>0.6m</td> <td>0.6m</td> <td>0.75m</td> <td>0.9m</td> </tr> <tr> <td>Agricultural</td> <td>1m</td> <td>1m</td> <td>1m</td> <td>1.1m</td> </tr> </tbody> </table>	Voltages (V)				LV (Low Voltage) and Services	Up to 1,000V			HV (High Voltage)	Over 1,000V to 11,000V			EHV (Extra High Voltage)	22,000V to 132,000V			Transmission	275,000V and 400,000V			NORMAL DEPTH TO THE TOP OF THE CABLE WHEN LAID					Services	LV	HV	EHV		Footpath/Unmade	0.45m	0.45m	0.6m	0.8m	Road Crossing	0.6m	0.6m	0.75m	0.9m	Agricultural	1m	1m	1m	1.1m	<table border="1" style="width: 100%; border-collapse: collapse;"> <thead> <tr> <th colspan="2">Legend</th> </tr> </thead> <tbody> <tr><td></td><td>Service Cable</td></tr> <tr><td></td><td>LV Mains</td></tr> <tr><td></td><td>2 - 11kV</td></tr> <tr><td></td><td>66kV</td></tr> <tr><td></td><td>11kV</td></tr> <tr><td></td><td>22kV</td></tr> <tr><td></td><td>33kV</td></tr> <tr><td></td><td>66kV</td></tr> <tr><td></td><td>132kV</td></tr> <tr><td></td><td>275kV</td></tr> <tr><td></td><td>400kV</td></tr> <tr><td></td><td>Fibre Optic</td></tr> <tr><td></td><td>Pilot Cable</td></tr> </tbody> </table> <table border="1" style="width: 100%; border-collapse: collapse; margin-top: 5px;"> <thead> <tr> <th colspan="2">Distribution Structures (Electric)</th> </tr> </thead> <tbody> <tr><td></td><td>Pole, Existing Location</td></tr> <tr><td></td><td>Pole Structure, Existing Location - Single</td></tr> <tr><td></td><td>Pole Structure, Existing Location - H</td></tr> <tr><td></td><td>Duct Route</td></tr> <tr><td></td><td>Cross Section Route</td></tr> </tbody> </table>	Legend			Service Cable		LV Mains		2 - 11kV		66kV		11kV		22kV		33kV		66kV		132kV		275kV		400kV		Fibre Optic		Pilot Cable	Distribution Structures (Electric)			Pole, Existing Location		Pole Structure, Existing Location - Single		Pole Structure, Existing Location - H		Duct Route		Cross Section Route	<p><b>Southern Electric Power Distribution plc</b> Registered Office: No.1 Forbury Place 43 Forbury Road Reading RG1 3JH Registered In England &amp; Wales No.04094290</p> <p>If you're unsure &amp; need to seek advice before commencing excavations, please contact: General Enquiries: 0800 048 3516</p> <p>Subject to revision – Master held by SSEN Asset Data Team: <a href="mailto:Asset.Data@sse.com">Asset.Data@sse.com</a> 01256 337 294</p>
Voltages (V)	
LV (Low Voltage) and Services	Up to 1,000V	
HV (High Voltage)	Over 1,000V to 11,000V	
EHV (Extra High Voltage)	22,000V to 132,000V	
Transmission	275,000V and 400,000V	
NORMAL DEPTH TO THE TOP OF THE CABLE WHEN LAID	
Services	LV	HV	EHV	
Footpath/Unmade	0.45m	0.45m	0.6m	0.8m	
Road Crossing	0.6m	0.6m	0.75m	0.9m	
Agricultural	1m	1m	1m	1.1m	
Legend	
	Service Cable	
	LV Mains	
	2 - 11kV	
	66kV	
	11kV	
	22kV	
	33kV	
	66kV	
	132kV	
	275kV	
	400kV	
	Fibre Optic	
	Pilot Cable	
Distribution Structures (Electric)	
	Pole, Existing Location	
	Pole Structure, Existing Location - Single	
	Pole Structure, Existing Location - H	
	Duct Route	
	Cross Section Route	
<p>Scale: 1:500 (When plotted at A4)</p>		<p><b>WARNING</b> There may have been subsequent alteration to the surface levels. Trial holes must be undertaken to determine position and depths of cables. HS (G) 47 Booklet from the Health and Safety Executive – Avoiding Danger from Buried Cables – should be consulted before commencing excavation work. WHEN WORKING IN THE VICINITY OF OVERHEAD LINES THE HEALTH AND SAFETY GUIDANCE NOTES G56 SHOULD BE CONSULTED (AVAILABLE FROM THE HSE WEBSITE)</p>	



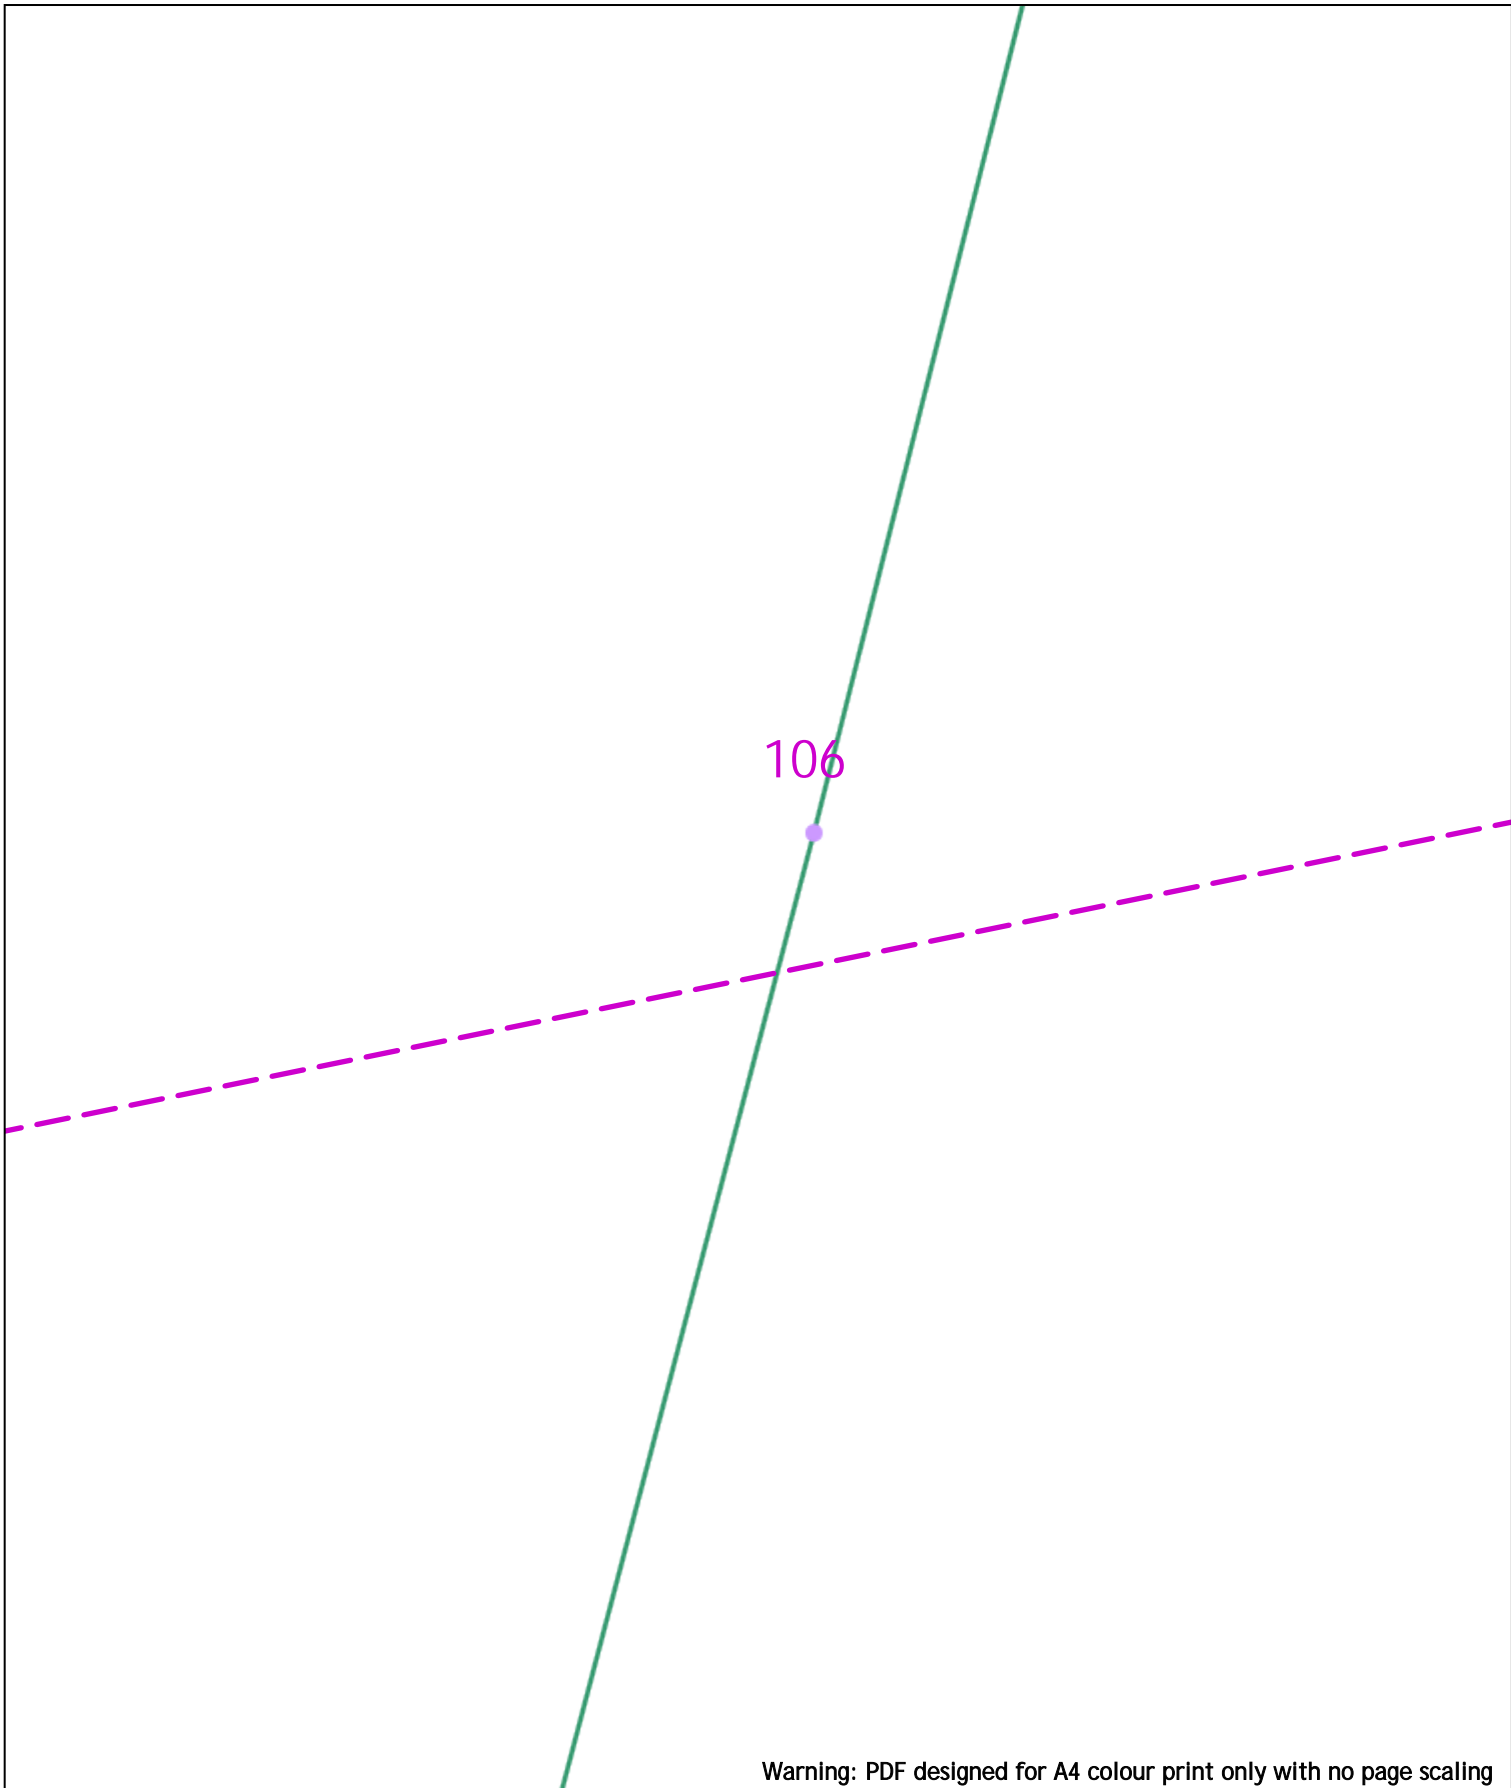


Warning: PDF designed for A4 colour print only with no page scaling

	Dig Sites Area:  Line:	<b>Extra High Voltage cables in vicinity</b>	
Date Requested: 24/06/2022 Job Reference: 25881037 Site Location: 448662 213014 Requested by: Mr Joe Shawyer Your Scheme/Reference: 31188_003	<table border="1"> <thead> <tr> <th colspan="5">Voltages (V)</th> </tr> </thead> <tbody> <tr> <td>LV (Low Voltage) and Services</td> <td colspan="4">Up to 1,000V</td> </tr> <tr> <td>HV (High Voltage)</td> <td colspan="4">Over 1,000V to 11,000V</td> </tr> <tr> <td>EHV (Extra High Voltage)</td> <td colspan="4">22,000V to 132,000V</td> </tr> <tr> <td>Transmission</td> <td colspan="4">275,000V and 400,000V</td> </tr> </tbody> </table> <table border="1"> <thead> <tr> <th colspan="5">NORMAL DEPTH TO THE TOP OF THE CABLE WHEN LAID</th> </tr> <tr> <th>Services</th> <th>LV</th> <th>HV</th> <th>EHV</th> <th></th> </tr> </thead> <tbody> <tr> <td>Footpath/Unmade</td> <td>0.45m</td> <td>0.45m</td> <td>0.6m</td> <td>0.8m</td> </tr> <tr> <td>Road Crossing</td> <td>0.6m</td> <td>0.6m</td> <td>0.75m</td> <td>0.9m</td> </tr> <tr> <td>Agricultural</td> <td>1m</td> <td>1m</td> <td>1m</td> <td>1.1m</td> </tr> </tbody> </table>	Voltages (V)					LV (Low Voltage) and Services	Up to 1,000V				HV (High Voltage)	Over 1,000V to 11,000V				EHV (Extra High Voltage)	22,000V to 132,000V				Transmission	275,000V and 400,000V				NORMAL DEPTH TO THE TOP OF THE CABLE WHEN LAID					Services	LV	HV	EHV		Footpath/Unmade	0.45m	0.45m	0.6m	0.8m	Road Crossing	0.6m	0.6m	0.75m	0.9m	Agricultural	1m	1m	1m	1.1m	<table border="1"> <thead> <tr> <th colspan="2">Legend</th> <th colspan="2">Distribution Structures (Electric)</th> </tr> </thead> <tbody> <tr> <td></td> <td>Service Cable</td> <td></td> <td>Pole, Existing Location</td> </tr> <tr> <td></td> <td>LV Mains</td> <td></td> <td>Pole Structure, Existing Location - Single</td> </tr> <tr> <td></td> <td>2 - 11kV</td> <td></td> <td>Pole Structure, Existing Location - H</td> </tr> <tr> <td></td> <td>66kV</td> <td></td> <td>Duct Route</td> </tr> <tr> <td></td> <td>11kV</td> <td></td> <td>Cross Section Route</td> </tr> <tr> <td></td> <td>22kV</td> <td></td> <td></td> </tr> <tr> <td></td> <td>33kV</td> <td></td> <td></td> </tr> <tr> <td></td> <td>66kV</td> <td></td> <td></td> </tr> <tr> <td></td> <td>132kV</td> <td></td> <td></td> </tr> <tr> <td></td> <td>275kV</td> <td></td> <td></td> </tr> <tr> <td></td> <td>400kV</td> <td></td> <td></td> </tr> <tr> <td></td> <td>Fibre Optic</td> <td></td> <td></td> </tr> <tr> <td></td> <td>Pilot Cable</td> <td></td> <td></td> </tr> </tbody> </table> <p><b>WARNING</b>          There may have been subsequent alteration to the surface levels. Trial holes must be undertaken to determine position and depths of cables. HS (G) 47 Booklet from the Health and Safety Executive - Avoiding Danger from Buried Cables - should be consulted before commencing excavation work.  <b>WHEN WORKING IN THE VICINITY OF OVERHEAD LINES THE HEALTH AND SAFETY GUIDANCE NOTES G66 SHOULD BE CONSULTED (AVAILABLE FROM THE HSE WEBSITE)</b></p>	Legend		Distribution Structures (Electric)			Service Cable		Pole, Existing Location		LV Mains		Pole Structure, Existing Location - Single		2 - 11kV		Pole Structure, Existing Location - H		66kV		Duct Route		11kV		Cross Section Route		22kV				33kV				66kV				132kV				275kV				400kV				Fibre Optic				Pilot Cable			<p style="text-align: center;"><b>Southern Electric Power Distribution plc</b>          Registered Office: No.1 Forbury Place          43 Forbury Road Reading RG1 3JH          Registered In England &amp; Wales No.04094290</p> <p>If you're unsure &amp; need to seek advice before commencing excavations, please contact:          General Enquiries: 0800 048 3516</p> <p>Subject to revision - Master held by SSEN Asset Data Team:  <a href="mailto:Asset.Data@sse.com">Asset.Data@sse.com</a>          01256 337 294</p>
Voltages (V)	
LV (Low Voltage) and Services	Up to 1,000V	
HV (High Voltage)	Over 1,000V to 11,000V	
EHV (Extra High Voltage)	22,000V to 132,000V	
Transmission	275,000V and 400,000V	
NORMAL DEPTH TO THE TOP OF THE CABLE WHEN LAID	
Services	LV	HV	EHV	
Footpath/Unmade	0.45m	0.45m	0.6m	0.8m	
Road Crossing	0.6m	0.6m	0.75m	0.9m	
Agricultural	1m	1m	1m	1.1m	
Legend		Distribution Structures (Electric)	
	Service Cable		Pole, Existing Location	
	LV Mains		Pole Structure, Existing Location - Single	
	2 - 11kV		Pole Structure, Existing Location - H	
	66kV		Duct Route	
	11kV		Cross Section Route	
	22kV	
	33kV	
	66kV	
	132kV	
	275kV	
	400kV	
	Fibre Optic	
	Pilot Cable	
<p style="font-size: small;">Scale: 1:500 (When plotted at A4)</p> <p style="font-size: x-small; text-align: center;">BASED UPON THE ORDNANCE SURVEY MAP WITH THE SANCTION OF THE CONTROLLER OF HM STATIONERY OFFICE CROWN COPYRIGHT RESERVED.          This copy has been made by or with the authority of Scottish and Southern Energy Power Distribution Ltd. Pursuant to section 47 of the Copyright, Designs and Patents Act 1988 ("The Act"). Unless the Act provides a relevant exception to copyright the copy must not be copied without prior permission of the copyright owner.          Plans generated by DigSAFE Pro™ software provided by LinesearchbeforeDig.</p>	

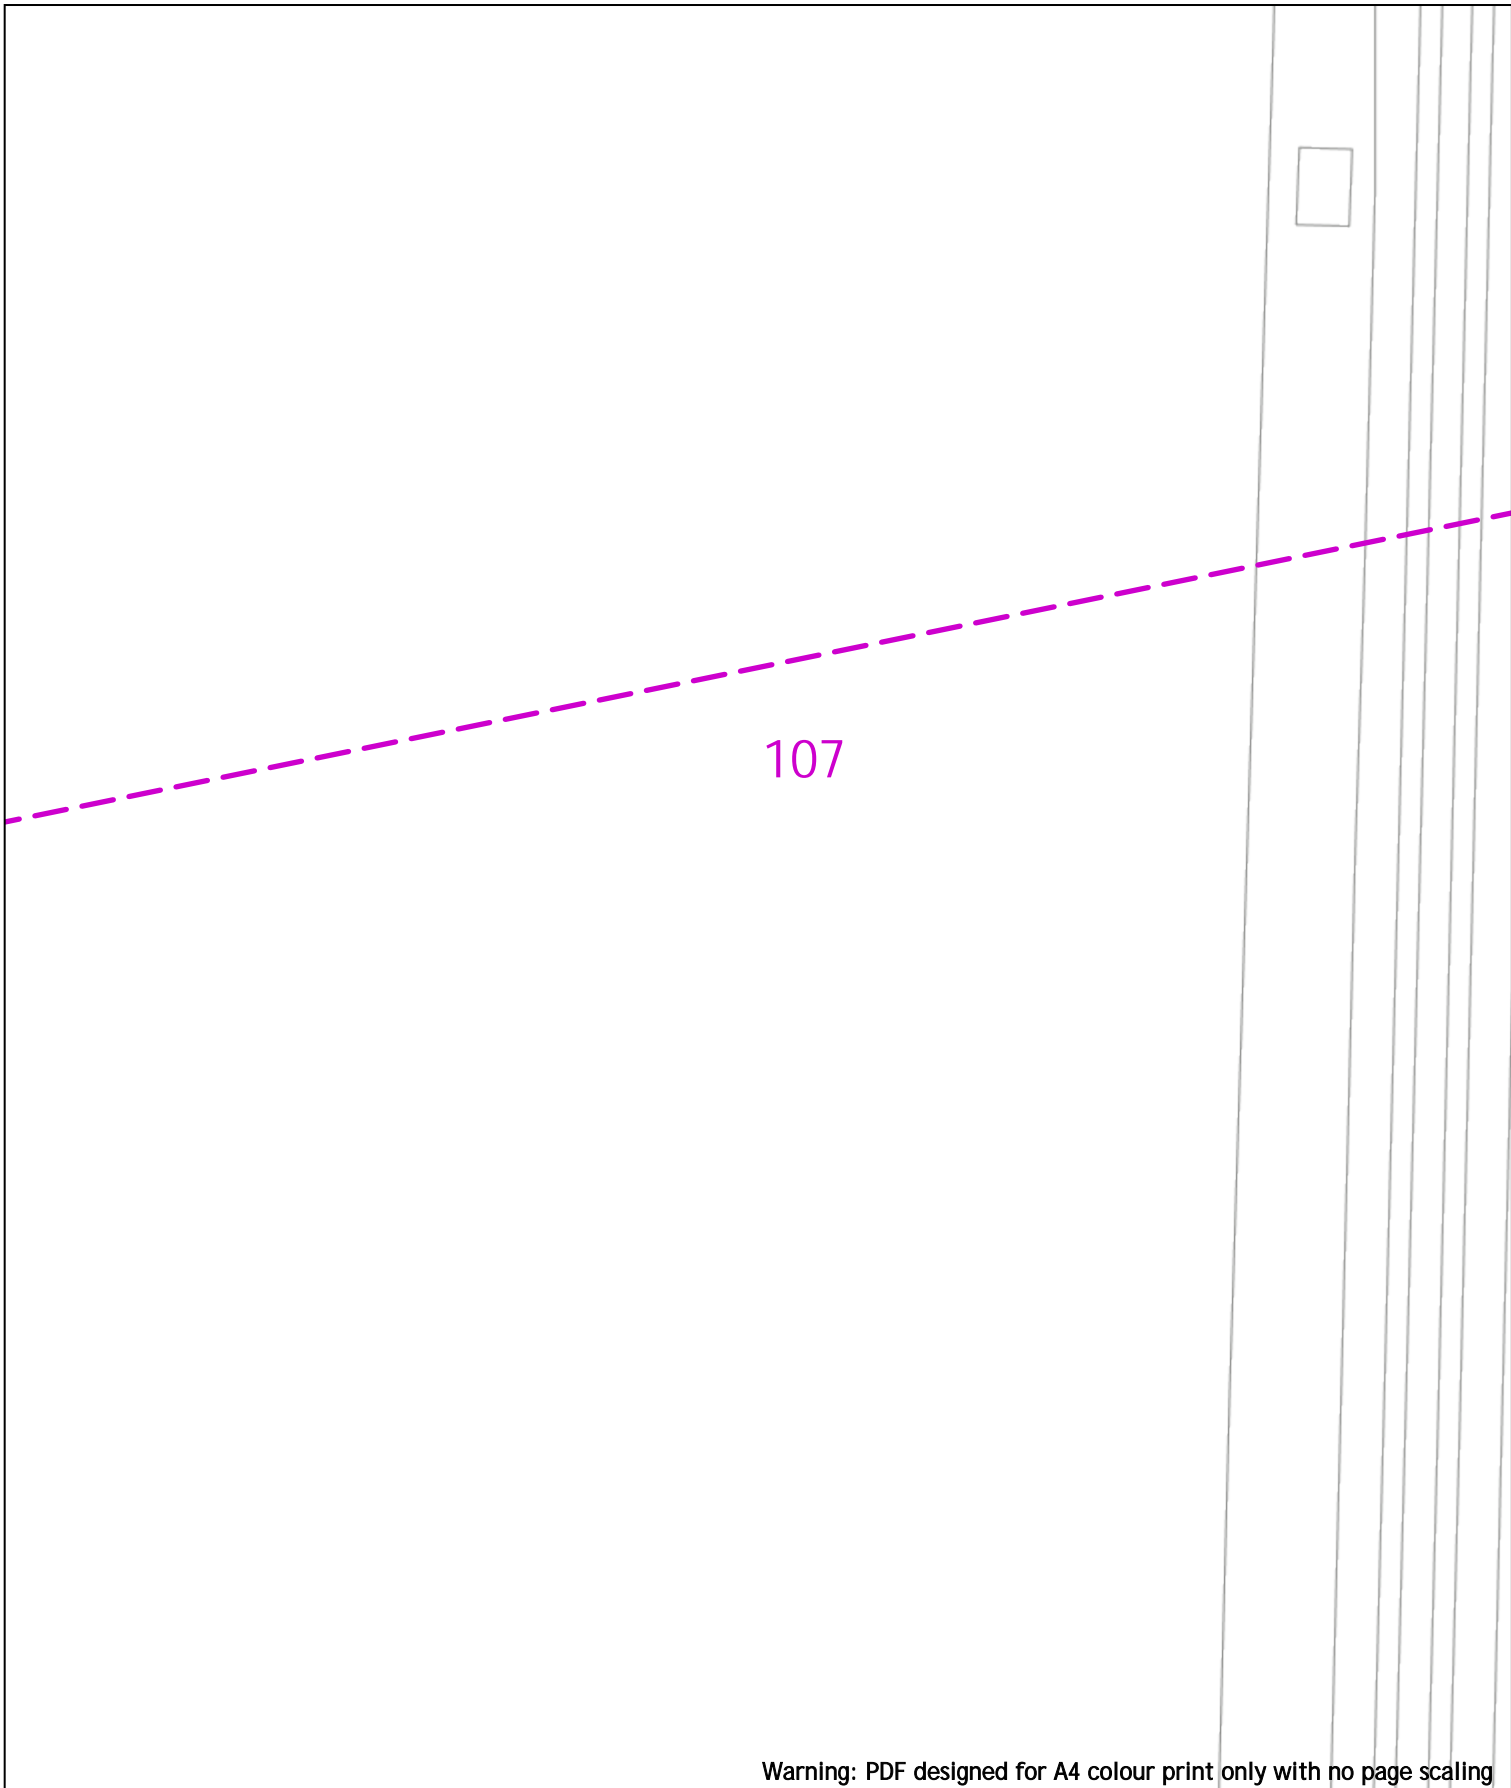


Warning: PDF designed for A4 colour print only with no page scaling

<p>0  20m</p> <p>Date Requested: 24/06/2022          Job Reference: 25881037          Site Location: 448662 213014          Requested by: Mr Joe Shawyer          Your Scheme/Reference: 31188_003</p>	<p>Dig Sites Area:  Line: </p> <p style="text-align: center; background-color: red; color: white; padding: 5px;"><b>Extra High Voltage cables in vicinity</b></p>	
<p>Scale: 1:500 (When plotted at A4)</p>	<table border="1" style="width: 100%; border-collapse: collapse;"> <thead> <tr> <th colspan="4">Voltages (V)</th> </tr> </thead> <tbody> <tr> <td>LV (Low Voltage) and Services</td> <td colspan="3">Up to 1,000V</td> </tr> <tr> <td>HV (High Voltage)</td> <td colspan="3">Over 1,000V to 11,000V</td> </tr> <tr> <td>EHV (Extra High Voltage)</td> <td colspan="3">22,000V to 132,000V</td> </tr> <tr> <td>Transmission</td> <td colspan="3">275,000V and 400,000V</td> </tr> </tbody> </table> <table border="1" style="width: 100%; border-collapse: collapse; margin-top: 5px;"> <thead> <tr> <th colspan="5">NORMAL DEPTH TO THE TOP OF THE CABLE WHEN LAID</th> </tr> <tr> <th>Services</th> <th>LV</th> <th>HV</th> <th>EHV</th> <th></th> </tr> </thead> <tbody> <tr> <td>Footpath/Unmade</td> <td>0.45m</td> <td>0.45m</td> <td>0.6m</td> <td>0.8m</td> </tr> <tr> <td>Road Crossing</td> <td>0.6m</td> <td>0.6m</td> <td>0.75m</td> <td>0.9m</td> </tr> <tr> <td>Agricultural</td> <td>1m</td> <td>1m</td> <td>1m</td> <td>1.1m</td> </tr> </tbody> </table> <p style="font-size: small; color: red; margin-top: 5px;"><b>WARNING</b>          There may have been subsequent alteration to the surface levels. Trial holes must be undertaken to determine position and depths of cables. HS (G) 47 Booklet from the Health and Safety Executive – Avoiding Danger from Buried Cables – should be consulted before commencing excavation work.  <b>WHEN WORKING IN THE VICINITY OF OVERHEAD LINES THE HEALTH AND SAFETY GUIDANCE NOTES G56 SHOULD BE CONSULTED (AVAILABLE FROM THE HSE WEBSITE)</b></p>	Voltages (V)				LV (Low Voltage) and Services	Up to 1,000V			HV (High Voltage)	Over 1,000V to 11,000V			EHV (Extra High Voltage)	22,000V to 132,000V			Transmission	275,000V and 400,000V			NORMAL DEPTH TO THE TOP OF THE CABLE WHEN LAID					Services	LV	HV	EHV		Footpath/Unmade	0.45m	0.45m	0.6m	0.8m	Road Crossing	0.6m	0.6m	0.75m	0.9m	Agricultural	1m	1m	1m	1.1m	<p style="text-align: center;"><b>Southern Electric Power Distribution plc</b>          Registered Office: No.1 Forbury Place          43 Forbury Road Reading RG1 3JH          Registered In England &amp; Wales No.04094290</p> <p style="font-size: small; margin-top: 10px;">If you're unsure &amp; need to seek advice before commencing excavations, please contact:          General Enquiries: 0800 048 3516</p> <p style="font-size: small; margin-top: 10px;">Subject to revision – Master held by SSEN Asset Data Team:  <a href="mailto:Asset.Data@sse.com">Asset.Data@sse.com</a>          01256 337 294</p>
Voltages (V)	
LV (Low Voltage) and Services	Up to 1,000V	
HV (High Voltage)	Over 1,000V to 11,000V	
EHV (Extra High Voltage)	22,000V to 132,000V	
Transmission	275,000V and 400,000V	
NORMAL DEPTH TO THE TOP OF THE CABLE WHEN LAID	
Services	LV	HV	EHV	
Footpath/Unmade	0.45m	0.45m	0.6m	0.8m	
Road Crossing	0.6m	0.6m	0.75m	0.9m	
Agricultural	1m	1m	1m	1.1m	

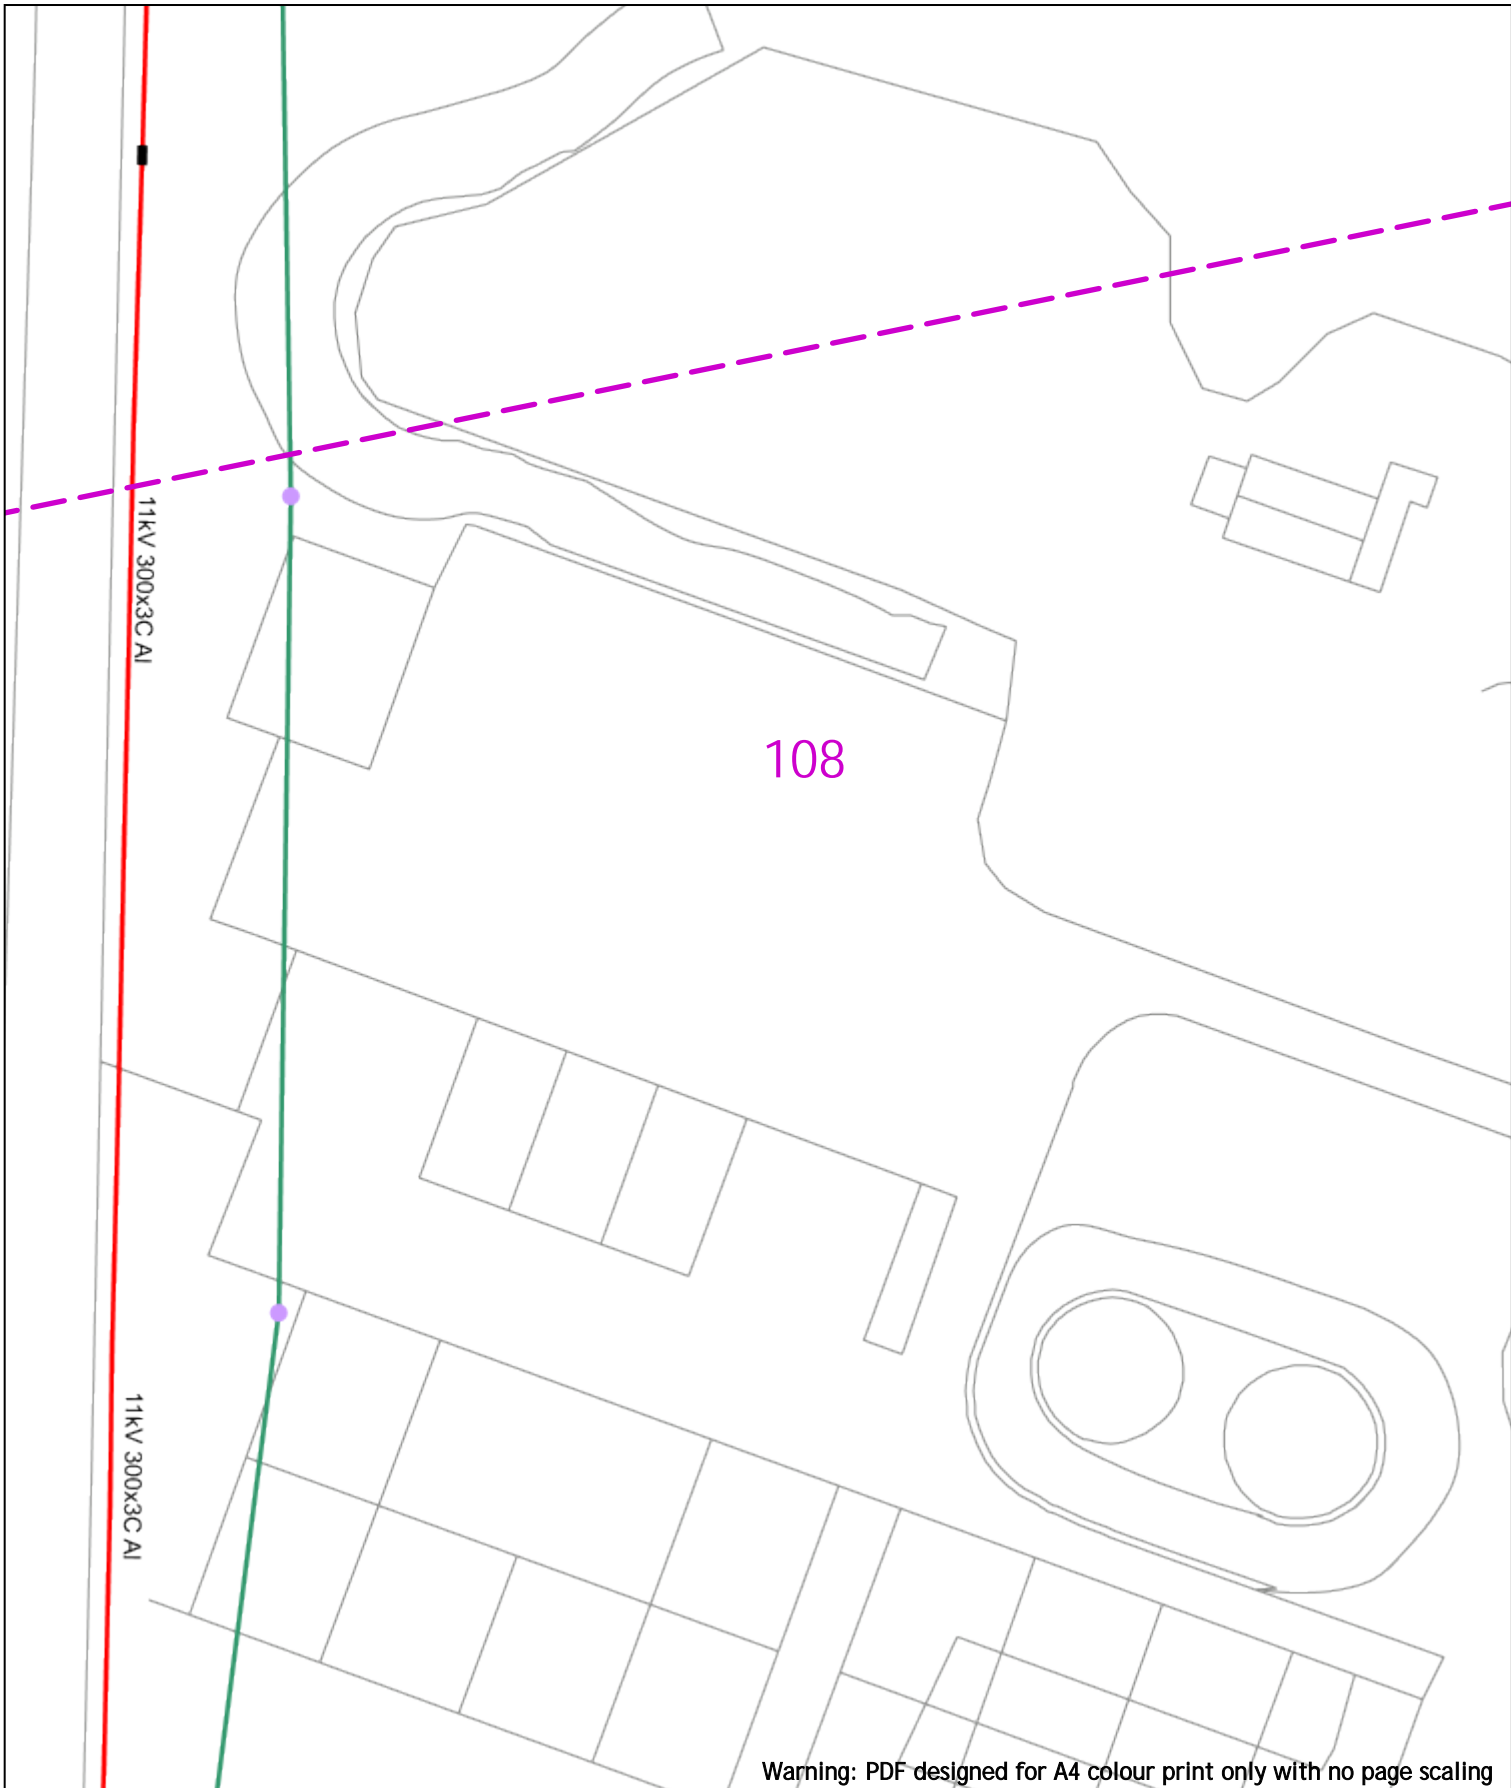


Warning: PDF designed for A4 colour print only with no page scaling

<p>0  20m</p> <p>Date Requested: 24/06/2022          Job Reference: 25881037          Site Location: 448662 213014          Requested by: Mr Joe Shawyer          Your Scheme/Reference: 31188_003</p>	<p>Dig Sites Area:  Line: </p> <p style="text-align: center; background-color: red; color: white; padding: 2px;"><b>Extra High Voltage cables in vicinity</b></p>	<p> </p> <p style="text-align: center;"><b>Southern Electric Power Distribution plc</b>          Registered Office: No.1 Forbury Place          43 Forbury Road Reading RG1 3JH          Registered In England &amp; Wales No.04094290</p> <p style="font-size: small;">If you're unsure &amp; need to seek advice before commencing excavations, please contact:          General Enquiries: 0800 048 3516</p> <p style="font-size: small;">Subject to revision – Master held by SSEN Asset Data Team:  <a href="mailto:Asset.Data@sse.com">Asset.Data@sse.com</a>          01256 337 294</p>																															
<p><b>Voltagess (V)</b></p> <table border="1" style="width: 100%; border-collapse: collapse; font-size: x-small;"> <tr> <td>LV (Low Voltage) and Services</td> <td colspan="3">Up to 1,000V</td> </tr> <tr> <td>HV (High Voltage)</td> <td colspan="3">Over 1,000V to 11,000V</td> </tr> <tr> <td>EHV (Extra High Voltage)</td> <td colspan="3">22,000V to 132,000V</td> </tr> <tr> <td>Transmission</td> <td colspan="3">275,000V and 400,000V</td> </tr> </table> <p><b>NORMAL DEPTH TO THE TOP OF THE CABLE WHEN LAID</b></p> <table border="1" style="width: 100%; border-collapse: collapse; font-size: x-small;"> <thead> <tr> <th>Services</th> <th>LV</th> <th>HV</th> <th>EHV</th> </tr> </thead> <tbody> <tr> <td>Footpath/Unmade</td> <td>0.45m</td> <td>0.45m</td> <td>0.6m</td> </tr> <tr> <td>Road Crossing</td> <td>0.6m</td> <td>0.6m</td> <td>0.75m</td> </tr> <tr> <td>Agricultural</td> <td>1m</td> <td>1m</td> <td>1.1m</td> </tr> </tbody> </table>	LV (Low Voltage) and Services	Up to 1,000V			HV (High Voltage)	Over 1,000V to 11,000V			EHV (Extra High Voltage)	22,000V to 132,000V			Transmission	275,000V and 400,000V			Services	LV	HV	EHV	Footpath/Unmade	0.45m	0.45m	0.6m	Road Crossing	0.6m	0.6m	0.75m	Agricultural	1m	1m	1.1m	<p><b>Legend</b></p> <ul style="list-style-type: none"> <li> Service Cable</li> <li> LV Mains</li> <li> 6.6kV</li> <li> 11kV</li> <li> 22kV</li> <li> 33kV</li> <li> 66kV</li> <li> 132kV</li> <li> 275kV</li> <li> 400kV</li> <li> Fibre Optic</li> <li> Pipit Cable</li> </ul> <p><b>Distribution Structures (Electric)</b></p> <ul style="list-style-type: none"> <li> Pole, Existing Location</li> <li> Pole Structure, Existing Location - Single</li> <li> Pole Structure, Existing Location - H</li> <li> Duct Route</li> <li> Cross Section Route</li> </ul>
LV (Low Voltage) and Services	Up to 1,000V																																
HV (High Voltage)	Over 1,000V to 11,000V																																
EHV (Extra High Voltage)	22,000V to 132,000V																																
Transmission	275,000V and 400,000V																																
Services	LV	HV	EHV																														
Footpath/Unmade	0.45m	0.45m	0.6m																														
Road Crossing	0.6m	0.6m	0.75m																														
Agricultural	1m	1m	1.1m																														
<p><b>WARNING</b></p> <p>There may have been subsequent alteration to the surface levels. Trial holes must be undertaken to determine position and depths of cables. HS (G) 47 Booklet from the Health and Safety Executive – Avoiding Danger from Buried Cables – should be consulted before commencing excavation work.</p> <p><b>WHEN WORKING IN THE VICINITY OF OVERHEAD LINES THE HEALTH AND SAFETY GUIDANCE NOTES G66 SHOULD BE CONSULTED (AVAILABLE FROM THE HSE WEBSITE)</b></p>																																	

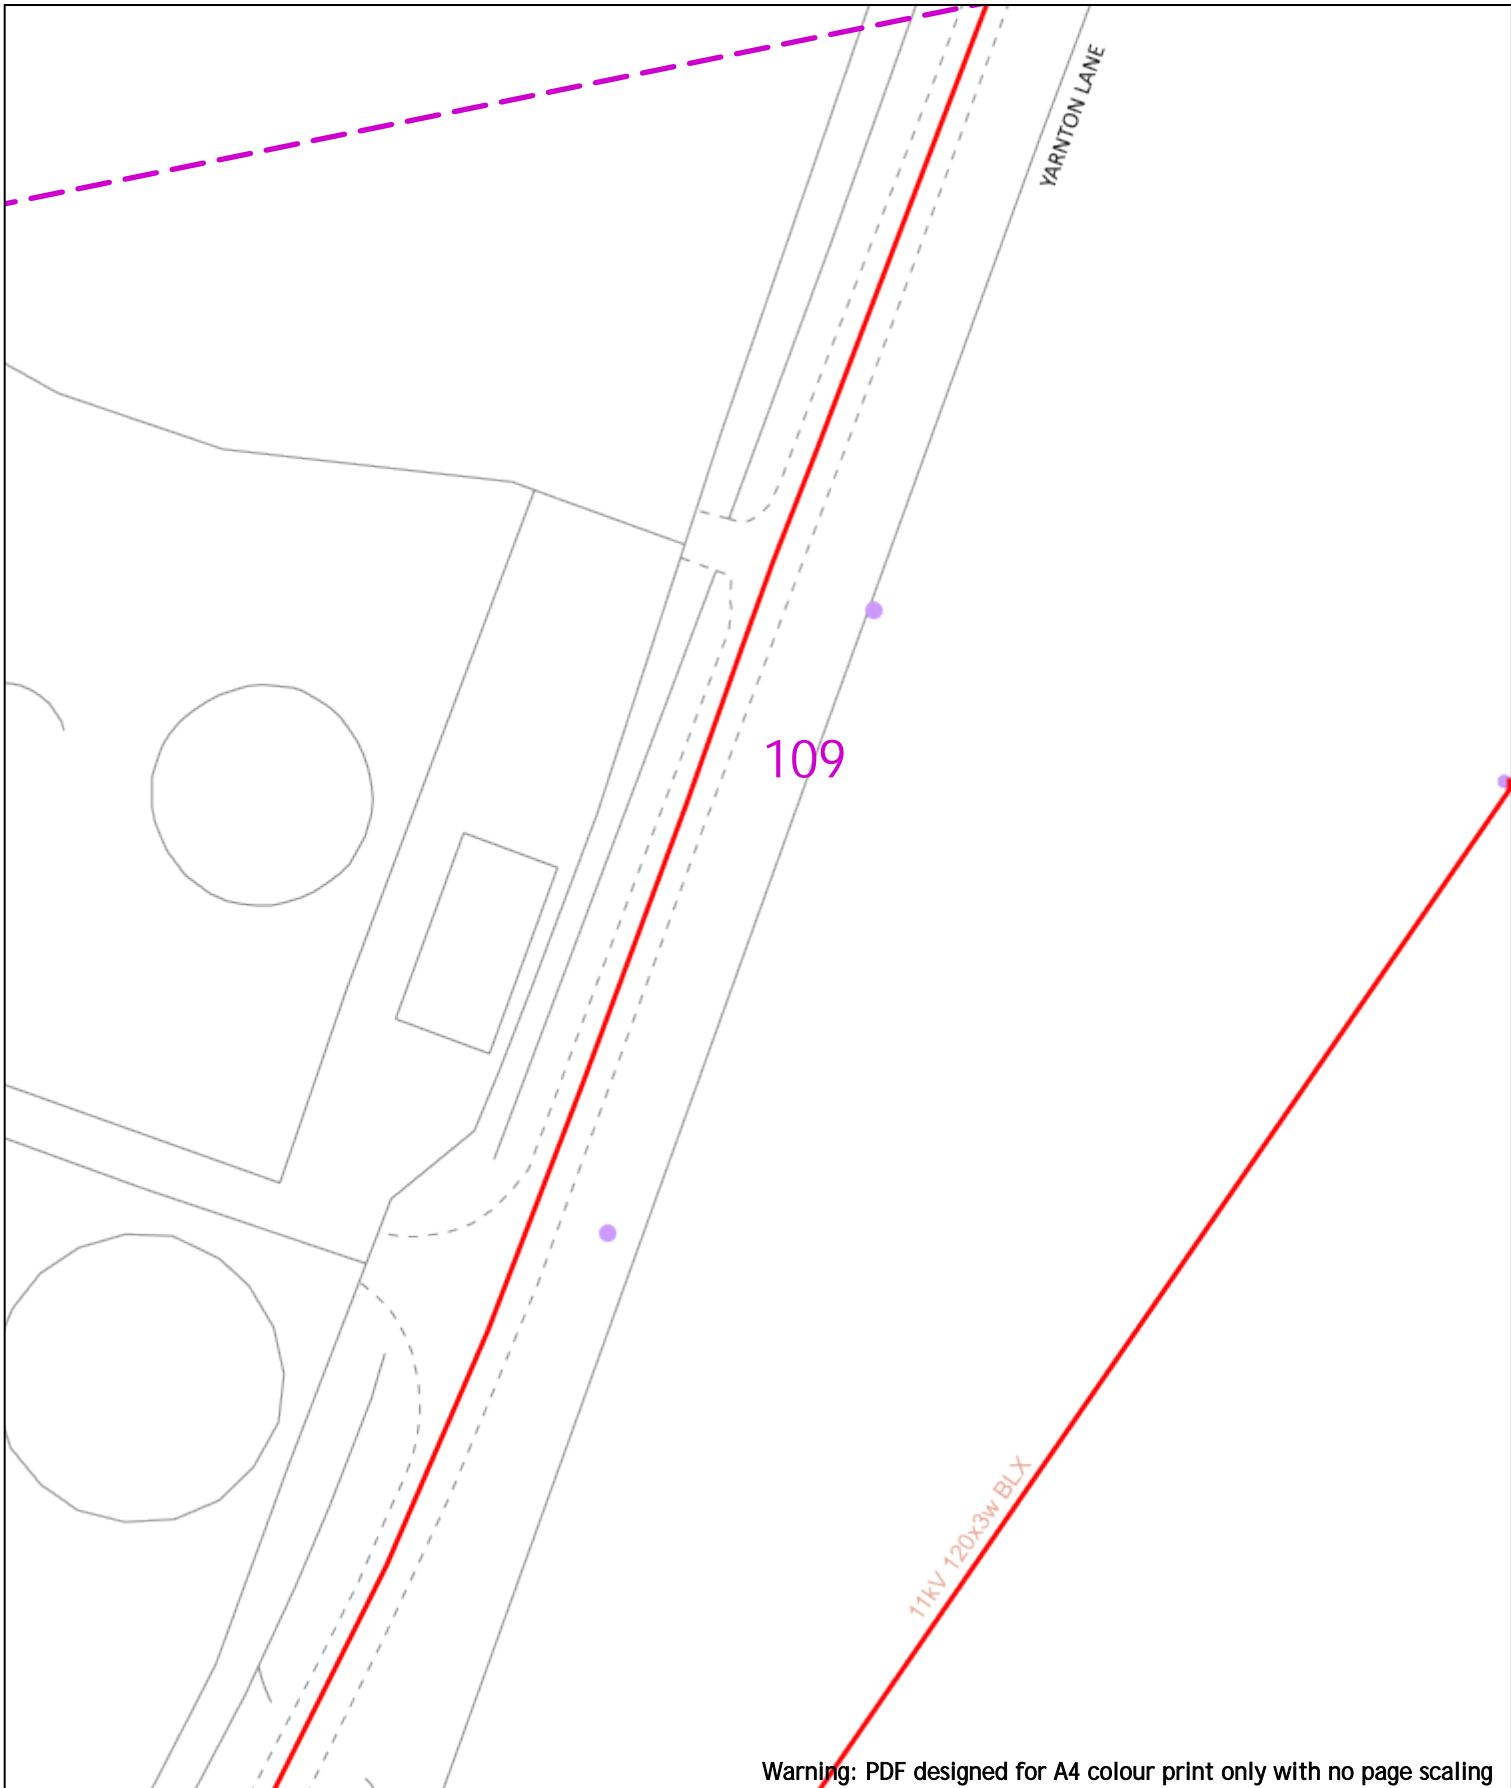


Warning: PDF designed for A4 colour print only with no page scaling

<p>0  20m</p>	<p>Dig Sites Area:  Line: </p>	<p><b>Extra High Voltage cables in vicinity</b></p>																																	
<p>Date Requested: 24/06/2022          Job Reference: 25881037          Site Location: 448662 213014          Requested by: Mr Joe Shawyer          Your Scheme/Reference: 31188_003</p>	<p><b>Voltages (V)</b></p> <table border="1"> <tr> <td>LV (Low Voltage) and Services</td> <td colspan="3">Up to 1,000V</td> </tr> <tr> <td>HV (High Voltage)</td> <td colspan="3">Over 1,000V to 11,000V</td> </tr> <tr> <td>EHV (Extra High Voltage)</td> <td colspan="3">22,000V to 132,000V</td> </tr> <tr> <td>Transmission</td> <td colspan="3">275,000V and 400,000V</td> </tr> </table> <p><b>NORMAL DEPTH TO THE TOP OF THE CABLE WHEN LAID</b></p> <table border="1"> <thead> <tr> <th>Services</th> <th>LV</th> <th>HV</th> <th>EHV</th> </tr> </thead> <tbody> <tr> <td>Footpath/Unmade</td> <td>0.45m</td> <td>0.45m</td> <td>0.6m 0.8m</td> </tr> <tr> <td>Road Crossing</td> <td>0.6m</td> <td>0.6m</td> <td>0.75m 0.9m</td> </tr> <tr> <td>Agricultural</td> <td>1m</td> <td>1m</td> <td>1m 1.1m</td> </tr> </tbody> </table>	LV (Low Voltage) and Services	Up to 1,000V			HV (High Voltage)	Over 1,000V to 11,000V			EHV (Extra High Voltage)	22,000V to 132,000V			Transmission	275,000V and 400,000V			Services	LV	HV	EHV	Footpath/Unmade	0.45m	0.45m	0.6m 0.8m	Road Crossing	0.6m	0.6m	0.75m 0.9m	Agricultural	1m	1m	1m 1.1m	<p><b>Legend</b></p> <ul style="list-style-type: none"> <li>Service Cable</li> <li>LV Mains</li> <li>2 - 11kV</li> <li>66kV</li> <li>11kV</li> <li>22kV</li> <li>33kV</li> <li>66kV</li> <li>132kV</li> <li>275kV</li> <li>400kV</li> <li>Fibre Optic</li> <li>Pilot Cable</li> </ul> <p><b>Distribution Structures (Electric)</b></p> <ul style="list-style-type: none"> <li>Pole, Existing Location</li> <li>Pole Structure, Existing Location - Single</li> <li>Pole Structure, Existing Location - H</li> <li>Duct Route</li> <li>Cross Section Route</li> </ul>	<p><b>Southern Electric Power Distribution plc</b>          Registered Office: No.1 Forbury Place          43 Forbury Road Reading RG1 3JH          Registered In England &amp; Wales No.04094290</p> <p>If you're unsure &amp; need to seek advice before commencing excavations, please contact:          General Enquiries: 0800 048 3516</p> <p>Subject to revision – Master held by SSEN Asset Data Team:  <a href="mailto:Asset.Data@sse.com">Asset.Data@sse.com</a>          01256 337 294</p>
LV (Low Voltage) and Services	Up to 1,000V																																		
HV (High Voltage)	Over 1,000V to 11,000V																																		
EHV (Extra High Voltage)	22,000V to 132,000V																																		
Transmission	275,000V and 400,000V																																		
Services	LV	HV	EHV																																
Footpath/Unmade	0.45m	0.45m	0.6m 0.8m																																
Road Crossing	0.6m	0.6m	0.75m 0.9m																																
Agricultural	1m	1m	1m 1.1m																																
<p>Scale: 1:500 (When plotted at A4)</p> <p><small>BASED UPON THE ORDNANCE SURVEY MAP WITH THE SANCTION OF THE CONTROLLER OF HM STATIONERY OFFICE CROWN COPYRIGHT RESERVED.          This copy has been made by or with the authority of Scottish and Southern Energy Power Distribution Ltd. Pursuant to section 47 of the Copyright, Designs and Patents Act 1988 ("The Act"). Unless the Act provides a relevant exception to copyright the copy must not be copied without prior permission of the copyright owner.          Plans generated by DigSAFE Pro™ software provided by LinesearchbeforeDig.</small></p>																																			

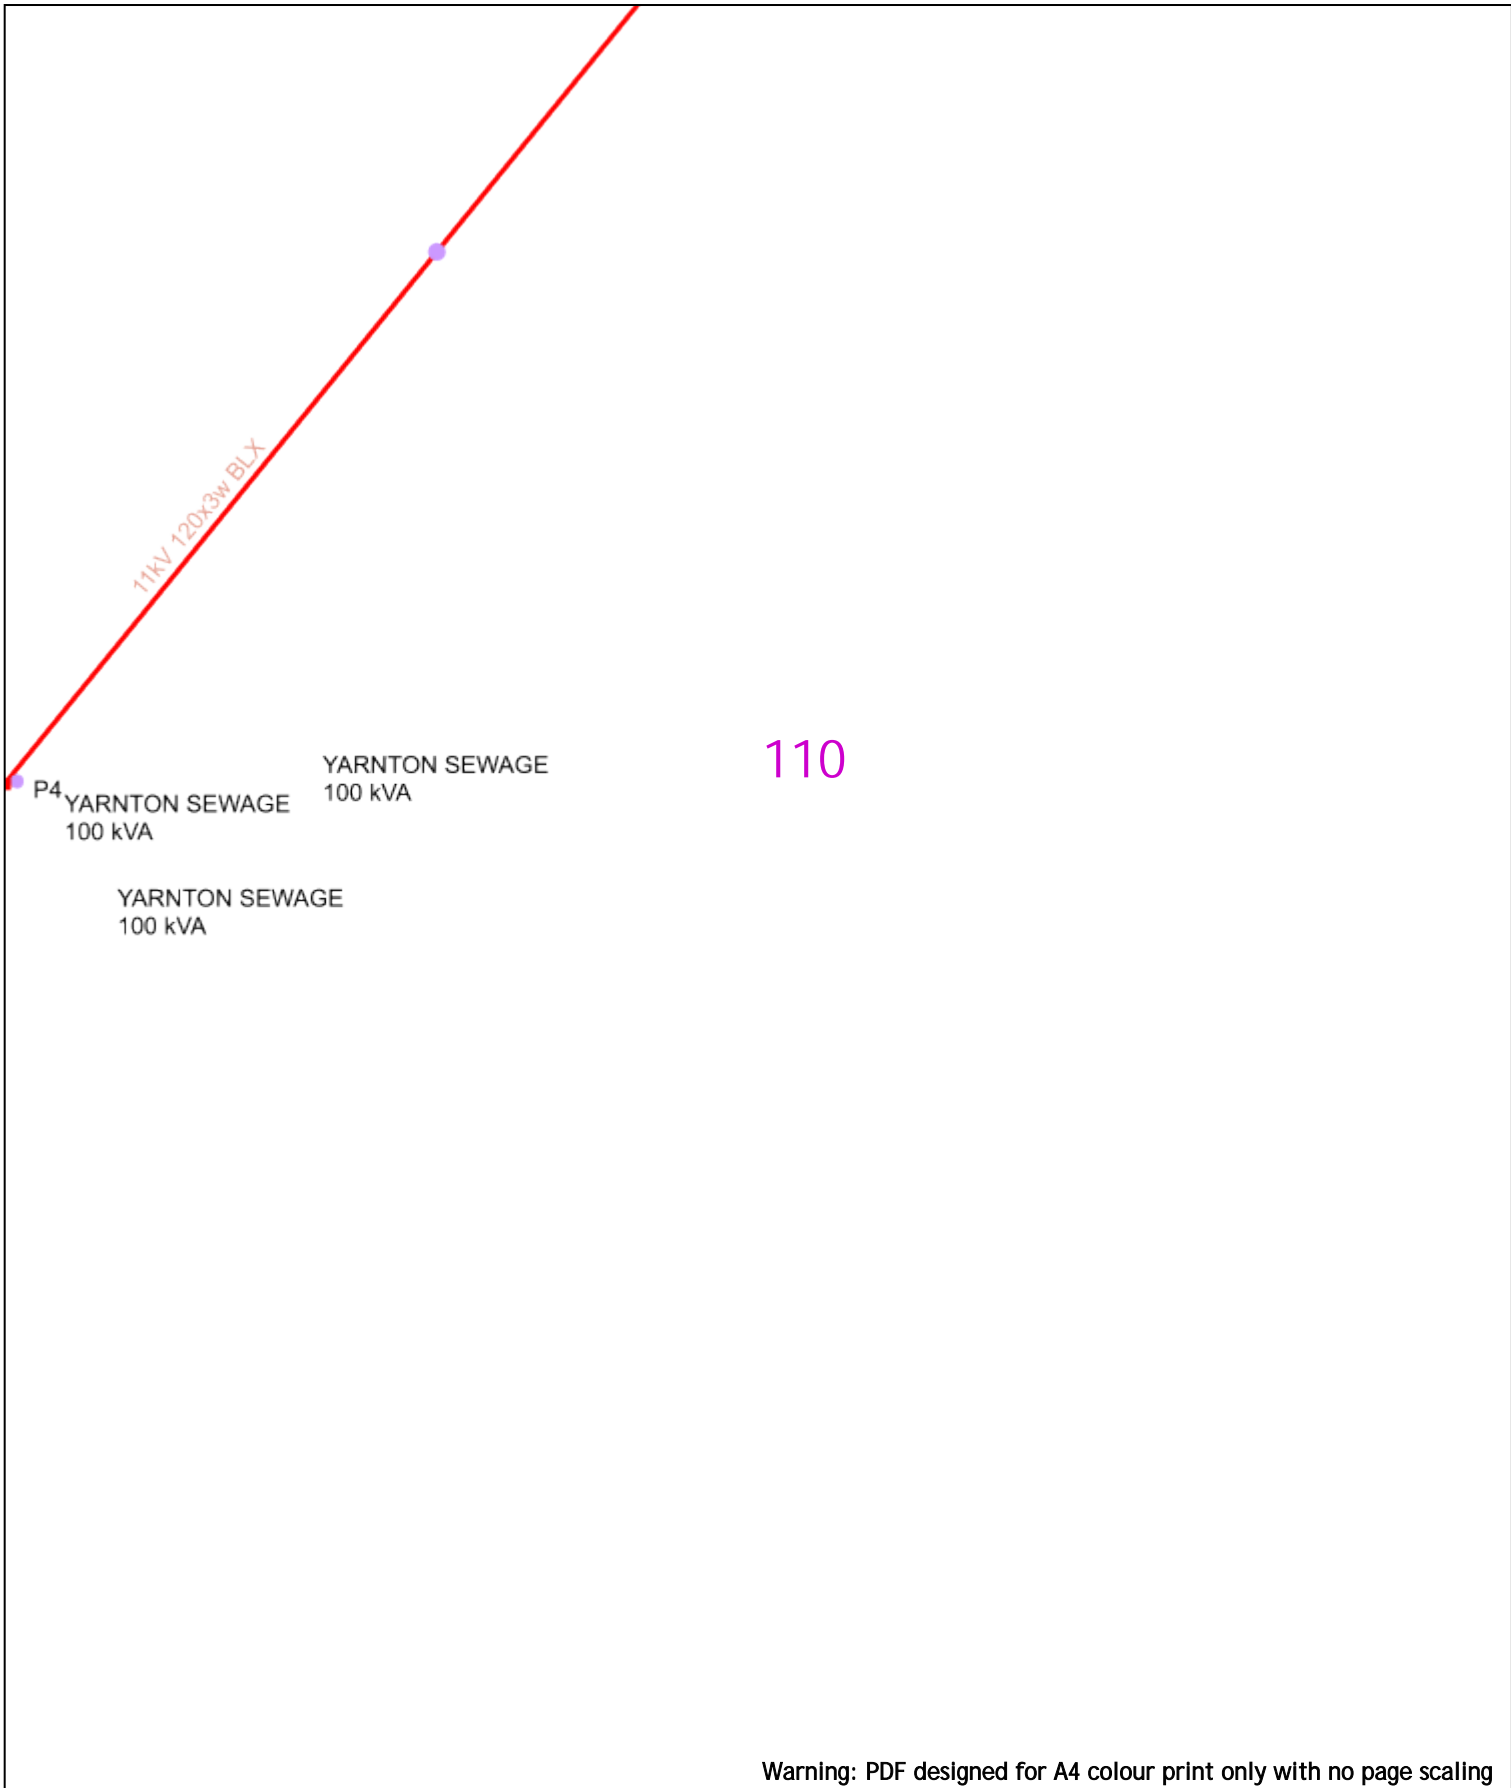


Warning: PDF designed for A4 colour print only with no page scaling

<p>0  20m</p> <p>Date Requested: 24/06/2022          Job Reference: 25881037          Site Location: 448662 213014          Requested by: Mr Joe Shawyer          Your Scheme/Reference: 31188_003</p>	<p>Dig Sites Area:  Line: </p>	<p>Extra High Voltage cables in vicinity</p>	
<p>Scale: 1:500 (When plotted at A4)</p>	<table border="1" style="width: 100%; border-collapse: collapse;"> <thead> <tr> <th colspan="4">Voltages (V)</th> </tr> </thead> <tbody> <tr> <td>LV (Low Voltage) and Services</td> <td colspan="3">Up to 1,000V</td> </tr> <tr> <td>HV (High Voltage)</td> <td colspan="3">Over 1,000V to 11,000V</td> </tr> <tr> <td>EHV (Extra High Voltage)</td> <td colspan="3">22,000V to 132,000V</td> </tr> <tr> <td>Transmission</td> <td colspan="3">275,000V and 400,000V</td> </tr> </tbody> </table> <table border="1" style="width: 100%; border-collapse: collapse; margin-top: 5px;"> <thead> <tr> <th colspan="5">NORMAL DEPTH TO THE TOP OF THE CABLE WHEN LAID</th> </tr> <tr> <th>Services</th> <th>LV</th> <th>HV</th> <th>EHV</th> <th></th> </tr> </thead> <tbody> <tr> <td>Footpath/Unmade</td> <td>0.45m</td> <td>0.45m</td> <td>0.6m</td> <td>0.8m</td> </tr> <tr> <td>Road Crossing</td> <td>0.6m</td> <td>0.6m</td> <td>0.75m</td> <td>0.9m</td> </tr> <tr> <td>Agricultural</td> <td>1m</td> <td>1m</td> <td>1m</td> <td>1.1m</td> </tr> </tbody> </table> <p style="font-size: small; color: red; text-align: center;"><b>WARNING</b>          There may have been subsequent alteration to the surface levels. Trial holes must be undertaken to determine position and depths of cables. HS (G) 47 Booklet from the Health and Safety Executive – Avoiding Danger from Buried Cables – should be consulted before commencing excavation work.  <b>WHEN WORKING IN THE VICINITY OF OVERHEAD LINES THE HEALTH AND SAFETY GUIDANCE NOTES G56 SHOULD BE CONSULTED (AVAILABLE FROM THE HSE WEBSITE)</b></p>	Voltages (V)				LV (Low Voltage) and Services	Up to 1,000V			HV (High Voltage)	Over 1,000V to 11,000V			EHV (Extra High Voltage)	22,000V to 132,000V			Transmission	275,000V and 400,000V			NORMAL DEPTH TO THE TOP OF THE CABLE WHEN LAID					Services	LV	HV	EHV		Footpath/Unmade	0.45m	0.45m	0.6m	0.8m	Road Crossing	0.6m	0.6m	0.75m	0.9m	Agricultural	1m	1m	1m	1.1m	<table border="1" style="width: 100%; border-collapse: collapse;"> <thead> <tr> <th colspan="2">Legend</th> </tr> </thead> <tbody> <tr><td></td><td>Service Cable</td></tr> <tr><td></td><td>LV Mains</td></tr> <tr><td></td><td>2 – 11kV</td></tr> <tr><td></td><td>66kV</td></tr> <tr><td></td><td>11kV</td></tr> <tr><td></td><td>22kV</td></tr> <tr><td></td><td>33kV</td></tr> <tr><td></td><td>66kV</td></tr> <tr><td></td><td>132kV</td></tr> <tr><td></td><td>275kV</td></tr> <tr><td></td><td>400kV</td></tr> <tr><td></td><td>Fibre Optic</td></tr> <tr><td></td><td>Pipe Cable</td></tr> </tbody> </table> <table border="1" style="width: 100%; border-collapse: collapse; margin-top: 5px;"> <thead> <tr> <th colspan="2">Distribution Structures (Electric)</th> </tr> </thead> <tbody> <tr><td></td><td>Pole, Existing Location</td></tr> <tr><td></td><td>Pole Structure, Existing Location – Single</td></tr> <tr><td></td><td>Pole Structure, Existing Location – H</td></tr> <tr><td></td><td>Duct Route</td></tr> <tr><td></td><td>Cross Section Route</td></tr> </tbody> </table>	Legend			Service Cable		LV Mains		2 – 11kV		66kV		11kV		22kV		33kV		66kV		132kV		275kV		400kV		Fibre Optic		Pipe Cable	Distribution Structures (Electric)			Pole, Existing Location		Pole Structure, Existing Location – Single		Pole Structure, Existing Location – H		Duct Route		Cross Section Route	<p><b>Southern Electric Power Distribution plc</b>          Registered Office: No.1 Forbury Place          43 Forbury Road Reading RG1 3JH          Registered In England &amp; Wales No.04094290</p> <p>If you're unsure &amp; need to seek advice before commencing excavations, please contact:          General Enquiries: 0800 048 3516</p> <p>Subject to revision – Master held by SSEN Asset Data Team:  <a href="mailto:Asset.Data@sse.com">Asset.Data@sse.com</a>          01256 337 294</p>
Voltages (V)	
LV (Low Voltage) and Services	Up to 1,000V	
HV (High Voltage)	Over 1,000V to 11,000V	
EHV (Extra High Voltage)	22,000V to 132,000V	
Transmission	275,000V and 400,000V	
NORMAL DEPTH TO THE TOP OF THE CABLE WHEN LAID	
Services	LV	HV	EHV	
Footpath/Unmade	0.45m	0.45m	0.6m	0.8m	
Road Crossing	0.6m	0.6m	0.75m	0.9m	
Agricultural	1m	1m	1m	1.1m	
Legend	
	Service Cable	
	LV Mains	
	2 – 11kV	
	66kV	
	11kV	
	22kV	
	33kV	
	66kV	
	132kV	
	275kV	
	400kV	
	Fibre Optic	
	Pipe Cable	
Distribution Structures (Electric)	
	Pole, Existing Location	
	Pole Structure, Existing Location – Single	
	Pole Structure, Existing Location – H	
	Duct Route	
	Cross Section Route	

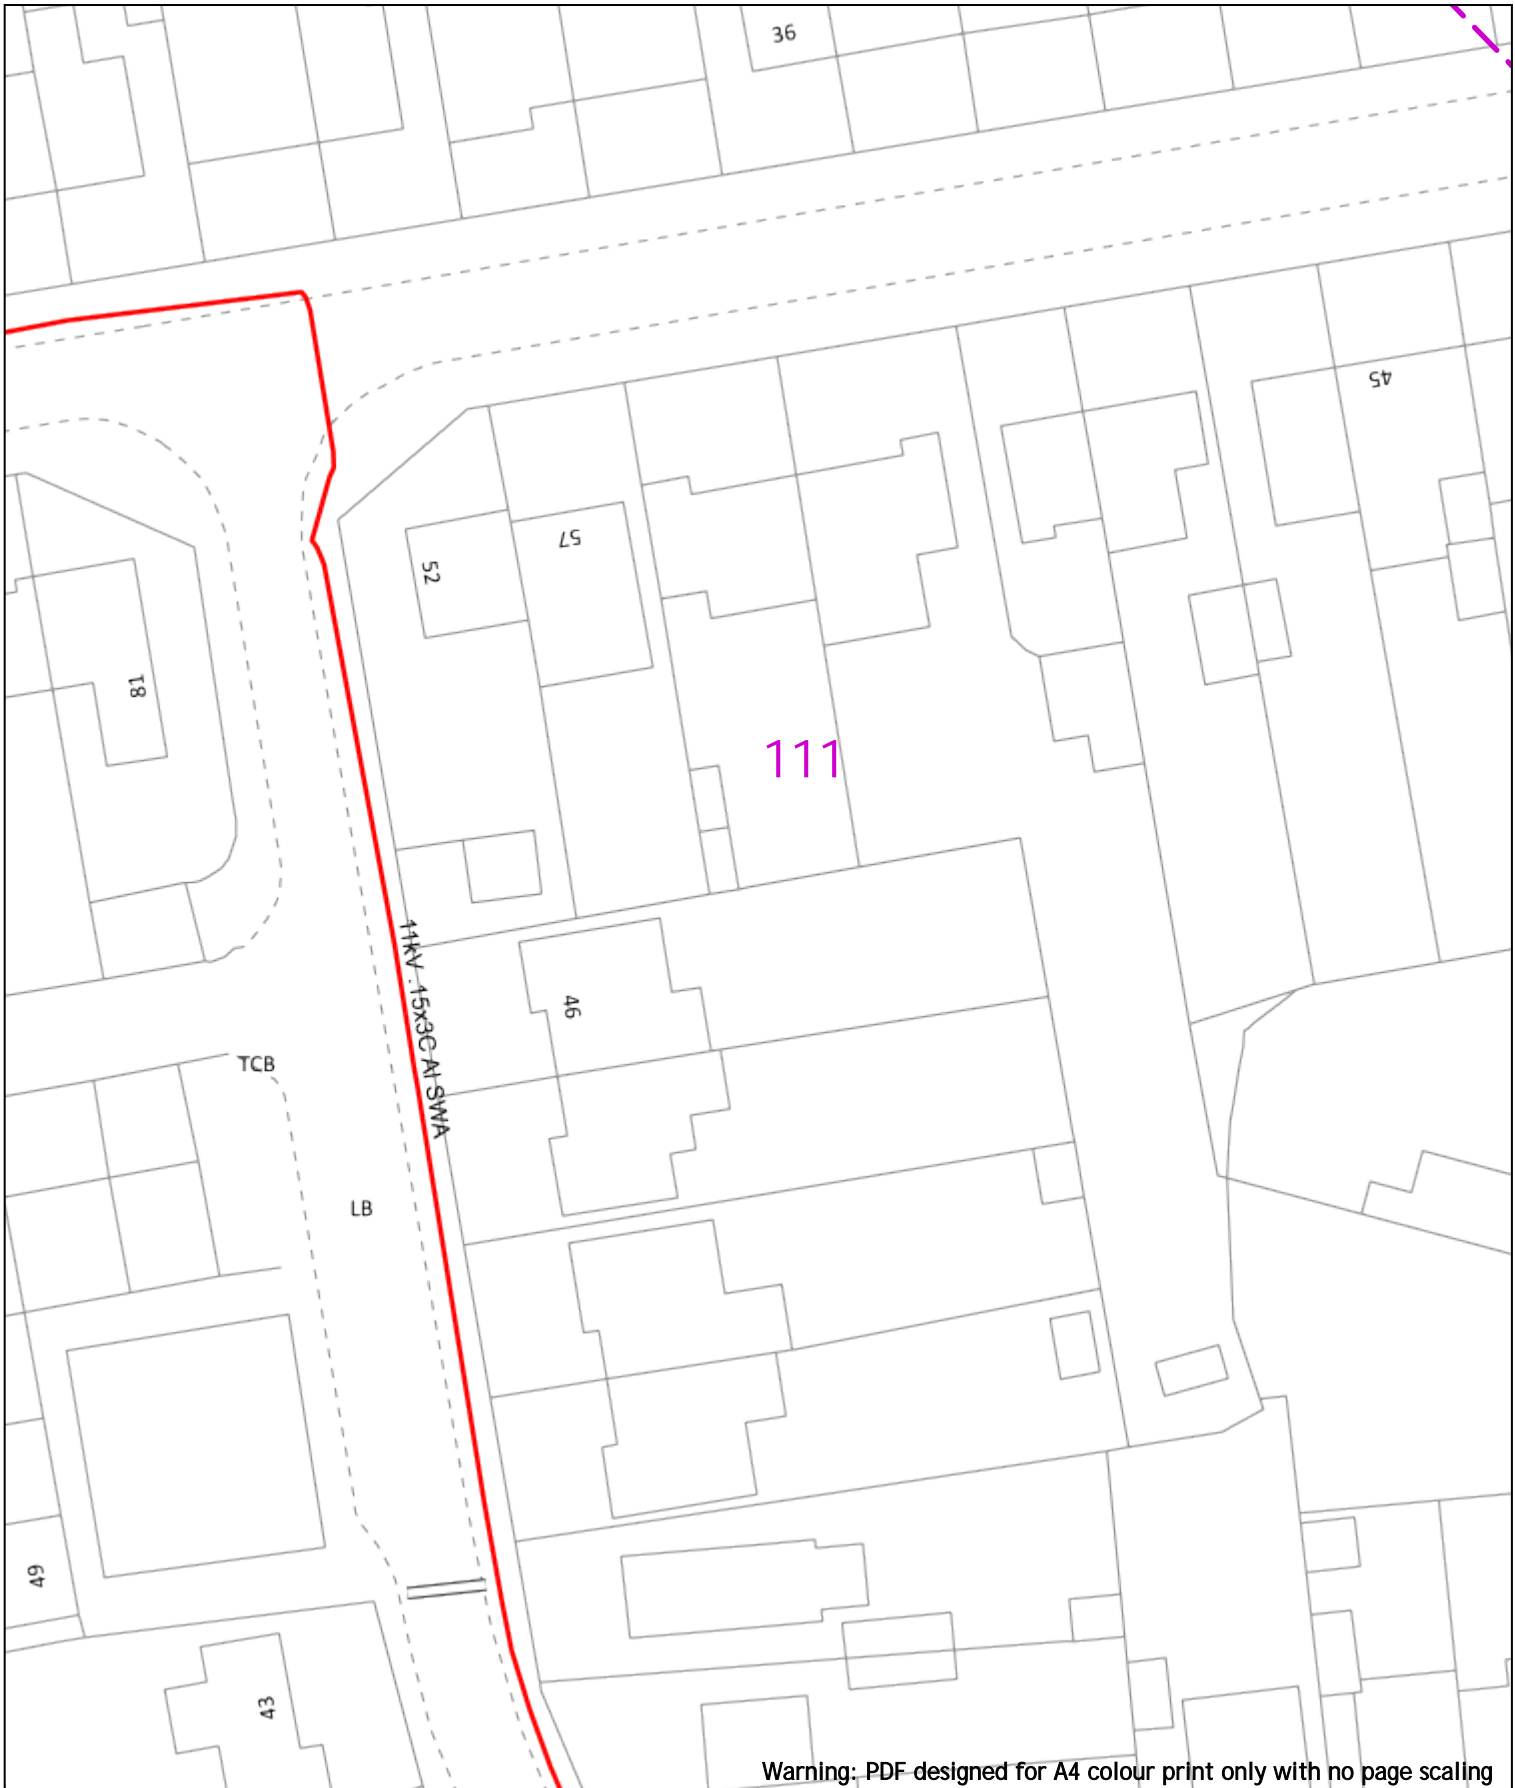

Warning: PDF designed for A4 colour print only with no page scaling

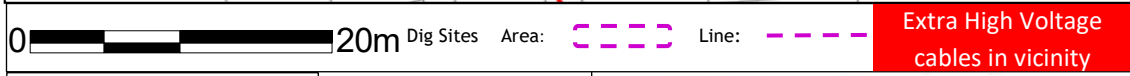

Date Requested: 24/06/2022  
 Job Reference: 25881037  
 Site Location: 448662 213014  
 Requested by: Mr Joe Shawyer  
 Your Scheme/Reference: 31188\_003

Voltages (V)			
LV (Low Voltage) and Services	Up to 1,000V		
HV (High Voltage)	Over 1,000V to 11,000V		
EHV (Extra High Voltage)	22,000V to 132,000V		
Transmission	275,000V and 400,000V		
NORMAL DEPTH TO THE TOP OF THE CABLE WHEN LAID			
Services	LV	HV	EHV
Footpath/Unmade	0.45m	0.45m	0.6m
Road Crossing	0.6m	0.6m	0.75m
Agricultural	1m	1m	1.1m

Legend	
Service Cable	—
LV Mains	—
6.6kV	—
11kV	—
22kV	—
33kV	—
66kV	—
132kV	—
275kV	—
400kV	—
Fibre Optic	—
Pipe Cable	—

Distribution Structures (Electric)	
Pole, Existing Location	●
Pole Structure, Existing Location - Single	○
Pole Structure, Existing Location - H	○
Duct Route	—
Cross Section Route	—

Scale: 1:500 (When plotted at A4)

**WARNING**  
 There may have been subsequent alteration to the surface levels. Trial holes must be undertaken to determine position and depths of cables. HS (G) 47 Booklet from the Health and Safety Executive - Avoiding Danger from Buried Cables - should be consulted before commencing excavation work.  
 WHEN WORKING IN THE VICINITY OF OVERHEAD LINES THE HEALTH AND SAFETY GUIDANCE NOTES G56 SHOULD BE CONSULTED (AVAILABLE FROM THE HSE WEBSITE)


**Southern Electric Power Distribution plc**  
 Registered Office: No.1 Forbury Place  
 43 Forbury Road Reading RG1 3JH  
 Registered In England & Wales No.04094290

If you're unsure & need to seek advice before commencing excavations, please contact:  
 General Enquiries: 0800 048 3516

Subject to revision - Master held by SSEN Asset Data Team:  
[Asset.Data@sse.com](mailto:Asset.Data@sse.com)  
 01256 337 294



Warning: PDF designed for A4 colour print only with no page scaling

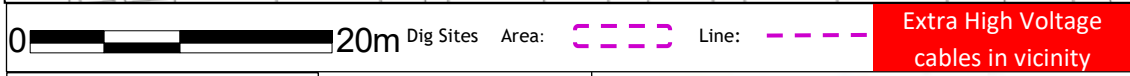

Date Requested: 24/06/2022  
 Job Reference: 25881037  
 Site Location: 448662 213014  
 Requested by: Mr Joe Shawyer  
 Your Scheme/Reference: 31188\_003

**Voltages (V)**

LV (Low Voltage) and Services	Up to 1,000V		
HV (High Voltage)	Over 1,000V to 11,000V		
EHV (Extra High Voltage)	22,000V to 132,000V		
Transmission	275,000V and 400,000V		

**NORMAL DEPTH TO THE TOP OF THE CABLE WHEN LAID**

Services	LV	HV	EHV
Footpath/Unmade	0.45m	0.45m	0.6m 0.8m
Road Crossing	0.6m	0.6m	0.75m 0.9m
Agricultural	1m	1m	1m 1.1m

**Legend**

- Service Cable
- LV Mains
- 6.6kV
- 11kV
- 22kV
- 33kV
- 66kV
- 132kV
- 275kV
- 400kV
- Fibre Optic
- Pipe Cable

**Distribution Structures (Electric)**

- Pole, Existing Location
- Pole Structure, Existing Location - Single
- Pole Structure, Existing Location - M
- Duct Route
- Cross Section Route

**WARNING**


There may have been subsequent alteration to the surface levels. Trial holes must be undertaken to determine position and depths of cables. HS (G) 47 Booklet from the Health and Safety Executive - Avoiding Danger from Buried Cables - should be consulted before commencing excavation work.

**WHEN WORKING IN THE VICINITY OF OVERHEAD LINES THE HEALTH AND SAFETY GUIDANCE NOTES G56 SHOULD BE CONSULTED (AVAILABLE FROM THE HSE WEBSITE)**

**Southern Electric Power Distribution plc**  
 Registered Office: No.1 Forbury Place  
 43 Forbury Road Reading RG1 3JH  
 Registered In England & Wales No.04094290

If you're unsure & need to seek advice before commencing excavations, please contact:  
 General Enquiries: 0800 048 3516

Subject to revision - Master held by SSEN Asset Data Team:  
[Asset.Data@sse.com](mailto:Asset.Data@sse.com)  
 01256 337 294

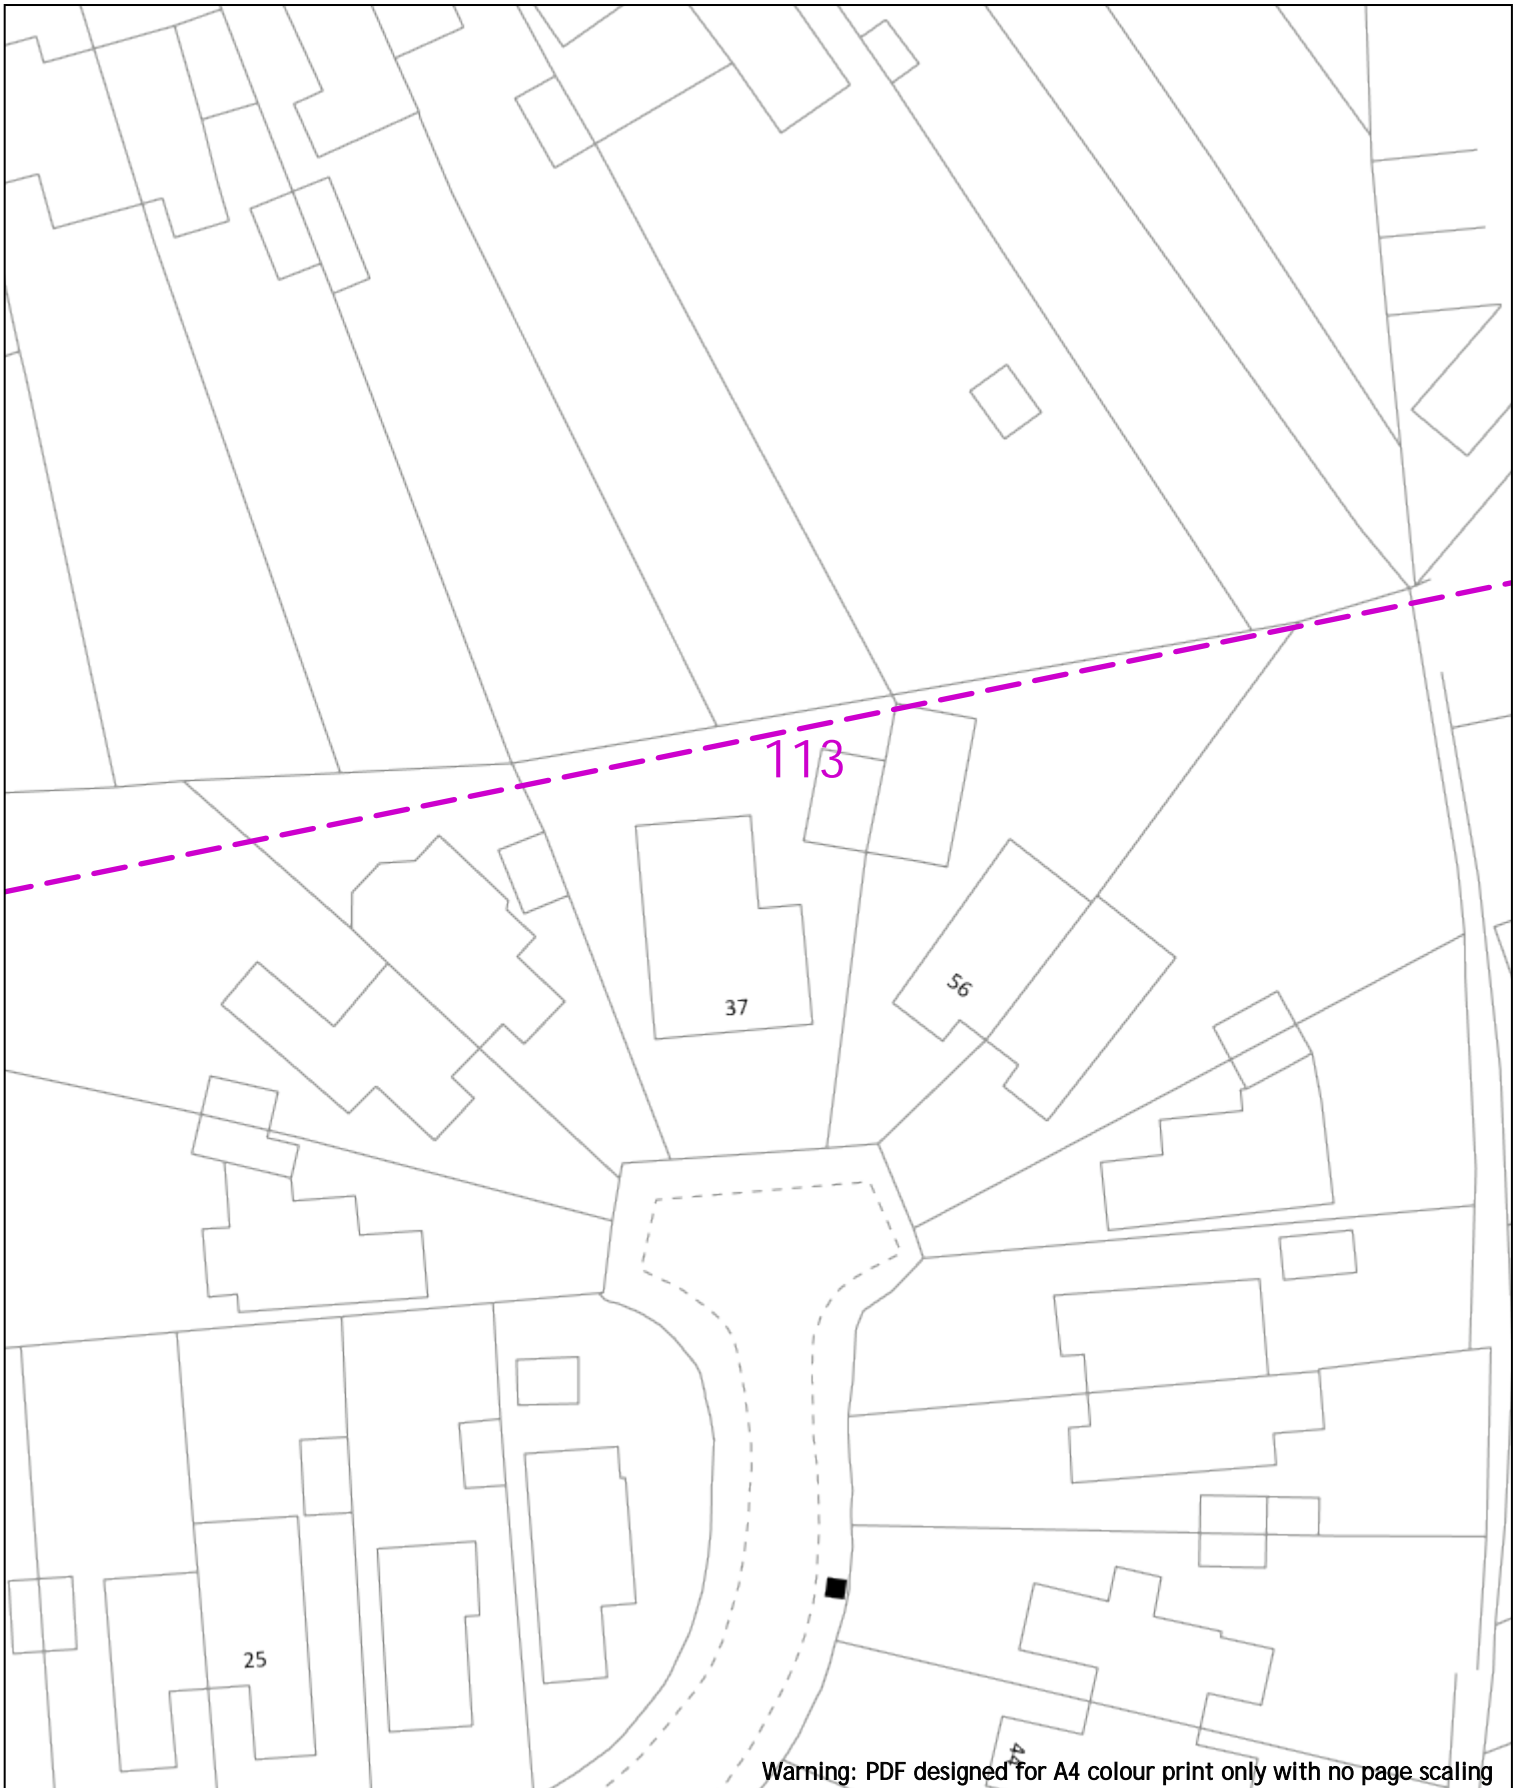

0 20m Dig Sites Area: Line: **Extra High Voltage cables in vicinity**

Date Requested: 24/06/2022  
 Job Reference: 25881037  
 Site Location: 448662 213014  
 Requested by: Mr Joe Shawyer  
 Your Scheme/Reference: 31188\_003

Voltages (V)			
LV (Low Voltage) and Services	Up to 1,000V		
HV (High Voltage)	Over 1,000V to 11,000V		
EHV (Extra High Voltage)	22,000V to 132,000V		
Transmission	275,000V and 400,000V		

NORMAL DEPTH TO THE TOP OF THE CABLE WHEN LAID			
Services	LV	HV	EHV
Footpath/Unmade	0.45m	0.45m	0.6m
Road Crossing	0.6m	0.6m	0.75m
Agricultural	1m	1m	1.1m

Legend		Distribution Structures (Electric)	
	Service Cable		Pole, Existing Location
	LV Mains		Pole Structure, Existing Location - Single
	66kV		Pole Structure, Existing Location - H
	11kV		Duct Route
	22kV		Cross Section Route
	33kV		
	66kV		
	132kV		
	275kV		
	400kV		
	Fibre Optic		
	Pipe Cable		

**WARNING**  
 There may have been subsequent alteration to the surface levels. Trial holes must be undertaken to determine position and depths of cables. HS (G) 47 Booklet from the Health and Safety Executive - Avoiding Danger from Buried Cables - should be consulted before commencing excavation work.  
**WHEN WORKING IN THE VICINITY OF OVERHEAD LINES THE HEALTH AND SAFETY GUIDANCE NOTES G56 SHOULD BE CONSULTED (AVAILABLE FROM THE HSE WEBSITE)**


Scale: 1:500 (When plotted at A4)

**Southern Electric Power Distribution plc**  
 Registered Office: No.1 Forbury Place  
 43 Forbury Road Reading RG1 3JH  
 Registered In England & Wales No.04094290

If you're unsure & need to seek advice before commencing excavations, please contact:  
 General Enquiries: 0800 048 3516


Subject to revision - Master held by SSEN Asset Data Team:  
[Asset.Data@sse.com](mailto:Asset.Data@sse.com)  
 01256 337 294



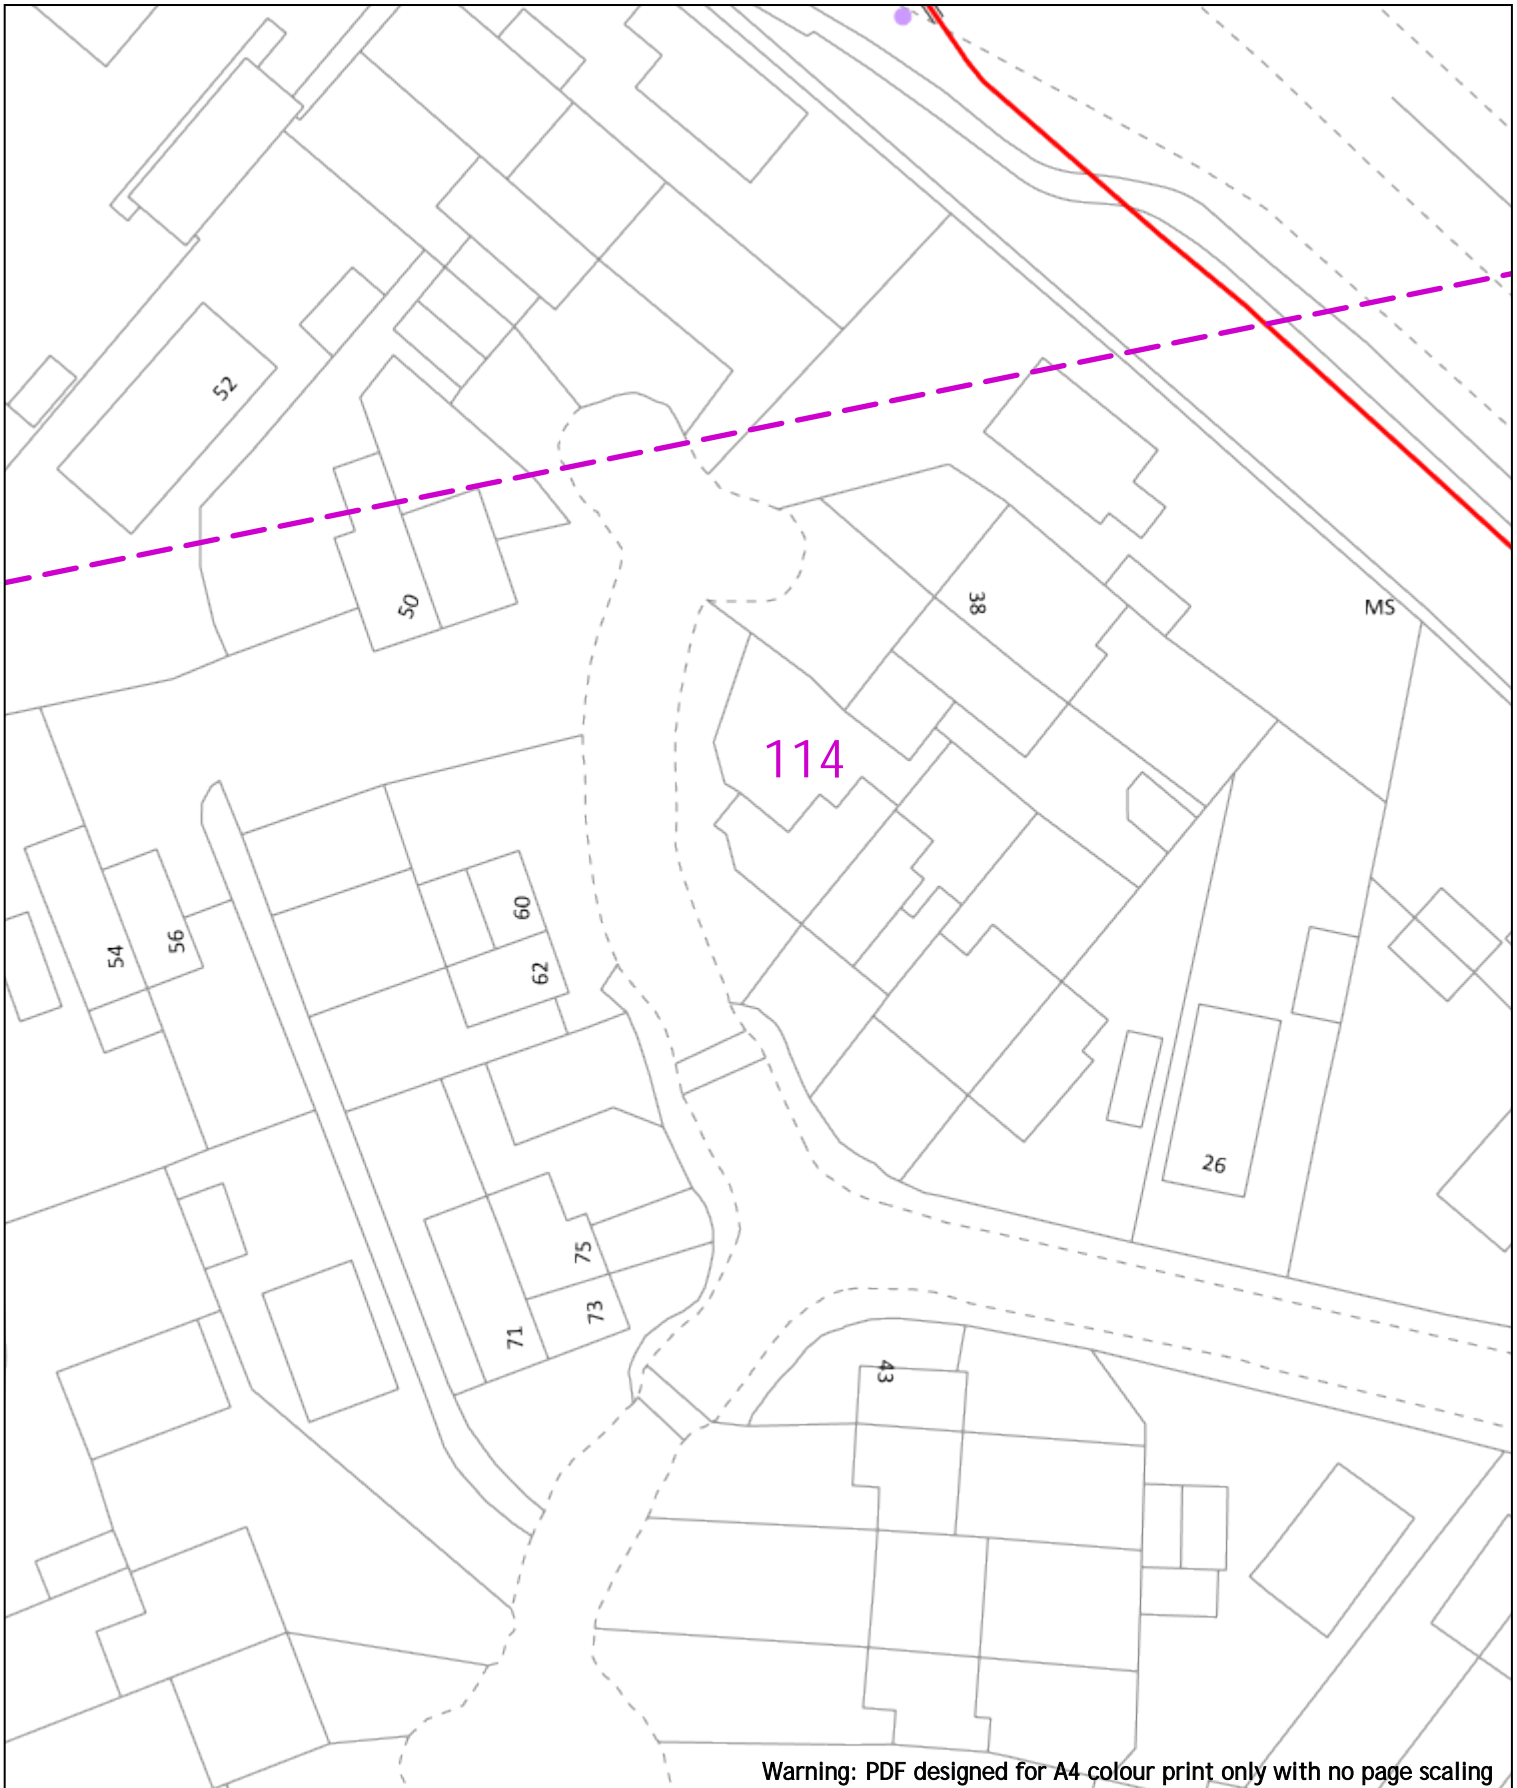

Warning: PDF designed for A4 colour print only with no page scaling

<p>0  20m Dig Sites Area:  Line:  <b>Extra High Voltage cables in vicinity</b></p>	
<p>Date Requested: 24/06/2022          Job Reference: 25881037          Site Location: 448662 213014          Requested by: Mr Joe Shawyer          Your Scheme/Reference: 31188_003</p>	<table border="1"> <thead> <tr> <th colspan="4">Voltages (V)</th> </tr> </thead> <tbody> <tr> <td>LV (Low Voltage) and Services</td> <td colspan="3">Up to 1,000V</td> </tr> <tr> <td>HV (High Voltage)</td> <td colspan="3">Over 1,000V to 11,000V</td> </tr> <tr> <td>EHV (Extra High Voltage)</td> <td colspan="3">22,000V to 132,000V</td> </tr> <tr> <td>Transmission</td> <td colspan="3">275,000V and 400,000V</td> </tr> </tbody> </table> <table border="1"> <thead> <tr> <th colspan="4">NORMAL DEPTH TO THE TOP OF THE CABLE WHEN LAID</th> </tr> </thead> <tbody> <tr> <td>Services</td> <td>LV</td> <td>HV</td> <td>EHV</td> </tr> <tr> <td>Footpath/Unmade</td> <td>0.45m</td> <td>0.45m</td> <td>0.6m 0.8m</td> </tr> <tr> <td>Road Crossing</td> <td>0.6m</td> <td>0.6m</td> <td>0.75m 0.9m</td> </tr> <tr> <td>Agricultural</td> <td>1m</td> <td>1m</td> <td>1m 1.1m</td> </tr> </tbody> </table> <p><b>Legend</b></p> <ul style="list-style-type: none"> <li>Service Cable</li> <li>LV Mains</li> <li>6kV</li> <li>11kV</li> <li>22kV</li> <li>33kV</li> <li>66kV</li> <li>132kV</li> <li>275kV</li> <li>400kV</li> <li>Fibre Optic</li> <li>Pipe Cable</li> </ul> <p><b>Distribution Structures (Electric)</b></p> <ul style="list-style-type: none"> <li>Pole, Existing Location</li> <li>Pole Structure, Existing Location - Single</li> <li>Pole Structure, Existing Location - H</li> <li>Duct Route</li> <li>Cross Section Route</li> </ul> <p><b>WARNING</b></p> <p>There may have been subsequent alteration to the surface levels. Trial holes must be undertaken to determine position and depths of cables. HS (G) 47 Booklet from the Health and Safety Executive - Avoiding Danger from Buried Cables - should be consulted before commencing excavation work.</p> <p><b>WHEN WORKING IN THE VICINITY OF OVERHEAD LINES THE HEALTH AND SAFETY GUIDANCE NOTES G56 SHOULD BE CONSULTED (AVAILABLE FROM THE HSE WEBSITE)</b></p>	Voltages (V)				LV (Low Voltage) and Services	Up to 1,000V			HV (High Voltage)	Over 1,000V to 11,000V			EHV (Extra High Voltage)	22,000V to 132,000V			Transmission	275,000V and 400,000V			NORMAL DEPTH TO THE TOP OF THE CABLE WHEN LAID				
<p>Scale: 1:500 (When plotted at A4)</p>	<p>BASED UPON THE ORDNANCE SURVEY MAP WITH THE SANCTION OF THE CONTROLLER OF HM STATIONERY OFFICE CROWN COPYRIGHT RESERVED.</p> <p>This copy has been made by or with the authority of Scottish and Southern Energy Power Distribution Ltd. Pursuant to section 47 of the Copyright, Designs and Patents Act 1988 ("The Act"). Unless the Act provides a relevant exception to copyright the copy must not be copied without prior permission of the copyright owner.</p> <p>Plans generated by DigSAFE Pro™ software provided by LinesearchbeforeUdig.</p>	
<p><b>Southern Electric Power Distribution plc</b>          Registered Office: No.1 Forbury Place          43 Forbury Road Reading RG1 3JH          Registered In England &amp; Wales No.04094290</p> <p>If you're unsure &amp; need to seek advice before commencing excavations, please contact:          General Enquiries: 0800 048 3516</p> <p>Subject to revision – Master held by SSEN Asset Data Team:  <a href="mailto:Asset.Data@sse.com">Asset.Data@sse.com</a>          01256 337 294</p>	

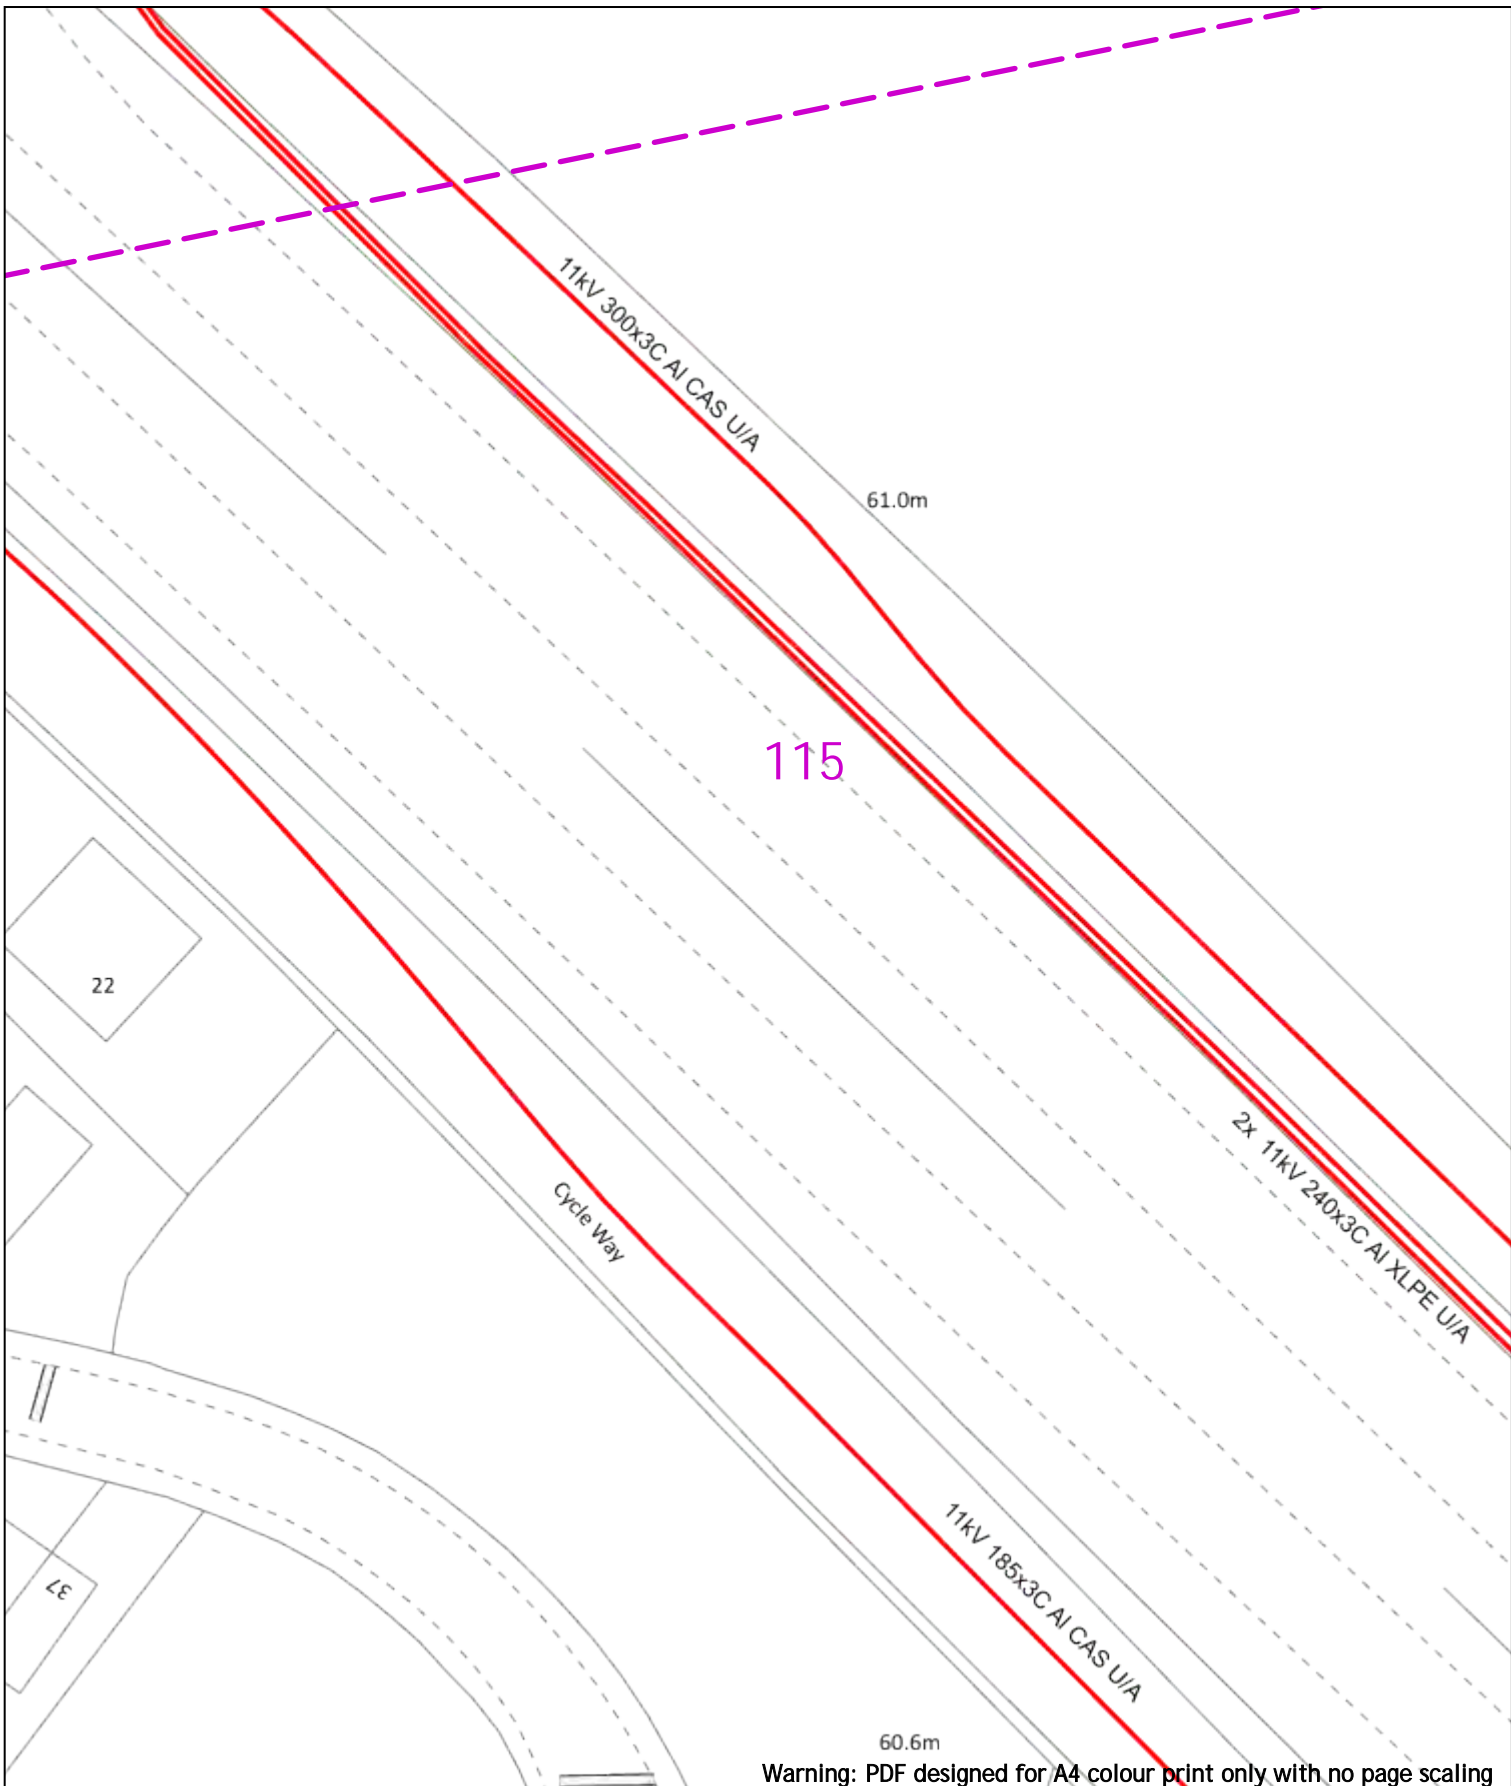

Warning: PDF designed for A4 colour print only with no page scaling

0 20m Dig Sites Area: Line:

**Extra High Voltage cables in vicinity**



Date Requested: 24/06/2022  
 Job Reference: 25881037  
 Site Location: 448662 213014  
 Requested by: Mr Joe Shawyer  
 Your Scheme/Reference: 31188\_003

Voltages (V)			
LV (Low Voltage) and Services	Up to 1,000V		
HV (High Voltage)	Over 1,000V to 11,000V		
EHV (Extra High Voltage)	22,000V to 132,000V		
Transmission	275,000V and 400,000V		
NORMAL DEPTH TO THE TOP OF THE CABLE WHEN LAID			
Services	LV	HV	EHV
Footpath/Unmade	0.45m	0.45m	0.6m
Road Crossing	0.6m	0.6m	0.75m
Agricultural	1m	1m	1.1m

Legend	
	Service Cable
	LV Mains
	2 - 11kV
	66kV
	11kV
	22kV
	33kV
	66kV
	132kV
	275kV
	400kV
	Fibre Optic
	Pilot Cable

Distribution Structures (Electric)	
	Pole, Existing Location
	Pole Structure, Existing Location - Single
	Pole Structure, Existing Location - H
	Duct Route
	Cross Section Route


**Southern Electric Power Distribution plc**  
 Registered Office: No.1 Forbury Place  
 43 Forbury Road Reading RG1 3JH  
 Registered In England & Wales No.04094290

If you're unsure & need to seek advice before commencing excavations, please contact:  
 General Enquiries: 0800 048 3516

Subject to revision - Master held by SSEN Asset Data Team:  
[Asset.Data@sse.com](mailto:Asset.Data@sse.com)  
 01256 337 294

Scale: 1:500 (When plotted at A4)

**WARNING**  
 There may have been subsequent alteration to the surface levels. Trial holes must be undertaken to determine position and depths of cables. HS (G) 47 Booklet from the Health and Safety Executive - Avoiding Danger from Buried Cables - should be consulted before commencing excavation work.  
 WHEN WORKING IN THE VICINITY OF OVERHEAD LINES THE HEALTH AND SAFETY GUIDANCE NOTES G56 SHOULD BE CONSULTED (AVAILABLE FROM THE HSE WEBSITE)

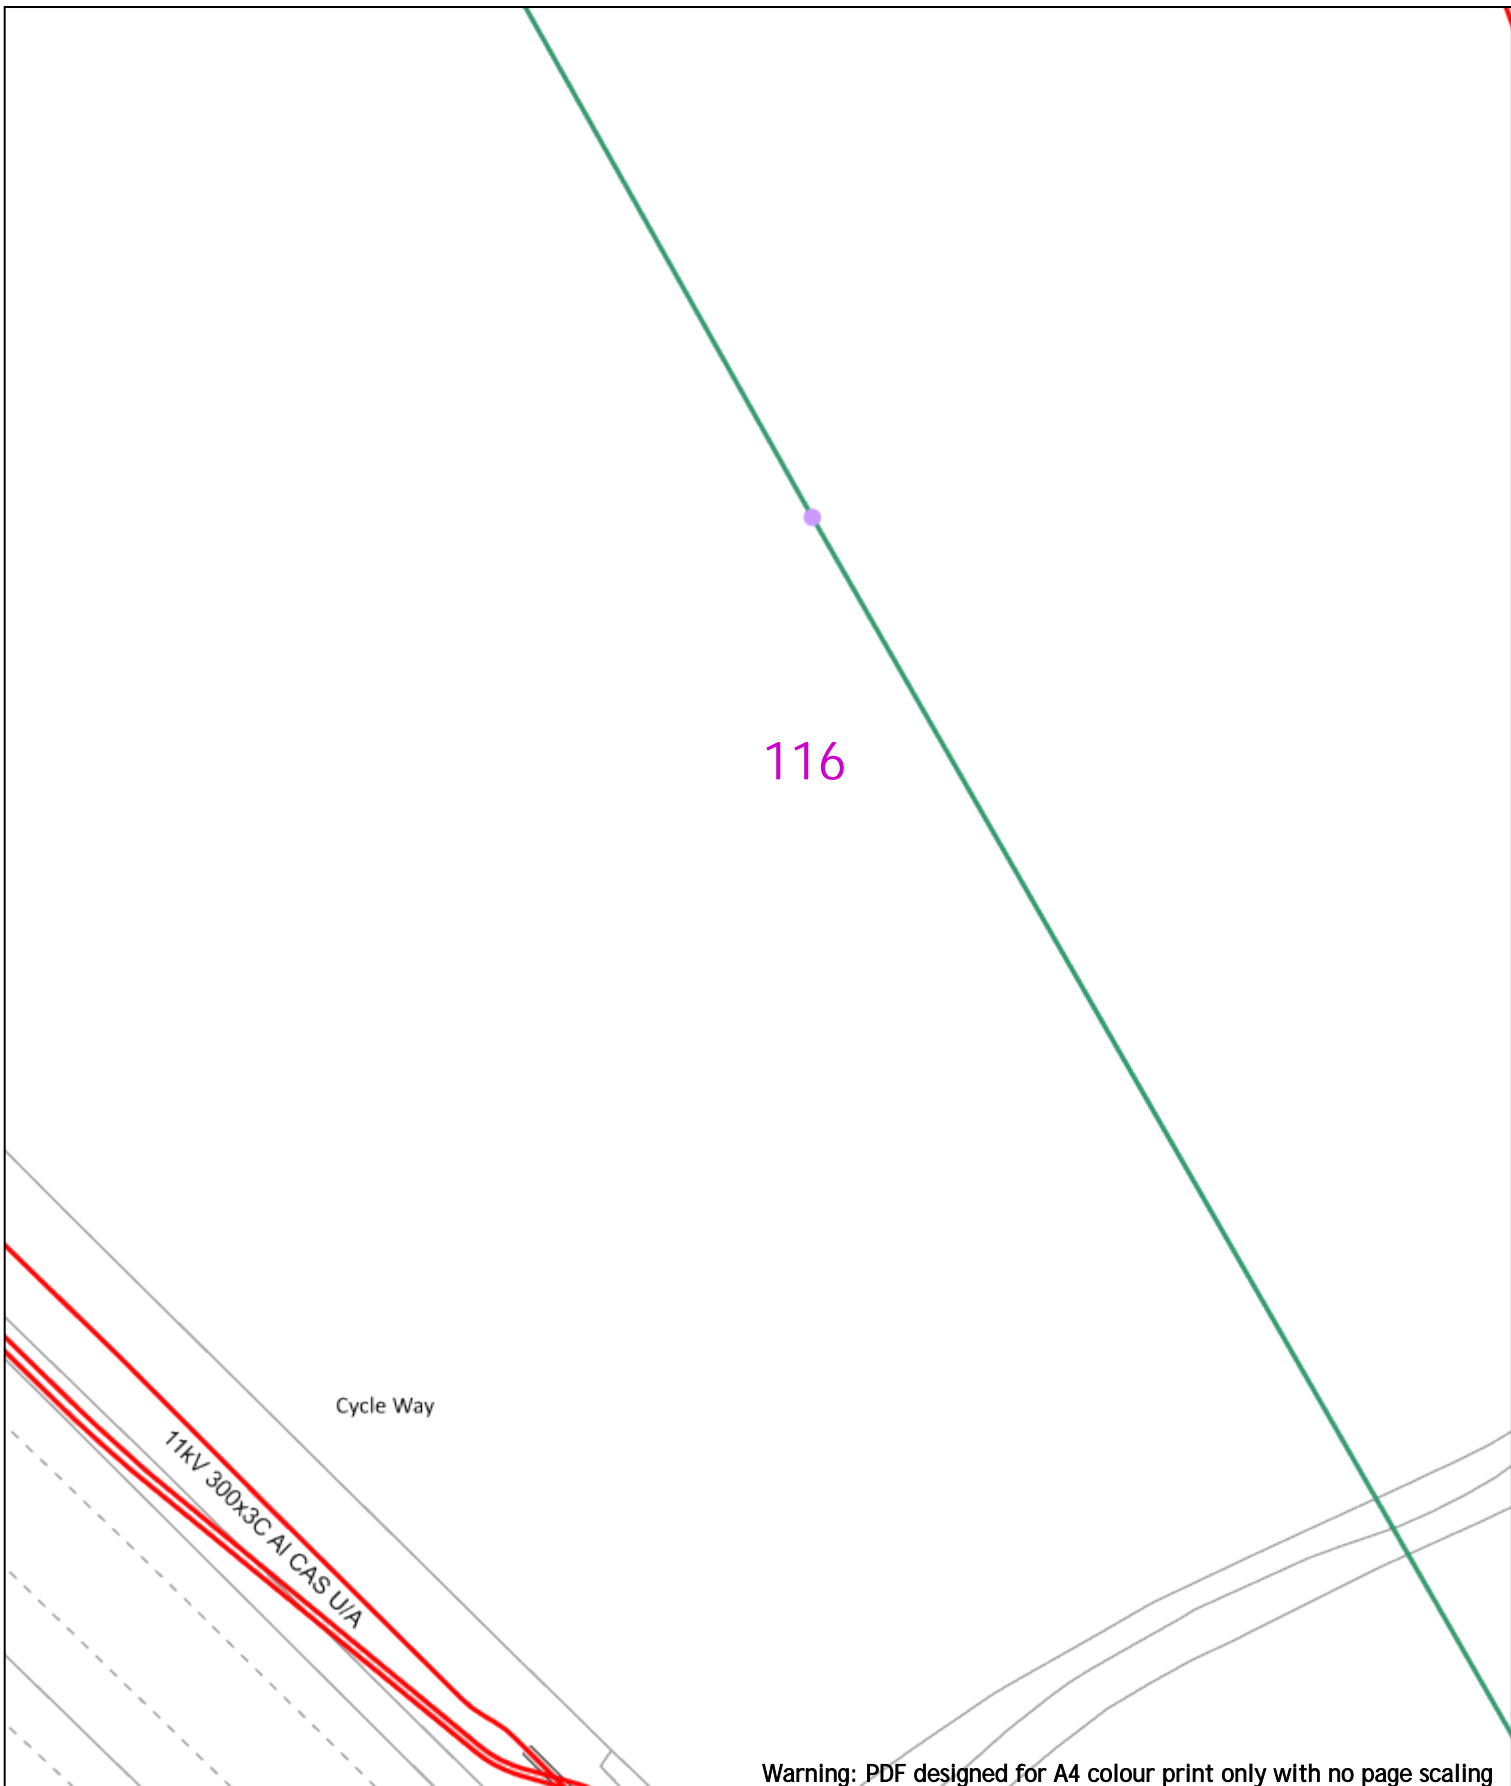

Warning: PDF designed for A4 colour print only with no page scaling



Dig Sites Area: [Dashed Purple Box] Line: [Dashed Purple Line]

**Extra High Voltage cables in vicinity**



Date Requested: 24/06/2022  
 Job Reference: 25881037  
 Site Location: 448662 213014  
 Requested by: Mr Joe Shawyer  
 Your Scheme/Reference: 31188\_003

Voltages (V)			
LV (Low Voltage) and Services	Up to 1,000V		
HV (High Voltage)	Over 1,000V to 11,000V		
EHV (Extra High Voltage)	22,000V to 132,000V		
Transmission	275,000V and 400,000V		
NORMAL DEPTH TO THE TOP OF THE CABLE WHEN LAID			
Services	LV	HV	EHV
Footpath/Unmade	0.45m	0.45m	0.6m
Road Crossing	0.6m	0.6m	0.75m
Agricultural	1m	1m	1.1m

Legend	


**Southern Electric Power Distribution plc**  
 Registered Office: No.1 Forbury Place  
 43 Forbury Road Reading RG1 3JH  
 Registered In England & Wales No.04094290

If you're unsure & need to seek advice before commencing excavations, please contact:  
 General Enquiries: 0800 048 3516

Scale: 1:500 (When plotted at A4)

**WARNING**  
 There may have been subsequent alteration to the surface levels. Trial holes must be undertaken to determine position and depths of cables. HS (G) 47 Booklet from the Health and Safety Executive - Avoiding Danger from Buried Cables - should be consulted before commencing excavation work.  
 WHEN WORKING IN THE VICINITY OF OVERHEAD LINES THE HEALTH AND SAFETY GUIDANCE NOTES G56 SHOULD BE CONSULTED (AVAILABLE FROM THE HSE WEBSITE)

Subject to revision - Master held by SSEN Asset Data Team:  
[Asset.Data@sse.com](mailto:Asset.Data@sse.com)  
 01256 337 294

Our Ref: 25881050      Your Ref: 31188\_004

Friday, 24 June 2022

Joe Shawyer  
Suite 6 Princess Caroline House 1 High Street  
Southend on Sea  
Essex  
SS1 1JE

Dear Joe Shawyer

**SSEN Distribution - Asset Network Plans**

We have sent you the plans of our network records within the area requested. You will shortly receive responses each of the following; any High Voltage Mains cables and Low Voltage Mains cables.


Attached to this email is the 'Guide to Interpreting' which includes the legends for the plans on pages 7-9.

If a Service Cable is not shown on our maps sent, and you require the Cable to be Traced, please contact the General Enquiries Department on 0800 048 3516 (option 3) or via email, [ge@ssen.co.uk](mailto:ge@ssen.co.uk)

If you need further information on our network in this area or a quotation for any required works, please contact the Connections & Engineering Department on 0800 048 3516 or via email, [connections@sse.com](mailto:connections@sse.com)

Kind Regards,

Asset Data Team  
01256 337 294  
[Asset.data@sse.com](mailto:Asset.data@sse.com)

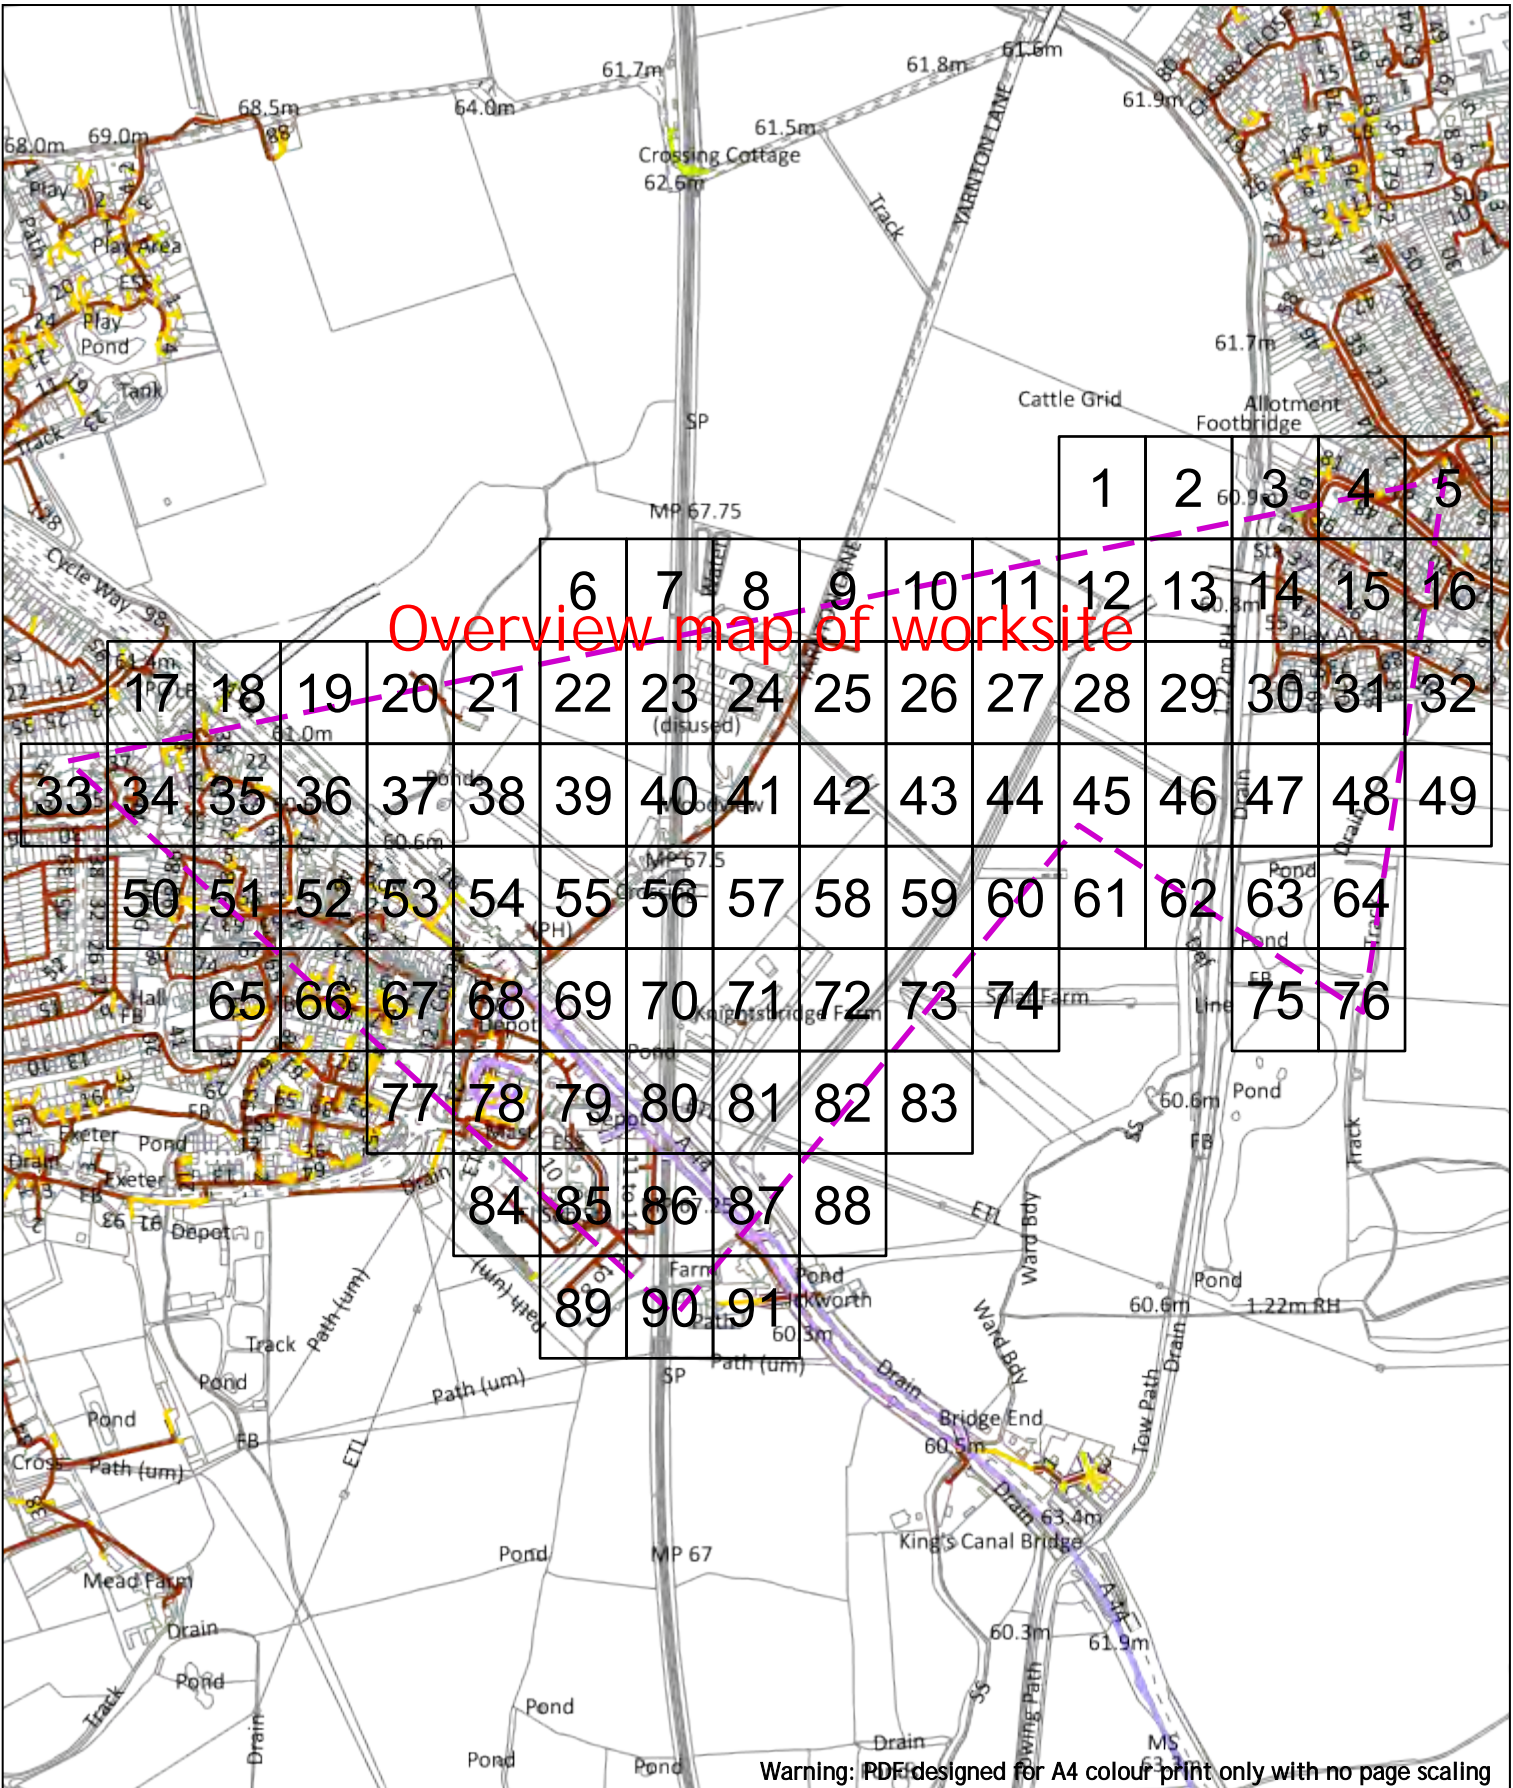

Dig Sites Area: Line:

Date Requested: 24/06/2022  
 Job Reference: 25881050  
 Site Location: 448447 212278  
 Requested by: Mr Joe Shawyer  
 Your Scheme/Reference: 31188\_004

Voltages (V)	
LV (Low Voltage) and Services	Up to 1,000V
HV (High Voltage)	Over 1,000V to 11,000V
EHV (Extra High Voltage)	22,000V to 132,000V
Transmission	275,000V and 400,000V

NORMAL DEPTH TO THE TOP OF THE CABLE WHEN LAID			
Services	LV	HV	EHV
Footpath/Unmade	0.45m	0.6m	0.8m
Road Crossing	0.6m	0.75m	0.9m
Agricultural	1m	1m	1.1m

**Legend**

- Service Cable
- LV Main
- 6.6kV
- 11kV
- 22kV
- 33kV
- 66kV
- 132kV
- 275kV
- 400kV
- Fibre Optic
- Road Cable

**Distribution Structures (Electric)**

- Pole, Existing Location
- Pole Structure, Existing Location - Single
- Pole Structure, Existing Location - e
- Duct Route
- Cross Section Route

**WARNING**

There may have been subsequent alteration to the surface levels. Trial holes must be undertaken to determine position and depths of cables. HS (G) 47 Booklet from the Health and Safety Executive - Avoiding Danger from Buried Cables - should be consulted before commencing excavation work.  
 WHEN WORKING IN THE VICINITY OF OVERHEAD LINES THE HEALTH AND SAFETY GUIDANCE NOTES G56 SHOULD BE CONSULTED (AVAILABLE FROM THE HSE WEBSITE)

Scale: 1:8712 (When plotted at A4)

**Southern Electric Power Distribution plc**  
 Registered Office: No.1 Forbury Place  
 43 Forbury Road Reading RG1 3JH  
 Registered In England & Wales No.04094290

If you're unsure & need to seek advice before commencing excavations, please contact:  
 General Enquiries: 0800 048 3516

Subject to revision - Master held by SSEN Asset Data Team:  
[Asset.Data@sse.com](mailto:Asset.Data@sse.com)  
 01256 337 294

Warning: PDF designed for A4 colour print only with no page scaling

0  20m Dig Sites Area:  Line: 



Date Requested: 24/06/2022  
 Job Reference: 25881050  
 Site Location: 448447 212278  
 Requested by: Mr Joe Shawyer  
 Your Scheme/Reference: 31188\_004

Voltages (V)			
LV (Low Voltage) and Services	Up to 1,000V		
HV (High Voltage)	Over 1,000V to 11,000V		
EHV (Extra High Voltage)	22,000V to 132,000V		
Transmission	275,000V and 400,000V		
NORMAL DEPTH TO THE TOP OF THE CABLE WHEN LAID			
Services	LV	HV	EHV
Footpath/Unmade	0.45m	0.45m	0.6m 0.8m
Road Crossing	0.6m	0.6m	0.75m 0.9m
Agricultural	1m	1m	1m 1.1m

**Legend**

- Service Cable
- LV Mains
- 2-33kV
- 6.6kV
- 11kV
- 22kV
- 33kV
- 66kV
- 132kV
- 275kV
- 400kV
- Fibre Optic
- Pilot Cable

**Distribution Structures (Electric)**

- Pole, Existing Location
- Pole Structure, Existing Location - Single
- Pole Structure, Existing Location - H
- Duct Route
- Cross Section Route

WARNING

There may have been subsequent alteration to the surface levels. Trial holes must be undertaken to determine position and depths of cables. HS (G) 47 Booklet from the Health and Safety Executive - Avoiding Danger from Buried Cables - should be consulted before commencing excavation work.

WHEN WORKING IN THE VICINITY OF OVERHEAD LINES THE HEALTH AND SAFETY GUIDANCE NOTES G56 SHOULD BE CONSULTED (AVAILABLE FROM THE HSE WEBSITE)

**Southern Electric Power Distribution plc**  
 Registered Office: No.1 Forbury Place  
 43 Forbury Road Reading RG1 3JH  
 Registered In England & Wales No.04094290

If you're unsure & need to seek advice before commencing excavations, please contact:  
 General Enquiries: 0800 048 3516

Subject to revision - Master held by SSEN Asset Data Team:  
[Asset.Data@sse.com](mailto:Asset.Data@sse.com)  
 01256 337 294

Warning: PDF designed for A4 colour print only with no page scaling

0  20m Dig Sites Area:  Line: 

Date Requested: 24/06/2022  
 Job Reference: 25881050  
 Site Location: 448447 212278  
 Requested by: Mr Joe Shawyer  
 Your Scheme/Reference: 31188\_004

Voltages (V)			
LV (Low Voltage) and Services	Up to 1,000V		
HV (High Voltage)	Over 1,000V to 11,000V		
EHV (Extra High Voltage)	22,000V to 132,000V		
Transmission	275,000V and 400,000V		
NORMAL DEPTH TO THE TOP OF THE CABLE WHEN LAID			
Services	LV	HV	EHV
Footpath/Unmade	0.45m	0.45m	0.6m 0.8m
Road Crossing	0.6m	0.6m	0.75m 0.9m
Agricultural	1m	1m	1m 1.1m

**Legend**

- Service Cable
- LV Mains
- 2-33kV
- 6.6kV
- 11kV
- 22kV
- 33kV
- 66kV
- 132kV
- 275kV
- 400kV
- Fibre Optic
- Pilot Cable

**Distribution Structures (Electric)**

- Pole, Existing Location
- Pole Structure, Existing Location - Single
- Pole Structure, Existing Location - H
- Duct Route
- Cross Section Route

Scale: 1:500 (When plotted at A4)


**WARNING**  
 There may have been subsequent alteration to the surface levels. Trial holes must be undertaken to determine position and depths of cables. HS (G) 47 Booklet from the Health and Safety Executive - Avoiding Danger from Buried Cables - should be consulted before commencing excavation work.  
**WHEN WORKING IN THE VICINITY OF OVERHEAD LINES THE HEALTH AND SAFETY GUIDANCE NOTES G56 SHOULD BE CONSULTED (AVAILABLE FROM THE HSE WEBSITE)**




**Southern Electric Power Distribution plc**  
 Registered Office: No.1 Forbury Place  
 43 Forbury Road Reading RG1 3JH  
 Registered In England & Wales No.04094290

If you're unsure & need to seek advice before commencing excavations, please contact:  
 General Enquiries: 0800 048 3516

Subject to revision – Master held by SSEN Asset Data Team:  
[Asset.Data@sse.com](mailto:Asset.Data@sse.com)  
 01256 337 294

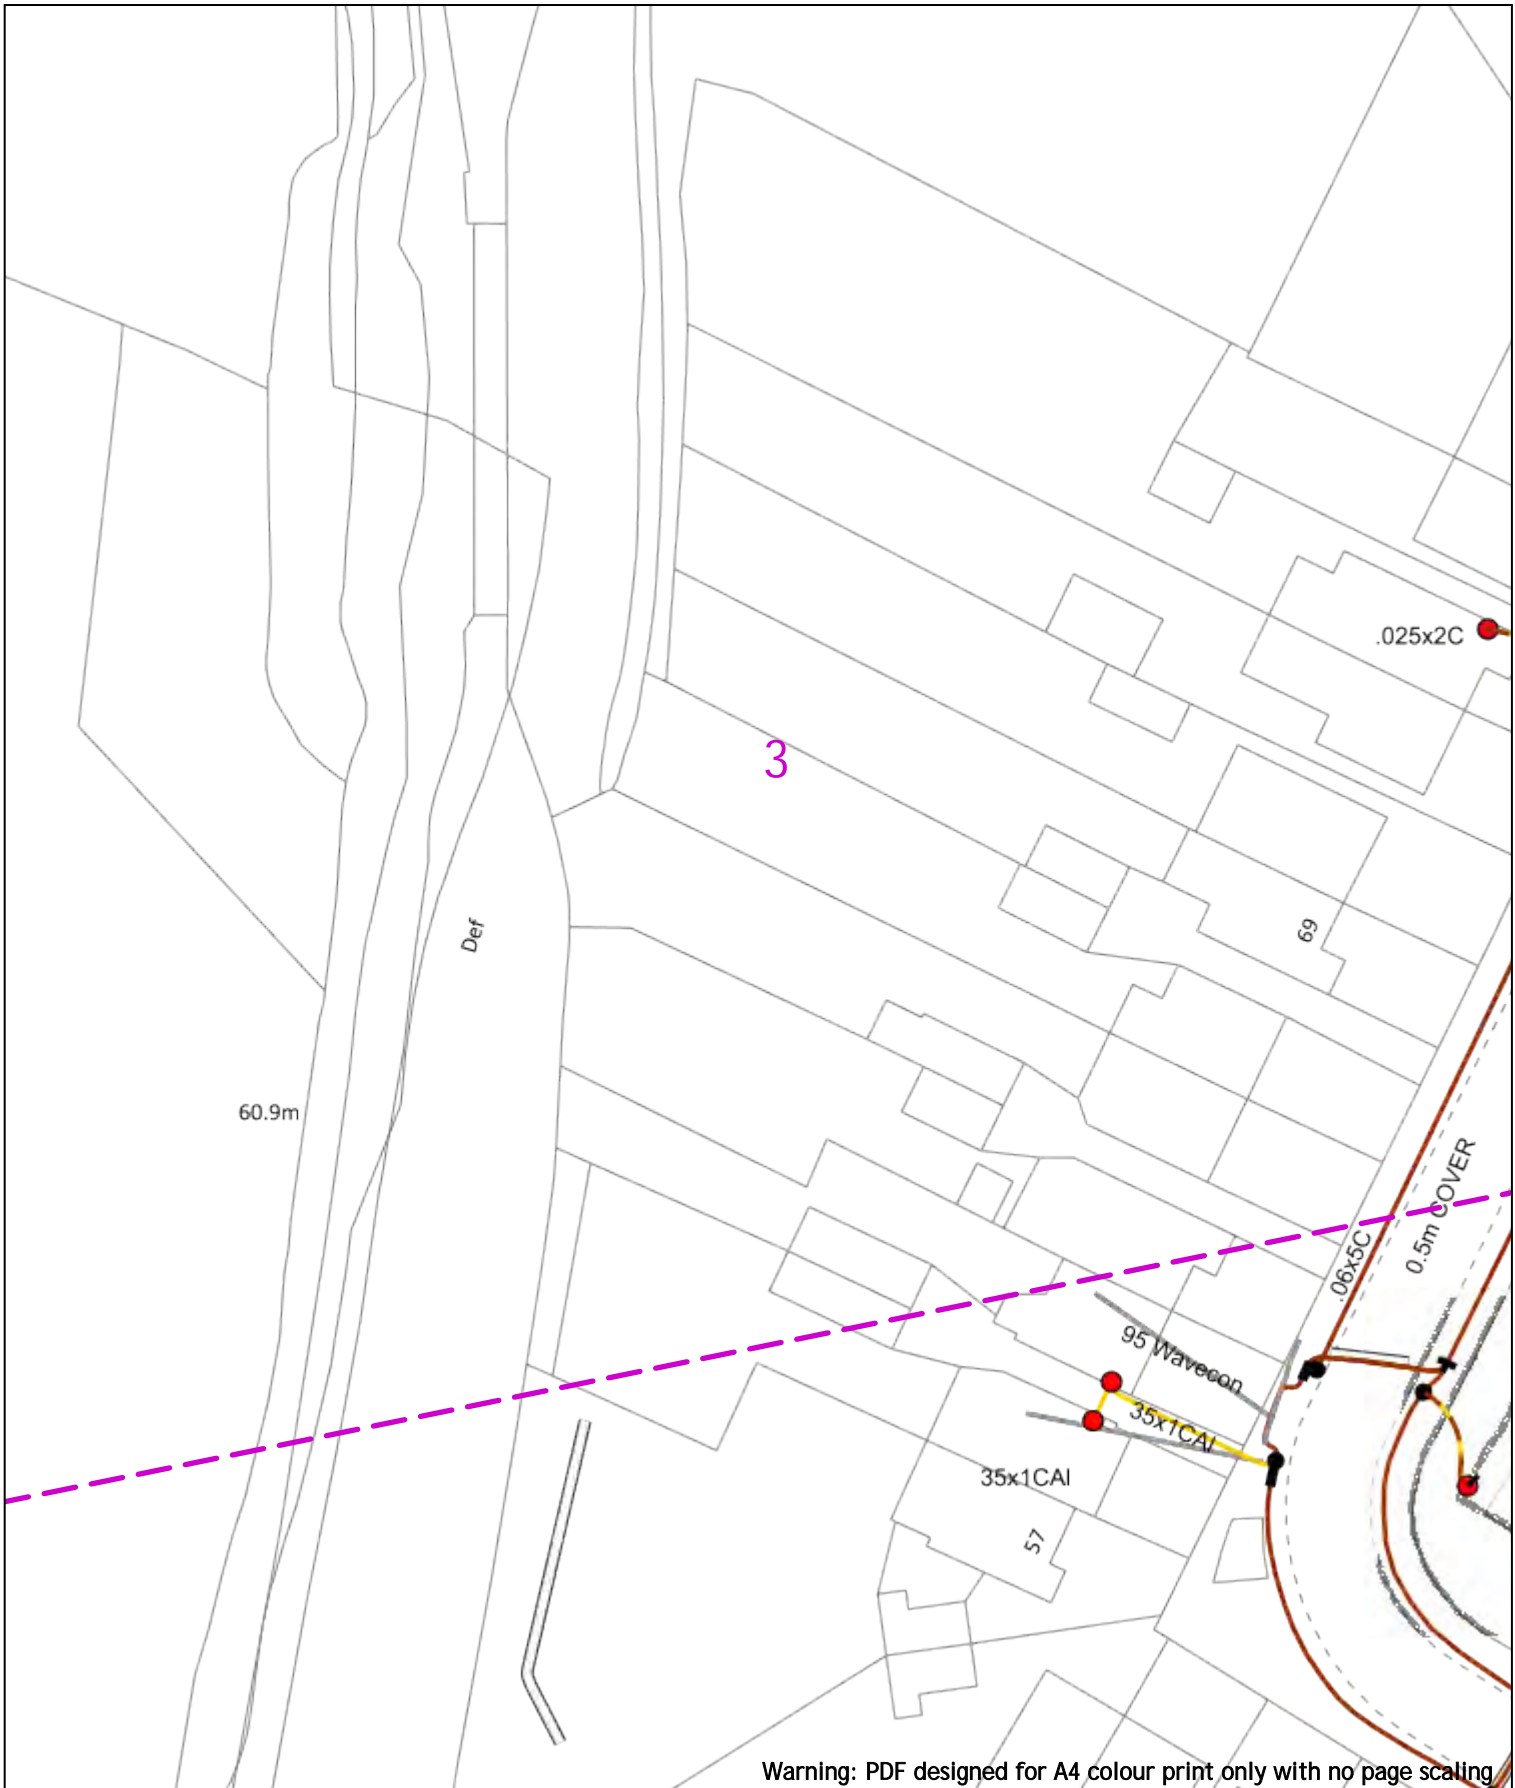

Warning: PDF designed for A4 colour print only with no page scaling

0 20m Dig Sites Area: Line:

Date Requested: 24/06/2022  
 Job Reference: 25881050  
 Site Location: 448447 212278  
 Requested by: Mr Joe Shawyer  
 Your Scheme/Reference: 31188\_004

Voltages (V)	
LV (Low Voltage) and Services	Up to 1,000V
HV (High Voltage)	Over 1,000V to 11,000V
EHV (Extra High Voltage)	22,000V to 132,000V
Transmission	275,000V and 400,000V

NORMAL DEPTH TO THE TOP OF THE CABLE WHEN LAID			
Services	LV	HV	EHV
Footpath/Unmade	0.45m	0.45m	0.6m
Road Crossing	0.6m	0.6m	0.75m
Agricultural	1m	1m	1.1m

**Legend**

- Service Cable
- LV Main
- 2-33kV
- 6.6kV
- 11kV
- 22kV
- 33kV
- 66kV
- 132kV
- 275kV
- 400kV
- Fibre Optic
- Pilot Cable

**Distribution Structures (Electric)**

- Pole, Existing Location
- Pole Structure, Existing Location - Single
- Pole Structure, Existing Location - 4
- Duct Route
- Cross Section Route


**WARNING**  
 There may have been subsequent alteration to the surface levels. Trial holes must be undertaken to determine position and depths of cables. HS (G) 47 Booklet from the Health and Safety Executive - Avoiding Danger from Buried Cables - should be consulted before commencing excavation work.  
 WHEN WORKING IN THE VICINITY OF OVERHEAD LINES THE HEALTH AND SAFETY GUIDANCE NOTES G56 SHOULD BE CONSULTED (AVAILABLE FROM THE HSE WEBSITE)

**Southern Electric Power Distribution plc**  
 Registered Office: No.1 Forbury Place  
 43 Forbury Road Reading RG1 3JH  
 Registered In England & Wales No.04094290

If you're unsure & need to seek advice before commencing excavations, please contact:  
 General Enquiries: 0800 048 3516

Subject to revision - Master held by SSEN Asset Data Team:  
[Asset.Data@sse.com](mailto:Asset.Data@sse.com)  
 01256 337 294



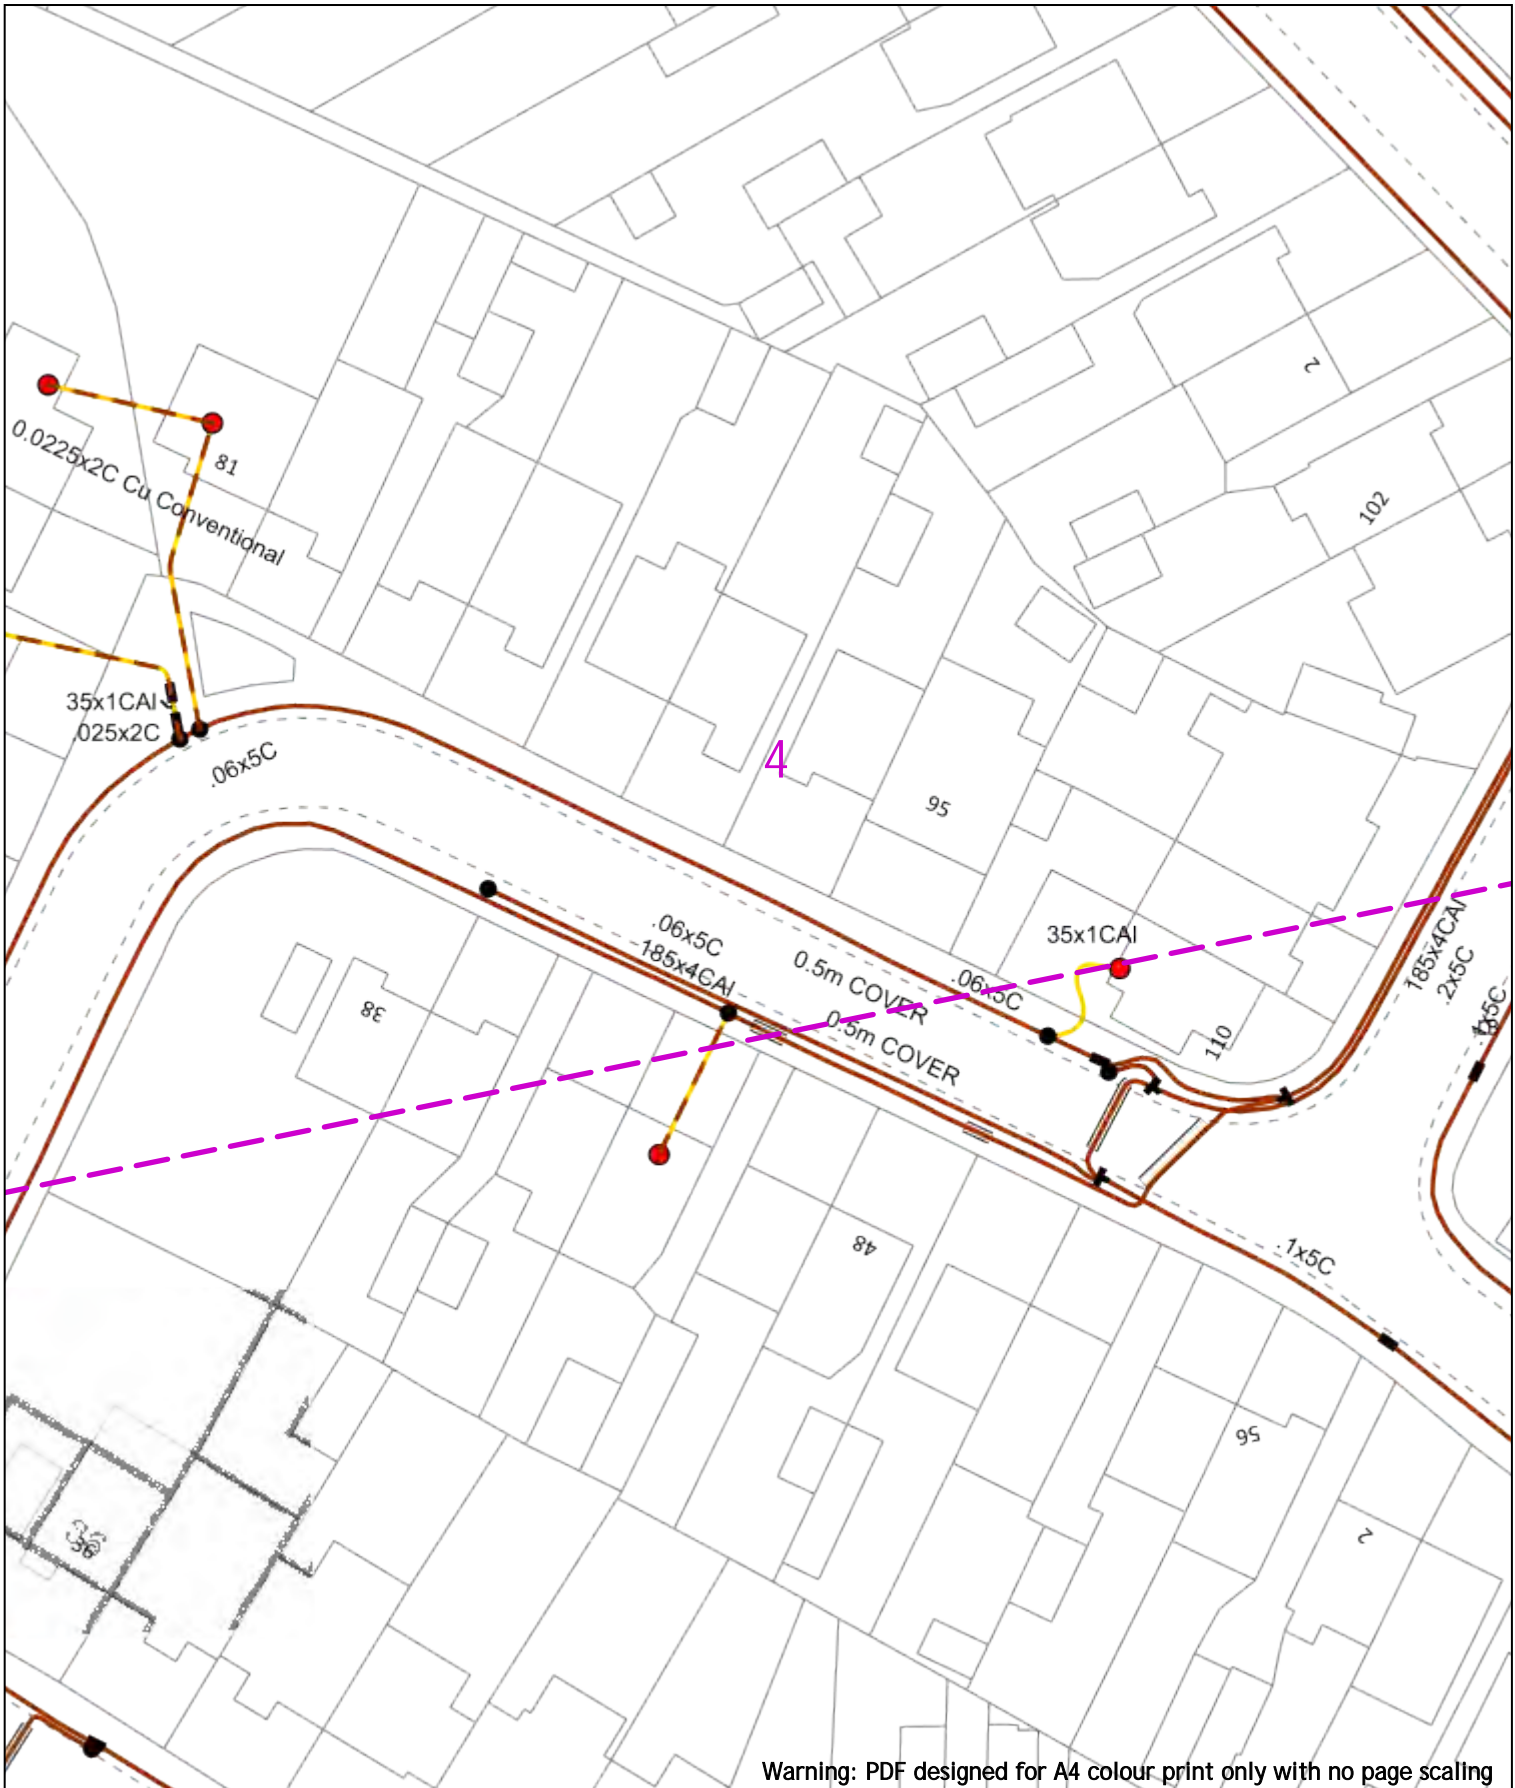

Warning: PDF designed for A4 colour print only with no page scaling

0 20m Dig Sites Area: Line:

Date Requested: 24/06/2022  
 Job Reference: 25881050  
 Site Location: 448447 212278  
 Requested by: Mr Joe Shawyer  
 Your Scheme/Reference: 31188\_004

Voltages (V)	
LV (Low Voltage) and Services	Up to 1,000V
HV (High Voltage)	Over 1,000V to 11,000V
EHV (Extra High Voltage)	22,000V to 132,000V
Transmission	275,000V and 400,000V


NORMAL DEPTH TO THE TOP OF THE CABLE WHEN LAID				
Services	LV	HV	EHV	
Footpath/Unmade	0.45m	0.45m	0.6m	0.8m
Road Crossing	0.6m	0.6m	0.75m	0.9m
Agricultural	1m	1m	1m	1.1m

**WARNING**  
 There may have been subsequent alteration to the surface levels. Trial holes must be undertaken to determine position and depths of cables. HS (G) 47 Booklet from the Health and Safety Executive – Avoiding Danger from Buried Cables – should be consulted before commencing excavation work.  
 WHEN WORKING IN THE VICINITY OF OVERHEAD LINES THE HEALTH AND SAFETY GUIDANCE NOTES G56 SHOULD BE CONSULTED (AVAILABLE FROM THE HSE WEBSITE)

**Southern Electric Power Distribution plc**  
 Registered Office: No.1 Forbury Place  
 43 Forbury Road Reading RG1 3JH  
 Registered In England & Wales No.04094290

If you're unsure & need to seek advice before commencing excavations, please contact:  
 General Enquiries: 0800 048 3516

Subject to revision – Master held by SSEN Asset Data Team:  
[Asset.Data@sse.com](mailto:Asset.Data@sse.com)  
 01256 337 294

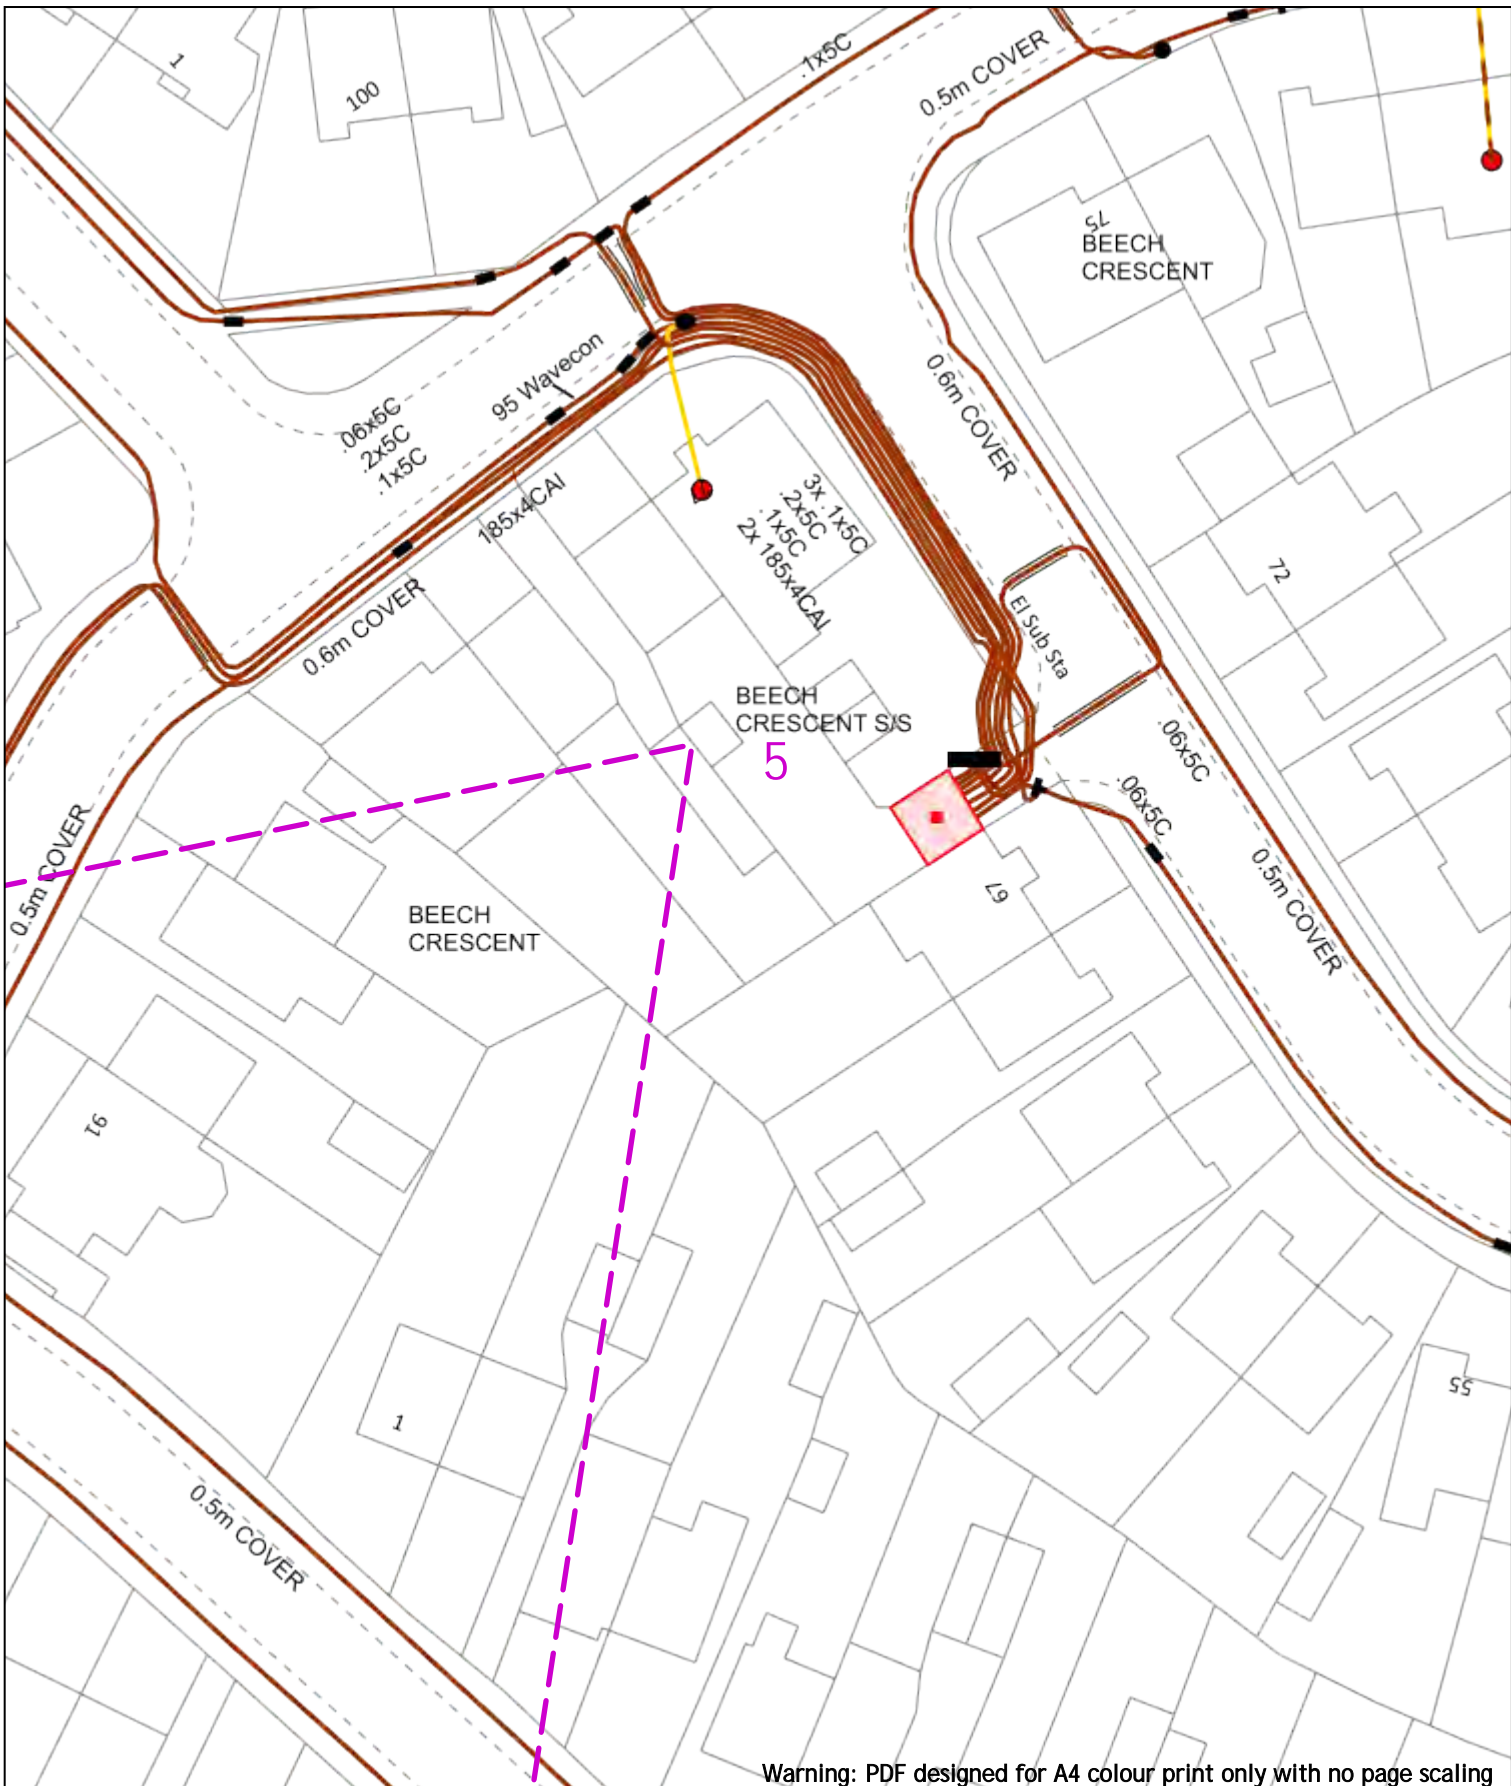

Warning: PDF designed for A4 colour print only with no page scaling

0 20m Dig Sites Area: Line:

Date Requested: 24/06/2022  
 Job Reference: 25881050  
 Site Location: 448447 212278  
 Requested by: Mr Joe Shawyer  
 Your Scheme/Reference: 31188\_004

Voltages (V)	
LV (Low Voltage) and Services	Up to 1,000V
HV (High Voltage)	Over 1,000V to 11,000V
EHV (Extra High Voltage)	22,000V to 132,000V
Transmission	275,000V and 400,000V

NORMAL DEPTH TO THE TOP OF THE CABLE WHEN LAID			
Services	LV	HV	EHV
Footpath/Unmade	0.45m	0.45m	0.6m
Road Crossing	0.6m	0.6m	0.75m
Agricultural	1m	1m	1.1m

Legend	
	Service Cable
	LV Mains
	2-13kV
	6.6kV
	11kV
	22kV
	33kV
	66kV
	132kV
	275kV
	400kV
	Fibre Optic
	Road Cable

Distribution Structures (Electric)	
	Pole, Existing Location
	Pole Structure, Existing Location - Single
	Pole Structure, Existing Location - m
	Duct Route
	Cross Section Route

**WARNING**  
 There may have been subsequent alteration to the surface levels. Trial holes must be undertaken to determine position and depths of cables. HS (G) 47 Booklet from the Health and Safety Executive - Avoiding Danger from Buried Cables - should be consulted before commencing excavation work.  
 WHEN WORKING IN THE VICINITY OF OVERHEAD LINES THE HEALTH AND SAFETY GUIDANCE NOTES G56 SHOULD BE CONSULTED (AVAILABLE FROM THE HSE WEBSITE)

Scale: 1:500 (When plotted at A4)

**Southern Electric Power Distribution plc**  
 Registered Office: No.1 Forbury Place  
 43 Forbury Road Reading RG1 3JH  
 Registered in England & Wales No.04094290

If you're unsure & need to seek advice before commencing excavations, please contact:  
 General Enquiries: 0800 048 3516

Subject to revision - Master held by SSEN Asset Data Team:  
[Asset.Data@sse.com](mailto:Asset.Data@sse.com)  
 01256 337 294

BASED UPON THE ORDNANCE SURVEY MAP WITH THE SANCTION OF THE CONTROLLER OF HM STATIONERY OFFICE CROWN COPYRIGHT RESERVED.  
 This copy has been made by or with the authority of Scottish and Southern Energy Power Distribution Ltd. Pursuant to section 47 of the Copyright, Designs and Patents Act 1988 ("The Act"). Unless the Act provides a relevant exception to copyright the copy must not be copied without the permission of the copyright owner.  
 Plans generated by DigSAFE Pro™ software provided by Linearcableforeddg.

6



Warning: PDF designed for A4 colour print only with no page scaling

0 20m Dig Sites Area: Line:



Date Requested: 24/06/2022  
 Job Reference: 25881050  
 Site Location: 448447 212278  
 Requested by: Mr Joe Shawyer  
 Your Scheme/Reference: 31188\_004

Voltages (V)			
LV (Low Voltage) and Services	Up to 1,000V		
HV (High Voltage)	Over 1,000V to 11,000V		
EHV (Extra High Voltage)	22,000V to 132,000V		
Transmission	275,000V and 400,000V		
NORMAL DEPTH TO THE TOP OF THE CABLE WHEN LAID			
Services	LV	HV	EHV
Footpath/Unmade	0.45m	0.45m	0.6m 0.8m
Road Crossing	0.6m	0.6m	0.75m 0.9m
Agricultural	1m	1m	1m 1.1m

Location</li> <li> Pole Structure, Existing Location - Single</li> <li> Pole Structure, Existing Location - H</li> <li> Duct Route</li> <li> Cross Section Route</li> </ul>
--	---


**WARNING**  
 There may have been subsequent alteration to the surface levels. Trial holes must be undertaken to determine position and depths of cables. HS (G) 47 Booklet from the Health and Safety Executive - Avoiding Danger from Buried Cables - should be consulted before commencing excavation work.  
**WHEN WORKING IN THE VICINITY OF OVERHEAD LINES THE HEALTH AND SAFETY GUIDANCE NOTES G56 SHOULD BE CONSULTED (AVAILABLE FROM THE HSE WEBSITE)**

**Southern Electric Power Distribution plc**  
 Registered Office: No.1 Forbury Place  
 43 Forbury Road Reading RG1 3JH  
 Registered In England & Wales No.04094290

If you're unsure & need to seek advice before commencing excavations, please contact:  
 General Enquiries: 0800 048 3516

Subject to revision - Master held by SSEN Asset Data Team:  
[Asset.Data@sse.com](mailto:Asset.Data@sse.com)  
 01256 337 294

Scale: 1:500 (When plotted at A4)

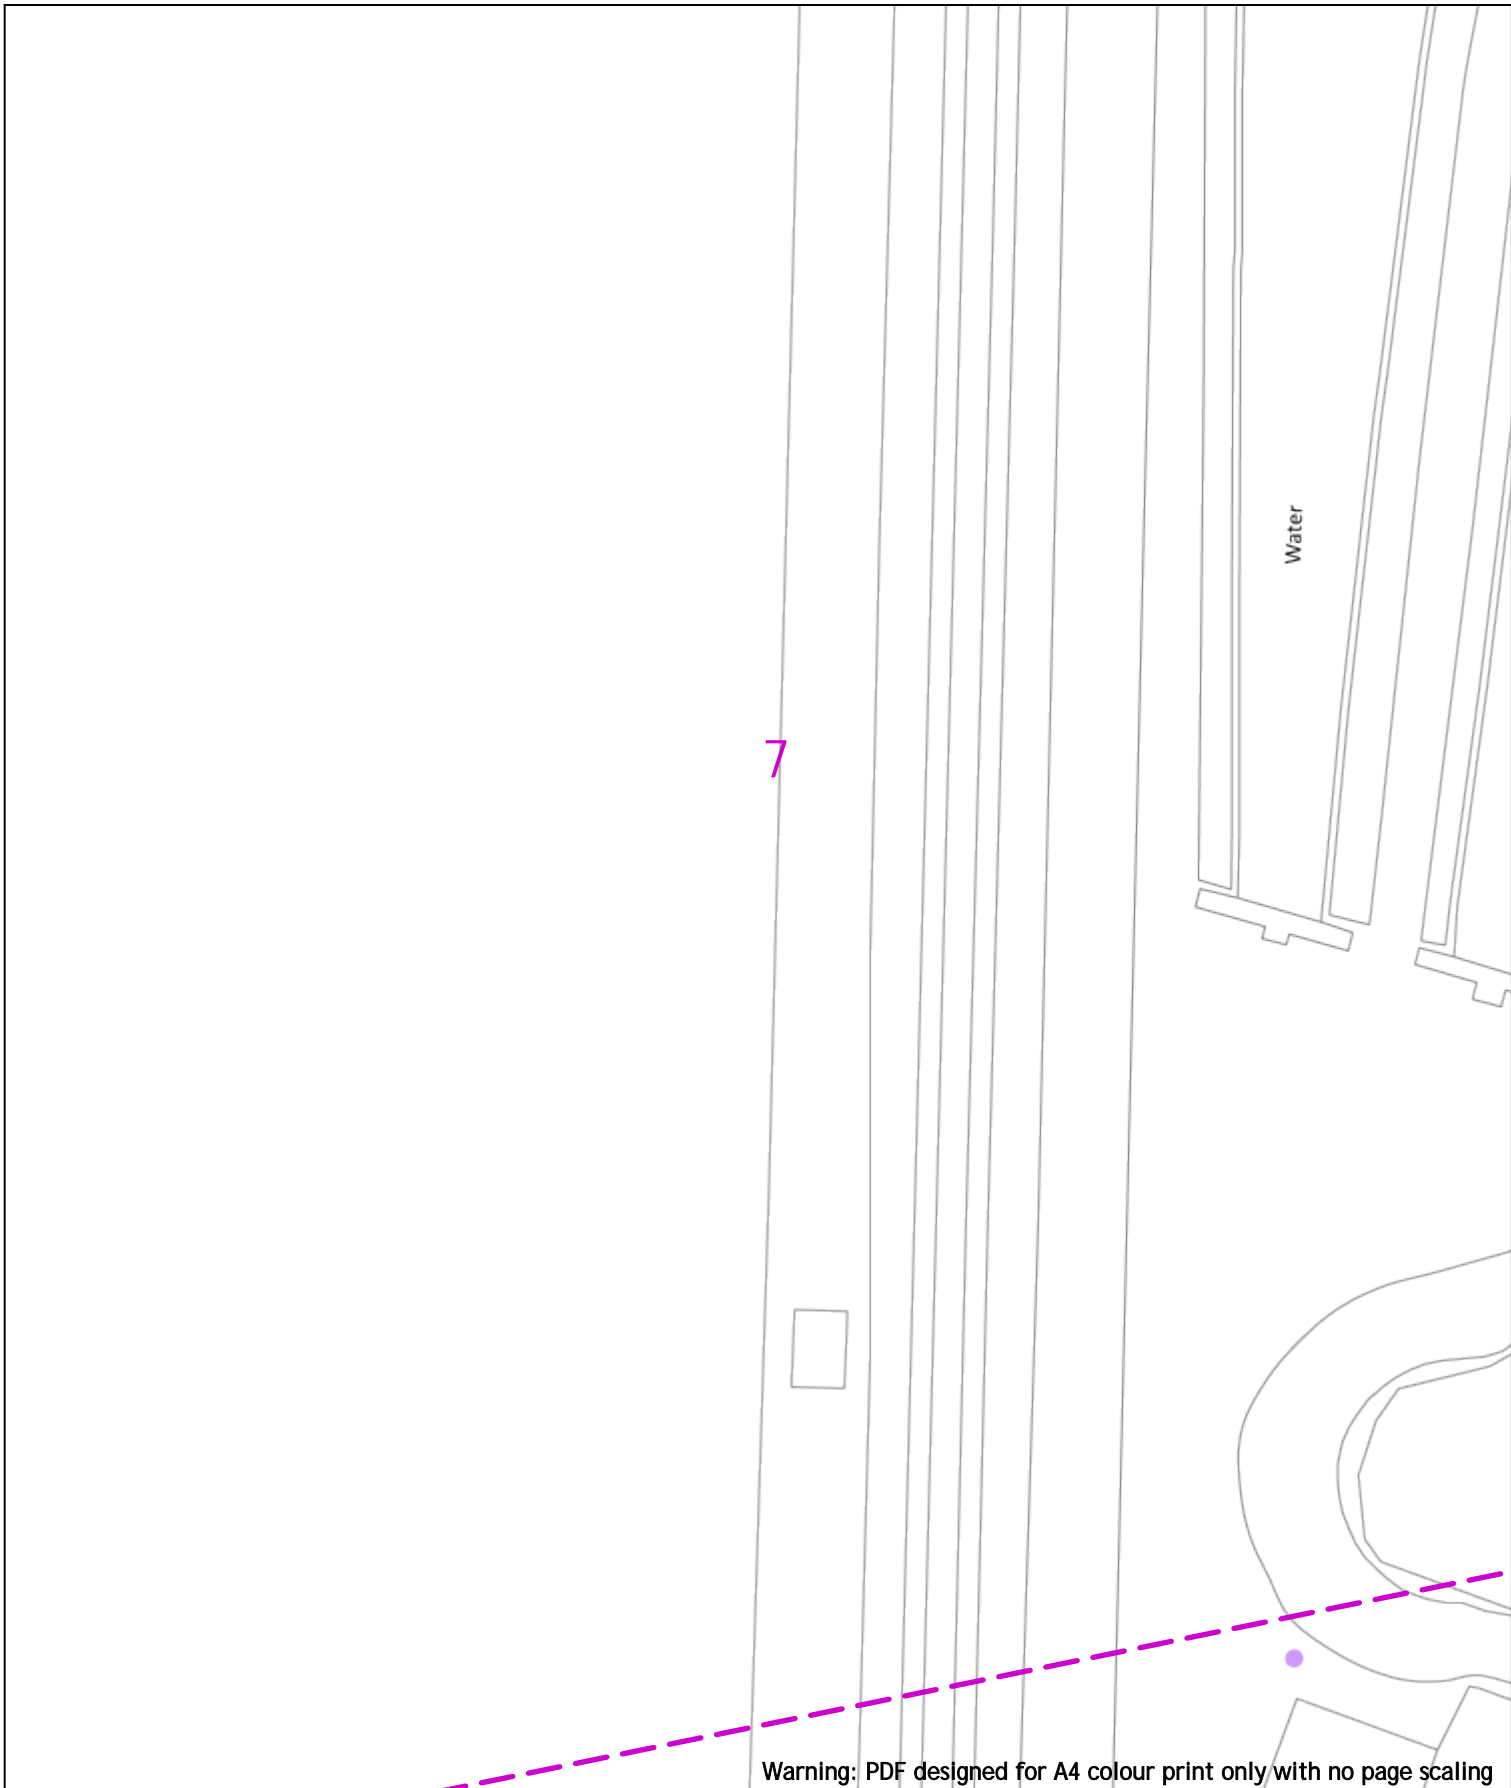

Warning: PDF designed for A4 colour print only with no page scaling

0 20m Dig Sites Area: Line:

Date Requested: 24/06/2022  
 Job Reference: 25881050  
 Site Location: 448447 212278  
 Requested by: Mr Joe Shawyer  
 Your Scheme/Reference: 31188\_004

Voltages (V)	
LV (Low Voltage) and Services	Up to 1,000V
HV (High Voltage)	Over 1,000V to 11,000V
EHV (Extra High Voltage)	22,000V to 132,000V
Transmission	275,000V and 400,000V

NORMAL DEPTH TO THE TOP OF THE CABLE WHEN LAID			
Services	LV	HV	EHV
Footpath/Unmade	0.45m	0.45m	0.8m
Road Crossing	0.6m	0.6m	0.9m
Agricultural	1m	1m	1.1m

**Legend**

- Service Cable
- LV Main
- 2-33kV
- 6.6kV
- 11kV
- 22kV
- 33kV
- 66kV
- 132kV
- 275kV
- 400kV
- Fibre Optic
- Road Cable

**Distribution Structures (Electric)**

- Pole, Existing Location
- Pole Structure, Existing Location - Single
- Pole Structure, Existing Location - H
- Duct Route
- Cross Section Route


**WARNING**  
 There may have been subsequent alteration to the surface levels. Trial holes must be undertaken to determine position and depths of cables. HS (G) 47 Booklet from the Health and Safety Executive - Avoiding Danger from Buried Cables - should be consulted before commencing excavation work.  
 WHEN WORKING IN THE VICINITY OF OVERHEAD LINES THE HEALTH AND SAFETY GUIDANCE NOTES G56 SHOULD BE CONSULTED (AVAILABLE FROM THE HSE WEBSITE)

Scale: 1:500 (When plotted at A4)

**Southern Electric Power Distribution plc**  
 Registered Office: No.1 Forbury Place  
 43 Forbury Road Reading RG1 3JH  
 Registered In England & Wales No.04094290

If you're unsure & need to seek advice before commencing excavations, please contact:  
 General Enquiries: 0800 048 3516

Subject to revision - Master held by SSEN Asset Data Team:  
[Asset.Data@sse.com](mailto:Asset.Data@sse.com)  
 01256 337 294

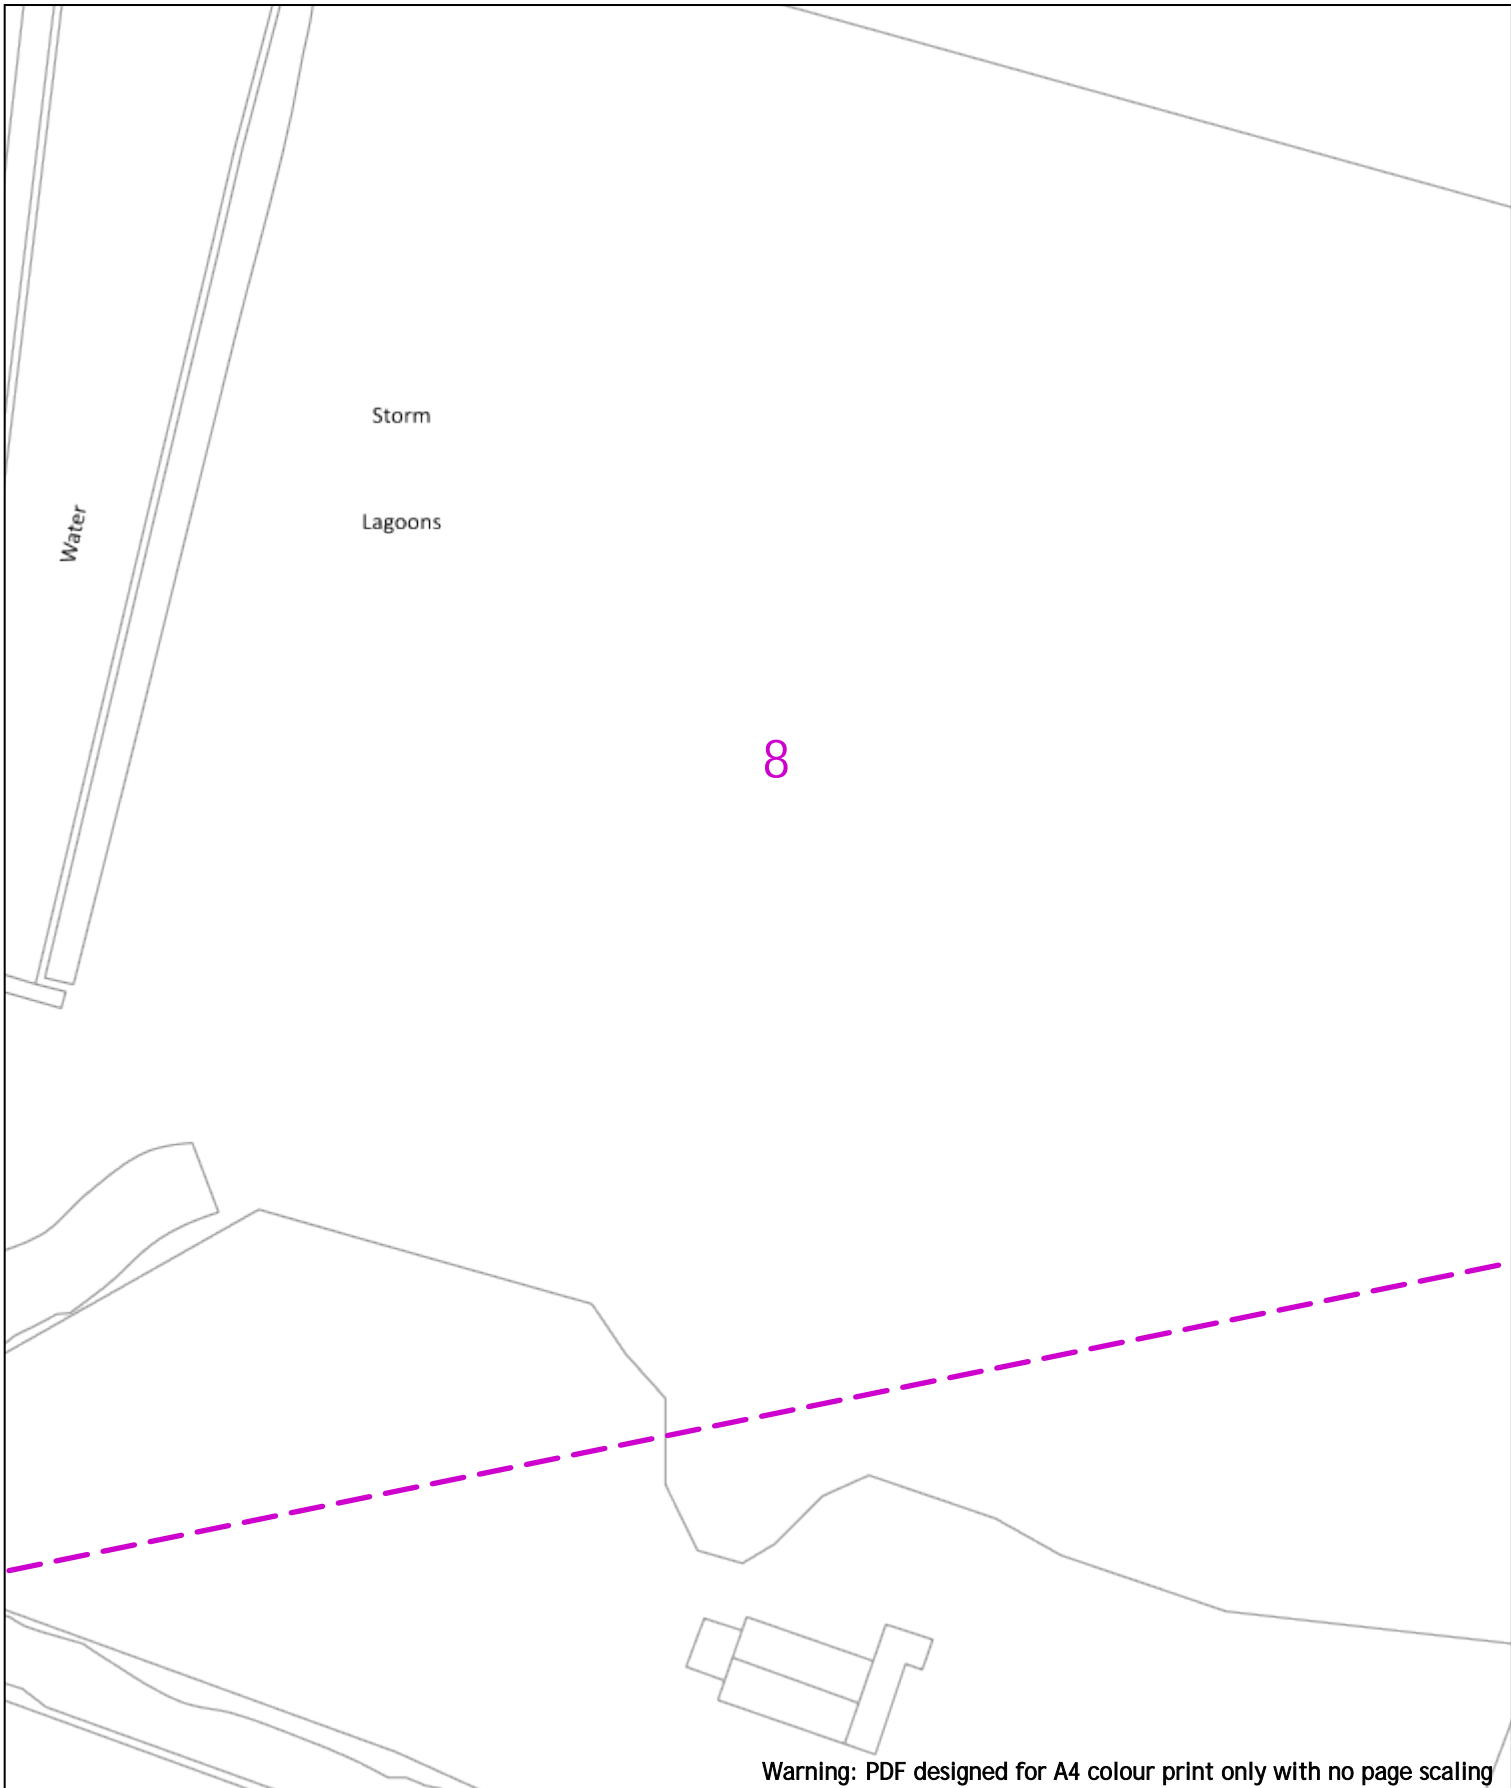

Warning: PDF designed for A4 colour print only with no page scaling

0 20m Dig Sites Area: Line:

Date Requested: 24/06/2022  
 Job Reference: 25881050  
 Site Location: 448447 212278  
 Requested by: Mr Joe Shawyer  
 Your Scheme/Reference: 31188\_004

Voltages (V)			
LV (Low Voltage) and Services	Up to 1,000V		
HV (High Voltage)	Over 1,000V to 11,000V		
EHV (Extra High Voltage)	22,000V to 132,000V		
Transmission	275,000V and 400,000V		

NORMAL DEPTH TO THE TOP OF THE CABLE WHEN LAID			
Services	LV	HV	EHV
Footpath/Unmade	0.45m	0.45m	0.8m
Road Crossing	0.6m	0.6m	0.9m
Agricultural	1m	1m	1.1m

**Legend**

- Service Cable
- LV Mains
- 2-33kV
- 66kV
- 11kV
- 22kV
- 33kV
- 66kV
- 132kV
- 275kV
- 400kV
- Fibre Optic
- Road Cable

**Distribution Structures (Electric)**

- Pole, Existing Location
- Pole Structure, Existing Location - Single
- Pole Structure, Existing Location - H
- Duct Route
- Cross Section Route


**WARNING**  
 There may have been subsequent alteration to the surface levels. Trial holes must be undertaken to determine position and depths of cables. HS (G) 47 Booklet from the Health and Safety Executive - Avoiding Danger from Buried Cables - should be consulted before commencing excavation work.  
 WHEN WORKING IN THE VICINITY OF OVERHEAD LINES THE HEALTH AND SAFETY GUIDANCE NOTES G56 SHOULD BE CONSULTED (AVAILABLE FROM THE HSE WEBSITE)

Scale: 1:500 (When plotted at A4)

**Southern Electric Power Distribution plc**  
 Registered Office: No.1 Forbury Place  
 43 Forbury Road Reading RG1 3JH  
 Registered In England & Wales No.04094290

If you're unsure & need to seek advice before commencing excavations, please contact:  
 General Enquiries: 0800 048 3516

Subject to revision - Master held by SSEN Asset Data Team:  
[Asset.Data@sse.com](mailto:Asset.Data@sse.com)  
 01256 337 294

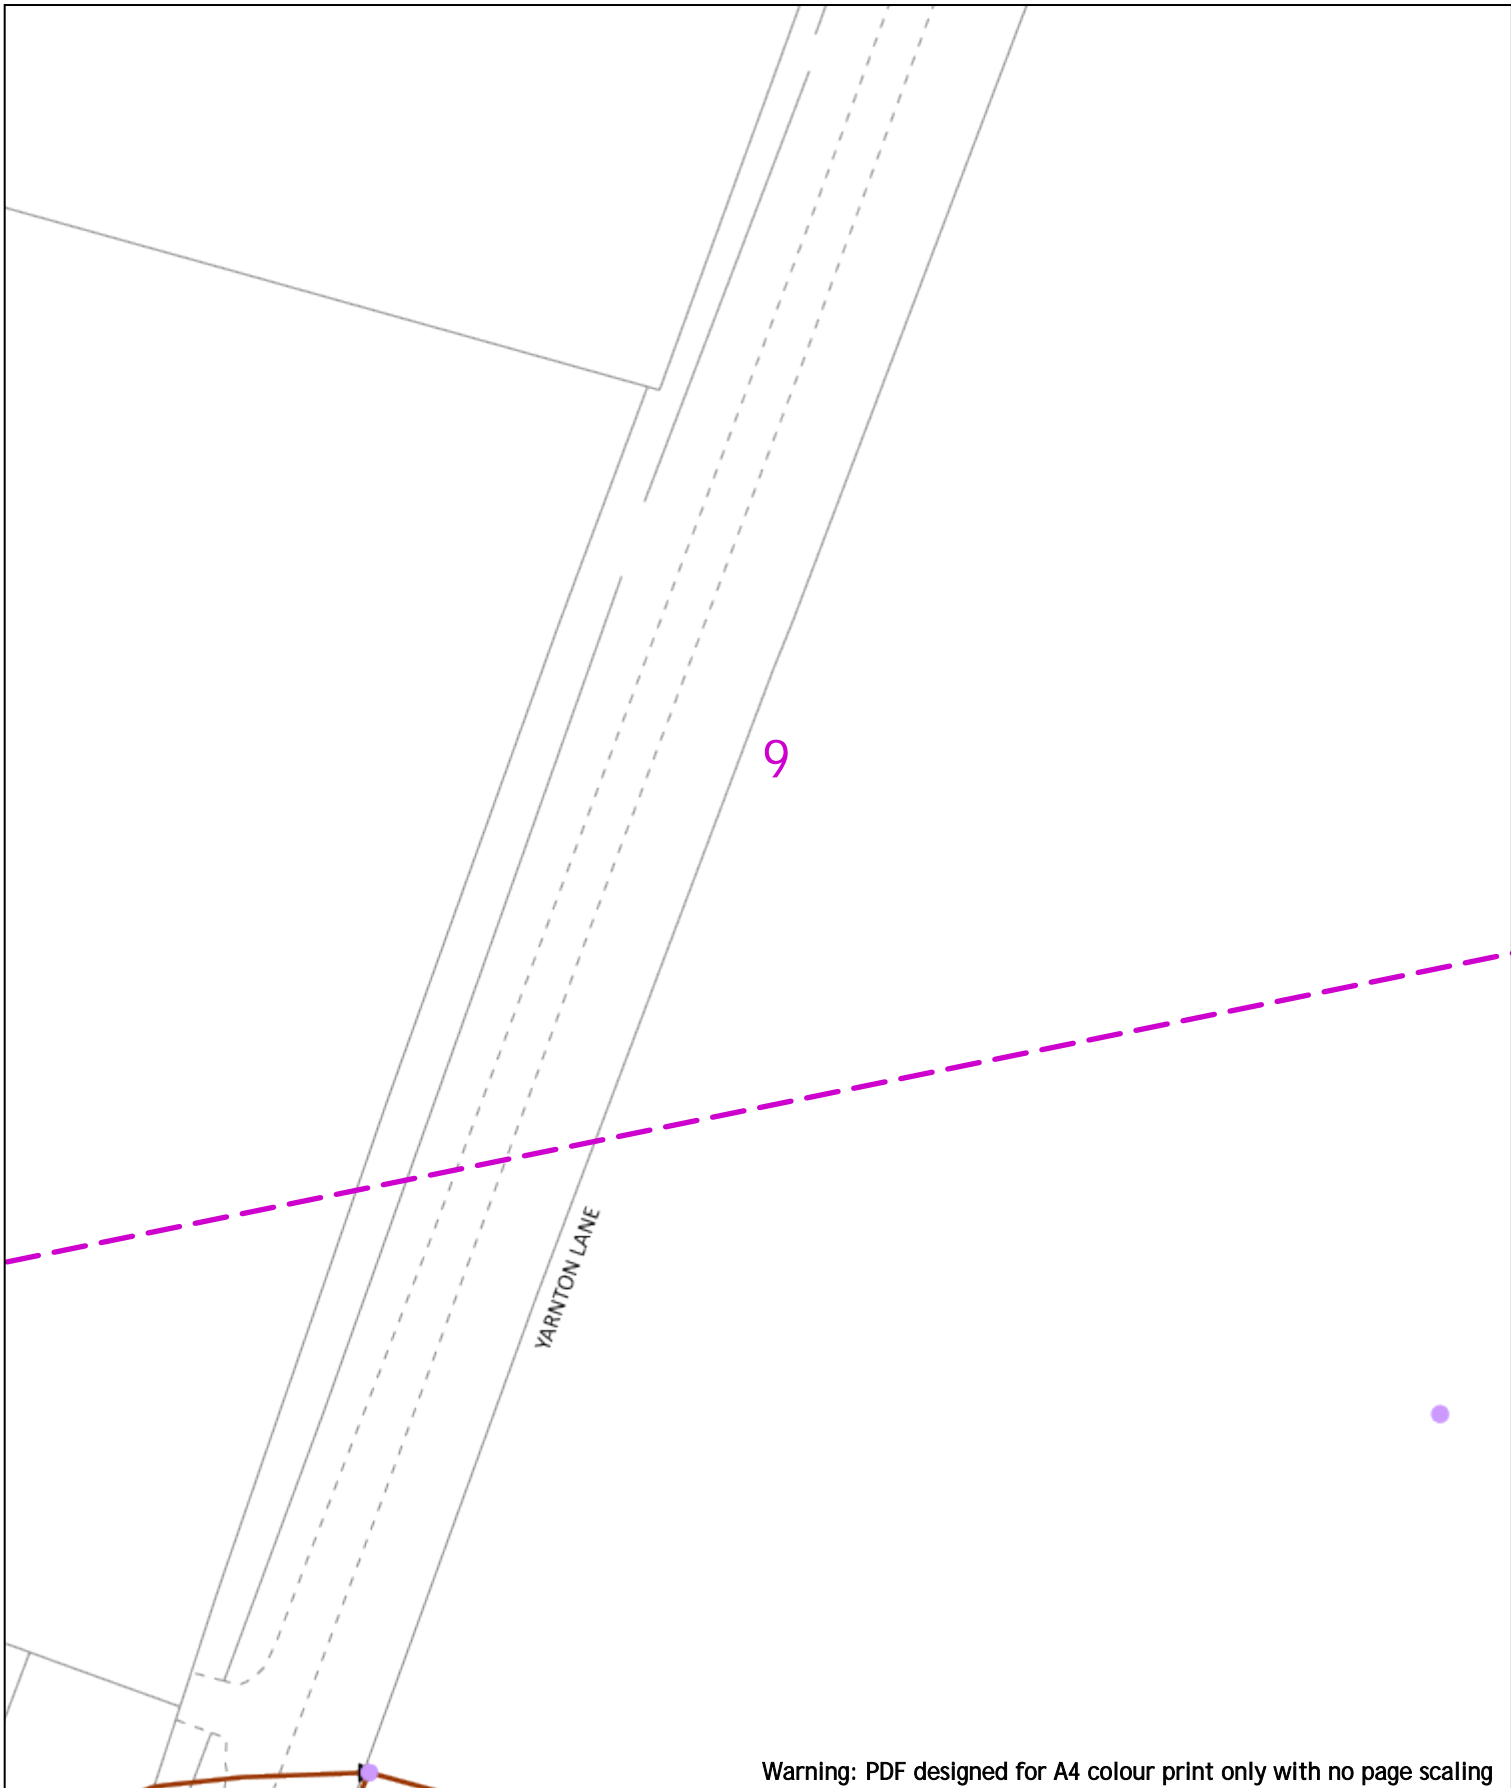

Warning: PDF designed for A4 colour print only with no page scaling

0 20m Dig Sites Area: Line:

Date Requested: 24/06/2022  
 Job Reference: 25881050  
 Site Location: 448447 212278  
 Requested by: Mr Joe Shawyer  
 Your Scheme/Reference: 31188\_004

Voltages (V)				
LV (Low Voltage) and Services	Up to 1,000V			
HV (High Voltage)	Over 1,000V to 11,000V			
EHV (Extra High Voltage)	22,000V to 132,000V			
Transmission	275,000V and 400,000V			

NORMAL DEPTH TO THE TOP OF THE CABLE WHEN LAID				
Services	LV	HV	EHV	
Footpath/Unmade	0.45m	0.45m	0.6m	0.8m
Road Crossing	0.6m	0.6m	0.75m	0.9m
Agricultural	1m	1m	1m	1.1m

**Legend**

- Service Cable
- LV Mains
- 2-33kV
- 6.6kV
- 11kV
- 22kV
- 33kV
- 66kV
- 132kV
- 275kV
- 400kV
- Fibre Optic
- Road Cable

**Distribution Structures (Electric)**

- Pole, Existing Location
- Pole Structure, Existing Location - Single
- Pole Structure, Existing Location - H
- Duct Route
- Cross Section Route


**WARNING**  
 There may have been subsequent alteration to the surface levels. Trial holes must be undertaken to determine position and depths of cables. HS (G) 47 Booklet from the Health and Safety Executive - Avoiding Danger from Buried Cables - should be consulted before commencing excavation work.  
 WHEN WORKING IN THE VICINITY OF OVERHEAD LINES THE HEALTH AND SAFETY GUIDANCE NOTES G56 SHOULD BE CONSULTED (AVAILABLE FROM THE HSE WEBSITE)

Scale: 1:500 (When plotted at A4)

**Southern Electric Power Distribution plc**  
 Registered Office: No.1 Forbury Place  
 43 Forbury Road Reading RG1 3JH  
 Registered In England & Wales No.04094290

If you're unsure & need to seek advice before commencing excavations, please contact:  
 General Enquiries: 0800 048 3516

Subject to revision - Master held by SSEN Asset Data Team:  
[Asset.Data@sse.com](mailto:Asset.Data@sse.com)  
 01256 337 294

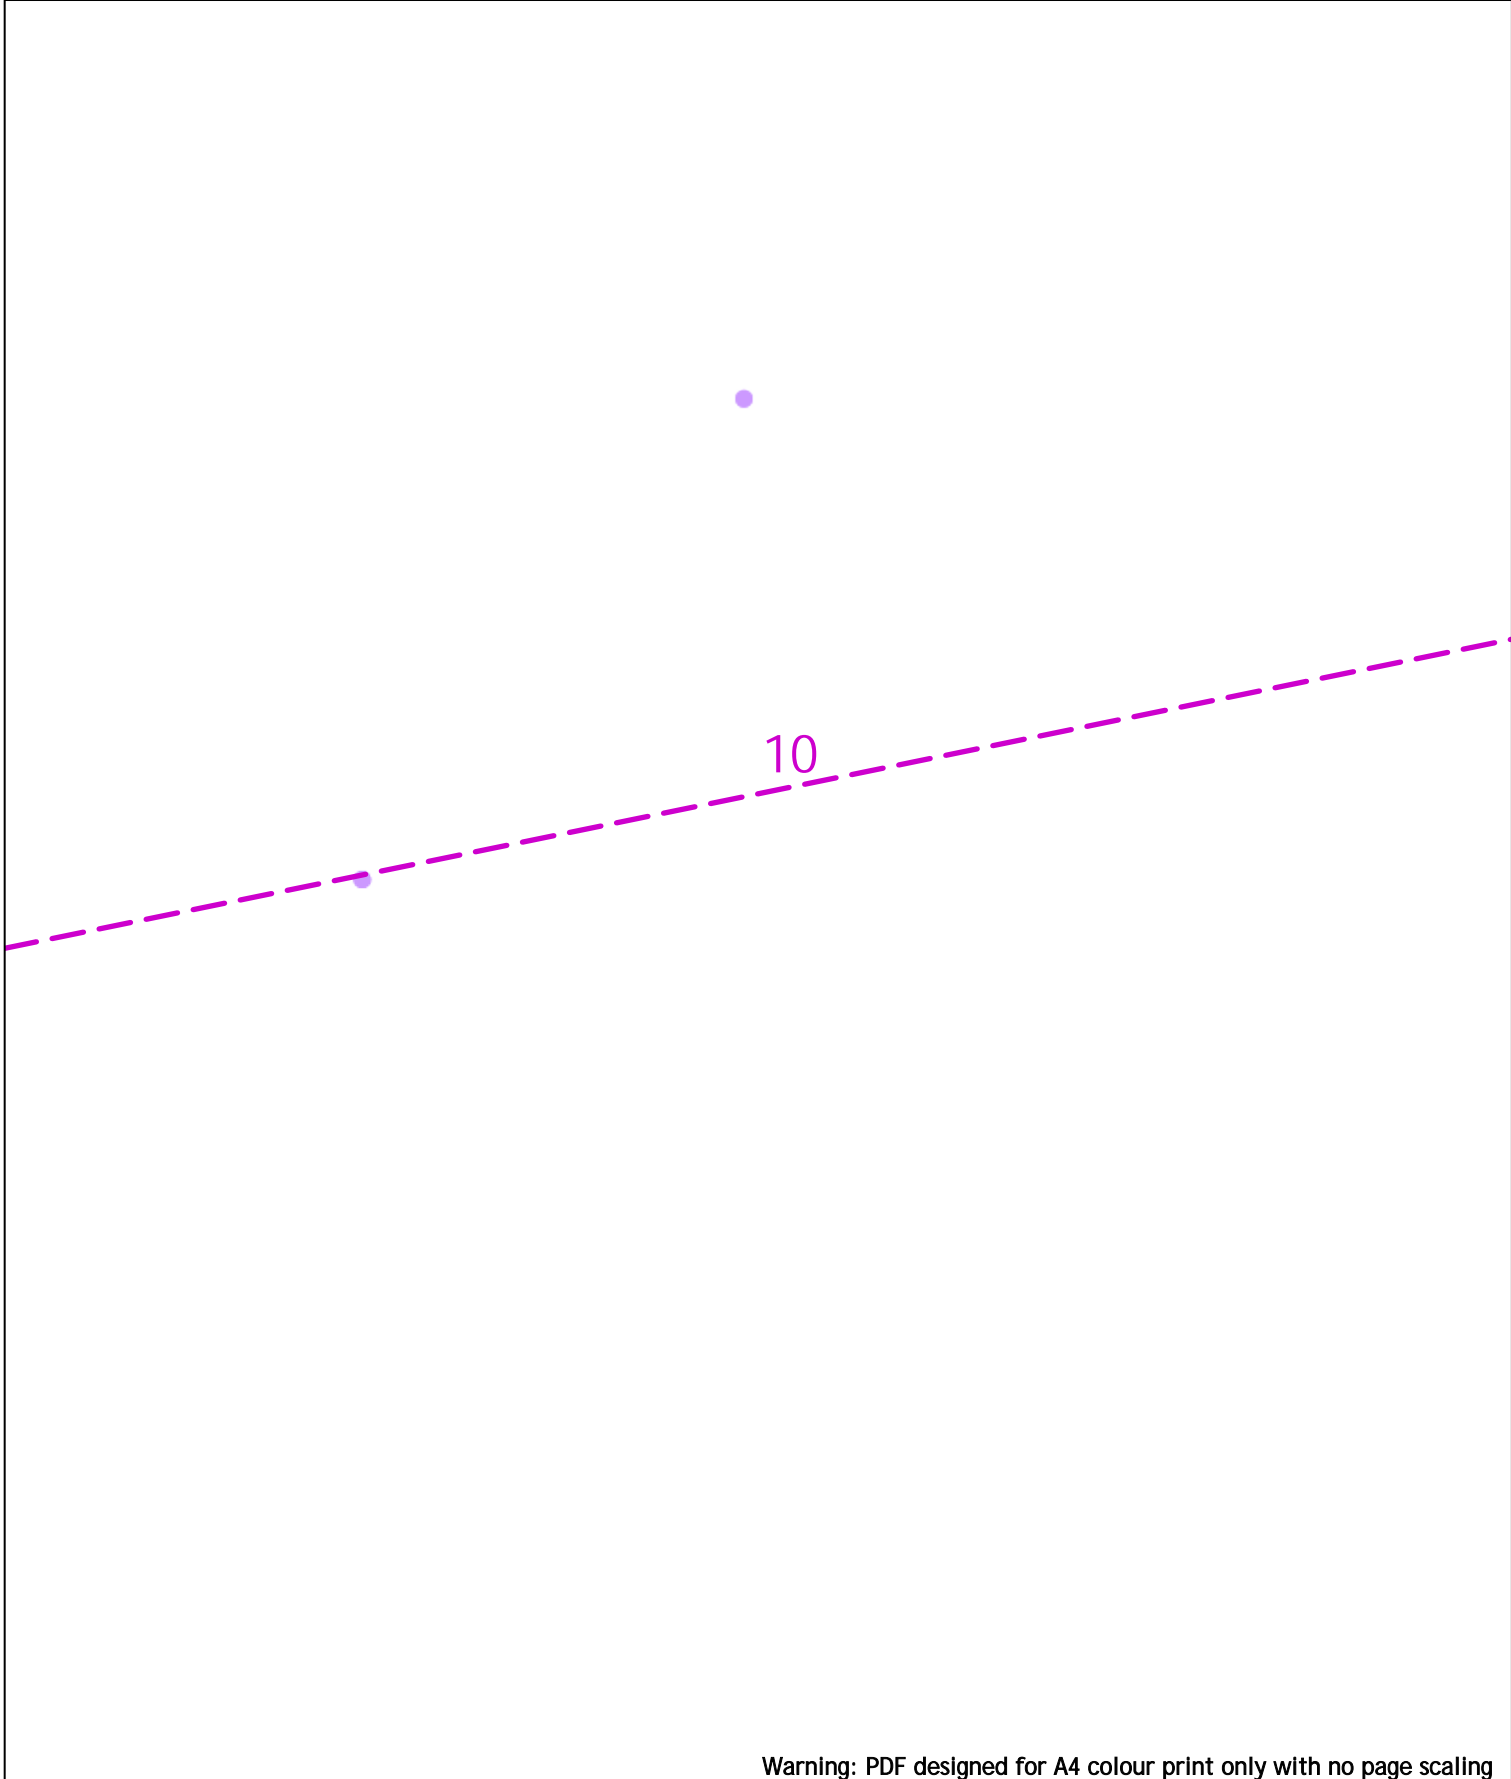

Warning: PDF designed for A4 colour print only with no page scaling

0 20m Dig Sites Area: Line:

Date Requested: 24/06/2022  
 Job Reference: 25881050  
 Site Location: 448447 212278  
 Requested by: Mr Joe Shawyer  
 Your Scheme/Reference: 31188\_004

Voltages (V)	
LV (Low Voltage) and Services	Up to 1,000V
HV (High Voltage)	Over 1,000V to 11,000V
EHV (Extra High Voltage)	22,000V to 132,000V
Transmission	275,000V and 400,000V

NORMAL DEPTH TO THE TOP OF THE CABLE WHEN LAID			
Services	LV	HV	EHV
Agricultural	1m	1m	1.1m

**WARNING**

There may have been subsequent alteration to the surface levels. Trial holes must be undertaken to determine position and depths of cables. HS (G) 47 Booklet from the Health and Safety Executive – Avoiding Danger from Buried Cables – should be consulted before commencing excavation work.


**WHEN WORKING IN THE VICINITY OF OVERHEAD LINES THE HEALTH AND SAFETY GUIDANCE NOTES G56 SHOULD BE CONSULTED (AVAILABLE FROM THE HSE WEBSITE)**




**Southern Electric Power Distribution plc**  
 Registered Office: No.1 Forbury Place  
 43 Forbury Road Reading RG1 3JH  
 Registered In England & Wales No.04094290

If you're unsure & need to seek advice before commencing excavations, please contact:  
 General Enquiries: 0800 048 3516

Subject to revision – Master held by SSEN Asset Data Team:  
[Asset.Data@sse.com](mailto:Asset.Data@sse.com)  
 01256 337 294

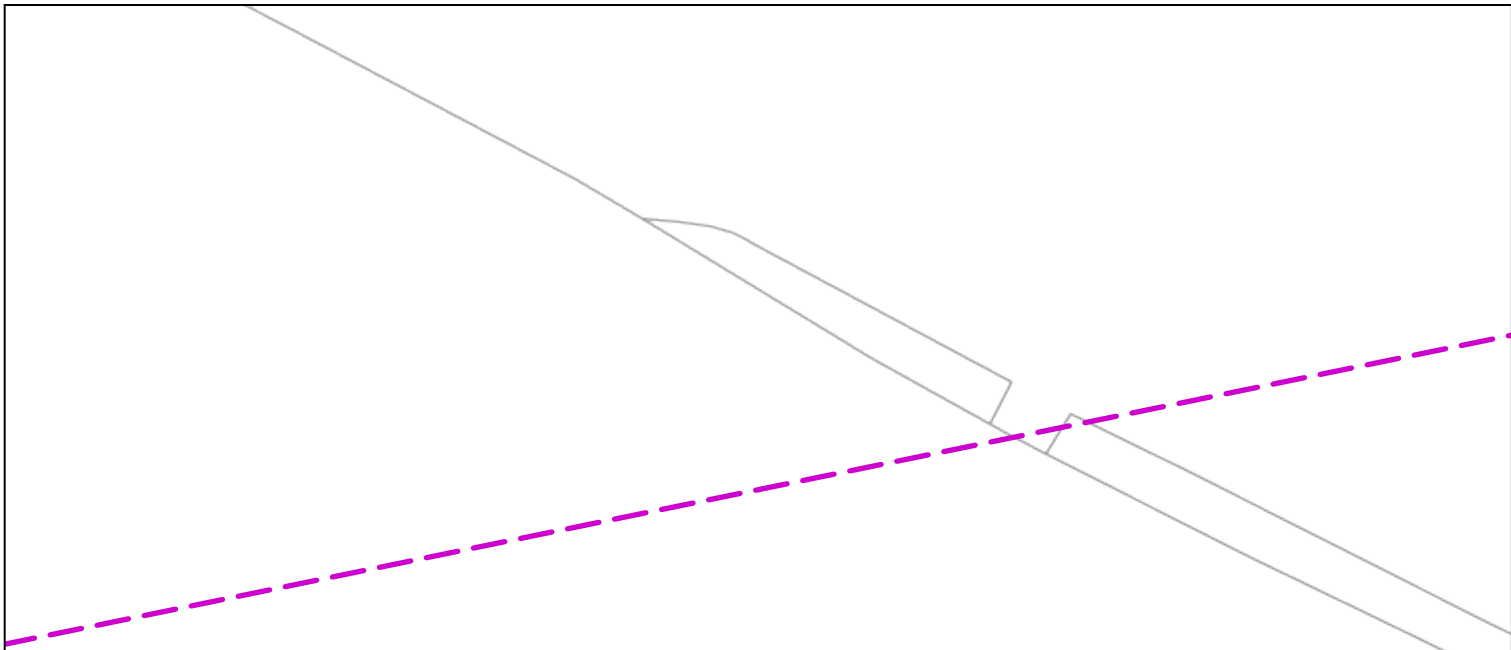

11

Warning: PDF designed for A4 colour print only with no page scaling

0 20m Dig Sites Area: Line:

Date Requested: 24/06/2022  
 Job Reference: 25881050  
 Site Location: 448447 212278  
 Requested by: Mr Joe Shawyer  
 Your Scheme/Reference: 31188\_004

Voltages (V)			
LV (Low Voltage) and Services	Up to 1,000V		
HV (High Voltage)	Over 1,000V to 11,000V		
EHV (Extra High Voltage)	22,000V to 132,000V		
Transmission	275,000V and 400,000V		
NORMAL DEPTH TO THE TOP OF THE CABLE WHEN LAID			
Services	LV	HV	EHV
Footpath/Unmade	0.45m	0.45m	0.6m
Road Crossing	0.6m	0.6m	0.75m
Agricultural	1m	1m	1.1m

Legend	Distribution Structures (Electric)
Service Cable	Pole, Existing Location
LV Mains	Pole Structure, Existing Location - Single
2-33kV	Pole Structure, Existing Location - H
6.6kV	Duct Route
11kV	Cross Section Route
22kV	
33kV	
66kV	
132kV	
275kV	
400kV	
Fibre Optic	
Pilot Cable	

**WARNING**  
 There may have been subsequent alteration to the surface levels. Trial holes must be undertaken to determine position and depths of cables. HS (G) 47 Booklet from the Health and Safety Executive - Avoiding Danger from Buried Cables - should be consulted before commencing excavation work.  
 WHEN WORKING IN THE VICINITY OF OVERHEAD LINES THE HEALTH AND SAFETY GUIDANCE NOTES G56 SHOULD BE CONSULTED (AVAILABLE FROM THE HSE WEBSITE)




**Southern Electric Power Distribution plc**  
 Registered Office: No.1 Forbury Place  
 43 Forbury Road Reading RG1 3JH  
 Registered In England & Wales No.04094290

If you're unsure & need to seek advice before commencing excavations, please contact:  
 General Enquiries: 0800 048 3516

Subject to revision - Master held by SSEN Asset Data Team:  
[Asset.Data@sse.com](mailto:Asset.Data@sse.com)  
 01256 337 294

Scale: 1:500 (When plotted at A4)



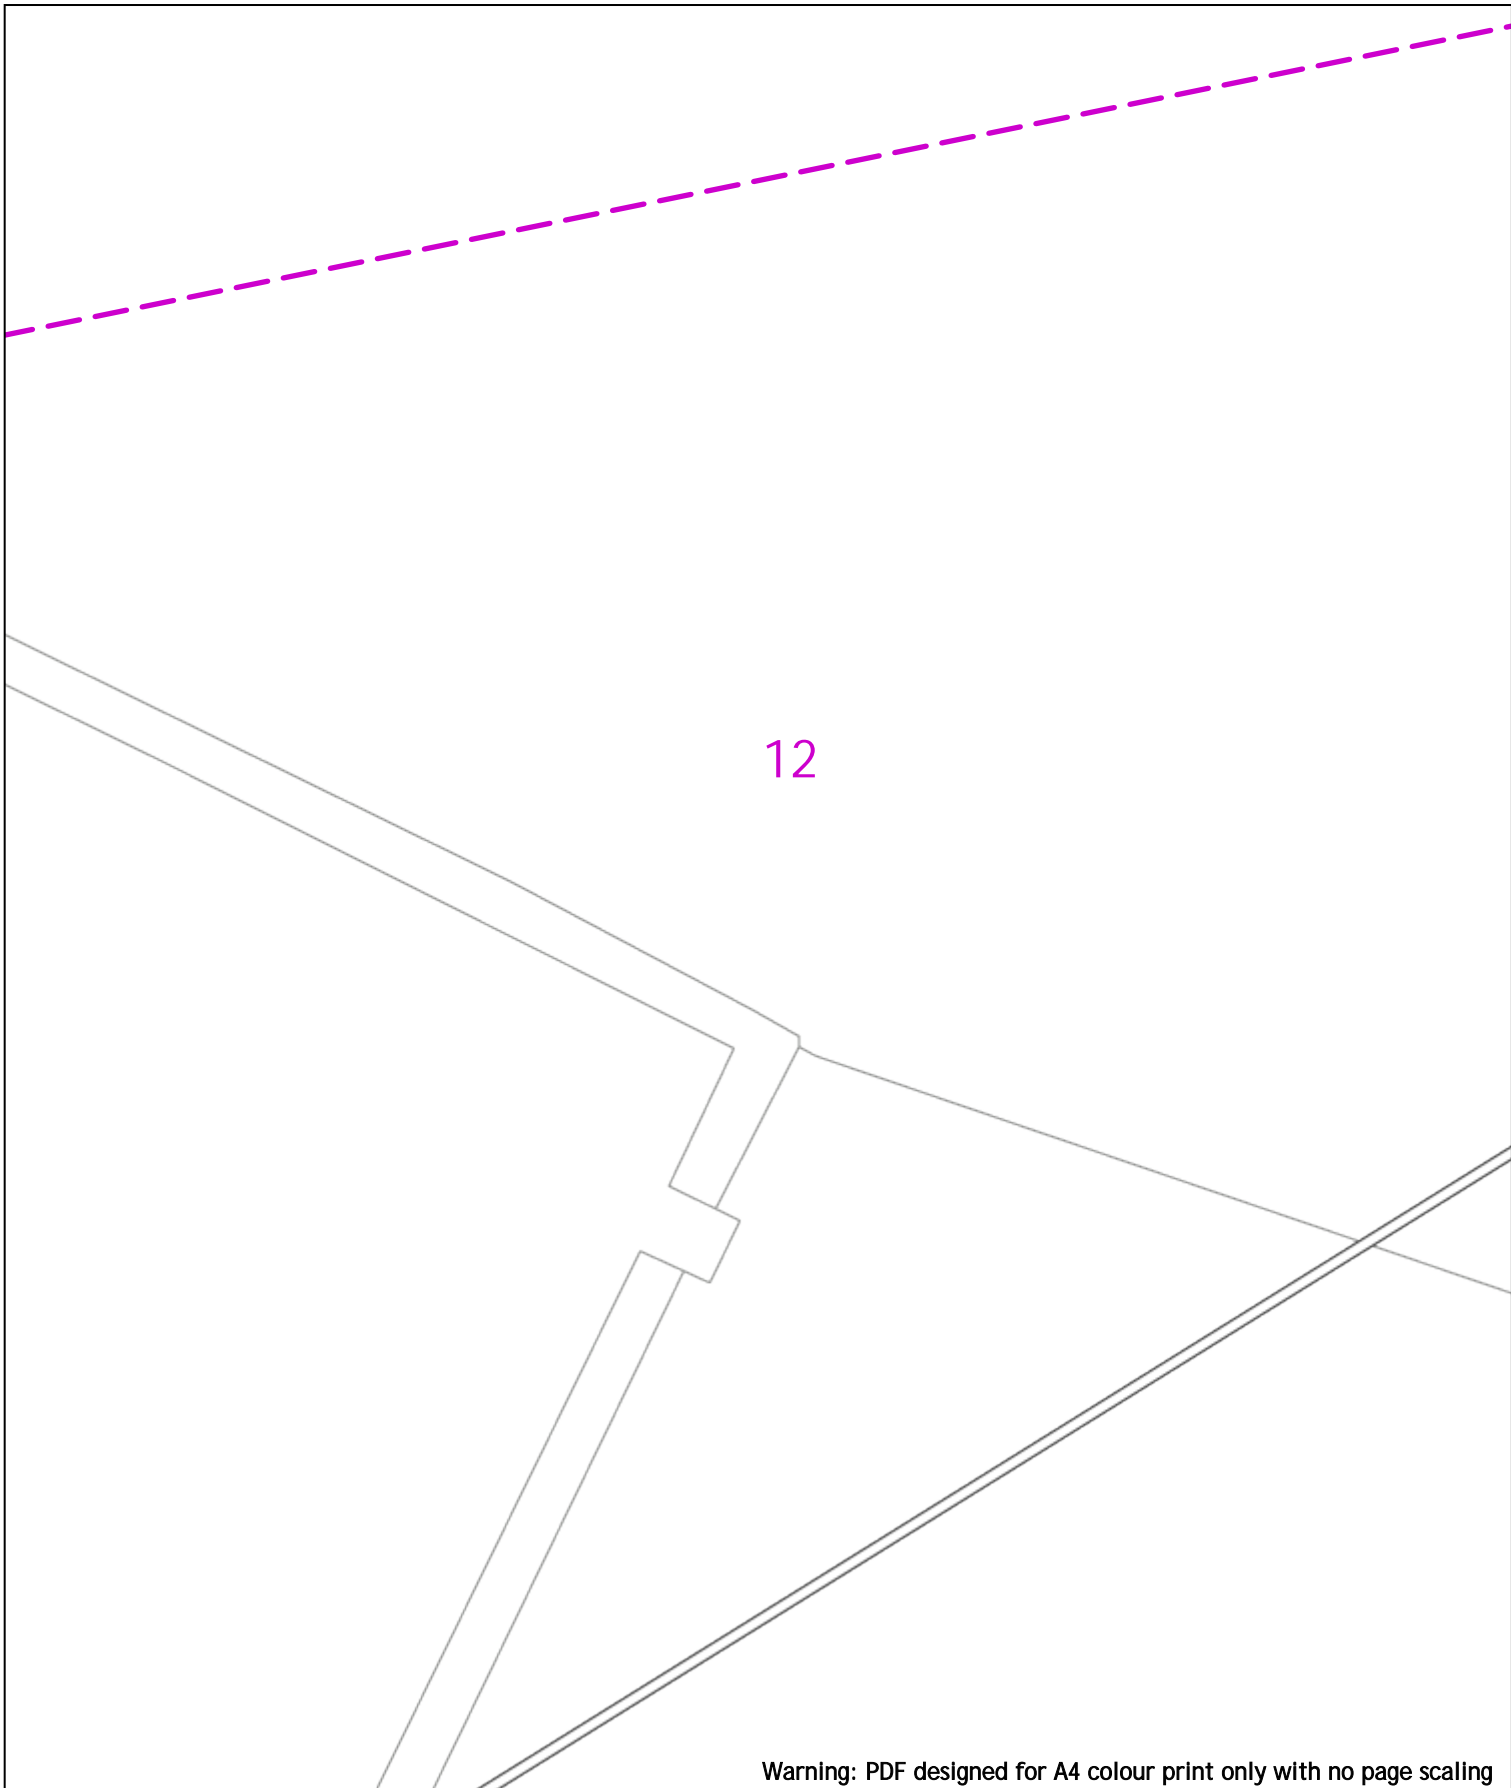

Warning: PDF designed for A4 colour print only with no page scaling

0 20m Dig Sites Area: Line:

Date Requested: 24/06/2022  
 Job Reference: 25881050  
 Site Location: 448447 212278  
 Requested by: Mr Joe Shawyer  
 Your Scheme/Reference: 31188\_004

Voltages (V)			
LV (Low Voltage) and Services	Up to 1,000V		
HV (High Voltage)	Over 1,000V to 11,000V		
EHV (Extra High Voltage)	22,000V to 132,000V		
Transmission	275,000V and 400,000V		

NORMAL DEPTH TO THE TOP OF THE CABLE WHEN LAID			
Services	LV	HV	EHV
Footpath/Unmade	0.45m	0.45m	0.6m
Road Crossing	0.6m	0.6m	0.75m
Agricultural	1m	1m	1.1m

<p><b>Legend</b></p> <ul style="list-style-type: none"> <li> Service Cable</li> <li> LV Mains</li> <li> 6.6kV</li> <li> 11kV</li> <li> 22kV</li> <li> 33kV</li> <li> 66kV</li> <li> 132kV</li> <li> 275kV</li> <li> 400kV</li> <li> Fibre Optic</li> <li> Pilot Cable</li> </ul>	<p><b>Distribution Structures (Electric)</b></p> <ul style="list-style-type: none"> <li> Pole, Existing Location</li> <li> Pole Structure, Existing Location - Single</li> <li> Pole Structure, Existing Location - H</li> <li> Duct Route</li> <li> Cross Section Route</li> </ul>
--	---

Scale: 1:500 (When plotted at A4)

**WARNING**  
 There may have been subsequent alteration to the surface levels. Trial holes must be undertaken to determine position and depths of cables. HS (G) 47 Booklet from the Health and Safety Executive - Avoiding Danger from Buried Cables - should be consulted before commencing excavation work.  
**WHEN WORKING IN THE VICINITY OF OVERHEAD LINES THE HEALTH AND SAFETY GUIDANCE NOTES G56 SHOULD BE CONSULTED (AVAILABLE FROM THE HSE WEBSITE)**

**Southern Electric Power Distribution plc**  
 Registered Office: No.1 Forbury Place  
 43 Forbury Road Reading RG1 3JH  
 Registered In England & Wales No.04094290

If you're unsure & need to seek advice before commencing excavations, please contact:  
 General Enquiries: 0800 048 3516

Subject to revision - Master held by SSEN Asset Data Team:  
[Asset.Data@sse.com](mailto:Asset.Data@sse.com)  
 01256 337 294

Warning: PDF designed for A4 colour print only with no page scaling

0  20m Dig Sites Area:  Line: 



Date Requested: 24/06/2022  
 Job Reference: 25881050  
 Site Location: 448447 212278  
 Requested by: Mr Joe Shawyer  
 Your Scheme/Reference: 31188\_004

Voltages (V)			
LV (Low Voltage) and Services	Up to 1,000V		
HV (High Voltage)	Over 1,000V to 11,000V		
EHV (Extra High Voltage)	22,000V to 132,000V		
Transmission	275,000V and 400,000V		
NORMAL DEPTH TO THE TOP OF THE CABLE WHEN LAID			
Services	LV	HV	EHV
Footpath/Unmade	0.45m	0.45m	0.6m
Road Crossing	0.6m	0.6m	0.75m
Agricultural	1m	1m	1.1m

Legend	Distribution Structures (Electric)
Service Cable	Pole, Existing Location
LV Mains	Pole Structure, Existing Location - Single
2-33kV	Pole Structure, Existing Location - H
6.6kV	Duct Route
11kV	Cross Section Route
22kV	
33kV	
66kV	
132kV	
275kV	
400kV	
Fibre Optic	
Pilot Cable	


**WARNING**  
 There may have been subsequent alteration to the surface levels. Trial holes must be undertaken to determine position and depths of cables. HS (G) 47 Booklet from the Health and Safety Executive - Avoiding Danger from Buried Cables - should be consulted before commencing excavation work.  
**WHEN WORKING IN THE VICINITY OF OVERHEAD LINES THE HEALTH AND SAFETY GUIDANCE NOTES G56 SHOULD BE CONSULTED (AVAILABLE FROM THE HSE WEBSITE)**

**Southern Electric Power Distribution plc**  
 Registered Office: No.1 Forbury Place  
 43 Forbury Road Reading RG1 3JH  
 Registered In England & Wales No.04094290

If you're unsure & need to seek advice before commencing excavations, please contact:  
 General Enquiries: 0800 048 3516

Subject to revision - Master held by SSEN Asset Data Team:  
[Asset.Data@sse.com](mailto:Asset.Data@sse.com)  
 01256 337 294

Scale: 1:500 (When plotted at A4)

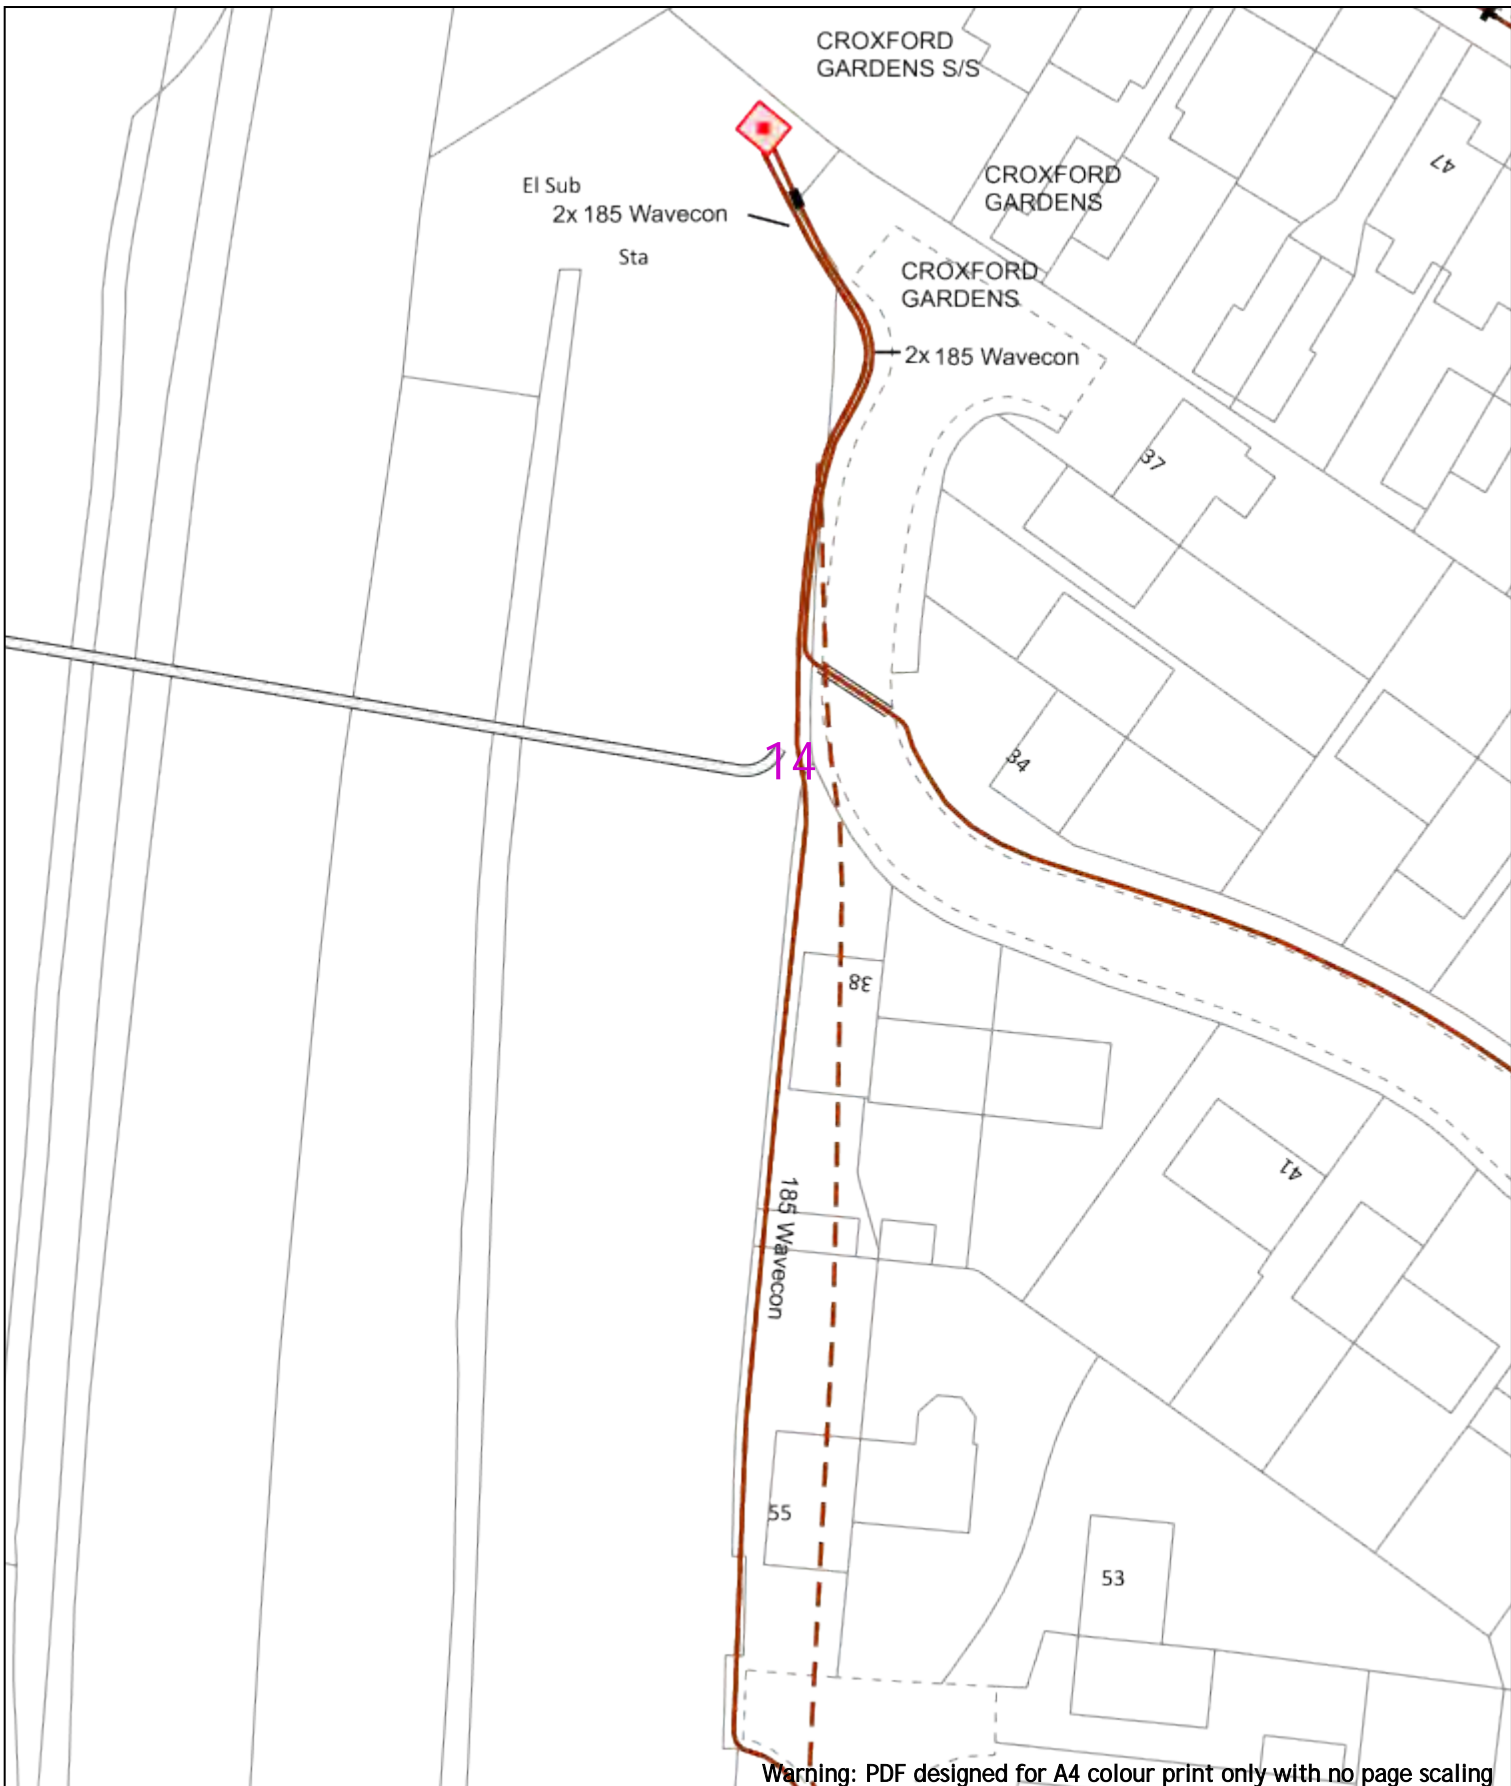

Warning: PDF designed for A4 colour print only with no page scaling

0 20m Dig Sites Area: Line:

Date Requested: 24/06/2022  
 Job Reference: 25881050  
 Site Location: 448447 212278  
 Requested by: Mr Joe Shawyer  
 Your Scheme/Reference: 31188\_004

Voltages (V)	
LV (Low Voltage) and Services	Up to 1,000V
HV (High Voltage)	Over 1,000V to 11,000V
EHV (Extra High Voltage)	22,000V to 132,000V
Transmission	275,000V and 400,000V

NORMAL DEPTH TO THE TOP OF THE CABLE WHEN LAID			
Services	LV	HV	EHV
Footpath/Unmade	0.45m	0.45m	0.6m
Road Crossing	0.6m	0.6m	0.75m
Agricultural	1m	1m	1.1m

Legend	
	Service Cable
	LV Main
	2-33kV
	6.6kV
	11kV
	22kV
	33kV
	66kV
	132kV
	275kV
	400kV
	Fibre Optic
	Road Cable


Distribution Structures (Electric)	
	Pole, Existing Location
	Pole Structure, Existing Location - Single
	Pole Structure, Existing Location - H
	Duct Route
	Cross Section Route

**WARNING**  
 There may have been subsequent alteration to the surface levels. Trial holes must be undertaken to determine position and depths of cables. HS (G) 47 Booklet from the Health and Safety Executive - Avoiding Danger from Buried Cables - should be consulted before commencing excavation work.  
 WHEN WORKING IN THE VICINITY OF OVERHEAD LINES THE HEALTH AND SAFETY GUIDANCE NOTES G56 SHOULD BE CONSULTED (AVAILABLE FROM THE HSE WEBSITE)

**Southern Electric Power Distribution plc**  
 Registered Office: No.1 Forbury Place  
 43 Forbury Road Reading RG1 3JH  
 Registered In England & Wales No.04094290

If you're unsure & need to seek advice before commencing excavations, please contact:  
 General Enquiries: 0800 048 3516

Subject to revision - Master held by SSEN Asset Data Team:  
[Asset.Data@sse.com](mailto:Asset.Data@sse.com)  
 01256 337 294

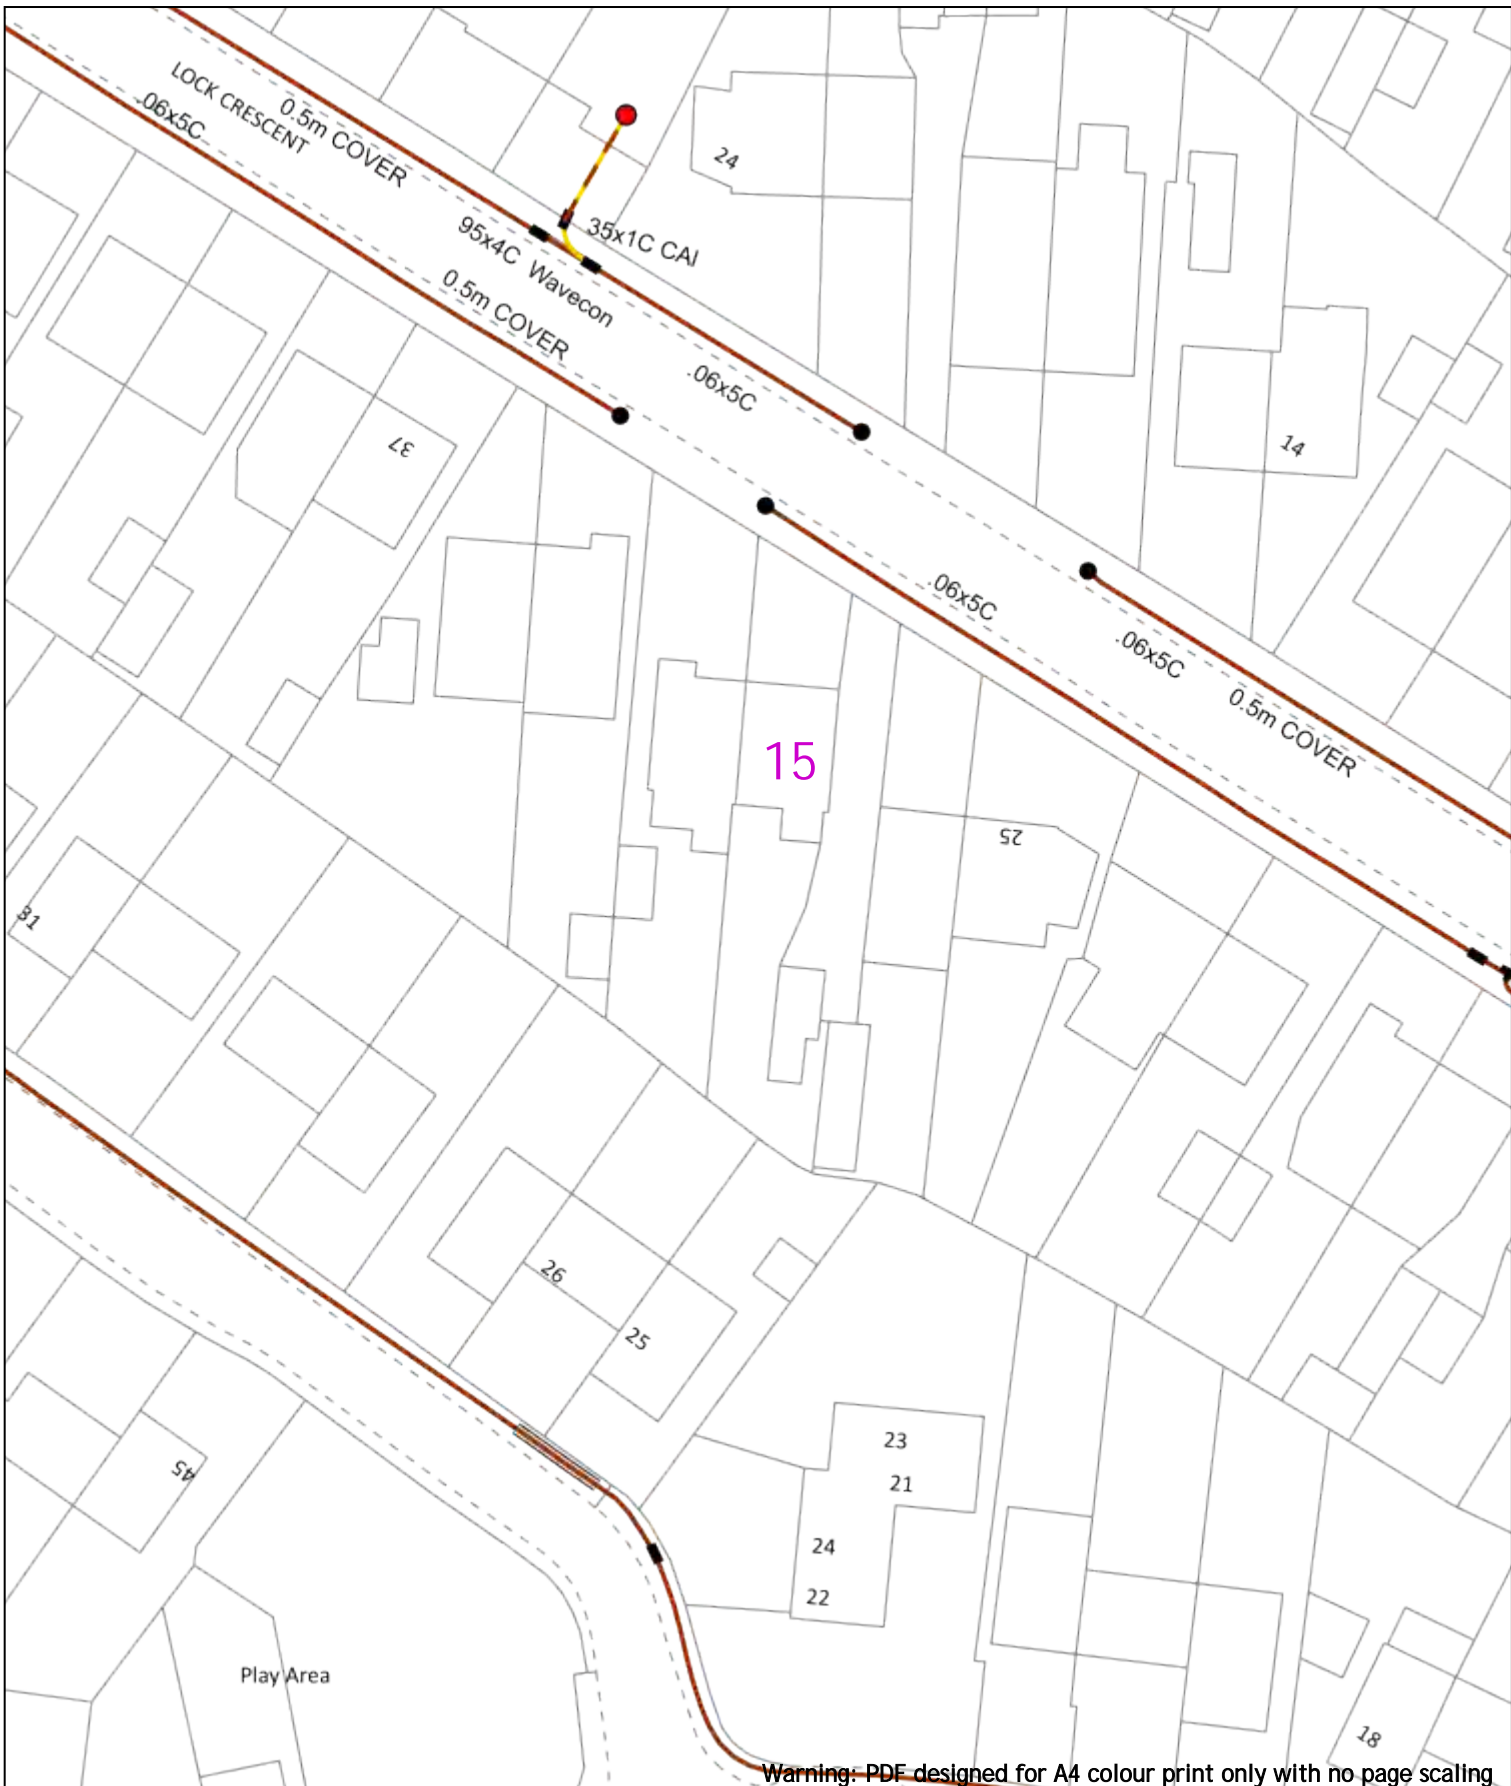

20m Dig Sites Area: Line:

Date Requested: 24/06/2022  
 Job Reference: 25881050  
 Site Location: 448447 212278  
 Requested by: Mr Joe Shawyer  
 Your Scheme/Reference: 31188\_004

Voltages (V)			
LV (Low Voltage) and Services	Up to 1,000V		
HV (High Voltage)	Over 1,000V to 11,000V		
EHV (Extra High Voltage)	22,000V to 132,000V		
Transmission	275,000V and 400,000V		
NORMAL DEPTH TO THE TOP OF THE CABLE WHEN LAID			
Services	LV	HV	EHV
Footpath/Unmade	0.45m	0.45m	0.6m
Road Crossing	0.6m	0.6m	0.75m
Agricultural	1m	1m	1.1m

Legend	
	Service Cable
	LV Mains
	2-13kV
	6.6kV
	11kV
	22kV
	33kV
	66kV
	132kV
	275kV
	400kV
	Fibre Optic
	Road Cable

Distribution Structures (Electric)	
	Pole, Existing Location
	Pole Structure, Existing Location - Single
	Pole Structure, Existing Location - H
	Duct Route
	Cross Section Route

**WARNING**  
 There may have been subsequent alteration to the surface levels. Trial holes must be undertaken to determine position and depths of cables. HS (G) 47 Booklet from the Health and Safety Executive - Avoiding Danger from Buried Cables - should be consulted before commencing excavation work.  
 WHEN WORKING IN THE VICINITY OF OVERHEAD LINES THE HEALTH AND SAFETY GUIDANCE NOTES G56 SHOULD BE CONSULTED (AVAILABLE FROM THE HSE WEBSITE)




**Southern Electric Power Distribution plc**  
 Registered Office: No.1 Forbury Place  
 43 Forbury Road Reading RG1 3JH  
 Registered In England & Wales No.04094290

If you're unsure & need to seek advice before commencing excavations, please contact:  
 General Enquiries: 0800 048 3516

Subject to revision - Master held by SSEN Asset Data Team:  
[Asset.Data@sse.com](mailto:Asset.Data@sse.com)  
 01256 337 294

Scale: 1:500 (When plotted at A4)

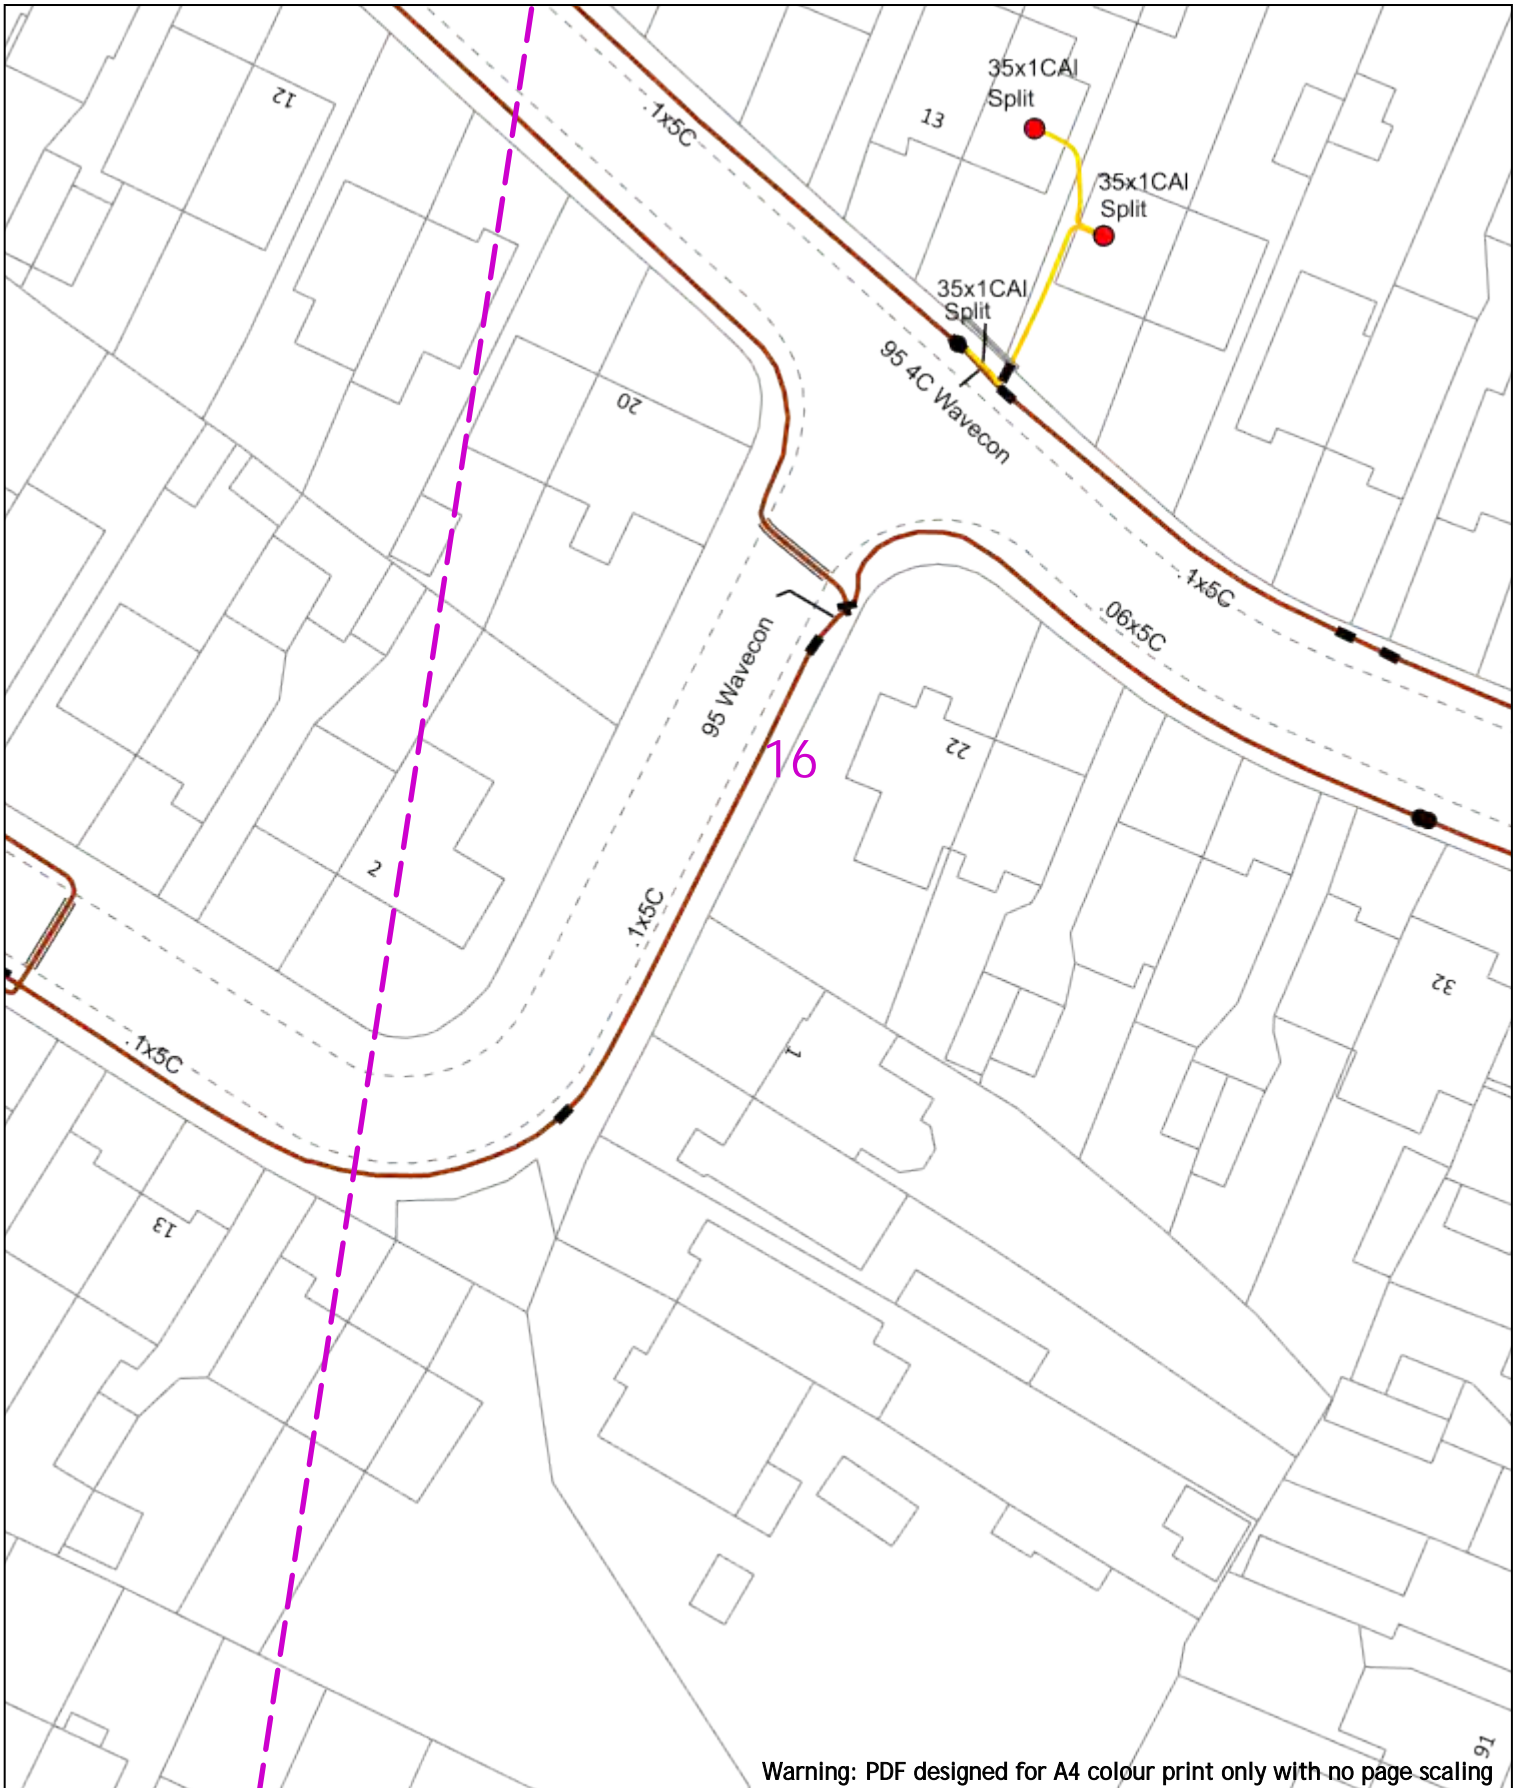

0 20m Dig Sites Area: Line:

Date Requested: 24/06/2022  
 Job Reference: 25881050  
 Site Location: 448447 212278  
 Requested by: Mr Joe Shawyer  
 Your Scheme/Reference: 31188\_004

Voltages (V)			
LV (Low Voltage) and Services	Up to 1,000V		
HV (High Voltage)	Over 1,000V to 11,000V		
EHV (Extra High Voltage)	22,000V to 132,000V		
Transmission	275,000V and 400,000V		
NORMAL DEPTH TO THE TOP OF THE CABLE WHEN LAID			
Services	LV	HV	EHV
Footpath/Unmade	0.45m	0.45m	0.6m
Road Crossing	0.6m	0.6m	0.75m
Agricultural	1m	1m	1.1m

Legend	
	Service Cable
	LV Mains
	2-13kV
	6.6kV
	11kV
	22kV
	33kV
	66kV
	132kV
	275kV
	400kV
	Fibre Optic
	Road Cable

Distribution Structures (Electric)	
	Pole, Existing Location
	Pole Structure, Existing Location - Single
	Pole Structure, Existing Location - e
	Duct Route
	Cross Section Route


**WARNING**  
 There may have been subsequent alteration to the surface levels. Trial holes must be undertaken to determine position and depths of cables. HS (G) 47 Booklet from the Health and Safety Executive - Avoiding Danger from Buried Cables - should be consulted before commencing excavation work.  
 WHEN WORKING IN THE VICINITY OF OVERHEAD LINES THE HEALTH AND SAFETY GUIDANCE NOTES G56 SHOULD BE CONSULTED (AVAILABLE FROM THE HSE WEBSITE)

Scale: 1:500 (When plotted at A4)

**Southern Electric Power Distribution plc**  
 Registered Office: No.1 Forbury Place  
 43 Forbury Road Reading RG1 3JH  
 Registered In England & Wales No.04094290

If you're unsure & need to seek advice before commencing excavations, please contact:  
 General Enquiries: 0800 048 3516

Subject to revision - Master held by SSEN Asset Data Team:  
[Asset.Data@sse.com](mailto:Asset.Data@sse.com)  
 01256 337 294

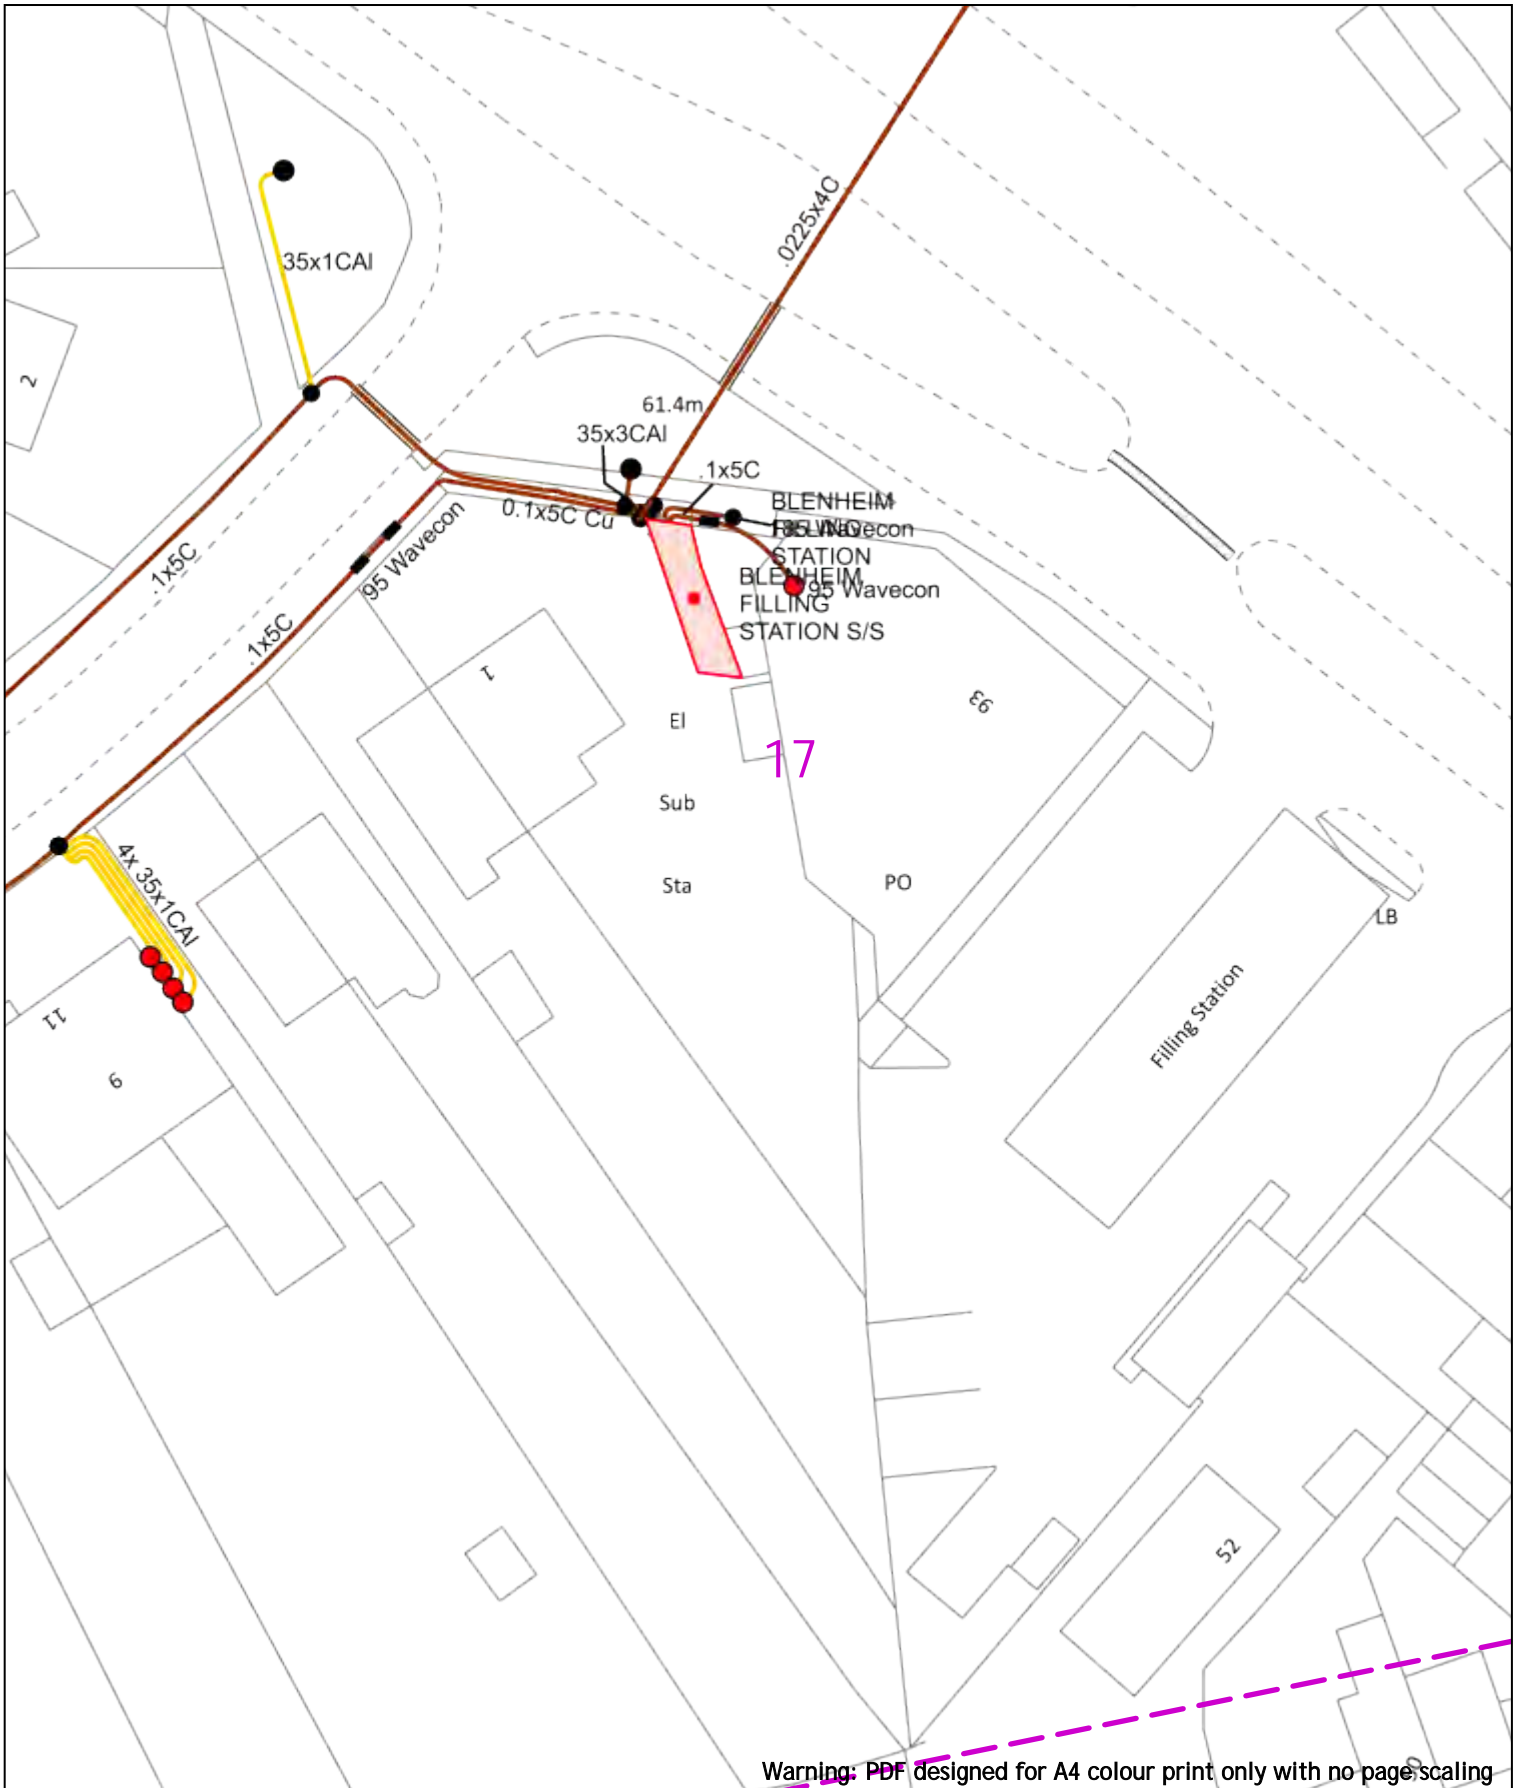

Warning: PDF designed for A4 colour print only with no page scaling

0 20m Dig Sites Area: Line:

Date Requested: 24/06/2022  
 Job Reference: 25881050  
 Site Location: 448447 212278  
 Requested by: Mr Joe Shawyer  
 Your Scheme/Reference: 31188\_004

Voltages (V)			
LV (Low Voltage) and Services	Up to 1,000V		
HV (High Voltage)	Over 1,000V to 11,000V		
EHV (Extra High Voltage)	22,000V to 132,000V		
Transmission	275,000V and 400,000V		

NORMAL DEPTH TO THE TOP OF THE CABLE WHEN LAID			
Services	LV	HV	EHV
Footpath/Unmade	0.45m	0.45m	0.6m
Road Crossing	0.6m	0.6m	0.75m
Agricultural	1m	1m	1.1m

Legend		Distribution Structures (Electric)	
	Service Cable		Pole, Existing Location
	LV Mains		Pole Structure, Existing Location - Single
	6.6kV		Pole Structure, Existing Location - H
	11kV		Duct Route
	22kV		Cross Section Route
	33kV		
	66kV		
	132kV		
	275kV		
	400kV		
	Fibre Optic		
	Rigid Cable		


**WARNING**  
 There may have been subsequent alteration to the surface levels. Trial holes must be undertaken to determine position and depths of cables. HS (G) 47 Booklet from the Health and Safety Executive - Avoiding Danger from Buried Cables - should be consulted before commencing excavation work.  
 WHEN WORKING IN THE VICINITY OF OVERHEAD LINES THE HEALTH AND SAFETY GUIDANCE NOTES G56 SHOULD BE CONSULTED (AVAILABLE FROM THE HSE WEBSITE)

Scale: 1:500 (When plotted at A4)

**Southern Electric Power Distribution plc**  
 Registered Office: No.1 Forbury Place  
 43 Forbury Road Reading RG1 3JH  
 Registered In England & Wales No.04094290

If you're unsure & need to seek advice before commencing excavations, please contact:  
 General Enquiries: 0800 048 3516

Subject to revision - Master held by SSEN Asset Data Team:  
[Asset.Data@sse.com](mailto:Asset.Data@sse.com)  
 01256 337 294

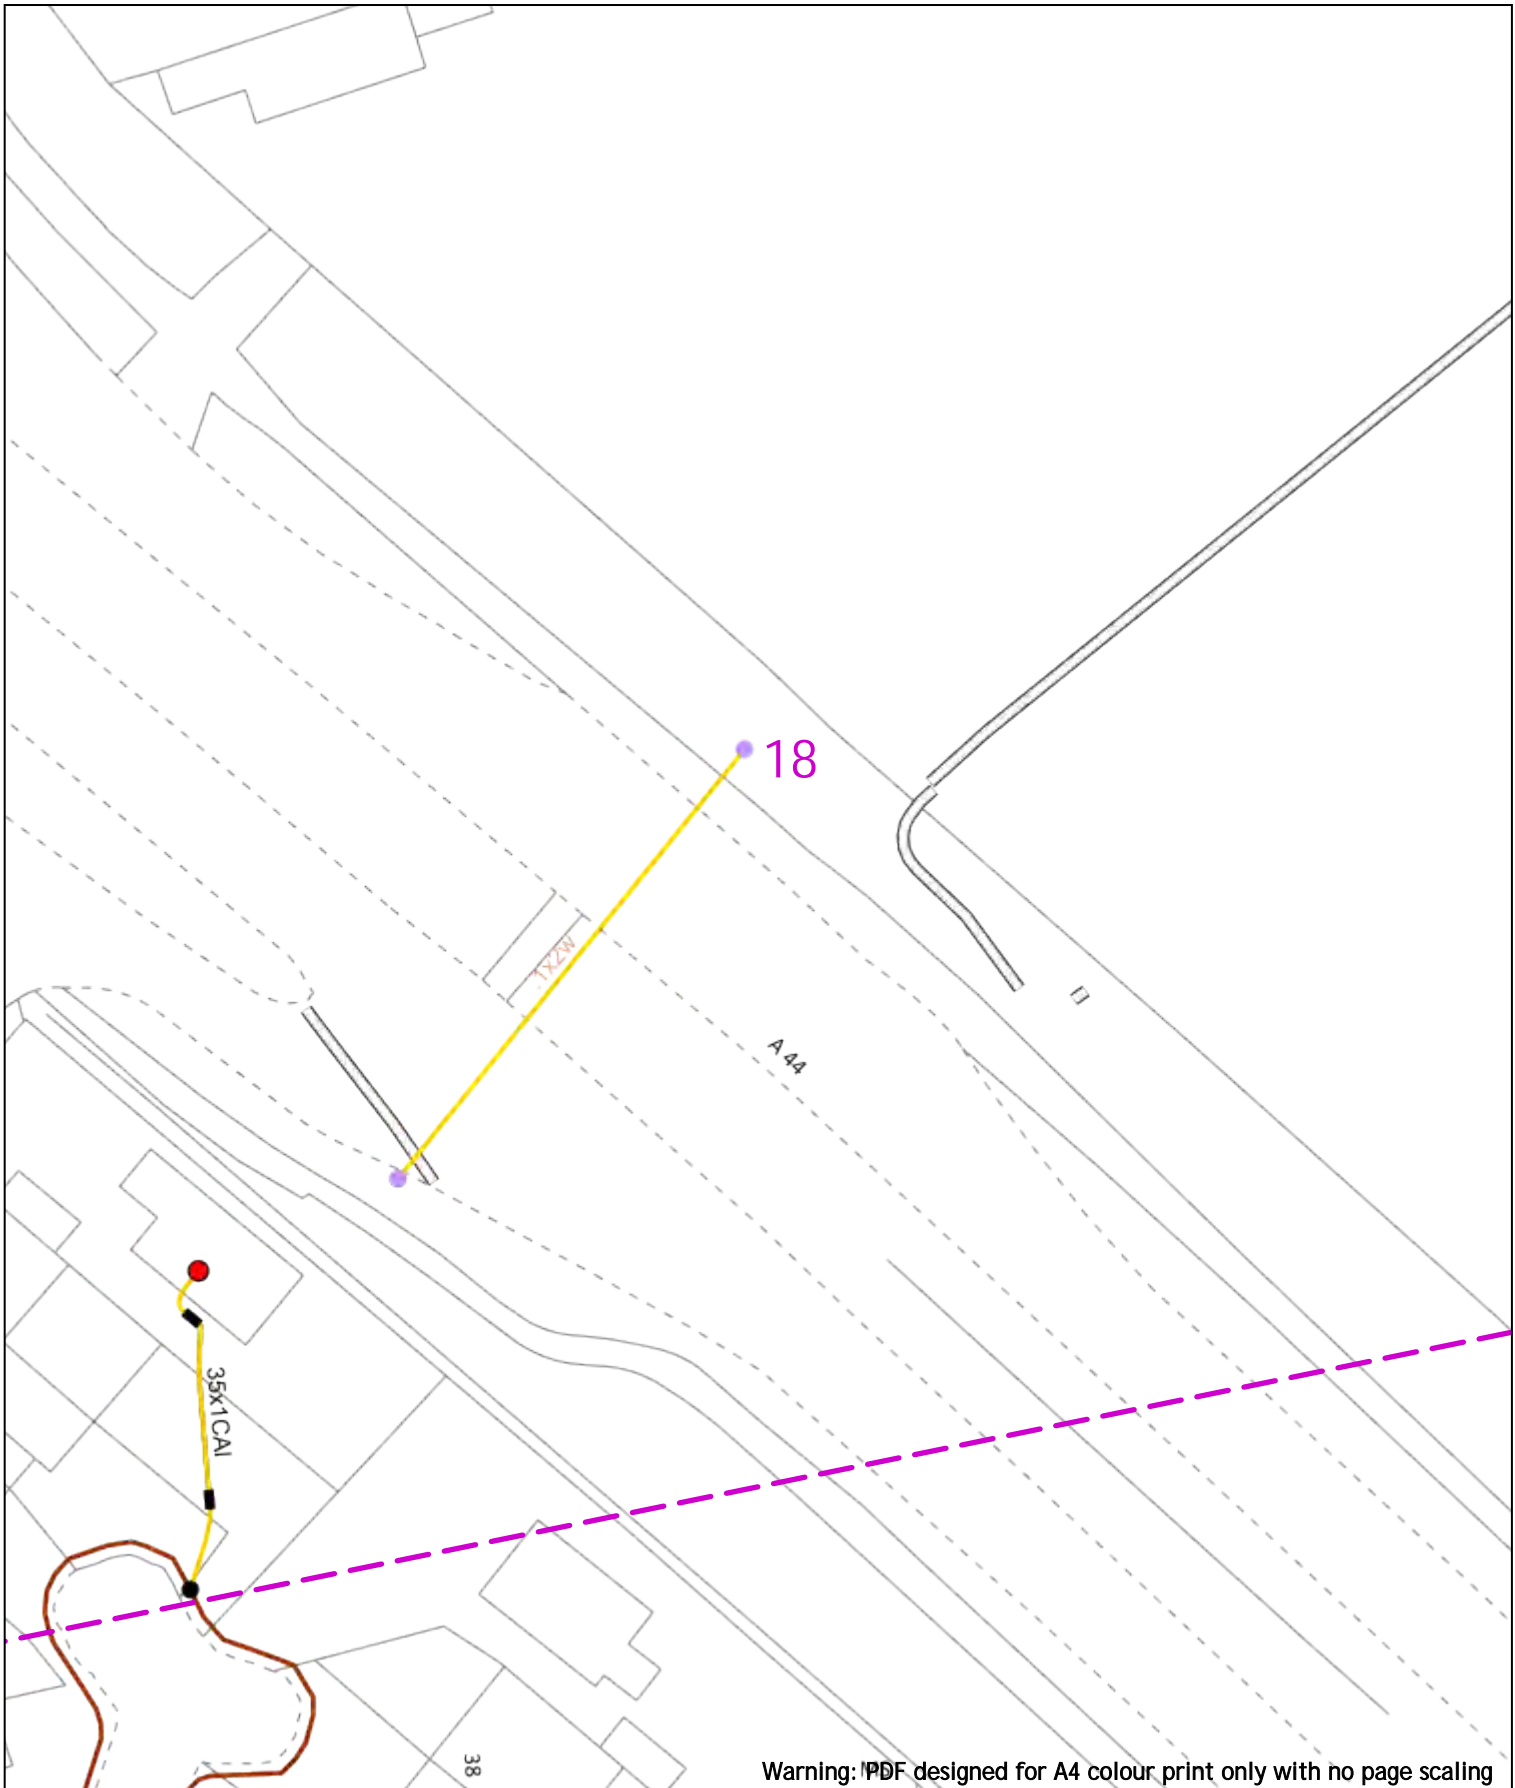

0 20m Dig Sites Area: Line:

Date Requested: 24/06/2022  
 Job Reference: 25881050  
 Site Location: 448447 212278  
 Requested by: Mr Joe Shawyer  
 Your Scheme/Reference: 31188\_004

Voltages (V)	
LV (Low Voltage) and Services	Up to 1,000V
HV (High Voltage)	Over 1,000V to 11,000V
EHV (Extra High Voltage)	22,000V to 132,000V
Transmission	275,000V and 400,000V

NORMAL DEPTH TO THE TOP OF THE CABLE WHEN LAID			
Services	LV	HV	EHV
Footpath/Unmade	0.45m	0.45m	0.6m
Road Crossing	0.6m	0.6m	0.75m
Agricultural	1m	1m	1.1m

**WARNING**  
 There may have been subsequent alteration to the surface levels. Trial holes must be undertaken to determine position and depths of cables. HS (G) 47 Booklet from the Health and Safety Executive – Avoiding Danger from Buried Cables – should be consulted before commencing excavation work.  
 WHEN WORKING IN THE VICINITY OF OVERHEAD LINES THE HEALTH AND SAFETY GUIDANCE NOTES G56 SHOULD BE CONSULTED (AVAILABLE FROM THE HSE WEBSITE)

Scale: 1:500 (When plotted at A4)




**Southern Electric Power Distribution plc**  
 Registered Office: No.1 Forbury Place  
 43 Forbury Road Reading RG1 3JH  
 Registered In England & Wales No.04094290

If you're unsure & need to seek advice before commencing excavations, please contact:  
 General Enquiries: 0800 048 3516

Subject to revision – Master held by SSEN Asset Data Team:  
[Asset.Data@sse.com](mailto:Asset.Data@sse.com)  
 01256 337 294

61.0m

Warning: PDF designed for A4 colour print only with no page scaling

0  20m Dig Sites Area:  Line: 



Date Requested: 24/06/2022  
 Job Reference: 25881050  
 Site Location: 448447 212278  
 Requested by: Mr Joe Shawyer  
 Your Scheme/Reference: 31188\_004

Voltages (V)				
LV (Low Voltage) and Services	Up to 1,000V			
HV (High Voltage)	Over 1,000V to 11,000V			
EHV (Extra High Voltage)	22,000V to 132,000V			
Transmission	275,000V and 400,000V			
NORMAL DEPTH TO THE TOP OF THE CABLE WHEN LAID				
Services	LV	HV	EHV	
Footpath/Unmade	0.45m	0.45m	0.6m	0.8m
Road Crossing	0.6m	0.6m	0.75m	0.9m
Agricultural	1m	1m	1m	1.1m

**Legend**

- Service Cable
- LV Mains
- 2-33kV
- 6.6kV
- 11kV
- 22kV
- 33kV
- 66kV
- 132kV
- 275kV
- 400kV
- Fibre Optic
- Pilot Cable

**Distribution Structures (Electric)**

- Pole, Existing Location
- Pole Structure, Existing Location - Single
- Pole Structure, Existing Location - H
- Duct Route
- Cross Section Route

WARNING

There may have been subsequent alteration to the surface levels. Trial holes must be undertaken to determine position and depths of cables. HS (G) 47 Booklet from the Health and Safety Executive - Avoiding Danger from Buried Cables - should be consulted before commencing excavation work.

WHEN WORKING IN THE VICINITY OF OVERHEAD LINES THE HEALTH AND SAFETY GUIDANCE NOTES G56 SHOULD BE CONSULTED (AVAILABLE FROM THE HSE WEBSITE)


**Southern Electric Power Distribution plc**  
 Registered Office: No.1 Forbury Place  
 43 Forbury Road Reading RG1 3JH  
 Registered In England & Wales No.04094290

If you're unsure & need to seek advice before commencing excavations, please contact:  
 General Enquiries: 0800 048 3516

Subject to revision - Master held by SSEN Asset Data Team:  
[Asset.Data@sse.com](mailto:Asset.Data@sse.com)  
 01256 337 294

Scale: 1:500 (When plotted at A4)



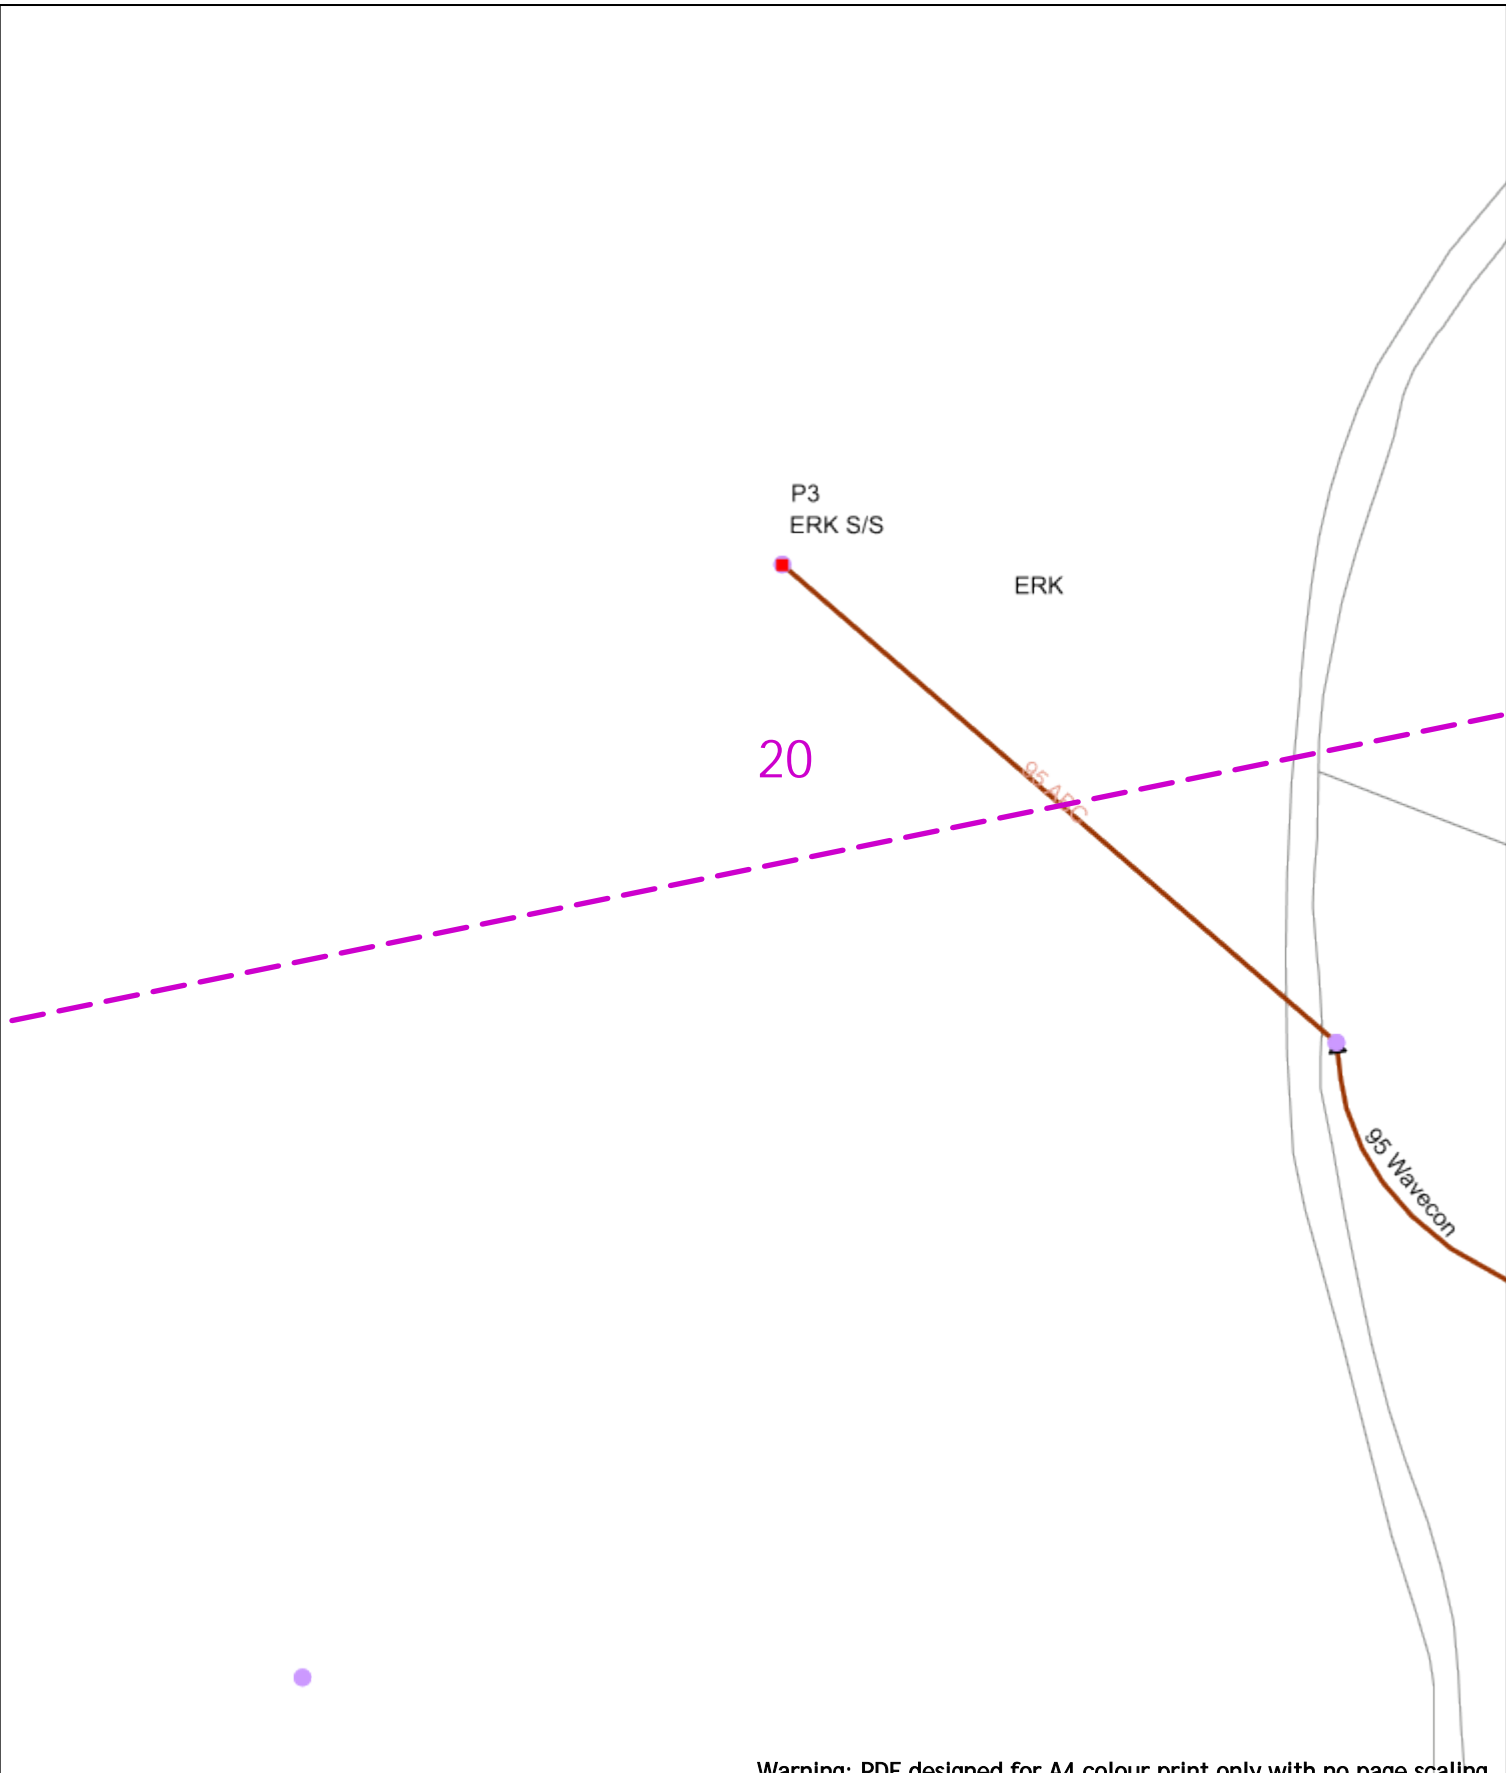

Warning: PDF designed for A4 colour print only with no page scaling

0 20m Dig Sites Area: Line:

Date Requested: 24/06/2022  
 Job Reference: 25881050  
 Site Location: 448447 212278  
 Requested by: Mr Joe Shawyer  
 Your Scheme/Reference: 31188\_004

Voltages (V)			
LV (Low Voltage) and Services	Up to 1,000V		
HV (High Voltage)	Over 1,000V to 11,000V		
EHV (Extra High Voltage)	22,000V to 132,000V		
Transmission	275,000V and 400,000V		

NORMAL DEPTH TO THE TOP OF THE CABLE WHEN LAID			
Services	LV	HV	EHV
Footpath/Unmade	0.45m	0.45m	0.6m
Road Crossing	0.6m	0.6m	0.75m
Agricultural	1m	1m	1.1m


Legend		Distribution Structures (Electric)	
	Service Cable		Pole, Existing Location
	LV Mains		Pole Structure, Existing Location - Single
	2-33kV		Pole Structure, Existing Location - H
	6.6kV		Duct Route
	11kV		Cross Section Route
	22kV		
	33kV		
	66kV		
	132kV		
	275kV		
	400kV		
	Fibre Optic		
	Rigid Cable		

**WARNING**  
 There may have been subsequent alteration to the surface levels. Trial holes must be undertaken to determine position and depths of cables. HS (G) 47 Booklet from the Health and Safety Executive - Avoiding Danger from Buried Cables - should be consulted before commencing excavation work.  
 WHEN WORKING IN THE VICINITY OF OVERHEAD LINES THE HEALTH AND SAFETY GUIDANCE NOTES G56 SHOULD BE CONSULTED (AVAILABLE FROM THE HSE WEBSITE)

**Southern Electric Power Distribution plc**  
 Registered Office: No.1 Forbury Place  
 43 Forbury Road Reading RG1 3JH  
 Registered In England & Wales No.04094290


If you're unsure & need to seek advice before commencing excavations, please contact:  
 General Enquiries: 0800 048 3516

Subject to revision - Master held by SSEN Asset Data Team:  
[Asset.Data@sse.com](mailto:Asset.Data@sse.com)  
 01256 337 294

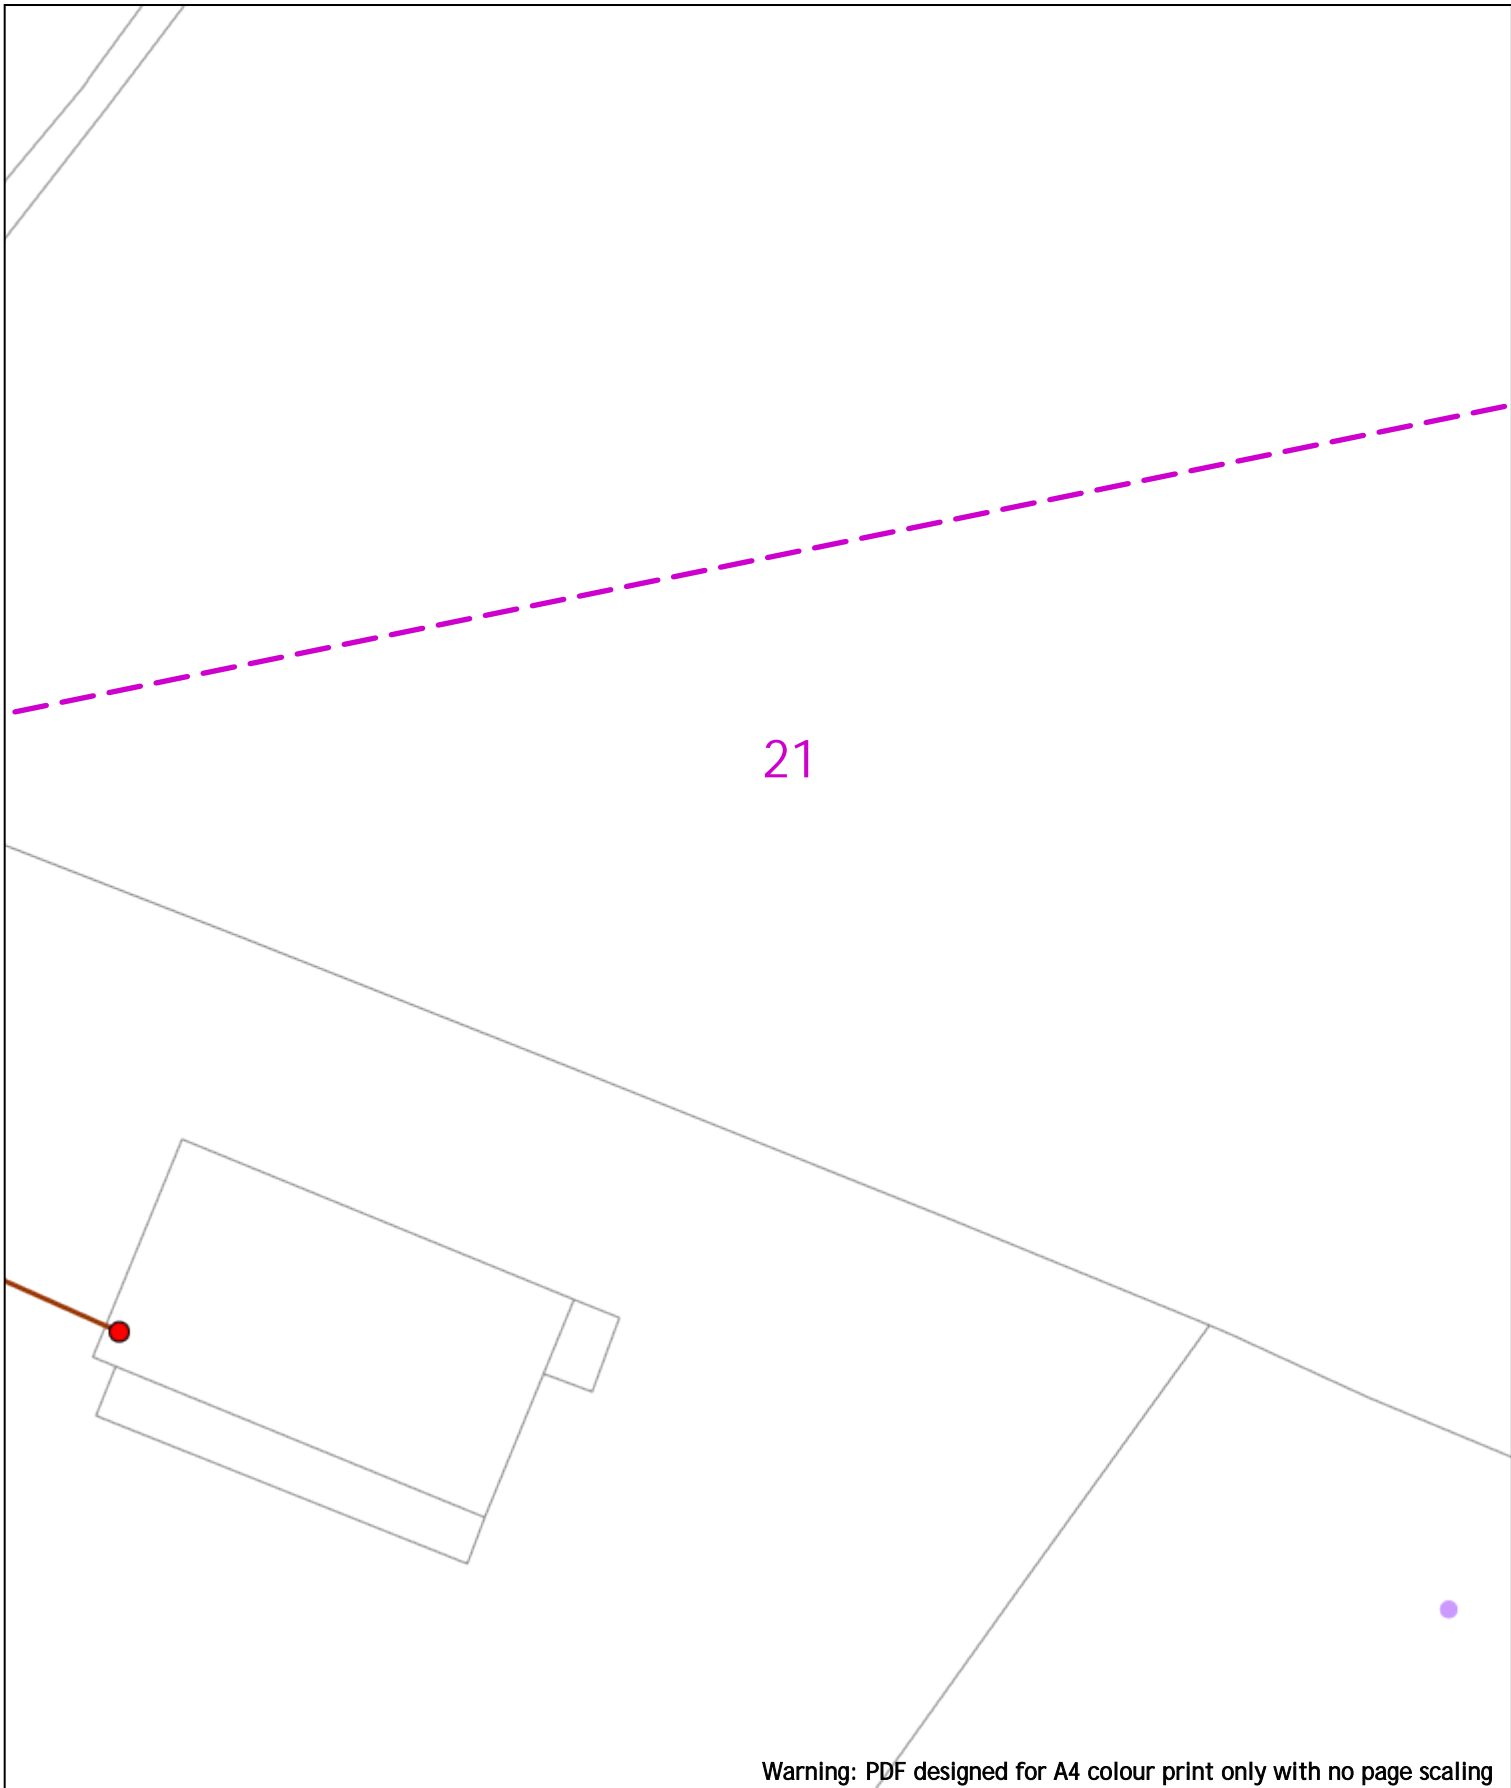

Warning: PDF designed for A4 colour print only with no page scaling

<p>0  20m Dig Sites Area:  Line: </p>	<p>Date Requested: 24/06/2022          Job Reference: 25881050          Site Location: 448447 212278          Requested by: Mr Joe Shawyer          Your Scheme/Reference: 31188_004</p>	<table border="1" style="width: 100%; border-collapse: collapse;"> <thead> <tr> <th colspan="4">Voltages (V)</th> </tr> </thead> <tbody> <tr> <td>LV (Low Voltage) and Services</td> <td colspan="3">Up to 1,000V</td> </tr> <tr> <td>HV (High Voltage)</td> <td colspan="3">Over 1,000V to 11,000V</td> </tr> <tr> <td>EHV (Extra High Voltage)</td> <td colspan="3">22,000V to 132,000V</td> </tr> <tr> <td>Transmission</td> <td colspan="3">275,000V and 400,000V</td> </tr> </tbody> </table> <table border="1" style="width: 100%; border-collapse: collapse;"> <thead> <tr> <th colspan="4">NORMAL DEPTH TO THE TOP OF THE CABLE WHEN LAID</th> </tr> <tr> <th>Services</th> <th>LV</th> <th>HV</th> <th>EHV</th> </tr> </thead> <tbody> <tr> <td>Footpath/Unmade</td> <td>0.45m</td> <td>0.45m</td> <td>0.6m 0.8m</td> </tr> <tr> <td>Road Crossing</td> <td>0.6m</td> <td>0.6m</td> <td>0.75m 0.9m</td> </tr> <tr> <td>Agricultural</td> <td>1m</td> <td>1m</td> <td>1m 1.1m</td> </tr> </tbody> </table> <p style="text-align: center; color: red; font-weight: bold; font-size: small;">WARNING</p> <p style="font-size: x-small;">There may have been subsequent alteration to the surface levels. Trial holes must be undertaken to determine position and depths of cables. HS (G) 47 Booklet from the Health and Safety Executive – Avoiding Danger from Buried Cables – should be consulted before commencing excavation work.  <b>WHEN WORKING IN THE VICINITY OF OVERHEAD LINES THE HEALTH AND SAFETY GUIDANCE NOTES G56 SHOULD BE CONSULTED (AVAILABLE FROM THE HSE WEBSITE)</b></p>	Voltages (V)				LV (Low Voltage) and Services	Up to 1,000V			HV (High Voltage)	Over 1,000V to 11,000V			EHV (Extra High Voltage)	22,000V to 132,000V			Transmission	275,000V and 400,000V			NORMAL DEPTH TO THE TOP OF THE CABLE WHEN LAID				Services	LV	HV	EHV	Footpath/Unmade	0.45m	0.45m	0.6m 0.8m	Road Crossing	0.6m	0.6m	0.75m 0.9m	Agricultural	1m	1m	1m 1.1m	<div style="text-align: center;">   </div> <p style="text-align: center; font-weight: bold; font-size: small;">Southern Electric Power Distribution plc</p> <p style="text-align: center; font-size: x-small;">Registered Office: No.1 Forbury Place          43 Forbury Road Reading RG1 3JH          Registered In England &amp; Wales No.04094290</p> <p style="text-align: center; font-size: x-small;">If you're unsure &amp; need to seek advice before commencing excavations, please contact:          General Enquiries: 0800 048 3516</p> <p style="text-align: center; font-size: x-small;">Subject to revision – Master held by SSEN Asset Data Team:  <a href="mailto:Asset.Data@sse.com">Asset.Data@sse.com</a>          01256 337 294</p>
Voltages (V)	
LV (Low Voltage) and Services	Up to 1,000V	
HV (High Voltage)	Over 1,000V to 11,000V	
EHV (Extra High Voltage)	22,000V to 132,000V	
Transmission	275,000V and 400,000V	
NORMAL DEPTH TO THE TOP OF THE CABLE WHEN LAID	
Services	LV	HV	EHV	
Footpath/Unmade	0.45m	0.45m	0.6m 0.8m	
Road Crossing	0.6m	0.6m	0.75m 0.9m	
Agricultural	1m	1m	1m 1.1m	
<p>Scale: 1:500 (When plotted at A4)</p>		<p style="text-align: center;">BASED UPON THE ORDNANCE SURVEY MAP WITH THE SANCTION OF THE CONTROLLER OF H.M. STATIONERY OFFICE CROWN COPYRIGHT RESERVED.          This copy has been made by or with the authority of Scottish and Southern Energy Power Distribution Ltd. Pursuant to section 47 of the Copyright, Designs and Patents Act 1988 ("The Act"). Unless the Act provides a relevant exception to copyright the copy must not be copied without prior permission of the copyright owner.          Plans generated by DigSAFE Pro™ software provided by Lineasarchitectofordg.</p>	

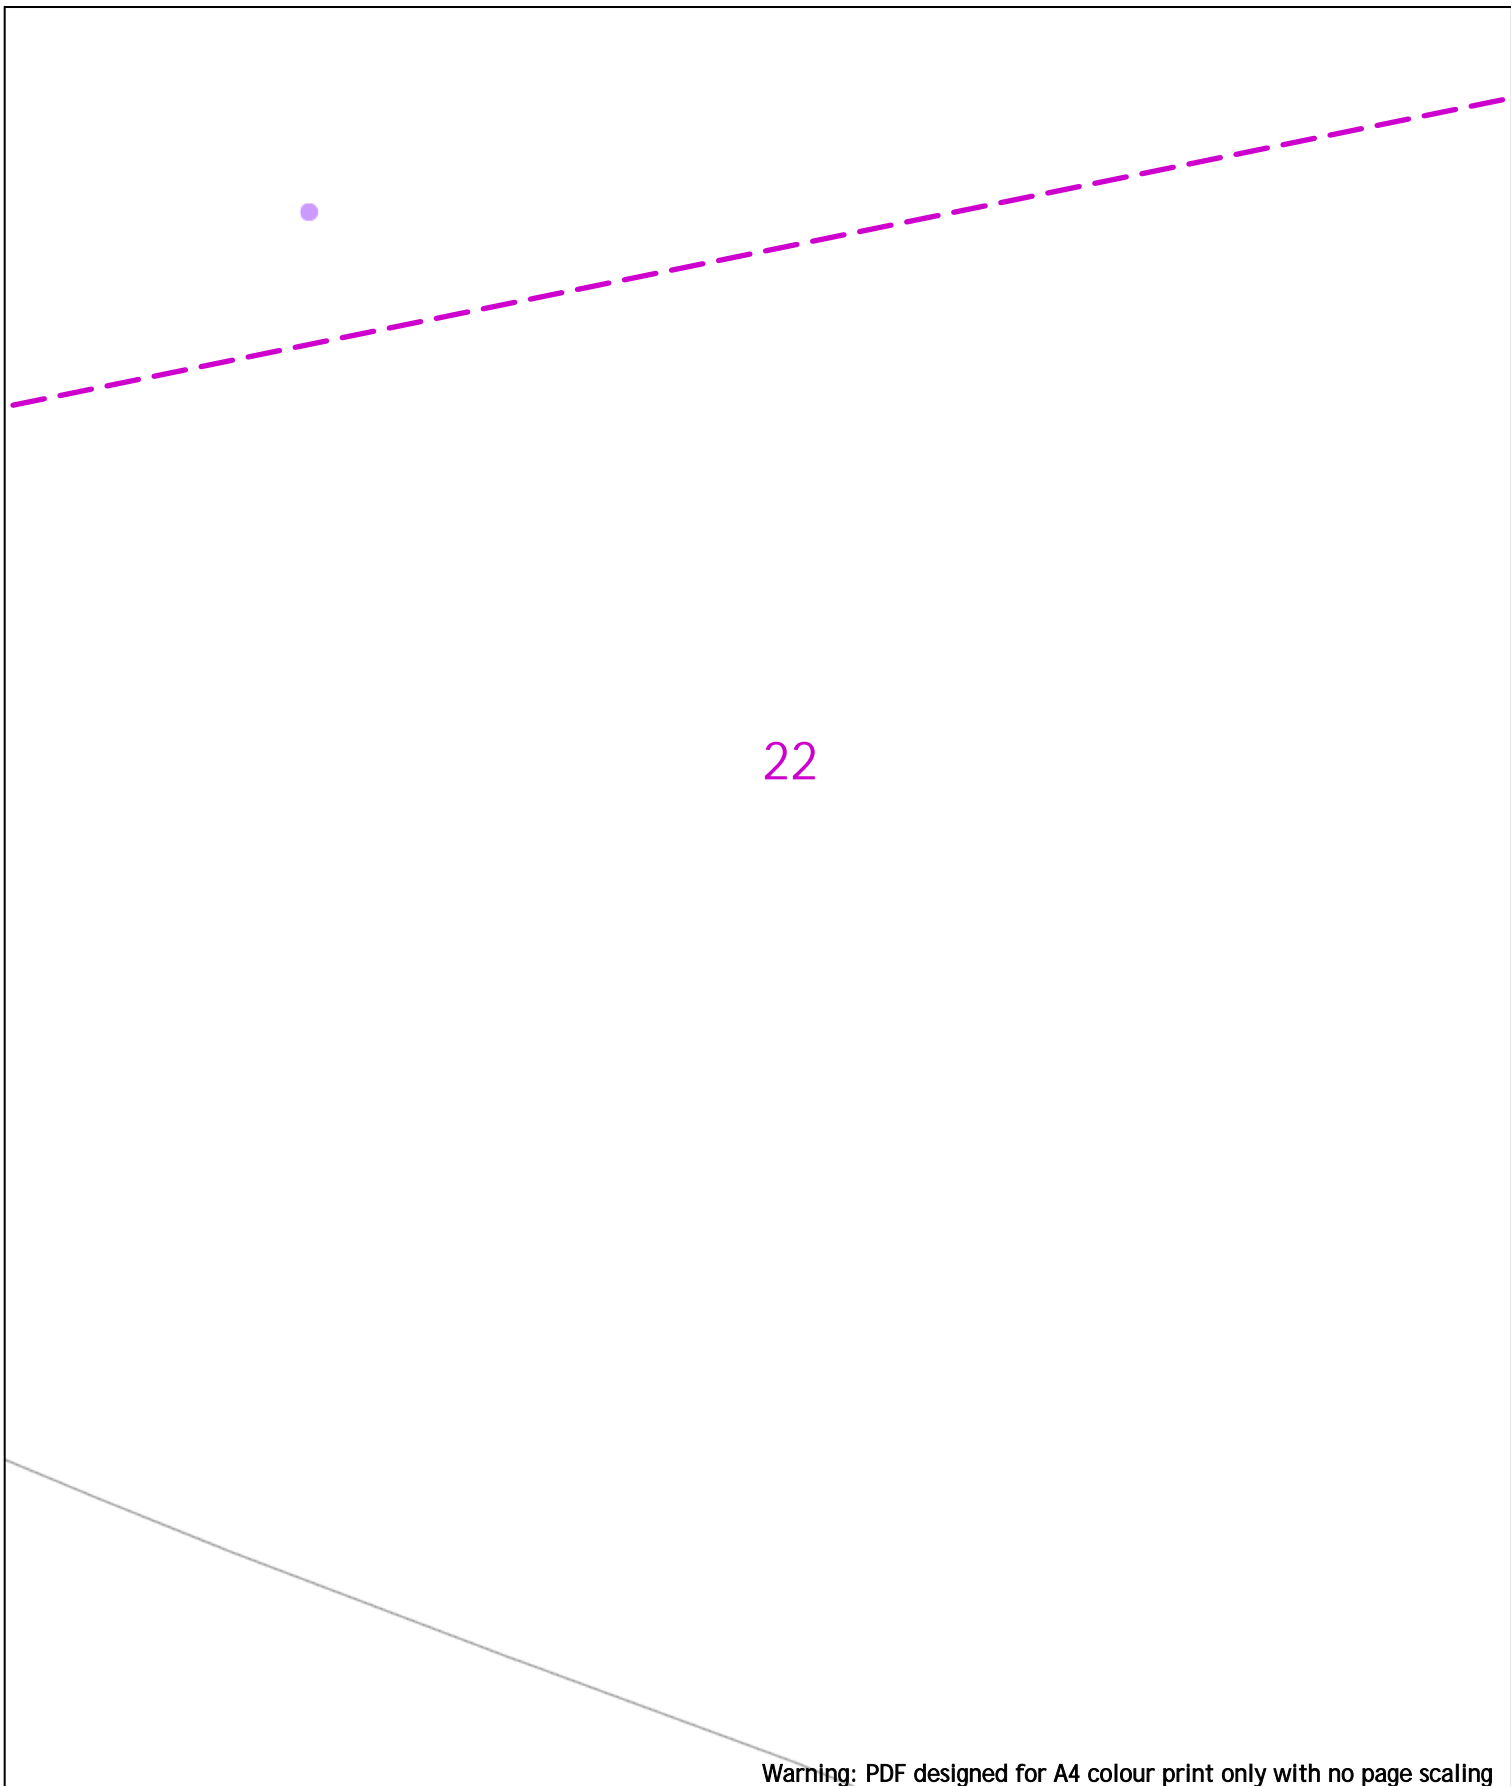

22

Warning: PDF designed for A4 colour print only with no page scaling

0 20m Dig Sites Area: Line:

Date Requested: 24/06/2022  
 Job Reference: 25881050  
 Site Location: 448447 212278  
 Requested by: Mr Joe Shawyer  
 Your Scheme/Reference: 31188\_004

Voltages (V)			
LV (Low Voltage) and Services	Up to 1,000V		
HV (High Voltage)	Over 1,000V to 11,000V		
EHV (Extra High Voltage)	22,000V to 132,000V		
Transmission	275,000V and 400,000V		

NORMAL DEPTH TO THE TOP OF THE CABLE WHEN LAID			
Services	LV	HV	EHV
Footpath/Unmade	0.45m	0.45m	0.6m
Road Crossing	0.6m	0.6m	0.75m
Agricultural	1m	1m	1.1m

**Legend**

- Service Cable
- LV Mains
- 2-33kV
- 6.6kV
- 11kV
- 22kV
- 33kV
- 66kV
- 132kV
- 275kV
- 400kV
- Fibre Optic
- Pilot Cable

**Distribution Structures (Electric)**

- Pole, Existing Location
- Pole Structure, Existing Location - Single
- Pole Structure, Existing Location - H
- Duct Route
- Cross Section Route

**WARNING**  
 There may have been subsequent alteration to the surface levels. Trial holes must be undertaken to determine position and depths of cables. HS (G) 47 Booklet from the Health and Safety Executive - Avoiding Danger from Buried Cables - should be consulted before commencing excavation work.  
 WHEN WORKING IN THE VICINITY OF OVERHEAD LINES THE HEALTH AND SAFETY GUIDANCE NOTES G56 SHOULD BE CONSULTED (AVAILABLE FROM THE HSE WEBSITE)


Scale: 1:500 (When plotted at A4)

**Southern Electric Power Distribution plc**  
 Registered Office: No.1 Forbury Place  
 43 Forbury Road Reading RG1 3JH  
 Registered In England & Wales No.04094290

If you're unsure & need to seek advice before commencing excavations, please contact:  
 General Enquiries: 0800 048 3516

Subject to revision - Master held by SSEN Asset Data Team:  
[Asset.Data@sse.com](mailto:Asset.Data@sse.com)  
 01256 337 294

BASED UPON THE ORDNANCE SURVEY MAP WITH THE SANCTION OF THE CONTROLLER OF H.M. STATIONERY OFFICE CROWN COPYRIGHT RESERVED.  
 This copy has been made by or with the authority of Scottish and Southern Energy Power Distribution Ltd. Pursuant to section 47 of the Copyright, Designs and Patents Act 1988 ("The Act"). Unless the Act provides a relevant exception to copyright the copy must not be copied without prior permission of the copyright owner.  
 Plans generated by DigSAFE Pro™ software provided by Lineascribbleforeldg.

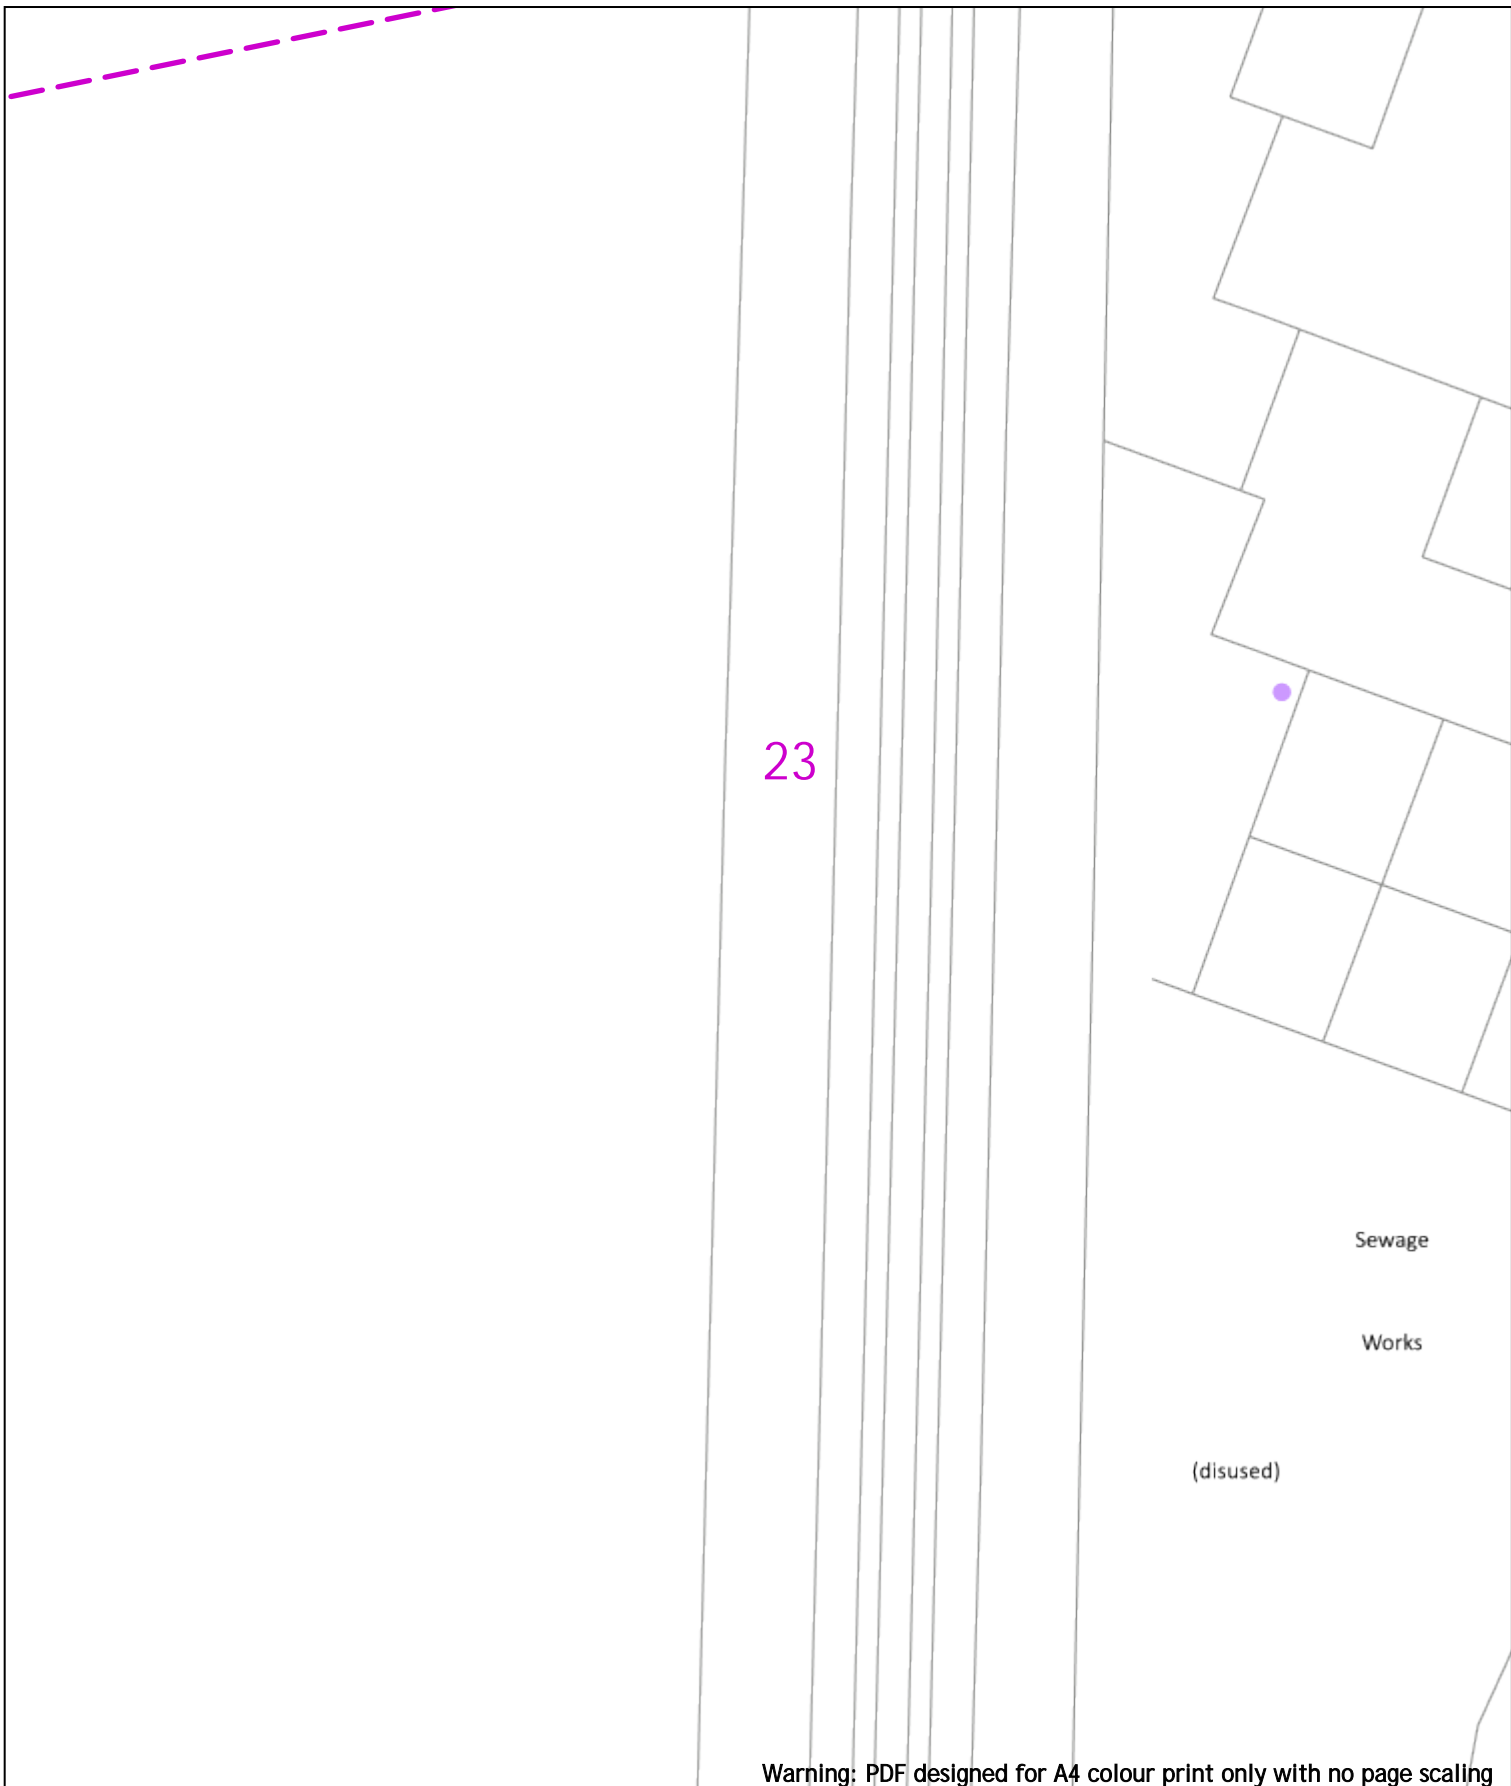

23

Sewage  
Works

(disused)

Warning: PDF designed for A4 colour print only with no page scaling

0 20m Dig Sites Area: Line:

Date Requested: 24/06/2022  
 Job Reference: 25881050  
 Site Location: 448447 212278  
 Requested by: Mr Joe Shawyer  
 Your Scheme/Reference: 31188\_004

Voltages (V)				
LV (Low Voltage) and Services	Up to 1,000V			
HV (High Voltage)	Over 1,000V to 11,000V			
EHV (Extra High Voltage)	22,000V to 132,000V			
Transmission	275,000V and 400,000V			
NORMAL DEPTH TO THE TOP OF THE CABLE WHEN LAID				
Services	LV	HV	EHV	
Footpath/Unmade	0.45m	0.45m	0.6m	0.8m
Road Crossing	0.6m	0.6m	0.75m	0.9m
Agricultural	1m	1m	1m	1.1m


Legend	Distribution Structures (Electric)
Service Cable	Pole, Existing Location
LV Mains	Pole Structure, Existing Location - Single
2-33kV	Pole Structure, Existing Location - H
6.6kV	Duct Route
11kV	Cross Section Route
22kV	
33kV	
66kV	
132kV	
275kV	
400kV	
Fibre Optic	
Riser Cable	

**WARNING**  
 There may have been subsequent alteration to the surface levels. Trial holes must be undertaken to determine position and depths of cables. HS (G) 47 Booklet from the Health and Safety Executive - Avoiding Danger from Buried Cables - should be consulted before commencing excavation work.  
 WHEN WORKING IN THE VICINITY OF OVERHEAD LINES THE HEALTH AND SAFETY GUIDANCE NOTES G56 SHOULD BE CONSULTED (AVAILABLE FROM THE HSE WEBSITE)

**Southern Electric Power Distribution plc**  
 Registered Office: No.1 Forbury Place  
 43 Forbury Road Reading RG1 3JH  
 Registered In England & Wales No.04094290

If you're unsure & need to seek advice before commencing excavations, please contact:  
 General Enquiries: 0800 048 3516

Subject to revision - Master held by SSEN Asset Data Team:  
[Asset.Data@sse.com](mailto:Asset.Data@sse.com)  
 01256 337 294

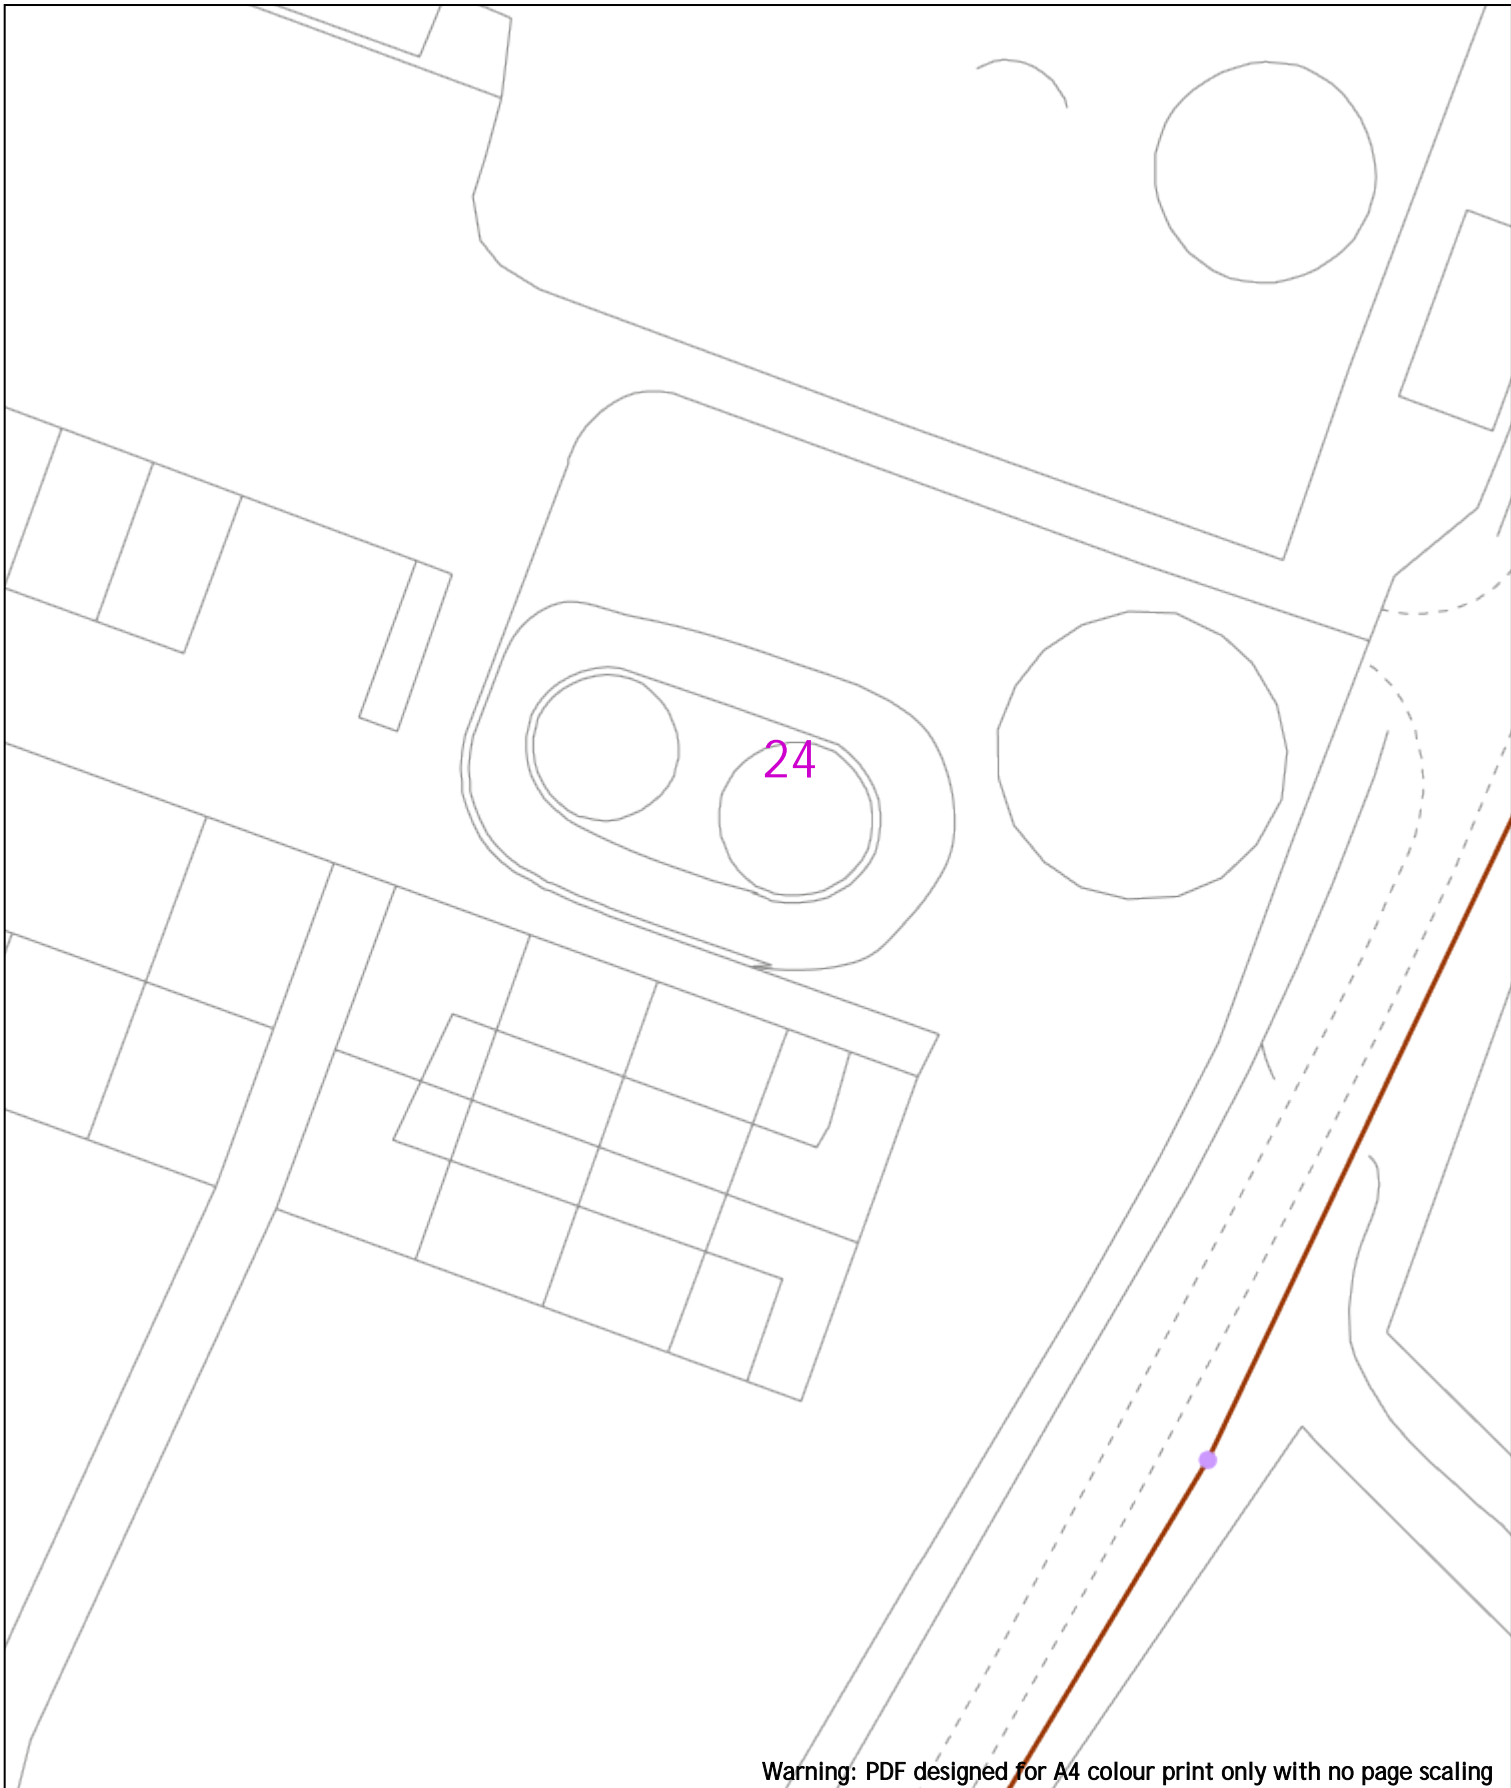

Warning: PDF designed for A4 colour print only with no page scaling

0 20m Dig Sites Area: Line:

Date Requested: 24/06/2022  
 Job Reference: 25881050  
 Site Location: 448447 212278  
 Requested by: Mr Joe Shawyer  
 Your Scheme/Reference: 31188\_004

Voltages (V)			
LV (Low Voltage) and Services	Up to 1,000V		
HV (High Voltage)	Over 1,000V to 11,000V		
EHV (Extra High Voltage)	22,000V to 132,000V		
Transmission	275,000V and 400,000V		

NORMAL DEPTH TO THE TOP OF THE CABLE WHEN LAID			
Services	LV	HV	EHV
Footpath/Unmade	0.45m	0.45m	0.8m
Road Crossing	0.6m	0.6m	0.9m
Agricultural	1m	1m	1.1m

Legend		Distribution Structures (Electric)	
	Service Cable		Pole, Existing Location
	LV Main		Pole Structure, Existing Location - Single
	6.6kV		Pole Structure, Existing Location - H
	11kV		Duct Route
	22kV		Cross Section Route
	33kV		
	66kV		
	132kV		
	275kV		
	400kV		
	Fibre Optic		
	Fiber Cable		


**WARNING**  
 There may have been subsequent alteration to the surface levels. Trial holes must be undertaken to determine position and depths of cables. HS (G) 47 Booklet from the Health and Safety Executive - Avoiding Danger from Buried Cables - should be consulted before commencing excavation work.  
 WHEN WORKING IN THE VICINITY OF OVERHEAD LINES THE HEALTH AND SAFETY GUIDANCE NOTES G56 SHOULD BE CONSULTED (AVAILABLE FROM THE HSE WEBSITE)

Scale: 1:500 (When plotted at A4)

**Southern Electric Power Distribution plc**  
 Registered Office: No.1 Forbury Place  
 43 Forbury Road Reading RG1 3JH  
 Registered In England & Wales No.04094290

If you're unsure & need to seek advice before commencing excavations, please contact:  
 General Enquiries: 0800 048 3516

Subject to revision - Master held by SSEN Asset Data Team:  
[Asset.Data@sse.com](mailto:Asset.Data@sse.com)  
 01256 337 294

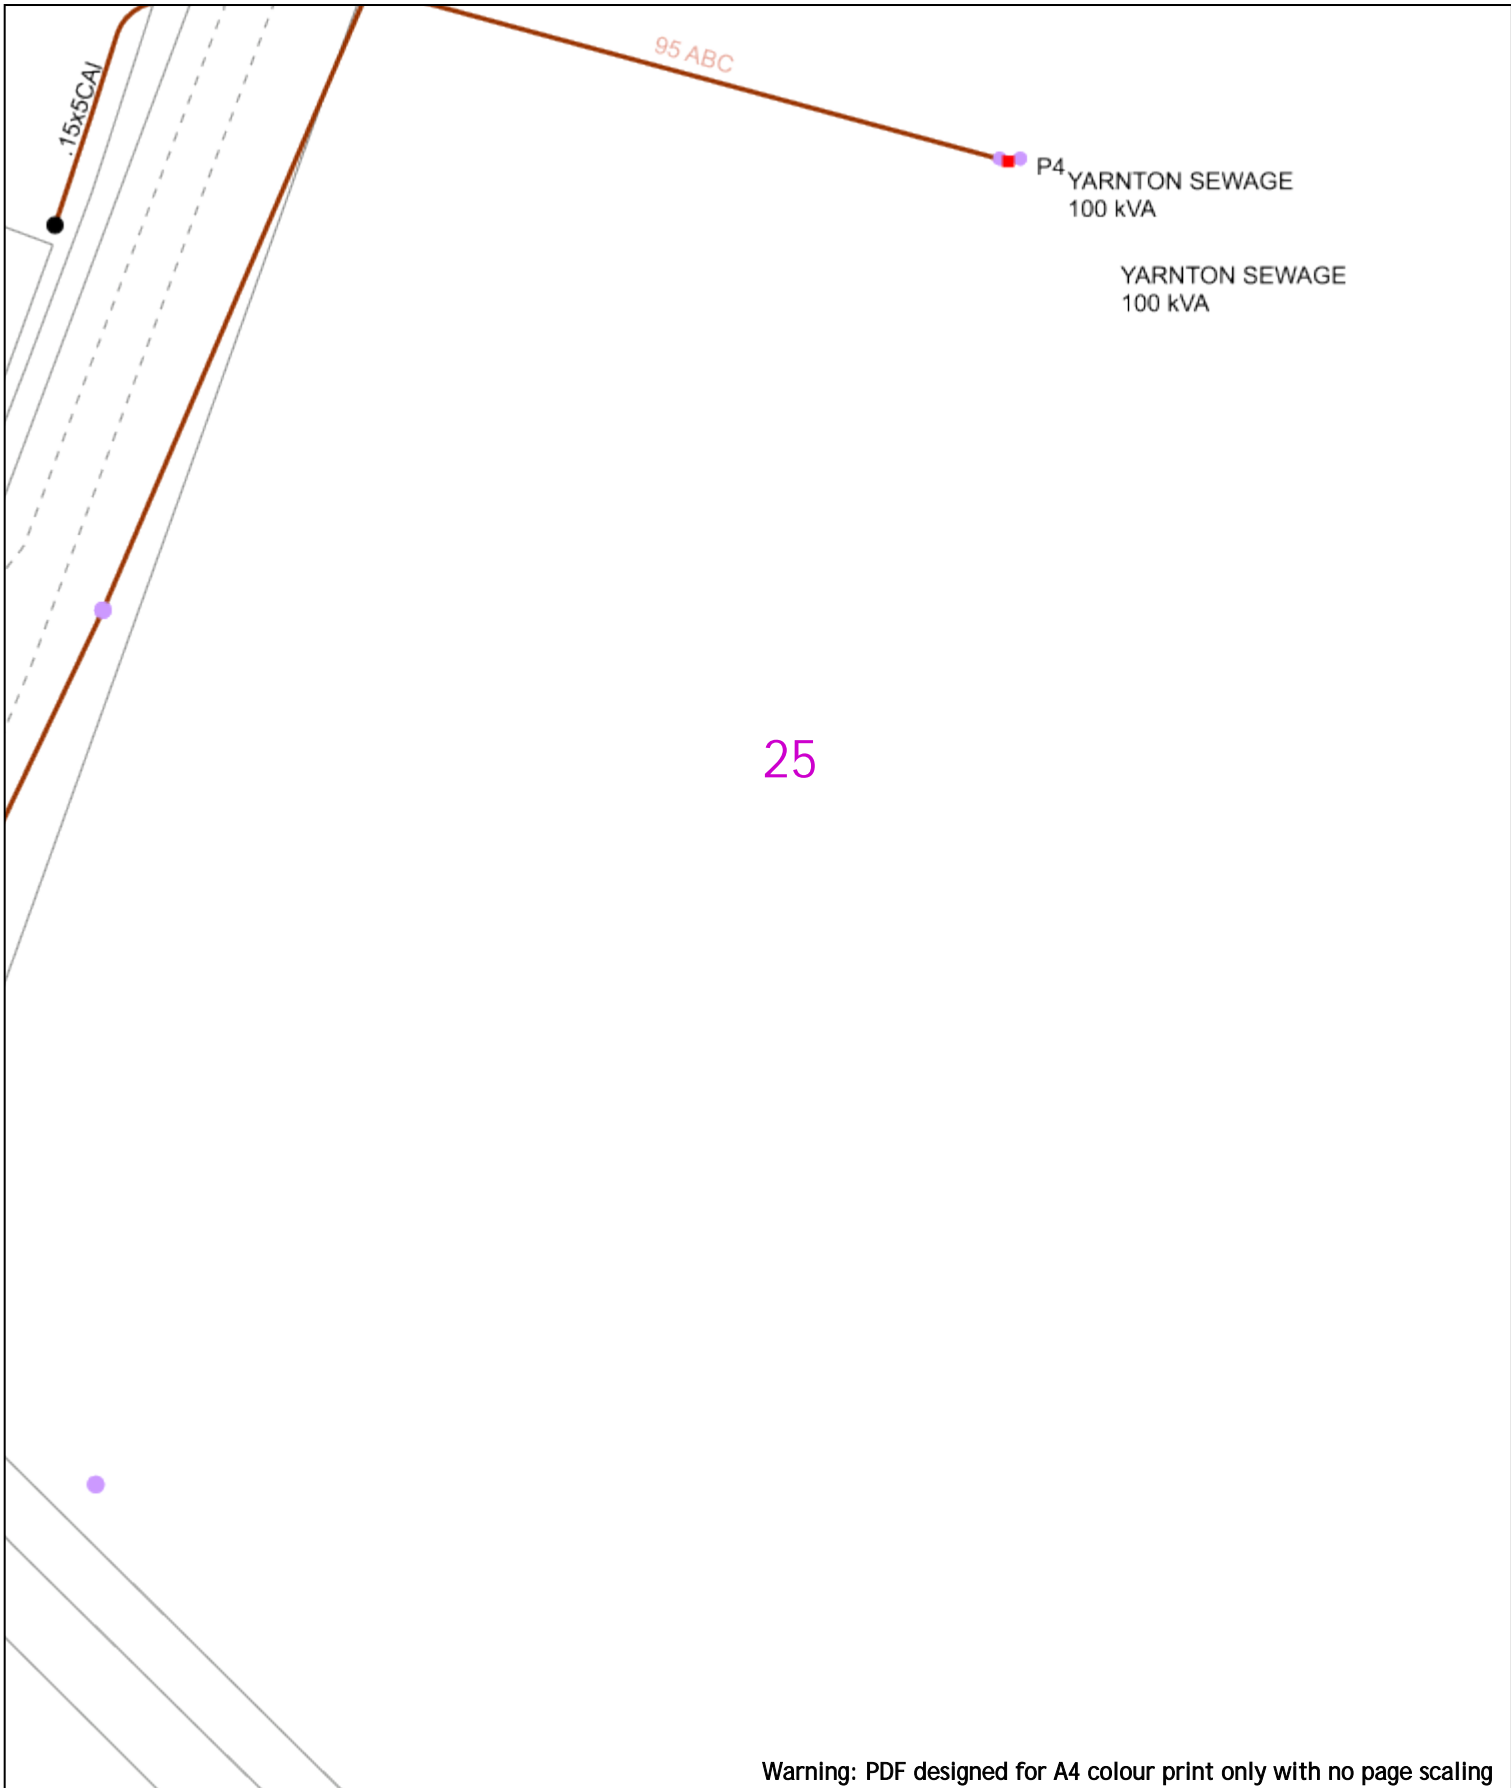


25

Warning: PDF designed for A4 colour print only with no page scaling

<p>0  20m Dig Sites Area:  Line: </p>	<p>Date Requested: 24/06/2022 Job Reference: 25881050 Site Location: 448447 212278 Requested by: Mr Joe Shawyer Your Scheme/Reference: 31188_004</p>	<table border="1" style="width: 100%; border-collapse: collapse;"> <thead> <tr> <th colspan="4">Voltages (V)</th> </tr> </thead> <tbody> <tr> <td>LV (Low Voltage) and Services</td> <td colspan="3">Up to 1,000V</td> </tr> <tr> <td>HV (High Voltage)</td> <td colspan="3">Over 1,000V to 11,000V</td> </tr> <tr> <td>EHV (Extra High Voltage)</td> <td colspan="3">22,000V to 132,000V</td> </tr> <tr> <td>Transmission</td> <td colspan="3">275,000V and 400,000V</td> </tr> <tr> <th colspan="4">NORMAL DEPTH TO THE TOP OF THE CABLE WHEN LAID</th> </tr> <tr> <td>Services</td> <td>LV</td> <td>HV</td> <td>EHV</td> </tr> <tr> <td>Footpath/Unmade</td> <td>0.45m</td> <td>0.45m</td> <td>0.6m</td> </tr> <tr> <td>Road Crossing</td> <td>0.6m</td> <td>0.6m</td> <td>0.75m</td> </tr> <tr> <td>Agricultural</td> <td>1m</td> <td>1m</td> <td>1.1m</td> </tr> </tbody> </table>	Voltages (V)				LV (Low Voltage) and Services	Up to 1,000V			HV (High Voltage)	Over 1,000V to 11,000V			EHV (Extra High Voltage)	22,000V to 132,000V			Transmission	275,000V and 400,000V			NORMAL DEPTH TO THE TOP OF THE CABLE WHEN LAID				Services	LV	HV	EHV	Footpath/Unmade	0.45m	0.45m	0.6m	Road Crossing	0.6m	0.6m	0.75m	Agricultural	1m	1m	1.1m	<table border="1" style="width: 100%; border-collapse: collapse;"> <thead> <tr> <th colspan="2">Legend</th> <th colspan="2">Distribution Structures (Electric)</th> </tr> </thead> <tbody> <tr> <td></td> <td>Service Cable</td> <td></td> <td>Pole, Existing Location</td> </tr> <tr> <td></td> <td>LV Main</td> <td></td> <td>Pole Structure, Existing Location - Single</td> </tr> <tr> <td></td> <td>2-33kV</td> <td></td> <td>Pole Structure, Existing Location - H</td> </tr> <tr> <td></td> <td>6.6kV</td> <td></td> <td>Duct Route</td> </tr> <tr> <td></td> <td>11kV</td> <td></td> <td>Cross Section Route</td> </tr> <tr> <td></td> <td>22kV</td> <td></td> <td></td> </tr> <tr> <td></td> <td>33kV</td> <td></td> <td></td> </tr> <tr> <td></td> <td>66kV</td> <td></td> <td></td> </tr> <tr> <td></td> <td>132kV</td> <td></td> <td></td> </tr> <tr> <td></td> <td>275kV</td> <td></td> <td></td> </tr> <tr> <td></td> <td>400kV</td> <td></td> <td></td> </tr> <tr> <td></td> <td>Fibre Optic</td> <td></td> <td></td> </tr> <tr> <td></td> <td>Riser Cable</td> <td></td> <td></td> </tr> </tbody> </table>	Legend		Distribution Structures (Electric)			Service Cable		Pole, Existing Location		LV Main		Pole Structure, Existing Location - Single		2-33kV		Pole Structure, Existing Location - H		6.6kV		Duct Route		11kV		Cross Section Route		22kV				33kV				66kV				132kV				275kV				400kV				Fibre Optic				Riser Cable			<div style="text-align: center;"> </div> <div style="text-align: center;"> </div> <p style="text-align: center;"><b>Southern Electric Power Distribution plc</b> Registered Office: No.1 Forbury Place 43 Forbury Road Reading RG1 3JH Registered In England &amp; Wales No.04094290</p> <p style="text-align: center;">If you're unsure &amp; need to seek advice before commencing excavations, please contact: General Enquiries: 0800 048 3516</p> <p style="text-align: center;">Subject to revision – Master held by SSEN Asset Data Team: <a href="mailto:Asset.Data@sse.com">Asset.Data@sse.com</a> 01256 337 294</p>
Voltages (V)	
LV (Low Voltage) and Services	Up to 1,000V	
HV (High Voltage)	Over 1,000V to 11,000V	
EHV (Extra High Voltage)	22,000V to 132,000V	
Transmission	275,000V and 400,000V	
NORMAL DEPTH TO THE TOP OF THE CABLE WHEN LAID	
Services	LV	HV	EHV	
Footpath/Unmade	0.45m	0.45m	0.6m	
Road Crossing	0.6m	0.6m	0.75m	
Agricultural	1m	1m	1.1m	
Legend		Distribution Structures (Electric)	
	Service Cable		Pole, Existing Location	
	LV Main		Pole Structure, Existing Location - Single	
	2-33kV		Pole Structure, Existing Location - H	
	6.6kV		Duct Route	
	11kV		Cross Section Route	
	22kV	
	33kV	
	66kV	
	132kV	
	275kV	
	400kV	
	Fibre Optic	
	Riser Cable	
<p>Scale: 1:500 (When plotted at A4)</p>		<p><b>WARNING</b> There may have been subsequent alteration to the surface levels. Trial holes must be undertaken to determine position and depths of cables. HS (G) 47 Booklet from the Health and Safety Executive – Avoiding Danger from Buried Cables – should be consulted before commencing excavation work. <b>WHEN WORKING IN THE VICINITY OF OVERHEAD LINES THE HEALTH AND SAFETY GUIDANCE NOTES G56 SHOULD BE CONSULTED (AVAILABLE FROM THE HSE WEBSITE)</b></p>		<p style="font-size: small;">BASED UPON THE ORDNANCE SURVEY MAP WITH THE SANCTION OF THE CONTROLLER OF H.M. STATIONERY OFFICE CROWN COPYRIGHT RESERVED. This copy has been made by or with the authority of Scottish and Southern Energy Power Distribution Ltd. Pursuant to section 47 of the Copyright, Designs and Patents Act 1988 ("The Act"). Unless the Act provides a relevant exception to copyright the copy must not be copied without prior permission of the copyright owner. Plans generated by DigSAFE Pro™ software provided by Linearcableforelding.</p>	

Warning: PDF designed for A4 colour print only with no page scaling

0  20m Dig Sites Area:  Line: 



Date Requested: 24/06/2022  
 Job Reference: 25881050  
 Site Location: 448447 212278  
 Requested by: Mr Joe Shawyer  
 Your Scheme/Reference: 31188\_004

Voltages (V)			
LV (Low Voltage) and Services	Up to 1,000V		
HV (High Voltage)	Over 1,000V to 11,000V		
EHV (Extra High Voltage)	22,000V to 132,000V		
Transmission	275,000V and 400,000V		
NORMAL DEPTH TO THE TOP OF THE CABLE WHEN LAID			
Services	LV	HV	EHV
Footpath/Unmade	0.45m	0.45m	0.6m 0.8m
Road Crossing	0.6m	0.6m	0.75m 0.9m
Agricultural	1m	1m	1m 1.1m

**Legend**

- Service Cable
- LV Mains
- 2-33kV
- 6.6kV
- 11kV
- 22kV
- 33kV
- 66kV
- 132kV
- 275kV
- 400kV
- Fibre Optic
- Pilot Cable

**Distribution Structures (Electric)**

- Pole, Existing Location
- Pole Structure, Existing Location - Single
- Pole Structure, Existing Location - H
- Duct Route
- Cross Section Route

WARNING

There may have been subsequent alteration to the surface levels. Trial holes must be undertaken to determine position and depths of cables. HS (G) 47 Booklet from the Health and Safety Executive - Avoiding Danger from Buried Cables - should be consulted before commencing excavation work.

WHEN WORKING IN THE VICINITY OF OVERHEAD LINES THE HEALTH AND SAFETY GUIDANCE NOTES G56 SHOULD BE CONSULTED (AVAILABLE FROM THE HSE WEBSITE)

**Southern Electric Power Distribution plc**  
 Registered Office: No.1 Forbury Place  
 43 Forbury Road Reading RG1 3JH  
 Registered In England & Wales No.04094290

If you're unsure & need to seek advice before commencing excavations, please contact:  
 General Enquiries: 0800 048 3516

Subject to revision - Master held by SSEN Asset Data Team:  
[Asset.Data@sse.com](mailto:Asset.Data@sse.com)  
 01256 337 294

Scale: 1:500 (When plotted at A4)