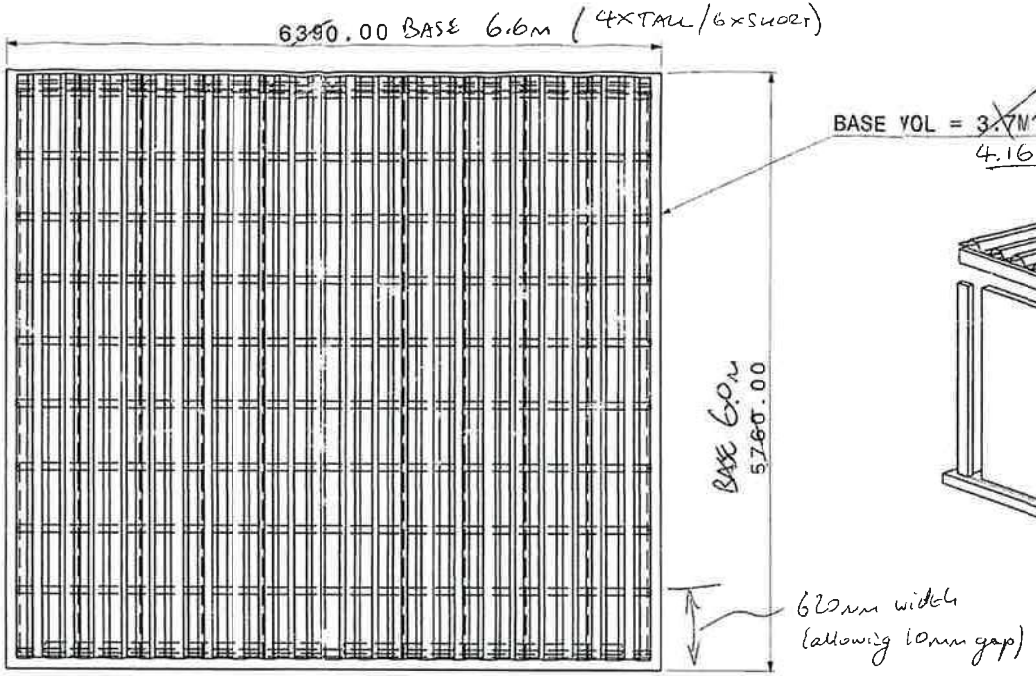

TOP VIEW
SCALE: 1:50

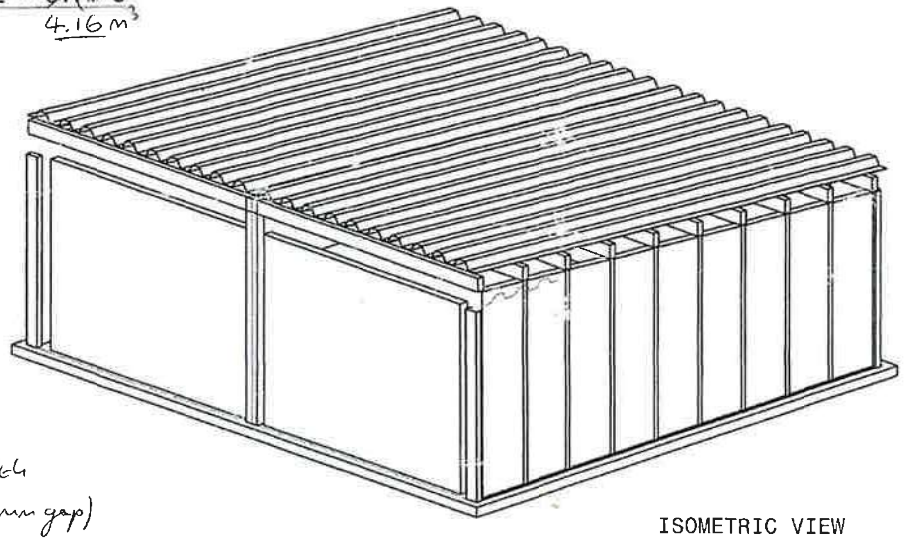

ISOMETRIC VIEW
SCALE: 1:50

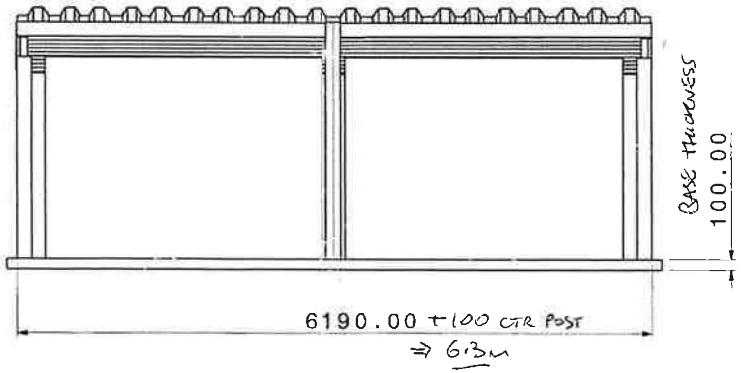

FRONT VIEW
SCALE: 1:50

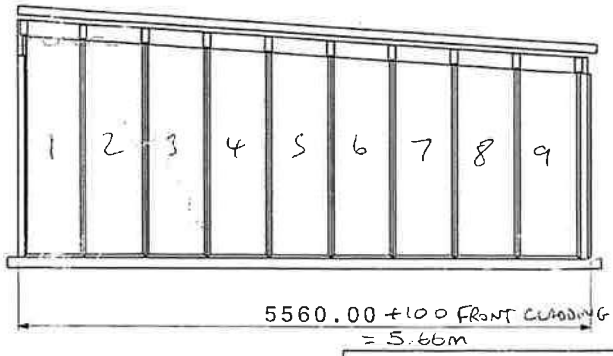

RIGHT VIEW
SCALE: 1:50

Sluttering

Circumference = 6 + 6 + 6.6 + 6.6
= 25.2m

4.2 × 4 = 16.8m
25.4 − 16.8 = 8.6
Say 6 length of 4.2m Sluttering

DOUBLE GARAGE DRAWING
SCALE 1:50
SHEET SIZE A3

PROPOSED SITE; COTSWOLD CLOSE, SIBFORD GOWER
APPLICANT; CHRISTIAN FLETCHER
01608 678000 DAY.