
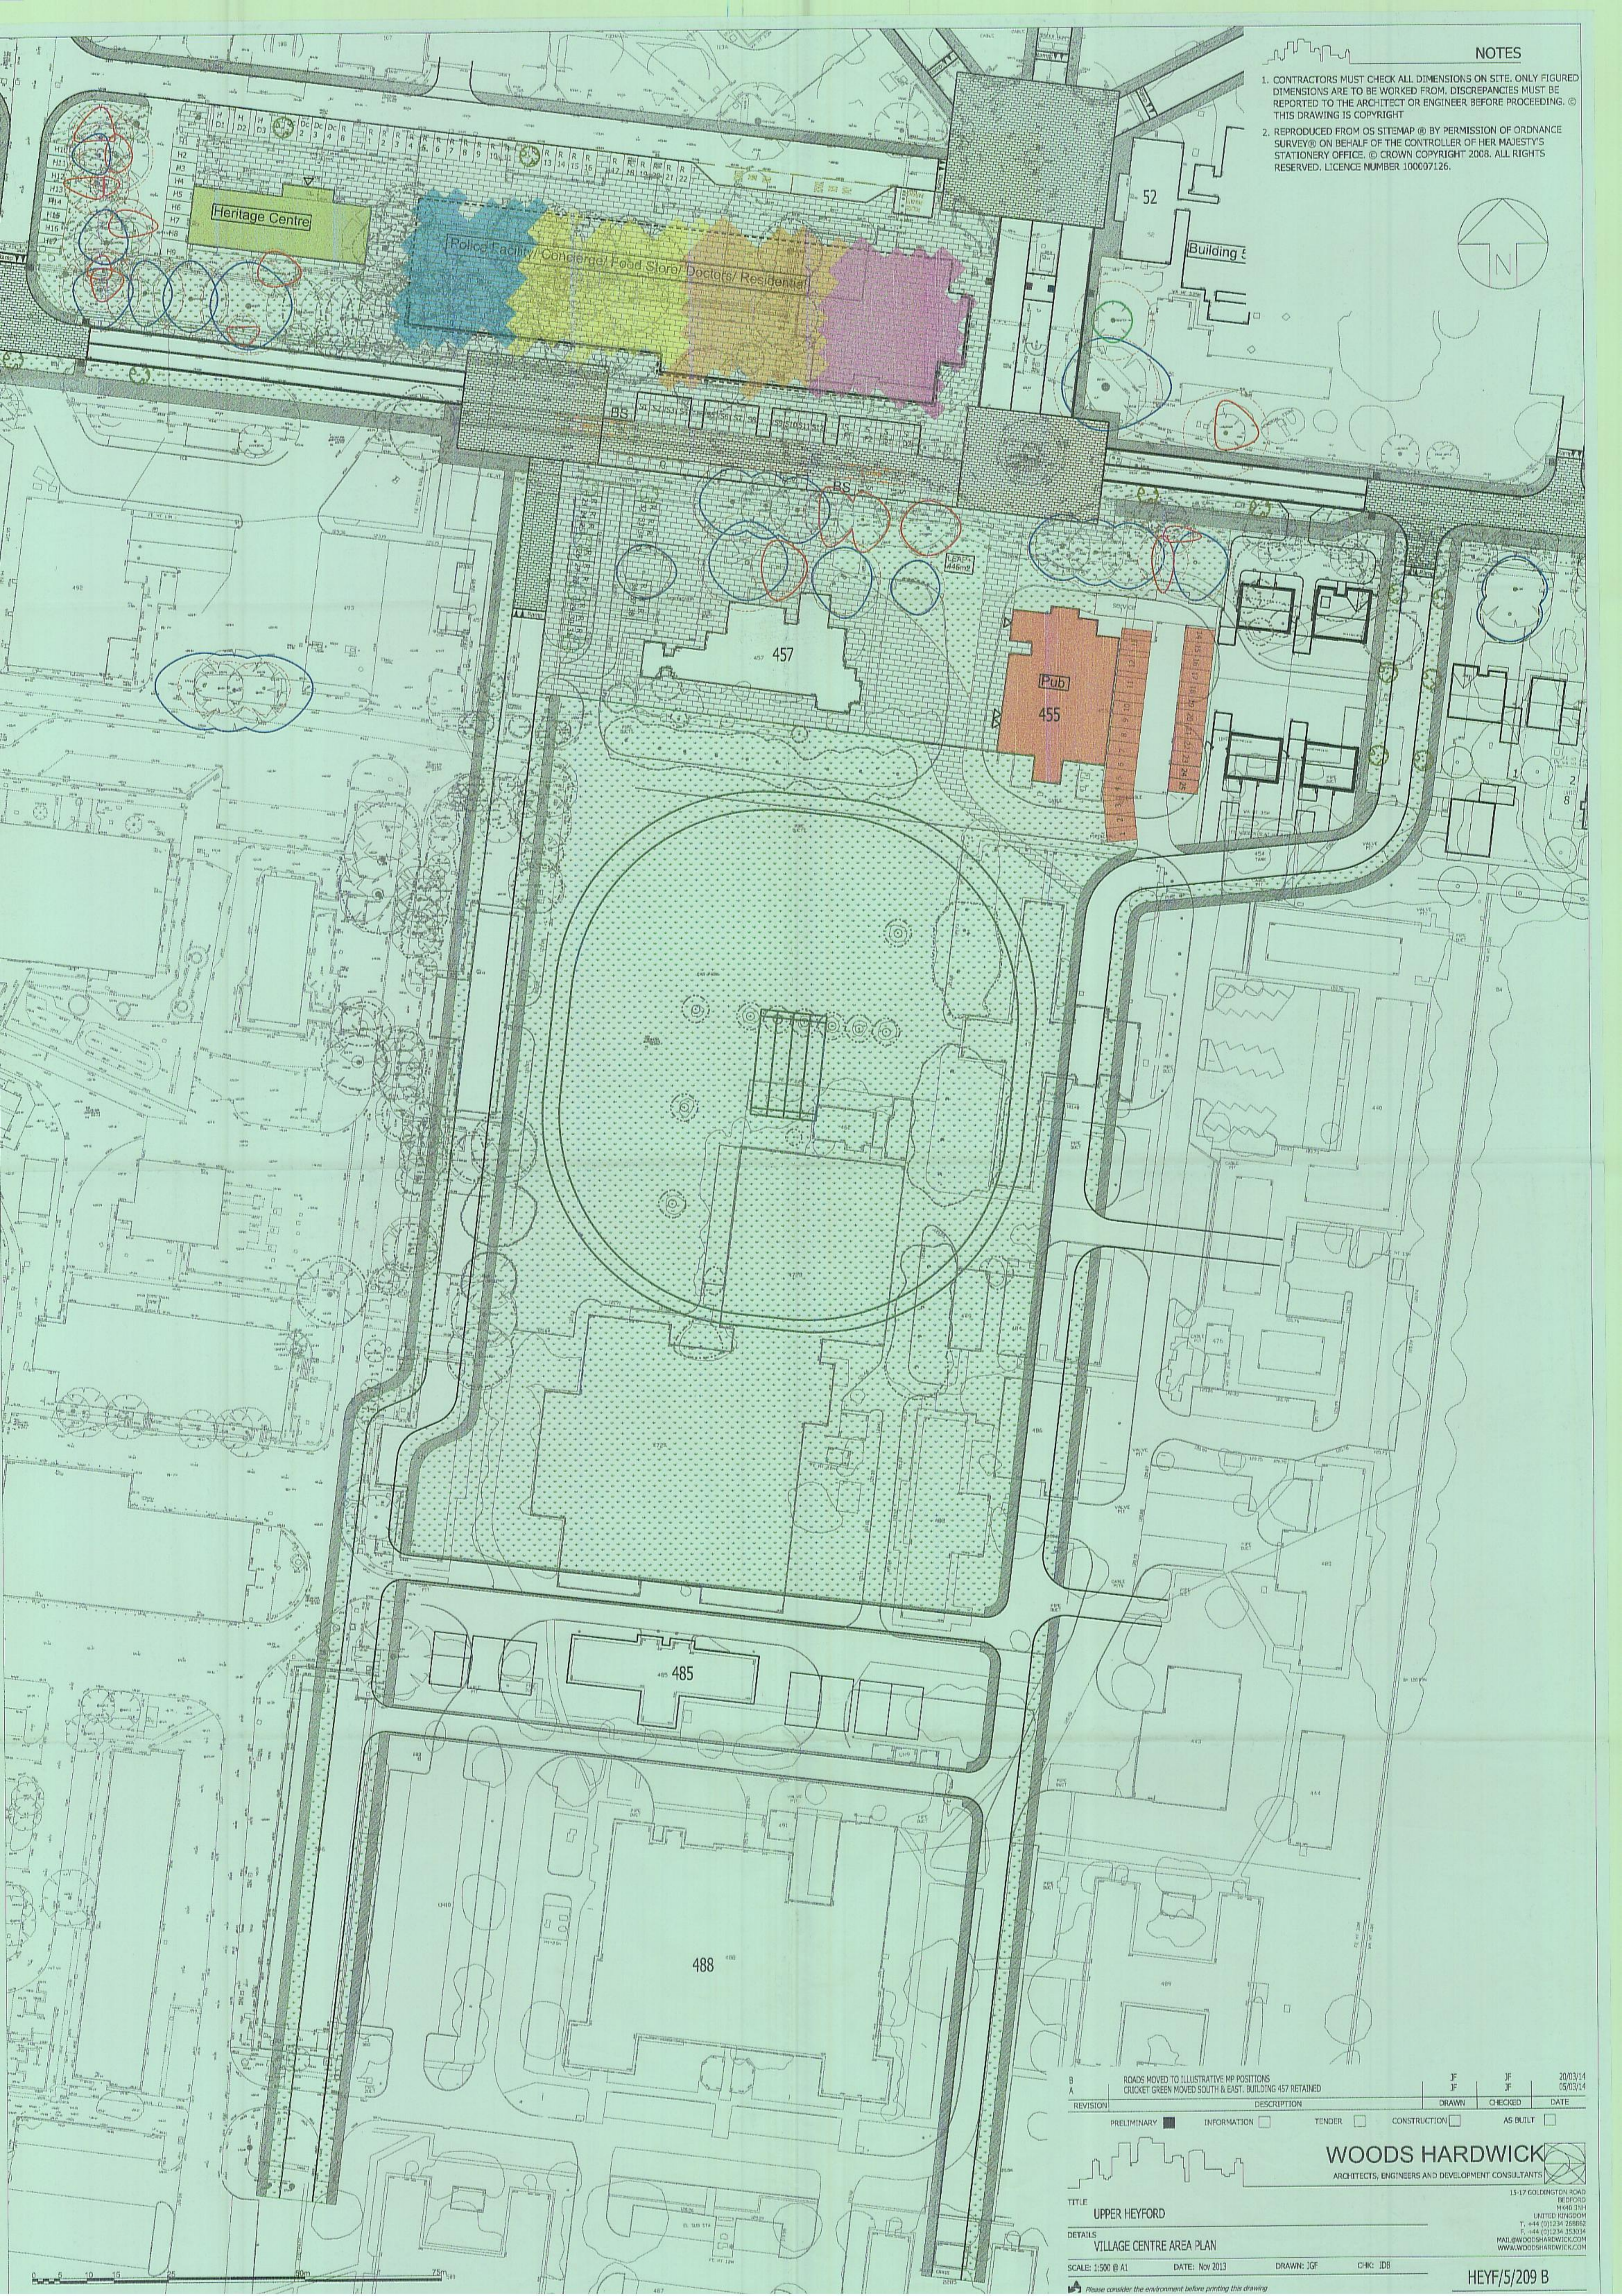


NOTES

1. CONTRACTORS MUST CHECK ALL DIMENSIONS ON SITE. ONLY FIGURED DIMENSIONS ARE TO BE WORKED FROM. DISCREPANCIES MUST BE REPORTED TO THE ARCHITECT OR ENGINEER BEFORE PROCEEDING. © THIS DRAWING IS COPYRIGHT
2. REPRODUCED FROM OS SITEMAP © BY PERMISSION OF ORDNANCE SURVEY © ON BEHALF OF THE CONTROLLER OF HER MAJESTY'S STATIONERY OFFICE. © CROWN COPYRIGHT 2008. ALL RIGHTS RESERVED. LICENCE NUMBER 100007126.

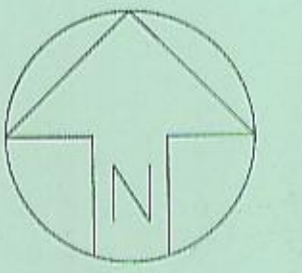

B	ROADS MOVED TO ILLUSTRATIVE MP POSITIONS	JF	JF	20/03/14
A	CRICKET GREEN MOVED SOUTH & EAST, BUILDING 457 RETAINED	JF	JF	05/03/14
REVISION	DESCRIPTION	DRAWN	CHECKED	DATE

PRELIMINARY INFORMATION TENDER CONSTRUCTION AS BUILT

WOODS HARDWICK
ARCHITECTS, ENGINEERS AND DEVELOPMENT CONSULTANTS

TITLE: UPPER HEYFORD
DETAILS: VILLAGE CENTRE AREA PLAN
SCALE: 1:500 @ A1 DATE: Nov 2013 DRAWN: JGF CHK: JDB