

PRELIMINARY CONSTRUCTION



Drawings must be printed/reproduced in colour.

Revision	Date	Revision notes	Design change	Issued by
A	05.11.13	General drawing update: Chestnut pale fencing removed where clouded. References to tarmac resurfacing removed. Change of material to raised performance space. Benching removed. Drawing number changed from L1900 to L1920.	LH	JN
B	03.12.13	Landscape amended to suit marked up drawings. Area of paving slabs changed to tarmac. area of grass increased.	SN	CH
C	07.04.14	Landscape amended to suit Kier comments 02.04.14	SN	U
D	22.04.14	Landscape amended to suit Kier comments 17.04.14	SN	U
E	24.04.14	Landscape amended to suit Kier comments 24.04.14	SN	U
F	12.05.14	Levels amended to north elevation	SN	U
G	19.06.14	Levels checked and main entrance pavement amended	JN	JN
H	02.07.14	Planning Issue	TFW	TFW
I	15.08.14	Amendments in line with Kier meeting 30.07.13 and updates from engineers.	CH	JN
J	13.11.14	Drawing number changed from L900 to L1900	TW	CH
K	20.11.14	Bike hoop hard standing amended.	U	CH
L	21.01.15	Soft landscape amended in line with comments from Tim Screen	CH	JN
M	29.01.15	Junior cycle shelter added	CH	JN
N	04.03.15	Nursery area amended	CH	JN
O	05.03.15	Nursery area amended	CH	JN
P	01.06.17	Sports equipment added	JT	JN

Job title
Heyford Park Free School Sports Hall


Drawing title
Proposed Landscape Plan

First issued	01.11.13
Drawn by	LH
Drawing sheet size	A1
Scale	1:200
Issued by	JN
Job code	HFSK-SH
Drawing number prefix	L
Drawing number	1900
Revision	P



33a Victoria Street
Birmingham
B1 3ND
T +44(0)121 234 4460
F +44(0)121 234 6450
bham@dp-architects.co.uk
www.dp-architects.co.uk

Check all dimensions and verify on site. Report any errors or omissions

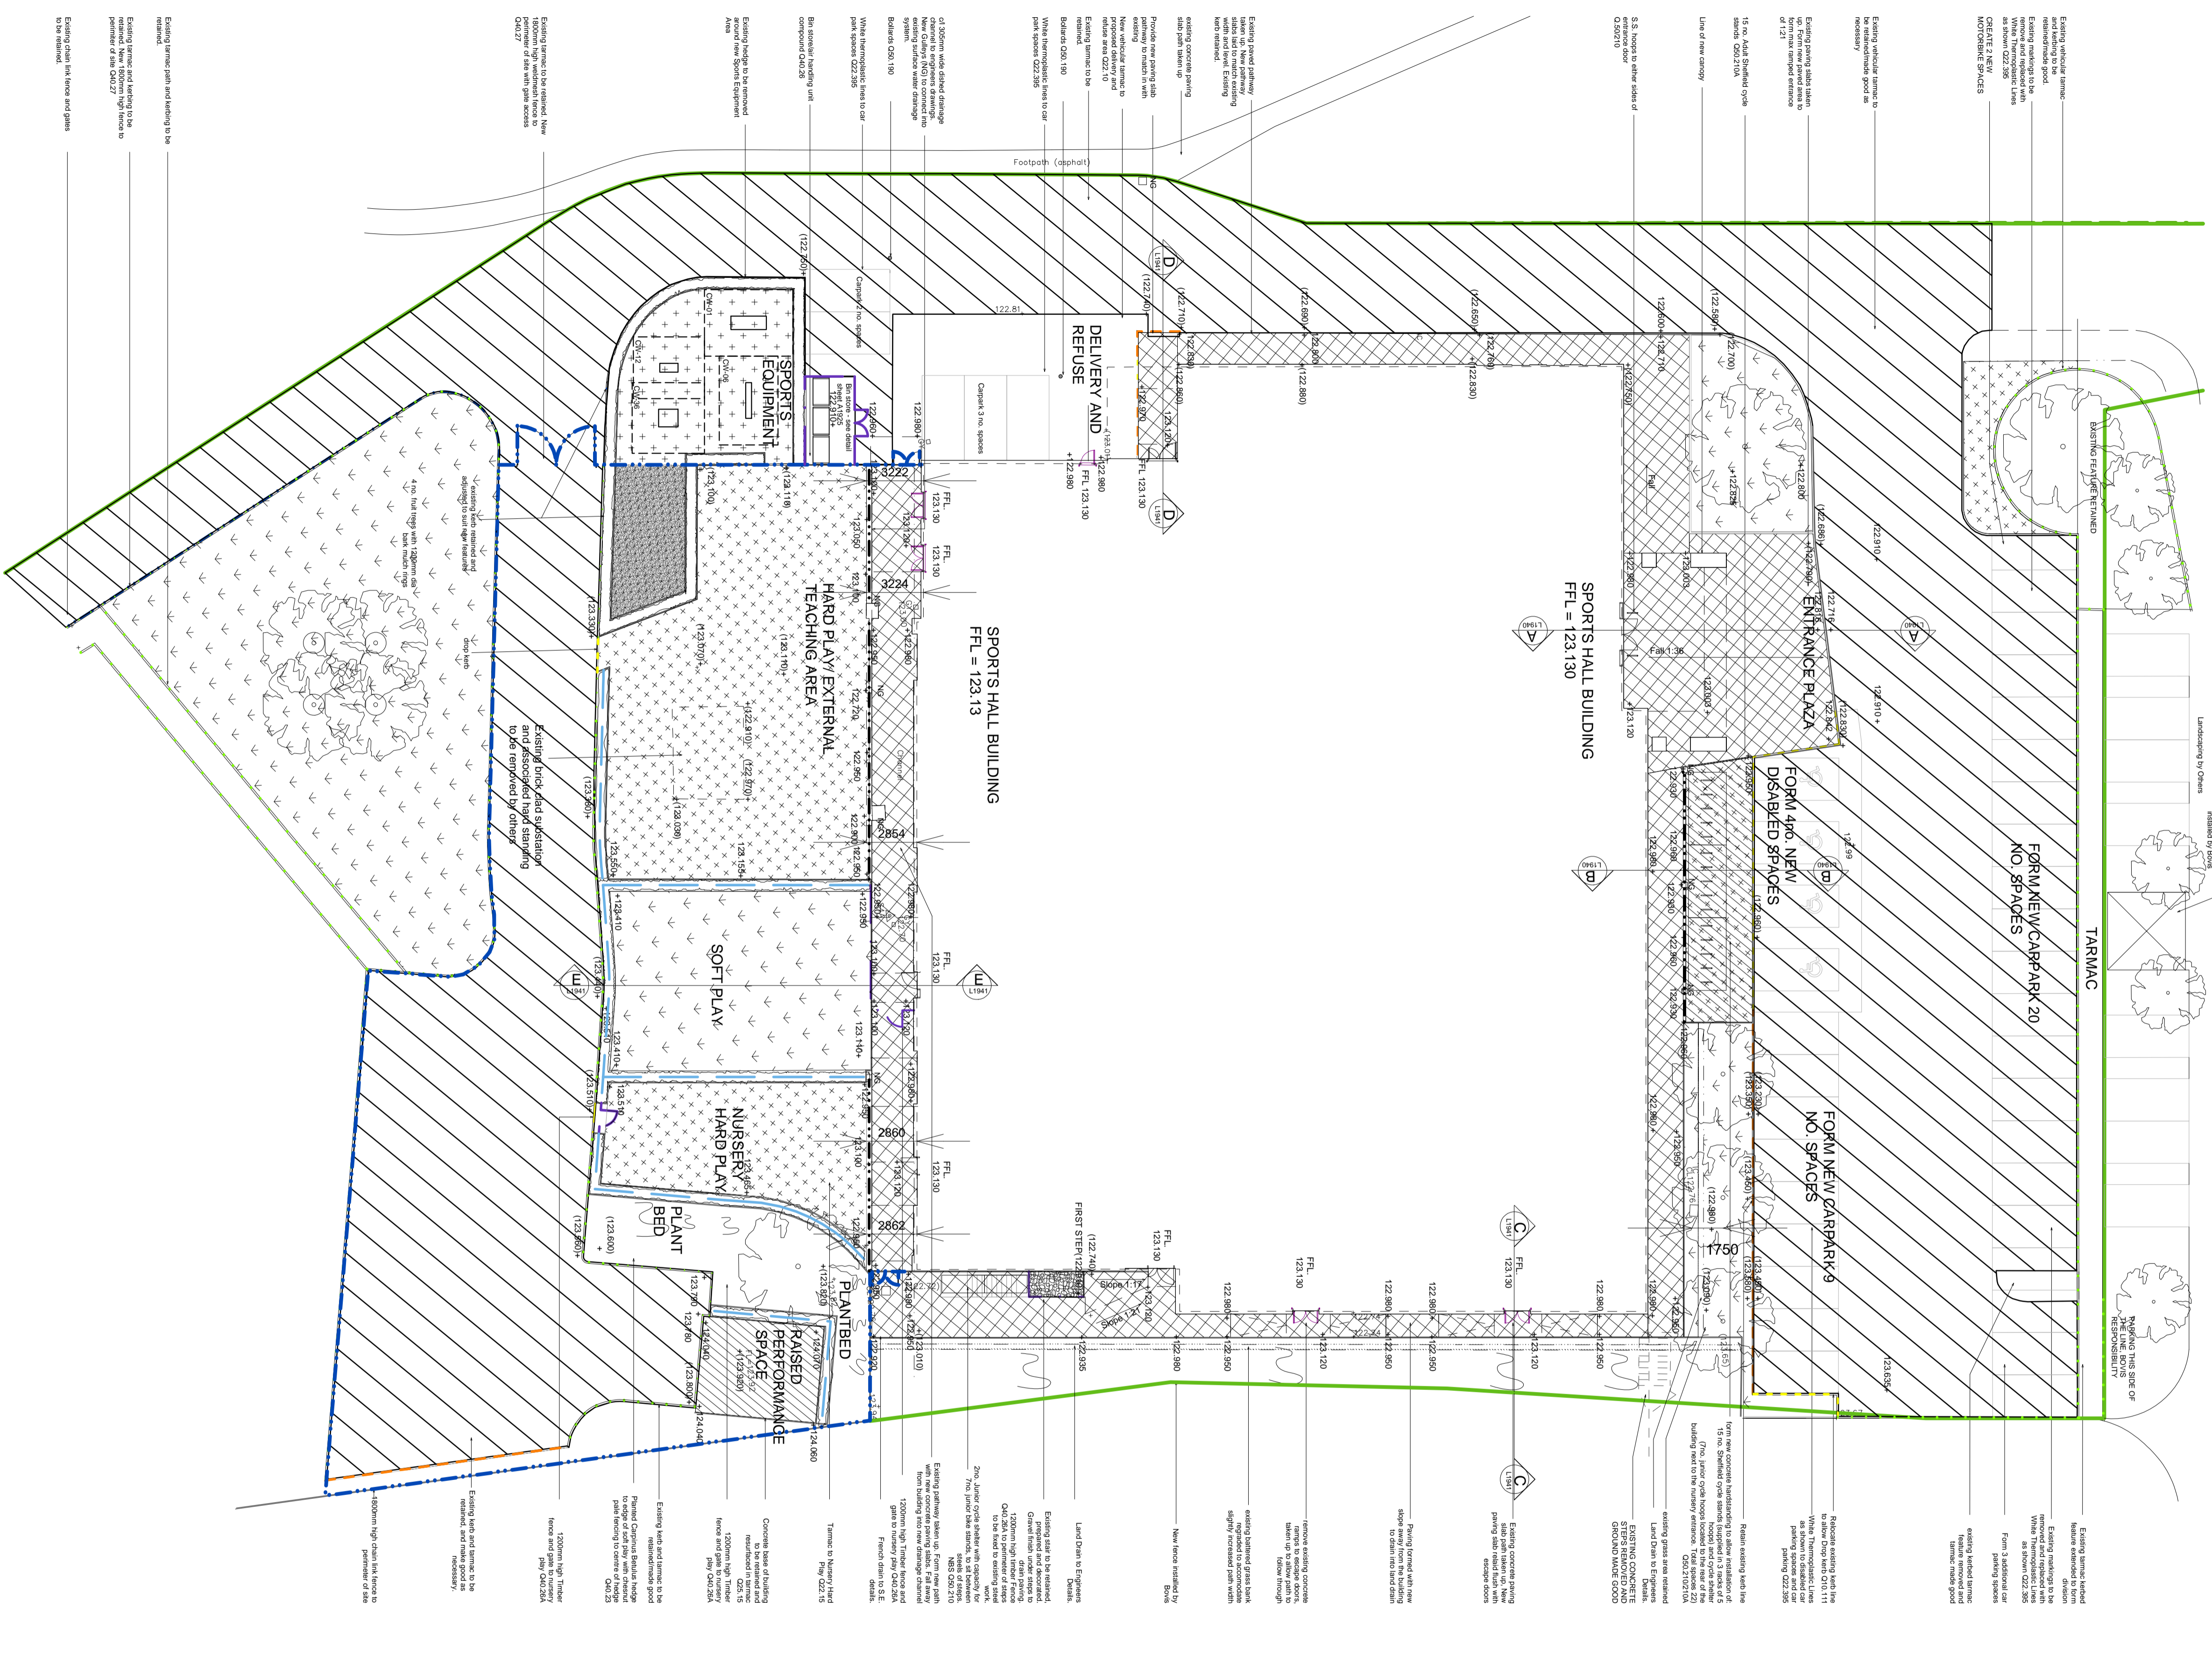

LEGEND

- Standard Pin Kerb Q10.110
- Standard Concrete Kerb Q10.111
- Existing Concrete Kerb to be Retained Q10.111
- Drop Kerb Q10.111
- 1800mm/1200mm High Inner fill and mesh fencing Q40.26/25A
- 1800mm High wild mesh fence to form secure line Q40.27B
- Chestnut Pale Fencing Q40.23
- Boundary Line (No Fence)
- Dished channel
- Land Drain
- Tarmacadam, standard vehicular to be retained.
- Tarmacadam, standard vehicular Q22.10
- Proposed Pedestrian Tarmacadam Q22.15
- Bushes Concrete handstanding
- Paving Slabs Q25.315
- Grass
- Gravel
- Soil
- Existing level +100.00
- Proposed levels +0.00 to +10.000m
- OK = top of kerb
- DK = top of wall
- Proposed coordinates








This line should measure 100mm along x and y axes when printed